
Index 711-002 Bicycle Markings

ORIGINATION

Date: 5/6/2026

Name: Carey Allie Caldwell

Phone: (850)414-4330

Email: carey.caldwell@dot.state.fl.us

COMMENTARY

MUTCD 11th Edition has removed the helmeted bicyclist symbol and therefore all FDOT Standards and Criteria must be updated accordingly.

COMMENTS AND RESPONSES

BLACK = Industry Review Comments **BLUE** = Standard Plans Response **GREEN** = Change Made to Index

Name: Joe Lauk





Date: 7/2/2026

COMMENT: The helmeted bicyclist is removed and the bicycle is added. The SF remains the same. Based on the Shared Lane Marking, the SF should be closer to 5 SF rather than the 6.3 SF shown.

RESPONSE: Thanks for your comment. Great catch - will correct accordingly.

CHANGE MADE TO INDEX: Yes.

Response Date: 7/13/26

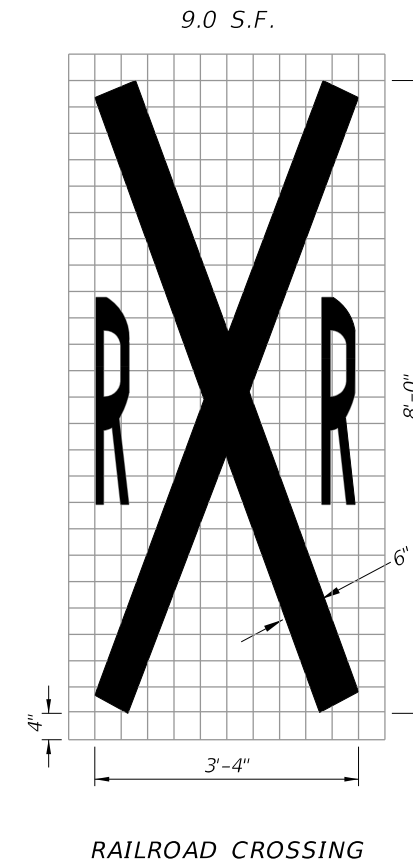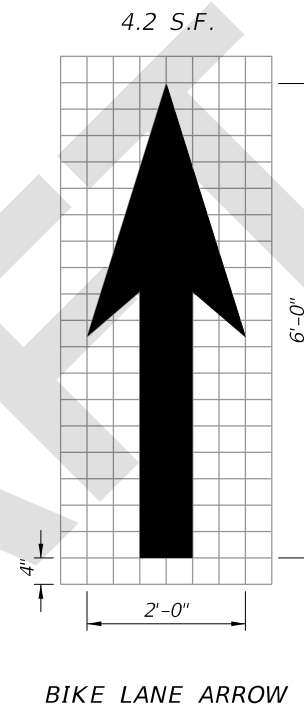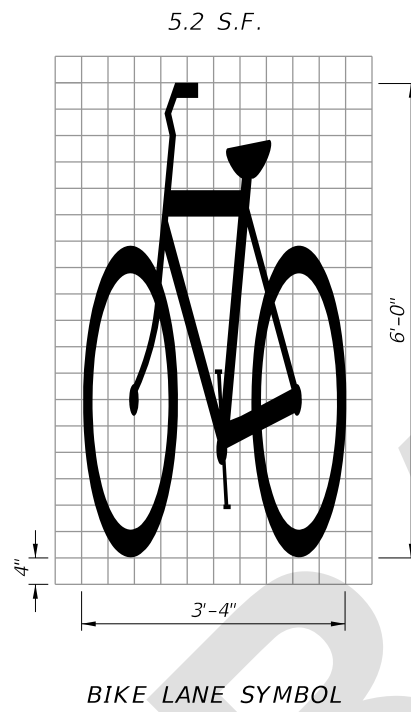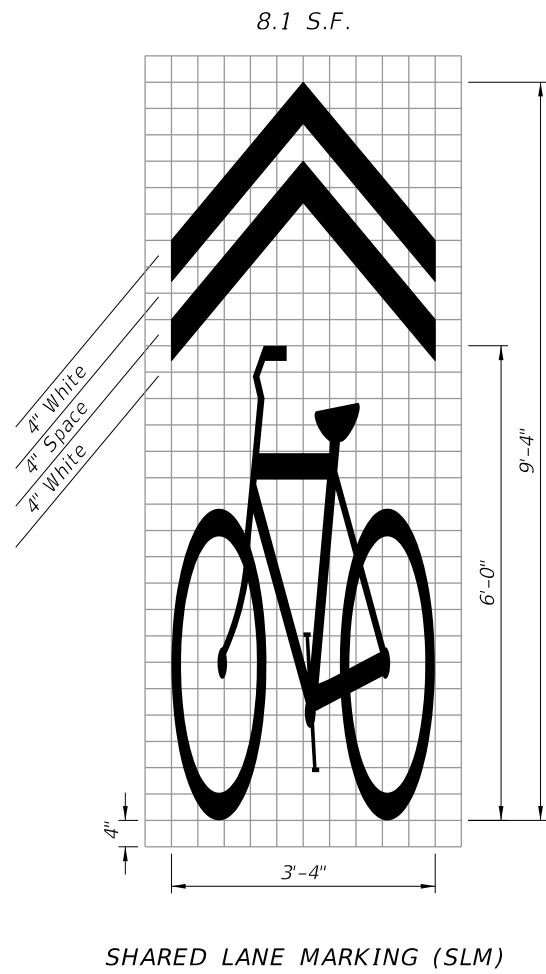

NOTES:

1. All bicycle markings and pavement messages shall be White.
2. All bicycle markings shall be preformed thermoplastic.
3. All grids are 4" x 4".

STANDARD PAVEMENT MARKING MESSAGE LAYOUTS

7/20/2026 10:42:41 AM

LAST REVISION 11/01/26	REVISION	DESCRIPTION:	 FY 2027-28 STANDARD PLANS	BICYCLE MARKINGS	INDEX 711-002	SHEET 1 of 2
------------------------------	----------	--------------	--	------------------	------------------	-----------------