

Final Documentation - Lap Record of Final Plans

TAB - 1

IN THIS SECTION:

1. AGENCY CLOSE OUT CHECK LIST
2. NTP (Agency to contractor)
3. OVERRUN/UNDER RUN
4. CHANGE ORDER(S) WITH TIME
5. TIME DAY COUNTS
6. LIQUIDATED DAMAGES ANALYSIS (If assessed)
7. RECORD OF FINAL PLANS (Form# 525-010-47)

Example



LAP PROJECT CLOSE OUT CHECKLIST LOCAL AGENCY

*District 4
Local Programs*

Financial Project Id (FM): 438342-1-58-01

Date: 2/14/21

Agency: Martin County

Project Name: Savannah Rd. Resurfacing

OFF SHS ON SHS CRITICAL PROJECT

REQUIREMENTS	
<input type="checkbox"/>	<ul style="list-style-type: none">• <u>LAP Record of Final Plans and Documentation (form# 525-010-47)</u>
<input type="checkbox"/>	<ul style="list-style-type: none">• <u>Overrun and Underrun calculations (if applicable)</u>
<input type="checkbox"/>	<ul style="list-style-type: none">• <u>Final Inspection Acceptance form</u>
<input type="checkbox"/>	<ul style="list-style-type: none">• <u>Material Certification letter (See Sample Letter verbiage)</u>
<input type="checkbox"/>	<ul style="list-style-type: none">• <u>Release of Liens documents</u>
<input type="checkbox"/>	<ul style="list-style-type: none">• <u>Anticipated DBE Participation (form# 275-030-12)</u>
<input type="checkbox"/>	<ul style="list-style-type: none">• <u>MBE Payment Certification (form #375-030-31)</u>
<input type="checkbox"/>	<ul style="list-style-type: none">• <u>Asbuilt</u>

Note: Include these documents with the final invoice. Incomplete close out package will result in suspension of final invoice.



MARTIN COUNTY

BOARD OF COUNTY COMMISSIONERS

2401 S.E. MONTEREY ROAD • STUART, FL 34996

DOUG SMITH
STACEY HETHERINGTON
HAROLD E. JENKINS II
SARAH HEARD
EDWARD V. CIAMPI

Commissioner, District 1
Commissioner, District 2
Commissioner, District 3
Commissioner, District 4
Commissioner, District 5

TARYN KRYZDA, CPM
SARAH W. WOODS
TELEPHONE (772) 288-5400
WEBSITE www.martin.fl.us
County Administrator
County Attorney

This document may be reproduced upon request in an alternative format by contacting the County ADA Coordinator (772) 320-3131, the County Administration Office (772) 288-5400, Florida Relay 711, or by completing our accessibility feedback form at www.martin.fl.us/accessibility-feedback.

March 25, 2021

To: Frank White, Project Administrator, The Corradino Group
From: Kimberly McLaughlin, Public Works Grant Coordinator
Cc: Carlos Lemus, LAP District 4 Consultant, FDOT
Subject: Federal-Aid Project Number: 438342-1-58-01
Financial Project Number: 438342-1-58-01
LAP Agreement Number: D419-04-B
Local Contract Number: G1G11 / RFB2020-3190
Local Agency: Martin County Board of County Commissioners
Description: Savannah Road Resurfacing Project

1. LAP Record of Final Plans and Documents
- Documents Contract Time
 - Documents Liquidated Damages
 - Documents Overruns and Underruns
 - Verification of As Builts
2. Final Invoice
- Must show Final Construction Project Cost and Final Plan Quantities
 - Supporting Documentation must attest that all DBEs and Subs have been paid
 - a. Certification Disbursement of Previous and Periodic Payment to Subcontractors
 - b. Lien Releases from all Subcontractors to Prime Contractor, and from Prime to Agency
3. Final Inspection and Acceptance of Federal Aid Project
4. Materials Certification (**From Locals for Off System, From State Materials if On System**)

Regards,

Kim McLaughlin

Kimberly McLaughlin



MARTIN COUNTY

BOARD OF COUNTY COMMISSIONERS

2401 S.E. MONTEREY ROAD • STUART, FL 34996

DOUG SMITH
STACEY HETHERINGTON
HAROLD E. JENKINS II
SARAH HEARD
EDWARD V. CIAMPI

Commissioner, District 1
Commissioner, District 2
Commissioner, District 3
Commissioner, District 4
Commissioner, District 5

TARYN KRYZDA, CPM
SARAH W. WOODS
TELEPHONE (772) 288-5400
WEBSITE www.martin.fl.us

County Administrator
County Attorney

This document may be reproduced upon request in an alternative format by contacting the County ADA Coordinator (772) 320-3131, the County Administration Office (772) 288-5400, Florida Relay 711, or by completing our accessibility feedback form at www.martin.fl.us/accessibility-feedback.

Phone: (772) 288-5777
Fax: (772) 288-5789
Email: kmclaugh@martin.fl.us

May 15, 2020

Community Asphalt Corp.
NW 117th Avenue, Suite 108
Miami, FL 33177

RE: Savannah Road Resurfacing & Bike Lanes
438342-1-58-01 / G1-G11 / D419-041-B
Notice to Proceed

Mr. Hickey,

This letter constitutes the official “Notice to Proceed” for the Savannah Road Resurfacing & Bike Lanes project for all work associated in the Contract including but not limited to *milling, resurfacing, and roadway widening to add bike lanes along NE Savannah Road. The scope of work also includes the installation of drainage piping and exfiltration piping/trench, erosion control, clearing and grubbing, excavation, fill and embankment, drainage structures and piping, bahia sod, and other incidental work as shown and specified in the Contract Documents.* The lump sum fee for this contract is **\$1,046,885.65**.

The official start date shall be **June 1, 2020** and work shall be finished to Substantial Completion within 130 days or by **October 11, 2020**. The Final Completion shall be within 30 days of issuance of the Punch List (not to exceed 60 days from substantial completion).

Please acknowledge receipt of this ‘Notice to Proceed’ where indicated below and return the signed original and signed and notarized Exhibit A to me.

Sincerely,

Kim McLaughlin

Kimberly McLaughlin
Construction Contract & Grants Administrator

Receipt of “Notice to Proceed” acknowledged by:

Don Hickey

Don Hickey Community Asphalt, Corp.
EVP, Southeast Civil Division

EXHIBIT A TO NOTICE TO PROCEED

MARTIN COUNTY'S NOTICE AND CONTRACTOR'S ACKNOWLEDGEMENT OF CONTRACTUAL LIQUIDATED DAMAGES PROVISIONS

Community Asphalt, Corp. (the "Contractor") is hereby notified by Martin County (the "County") and acknowledges the following:

1. Article 7 of the contract between Martin County and Contractor dated March 24, 2020, (the "Contract") for the construction of **Savannah Road Resurfacing & Bike Lanes project** specifically provides the following:

7.1 Upon failure of the CONTRACTOR to Substantially Complete the Agreement within the specified period of time, plus approved time extensions, the CONTRACTOR shall pay to the COUNTY daily liquidated damages in the amount shown on Page 1 of this Agreement to reflect the COUNTY's estimated damages resulting from the delay to Substantial Completion.

7.2 Upon failure of the CONTRACTOR to Finally Complete the Agreement within the specified period of time, plus approved time extensions, the CONTRACTOR shall pay to the COUNTY daily liquidated damages in the amount shown on Page 1 of this Agreement to reflect the COUNTY's estimated damages resulting from the delay to Final Completion.

7.3 Milestones, milestone completion dates, and applicable Liquidated Damages shall be in accordance with the Contract Documents.

7.4 If the milestones are not strictly complied with, then Liquidated Damages will be assessed against the CONTRACTOR, which are agreed upon, and it is further agreed that such Liquidated Damages bear a reasonable relationship to damages to be incurred by the COUNTY, and are not a penalty.

2. The Contract further provides on page 1 that daily liquidated damages for delays in substantial completion is the amount of \$1,665.00, and the daily liquidated damages for final completion is the amount of \$1,665.00.

3. The Contractor acknowledges the Contractor and the County stipulated in advance the amount to be paid as liquidated damages in the event of a breach as provided in the Contract, and further, the Contractor and the County so stipulated because the damages from a breach were not readily ascertainable at the time of the drawing of the Contact.

4. The Contractor further acknowledges the liquidated damages provisions of the Contract are not a penalty.

5. Nothing in this Notice and Acknowledgment shall constitute a waiver of any affirmative defense the Contractor may have to any claim of liquidated damages other than the amount of the liquidated damages as provided in the Contract.

6. The Contractor signs this Notice and Acknowledgement through its duly authorized representative and does so voluntarily and without duress after reading the foregoing in its entirety.

State of Florida)
)
County of Miami-Dade) SS

Community Asphalt, Corp.

By: Don Hickey
Don Hickey
EVP, Southeast Civil Division


Sworn to and subscribed before me this 26th day of May, 2020, by
Don Hickey, who is personally known to me or has produced identification
(if identification, state type: -----).

Sandra Elizondo
Notary Public

Print Name:

Sandra Elizondo

My commission expires:

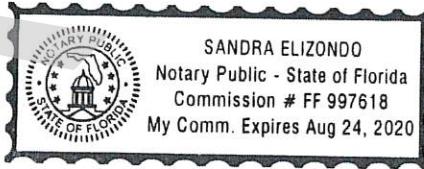

Construction Cost Analysis
FM# 458342-1-SB-01

Contract No.: G-1611
Project Description: Savannah Road Resurfacing Project

Pay Item Number*	Pay Item Description*	FINAL QUANTITY				Overrun/Underrun	Justification	
		Unit	Bid Quantity	Bid Price	Bid Cost	Quantity	Construction Cost	
E22-1	Concrete Sidewalk, 4" Thick	SY	126,000	\$7,861.20	1,000,046		\$2,109.55	The final quantity reflects the actual amount of 4" Sidewalk installed and approved for the project.
E22-2	Concrete Driveway, 6" Thick	SY	355,000	\$21,945.50	3,877,355	24,074,325	\$2,152.69	The final quantity reflects the actual amount of driveway installed and approved for the project.
E70-1-2	Bahia Sod	SF	3000,000	\$2.30	5,380,000	11,150		The final quantity reflects the actual amount of Bahia sod installed and approved for the project.
E70-1-2	Bahia Sod	SF		\$2.00		9,750	19,500,000	Contractor charged \$0 at cost due to contractor's miscalculations. This is 30 less than bid price.
T05-5	Remo-Reflective Pavement Markers	EA	1075,000	\$3.30	\$3,440.90	1528	\$5,655.800	The final quantity reflects the actual amount of Thermo Plastic Standards White, 12" Solid installed and approved for the project.
711-1-1-123	Thermo Plastic, Standard, White, 12" Solid	LF	773,000	\$2.70	\$2,087.10	1828	\$4,860.200	The final quantity reflects the actual amount of Thermo Plastic, Standard, White, 12" Solid installed and approved for the project.
711-1-1-234	Thermo Plastic, Standard, White, 24" Solid	LF	240,000	\$5.240	\$2,366.00	487	\$259,800	The final quantity reflects the actual amount of Thermo Plastic, Standard, White, 24" Solid installed and approved for the project.
	Insulation or Felt Backing	EA	0.0001	\$0.00	0.000	1	1000,000	Installed per Martin County. Excessively left off of bid items.
	Filled Density Tests	EA				22	25,000	Changed back to the Contractor per Martin County Contract RFB 2020-3150
	Geotechnical Stand by hours	EA				25	60,000	Changed back to the Contractor per Martin County Contract RFB 2020-3150
	Geotechnical Stand by hours	EA				2	105,000	Changed back to the Contractor per Martin County Contract RFB 2020-3150
							\$28,573.35	
								Subtotal
								Subtotal

*Total Projects **SMALL** utilize FDOT pay item numbers and descriptions.

Justification

Any difference of \$10,000 or more

Any unused quantities



**MARTIN COUNTY BOARD OF COUNTY COMMISSIONERS
CHANGE ORDER TO CONSTRUCTION AGREEMENT**

PROJECT NAME: Savannah Road Resurfacing
CONTRACT #: 438342-1-58-01 / D419-041-B / G-1G11 / RFB2020-
3190
CONTRACT DATE: 3/24/2020

CHANGE ORDER #: 1
CO DATE: 8/27/2020

The Contract is changed as follows:

Original Contract Sum	\$	1,046,885.65
Net Change by Previously Authorized Change Orders	\$	-
Contract Sum Prior to This Change Order	\$	1,046,885.65
Amount of this Change Order	\$	4,120.25
New Contract Sum	\$	1,051,005.90

Contract Time Increase (calendar days)
Substantial Completion Date (Actual)
New Final Completion Date, if applicable

0
10/11/2020

Community Asphalt (OHL)

**BOARD OF COUNTY COMMISSIONERS
MARTIN COUNTY, FLORIDA**

Danny
Lustgarten

Digitally signed by Danny Lustgarten
DN: cn=Danny Lustgarten, o=OHL/CAC,
ou=email=danny.lustgarten@ohl.ca,
c=US
Date: 2020-09-09 17:02:20 -04'00'

Danny Lustgarten
Project Manager

James Gorton
Public Works Director



MARTIN COUNTY

BOARD OF COUNTY COMMISSIONERS

2401 S.E. MONTEREY ROAD • STUART, FL 34996

DOUG SMITH Commissioner, District 1
STACEY HETHERINGTON Commissioner, District 2
HAROLD E. JENKINS II Commissioner, District 3
SARAH HEARD Commissioner, District 4
EDWARD V. CIAMPI Commissioner, District 5

TARYN KRYZDA, CPM County Administrator
SARAH W. WOODS County Attorney

TELEPHONE (772) 288-5400
WEBSITE www.martin.fl.us

This document may be reproduced upon request in an alternative format by contacting the County ADA Coordinator (772) 320-3131, the County Administration Office (772) 288-5400, Florida Relay 711, or by completing our accessibility feedback form at www.martin.fl.us/accessibility-feedback.

August 20, 2020

TO: Carlos Lemus, FDOT- LAP D4 Consultant
FR: George Dzama, P.E., MC – Capital Project Manager
RE: 438342-1 Savannah Rd Resurfacing
Change Order 1 Request

Carlos,

The county would like to install an 18" riser at R-50 per Martin County Standard Detail. The cross slope is too steep due to the extension of the turn lane. This change will mitigate any safety hazards.

We have verified the cost to be fair pricing.

This work will be done as a change Order to the current Contract. Martin County is not requesting any additional funds for this work.

Sincerely,

George Dzama

RF/kcm

Cc: Rene Fresneda, Project Manager
Frank White, The Corradino Group, LAP oversight
Diego Velazquez, FDOT – Treasure Coast

SUMMARY OF WORK ORDER

FM - 438342-1-58-01
Savannah Road Project CAC # 7257

DATE: DESCRIPTION:	<u>Wednesday, August 19, 2020</u>
LABOR BREAKDOWN	<u>Cost Proposal 1 - Installation of Manhole Riser at Savannah Road</u>
	<u>Includes: Material Costs, Installation and Equipment</u>

DESCRIPTION	U/M	RATE	QTY	EXTENSION	TOTAL COST
Foreman (8/17/2020)	HR	\$ 56.24	8	\$ 449.92	
Labor - 8/17/2020 (8 hours), 8/18/2020 (4 hours) (Crew 1)	HR	\$ 31.17	12	\$ 374.04	
Low Boy Driver	HR	\$ 41.57	4	\$ 166.28	
Rubber Tire Operator (1 full day, 1 half day)	HR	\$ 37.18	12	\$ 446.16	
Loader Operator	HR	\$ 41.57	4	\$ 166.28	
TOTAL LABOR: \$		1,602.68			

MATERIAL BREAKDOWN

DESCRIPTION	U/M	RATE	QTY	EXTENSION
Type E - Manhole Riser (18" Height)	EA	\$ 277.00	1	\$ 277.00
Wrapid Seal (Core and Main)	ROLL	\$ 142.27	2	\$ 284.54
			-	\$

TOTAL MATERIAL: \$ 561.54

EQUIPMENT

EQUIPMENT	U/M	RATE	QTY	EXTENSION
Lowboy - Delivery	HR	\$ 50.00	4	\$ 200.00
Rubber Tire Excavator (Unload, Setup)	HR	\$ 40.00	12	\$ 480.00
Loader (Fill allowance)	HR	\$ 25.00	4	\$ 100.00
Tamping	HR	\$ 10.00	4	\$ 40.00
				TOTAL EQUIPMENT \$ 820.00

SUBCONTRACT

SUBCONTRACTOR	U/M	RATE	QTY	EXTENSION
Hirequest - Flaggers (2)(8/17), (1)(8/18 - 8 hours)	HR	\$ 21.50	24.00	\$ 516.00
				BCONTRACT \$ 516.00

TOTAL LABOR: \$ 1,602.68
 TOTAL MATL: \$ 561.54
 TOTAL MATL TAX (7%): \$ 39.31
 TOTAL EQUIP: \$ 820.00
 Profit 17.5% \$ 3552.65


TOTAL SUBC: \$ 516.00

10% \$ 567.60


SUBTOTAL: \$ 4,120.25
 TOTAL \$ 4,120.25



SPECIAL
ACCESSORY TO
ORDER BY CPPB:
NONE.

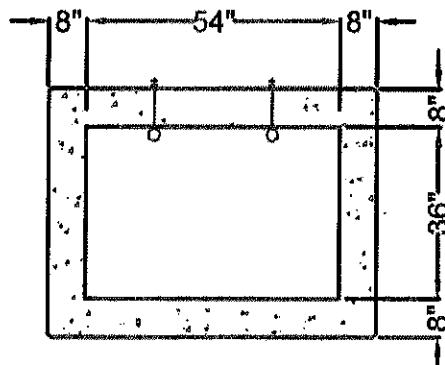


PLAN VIEW

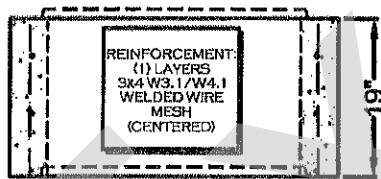

FRONT ELEVATION

RISER TOTAL:	
2,763#S	
0.69 CYDS	

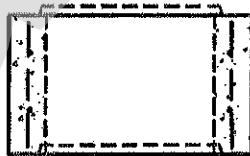

SIDE ELEVATION

DBI TYPE "E" RISER



CONCRETE PRODUCTS
OF THE PALM BEACHES, INC.

460 AVENUE "B"
RIVIERA BEACH, FL 33404
PHONE: 561-842-2743
FAX: 561-842-6387

COMMUNITY ASPHALT

JOB NAME

PROJECT NUMBER:
ML2020

STR NUMBER:
R1

STR TYPE:
DBI TYPE "E"
RISER
F.D.O.T. INDEX:
200, 201 & 232

CASTING:

CONC. WEIGHT: 1,744#V/FT


GRATE ELEV:	-
INVERT ELEV:	-
CUT HEIGHT:	-
ADJUSTMENTS:	-
BOT. ELEV:	-
TOTAL HEIGHT:	-

GENERAL NOTES:


1. ALL CONCRETE TO BE 4000 PSI COMPRESSIVE STRENGTH @ 28 DAYS TYPE II CONCRETE.
2. STEEL REINFORCING PER F.D.O.T. INDEX #200 & #232.
3. ALL REINFORCING TO BE MINIMUM OF GRADE 60 STEEL WITH 2" CLR IN BASE & 3" CLR IN THE WALLS.
4. ADDITIONAL REINFORCING @ ALL OPENINGS.
5. F.D.O.T INSPECT & STAMP: NO.
6. (2) EYEBOLT & (2) CHAIN @ 30": YES (EYEBOLTS IN WALL AS SHOWN & PLACED 5" BELOW GRATE SEAT)

DATE: 8-4-20	REVISION:
DRAWN BY: AD	SCALE: N.T.S.
DWG NUM: R1	LOCATION:
REMARKS:	

MATCH LINE STA. 91+40

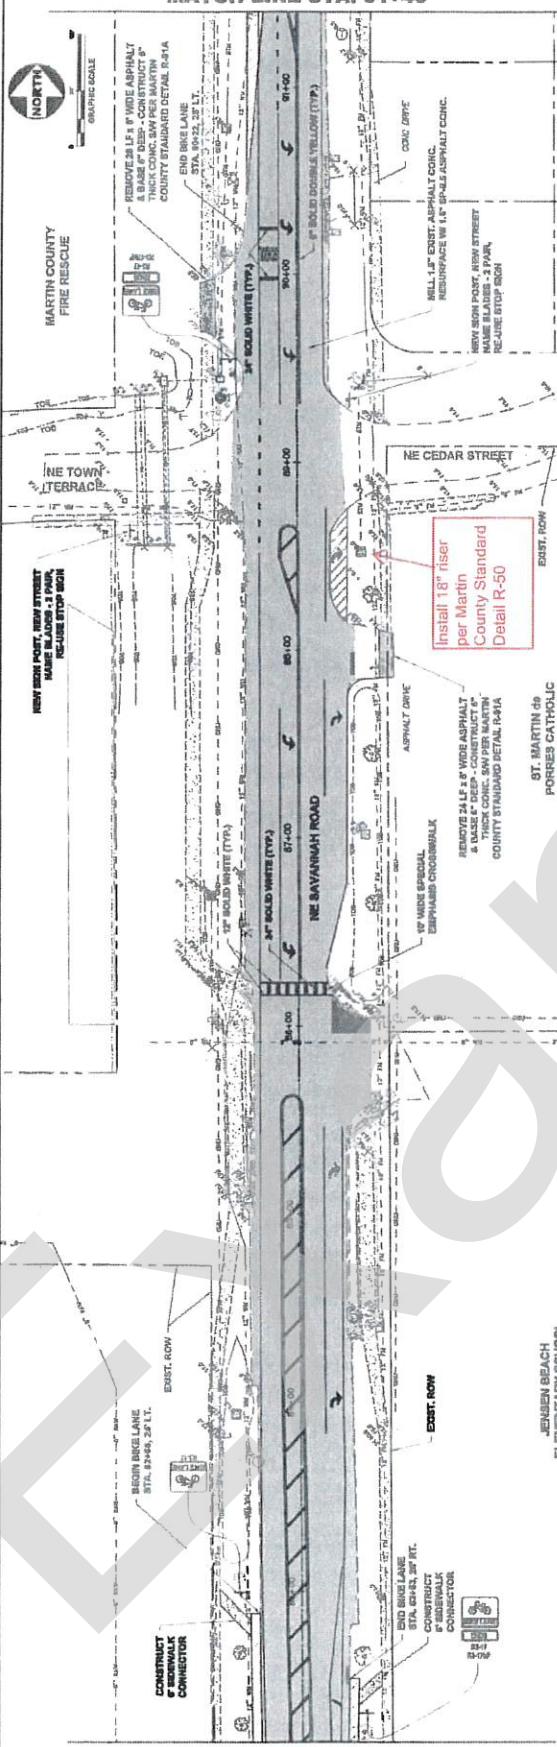

MATCH LINE STA. 100+60

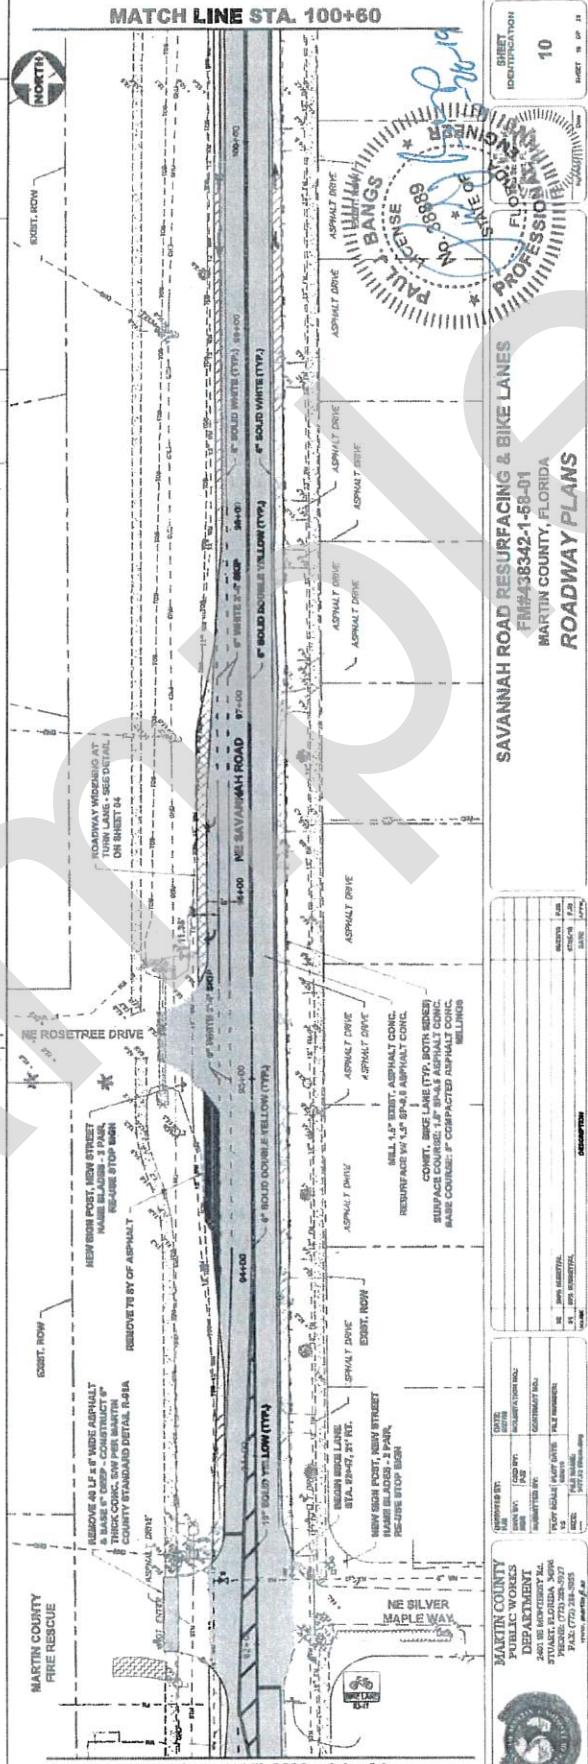

SAVANNAH ROAD RESURFACING & BIKE LANES
FM#438342-1-158-01
MARTIN COUNTY, FLORIDA
ROADWAY PLANS



MARIN COUNTY
PUBLIC WORKS
DEPARTMENT
44-461 99 MONTGOMERY RD.
SUITE 1, FLORIDA 34990
(727) 288-5927
(727) 288-5935
[WWW.MARINFL.GOV](http://www.marinfl.gov)



Kimberly McLaughlin

From: Lemus, Carlos <Carlos.Lemus@dot.state.fl.us>
Sent: Thursday, September 3, 2020 8:54 AM
To: Kimberly McLaughlin; George Dzama
Cc: Velazquez, Diego
Subject: 438342-1 Savannah Rd - Change Order No. 1 FDOT Concurrence
Attachments: 438342-1 SavannahRdResurfacing_CO1_Final.pdf

**Think Before You Click: This Email Originated
Outside of your organization.**

Good morning Kim,

The Department has reviewed C.O. #1 for FM 438342-1 and concur with the proposed work with no additional funding from FDOT.

Thank you.

Carlos Lemus
LAP D4 Consultant
Program Management-FDOT District Four
Teleworking Schedule M-F 7:00 am to 3:30 pm
O: 954-777-4522
Carlos.Lemus@dot.state.fl.us





MARTIN COUNTY BOARD OF COUNTY COMMISSIONERS
CHANGE ORDER TO CONSTRUCTION AGREEMENT

PROJECT NAME: Savannah Road Resurfacing
CONTRACT #: 438342-1-58-01/G1G11/RFB20203190
CONTRACT DATE: 3/24/2020

CHANGE ORDER #: 2
CO DATE: 12/15/2020

The Contract is changed as follows:

Pay Item	Description	Unit	Quantity	Unit Price	Overrun/Underrun Amount	Justification
522-1	Concrete Sidewalk 4" Thick	SY	55.33	\$56.20	\$3,109.55	See attached
522-2	Concrete Driveway 6" Thick	SY	32.55	\$85.50	\$2,732.03	
570-1-2	Bahia Sod	SF	9350	\$2.00	\$18,700.00	
706-3	Retro-Reflective Pavement Markers	EA	553	\$3.30	\$1,824.90	
711-11-123	Thermo Plastic, Standard, White, 12" Solid	LF	1053	\$2.70	\$2,843.10	
711-11-125	Thermo Plastic, Standard, White, 24" Solid	LF	197	\$5.40	\$1,063.80	
NA	Installation of new loop window	EA	1	\$1,500.00	\$1,500.00	
NA	Failed Density Tests	EA	22	\$25.00	-\$550.00	
NA	Geotechnical stand by hours	EA	25	\$80.00	-\$1,500.00	
NA	Geotechnical stand by hours	EA	2	\$105.00	-\$210.00	
TOTAL				\$ 28,913.37		

Original Contract Sum	\$ 1,046,885.65
Net Change by Previously Authorized Change Orders	\$ 4,120.25
Contract Sum Prior to This Change Order	\$ 1,051,005.90
Amount of this Change Order	\$ 28,913.37
New Contract Sum	\$ 1,079,919.27

Contract Time Increase (calendar days)

0

Substantial Completion Date (Actual)

10/11/2020

New Final Completion Date, If applicable

11/25/2020

COMMUNITY ASPHALT (OHL)


Danny Lustgarten
Project Manager

BOARD OF COUNTY COMMISSIONERS
MARTIN COUNTY, FLORIDA


James Gorton
Public Works Director



MARTIN COUNTY

BOARD OF COUNTY COMMISSIONERS

2401 S.E. MONTEREY ROAD • STUART, FL 34996

DOUG SMITH
STACEY HETHERINGTON
HAROLD E. JENKINS II
SARAH HEARD
EDWARD V. CIAMPI

Commissioner, District 1
Commissioner, District 2
Commissioner, District 3
Commissioner, District 4
Commissioner, District 5

TARYN KRYZDA, CPM
SARAH W. WOODS

TELEPHONE (772) 288-5400
WEBSITE www.martin.fl.us

County Administrator
County Attorney

This document may be reproduced upon request in an alternative format by contacting the County ADA Coordinator (772) 320-3131, the County Administration Office (772) 288-5400, Florida Relay 711, or by completing our accessibility feedback form at www.martin.fl.us/accessibility-feedback.

December 15, 2020

Mr. Carlos Lemus
Florida Department of Transportation
District Program Management Office
3400 West Commercial Blvd
Fort Lauderdale, FL 33309-3421

RE: FM# 438342-1-58-01 Savannah Road Resurfacing - Change Order #2 Request

Mr. Lemus,

Please find the Change Order # 2 (Overrun/Underrun) request for 438342-1 Savannah Rd Resurfacing for FDOT concurrence.

Justification/Clarification:

1. The Sod tickets and quantity calculations have been verified by field inspection. The Contractor charged us less than bid price for the overage due to their miscalculations and that of the plans.
2. We have included the invoice for installation of the traffic window that was verified by Martin County to be a fair price.
3. We have attached the invoice and back up for charge-backs from geotesting delays and failed tests per Community's contract with Martin County in section 1010 of the Technical Specifications: 2.2 Coordination #C.

The CONTRACTOR shall coordinate with the COUNTY'S soils and material testing consultants. The CONTRACTOR is responsible for scheduling and coordinating all soil and material testing required in the performance the Work. Unless otherwise specified in the Contract Documents, the number and frequency of soils and material testing shall be in accordance with the FDOT Guidelines for Sampling and Testing. The COUNTY will pay for costs associated with the initial soils and material testing and the CONTRACTOR will be liable for costs associated with re-testing as a result of initial test failure due to deficiencies in the CONTRACTOR'S work efforts.

The work is a change to the current contract. Martin County is not asking the District for any additional funding.

Sincerely

Kimberly McLaughlin

Kimberly McLaughlin
Public Works Grants Coordinator

Cc: George Dzama, Capital Projects Administrator
Rene Fresneda, Sr. Project Manager

Kimberly McLaughlin

From: Williams, Mya <Mya.Williams@dot.state.fl.us>
Sent: Friday, January 22, 2021 12:47 PM
To: Kimberly McLaughlin
Cc: George Dzama; Lemus, Carlos
Subject: RE: 438342-1_SavannahRd_Resurfacing_CO2 - charging issue

**Think Before You Click: This Email Originated
Outside of your organization.**

Morning Kim,

As part of our oversight, we are to ensure the County is following its Contract. Therefore, we concur with Contractor responsibility. The Department concur with Change Order #2 at not additional time and/or cost to the LAP Agreement.

Thank you.

Mya Williams-Gray
Local Program Administrator
District 4 Program Management Office
Email: mya.williams@dot.state.fl.us
Work Phone: 954-777-4608
FDOT Cell: 954-459-5447




From: Kimberly McLaughlin <kmclaugh@martin.fl.us>
Sent: Friday, January 22, 2021 10:12 AM
To: Williams, Mya <Mya.Williams@dot.state.fl.us>
Cc: George Dzama <gdzama@martin.fl.us>
Subject: RE: 438342-1_SavannahRd_Resurfacing_CO2 - charging issue

EXTERNAL SENDER: Use caution with links and attachments.

Good morning Mya,

I am just following up the email below regarding Savannah Rd – CO2.

Regards,
Kim

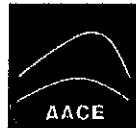

ANDERSEN ANDRE CONSULTING ENGINEERS, INC.

834 SW Swan Avenue
Port St. Lucie, Florida 34983

INVOICE

Invoice No: A20-3121
Invoice Date: July 22, 2020
AACE Project No: 20-175

Bill To: Martin County Board of County Commissioners
Public Works Department
2401 SE Monterey Road
Stuart, FL 34996

Attention: Ms. Kimberly McLaughlin

**CONSTRUCTION MATERIALS TESTING
SAVANNAH ROAD RESURFACING & BIKE LANES
MARTIN COUNTY, FLORIDA
Martin County Purchase Order No. P2005396**

Martin County Vendor No. 28510

(Invoice No. 1: Services Performed Between May 25, 2020 and July 17, 2020)

Field Density Testing:

- 06/09/20 - 4 in-place density tests @ \$25.00/test..... \$100.00
- 06/10/20 - 6 in-place density tests @ \$25.00/test..... \$150.00
- 06/11/20 - 4 in-place density test @ \$25.00/test..... \$100.00
- 06/12/20 - 8 in-place density tests @ \$25.00/test..... \$200.00
- 06/15/20 - 8 in-place density tests @ \$25.00/test..... \$200.00
- 06/16/20 - 4 in-place density tests @ \$25.00/test..... \$100.00
- 06/17/20 - 8 in-place density tests @ \$25.00/test..... \$200.00
- 06/18/20 - 4 in-place density tests @ \$25.00/test..... \$100.00
- 06/19/20 - 8 in-place density tests @ \$25.00/test..... \$200.00
- 06/22/20 - 7 in-place density tests @ \$25.00/test..... \$175.00
- 06/23/20 - 10 in-place density tests @ \$25.00/test..... \$250.00
- 06/24/20 - 12 in-place density tests @ \$25.00/test..... \$300.00
- 06/25/20 - 10 in-place density tests @ \$25.00/test..... \$250.00
- 06/26/20 - 13 in-place density tests @ \$25.00/test..... \$325.00
- 06/29/20 - 5 in-place density tests @ \$25.00/test..... \$125.00
- 06/30/20 - 13 in-place density tests @ \$25.00/test..... \$325.00
- 07/01/20 - 21 in-place density tests @ \$25.00/test..... \$525.00
- 07/03/20 - 11 in-place density tests @ \$25.00/test..... \$275.00
- 07/13/20 - 7 in-place density tests @ \$25.00/test..... \$175.00
- 07/14/20 - 12 in-place density tests @ \$25.00/test..... \$300.00

Subtotal: \$4,375.00

Engineering Technician Man-Hours:

- 05/27/20 - 1 hour @ \$60.00/hour (meet Rene to collect Proctors)..... \$60.00
- 06/09/20 - 2 hours @ \$60.00/hour (standby at request of contractor for base to be delivered)..... \$120.00
- 06/16/20 - 2 hours @ \$60.00/hour (standby at request of contractor, testing canceled due to moisture) .. \$120.00
- 06/22/20 - 4 hours @ \$60.00/hour (standby during compaction at request of contractor)..... \$240.00
- 06/23/20 - 3.5 hours @ \$60.00/hour (standby during compaction at request of contractor) \$210.00
- 06/24/20 - 4 hours @ \$60.00/hour (standby during compaction at request of contractor)..... \$240.00
- 06/26/20 - 2 hours @ \$60.00/hour (standby, testing canceled upon 2nd visit to site)..... \$120.00
- 06/29/20 - 2 hours @ \$60.00/hour (standby during compaction at request of contractor)..... \$120.00
- 06/30/20 - 3 hours @ \$60.00/hour (standby during compaction at request of contractor)..... \$180.00

Subtotal: \$1,410.00

- Invoice Continued on Next Page -

Laboratory Testing:

- | | |
|---|-----------------|
| • LBR Test: 1 test @ \$295.00/test | \$295.00 |
| • Proctor Tests: 5 tests @ \$88.00/test | <u>\$440.00</u> |

Subtotal: \$735.00

Professional/Administrative Man-Hours:

- | | |
|---|-----------------|
| • Sr. Project Engineer; 4 hours @ \$130.00/hour | \$520.00 |
| • Technical Secretary; 3 hours @ \$48.00/hour | <u>\$144.00</u> |

Subtotal: \$664.00

TOTAL INVOICE AMOUNT \$7,184.00

Please remit payment within 30 days to:

Andersen Andre Consulting Engineers, Inc. • 834 SW Swan Avenue • Port St. Lucie, Florida 34983
Please call (772) 807-9191 with any questions concerning payment

Construction Cost Analysis
FW# 438342-1-58-01
Contract No: G-1G11

Project Description: Savannah Road Resurfacing Project

Pay Item Number*	Pay Item Description*	CONTRACT QUANTITY				FINAL QUANTITY		Overrun/Underrun	Justification
		Unit	Bid Quantity	Bid Prices	Bid Cost	Quantity	Construction Cost		
522-1	Concrete Sidewalk, 4" Thick	SY	126,000	\$58.20	\$7,081.20	181,33	10130,746	\$3,109.55	The final quantity reflects the actual amount of 4" Sidewalk installed and approved for the project.
522-2	Concrete Driveway, 6" Thick	SY	386,000	\$65.50	\$21,942.50	367,55	24074,525	\$2,132.03	The final quantity reflects the actual amount of 6" driveway installed and approved for the project.
570-1-2	Bahia Sod	SF	3600,000	\$2.50	\$18,000.00	11150			The final quantity reflects the actual amount of Bahia sod installed and approved for the project.
570-1-2	Bahia Sod	SF		\$2.00		9850	18700,000	\$18,700.00	Contractor charged 100% at cost due to contractor's miscalculations. This is .30 less than bid price.
706-3	Retro-Reflective Pavement Markers	EA	1073,000	\$3.30	\$3,540.90	1826	5365,800	\$1,824.90	The final quantity reflects the actual amount of RPPMs installed and approved for the project.
711-11-123	Thermo Plastic, Standard, White, 12" Solid	LF	773,000	\$2.70	\$2,087.10	1828	4530,200	\$2,843.10	The final quantity reflects the actual amount of Thermo Plastic, Standard, White, 12" Solid installed and approved for the project.
711-11-125	Thermo Plastic, Standard, White, 24" Solid	LF	240,000	\$5.40	\$1,296.00	437	235,000	\$1,063.80	The final quantity reflects the actual amount of Thermo Plastic, Standard, White, 24" Solid installed and approved for the project.
	Installation of new logo window	EA	0,000	\$0.00	\$0.00	1	150,000	\$1,500.00	Installed per Martin County. Erroneously left off bid items.
	Filled Density Tests	EA				22	25,000	\$550.00	Charged back to the Contractor per Martin County Contract RFB 2020-3130
	Geotechnical Stand by hours	EA				25	60,000	\$1,500.00	Charged back to the Contractor per Martin County Contract RFB 2020-3130
	Geotechnical stand by hours	EA				2	105,000	\$21,000.00	Charged back to the Contractor per Martin County Contract RFB 2020-3130
							6731,1071	\$28,913.38	
									Subtotal

Initial Projects **SHALL** utilize FDOT pay item numbers and descriptions.

Justification

Any difference of \$10,000 or more

Any unused quantities

Savannah Road Resurfacing											
Calfile with Holiday 2.2											
Project Engineer: Rene Fresnedra											
Contract No:											Original Time to Substantial Completion:
FIN No: 438342-1-58-01											130
Codes:											Contract Time Extended By C.O. 0
FIN No:											Present Time to Substantial Completion 130
FIN No:											Actual 0
FIN No:											Max Time from Substantial to Punchlist 30
FIN No:											Actual 0
FIN No:											Max Time from Punchlist to Final 30
Comments:											Actual 177
W=Weather											Underrun 13
H = Holiday											Maximum Contract Time to Final: 190
O=Other											Actual Time to Final: 177
CA=Conditional Acceptance											
SA=Adhesion of RPM's											
MT=Materials Procurement											
6/1/2020 Start Contract Time											
12/7/2020 Extended Contract Completion date											
Year	2020										
Month	6										
Weekday	Mon	Tue	Wed	Thu	Fri	Sat	Sun	Mon	Tue	Wed	Thu
Contract Day No:	1	2	3	4	5	6	7	8	9	10	11
Code											
Day	1	2	3	4	5	6	7	8	9	10	11
Federal Aid											
Contract Day No:	1	2	3	4	5	6	7	8	9	10	11
Code											
Comments	CD 1										
Year	2020										
Month	7										
Weekday	Wed	Thu	Fri	Sat	Sun	Mon	Tue	Wed	Thu	Fri	Sat
Contract Day No:	31	32	33	34	35	36	37	38	39	40	41
Code											
Day	1	2	3	4	5	6	7	8	9	10	11
Federal Aid											
Contract Day No:	31	32	33	34	35	36	37	38	39	40	41
Code											
Comments	CD 2										
Year	2020										
Month	8										
Weekday	Sat	Sun	Mon	Tue	Wed	Thu	Fri	Sat	Sun	Mon	Tue
Contract Day No:	62	63	64	65	66	67	68	69	70	71	72
Code											
Day	1	2	3	4	5	6	7	8	9	10	11
Federal Aid											
Contract Day No:	62	63	64	65	66	67	68	69	70	71	72
Code											
Comments	CD 3										
Year	2020										
Month	9										
Weekday	Sun	Mon	Tue	Wed	Thu	Fri	Sat	Sun	Mon	Tue	Wed
Contract Day No:	62	63	64	65	66	67	68	69	70	71	72
Code											
Day	1	2	3	4	5	6	7	8	9	10	11
Federal Aid											
Contract Day No:	62	63	64	65	66	67	68	69	70	71	72
Code											
Comments	CD 4										
Year	2020										
Month	10										
Weekday	Sun	Mon	Tue	Wed	Thu	Fri	Sat	Sun	Mon	Tue	Wed
Contract Day No:	62	63	64	65	66	67	68	69	70	71	72
Code											
Day	1	2	3	4	5	6	7	8	9	10	11
Federal Aid											
Contract Day No:	62	63	64	65	66	67	68	69	70	71	72
Code											
Comments	CD 5										
Year	2020										
Month	11										
Weekday	Sun	Mon	Tue	Wed	Thu	Fri	Sat	Sun	Mon	Tue	Wed
Contract Day No:	62	63	64	65	66	67	68	69	70	71	72
Code											
Day	1	2	3	4	5	6	7	8	9	10	11
Federal Aid											
Contract Day No:	62	63	64	65	66	67	68	69	70	71	72
Code											
Comments	CD 6										
Year	2020										
Month	12										
Weekday	Sun	Mon	Tue	Wed	Thu	Fri	Sat	Sun	Mon	Tue	Wed
Contract Day No:	62	63	64	65	66	67	68	69	70	71	72
Code											
Day	1	2	3	4	5	6	7	8	9	10	11
Federal Aid											
Contract Day No:	62	63	64	65	66	67	68	69	70	71	72
Code											
Comments	CD 7										
Year	2020										
Month	1										
Weekday	Sun	Mon	Tue	Wed	Thu	Fri	Sat	Sun	Mon	Tue	Wed
Contract Day No:	62	63	64	65	66	67	68	69	70	71	72
Code											
Day	1	2	3	4	5	6	7	8	9	10	11
Federal Aid											
Contract Day No:	62	63	64	65	66	67	68	69	70	71	72
Code											
Comments	CD 8										
Year	2020										
Month	2										
Weekday	Sun	Mon	Tue	Wed	Thu	Fri	Sat	Sun	Mon	Tue	Wed
Contract Day No:	62	63	64	65	66	67	68	69	70	71	72
Code											
Day	1	2	3	4	5	6	7	8	9	10	11
Federal Aid											
Contract Day No:	62	63	64	65	66	67	68	69	70	71	72
Code											
Comments	CD 9										
Year	2020										
Month	3										
Weekday	Sun	Mon	Tue	Wed	Thu	Fri	Sat	Sun	Mon	Tue	Wed
Contract Day No:	62	63	64	65	66	67	68	69	70	71	72
Code											
Day	1	2	3	4	5	6	7	8	9	10	11
Federal Aid											
Contract Day No:	62	63	64	65	66	67	68	69	70	71	72
Code											
Comments	CD 10										

LOCAL AGENCY NAME: MARTIN COUNTY BOCC	PROJECT DESCRIPTION: SAVANNAH ROAD RESURFACING	LOCAL AGENCY CONTRACT NO. RFB2020-3190	
		FORCE ACCOUNT: <input type="checkbox"/> YES <input checked="" type="checkbox"/> NO	DESIGN/BUILD: <input type="checkbox"/> YES <input checked="" type="checkbox"/> NO
LAP AGREEMENT NO.(S): 4383472-1-58-01 FINANCIAL PROJECT ID(S): 4383472-1-58-01 FEDERAL AID PROJECT NO.(S): D419-041-B		ORIGINAL CONSTRUCTION COST: \$ 1,046,885.65 FINAL CONSTRUCTION COST: \$ 1,079,919.27	
LAP PROJECT CLASSIFICATION: <input type="checkbox"/> A (State/National Highway System) <input type="checkbox"/> B (off-system >\$10 million) <input checked="" type="checkbox"/> C (off-system critical structures)		LETTING DATE: 12/21/2019 CONTRACT EXECUTION DATE: 3/24/2020	DBE PARTICIPATION %: 3.37%
CONTRACTOR NAME: COMMUNITY ASPHALT			
DESIGN FIRM NAME (IF DESIGN/BUILD):			
CE/FIRM NAME: MARTIN COUNTY / PUBLIC WORKS DEPARTMENT			
LOCAL AGENCY PROJECT MANAGER: RENE FRESNEDA / KIM MC LAUGHLIN		AS BUILTS RETAINED BY LOCALS: <input checked="" type="checkbox"/>	
AS BUILTS RETAINED BY FDOT: <input checked="" type="checkbox"/>			
DATE CONTRACT TIME BEGAN: 6/1/20		DATE WORK BEGAN: 6/1/20	LOCAL AGENCY FINAL ACCEPTANCE DATE: 11/24/21

	FEDERAL-AID PARTICIPATING DAYS GRANTED	FEDERAL-AID NON-PARTICIPATING DAYS GRANTED
Original Number of Days Allowed by Contract	190	N/A
Number of Contract Days Granted by Change Order	0	0
Number of Contract Days Granted by Time Extension	0	0
Number of Contract Days Granted for Weather Delays	0	0
Number of Contract Days Granted for Holidays/Special Events	0	0
Total Number of Contract Days Allowed	190	0
Total Number of Contract Days Elapsed	177	0
Total Number of Contract Days Overrun	0	0
Total Number of Contract Days Underrun	13	0

LIQUIDATED DAMAGES	ASSESSED BY LOCAL AGENCY	ASSESSED BY FDOT/FHWA
Liquidated Damages Assessed: <input type="checkbox"/> YES <input checked="" type="checkbox"/> NO		
Liquidated Damages Rate Per Day (\$): 1,665.000		
Total Number of Days Assessed: 0		
Total Dollar Amount of Liquidated Damages Assessed: 0		

Kim McLaughlin **COUNTY/CITY ENGINEER OR DESIGNEE (PRINT NAME)** **TITLE** **Public Works Grants Coordinator**

Construction Cost Analysis
FM# 499342-1-38-01
Contract No: G-1G.1

Project Description: Savannah Road Resurfacing Project

Pay Item Number*	Pay Item Description*	Contract Quantity			Final Quantity			Overrun/Underrun	Justification
		Unit	Bid Quantity	Bid Price	Bid Cost	Quantity	Construction Cost		
522-1	Copper Sidelite 4" Thick	SY'	225.000	\$56.20	\$12,758.20	201.33	10990.45	\$3,109.55	The final quantity reflects the actual amount of 4" Sidelite installed and approved for the project.
622-2	Concrete Driveway 2" Thick	SY'	325.000	\$65.00	\$21,250.00	307.55	24745.25	\$2,132.03	The final quantity reflects the actual amount of 2" driveway installed and approved for the project.
570-1-2	Baltic Sand	SF	380.000	\$2.30	\$824.00	11150			The final quantity reflects the actual amount of Baltic sand installed and approved for the project.
570-1-2	Baltic Sand	SF		\$2.00		6950	13900.00	\$16,700.00	Contractor charged bid at cost due to contractor's install mistakes. This is a bid off price.
703-3	Retro-Reflective Pavement Markers	EA	1073.000	\$8.30	\$85.40	1029	5655.80	\$1,824.80	The final quantity reflects the actual amount of Thermo Plastic Standard White, 21" Said 18" Retros installed and approved for this project.
715-11-123	Thermo Plastic Standard White, 12" Spill	LF	773.000	\$2.70	\$2,067.10	1226	4092.20	\$2,958.10	The final quantity reflects the actual amount of Thermo Plastic Standard White, 24" Spill 12" Standard installed and approved for this project.
711-11-125	Thermo Plastic Standard White, 24" Spill	LF	240.000	\$51.40	\$1,236.00	487	2359.80	\$1,065.40	The final quantity reflects the actual amount of Thermo Plastic Standard White, 24" Spill 12" Standard installed for Martin County. Excessively left off or bid more.
	Installation of new Box-Verde	EA	0.000	\$0.00	\$0.00	1	3500.00	\$1,500.00	Changed back to the Contractor per Martin County Contract #B-1020-3150
	Felled Pines 7' Talls	EA				21	25.00	625.00	Changed back to the Contractor per Martin County Contract #B-1020-3150
	Gravel/Cement Island by 1 hours	EA				20	60.00	-51,500.00	Changed back to the Contractor per Martin County Contract #B-1020-3150
	Gravel/Cement Island by 1 hours	EA				2	105.00	-5210.00	Changed back to the Contractor per Martin County Contract #B-1020-3150
							\$2,422.70	\$28,913.20	
							87343.07		
									Subtotal
									Subtotal
									Subtotal

Note: Projects SHARE utilizes FOOT pay items numbers and descriptions.

Justification:

Any difference of \$10,000 or more

Any unused quantities

Final Documentation - Final Invoice & Backup

TAB-2

IN THIS SECTION

- 8. FINAL INVOICE
- 9. FINAL RELEASE OF LIEN
- 10. CERTIFICATION OF PAYMENTS
- 11. MONTHLY MPRs
- 12. CONTRACTOR AFFIDAVIT AND SURETY CONSENT

Example

APPLICATION AND CERTIFICATE FOR PAYMENT

AIA DOCUMENT G 702

(Instructions on reverse side)

TO (OWNER):

Martin County
Board of County Commissioners
2401 SE Monterey Rd
Stuart, FL, 34996

FROM(CONTRACTOR):
Community Asphalt Corp
7795 Hooper Road
West Palm Beach FL 33411

PROJECT:

VIA (AE):

ARCHITECT'S
PROJECT NO.:

OWNER
 ARCHITECT
 CONTRACTOR

APPLICATION NO.: 7 - FINAL
PERIOD TO: 11/30/2020

CONTRACTOR'S APPLICATION FOR PAYMENT

CONTRACT FOR: Contract No: G1-G11/FM-438342-1-58-1

FM4-438342-1-58-1

58-1

6/1/2020

CONTINUATION SHEET, AIA DOCUMENT G703, IS ATTACHED.

CHANGE ORDER SUMMARY		ADDITIONS		DEDUCTIONS			
Change Orders approved in previous months by owner	TOTAL						
Approved this Month							
Number	Date Approved						
1	8/19/2020	\$4,120.25	\$28,913.37				
2	12/15/2020						
	TOTALS	\$33,033.62	\$0.00				
Net change by Change Orders		\$33,033.62					

AMOUNT CERTIFIED 5/12/21 Date: 5/12/21

6. TOTAL EARNED LESS RETAINAGE (Line 4 less Line 5 Total)

7. LESS PREVIOUS CERTIFICATES FOR PAYMENT (Line 6 from prior Certificate)

8. CURRENT PAYMENT DUE

9. BALANCE TO FINISH, PLUS RETAINAGE (Line 3 less Line 6)

10. PAYMENT (Line 8 less Line 9)

11. BOND (Line 10 less Line 10)

12. NOTARIAL SIGNATURE (Line 11 less Line 12)

13. ENGINEER'S SIGNATURE (Line 12 less Line 13)

14. DATE (Line 13 less Line 14)

15. STATE (Line 14 less Line 15)

16. CITY (Line 15 less Line 16)

17. ZIP CODE (Line 16 less Line 17)

18. COUNTY (Line 17 less Line 18)

19. STATE (Line 18 less Line 19)

20. ZIP CODE (Line 19 less Line 20)

21. CITY (Line 20 less Line 21)

22. COUNTY (Line 21 less Line 22)

23. STATE (Line 22 less Line 23)

24. ZIP CODE (Line 23 less Line 24)

25. CITY (Line 24 less Line 25)

26. COUNTY (Line 25 less Line 26)

27. STATE (Line 26 less Line 27)

28. ZIP CODE (Line 27 less Line 28)

29. CITY (Line 28 less Line 29)

30. COUNTY (Line 29 less Line 30)

31. STATE (Line 30 less Line 31)

32. ZIP CODE (Line 31 less Line 32)

33. CITY (Line 32 less Line 33)

34. COUNTY (Line 33 less Line 34)

35. STATE (Line 34 less Line 35)

36. ZIP CODE (Line 35 less Line 36)

37. CITY (Line 36 less Line 37)

38. COUNTY (Line 37 less Line 38)

39. STATE (Line 38 less Line 39)

40. ZIP CODE (Line 39 less Line 40)

41. CITY (Line 40 less Line 41)

42. COUNTY (Line 41 less Line 42)

43. STATE (Line 42 less Line 43)

44. ZIP CODE (Line 43 less Line 44)

45. CITY (Line 44 less Line 45)

46. COUNTY (Line 45 less Line 46)

47. STATE (Line 46 less Line 47)

48. ZIP CODE (Line 47 less Line 48)

49. CITY (Line 48 less Line 49)

50. COUNTY (Line 49 less Line 50)

51. STATE (Line 50 less Line 51)

52. ZIP CODE (Line 51 less Line 52)

53. CITY (Line 52 less Line 53)

54. COUNTY (Line 53 less Line 54)

55. STATE (Line 54 less Line 55)

56. ZIP CODE (Line 55 less Line 56)

57. CITY (Line 56 less Line 57)

58. COUNTY (Line 57 less Line 58)

59. STATE (Line 58 less Line 59)

60. ZIP CODE (Line 59 less Line 60)

61. CITY (Line 60 less Line 61)

62. COUNTY (Line 61 less Line 62)

63. STATE (Line 62 less Line 63)

64. ZIP CODE (Line 63 less Line 64)

65. CITY (Line 64 less Line 65)

66. COUNTY (Line 65 less Line 66)

67. STATE (Line 66 less Line 67)

68. ZIP CODE (Line 67 less Line 68)

69. CITY (Line 68 less Line 69)

70. COUNTY (Line 69 less Line 70)

71. STATE (Line 70 less Line 71)

72. ZIP CODE (Line 71 less Line 72)

73. CITY (Line 72 less Line 73)

74. COUNTY (Line 73 less Line 74)

75. STATE (Line 74 less Line 75)

76. ZIP CODE (Line 75 less Line 76)

77. CITY (Line 76 less Line 77)

78. COUNTY (Line 77 less Line 78)

79. STATE (Line 78 less Line 79)

80. ZIP CODE (Line 79 less Line 80)

81. CITY (Line 80 less Line 81)

82. COUNTY (Line 81 less Line 82)

83. STATE (Line 82 less Line 83)

84. ZIP CODE (Line 83 less Line 84)

85. CITY (Line 84 less Line 85)

86. COUNTY (Line 85 less Line 86)

87. STATE (Line 86 less Line 87)

88. ZIP CODE (Line 87 less Line 88)

89. CITY (Line 88 less Line 89)

90. COUNTY (Line 89 less Line 90)

91. STATE (Line 90 less Line 91)

92. ZIP CODE (Line 91 less Line 92)

93. CITY (Line 92 less Line 93)

94. COUNTY (Line 93 less Line 94)

95. STATE (Line 94 less Line 95)

96. ZIP CODE (Line 95 less Line 96)

97. CITY (Line 96 less Line 97)

98. COUNTY (Line 97 less Line 98)

99. STATE (Line 98 less Line 99)

100. ZIP CODE (Line 99 less Line 100)

101. CITY (Line 100 less Line 101)

102. COUNTY (Line 101 less Line 102)

103. STATE (Line 102 less Line 103)

104. ZIP CODE (Line 103 less Line 104)

105. CITY (Line 104 less Line 105)

106. COUNTY (Line 105 less Line 106)

107. STATE (Line 106 less Line 107)

108. ZIP CODE (Line 107 less Line 108)

109. CITY (Line 108 less Line 109)

110. COUNTY (Line 109 less Line 110)

111. STATE (Line 110 less Line 111)

112. ZIP CODE (Line 111 less Line 112)

113. CITY (Line 112 less Line 113)

114. COUNTY (Line 113 less Line 114)

115. STATE (Line 114 less Line 115)

116. ZIP CODE (Line 115 less Line 116)

117. CITY (Line 116 less Line 117)

118. COUNTY (Line 117 less Line 118)

119. STATE (Line 118 less Line 119)

120. ZIP CODE (Line 119 less Line 120)

121. CITY (Line 120 less Line 121)

122. COUNTY (Line 121 less Line 122)

123. STATE (Line 122 less Line 123)

124. ZIP CODE (Line 123 less Line 124)

125. CITY (Line 124 less Line 125)

126. COUNTY (Line 125 less Line 126)

127. STATE (Line 126 less Line 127)

128. ZIP CODE (Line 127 less Line 128)

129. CITY (Line 128 less Line 129)

130. COUNTY (Line 129 less Line 130)

131. STATE (Line 130 less Line 131)

132. ZIP CODE (Line 131 less Line 132)

133. CITY (Line 132 less Line 133)

134. COUNTY (Line 133 less Line 134)

135. STATE (Line 134 less Line 135)

136. ZIP CODE (Line 135 less Line 136)

137. CITY (Line 136 less Line 137)

138. COUNTY (Line 137 less Line 138)

139. STATE (Line 138 less Line 139)

140. ZIP CODE (Line 139 less Line 140)

141. CITY (Line 140 less Line 141)

142. COUNTY (Line 141 less Line 142)

143. STATE (Line 142 less Line 143)

144. ZIP CODE (Line 143 less Line 144)

145. CITY (Line 144 less Line 145)

146. COUNTY (Line 145 less Line 146)

147. STATE (Line 146 less Line 147)

148. ZIP CODE (Line 147 less Line 148)

149. CITY (Line 148 less Line 149)

150. COUNTY (Line 149 less Line 150)

151. STATE (Line 150 less Line 151)

152. ZIP CODE (Line 151 less Line 152)

153. CITY (Line 152 less Line 153)

154. COUNTY (Line 153 less Line 154)

155. STATE (Line 154 less Line 155)

156. ZIP CODE (Line 155 less Line 156)

157. CITY (Line 156 less Line 157)

158. COUNTY (Line 157 less Line 158)

159. STATE (Line 158 less Line 159)

160. ZIP CODE (Line 159 less Line 160)

161. CITY (Line 160 less Line 161)

162. COUNTY (Line 161 less Line 162)

163. STATE (Line 162 less Line 163)

164. ZIP CODE (Line 163 less Line 164)

165. CITY (Line 164 less Line 165)

166. COUNTY (Line 165 less Line 166)

167. STATE (Line 166 less Line 167)

168. ZIP CODE (Line 167 less Line 168)

169. CITY (Line 168 less Line 169)

170. COUNTY (Line 169 less Line 170)

171. STATE (Line 170 less Line 171)

172. ZIP CODE (Line 171 less Line 172)

173. CITY (Line 172 less Line 173)

174. COUNTY (Line 173 less Line 174)

175. STATE (Line 174 less Line 175)

176. ZIP CODE (Line 175 less Line 176)

177. CITY (Line 176 less Line 177)

178. COUNTY (Line 177 less Line 178)

179. STATE (Line 178 less Line 179)

180. ZIP CODE (Line 179 less Line 180)

181. CITY (Line 180 less Line 181)

182. COUNTY (Line 181 less Line 182)

183. STATE (Line 182 less Line 183)

184. ZIP CODE (Line 183 less Line 184)

185. CITY (Line 184 less Line 185)

186. COUNTY (Line 185 less Line 186)

187. STATE (Line 186 less Line 187)

188. ZIP CODE (Line 187 less Line 188)

189. CITY (Line 188 less Line 189)

190. COUNTY (Line 189 less Line 190)

191. STATE (Line 190 less Line 191)

192. ZIP CODE (Line 191 less Line 192)

193. CITY (Line 192 less Line 193)

194. COUNTY (Line 193 less Line 194)

195. STATE (Line 194 less Line 195)

196. ZIP CODE (Line 195 less Line 196)

197. CITY (Line 196 less Line 197)

198. COUNTY (Line 197 less Line 198)

199. STATE (Line 198 less Line 199)

200. ZIP CODE (Line 199 less Line 200)

201. CITY (Line 200 less Line 201)

202. COUNTY (Line 201 less Line 202)

203. STATE (Line 202 less Line 203)

204. ZIP CODE (Line 203 less Line 204)

205. CITY (Line 204 less Line 205)

206. COUNTY (Line 205 less Line 206)

207. STATE (Line 206 less Line 207)

208. ZIP CODE (Line 207 less Line 208)

209. CITY (Line 208 less Line 209)

210. COUNTY (Line 209 less Line 210)

211. STATE (Line 210 less Line 211)

212. ZIP CODE (Line 211 less Line 212)

213. CITY (Line 212 less Line 213)

214. COUNTY (Line 213 less Line 214)

215. STATE (Line 214 less Line 215)

FINAL RELEASE OF LIEN

The undersigned is an officer and/or agent of **FLORIDA DIRT GROUP, INC.** ("Company"), authorized to execute this Final Release, in consideration and upon payment of the sum of \$0.00, which represents the final payment due the Company for labor, equipment, services and/or materials furnished to a project known as **SAVANNAH ROAD RESURFACING & BIKE LANES 438342-1-58-01** ("Project") of which **MARTIN COUNTY BOARD OF COUNTY COMMISSIONERS** ("Owner") is owner, and hereby:

(1) On behalf of itself and its officers, directors, servants, agents, subcontractors and anyone claiming by, through and under them, releases, acquires, discharges and waives any and all claims, liens, claim of liens, bond rights, suits, accounts, debts, demands, torts, charges or causes of action against Owner, Community Asphalt Corp., its surety and their successors, assigns, directors, officers, agents, employees, and parents and subsidiary companies, which now exist, have existed in the past or will exist in the future (the "Released Parties"), arising out of work, services, labor, materials or equipment for, by or on behalf of the undersigned, or arising out of any occurrence involving the subcontract and/or purchase order for the Project;

(2) Warrants and represents that all work performed and materials furnished under its subcontract have been paid for in full, and that the Company has paid all applicable federal, state and local sales, use, excise, payroll and similar taxes, duties, licenses and royalties, if any, applicable to the labor, services, materials, equipment and supplies furnished by or for the Company and that there are no outstanding claims or rights to claim against the Company, the Released Parties, or any bond posted in connection with the Project;

(3) Warrants and represents that Community Asphalt Corp. and/or Owner has good title to all materials, equipment and supplies furnished, and that there are no liens, encumbrances or security interest against such materials, equipment and supplies; and

(4) Acknowledges that this release is given with full knowledge, intention and understanding that it will be relied upon by Community Asphalt Corp. in disbursing money to the Company pursuant to its subcontract and/or purchase order with Community Asphalt Corp. The undersigned Company and individual agree to defend, indemnify and hold harmless the Released Parties from and against any and all losses, damages, costs, or expenses (including attorneys' fees) they suffer as a result of any false or inaccurate information contained herein.

IN WITNESS WHEREOF, I have hereunto set my hand and seal this 18 day of March 2021

Signature:
Company:
Name/Title:

Ryan Miller
FLORIDA DIRT GROUP, INC.
Ryan Miller - President

STATE OF Florida
COUNTY OF Brevard


BEFORE ME, the undersigned authority, personally appeared Ryan Miller, [] or who produced [] known to me to be the individual who executed its contents, [] or who produced [] as identification, who did take an oath and freely executed this Partial Release for the sole consideration expressed therein.

SWORN TO AND SUBSCRIBED before me this 18th day of March 2021

NOTARY PUBLIC

My commission expires 12/25/2024

Notary Name typed/stamped/printed

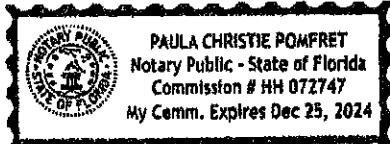

FINAL RELEASE OF LIEN

The undersigned is an officer and/or agent of MCSHEA CONTRACTING. ("Company"), authorized to execute this Final Release, in consideration and upon payment of the sum of \$4109.87, which represents the final payment due the Company for labor, equipment, services and/or materials furnished to a project known as SAVANNAH ROAD RESURFACING & BIKE LANES 438342-1-58-01("Project") of which MARTIN COUNTY BOARD OF COUNTY COMMISSIONERS ("Owner") is owner, and hereby:

(1) On behalf of itself and its officers, directors, servants, agents, subcontractors and anyone claiming by, through and under them, releases, acquits, discharges and waives any and all claims, liens, claim of liens, bond rights, suits, accounts, debts, demands, torts, charges or causes of action against Owner, Community Asphalt Corp., its surety and their successors, assigns, directors, officers, agents, employees, and parents and subsidiary companies, which now exist, have existed in the past or will exist in the future (the "Released Parties"), arising out of work, services, labor, materials or equipment for, by or on behalf of the undersigned, or arising out of any occurrence involving the subcontract and/or purchase order for the Project;

(2) Warrants and represents that all work performed and materials furnished under its subcontract have been paid for in full, and that the Company has paid all applicable federal, state and local sales, use, excise, payroll and similar taxes, duties, licenses and royalties, if any, applicable to the labor, services, materials, equipment and supplies furnished by or for the Company and that there are no outstanding claims or rights to claim against the Company, the Released Parties, or any bond posted in connection with the Project;

(3) Warrants and represents that Community Asphalt Corp. and/or Owner has good title to all materials, equipment and supplies furnished, and that there are no liens, encumbrances or security interest against such materials, equipment and supplies; and

(4) Acknowledges that this release is given with full knowledge, intention and understanding that it will be relied upon by Community Asphalt Corp. in disbursing money to the Company pursuant to its subcontract and/or purchase order with Community Asphalt Corp. The undersigned Company and individual agree to defend, indemnify and hold harmless the Released Parties from and against any and all losses, damages, costs, or expenses (including attorneys' fees) they suffer as a result of any false or inaccurate information contained herein.

IN WITNESS WHEREOF, I have hereunto set my hand and seal this 17th day of March, 2021.

Signature:

Company:

Name/Title:


McShea Contracting
Daniel S. McWilliams, President

STATE OF FL
COUNTY OF Lee

BEFORE ME, the undersigned authority, personally appeared Daniel S. McWilliams, [
X] known to me to be the individual who executed its contents, [] or who produced _____ as identification, who did take an oath and freely executed this Partial Release for the sole consideration expressed therein.

SWORN TO AND SUBSCRIBED before me this 17th day of March, 2021.


NOTARY PUBLIC
My commission expires



Notary Name typed/stamped/printed

FINAL RELEASE OF LIEN

The undersigned is an officer and/or agent of NATURE'S KEEPER, INC., ("Company"), authorized to execute this Final Release, in consideration and upon payment of the sum of \$ 1362.82, which represents the final payment due the Company for labor, equipment, services and/or materials furnished to a project known as SAVANNAH ROAD RESURFACING & BIKE LANES 438342-1-58-01("Project") of which MARTIN COUNTY BOARD OF COUNTY COMMISSIONERS ("Owner") is owner, and hereby:

(1) On behalf of itself and its officers, directors, servants, agents, subcontractors and anyone claiming by, through and under them, releases, acquires, discharges and waives any and all claims, liens, claim of liens, bond rights, suits, accounts, debts, demands, torts, charges or causes of action against Owner, Community Asphalt Corp., its surety and their successors, assigns, directors, officers, agents, employees, and parents and subsidiary companies, which now exist, have existed in the past or will exist in the future (the "Released Parties"), arising out of work, services, labor, materials or equipment for, by or on behalf of the undersigned, or arising out of any occurrence involving the subcontract and/or purchase order for the Project;

(2) Warrants and represents that all work performed and materials furnished under its subcontract have been paid for in full, and that the Company has paid all applicable federal, state and local sales, use, excise, payroll and similar taxes, duties, licenses and royalties, if any, applicable to the labor, services, materials, equipment and supplies furnished by or for the Company and that there are no outstanding claims or rights to claim against the Company, the Released Parties, or any bond posted in connection with the Project;

(3) Warrants and represents that Community Asphalt Corp. and/or Owner has good title to all materials, equipment and supplies furnished, and that there are no liens, encumbrances or security interest against such materials, equipment and supplies; and

(4) Acknowledges that this release is given with full knowledge, intention and understanding that it will be relied upon by Community Asphalt Corp. in disbursing money to the Company pursuant to its subcontract and/or purchase order with Community Asphalt Corp. The undersigned Company and individual agree to defend, indemnify and hold harmless the Released Parties from and against any and all losses, damages, costs, or expenses (including attorneys' fees) they suffer as a result of any false or inaccurate information contained herein.

IN WITNESS WHEREOF, I have hereunto set my hand and seal this 21 day of April, 20 21.

Signature:

Company:

Name/Title:


Nature's Keeper Inc

Krysten Bieger President

STATE OF Florida
COUNTY OF St. Lucie


BEFORE ME, the undersigned authority, personally appeared Krysten Bieger, [REDACTED]
known to me to be the individual who executed its contents, [REDACTED] or who produced
[REDACTED] as identification, who did take an oath and freely executed this Partial
Release for the sole consideration expressed therein.

SWORN TO AND SUBSCRIBED before me this 21 day of April, 2021.

Courtney L. Brown
NOTARY PUBLIC
My commission expires March 19, 2025

Courtney L. Brown

Notary Name typed/stamped/printed

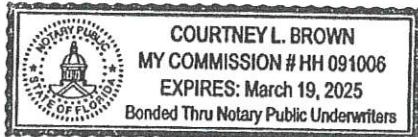

PARTIAL RELEASE OF LIEN

The undersigned is an officer and/or agent of NATURE'S KEEPER, INC.. (Company), authorized to execute this Partial Release, in consideration and upon payment of the sum of \$3367.27, which represents the full value of labor, equipment, services and/or materials furnished by the Company through the 21th day of April 2021 to a project known SAVANNAH ROAD RESURF, BIKE LANE (7257) is the owner (Owner), and hereby:

(1) Warrants and represents that all labor and work performed and materials and equipment furnished under its subcontract and/or purchase order for the Project have been paid for in full, and that it has paid all applicable federal, state and local sales, use, excise, payroll and similar taxes, duties, licenses and royalties, if any, applicable to the labor, services, materials, equipment and supplies furnished to or for the Project from the beginning of the work through the date of this Partial Release, except as follows (none unless noted):

(2) Releases and discharges any and all claims, liens, bond rights, suits, accounts, debts, demands, torts, charges, and causes of actions for labor, material, equipment or services furnished through the date set forth above to the Project or pursuant to its subcontract and/or purchase order, or otherwise arising against Owner, Community Asphalt Corp., its surety and their successors, assigns, directors, officers agents, employees, and parents and subsidiary companies, which now exist, have existed in the past or will exist in the future (the "Released Parties"), except as follows (none unless noted):

(3) Acknowledges that this release is given with full knowledge and understanding that it will be relied upon by Community Asphalt Corp. in disbursing money to the Company pursuant to its subcontract and/or purchase order with Community Asphalt Corp. The undersigned Company and individual agree to defend, indemnify and hold the Released Parties harmless from and against any and all losses, damages, costs, or expenses (including attorneys' fees) they suffer as a result of any false or inaccurate information contained herein. This waiver and release does not cover any retention or any labor, equipment, services and/or materials furnished after the date set forth above.

IN WITNESS WHEREOF, I have hereunto set my hand and seal this 21 day of April, 2021.

Signature: 

Company: NATURE'S KEEPER, INC.


Name/Title: Krysten Bieger President

STATE OF Florida
COUNTY OF St. Lucie
BEFORE ME, the undersigned authority, personally appeared Krysten Bieger known to me to be the individual who executed its contents, or who produced as identification, who did take an oath and freely executed this Partial Release for the sole consideration expressed therein.

SWORN TO AND SUBSCRIBED before me this 21 day of April, 2021.


NOTARY PUBLIC
My commission expires:

March 19, 2025

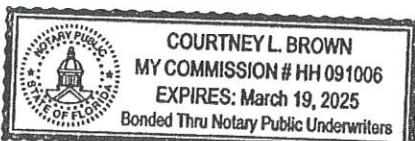

Courtney L. Brown
Notary Name typed/stamped/printed

PARTIAL RELEASE OF LIEN

The undersigned is an officer and/or agent of WM D. ADEIMY JR.. (Company), authorized to execute this Partial Release, in consideration and upon payment of the sum of \$4296.36, which represents the full value of labor, equipment, services and/or materials furnished by the Company through the 27th day of April 2021 to a project known SAVANNAH ROAD RESURF, BIKE LANE (7257) is the owner (Owner), and hereby:

(1) Warrants and represents that all labor and work performed and materials and equipment furnished under its subcontract and/or purchase order for the Project have been paid for in full, and that it has paid all applicable federal, state and local sales, use, excise, payroll and similar taxes, duties, licenses and royalties, if any, applicable to the labor, services, materials, equipment and supplies furnished to or for the Project from the beginning of the work through the date of this Partial Release, except as follows (none unless noted):

(2) Releases and discharges any and all claims, liens, bond rights, suits, accounts, debts, demands, torts, charges, and causes of actions for labor, material, equipment or services furnished through the date set forth above to the Project or pursuant to its subcontract and/or purchase order, or otherwise arising against Owner, Community Asphalt Corp., its surety and their successors, assigns, directors, officers agents, employees, and parents and subsidiary companies, which now exist, have existed in the past or will exist in the future (the "Released Parties"), except as follows (none unless noted):

(3) Acknowledges that this release is given with full knowledge and understanding that it will be relied upon by Community Asphalt Corp. in disbursing money to the Company pursuant to its subcontract and/or purchase order with Community Asphalt Corp. The undersigned Company and individual agree to defend, indemnify and hold the Released Parties harmless from and against any and all losses, damages, costs, or expenses (including attorneys' fees) they suffer as a result of any false or inaccurate information contained herein. This waiver and release does not cover any retention or any labor, equipment, services and/or materials furnished after the date set forth above.

IN WITNESS WHEREOF, I have hereunto set my hand and seal this 28th day of April, 2021.

Signature: Wm D Adeimy Jr

Company: WM D. ADEIMY JR.


Name/Title: Wm. D. Adeimy Jr - President

STATE OF Florida
COUNTY OF Palm Beach

BEFORE ME, the undersigned authority, personally appeared Wm. D. Adeimy Jr, [I know to me to be the individual who executed its contents, [] or who produced _____ as identification, who did take an oath and freely executed this Partial Release for the sole consideration expressed therein.

SWORN TO AND SUBSCRIBED before me this 28th day of April, 2021.

Andrea Barone
NOTARY PUBLIC
My commission expires:

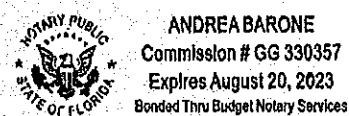

Notary Name typed/stamped/printed

FINAL RELEASE OF LIEN

The undersigned is an officer and/or agent of **LP VIDEO PRODUCTS, INC.** ("Company"), authorized to execute this Final Release, in consideration and upon payment of the sum of **\$0.00**, which represents the final payment due the Company for labor, equipment, services and/or materials furnished to a project known as **SAVANNAH ROAD RESURFACING & BIKE LANES 438342-1-58-01** ("Project") of which **MARTIN COUNTY BOARD OF COUNTY COMMISSIONERS** ("Owner") is owner, and hereby:

- (1) On behalf of itself and its officers, directors, servants, agents, subcontractors and anyone claiming by, through and under them, releases, acquires, discharges and waives any and all claims, liens, claim of liens, bond rights, suits, accounts, debts, demands, torts, charges or causes of action against Owner, Community Asphalt Corp., its surety and their successors, assigns, directors, officers, agents, employees, and parents and subsidiary companies, which now exist, have existed in the past or will exist in the future (the "Released Parties"), arising out of work, services, labor, materials or equipment for, by or on behalf of the undersigned, or arising out of any occurrence involving the subcontract and/or purchase order for the Project;
- (2) Warrants and represents that all work performed and materials furnished under its subcontract have been paid for in full, and that the Company has paid all applicable federal, state and local sales, use, excise, payroll and similar taxes, duties, licenses and royalties, if any, applicable to the labor, services, materials, equipment and supplies furnished by or for the Company and that there are no outstanding claims or rights to claim against the Company, the Released Parties, or any bond posted in connection with the Project;
- (3) Warrants and represents that Community Asphalt Corp. and/or Owner has good title to all materials, equipment and supplies furnished, and that there are no liens, encumbrances or security interest against such materials, equipment and supplies; and
- (4) Acknowledges that this release is given with full knowledge, intention and understanding that it will be relied upon by Community Asphalt Corp. in disbursing money to the Company pursuant to its subcontract and/or purchase order with Community Asphalt Corp. The undersigned Company and individual agree to defend, indemnify and hold harmless the Released Parties from and against any and all losses, damages, costs, or expenses (including attorneys' fees) they suffer as a result of any false or inaccurate information contained herein.

IN WITNESS WHEREOF, I have hereunto set my hand and seal this 18 day of March, 2021.


Signature: Ron Stimpson
Company: LP VIDEO
Name/Title: Ron Stimpson, ~P

STATE OF FLORIDA
COUNTY OF ORLANDO

BEFORE ME, the undersigned authority, personally appeared Ron Stimpson, [REDACTED]
I know [REDACTED] to me to be the individual who executed its contents, [REDACTED] or who produced
[REDACTED] as identification, who did take an oath and freely executed this Partial
Release for the sole consideration expressed therein.

SWORN TO AND SUBSCRIBED before me this 18 day of March, 2021.


NOTARY PUBLIC
My commission expires

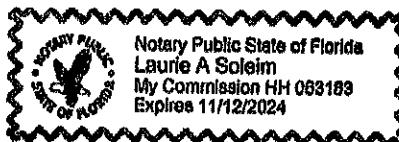

Notary Name typed/stamped/printed

FINAL RELEASE OF LIEN

The undersigned is an officer and/or agent of PIPELINE UTILITIES INC. ("Company"), authorized to execute this Final Release, in consideration and upon payment of the sum of \$0.00, which represents the final payment due the Company for labor, equipment, services and/or materials furnished to a project known as SAVANNAH ROAD RESURFACING & BIKE LANES 438342-1-58-01("Project") of which MARTIN COUNTY BOARD OF COUNTY COMMISSIONERS ("Owner") is owner, and hereby:

(1) On behalf of itself and its officers, directors, servants, agents, subcontractors and anyone claiming by, through and under them, releases, acquires, discharges and waives any and all claims, liens, claim of liens, bond rights, suits, accounts, debts, demands, torts, charges or causes of action against Owner, Community Asphalt Corp., its surety and their successors, assigns, directors, officers, agents, employees, and parents and subsidiary companies, which now exist, have existed in the past or will exist in the future (the "Released Parties"), arising out of work, services, labor, materials or equipment for, by or on behalf of the undersigned, or arising out of any occurrence involving the subcontract and/or purchase order for the Project;

(2) Warrants and represents that all work performed and materials furnished under its subcontract have been paid for in full, and that the Company has paid all applicable federal, state and local sales, use, excise, payroll and similar taxes, duties, licenses and royalties, if any, applicable to the labor, services, materials, equipment and supplies furnished by or for the Company and that there are no outstanding claims or rights to claim against the Company, the Released Parties, or any bond posted in connection with the Project;

(3) Warrants and represents that Community Asphalt Corp. and/or Owner has good title to all materials, equipment and supplies furnished, and that there are no liens, encumbrances or security interest against such materials, equipment and supplies; and

(4) Acknowledges that this release is given with full knowledge, intention and understanding that it will be relied upon by Community Asphalt Corp. in disbursing money to the Company pursuant to its subcontract and/or purchase order with Community Asphalt Corp. The undersigned Company and individual agree to defend, indemnify and hold harmless the Released Parties from and against any and all losses, damages, costs, or expenses (including attorneys' fees) they suffer as a result of any false or inaccurate information contained herein.

IN WITNESS WHEREOF, I have hereunto set my hand and seal this 17 day of March, 20 21.

Signature:

Company:

Name/Title:


C. Brooks
Pipeline Utilities Inc.
Barry DeRote - Vice President

STATE OF Florida
COUNTY OF Palm Beach

BEFORE ME, the undersigned authority, personally appeared Barry DeRote, [
] known to me to be the individual who executed its contents, [] or who produced _____ as identification, who did take an oath and freely executed this Partial Release for the sole consideration expressed therein.

SWORN TO AND SUBSCRIBED before me this 17th day of MARCH, 2021.

Mary Brooks
NOTARY PUBLIC
My commission expires 4/16/23

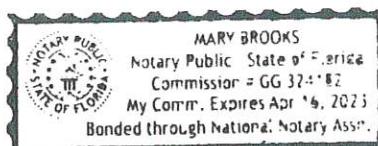

Notary Name typed/stamped/printed

FINAL RELEASE OF LIEN

The undersigned is an officer and/or agent of **ARRIVE ALIVE TRAFFIC CONTROL** ("Company"), authorized to execute this Final Release, in consideration and upon payment of the sum of \$429.78, which represents the final payment due the Company for labor, equipment, services and/or materials furnished to a project known as **SAVANNAH ROAD RESURFACING & BIKE LANES 438342-1-58-01**("Project") of which **MARTIN COUNTY BOARD OF COUNTY COMMISSIONERS** ("Owner") is owner, and hereby:

(1) On behalf of itself and its officers, directors, servants, agents, subcontractors and anyone claiming by, through and under them, releases, acquires, discharges and waives any and all claims, liens, claim of liens, bond rights, suits, accounts, debts, demands, torts, charges or causes of action against Owner, Community Asphalt Corp., its surety and their successors, assigns, directors, officers, agents, employees, and parents and subsidiary companies, which now exist, have existed in the past or will exist in the future (the "Released Parties"), arising out of work, services, labor, materials or equipment for, by or on behalf of the undersigned, or arising out of any occurrence involving the subcontract and/or purchase order for the Project;

(2) Warrants and represents that all work performed and materials furnished under its subcontract have been paid for in full, and that the Company has paid all applicable federal, state and local sales, use, excise, payroll and similar taxes, duties, licenses and royalties, if any, applicable to the labor, services, materials, equipment and supplies furnished by or for the Company and that there are no outstanding claims or rights to claim against the Company, the Released Parties, or any bond posted in connection with the Project;

(3) Warrants and represents that Community Asphalt Corp. and/or Owner has good title to all materials, equipment and supplies furnished, and that there are no liens, encumbrances or security interest against such materials, equipment and supplies; and

(4) Acknowledges that this release is given with full knowledge, intention and understanding that it will be relied upon by Community Asphalt Corp. in disbursing money to the Company pursuant to its subcontract and/or purchase order with Community Asphalt Corp. The undersigned Company and individual agree to defend, indemnify and hold harmless the Released Parties from and against any and all losses, damages, costs, or expenses (including attorneys' fees) they suffer as a result of any false or inaccurate information contained herein.

IN WITNESS WHEREOF, I have hereunto set my hand and seal this 24 day of April, 2021.

Signature:
Company:
Name/Title:

*Arrive Alive Traffic Control
David Feise, President*


STATE OF Florida
COUNTY OF Orange

BEFORE ME, the undersigned authority, personally appeared David Feise, President, [] known to me to be the individual who executed its contents, [] or who produced _____ as identification, who did take an oath and freely executed this Partial Release for the sole consideration expressed therein.

SWORN TO AND SUBSCRIBED before me this 24 day of April, 2021.

[Signature]
NOTARY PUBLIC

My commission expires 8/28/23

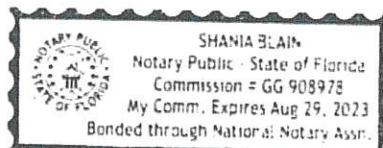

Notary Name typed/stamped/printed

FINAL RELEASE OF LIEN

The undersigned is an officer and/or agent of **WIRETEK SOLUTIONS, LLC.** ("Company"), authorized to execute this Final Release, in consideration and upon payment of the sum of \$275, which represents the final payment due the Company for labor, equipment, services and/or materials furnished to a project known as **SAVANNAH ROAD RESURFACING & BIKE LANES 438342-1-58-01** ("Project") of which **MARTIN COUNTY BOARD OF COUNTY COMMISSIONERS** ("Owner") is owner, and hereby:

(1) On behalf of itself and its officers, directors, servants, agents, subcontractors and anyone claiming by, through and under them, releases, acquires, discharges and waives any and all claims, liens, claim of liens, bond rights, suits, accounts, debts, demands, torts, charges or causes of action against Owner, Community Asphalt Corp., its surety and their successors, assigns, directors, officers, agents, employees, and parents and subsidiary companies, which now exist, have existed in the past or will exist in the future (the "Released Parties"), arising out of work, services, labor, materials or equipment for, by or on behalf of the undersigned, or arising out of any occurrence involving the subcontract and/or purchase order for the Project;

(2) Warrants and represents that all work performed and materials furnished under its subcontract have been paid for in full, and that the Company has paid all applicable federal, state and local sales, use, excise, payroll and similar taxes, duties, licenses and royalties, if any, applicable to the labor, services, materials, equipment and supplies furnished by or for the Company and that there are no outstanding claims or rights to claim against the Company, the Released Parties, or any bond posted in connection with the Project;

(3) Warrants and represents that Community Asphalt Corp. and/or Owner has good title to all materials, equipment and supplies furnished, and that there are no liens, encumbrances or security interest against such materials, equipment and supplies; and

(4) Acknowledges that this release is given with full knowledge, intention and understanding that it will be relied upon by Community Asphalt Corp. in disbursing money to the Company pursuant to its subcontract and/or purchase order with Community Asphalt Corp. The undersigned Company and individual agree to defend, indemnify and hold harmless the Released Parties from and against any and all losses, damages, costs, or expenses (including attorneys' fees) they suffer as a result of any false or inaccurate information contained herein.

IN WITNESS WHEREOF, I have hereunto set my hand and seal this _____ day of _____, 20____.

Signature:
Company:
Name/Title:

MAXINE HALL
Wiretek Solutions, LLC
Maxine Hall, President

STATE OF _____
COUNTY OF _____

BEFORE ME, the undersigned authority, personally appeared _____, I
know to me to be the individual who executed its contents, [] or who produced
as identification, who did take an oath and freely executed this Partial
Release for the sole consideration expressed therein.

SWORN TO AND SUBSCRIBED before me this _____ day of _____.

NOTARY PUBLIC
My commission expires _____

Notary Name typed/stamped/printed

CERTIFICATION**DISBURSEMENT OF PREVIOUS PERIODIC PAYMENT TO SUBCONTRACTORS**

(As required by Florida Transportation Code, Section 337.11, Subsection (11), F.S.)

DATE 3/18/2021

FIN PROJ. I.D.	438342-1-58-01 Savannah Road
	Resurfacing & Bike Lanes
	Martin County Board Of Commisi
	Martin County

CONTRACT NO. RFB2020-3190 (G1-G11)

TO RELEASE MONTHLY PAYMENT FOR FINAL

Community Asphalt Corp.

, prime contractor

for the above referenced contract, hereby certifies that all subcontractors, except for those noted below, having interest in this contract have received their pro rata share of all previous periodic payments made to date by the Department for all work, materials and equipment furnished under the contract. The term "subcontractor", as used herein, shall also include persons or firms furnishing materials, services or equipment incorporated into the work or stockpiled in the vicinity of the project for which partial payment has been made by the Department and work done under equipment-rental agreements.

EXCEPTION:

The following subcontractors have not been paid and a copy of the notification sent to each, explaining the good cause why payment has not been made, is attached to this form:

Subcontractor name

Subcontractor name

Street Address

Street Address

City State Zip

City State Zip

State of Florida

County of _____
Sworn to and subscribed before me this _____ day

of _____, _____, by _____

(Print name of person signing Certification)

A false statement or omission made in connection with this certification is sufficient cause for suspension, revocation, or denial of qualification to bid, and a determination of non-responsibility, and may subject the person and/or entity making the false statement to any and all civil and criminal penalties available pursuant to applicable Federal and State Law.

Notary Public , not required when digital

John Hickey

Florida Department of Transportation
Division of Construction
Contractor Identification Number: 00000000000000000000000000000000

Commission Expires

Contractor

Personally Known OR Produced Identification

Community Asphalt Corp.

Type of Identification Produced _____

By

Donald Hickey, Executive Vice President

Instructions:

1. Attach copy of the notification good cause sent to each applicable subcontractor.
2. List the subcontractors which have not been paid the proportionate share of payments received by the contractor and the date listed as exception.
3. A separate certification is required for each contract.
4. To be signed by an officer or director of the Contractor with the authority to bind the Contractor and notarized.
5. To avoid delay in payment, certification must be submitted to the Project Engineer no later than the Friday before the monthly estimate cutoff date (generally the 3rd Sunday of the month).

STATE OF FLORIDA DEPARTMENT OF TRANSPORTATION
CONSTRUCTION COMPLIANCE WITH
SPECIFICATIONS AND PLANS

760-020-02
CONSTRUCTION
12/16
Page 1 of 2

FIN PROJECT I.D.(s)

FM-438342-1-58-01	

DATE: 11/30/2020

CONTRACT NO: G1-G11

Monthly:

Final:

OHL NORTH AMERICA

, Prime Contractor for the above referenced contract, hereby verifies based on personal knowledge or reasonable investigation and good faith belief, all Quality Control functions and Quality Control sampling and testing results are in substantial compliance with the contract specification requirements and the approved Quality Control Plan for this project. This includes the input of test results into the Department's MAC database within 24 hours of results being received. This represents work done between 11/01/2020 and 11/30/2020. Exceptions to these requirements are listed below.

1.) Item No.: _____
Exception:

2.) Item No.: _____
Exception:

3.) Item No.: _____
Exception:

4.) Item No.: _____
Exception:

STATE OF FLORIDA DEPARTMENT OF TRANSPORTATION
**CONSTRUCTION COMPLIANCE WITH
SPECIFICATIONS AND PLANS**

700-020-02
CONSTRUCTION
12/16
Page 2 of 2

5.) Item No.: _____
Exception:

6.) Item No.: _____
Exception:

A false statement or omission made in connection with this certification is sufficient cause for suspension, revocation, or denial of qualification to bid, and a determination of non-responsibility, and may subject the person and/or entity making the false statement to any and all civil and criminal penalties available pursuant to applicable Federal and State Law.

State of Florida
County of _____

Sworn to (or affirmed) and subscribed before me, by means of
 physical presence or online notarization, this _____ day
of _____, _____ (year),
by _____

Notary Public (Not Required when Digital)

Michael Dempsey
Quality Control Manager

OHL NA
Company

Michael P Dempsey Digitally signed by Michael P Dempsey
Date: 2021.03.22 11:52:43 -04'00'

y Signed By

Commission Expires _____

Personally Known _____ or Produced Identification _____
Type of Identification Produced _____

(Print name of person signing Certification)

State of Florida
County of _____

Sworn to and subscribed before me, by means of physical
presence or online notarization, this _____ day of
_____, _____ (year),

by _____
(Print name of person signing Certification)

Notary Public (Not Required when Digital)

Commission Expires _____

Personally Known _____ or Produced Identification _____
Type of Identification Produced _____

OHL NA
Contractor

Project Manager
Title

Danny Lustgarten Digitally signed by Danny Lustgarten
Date: 2021.03.22 11:52:43 -04'00'

Signed By

Name

Date modified

✓  MPR No. 1 for 6-1-20 thru 6-30-20.pdf	5/3/2021 1:45 PM
✓  MPR No. 3 for 7-1-20 thru 8-31-20.pdf	10/6/2020 12:54 PM
✓  PMSR No. 1 for June 2020.pdf	8/21/2020 4:06 PM
✓  PMSR No. 2 and 3 for July and August 2020.pdf	10/6/2020 3:03 PM
✓  PMSR No. 4 for September 2020.pdf	5/21/2021 11:53 AM
✓  PMSR No. 5 for October 2020.pdf	5/21/2021 11:53 AM
✓  PMSR No. 6 for November 2020.pdf	5/21/2021 11:53 AM

Example

MONTHLY PROGRESS REPORT No. 1

MONTHLY PROGRESS REPORT # 1				
PROJECT NAME		SAVANNAH ROAD RESURFACING		
PROJECT LOCATION		Project extends from Jensen Beach Boulevard to NE Dixie Highway		
COUNTY	FM	FUNDING	FED AID PROJ#	Martin County CONTRACT #
Martin	438342-1-58-01	Federal (LAP) Oversight	D419-041-B	RFB2020-3174
CONTRACTOR/PHONE #	FDOT CONSTRUCTION PM	LAP AGENCY - CONTACT INFO	PROG ENG/CO NAME/PH#	
Community Asphalt Corp OHL Community Asphalt 9675 NW 117th Avenuem Suite 108 Miami, FL 33177 786-418-3476	Chloann Lawrence (772) 429-4866 Chloann.Lawrence@dot.state.fl.us Diego Valazquez (772) 429-4818 Diego.Valazquez@dot.state.fl.us	Kimberly McLaughlin Capital Projects/Public Works Dept. (772) 288-5777 kmclaugh@martin.fl.us Martin County BOCC 2401 SE Monterey Road Stuart, FL 34996	Rene Fresneda Capital Projects/Public Works Dept. (772) 288-5467 rfresneda@martin.fl.us Martin County BOCC 2401 SE Monterey Road Stuart, FL 34996	
	Contractor	FDOT DESIGN PROJECT MANAGER	DESIGNER OF RECORD	
ORIGINAL CONTRACT \$	\$1,046,885.65	Paul J. Bangs, P.E. Martin County BOCC (772) 463-2848 pbangs@martin.fl.us	Paul J. Bangs, P.E. Martin County BOCC (772) 463-2848 pbangs@martin.fl.us	
PRESENT CONTRACT \$	\$1,046,885.65			
AMOUNT PAID TO DATE	\$161,292.36			
Percent Complete Cost	15.41%			
Percent Increase Cost	0.00%			
ORIGINAL CONTRACT TIME	130			
Present Contract Time	130			
WEATHER DAYS/HOLIDAYS	0			
SA & EXTENSIONS	0			
Percent Complete Time	23.08%			
Percent Increase Time	0.00%			
% Scheduled	23.08%			
Days Used	CUT OFF DATE	FIRST CONTRACT DAY	Last Contract Day	PA ESTIMATE OF COMPLETION
30	06/30/20	June 1, 2020	October 11, 2020	October 11, 2020

revision 2/20/14

MAJOR ACTIVITIES DURING REPORTING MONTH

Mobilization, completion of the pre-construction video, MOT, clearing and grubbing, turn lane widening, bike lane widening

MAJOR ACTIVITIES SCHEDULED FOR NEXT MONTH

Temporary striping, bike lane widening, roadway milling.

PROJECT ENGINEER'S COMMENTS ON PROJECT STATUS (REQUIRED IF COST +5% OR TIME +10%)

PENDING ISSUES (S.A., TIME EXTENSION, SCHEDULE, PERMITS, SHOP DRAWINGS, VECP, ETC)

N/A

CURRENT/PENDING MOT PHASE

N/A

INNOVATIVE CONTRACTING METHOD

Design-Build

MONTHLY PROGRESS REPORT No. 3

PROJECT NAME		SAVANNAH ROAD RESURFACING		
PROJECT LOCATION		Project extends from Jensen Beach Boulevard to NE Dixie Highway		
COUNTY	FM	FUNDING	FED AID PROJ#	Martin County CONTRACT #
Martin	438342-1-58-01	Federal (LAP) Oversight	D419-041-B	RFB2020-3174
CONTRACTOR/PHONE #	FDOT CONSTRUCTION PM		LAP AGENCY - CONTACT INFO	PROG ENG/CO NAME/PH#
Community Asphalt Corp OHL Community Asphalt 9675 NW 117th Avenuem Suite 108 Miami, FL 33177 786-418-3476	Chloann Lawrence (772) 429-4866 Chloann.Lawrence@dot.state.fl.us		Kimberly McLaughlin Capital Projects/Public Works Dept. (772) 288-5777 kmclaugh@martin.fl.us	Rene Fresneda Capital Projects/Public Works Dept. (772) 288-5467 rffresneda@martin.fl.us
	Diego Valazquez (772) 429-4818 Diego.Valazquez@dot.state.fl.us		Martin County BOCC 2401 SE Monterey Road Stuart, FL 34996	Martin County BOCC 2401 SE Monterey Road Stuart, FL 34996
	Contractor		FDOT DESIGN PROJECT MANAGER	DESIGNER OF RECORD
ORIGINAL CONTRACT \$	\$1,046,885.65		Paul J. Bangs, P.E.	Paul J. Bangs, P.E.
PRESENT CONTRACT \$	\$1,046,885.65		Martin County BOCC	Martin County BOCC
AMOUNT PAID TO DATE	\$456,461.31		(772) 463-2848	(772) 463-2848
Percent Complete Cost	43.60%		pbangs@martin.fl.us	pbangs@martin.fl.us
Percent Increase Cost	0.00%			
ORIGINAL CONTRACT TIME	130			
Present Contract Time	130			
WEATHER DAYS/HOLIDAYS	0			
SA & EXTENSIONS	0			
Percent Complete Time	65.38%			
Percent Increase Time	0.00%			
% Scheduled	65.38%			
Days Used	CUT OFF DATE	FIRST CONTRACT DAY	Last Contract Day	PA ESTIMATE OF COMPLETION
85	08/31/20	June 1, 2020	October 11, 2020	October 11, 2020

revision 2/20/14

MAJOR ACTIVITIES DURING REPORTING MONTH

MOT, milling, turn outs, turn lanes, leveling roadway, grading slopes and embankments

MAJOR ACTIVITIES SCHEDULED FOR NEXT MONTH

night milling and paving

PROJECT ENGINEER'S COMMENTS ON PROJECT STATUS (REQUIRED IF COST +5% OR TIME +10%)

PENDING ISSUES (S.A., TIME EXTENSION, SCHEDULE, PERMITS, SHOP DRAWINGS, VCP, ETC.)

N/A

CURRENT/PENDING MOT PHASE

N/A

INNOVATIVE CONTRACTING METHOD

INNOVATIVE
Design-Build

MONTHLY PROGRESS REPORT No 6 (FINAL)

PROJECT NAME		SAVANNAH ROAD RESURFACING		
PROJECT LOCATION		Project extends from Jensen Beach Boulevard to NE Dixie Highway		
COUNTY	FM	FUNDING	FED AID PROJ#	Martin County CONTRACT #
Martin	438342-1-58-01	Federal (LAP) Oversight	D419-041-B	RFB2020-3174
CONTRACTOR/PHONE #	FDOT CONSTRUCTION PM		FDOT DESIGN PROJECT MANAGER	DESIGNER OF RECORD
Community Asphalt Corp OHL Community Asphalt 9675 NW 117th Avenuem Suite 108 Miami, FL 33177 786-418-3476	Chloann Lawrence (772) 429-4866 Chloann.Lawrence@dot.state.fl.us Diego Valazquez (772) 429-4818 Diego.Valazquez@dot.state.fl.us		Kimberly McLaughlin Capital Projects/Public Works Dept. (772) 288-5777 kmclaugh@martin.fl.us	Rene Fresneda Capital Projects/Public Works Dept. (772) 288-5467 rresneda@martin.fl.us
		Martin County BOCC 2401 SE Monterey Road Stuart, FL 34996		Martin County BOCC 2401 SE Monterey Road Stuart, FL 34996
ORIGINAL CONTRACT \$	Contractor		FDOT DESIGN PROJECT MANAGER	DESIGNER OF RECORD
\$1,046,885.65			Paul J. Bangs, P.E.	Paul J. Bangs, P.E.
\$1,079,969.51			Martin County BOCC	Martin County BOCC
\$1,079,969.51			(772) 463-2848	(772) 463-2848
Percent Complete Cost	100.00%		pbangs@martin.fl.us	pbangs@martin.fl.us
Percent Increase Cost	3.16%			
ORIGINAL CONTRACT TIME	130			
Present Contract Time	137			
WEATHER DAYS/HOLIDAYS	0			
SA & EXTENSIONS	0			
Percent Complete Time	100.00%			
Percent Increase Time	5.38%			
% Scheduled	100.00%			
Days Used	CUT OFF DATE	FIRST CONTRACT DAY	Last Contract Day	PA ESTIMATE OF COMPLETION
137	11/24/20	June 1, 2020	November 24, 2020	November 24, 2020

revision 2/20/14

MAJOR ACTIVITIES DURING REPORTING MONTH

final milling & paving, erosion control, slope grading, sod, signage, striping

MAJOR ACTIVITIES SCHEDULED FOR NEXT MONTH

project complete

PROJECT ENGINEER'S COMMENTS ON PROJECT STATUS (REQUIRED IF COST +5% OR TIME +10%)

PENDING ISSUES (S.A., TIME EXTENSION, SCHEDULE, PERMITS, SHOP DRAWINGS, VECP, ETC)

N/A

CURRENT/PENDING MOT PHASE

N/A


INNOVATIVE CONTRACTING METHOD

INNOVATION

Design-Build

STATE OF FLORIDA DEPARTMENT OF TRANSPORTATION
LOCAL PROGRAMS
PROJECT MONITORING STATUS REPORT

Program Management
03/18

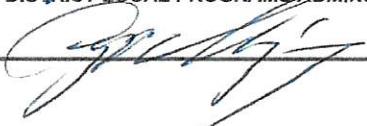INSTRUCTIONS: Local Agency to complete this form when submitting an invoice to the department.		
LOCAL AGENCY NAME: Martin County BOCC	DATES OF REPORTING PERIOD: 6/1/2020 - 6/30/2020	FDOT FINANCIAL PROJECT NO.: 438342-1-58-01
PROJECT DESCRIPTION: Gove Road Resurfacings <i>Savannah</i>		
INVOICE ATTACHED: Yes X No N/A	OTHER PROGRESS REPORT ATTACHED: Yes X No N/A	
PHOTOS ATTACHED: Yes No X N/A	AGENCY PROJECT NOTICE-TO-PROCEED DATE: 6/1/2020	AGENCY PROJECT ESTIMATED COMPLETION DATE: 10/11/2020
1. PROJECT STATUS: Active		
2. WORK COMPLETED OR IN PROGRESS THIS PERIOD (use a separate sheet of paper if more space is needed): Mobilization, completion of the pre-construction video, MOT, clearing and grubbing, turn lane widening, bike lane widening		
3. WORK ANTICIPATED FOR NEXT PERIOD (use a separate sheet of paper if more space is needed): Temporary striping, bike lane widening, roadway milling.		
4. PROBLEM AREAS / OTHER COMMENTS (Plan revisions, changes in specifications, delays, difficulties, etc., and actions taken): None.		
AGENCY	LOCAL AGENCY DESIGNATED REPRESENTATIVE I certify that the information provided above is true and correct per the terms of the Grant Agreement.	
	DATE 8/14/2020	PRINTED NAME AND TITLE Kimberly McLaughlin Construction Contract & Grants Administrator
FDOT	COMMENTS / NOTES	
	VERIFICATION DATE <i>8/18/20</i>	SITE VISIT Yes <input checked="" type="radio"/> No <input type="radio"/> N/A
DISTRICT LOCAL PROGRAMS ADMINISTRATOR OR DESIGNEE [SIGNATURE] 		

STATE OF FLORIDA DEPARTMENT OF TRANSPORTATION
LOCAL PROGRAMS
PROJECT MONITORING STATUS REPORT

Program Management
 03/18

INSTRUCTIONS: Local Agency to complete this form when submitting an invoice to the department.

LOCAL AGENCY NAME: Martin County BOCC	DATES OF REPORTING PERIOD: 7/1/2020 - 8/31/2020	FDOT FINANCIAL PROJECT NO.: 438342-1-58-01
PROJECT DESCRIPTION: Savannah Road Resurfacings		
INVOICE ATTACHED: Yes X No N/A		OTHER PROGRESS REPORT ATTACHED: Yes X No N/A
PHOTOS ATTACHED: Yes No X N/A	AGENCY PROJECT NOTICE-TO-PROCEED DATE: 6/1/2020	AGENCY PROJECT ESTIMATED COMPLETION DATE: 10/11/2020
<p>1. PROJECT STATUS: Active</p> <p>2. WORK COMPLETED OR IN PROGRESS THIS PERIOD (use a separate sheet of paper if more space is needed): Mobilization, completion of the pre-construction video, MOT, clearing and grubbing, turn lane widening, bike lane widening, turn outs, turn lanes, leveling roadway, grading slopes and embankments.</p> <p>3. WORK ANTICIPATED FOR NEXT PERIOD (use a separate sheet of paper if more space is needed): Temporary striping, bike lane widening, roadway milling and paving.</p> <p>4. PROBLEM AREAS / OTHER COMMENTS (Plan revisions, changes in specifications, delays, difficulties, etc., and actions taken): None.</p>		
AGENCY	<p align="center">LOCAL AGENCY DESIGNATED REPRESENTATIVE</p> <p>I certify that the information provided above is true and correct per the terms of the Grant Agreement.</p>	
	DATE 9/15/2020	PRINTED NAME AND TITLE Kimberly McLaughlin Construction Contract & Grants Administrator
FDOT	COMMENTS / NOTES	
	VERIFICATION DATE 10/6/20	SITE VISIT <input checked="" type="radio"/> Yes No N/A
DISTRICT LOCAL PROGRAMS ADMINISTRATOR OR DESIGNEE [SIGNATURE]		

STATE OF FLORIDA DEPARTMENT OF TRANSPORTATION
LOCAL PROGRAMS
PROJECT MONITORING STATUS REPORT

Program Management
03/18

INSTRUCTIONS: Local Agency to complete this form when submitting an invoice to the department.			
LOCAL AGENCY NAME: Martin County BOCC	DATES OF REPORTING PERIOD: 9/1/20 - 9/30/20	FDOT FINANCIAL PROJECT NO.: 438342-1-58-01	
PROJECT DESCRIPTION: Savannah Road Resurfacings			
INVOICE ATTACHED: Yes X No N/A		OTHER PROGRESS REPORT ATTACHED: Yes X No N/A	
PHOTOS ATTACHED: Yes No X N/A	AGENCY PROJECT NOTICE-TO-PROCEED DATE: 6/1/2020	AGENCY PROJECT ESTIMATED COMPLETION DATE: 11/24/2020	
1. PROJECT STATUS: Active			
2. WORK COMPLETED OR IN PROGRESS THIS PERIOD (use a separate sheet of paper if more space is needed): Paving, erosion control, slope grading, temporary striping.			
3. WORK ANTICIPATED FOR NEXT PERIOD (use a separate sheet of paper if more space is needed): Paving, slope grading, sodding, signage			
4. PROBLEM AREAS / OTHER COMMENTS (Plan revisions, changes in specifications, delays, difficulties, etc., and actions taken): None.			
AGENCY	LOCAL AGENCY DESIGNATED REPRESENTATIVE I certify that the information provided above is true and correct per the terms of the Grant Agreement.		
	DATE 5/21/2021	PRINTED NAME AND TITLE Kimberly McLaughlin Public Works Grants Coordinator	SIGNATURE <i>Kimberly McLaughlin</i>
FDOT	COMMENTS / NOTES Diego Velazquez		Digitally signed by Diego Velazquez Date: 2021.06.24 16:46:20 -04'00'
	VERIFICATION DATE	SITE VISIT Yes No N/A	DISTRICT LOCAL PROGRAMS ADMINISTRATOR OR DESIGNEE [PRINTED NAME]
	DISTRICT LOCAL PROGRAMS ADMINISTRATOR OR DESIGNEE [SIGNATURE]		

STATE OF FLORIDA DEPARTMENT OF TRANSPORTATION
LOCAL PROGRAMS
PROJECT MONITORING STATUS REPORT

Program Management
 03/18

INSTRUCTIONS: Local Agency to complete this form when submitting an invoice to the department.			
LOCAL AGENCY NAME: Martin County BOCC		DATES OF REPORTING PERIOD: 10/1/20 - 10/31/20	FDOT FINANCIAL PROJECT NO.: 438342-1-58-01
PROJECT DESCRIPTION: Savannah Road Resurfacings			
INVOICE ATTACHED: Yes X No N/A		OTHER PROGRESS REPORT ATTACHED: Yes X No N/A	
PHOTOS ATTACHED: Yes No X N/A		AGENCY PROJECT NOTICE-TO-PROCEED DATE: 6/1/2020	AGENCY PROJECT ESTIMATED COMPLETION DATE: 11/24/2020
1. PROJECT STATUS: Active			
2. WORK COMPLETED OR IN PROGRESS THIS PERIOD (use a separate sheet of paper if more space is needed): grading for sod, laying sod, cleaning clumps, reinstalling mailboxes			
3. WORK ANTICIPATED FOR NEXT PERIOD (use a separate sheet of paper if more space is needed): sodding, signage, loops, thermo			
4. PROBLEM AREAS / OTHER COMMENTS (Plan revisions, changes in specifications, delays, difficulties, etc., and actions taken): None.			
AGENCY	LOCAL AGENCY DESIGNATED REPRESENTATIVE I certify that the information provided above is true and correct per the terms of the Grant Agreement.		
	DATE 5/21/2021	PRINTED NAME AND TITLE Kimberly McLaughlin Public Works Grants Coordinator	SIGNATURE 
FDOT	COMMENTS / NOTES <div style="text-align: center;"> Diego Velazquez Digitally signed by Diego Velazquez Date: 2021.06.24 16:47:33 -04'00' </div>		
	VERIFICATION DATE Yes No N/A	DISTRICT LOCAL PROGRAMS ADMINISTRATOR OR DESIGNEE [PRINTED NAME]	
	DISTRICT LOCAL PROGRAMS ADMINISTRATOR OR DESIGNEE [SIGNATURE]		

STATE OF FLORIDA DEPARTMENT OF TRANSPORTATION
LOCAL PROGRAMS
PROJECT MONITORING STATUS REPORT

Program Management
 03/18

INSTRUCTIONS: Local Agency to complete this form when submitting an invoice to the department.			
LOCAL AGENCY NAME: Martin County BOCC		DATES OF REPORTING PERIOD: 11/1/20 - 11/24/20	FDOT FINANCIAL PROJECT NO.: 438342-1-58-01
PROJECT DESCRIPTION: Savannah Road Resurfacings			
INVOICE ATTACHED: Yes X No N/A		OTHER PROGRESS REPORT ATTACHED: Yes X No N/A	
PHOTOS ATTACHED: Yes No X N/A		AGENCY PROJECT NOTICE-TO-PROCEED DATE: 6/1/2020	AGENCY PROJECT ESTIMATED COMPLETION DATE: 11/24/2020
1. PROJECT STATUS: Active			
2. WORK COMPLETED OR IN PROGRESS THIS PERIOD (use a separate sheet of paper if more space is needed): project is complete			
3. WORK ANTICIPATED FOR NEXT PERIOD (use a separate sheet of paper if more space is needed): None			
4. PROBLEM AREAS / OTHER COMMENTS (Plan revisions, changes in specifications, delays, difficulties, etc., and actions taken): None.			
AGENCY	LOCAL AGENCY DESIGNATED REPRESENTATIVE I certify that the information provided above is true and correct per the terms of the Grant Agreement.		
	DATE 5/21/2021	PRINTED NAME AND TITLE Kimberly McLaughlin Public Works Grants Coordinator	SIGNATURE <i>Kimberly McLaughlin</i>
FDOT	COMMENTS / NOTES <div style="text-align: center;">  Digitally signed by Diego Velazquez Date: 2021.06.24 16:47:56 -04'00' </div>		
	VERIFICATION DATE	SITE VISIT Yes No N/A	DISTRICT LOCAL PROGRAMS ADMINISTRATOR OR DESIGNEE [PRINTED NAME]
	DISTRICT LOCAL PROGRAMS ADMINISTRATOR OR DESIGNEE [SIGNATURE]		

AIA® Document G707™ – 1994

Consent Of Surety to Final Payment

Bond No.: 015209114

PROJECT: (Name and address)

Savannah Road Resurfacing
& Bike Lanes
Contract# RFB2020-3190
FDOT Contract Number: G1-G11

ARCHITECT'S PROJECT NUMBER:

OWNER:

CONTRACT FOR: Savannah Road Resurfacing
& Bike Lanes
Contract# RFB2020-3190
FDOT Contract Number: G1-G11

ARCHITECT:

CONTRACTOR:

SURETY:

OTHER:

TO OWNER: (Name and address)
Martin County Board of County Commissioners
2401 S.E. Monterey Road
Stuart, FL 34996

CONTRACT DATED: 03/24/2020

In accordance with the provisions of the Contract between the Owner and the Contractor as indicated above, the
(Insert name and address of Surety)

Liberty Mutual Insurance Company
175 Berkeley Street
Boston, MA 02116

, SURETY,

on bond of
(Insert name and address of Contractor)

Community Asphalt Corp.
9675 NW 117th Avenue
Suite 108
Miami, FL 33178

, CONTRACTOR,

hereby approves of the final payment to the Contractor, and agrees that final payment to the Contractor shall not relieve the
Surety of any of its obligations to
(Insert name and address of Owner)

Martin County Board of County Commissioners
2401 S.E. Monterey Road
Stuart, FL 34996

, OWNER,

as set forth in said Surety's bond.

IN WITNESS WHEREOF, the Surety has hereunto set its hand on this date: March 22, 2021
(Insert in writing the month followed by the numeric date and year.)

Attest:
(Seal): James Merrill

Liberty Mutual Insurance Company

(Surety)


(Signature of authorized representative)

Andrea E. Gorbert, Attorney-In-Fact

(Printed name and title)



This Power of Attorney limits the acts of those named herein, and they have no authority to bind the Company except in the manner and to the extent herein stated.

Liberty Mutual Insurance Company
The Ohio Casualty Insurance Company
West American Insurance Company

Certificate No: 8204466 - 985164

POWER OF ATTORNEY

KNOWN ALL PERSONS BY THESE PRESENTS: That The Ohio Casualty Insurance Company is a corporation duly organized under the laws of the State of New Hampshire, that Liberty Mutual Insurance Company is a corporation duly organized under the laws of the State of Massachusetts, and West American Insurance Company is a corporation duly organized under the laws of the State of Indiana (herein collectively called the "Companies"), pursuant to and by authority herein set forth, does hereby name, constitute and appoint, _____ Andrea E. Gorbert, Kevin T. Walsh, Jr., Michael Marino

all of the city of Jericho state of NY each individually if there be more than one named, its true and lawful attorney-in-fact to make, execute, seal, acknowledge and deliver, for and on its behalf as surety and as its act and deed, any and all undertakings, bonds, recognizances and other surety obligations, in pursuance of these presents and shall be as binding upon the Companies as if they have been duly signed by the president and attested by the secretary of the Companies in their own proper persons.

IN WITNESS WHEREOF, this Power of Attorney has been subscribed by an authorized officer or official of the Companies and the corporate seals of the Companies have been affixed thereto this 9th day of November, 2020.



Liberty Mutual Insurance Company
The Ohio Casualty Insurance Company
West American Insurance Company

By:
David M. Carey, Assistant Secretary

Not valid for mortgage, note, loan, letter of credit, currency rate, interest rate or residual value guarantees.

State of PENNSYLVANIA
County of MONTGOMERY ss

On this 9th day of November, 2020 before me personally appeared David M. Carey, who acknowledged himself to be the Assistant Secretary of Liberty Mutual Insurance Company, The Ohio Casualty Company, and West American Insurance Company, and that he, as such, being authorized so to do, execute the foregoing instrument for the purposes therein contained by signing on behalf of the corporations by himself as a duly authorized officer.

IN WITNESS WHEREOF, I have hereunto subscribed my name and affixed my notarial seal at King of Prussia, Pennsylvania, on the day and year first above written.



COMMONWEALTH OF PENNSYLVANIA
Notarial Seal
Teresa Pastella, Notary Public
Upper Merion Twp., Montgomery County
My Commission Expires March 28, 2021
Member, Pennsylvania Association of Notaries

By:
Teresa Pastella, Notary Public

This Power of Attorney is made and executed pursuant to and by authority of the following By-laws and Authorizations of The Ohio Casualty Insurance Company, Liberty Mutual Insurance Company, and West American Insurance Company which resolutions are now in full force and effect reading as follows:

ARTICLE IV – OFFICERS: Section 12. Power of Attorney.

Any officer or other official of the Corporation authorized for that purpose in writing by the Chairman or the President, and subject to such limitation as the Chairman or the President may prescribe, shall appoint such attorneys-in-fact, as may be necessary to act in behalf of the Corporation to make, execute, seal, acknowledge and deliver as surety any and all undertakings, bonds, recognizances and other surety obligations. Such attorneys-in-fact, subject to the limitations set forth in their respective powers of attorney, shall have full power to bind the Corporation by their signature and execution of any such instruments and to attach thereto the seal of the Corporation. When so executed, such instruments shall be as binding as if signed by the President and attested to by the Secretary. Any power or authority granted to any representative or attorney-in-fact under the provisions of this article may be revoked at any time by the Board, the Chairman, the President or by the officer or officers granting such power or authority.

ARTICLE XIII – Execution of Contracts: Section 5. Surety Bonds and Undertakings.

Any officer of the Company authorized for that purpose in writing by the chairman or the president, and subject to such limitations as the chairman or the president may prescribe, shall appoint such attorneys-in-fact, as may be necessary to act in behalf of the Company to make, execute, seal, acknowledge and deliver as surety any and all undertakings, bonds, recognizances and other surety obligations. Such attorneys-in-fact subject to the limitations set forth in their respective powers of attorney, shall have full power to bind the Company by their signature and execution of any such instruments and to attach thereto the seal of the Company. When so executed such instruments shall be as binding as if signed by the president and attested by the secretary.

Certificate of Designation – The President of the Company, acting pursuant to the Bylaws of the Company, authorizes David M. Carey, Assistant Secretary to appoint such attorneys-in-fact as may be necessary to act on behalf of the Company to make, execute, seal, acknowledge and deliver as surety any and all undertakings, bonds, recognizances and other surety obligations.

Authorization – By unanimous consent of the Company's Board of Directors, the Company consents that facsimile or mechanically reproduced signature of any assistant secretary of the Company, wherever appearing upon a certified copy of any power of attorney issued by the Company in connection with surety bonds, shall be valid and binding upon the Company with the same force and effect as though manually affixed.

I, Renee C. Llewellyn, the undersigned, Assistant Secretary, The Ohio Casualty Insurance Company, Liberty Mutual Insurance Company, and West American Insurance Company do hereby certify that the original power of attorney of which the foregoing is a full, true and correct copy of the Power of Attorney executed by said Companies, is in full force and effect and has not been revoked.

IN TESTIMONY WHEREOF, I have hereunto set my hand and affixed the seals of said Companies this 22nd day of March, 2021.



By:
Renee C. Llewellyn, Assistant Secretary

For bond and/or Power of Attorney (POA) verification inquiries, please call 610-832-8240 or email HOSUR@libertymutual.com.



LIBERTY MUTUAL INSURANCE COMPANY
FINANCIAL STATEMENT — DECEMBER 31, 2019

Assets	
Cash and Bank Deposits..... \$778,754,989	
*Bonds — U.S Government..... 2,780,808,610	
*Other Bonds..... 12,645,608,792	
*Stocks..... 16,385,435,431	
Real Estate..... 235,608,378	
Agents' Balances or Uncollected Premiums	6,217,983,641
Accrued Interest and Rents..... 102,273,390	
Other Admitted Assets	11,957,106,292
Total Admitted Assets	<u>\$51,103,579,523</u>

Liabilities	
Unearned Premiums	\$8,007,146,482
Reserve for Claims and Claims Expense	21,532,853,787
Funds Held Under Reinsurance Treaties	507,868,920
Reserve for Dividends to Policyholders.....	1,143,826
Additional Statutory Reserve.....	125,722,000
Reserve for Commissions, Taxes and	
Other Liabilities.....	4,117,460,075
Total.....	<u>\$34,292,195,090</u>
Special Surplus Funds.....	\$32,768,443
Capital Stock.....	10,000,075
Paid in Surplus.....	10,044,978,933
Unassigned Surplus	6,723,636,983
Surplus to Policyholders.....	<u>16,811,384,434</u>
Total Liabilities and Surplus.....	<u>\$51,103,579,524</u>

* Bonds are stated at amortized or investment value; Stocks at Association Market Values.
The foregoing financial information is taken from Liberty Mutual Insurance Company's financial statement filed with the state of Massachusetts Department of Insurance.



I, TIM MIKOLAJEWSKI, Assistant Secretary of Liberty Mutual Insurance Company, do hereby certify that the foregoing is a true, and correct statement of the Assets and Liabilities of said Corporation, as of December 31, 2019, to the best of my knowledge and belief.

IN WITNESS WHEREOF, I have hereunto set my hand and affixed the seal of said Corporation at Seattle, Washington, this 27th day of March, 2020.

Assistant Secretary

Final Acceptance Documents

TAB-3

IN THIS SECTION:

13. FINAL INSPECTION AND ACCEPTANCE FORM

Example

STATE OF FLORIDA DEPARTMENT OF TRANSPORTATION
**LOCAL AGENCY PROGRAM FINAL INSPECTION AND ACCEPTANCE OF
 FEDERAL-AID PROJECT**

525-010-42
 PRODUCTION SUPPORT
 01/08

INSTRUCTIONS: Local Agency to complete this form for each completed exempt project

FEDERAL PROJECT NO. 438342-1-58-01	FINANCIAL PROJECT NO. D419-041-B	CONTRACT NO. G1G11
PROJECT TYPE (CHECK ONE) <input type="checkbox"/> NHS <input checked="" type="checkbox"/> NON-NHS		
DESCRIPTION OF IMPROVEMENT AS PROGRAMMED Savannah Road Resurfacing and Bike Lanes from NE Cardinal Avenue to Jensen Beach Boulevard		
LOCAL AGENCY Martin County BOCC	COUNTY Martin	LAP AGREEMENT AMOUNT \$1,090,715.00
	FINAL COMPLETION DATE 11/24/2020	TOTAL PROJECT COST \$1,079,969.51
NOTICE OF FINAL INSPECTION AND ACCEPTANCE: I certify that this project has been completed in accordance with the terms of the Local Agency Program Agreement and constructed in accordance with the approved plans and specifications.		
<u>James Gorton</u> COUNTY/CITY ENGINEER OR DESIGNEE (PRINT NAME) *		<u>Public Works Director</u> TITLE
 SIGNATURE *		<u>March 26, 2021</u> DATE
INSPECTION DATE <u>11/24/20</u>	INSPECTED BY <u>Diego Velazquez</u> <u>OZB637</u>	FINAL ACCEPTANCE DATE <u>3/26/21</u>
ACCEPTANCE: The above listed project has been completed by the Local Agency and accepted by the Department.		
DIST. CONST. ENGINEER OR DESIGNEE (PRINT NAME) *		TITLE
SIGNATURE *		DATE
<small>* Need a responsible charge Local Agency or Department employee's signature for Final Inspection or Final Acceptance. A non-Local Agency employee (i.e., consultants) cannot sign for Final Inspection or Final Acceptance.</small>		

Distribution: Federal Aid Management Office (MS 21)
 Office of Comptroller, Federal Project Cost Section (MS42)
 FHWA Florida Division Office, Program Operations Engineer (MS 29)

Material Certification

TAB-4

IN THIS SECTION:

14. MATERIALS CERTIFICATION LETTER

Example



MARTIN COUNTY

BOARD OF COUNTY COMMISSIONERS

2401 S.E. MONTEREY ROAD • STUART, FL 34996

DOUG SMITH	Commissioner, District 1	TARYN KRYZDA, CPM	County Administrator
STACEY HETHERINGTON	Commissioner, District 2	SARAH W. WOODS	County Attorney
HAROLD E. JENKINS II	Commissioner, District 3		
SARAH HEARD	Commissioner, District 4	TELEPHONE	(772) 288-5400
EDWARD V. CIAMPI	Commissioner, District 5	WEBSITE	www.martin.fl.us

This document may be reproduced upon request in an alternative format by contacting the County ADA Coordinator (772) 320-3131, the County Administration Office (772) 288-5400, Florida Relay 711, or by completing our accessibility feedback form at www.martin.fl.us/accessibility-feedback.

March 25, 2021

Ms. Mya Williams-Gray
Florida Department of Transportation
District 4 Program Management Office
3400 West Commercial Boulevard
Fort Lauderdale, FL 33309

FM# 438342-1-54-01 / G1G11 / RFB2020-3190
Savannah Road Resurfacing Project
Materials Certification Letter

Ms. Williams-Gray,

The results of the test used in the acceptance program indicate that the materials incorporated in the construction work, and the construction operations controlled by sampling and testing, were in conformity with the approved plans and specifications.

Sincerely,

James Gorton
Martin County Public Works Director
JG/kmc

CC: Carlos Lemus, FDOT
Chloann Lawrence, FDOT
Diego Velazquez, FDOT
Frank White, The Corradino Group/FDOT
George Dzama, Deputy Director, Public Works, Martin County

DBE Subcontracts

TAB-5

IN THIS SECTION:

15. DBE SUBCONTRACTS

Example



Florida Department of Transportation

Contract DBE Commitment Details Report

Contract ID: RFB2020-3190

Prime: COMMUNITY ASPHALT CORPORATION - F592023298

Total Contract Amount: \$1,046,855.65

NAICS Description	Specialty Code	Date Submitted	Commitment Amount	DBE Credit Amount	% Of Contract	Date Reported	Current Status
Sub: NATURE'S KEEPER INC - F650313390							
561730 - Landscaping Services	575 - SODDING	6/15/2020	\$8,614.00	\$8,614.00	0.82%	7/1/2020	READY
561730 - Landscaping Services	575 - SODDING	3/10/2021	\$21,150.33	\$21,150.33	2.02%	3/18/2021	READY
561730 - Landscaping Services	575 - SODDING	6/11/2021	(\$3,883.83)	(\$3,883.83)	< 0%		SUBMITTED
Sub Total			\$25,880.50	\$25,880.50	2.47%		

Sub: WIRETEK SOLUTIONS LLC - F262583742	Tier - 01	
238210 - Electrical Contractors and Other Wiring Installation Contractors	238210 - ELECTRICAL CONTRACTORS AND OTHER WIRING INSTALLATION CONTRA	6/8/2020
238210 - Electrical Contractors and Other Wiring Installation Contractors	238210 - ELECTRICAL CONTRACTORS AND OTHER WIRING INSTALLATION CONTRA	6/11/2021
238210 - Electrical Contractors and Other Wiring Installation Contractors	238210 - ELECTRICAL CONTRACTORS AND OTHER WIRING INSTALLATION CONTRA	6/11/2021
Sub Total	\$5,500.02	\$5,500.02
Contract Total	\$31,380.52	\$31,330.52
"Current Status" Definitions		
<ul style="list-style-type: none">• Working : Contractor has not submitted commitment• Submitted : Contractor has submitted commitment and RCS needs to review• Accepted : Entry is waiting on the DCCM and Maintenance Admin to review• Ready : Entry reviewed by all and will be counted as of Date Reported		



Florida Department of Transportation
Contract DBE Payment Details

Prime: COMMUNITY ASPHALT CORPORATION

NAICS Description	Specialty Area	DBE Credit	Credit Amount	Date Submitted	Date Reported	Current Status
NATURE'S KEEPER INC - F650313390	Tier: 01	Hired By: COMMUNITY ASPHALT CORPORATION				
DBE Credit: \$25,880.50						
Payment Date: 06/03/2021	Service From: 11/23/2020 Service To: 11/23/2020 Work Complete:	Date Updated: 06/04/2021 Final Payment: N Contract : RFB2020-3190				
Total Payment Amount: \$3,367.27	Retainage Amount: \$177.22	Zero Payment Reason: \$3,367.27	06/04/2021	06/04/2021	READY	
561730-Landscaping Services	575-SODDING					
Payment Date: 06/03/2021	Service From: 06/01/2020 Service To: 11/23/2020 Work Complete: 11/23/2020	Date Updated: 06/04/2021 Final Payment: Y Contract : RFB2020-3190				
Total Payment Amount: \$1,352.90	Retainage Amount: -\$1,362.90	Zero Payment Reason: -\$1,362.90				
Contractor Payment Summary Comment:	Retainage	575-SODDING	\$1,362.90	06/04/2021	06/04/2021	READY
561730-Landscaping Services						
Payment Date: 04/13/2021	Service From: 11/23/2020 Service To: 11/23/2020 Work Complete:	Date Updated: 05/13/2021 Final Payment: N Contract : RFB2020-3190				
Total Payment Amount: \$0.00	Retainage Amount: \$0.00	Zero Payment Reason: NONPYMT				
Payment Date: 03/31/2021	Service From: 03/01/2021 Service To: 03/31/2021 Work Complete:	Date Updated: 04/15/2021 Final Payment: N Contract : RFB2020-3190				
Total Payment Amount: \$0.00	Retainage Amount: \$0.00	Zero Payment Reason: NONPYMT				
Payment Date: 02/01/2021	Service From: 10/01/2020 Service To: 10/31/2020 Work Complete:	Date Updated: 03/10/2021 Final Payment: N Contract : RFB2020-3190				
Total Payment Amount: \$21,150.33	Retainage Amount: \$1,113.18	Zero Payment Reason: \$21,150.33	03/10/2021	03/10/2021	READY	
561730-Landscaping Services	575-SODDING					
Payment Date: 12/31/2020	Service From: 12/01/2020 Service To: 12/31/2020 Work Complete:	Date Updated: 01/05/2021 Final Payment: N Contract : RFB2020-3190				
Total Payment Amount: \$0.00	Retainage Amount: \$0.00	Zero Payment Reason: NONPYMT				
Payment Date: 11/30/2020	Service From: 11/01/2020 Service To: 11/30/2020 Work Complete:	Date Updated: 12/14/2020 Final Payment: N Contract : RFB2020-3190				
Total Payment Amount: \$0.00	Retainage Amount: \$0.00	Zero Payment Reason: NONPYMT				
Payment Date: 10/31/2020	Service From: 10/01/2020 Service To: 10/31/2020 Work Complete:	Date Updated: 11/18/2020 Final Payment: N Contract : RFB2020-3190				
Total Payment Amount: \$0.00	Retainage Amount: \$0.00	Zero Payment Reason: NONPYMT				
Payment Date: 09/30/2020	Service From: 09/01/2020 Service To: 09/30/2020 Work Complete:	Date Updated: 11/18/2020 Final Payment: N Contract : RFB2020-3190				
Total Payment Amount: \$0.00	Retainage Amount: \$0.00	Zero Payment Reason: NONPYMT				



Florida Department of Transportation
Contract DBE Payment Details

Prime: COMMUNITY ASPHALT CORPORATION

NAICS Description	Specialty Area	DBE Credit Amount	Date Submitted	Date Reported	Current Status
Payment Date: 08/04/2020 Total Payment Amount: 561730-Landscaping Services	Service From: 06/01/2020 Service To: 06/30/2020 Work Complete: Retainage Amount : \$1,377.50 575-SODDING	\$72.50			Date Updated: 09/11/2020 Final Payment: N Contract : RFB2020-3190 Zero Payment Reason: \$.00 09/11/2020 REJECTED
Payment Date: 08/04/2020 Total Payment Amount: 561730-Landscaping Services	Service From: 06/01/2020 Service To: 06/30/2020 Work Complete: Retainage Amount : \$1,377.50 575-SODDING	\$72.50			Date Updated: 06/03/2021 Final Payment: N Contract : RFB2020-3190 Zero Payment Reason: \$.00 09/11/2020 REJECTED
Contractor Payment Summary Comment: 561730-Landscaping Services	Previously reported amount made on 9/11/2020 that was rejected.				
Payment Date: 08/04/2020 Total Payment Amount: 561730-Landscaping Services	Service From: 06/01/2020 Service To: 06/30/2020 Work Complete: Retainage Amount : -\$1,377.50 575-SODDING	-\$72.50			Date Updated: 06/04/2021 Final Payment: N Contract : RFB2020-3190 Zero Payment Reason: \$1,377.50 06/03/2021 06/04/2021 READY
Contractor Payment Summary Comment: 561730-Landscaping Services	Correction				
Total for NATURE'S KEEPER INC :		\$25,880.50			
WIRETEK SOLUTIONS LLC - F262583742	Tier: 01 Hired By: COMMUNITY ASPHALT CORPORATION				
DBE Credit: \$5,225.02					
Payment Date: 06/01/2021 Total Payment Amount:	Service From: 10/01/2020 Service To: 10/31/2021 Date Updated: 10/31/2021 Final Payment: Y Contract : RFB2020-3190 Retainage Amount : \$275.00 -\$275.00				Zero Payment Reason: \$.00 06/11/2021 SUBMITTED
Contractor Payment Summary Comment: 238210-Electrical Contractors and Other Wiring Installation Contractors	Retainalge 238210-ELECTRICAL CONTRACTORS AND OTHER WIRING INSTALLATION CONTRA				
Payment Date: 04/30/2021 Total Payment Amount:	Service From: 11/23/2020 Service To: 11/23/2020 Work Complete: Date Updated: 05/13/2021 Final Payment: N Contract : RFB2020-3190 Retainage Amount : \$.00 \$.00				Zero Payment Reason: NONPYMT \$.00 06/11/2021 SUBMITTED
Payment Date: 03/31/2021 Total Payment Amount:	Service From: 03/01/2021 Service To: 03/31/2021 Work Complete: Date Updated: 04/15/2021 Final Payment: N Contract : RFB2020-3190 Retainage Amount : \$.00 \$.00				Zero Payment Reason: NONPYMT \$.00 06/11/2021 SUBMITTED
Payment Date: 02/01/2021 Total Payment Amount:	Service From: 02/01/2021 Service To: 02/28/2021 Work Complete: Date Updated: 03/10/2021 Final Payment: N Contract : RFB2020-3190 Retainage Amount : \$.00 \$.00				Zero Payment Reason: NONPYMT \$.00 06/11/2021 SUBMITTED



Florida Department of Transportation
Contract DBE Payment Details

Prime: COMMUNITY ASPHALT CORPORATION

NAICS Description	Specialty Area	DBE Credit Amount	Date Submitted	Date Reported	Current Status
Payment Date: 01/15/2021 Service From: 10/01/2020 Service To: 10/31/2020 Work Complete: Total Payment Amount: \$5,225.02 238210-Electrical Contractors and Other Wiring Installation Contractors	Retainage Amount: \$275.00 OTHER WIRING INSTALLATION CONTRA	\$275.00	02/12/2021	02/15/2021	READY
Payment Date: 12/31/2020 Service From: 12/01/2020 Service To: 12/31/2020 Work Complete: Total Payment Amount: \$0.00	Retainage Amount:		01/05/2021	01/12/2021	READY
Payment Date: 11/30/2020 Service From: 11/01/2020 Service To: 11/30/2020 Work Complete: Total Payment Amount: \$0.00	Retainage Amount:		12/14/2020	12/14/2020	READY
Payment Date: 10/31/2020 Service From: 10/01/2020 Service To: 10/31/2020 Work Complete: Total Payment Amount: \$0.00	Retainage Amount:		11/18/2020	11/18/2020	READY
Payment Date: 09/30/2020 Service From: 09/01/2020 Service To: 09/30/2020 Work Complete: Total Payment Amount: \$0.00	Retainage Amount:		11/18/2020	11/18/2020	READY
Total for WIRETEK SOLUTIONS LLC :		\$5,225.02			

Audits and Final Photos

TAB-6

IN THIS SECTION:

16. CONSTRUCTION INITIAL CCCA* FORM
17. CONSTRUCTION FINAL CCCA* FORM
18. PHOTOS
19. AS-BUILTS

Local Agency Program (LAP) Construction Contract Administration Audit Form

<u>FM No. & FAP No.</u> 438342-1-58-01 / 419-041-B	<u>Local Agency (LA)</u> Martin County / RFB2020-3190	<u>Project Name/Location</u> Savanna Road Resurfacing - Jensen Beach	<u>Audit Type</u> Interim 1	<u>Auditor and Audit Date</u> Frank White 8/3/2020 (Invoice 2)
General Information				
<u>FDOT PM</u> Chloann Lawrence	<u>LA Responsible Charge</u> Rene Fresneda, Field Representative <u>LA Project Manager and Contact #</u> Kimberly McLaughlin	<u>LA Advertisement Date</u> 12/21/2019 <u>Award Date</u> 3/4/2020 <u>Execution Date</u> 3/24/2020	<u>Local Agency NTP Date</u> 6/1/2020 <u>Contract Start Date</u> 6/1/2020 <u>Original Contract Days</u> 190	<u>Original LAP Agreement Amount</u> \$1,193,763.00 <u>Final LAP Agreement Amount</u> Pending <u>Original Construction Amount</u> \$1,046,885.65 <u>Final Construction Amount</u> Pending
<u>FDOT LAP Number and Expiration Date</u> 12/31/2021	<u>CEI Consultant</u> N/A			
<u>FDOT NTP Date</u> 11/8/2019	<u>Contactor</u> Community Asphalt Corp.	<u>Preconstruction Date</u> 5/8/2020	<u>Final Contract Days</u> 190	
<u>EDOT Bid Concurrence Date</u> 11/8/2020				

Project Classification - Refer to Chapter 19 of the Local Area Program Manual (check only one, work left to right)

<u>Class</u>	<u>Class A</u> <input type="checkbox"/>	<u>Class B</u> <input type="checkbox"/>	<u>Class C</u> <input type="checkbox"/>	<u>Class D</u> <input checked="" type="checkbox"/>
<u>Criteria</u>	<u>On NHS or SHS</u>	<u>>\$10M Construction Cost</u>	<u>with Bridge Components</u>	<u>Off-System, no bridges</u>
<u>Specs/Material Testing</u>	<u>FDOT</u>	<u>FDOT</u>	<u>FDOT Struct and LAP Big 4</u>	<u>LAP Big 4</u>

Pre-Construction - Contract Review (to be conducted before the pre-construction meeting)

	<u>Topic</u>	<u>Reference</u>	<u>Activity</u>	<u>Y</u>	<u>N</u>	<u>N/A</u>	<u>Comments</u>
1	Specifications	LAP Manual Chapter 20.3	Are the correct specifications included as part of the executed contract?	<input checked="" type="checkbox"/>	<input type="checkbox"/>	<input type="checkbox"/>	Project is a Class D, FDOT 2016 Standard Specs as modified by Contract Documents to include "Big 4 Specs".
2	Contract Plans	LAP Manual Chapter 20.2	Is a complete set of signed and sealed construction plans available?	<input checked="" type="checkbox"/>	<input type="checkbox"/>	<input type="checkbox"/>	Verified
3	Buy America	LAP Manual Chapter 22.7.1	Have Buy America requirements been included in the Contract?	<input checked="" type="checkbox"/>	<input type="checkbox"/>	<input type="checkbox"/>	Exhibit A - #1.1, #1.4 and Exhibit D (Form) 70 of 85 and FDOT Division 1 Specs.
4	Liquidated Damages	LAP Manual Chapter 23.8	Have Liquidated Damages terms and conditions been established in the contract? Daily rates?	<input checked="" type="checkbox"/>	<input type="checkbox"/>	<input type="checkbox"/>	Article 7, Page 3 of 85 and Page 11 of 85.
5	Change Orders	LAP Manual Chapter 23.5	Did the LA develop change order procedures and include them in the contract?	<input checked="" type="checkbox"/>	<input type="checkbox"/>	<input type="checkbox"/>	Article 8 and Article 13.
6	Progress Payments	LAP Manual Chapter 23.4	Did the LA develop contract language to ensure that payments are based on work completed?	<input checked="" type="checkbox"/>	<input type="checkbox"/>	<input type="checkbox"/>	Article 5

Contract Review general comments :

Pre-Construction - to be discussed at the Pre-construction meeting

	<u>Topic</u>	<u>Reference</u>	<u>Activity</u>	<u>Y</u>	<u>N</u>	<u>N/A</u>	<u>Comments</u>

Local Agency Program (LAP) Construction Contract Administration Audit Form

<u>FM INo. & FAP No.</u>	<u>Martin County / RFB2020-3190</u>	<u>Local Agency (LA)</u>	<u>Project Name/location</u>	<u>Audit Type</u>	<u>Auditor and Audit Date</u>
			<u>Savanna Road Resurfacing - Jensen Beach</u>	<u>Interim 1</u>	<u>Frank White 8/3/2020 (Invoice 2)</u>
7	Audit Procedures	LAP Manual Section 23.3 LAP Memorandum 3-11.	Has the LA been briefed on the Audit process including this form? Review Audit Process and form with LA	<input checked="" type="checkbox"/>	<input type="checkbox"/> <input type="checkbox"/> <input type="checkbox"/> Discussed at the Pre-construction Meeting; and performed this initial Audit Review with the LA.
8	Stockpiled Materials	LAP Manual Chapter 23.4 CPAM 9-5.5.1	Are there any pay items in the contract that the LA Plans to pay for as stock piled materials? If yes, review requirement with agency	<input type="checkbox"/>	<input checked="" type="checkbox"/> <input type="checkbox"/> The LA does not expect a request for Stockpiled Materials payments
9	Environmental	LAP Manual Chapter 11	Has the LA been briefed on their obligation to comply with NEPA? Direct the LA to Review LAP Manual Chapter 11	<input checked="" type="checkbox"/>	<input type="checkbox"/> <input type="checkbox"/> Discussed at the May 13, 2020 pre-construction meeting as shown on page 4 of 15 under Pollution and Erosion Control.
10	ADA	LAP Manual Chapter 4	Has the LA been briefed on their obligation to comply with ADA standards? Direct the LA to Review LAP Manual Chapter 4	<input checked="" type="checkbox"/>	<input type="checkbox"/> <input type="checkbox"/> Agency and Contractor are aware of their ADA responsibility.
11	Change Orders	LAP Manual Chapter 23.5	Has the LA been briefed on the Change Order procedures? Review Change Order procedure with LA	<input checked="" type="checkbox"/>	<input type="checkbox"/> <input type="checkbox"/> Explained the additional FDOT requirements, including the FDOT approval.
12	Reimbursement	23 CFR 635.127	Has the LA been briefed on the Reimbursement procedures? Review Reimbursement procedure with LA	<input checked="" type="checkbox"/>	<input type="checkbox"/> <input type="checkbox"/> LA is very familiar with the FDOT Reimbursement procedure and requirements
13	Closure	LAP Manual Chapter 23.10	Has the LA been briefed on the Closeout process and what documents will be required of them? Review Closeout process with LA.	<input checked="" type="checkbox"/>	<input type="checkbox"/> <input type="checkbox"/> Kim McLaughlin has closed previous LAP projects with Treasure Coast Opps and is very familiar with the process.
14	LAPIT	LAP Manual 2.8	Who will be responsible for uploading documents into LAPIT? Review LAPIT Document Guide with LA.	<input checked="" type="checkbox"/>	<input type="checkbox"/> <input type="checkbox"/> Kim McLaughlin at email: kmclaugh@martin.fl.us Phone: (772) 288-5777

Pre-Construction Audit comments :

Local Agency Program (LAP) Construction Contract Administration Audit Form

FM No. & FAP No.	438342-1-58-01 / 419-041-B	Local Agency (LA)	Project Name/Location	Audit Type
		Martin County / RFB2020-3190	Savanna Road Resurfacing - Jensen Beach	Interim 1

Interim/Final Audit - to be conducted after the start of construction.

General Compliance and Considerations

Topic	Reference	Activity	Y	N	N/A	Comments
15 Reimbursements	LAP Manual Chapter 23.4	Have reimbursements been submitted at least quarterly as required?	<input checked="" type="checkbox"/>	<input type="checkbox"/>	<input type="checkbox"/>	Reimbursement invoices No. 1 was processed and was submitted for review and concurrence.
16 Change Orders	LAP Manual Chapter 23.5	Have there been any change orders to date?	<input checked="" type="checkbox"/>	<input type="checkbox"/>	<input type="checkbox"/>	No change orders to date.
		Has all documentation been submitted to FDOT for approval?	<input checked="" type="checkbox"/>	<input type="checkbox"/>	<input type="checkbox"/>	No change orders to date.
17 Schedule	LAP Manual Chapter 23.5	Has any time been added to the construction contract through approved change orders? How many days? What is the new contract end date?	<input checked="" type="checkbox"/>	<input type="checkbox"/>	<input type="checkbox"/>	No contract days added to date.
		Is it reasonable to assume that construction activities will be completed before the LAP expiration Date? If No, then coordinate with District.	<input checked="" type="checkbox"/>	<input type="checkbox"/>	<input type="checkbox"/>	Yes.
18 Buy America	LAP Manual Chapter 22.7.1	Are Buy America certifications available for all steel and iron used on the project?	<input checked="" type="checkbox"/>	<input type="checkbox"/>	<input type="checkbox"/>	No Steel invoiced or installed to date.
19 Daily Reports	LAP Manual Chapter 23	Have daily reports been made available for the work completed to date?	<input checked="" type="checkbox"/>	<input type="checkbox"/>	<input type="checkbox"/>	Dailies have been sent to the Resident Compliance Specialist and uploaded in LAPIT.
20 LAPIT	LAPIT Document Guide	Is LAPIT current with the requirements? Refer to the LAPIT document guide.	<input checked="" type="checkbox"/>	<input type="checkbox"/>	<input type="checkbox"/>	Agency has uploaded required documents as available to date.
21 Other considerations	LAP Manual	Are there any other areas of concern?	<input type="checkbox"/>	<input checked="" type="checkbox"/>	<input type="checkbox"/>	

Interim Audit General Comments :

Local Agency Program (LAP) Construction Contract Administration Audit Form

<u>FM No.</u>	&	<u>FAP No.</u>
438342-1-58-01 / 419-041-B		Martin County / RFB2020-3190

Construction Compliance

Reference	Activity	Audit Type			Comments
		Y	N	N/A	
22 LAP Specifications Chapter 334	FDOT's Construction Project Administration Manual (CPAM) 11.1.4 states the following are required on tickets - Financial Project ID Number, contract number, date and time, mix design, material, ticket number, Asphalt company name and address, truck number, load number, Gross, Tare and Net Weight in Tons, plant number, total accumulated daily quantity and the hand-written temperature	Are Asphalt tickets available and have they been completed in accordance with requirements?	<input type="checkbox"/>	<input checked="" type="checkbox"/>	No asphalt placed todate.
23 LAP Specification Section 334-3	Does asphalt provided match approved mix design?	<input type="checkbox"/>	<input checked="" type="checkbox"/>	<input type="checkbox"/>	No asphalt placed todate.
24 LAP Specification Section 334-5.10	Was documentation provided that indicates that the LA checked for adequate surface conditions?	<input type="checkbox"/>	<input checked="" type="checkbox"/>	<input type="checkbox"/>	No asphalt placed todate.
25 LAP Specification Section 334-6.3.1	Has documentation of process control and acceptance testing (densities, etc.) been completed and provided by the contractor for category 2 and 3?	<input type="checkbox"/>	<input checked="" type="checkbox"/>	<input type="checkbox"/>	No asphalt placed todate.
26 LAP Specification Section 334-6.3	Or was the mixture accepted based on visual observation if less than 500 tons?	<input type="checkbox"/>	<input checked="" type="checkbox"/>	<input type="checkbox"/>	No asphalt placed todate.
27 LAP Specification Section 334-7 and 8	Was documentation provided that indicates that the LA can support the quantity of asphalt paid? <i>Review recent pay application.</i>	<input type="checkbox"/>	<input checked="" type="checkbox"/>	<input type="checkbox"/>	No asphalt placed todate.

Local Agency Program (LAP) Construction Contract Administration Audit Form

<u>FM No.</u>	<u>& FAP No.</u>	<u>Martin County / RFB2020-3190</u>	<u>Project Name/Location</u>	<u>Audit Type</u>	<u>Auditor and Audit Date</u>
438342-1-58-01 / 419-041-B		Savanna Road Resurfacing - Jensen Beach	Interim 1	Frank White	8/3/2020 (Invoice 2)

Construction Compliance (continued)

<u>Concrete</u>	<input checked="" type="checkbox"/> Yes <input type="checkbox"/> No	<input type="checkbox"/> LAP Specifications Chapter 344	<input checked="" type="checkbox"/> Category 1: Sidewalks, curb and gutter, ditch and slope pavement, or non-reinforced cast-in-place concrete <input type="checkbox"/> Category 2: Precast concrete - barriers, inlets, manholes, junction boxes, culverts, etc. <input type="checkbox"/> Category 3: Structural cast-in-place concrete
-----------------	---	---	--

Reference	Activity	Y	N	N/A	Comments
28 LAP Specification Section 344-3.1.1	Is Concrete produced from National Ready-Mixed Concrete Association (NRMCA) or on the list of FDOT non-structural concrete producers?	<input type="checkbox"/>	<input type="checkbox"/>	<input checked="" type="checkbox"/>	No Concrete to date.
29 LAP Specification Section 344-3.1.2	For Category 2, Is produced at a prestressed and/or precast facility listed on the FDOT Producers with Accepted QC Programs for precast or prestressed concrete?	<input type="checkbox"/>	<input type="checkbox"/>	<input checked="" type="checkbox"/>	No Concrete to date.
30 LAP Specification Section 344-3.1.3	For Category 3, Is produced at a structural concrete facility listed on the FDOT Producers with Accepted QC Programs for structural concrete?	<input type="checkbox"/>	<input type="checkbox"/>	<input checked="" type="checkbox"/>	No Concrete to date.
31 LAP Specification Section 344-3.3	For Category 3, has the Contractor furnish a Quality Control (QC) plan to identify to the Engineer for their approval?	<input type="checkbox"/>	<input type="checkbox"/>	<input checked="" type="checkbox"/>	No Concrete to date.
32 LAP Specification Section 344-3.4	For Category 1 or Category 2, has the Contractor submitted the proposed mix designs to the Engineer on a form provided by the Engineer?	<input type="checkbox"/>	<input type="checkbox"/>	<input checked="" type="checkbox"/>	No Concrete to date.
33 LAP Specification Section 344-3.4	For Category 3, submit to the Engineer for approval, FDOT approved mix designs?	<input type="checkbox"/>	<input type="checkbox"/>	<input checked="" type="checkbox"/>	No Concrete to date.
34 LAP Specification Section 344-3.5	For Cat 1 and 3, are delivery tickets available, and do they indicate the date, producer, quantity and mix, and have they been signed by both batcher and contractor?	<input type="checkbox"/>	<input type="checkbox"/>	<input checked="" type="checkbox"/>	No Concrete to date.
35 LAP Specification Section 344	Was adequate oversight of concrete activities performed to reasonably ensure compliance with general construction requirements?	<input type="checkbox"/>	<input type="checkbox"/>	<input checked="" type="checkbox"/>	No Concrete to date.
36 LAP Specification Section 344-3.9	Have concrete cylinders been tested to determine compliance with design compressive strength?	<input type="checkbox"/>	<input type="checkbox"/>	<input checked="" type="checkbox"/>	No Concrete to date.
37 LAP Specification Section 344-5 and 6	Is there adequate support of the quantities paid?	<input type="checkbox"/>	<input type="checkbox"/>	<input checked="" type="checkbox"/>	No Concrete to date.

Local Agency Program (LAP) Construction Contract Administration Audit Form

<u>FIM No.</u>	<u>& FAP No.</u>	<u>Local Agency (LA)</u>	<u>Project Name/Location</u>	<u>Audit Type</u>	<u>Auditor and Audit Date</u>
438342-1-58-01 / 419-041-B		Martin County / RFB2020-3190	Savanna Road Resurfacing - Jansen Beach	Interim 1	Frank White 8/3/2020 (Invoice 2)

Construction Compliance (continued)

Reference	Activity	Y	N	N/A	Comments
38 LAP Specification Section 120	Are Density Log Books/Reports on file?	<input checked="" type="checkbox"/>	<input type="checkbox"/>	<input type="checkbox"/>	
39 LAP Specification Section 120	Are Proctors Documented?	<input checked="" type="checkbox"/>	<input type="checkbox"/>	<input type="checkbox"/>	Documentation on file to verify compliance.
40 LAP Specification Section 120	Are Soil Classifications Documented?	<input type="checkbox"/>	<input checked="" type="checkbox"/>	<input type="checkbox"/>	
41 LAP Specification Section 120	Is there adequate support of the quantities paid?	<input checked="" type="checkbox"/>	<input type="checkbox"/>	<input type="checkbox"/>	Documentation on file to verify compliance.

Construction Compliance - Other Work Types

Work Type	Activity	Y	N	N/A	Comments
42 Landscaping		<input type="checkbox"/>	<input checked="" type="checkbox"/>	<input type="checkbox"/>	
43 Lighting		<input type="checkbox"/>	<input checked="" type="checkbox"/>	<input type="checkbox"/>	
44 Signalization	How are quantities tracked? Is there adequate support of the quantities paid?	<input type="checkbox"/>	<input checked="" type="checkbox"/>	<input type="checkbox"/>	
45 Guardrail		<input type="checkbox"/>	<input checked="" type="checkbox"/>	<input type="checkbox"/>	
46 Signage		<input type="checkbox"/>	<input checked="" type="checkbox"/>	<input type="checkbox"/>	
47 Sodding		<input checked="" type="checkbox"/>	<input type="checkbox"/>	<input type="checkbox"/>	Quantities back up with delivery tickets.

Construction Compliance Comments :

--

<u>FM No.</u>	&	<u>FAP No.</u>		<u>Local Agency (LA)</u>	<u>Project Name/location</u>	<u>Audit Type</u>	<u>Auditor and Audit Date</u>
438342-1-58-01 / 419-041-B				Martin County / RFB2020-3190	Savanna Road Resurfacing - Jensen Beach	Interim 1	Frank White 8/3/2020 (Invoice 2)

Final Audit - to be conducted after construction has been completed

	Topic	Reference	Activity	Y	N	N/A	Comments
48	Project Acceptance	LAP Manual Chapter 23.10	Was a pre-final and final walkthrough conducted? List dates.	<input type="checkbox"/>	<input type="checkbox"/>	<input checked="" type="checkbox"/>	
49	Project Acceptance	LAP Manual Chapter 23.10	Was a punch-list generated at the Final walkthrough and were all items corrected prior to final acceptance?	<input type="checkbox"/>	<input type="checkbox"/>	<input checked="" type="checkbox"/>	
50	As-built	LAP Manual Chapter 23.10	Were final as-built plans completed and submitted for on-system projects?	<input type="checkbox"/>	<input type="checkbox"/>	<input checked="" type="checkbox"/>	
51	Close-out documentation	LAP Manual Chapter 23.10	Have close-out documents been provided for review and acceptance by FDOT?	<input type="checkbox"/>	<input type="checkbox"/>	<input checked="" type="checkbox"/>	
52	Reimbursements	LAP Manual Chapter 23.10	Has a final reimbursement request been prepared and submitted to FDOT?	<input type="checkbox"/>	<input type="checkbox"/>	<input checked="" type="checkbox"/>	
53	LAPIT	LAP Manual Chapter 23.10	Have all construction documents been uploaded into LAPIT. Refer to the LAPIT document guide.	<input type="checkbox"/>	<input type="checkbox"/>	<input checked="" type="checkbox"/>	

Final Audit Comments :

Note: Due to the Covid 19 Virus guidelines, the normal in person audit, was done remotely by phone, emails and file attachments for back up documentation. documents will be preserved for future reference.

All back up

CONTINUATION SHEET

AIA Document G705, APPLICATION AND CERTIFICATE FOR PAYMENT:

Contractor's signed Certification is attached.

In tabular form below, amounts are stated to the nearest \$100.

The Column for Contracts where variable remuneration for the license may apply.

AIA DOCUMENT G705 (Instructions on reverse side)

APPLICATION NO. 2
APPLICATION DATE 2/7/2020
PERIOD TO 3-1-2020

CONTRACT NO:

PROJECT NO:

BALANCE

TO
FEB
2020

%
(G/C)

BALANCE
REMAINING
(F/E VARIABLE
RATES)

10%

ITEM NO.	DESCRIPTION OF WORK	ORIGINAL CONTRACT			PREVIOUS			CURRENT			MATERIALS PRESENTLY STORED (NOT IN E OR F)			COMPLETED AND STORED TO DATE QTY / AMOUNT (D+E+F)			BALANCE TO FEB 2020 (G/C)		
		Unit Qty	Unit Price	Amount	QTY	Amount	QTY	QTY	Amount	QTY	Amount	QTY	Amount	QTY	Amount	QTY	Amount	QTY	Amount
1 Base																			
1 MOBILIZATION	L 50' TIEDOWN S 100' TIEBACK S	0.25	\$25,970.00	\$2,500.00				0.25	\$25,970.00			0.50	\$3,470.00			0.50	\$3,470.00		
2 Price Point Construction Values	L 50' TIEDOWN S 100' TIEBACK S	0.50	\$1,850.00	\$2,500.00	0.50	\$2,500.00		0.50	\$1,850.00			0.50	\$3,470.00			0.50	\$3,470.00		
3 CONSTRUCTION LAYOUT & AS-BUILT SURVEY	L 50' TIEDOWN S 100' TIEBACK S	0.50	\$2,500.00	\$2,500.00	0.25	\$1,250.00		0.25	\$1,250.00			0.50	\$3,470.00			0.50	\$3,470.00		
4 MAINTENANCE ON TRAFFIC	L 50' TIEDOWN S 100' TIEBACK S	0.50	\$1,850.00	\$2,500.00	0.50	\$2,500.00		0.50	\$1,850.00			0.50	\$3,470.00			0.50	\$3,470.00		
5 EROSION CONTROL, SILT FENCE TYPE II	L 50' TIEDOWN S 100' TIEBACK S	0.50	\$1,850.00	\$2,500.00	0.25	\$1,250.00		0.25	\$1,250.00			0.50	\$3,470.00			0.50	\$3,470.00		
6 CLEANING AND GRUBBING	L 50' TIEDOWN S 100' TIEBACK S	0.50	\$1,850.00	\$2,500.00	0.25	\$1,250.00		0.25	\$1,250.00			0.50	\$3,470.00			0.50	\$3,470.00		
7 REGULAR EXCAVATION	L 50' TIEDOWN S 100' TIEBACK S	0.50	\$1,850.00	\$2,500.00	0.25	\$1,250.00		0.25	\$1,250.00			0.50	\$3,470.00			0.50	\$3,470.00		
8 OPTIONAL BASE, BASE GROUP I	L 50' TIEDOWN S 100' TIEBACK S	0.50	\$1,850.00	\$2,500.00	0.25	\$1,250.00		0.25	\$1,250.00			0.50	\$3,470.00			0.50	\$3,470.00		
9 OPTIONAL BASE, BASE GROUP I-C, COUSIDA	L 50' TIEDOWN S 100' TIEBACK S	0.50	\$1,850.00	\$2,500.00	0.25	\$1,250.00		0.25	\$1,250.00			0.50	\$3,470.00			0.50	\$3,470.00		
10 OPTIONAL EARTH ANCHOR PAINT, 1' NAILER, 125' AVG DEPTH	L 50' TIEDOWN S 100' TIEBACK S	0.50	\$1,850.00	\$2,500.00	0.25	\$1,250.00		0.25	\$1,250.00			0.50	\$3,470.00			0.50	\$3,470.00		
11 TYPED EARTH ANCHOR PAINT, 1' NAILER, 125' AVG DEPTH	L 50' TIEDOWN S 100' TIEBACK S	0.50	\$1,850.00	\$2,500.00	0.25	\$1,250.00		0.25	\$1,250.00			0.50	\$3,470.00			0.50	\$3,470.00		
12 SP-12.5 ASPHALT CONCRETE, 4" THICK, 12' X 12' TILES	L 50' TIEDOWN S 100' TIEBACK S	0.50	\$1,850.00	\$2,500.00	0.25	\$1,250.00		0.25	\$1,250.00			0.50	\$3,470.00			0.50	\$3,470.00		
13 CONCRETE SIDEWALK, 4"	L 50' TIEDOWN S 100' TIEBACK S	0.50	\$1,850.00	\$2,500.00	0.25	\$1,250.00		0.25	\$1,250.00			0.50	\$3,470.00			0.50	\$3,470.00		
14 CONCRETE SIDEWALK, 6"	L 50' TIEDOWN S 100' TIEBACK S	0.50	\$1,850.00	\$2,500.00	0.25	\$1,250.00		0.25	\$1,250.00			0.50	\$3,470.00			0.50	\$3,470.00		
15 SCOURING	L 50' TIEDOWN S 100' TIEBACK S	0.50	\$1,850.00	\$2,500.00	0.25	\$1,250.00		0.25	\$1,250.00			0.50	\$3,470.00			0.50	\$3,470.00		
16 BANKMENT	L 50' TIEDOWN S 100' TIEBACK S	0.50	\$1,850.00	\$2,500.00	0.25	\$1,250.00		0.25	\$1,250.00			0.50	\$3,470.00			0.50	\$3,470.00		
17 RELOCATE FIRE HYDRANT	L 50' TIEDOWN S 100' TIEBACK S	0.50	\$1,850.00	\$2,500.00	0.25	\$1,250.00		0.25	\$1,250.00			0.50	\$3,470.00			0.50	\$3,470.00		
18 SIGNING AND STRIPPING	L 50' TIEDOWN S 100' TIEBACK S	0.50	\$1,850.00	\$2,500.00	0.25	\$1,250.00		0.25	\$1,250.00			0.50	\$3,470.00			0.50	\$3,470.00		
19 RETROGRADE STICKER, PAVERAEST MARKERS	L 50' TIEDOWN S 100' TIEBACK S	0.50	\$1,850.00	\$2,500.00	0.25	\$1,250.00		0.25	\$1,250.00			0.50	\$3,470.00			0.50	\$3,470.00		
20 THERMOPLASTIC, STANDARD, WHITE, SOLID, 12"	L 50' TIEDOWN S 100' TIEBACK S	0.50	\$1,850.00	\$2,500.00	0.25	\$1,250.00		0.25	\$1,250.00			0.50	\$3,470.00			0.50	\$3,470.00		
21 THERMOPLASTIC, STANDARD, WHITE, SOLID, 12"	L 50' TIEDOWN S 100' TIEBACK S	0.50	\$1,850.00	\$2,500.00	0.25	\$1,250.00		0.25	\$1,250.00			0.50	\$3,470.00			0.50	\$3,470.00		
22 THERMOPLASTIC, STANDARD, WHITE, SOLID, 12"	L 50' TIEDOWN S 100' TIEBACK S	0.50	\$1,850.00	\$2,500.00	0.25	\$1,250.00		0.25	\$1,250.00			0.50	\$3,470.00			0.50	\$3,470.00		
23 THERMOPLASTIC, STANDARD, WHITE, SOLID, 12"	L 50' TIEDOWN S 100' TIEBACK S	0.50	\$1,850.00	\$2,500.00	0.25	\$1,250.00		0.25	\$1,250.00			0.50	\$3,470.00			0.50	\$3,470.00		
24 THERMOPLASTIC, STANDARD, WHITE, SOLID, 12"	L 50' TIEDOWN S 100' TIEBACK S	0.50	\$1,850.00	\$2,500.00	0.25	\$1,250.00		0.25	\$1,250.00			0.50	\$3,470.00			0.50	\$3,470.00		
25 SINGLE POST SIGNS, FEED (GROUND) & LEFT TURN PORTS	L 50' TIEDOWN S 100' TIEBACK S	0.50	\$1,850.00	\$2,500.00	0.25	\$1,250.00		0.25	\$1,250.00			0.50	\$3,470.00			0.50	\$3,470.00		
31 REPLACE TYPE C DOORS, 6'x8'-2" x 13'-0"	L 50' TIEDOWN S 100' TIEBACK S	0.50	\$1,850.00	\$2,500.00	0.25	\$1,250.00		0.25	\$1,250.00			0.50	\$3,470.00			0.50	\$3,470.00		
Total Original Contract																			
Adjustments by Change Order																			
Subtotal Change Orders																			
Total Contract Amount																			

G705

AIA DOCUMENT G705 - CONTRACTION SHEET FOR G705 - 1972 EDITION - AIA - 1982 - THE AMERICAN INSTITUTE OF ARCHITECTS, INC., NEW YORK, NY. © 1972, AMERICAN INSTITUTE OF ARCHITECTS, INC. ALL RIGHTS RESERVED. THIS DOCUMENT IS PROVIDED FOR INFORMATION PURPOSES ONLY AND IS NOT A CONTRACT DOCUMENT.

ARCHITECTS, INC., NEW YORK, NY. © 1972, AMERICAN INSTITUTE OF ARCHITECTS, INC. ALL RIGHTS RESERVED. THIS DOCUMENT IS PROVIDED FOR INFORMATION PURPOSES ONLY AND IS NOT A CONTRACT DOCUMENT.

AVENUE, N.W., WASHINGTON, D.C. 20060-2232. WARNING: This document is copyrighted material and shall not be reproduced or distributed without the written consent of the copyright owner.

AVENUE, N.W., WASHINGTON, D.C. 20060-2232. WARNING: This document is copyrighted material and shall not be reproduced or distributed without the written consent of the copyright owner.

Local Agency Program (LAP) Construction Contract Administration Audit Form

<u>FM No. & FAP No.</u>	<u>Martin County / RFB2020-3190</u>	<u>Local Agency (LA)</u>	<u>Project Name/Location</u>	<u>Audit Type</u>
<u>438342-1-58-01 / 419-041-B</u>			<u>Savanna Road Resurfacing - Jensen Beach</u>	<u>Final</u>

General Information

<u>FDOT PM</u>	<u>Chloann Lawrence</u>	<u>LA Responsible Charge</u>	<u>LA Advertisement Date</u>	<u>Local Agency NTP Date</u>	<u>Original LAP Agreement Amount</u>
<u>FDOT LAP Number and Expiration Date</u>	<u>12/31/2021</u>	<u>LA Project Manager and Contact #</u>	<u>Award Date</u>	<u>Contract Start Date</u>	<u>Final LAP Agreement Amount</u>
<u>FDOT NTP Date</u>	<u>11/8/2019</u>	<u>Kimberly McLaughlin</u>	<u>3/4/2020</u>	<u>6/1/2020</u>	<u>\$1,193,763.00</u>
<u>FDOT Bid Concurrence Date</u>	<u>11/8/2020</u>	<u>CEI Consultant</u>	<u>Execution Date</u>	<u>Original Contract Days</u>	<u>Original Construction Amount</u>
		<u>N/A</u>	<u>3/24/2020</u>	<u>190</u>	<u>\$1,046,885.65</u>
		<u>Contactor</u>	<u>Preconstruction Date</u>	<u>Final Contract Days</u>	<u>Final Construction Amount</u>
		<u>Community Asphalt Corp.</u>	<u>5/8/2020</u>	<u>190</u>	<u>\$1,079,969.51</u>

Project Classification - Refer to Chapter 19 of the Local Area Program Manual (check only one, work left to right)

<u>Class</u>	<u>Class A</u>	<u>Class B</u>	<u>Class C</u>	<u>Class D</u>
<u>Criteria</u>	<u>On NHS or SHS</u>	<u>>\$10M Construction Cost with Bridge components</u>	<u>Off-System, no bridges</u>	<input checked="" type="checkbox"/>
<u>Specs/Material Testing</u>	<u>FDOT</u>	<u>FDOT Struct and LAP Big 4</u>	<u>LAP Big 4</u>	

Pre-Construction - Contract Review (to be conducted before the pre-construction meeting)

	<u>Topic</u>	<u>Reference</u>	<u>Activity</u>	<u>Y</u>	<u>N</u>	<u>N/A</u>	<u>Comments</u>
1	<u>Specifications</u>	<u>LAP Manual Chapter 20.3</u>	<u>Are the correct specifications included as part of the executed contract?</u>	<input checked="" type="checkbox"/>	<input type="checkbox"/>	<input type="checkbox"/>	<u>Project is a Class D, FDOT 2016 Standard Specs as modified by Contract Documents to include "Big 4 Specs".</u>
2	<u>Contract Plans</u>	<u>LAP Manual Chapter 20.2</u>	<u>Is a complete set of signed and sealed construction plans available?</u>	<input checked="" type="checkbox"/>	<input type="checkbox"/>	<input type="checkbox"/>	<u>Verified</u>
3	<u>Buy America</u>	<u>LAP Manual Chapter 22.7.1</u>	<u>Have Buy America requirements been included in the Contract?</u>	<input checked="" type="checkbox"/>	<input type="checkbox"/>	<input type="checkbox"/>	<u>Exhibit A - #11, #14 and Exhibit D (Form) 70 of 85 and FDOT Division 1 Specs.</u>
4	<u>Liquidated Damages</u>	<u>LAP Manual Chapter 23.8</u>	<u>Have Liquidated Damages terms and conditions been established in the contract? Daily rates?</u>	<input checked="" type="checkbox"/>	<input type="checkbox"/>	<input type="checkbox"/>	<u>Article 7, Page 3 of 85 and Page 11 of 85.</u>
5	<u>Change Orders</u>	<u>LAP Manual Chapter 23.5</u>	<u>Did the LA develop change order procedures and include them in the contract?</u>	<input checked="" type="checkbox"/>	<input type="checkbox"/>	<input type="checkbox"/>	<u>Article 8 and Article 13.</u>
6	<u>Progress Payments</u>	<u>LAP Manual Chapter 23.4</u>	<u>Did the LA develop contract language to ensure that payments are based on work completed?</u>	<input checked="" type="checkbox"/>	<input type="checkbox"/>	<input type="checkbox"/>	<u>Article 5</u>

Contract Review general comments :

Pre-Construction - to be discussed at the Pre-construction meeting

<u>Topic</u>	<u>Reference</u>	<u>Activity</u>	<u>Y</u>	<u>N</u>	<u>N/A</u>	<u>Comments</u>

Local Agency Program (LAP) Construction Contract Administration Audit Form

<u>FM No.</u>	<u>&</u>	<u>FAP No.</u>	<u>Local Agency (LA)</u>	<u>Project Name/Location</u>	<u>Audit Type</u>	<u>Auditor and Audit Date</u>
438342-1-58-01 / 419-041-B		Martin County / RFB2020-3190	Savanna Road Resurfacing - Jensen Beach	Final		Frank White 5/7/21 (Invoice No. 7 FINAL)
7	Audit Procedures	LAP Manual Section 23.3 LAP Memorandum 3-11.	Has the LA been briefed on the Audit process including this form? Review Audit Process and form with LA	<input checked="" type="checkbox"/>	<input type="checkbox"/>	Discussed at the Pre-construction Meeting; and performed this initial Audit Review with the LA.
8	Stockpiled Materials	LAP Manual Chapter 23.4 CPAM 9-5.5.1	Are there any pay items in the contract that the LA Plans to pay for as stock piled materials? If Yes, review requirement with agency	<input type="checkbox"/>	<input checked="" type="checkbox"/>	The LA does not expect a request for Stockpiled Materials payments
9	Environmental	LAP Manual Chapter 11	Has the LA been briefed on their obligation to comply with NEPA? Direct the LA to Review LAP Manual Chapter 11	<input checked="" type="checkbox"/>	<input type="checkbox"/>	Discussed at the May 13, 2020 pre-construction meeting as shown on page 4 of 15 under Pollution and Erosion Control.
10	ADA	LAP Manual Chapter 4	Has the LA been briefed on their obligation to comply with ADA standards? Direct the LA to Review LAP Manual Chapter 4	<input checked="" type="checkbox"/>	<input type="checkbox"/>	Agency and Contractor are aware of their ADA responsibility.
11	Change Orders	LAP Manual Chapter 23.5	Has the LA been briefed on the Change Order procedures? Review Change Order procedure with LA	<input checked="" type="checkbox"/>	<input type="checkbox"/>	Explained the additional FDOT requirements, including the FDOT approval.
12	Reimbursements	23 CFR 635.127	Has the LA been briefed on the Reimbursement procedures? Review Reimbursement procedure with LA	<input checked="" type="checkbox"/>	<input type="checkbox"/>	LA is very familiar with the FDOT Reimbursement procedure and requirements
13	Closure	LAP Manual Chapter 23.10	Has the LA been briefed on the Closeout process and what documents will be required of them? Review Closeout process with LA.	<input checked="" type="checkbox"/>	<input type="checkbox"/>	Kim McLaughlin has closed previous LAP projects with Treasure Coast Opps and is very familiar with the process.
14	LAPIT	LAP Manual 2.8	Who will be responsible for uploading documents into LAPIT? Review LAPIT Document Guide with LA.	<input checked="" type="checkbox"/>	<input type="checkbox"/>	Kim McLaughlin at email: kmclaughlin@martin.fl.us Phone: (772) 288-5777

Pre-Construction Audit comments :

Local Agency Program (LAP) Construction Contract Administration Audit Form

<u>FM No.</u> & <u>FAP No.</u>	<u>438342-1-58-01 / 419-041-B</u>	<u>Local Agency (LA)</u>	<u>Martin County / RFB2020-3190</u>	<u>Project Name/location</u>	<u>Savanna Road Resurfacing - Jensen Beach</u>	<u>Audit Type</u>	<u>Final</u>	<u>Auditor and Audit Date</u>	<u>Frank White 5/7/21 (Invoice No. 7 FINAL)</u>
--------------------------------	-----------------------------------	--------------------------	-------------------------------------	------------------------------	--	-------------------	--------------	-------------------------------	---

Interim/Final Audit - to be conducted after the start of construction.

General Compliance and Considerations

	Topic	Reference	Activity	Y	N	N/A	Comments
15	Reimbursements	LAP Manual Chapter 23.4	Have reimbursements been submitted at least quarterly as required?	<input checked="" type="checkbox"/>	<input type="checkbox"/>	<input type="checkbox"/>	There have been two reimbursement invoices processed with only the final to be submitted for review and concurrence.
16	Change Orders	LAP Manual Chapter 23.5	Have there been any change orders to date?	<input checked="" type="checkbox"/>	<input type="checkbox"/>	<input type="checkbox"/>	Change Order No. 1 was a Final True-up and addes 10 Days
			Has all documentation been submitted to FDOT for approval?	<input checked="" type="checkbox"/>	<input type="checkbox"/>	<input type="checkbox"/>	Change Order No 1, Final True-up was submitted to District with back up for approval.
17	Schedule	LAP Manual Chapter 23.5	Has any time been added to the construction contract through approved change orders? How many days? What is the new contract end date? Is it reasonable to assume that construction activities will be completed before the LAP expiration Date? If No, then coordinate with District.	<input checked="" type="checkbox"/>	<input type="checkbox"/>	<input type="checkbox"/>	A total of 10 days were added by CO No. 1 (True-up). The original contract time was180 days. Final Acceptance 9/11/20. Final acceptance on 9/11/20 at 160 of 180 contract days.
18	Buy America	LAP Manual Chapter 22.7.1	Are Buy America certifications available for all steel and iron used on the project?	<input checked="" type="checkbox"/>	<input type="checkbox"/>	<input type="checkbox"/>	BA certs were verified for reinforcement; endwall, inlets and RCP drainage pipe.
19	Daily Reports	LAP Manual Chapter 23	Have daily reports been made available for the work completed to date?	<input checked="" type="checkbox"/>	<input type="checkbox"/>	<input type="checkbox"/>	Dailies have been sent to the Resident Compliance Specialist and uploaded in LAPIT.
20	LAPIT	LAPIT Document Guide	Is LAPIT current with the requirements? Refer to the LAPIT document guide.	<input checked="" type="checkbox"/>	<input type="checkbox"/>	<input type="checkbox"/>	Agency has uploaded required documents as available to date.
21	Other considerations	LAP Manual	Are there any other areas of concern?	<input type="checkbox"/>	<input checked="" type="checkbox"/>	<input type="checkbox"/>	

Interim Audit General Comments :

--

Local Agency Program (LAP) Construction Contract Administration Audit Form

<u>FM No.</u>	&	<u>FAP No.</u>
438342-1-58-01 / 419-041-B		<u>Local Agency (LA)</u>
		Martin County / RFB2020-3190

Construction Compliance

Reference	Activity	Audit Type			Comments
		Y	N	N/A	
22 LAP Specifications Chapter 334	Are Asphalt tickets available and have they been completed in accordance with requirements?				
23 LAP Specification Section 334-3	Does asphalt provided match approved mix design?	<input checked="" type="checkbox"/>	<input type="checkbox"/>	<input type="checkbox"/>	Verified at random, SP 16-14509A (TL-C)
24 LAP Specification Section 334-5.10	Was documentation provided that indicates that the LA checked for adequate surface conditions?	<input checked="" type="checkbox"/>	<input type="checkbox"/>	<input type="checkbox"/>	
25 LAP Specification Section 334-6.3.1	Has documentation of process control and acceptance testing (densities, etc.) been completed and provided by the contractor for category 2 and 3?	<input checked="" type="checkbox"/>	<input type="checkbox"/>	<input type="checkbox"/>	Approved QC Plan on file
26 LAP Specification Section 334-6.3	Or was the mixture accepted based on visual observation if less than 500 tons?	<input type="checkbox"/>	<input type="checkbox"/>	<input checked="" type="checkbox"/>	
27 LAP Specification Section 334-7 and 8	Was documentation provided that indicates that the LA can support the quantity of asphalt paid? <i>Review recent pay application.</i>	<input checked="" type="checkbox"/>	<input type="checkbox"/>	<input type="checkbox"/>	Plan Quantity: 5,027 Tons; Final Quantity: 4,861 Tons Total Underrun: 166 Tons

Local Agency Program (LAP) Construction Contract Administration Audit Form

<u>FM No.</u>	&	<u>FAP No.</u>
438342-1-58-01 / 419-041-B		Martin County / RFB2020-3190
LAP Specifications Chapter 344		Savanna Road Resurfacing - Jensen Beach

Construction Compliance (continued)

Concrete	Yes <input checked="" type="checkbox"/>	No <input type="checkbox"/>	Category 1: Sidewalks, curb and gutter, ditch and slope pavement, or non-reinforced cast-in-place concrete Category 2: Precast concrete - barriers, inlets, manholes, junction boxes, culverts, etc. Category 3: Structural cast-in-place concrete	Project Name/location	Audit Type		
					Final	Frank White 5/7/21 (Invoice No. 7 FINAL)	Auditor and Audit Date
Reference	Activity			Y	N	N/A	Comments
28 LAP Specification Section 344-3.1.1	Is Concrete produced from National Ready-Mixed Concrete Association (NRMCA) or on the list of FDOT non-structural concrete producers?	<input checked="" type="checkbox"/>	<input type="checkbox"/>	<input checked="" type="checkbox"/>	<input type="checkbox"/>	<input checked="" type="checkbox"/>	Documentation is on file for Cemex Plant 090-1090.
29 LAP Specification Section 344-3.1.2	For Category 2, Is produced at a prestressed and/or precast facility listed on the FDOT Producers with Accepted QC Programs for precast or prestressed concrete?	<input type="checkbox"/>	<input type="checkbox"/>	<input type="checkbox"/>	<input checked="" type="checkbox"/>	<input type="checkbox"/>	No prestressed or precast concrete items in the contract.
30 LAP Specification Section 344-3.1.3	For Category 3, Is produced at a structural concrete facility listed on the FDOT Producers with Accepted QC Programs for structural concrete?	<input type="checkbox"/>	<input type="checkbox"/>	<input type="checkbox"/>	<input checked="" type="checkbox"/>	<input type="checkbox"/>	No structural concrete in the contract.
31 LAP Specification Section 344-3.3	For Category 3, has the Contractor furnish a Quality Control (QC) plan to identify to the Engineer for their approval?	<input type="checkbox"/>	<input type="checkbox"/>	<input type="checkbox"/>	<input checked="" type="checkbox"/>	<input type="checkbox"/>	Not required by contract for this project.
32 LAP Specification Section 344-3.4	For Category 1 or Category 2, has the Contractor submitted the proposed mix designs to the Engineer on a form provided by the Engineer?	<input checked="" type="checkbox"/>	<input type="checkbox"/>	<input type="checkbox"/>	<input type="checkbox"/>	<input type="checkbox"/>	Documentation on file for Cemex Concrete design mixes.
33 LAP Specification Section 344-3.4	For Category 3, submit to the Engineer for approval, FDOT approved mix designs?	<input checked="" type="checkbox"/>	<input type="checkbox"/>	<input type="checkbox"/>	<input type="checkbox"/>	<input type="checkbox"/>	
34 LAP Specification Section 344-3.5	For Cat 1 and 3, are delivery tickets available, and do they indicate the date, producer, quantity and mix, and have they been signed by both batcher and contractor?	<input type="checkbox"/>	<input type="checkbox"/>	<input type="checkbox"/>	<input type="checkbox"/>	<input type="checkbox"/>	Documentation on file and delivery ticket 57253717 pulled to verify compliance.
35 LAP Specification Section 344	Was adequate oversight of concrete activities performed to reasonably ensure compliance with general construction requirements?	<input checked="" type="checkbox"/>	<input type="checkbox"/>	<input type="checkbox"/>	<input type="checkbox"/>	<input type="checkbox"/>	Verified throughout the construction, by Oversight visits.
36 LAP Specification Section 344-3.9	Have concrete cylinders been tested to determine compliance with design compressive strength?	<input type="checkbox"/>	<input type="checkbox"/>	<input checked="" type="checkbox"/>	<input type="checkbox"/>	<input checked="" type="checkbox"/>	Not required by contract for this project.
37 LAP Specification Section 344-5 and 6	Is there adequate support of the quantities paid?	<input checked="" type="checkbox"/>	<input type="checkbox"/>	<input type="checkbox"/>	<input type="checkbox"/>	<input type="checkbox"/>	Plan Quantity 3,600 SY Paid; Overrun Quantity 9,350 SY on Final True-up change order; Total 12,950 SY per Sod Tickets

Local Agency Program (LAP) Construction Contract Administration Audit Form

<u>FM No.</u> & <u>FAP No.</u>	<u>438342-1-58-01 / 419-041-B</u>	<u>Local Agency (LA)</u>	<u>Martin County / RFB2020-3190</u>	<u>Project Name/Location</u>	<u>Savanna Road Resurfacing - Jensen Beach</u>	<u>Audit Type</u>	<u>Final</u>	<u>Auditor and Audit Date</u>	<u>Frank White 5/7/21 (Invoice No. 7 FINAL)</u>
--------------------------------	-----------------------------------	--------------------------	-------------------------------------	------------------------------	--	-------------------	--------------	-------------------------------	---

Construction Compliance (continued)

<u>Earthwork</u>	<u>Yes</u> <input type="checkbox"/> <u>No</u> <input type="checkbox"/>	<u>LAP Specifications Chapter 120</u>	<u>Category 1:</u> construction of sidewalks and bike paths along with any associated drainage structures. <u>Category 2:</u> turn lanes and other non-mainline traffic lane work including widening, roadway shoulders, and other drainage structures. <u>Category 3:</u> new mainline pavement, along with concrete box culverts, retaining walls, and other drainage structures on the mainline pavement
38		LAP Specification Section 120	Are Density Log Books/Reports on file? <input type="checkbox"/>
39		LAP Specification Section 120	Are Proctors Documented? <input checked="" type="checkbox"/>
40		LAP Specification Section 120	Are Soil Classifications Documented? <input type="checkbox"/>
41		LAP Specification Section 120	Is there adequate support of the quantities paid? <input checked="" type="checkbox"/>

Construction Compliance - Other Work Types

<u>Work Type</u>	<u>Activity</u>	<u>Y</u>	<u>N</u>	<u>N/A</u>	<u>Comments</u>
42	Landscaping	<input type="checkbox"/>	<input type="checkbox"/>	<input checked="" type="checkbox"/>	
43	Lighting	<input type="checkbox"/>	<input type="checkbox"/>	<input checked="" type="checkbox"/>	
44	Signalization	<input type="checkbox"/>	<input type="checkbox"/>	<input checked="" type="checkbox"/>	
45	Guardrail	<input type="checkbox"/>	<input type="checkbox"/>	<input checked="" type="checkbox"/>	
46	Signage	<input type="checkbox"/>	<input type="checkbox"/>	<input checked="" type="checkbox"/>	
47	Sodding	<input checked="" type="checkbox"/>	<input type="checkbox"/>	<input type="checkbox"/>	Quantities back up was submitted with the Final True-up change order.

Construction Compliance Comments :

--

Local Agency Program (LAP) Construction Contract Administration Audit Form

FM No. & FAP No.	4383422-1-58-01 / 419-041-B	Local Agency (LA)	Project Name/Location	Audit Type
		Martin County / RFB2020-3190	Savanna Road Resurfacing - Jensen Beach	Final

Final Audit - to be conducted after construction has been completed

	Topic	Reference	Activity	Y	N	N/A	Comments
48	Project Acceptance	LAP Manual Chapter 23.10	Was a pre-final and final walkthrough conducted? List dates.	<input checked="" type="checkbox"/>	<input type="checkbox"/>	<input type="checkbox"/>	Final walkthrough was conducted on 9/11/20 wherein a few punchlist items were noted and corrected the same day.
49	Project Acceptance	LAP Manual Chapter 23.10	Was a punch-list generated at the Final walkthrough and were all items corrected prior to final acceptance?	<input checked="" type="checkbox"/>	<input type="checkbox"/>	<input type="checkbox"/>	Final walkthrough was conducted on 9/11/20 wherein a few punchlist items were noted and corrected the same day.
50	As-built	LAP Manual Chapter 23.10	Were final as-built plans completed and submitted for on-system projects?	<input checked="" type="checkbox"/>	<input type="checkbox"/>	<input type="checkbox"/>	Yes, the approved and certified as-built are in LAPIT and the Blue Folder.
51	Close-out documentation	LAP Manual Chapter 23.10	Have close-out documents been provided for review and acceptance by FDOT?	<input type="checkbox"/>	<input type="checkbox"/>	<input type="checkbox"/>	Change Order No 1, the Final True-up was submitted to FDOT
52	Reimbursements	LAP Manual Chapter 23.10	Has a final reimbursement request been prepared and submitted to FDOT?	<input checked="" type="checkbox"/>	<input type="checkbox"/>	<input type="checkbox"/>	Final Reimbursement Invoice No 3, was submitted to FDOT for approval.
53	LAPIT	LAP Manual Chapter 23.10	Have all construction documents been uploaded into LAPIT. Refer to the LAPIT document guide.	<input checked="" type="checkbox"/>	<input type="checkbox"/>	<input type="checkbox"/>	The Agency has uploaded all of their documents.

Final Audit Comments :



Note: Due to the Covid 19 Virus guidelines, the normal in person audit, was done remotely by phone, emails and file attachments for back up documentation.
documents will be preserved for future reference.

All back up

STATE OF FLORIDA DEPARTMENT OF TRANSPORTATION
LOCAL AGENCY PROGRAM PERFORMANCE EVALUATION

525-010-50
PROGRAM MANAGEMENT
10/18
Page 1 of 7

Financial Project Number: 438342-1-58-01

Local Agency Name: Martin County

Reviewer: Diego Velázquez

District: 4

Local Agency Project Evaluation Form Overview

The Department assesses what aspects of the Local Agency's efforts are compliant, where compliance is less than satisfactory, and whether the LAP certification type needs to change or be removed based on risk to the Department or the program. The evaluations inform project and agency monitoring plans, the Local Agency's risk assessment, and the certification review process. The District LAP Administrator completes the evaluation based on input from the Department's project managers. Once the District LAP Administrator completes the evaluation, the evaluation is reviewed and signed by the Local Agency's responsible charge and the District LAP Administrator. Completed performance evaluation forms are provided to the Local Agency's responsible charge as part of the project closeout process. The Department provides the evaluation to the Local Agency as soon as practicable and no more than 30 days after project close out.

LAP Manual, 2.6.2 Performance Evaluation Ratings

Each performance evaluation will result in one of three ratings:

- 1- **Unsatisfactory Performance** means the Local Agency failed to develop the project in accordance with applicable federal and state regulations, standards and procedures, required excessive Department involvement/oversight, or required corrective actions by the Department to complete the project.
- 2- **Satisfactory Performance** means the Local Agency developed the project in accordance with applicable federal and state regulations, standards and procedures, with minimal Department involvement/oversight.
- 3- **Above Satisfactory Performance** means the Local Agency developed the project in accordance with applicable federal and state regulations, standards and procedures, and the Department did not have to exceed the minimum oversight and monitoring requirements identified for the project.

PROFESSIONAL SERVICES PROCUREMENT: This section covers the Planning, Design and CEI phases where a consultant is being hired. A given project may have multiple evaluations for multiple consultant procurement phases. If Planning, Design, and/or CEI is being performed in-house, this section would **NOT** apply to that particular phase.

1) The Agency's staff were responsive to Department requests for project information.

- Select Rating NA 1 The Agency's staff were difficult to contact and caused project delays due to lack of communication or non-responsiveness to requests for information.
2 The Agency's staff responded to requests for information, but required Department staff to increase oversight in order to ensure consistent communication and responsiveness during the project.
3 The Agency's staff responded to requests for information and the Department performed the minimum project oversight required.

STATE OF FLORIDA DEPARTMENT OF TRANSPORTATION
LOCAL AGENCY PROGRAM PERFORMANCE EVALUATION

525-010-50
PROGRAM MANAGEMENT
10/18
Page 2 of 7

2) The Agency provided addenda for the Department's concurrence prior to issuance.

Select Rating NA 1 The Agency did not follow procedures, required excessive involvement by the Department and/or corrective actions.

2 The Agency followed procedures with minimal prompting by the Department.

3 The Agency followed procedures and the Department provided concurrence after performing the minimum project oversight required.

3) The agency received less than three responses to their solicitation for services and followed the LAP Manual Chapter 18 procedures by contacting the District, extending the advertisement, re-advertising or receiving approval from their District Administrator/State Administrator/FHWA DTE prior to moving forward.

Select Rating NA 1 The Agency did not follow procedures, required excessive involvement by the Department and/or corrective actions.

2 The Agency followed procedures with minimal prompting and/or reviews by the Department.

3 The Agency followed procedures and the Department provided concurrence after performing the minimum project oversight required.

4) The Agency evaluated and scored a minimum of three shortlisted firms and submitted supporting documentation of the evaluation process for review. Department issued concurrence prior to the agency entering negotiations with the most qualified firm.

Select Rating NA 1 The Agency did not follow procedures and required excessive involvement by the Department and/or required corrective actions

2 The Agency followed procedures with minimal prompting and/or reviews by the Department.

3 The Agency followed procedures and the Department provided concurrence after performing the minimum project oversight required.

5) The Agency's final contract package met the LAP Professional Services Checklist requirements.

Select Rating NA 1 The Agency did not follow procedures and required excessive involvement or reviews by the Department and/or required corrective actions.

2 The Agency followed procedures with minimal prompting and/or reviews by the Department.

3 The Agency followed procedures and the Department provided concurrence after performing the minimum project oversight required.

STATE OF FLORIDA DEPARTMENT OF TRANSPORTATION
LOCAL AGENCY PROGRAM PERFORMANCE EVALUATION

525-010-50
PROGRAM MANAGEMENT
10/18
Page 3 of 7

- 6) The Agency created the "Local Agency Contract" screen in LAPIT and the information exported to the Equal Opportunity Compliance database allowing DBE reporting by the date consultant work began.

- Select Rating NA 1 The Agency did not follow procedures and required excessive involvement by the Department and/or required corrective actions.
 2 The Agency followed procedures with minimal prompting and/or reviews by the Department.
 3 The Agency followed procedures and the Department performed the minimum project oversight required.

Average:

DESIGN PHASE

- 1) The Agency performed technical and plans development oversight of the design phase in accordance with Chapters 19 and 20 of the LAP Manual. Phase submittals reviewed by the Department were in reasonable conformance with applicable standards and specifications.

- Select Rating NA 1 The Agency did not follow procedures and required excessive involvement by the Department and/or required corrective actions.
 2 The Agency followed procedures with minimal prompting and/or reviews by the Department.
 3 The Agency followed procedures and the Department performed the minimum project oversight required.

- 2) The Agency's staff were responsive to Department requests for project information.

- Select Rating NA 1 The Agency's staff were difficult to contact and caused project delays due to lack of communication or non-responsiveness to requests for information.
 2 The Agency's staff responded to requests for information, but required Department staff to increase oversight in order to ensure consistent communication and responsiveness during the project.
 3 The Agency's staff responded to requests for information and the Department performed the minimum project oversight required.

- 3) The Agency submitted contract changes or scope changes for concurrence prior to implementation of the change, and backup was submitted to support the changes in scope, cost, and/or schedule.

- Select Rating NA 1 The Agency did not follow procedures and required excessive involvement by the Department and/or required corrective actions.
 2 The Agency followed procedures with minimal prompting and/or reviews by the Department.
 3 The Agency followed procedures and the Department performed the minimum project oversight required.

STATE OF FLORIDA DEPARTMENT OF TRANSPORTATION
LOCAL AGENCY PROGRAM PERFORMANCE EVALUATION

525-010-50
PROGRAM MANAGEMENT
10/18
Page 4 of 7

- 4) The Agency submitted quarterly and final invoices on time with supporting documentation (e.g. executed payrolls, time records, invoices, contracts or vouchers). Supporting documentation established that the deliverables were received and accepted in writing by the Agency per the terms of the LAP Agreement.**

- Select Rating NA 1 The Agency did not follow procedures and required excessive involvement by the Department and/or required corrective actions. Agency did not submit invoices per the terms of the LAP Agreement.
2 The Agency followed procedures and submitted invoices within the terms of the LAP Agreement with minimal prompting and/or reviews by the Department.
3 The Agency followed procedures and the Department performed the minimum project oversight required. The Local Agency met or exceeded invoice submittal requirements per the terms of the LAP Agreement.

Average:

CONSTRUCTION ADVERTISEMENT AND AWARD

- 1) The Agency's staff were responsive to Department requests for project information.**

- Select Rating NA 1 The Agency's staff were difficult to contact and caused project delays due to lack of communication or non-responsiveness to requests for information.
2 The Agency's staff responded to requests for information, but required Department staff to increase oversight in order to ensure consistent communication and responsiveness during the project.
3 The Agency's staff responded to requests for information and the Department performed the minimum project oversight required.

- 2) The Agency's bid package met the LAP Construction Checklist requirements and the agency received concurrence from the Department prior to advertisement.**

- Select Rating NA 1 The Agency did not follow procedures and required excessive involvement by the Department and/or required corrective actions.
2 The Agency followed procedures with minimal prompting and/or reviews by the Department.
3 The Agency followed procedures and the Department performed the minimum project oversight required.

- 3) The Agency advertised the project within thirty (30) days of the date the Department issued the Construction Notice to Proceed per the terms of the LAP Agreement. If the project was not able to meet the scheduled advertisement, the Department was notified.**

- Select Rating NA 1 The Agency did not follow procedures and required excessive involvement or reviews by the Department and/or required corrective actions. Delays were not communicated.
2 The Agency followed procedures with minimal prompting and/or reviews by the Department. Delays were communicated.
3 The Agency followed procedures and the Department performed the minimum project oversight required.

STATE OF FLORIDA DEPARTMENT OF TRANSPORTATION
LOCAL AGENCY PROGRAM PERFORMANCE EVALUATION

525-010-50
PROGRAM MANAGEMENT
10/18
Page 5 of 7

4) The Agency's provided addenda for the Department's concurrence prior to issuance.

- Select Rating NA 1 The Agency did not follow procedures and required excessive involvement by the Department and/or corrective actions.
 2 The Agency followed procedures with minimal prompting and/or reviews by the Department.
 3 The Agency followed procedures and the Department performed the minimum project oversight required.

5) The Agency requested Department concurrence to award the contract to the lowest responsive responsible bidder and submitted supporting documentation the bid tabulations for review.

- Select Rating NA 1 The Agency did not follow procedures and required excessive involvement by the Department and/or required corrective actions.
 2 The Agency followed procedures with minimal prompting and/or reviews by the Department. Delays were communicated.
 3 The Agency followed procedures and the Department performed the minimum project oversight required.

6) The Agency created the "Local Agency Contract" screen in LAPIT and the information exported to the Equal Opportunity Compliance database allowing DBE reporting by the date of the pre-construction meeting.

- Select Rating NA 1 The Agency did not follow procedures and required excessive involvement by the Department and/or required corrective actions.
 2 The Agency followed procedures with minimal prompting and/or reviews by the Department.
 3 The Agency followed procedures and the Department performed the minimum project oversight required..

Average:

CONSTRUCTION AND CONSTRUCTION ADMINISTRATION

1) The Agency communicated project information and staffing changes to the Department. The Agency's staff were responsive to Department requests for project information.

- Select Rating 2 1 The Agency's staff were difficult to contact and caused project delays due to lack of communication or non-responsiveness to requests for information.
 2 The Agency's staff responded to requests for information, but required Department staff to increase oversight in order to ensure consistent communication and responsiveness during the project.
 3 The Agency's staff responded to requests for information and the Department performed the minimum project oversight required.

STATE OF FLORIDA DEPARTMENT OF TRANSPORTATION
LOCAL AGENCY PROGRAM PERFORMANCE EVALUATION

525-010-50
PROGRAM MANAGEMENT
10/18
Page 6 of 7

2) The Agency submitted contract changes or scope changes for concurrence prior to implementation of the change, and backup was submitted to support the changes in scope, cost, and/or schedule.

- Select Rating 2 1 The Agency did not follow procedures and required excessive involvement by the Department and/or required corrective actions.
 2 The Agency followed procedures with minimal prompting and/or reviews by the Department. Delays were communicated.
 3 The Agency followed procedures and the Department performed the minimum project oversight required.

3) The Agency submitted quarterly and final invoices on time with supporting documentation (e.g. executed payrolls, time records, invoices, contracts or vouchers). Supporting documentation established that the deliverables were received and accepted in writing by the Agency per the terms of the LAP Agreement.

- Select Rating 2 1 The Agency did not follow procedures and required excessive involvement by the Department and/or required corrective actions. Agency did not submit invoices per the terms of the LAP Agreement.
 2 The Agency followed procedures and submitted invoices within the terms of the LAP Agreement with minimal prompting and/or reviews by the Department.
 3 The Agency followed procedures and the Department performed the minimum project oversight required. The Local Agency met or exceeded invoice submittal requirements per the terms of the LAP Agreement.

4) Materials testing requirements were met per the terms of the construction specifications and a materials acceptance certification was included with the construction close out package.

- Select Rating 3 1 The Agency did not follow procedures and required excessive involvement by the Department and/or required corrective actions.
 2 The Agency followed procedures with minimal prompting and/or reviews by the Department. Delays were communicated.
 3 The Agency followed procedures and the Department performed the minimum project oversight required.

5) The Agency's Resident Compliance Specialist performed construction contract compliance per the terms of the FDOT Contract Compliance Manual.

- Select Rating 3 1 The Agency did not follow procedures and required excessive involvement by the Department and/or required corrective actions.
 2 The Agency followed procedures with minimal prompting and/or reviews by the Department. Delays were communicated.
 3 The Agency followed procedures and the Department performed the minimum project oversight required.

Average: 3

STATE OF FLORIDA DEPARTMENT OF TRANSPORTATION
LOCAL AGENCY PROGRAM PERFORMANCE EVALUATION

525-010-50
PROGRAM MANAGEMENT
10/18
Page 7 of 7

GENERAL COMMENTS

Signature: _____
Local Agency Responsible Charge

Date: _____

Signature: _____
District LAP Administrator

Date: _____

Example

438342-1-58-01 Savanna Road Sidewalk - LAP Project

6-23-20 Contract Day 23 Early Construction Photos



1. North end moving south.JPG



2.JPG



3.JPG



4.JPG



5.JPG



6.JPG



7.JPG



8.JPG



9.JPG

438342-1-58-01 Savanna Road Sidewalk - LAP Project

6-23-20 Contract Day 23 Early Construction Photos



10.JPG



11.JPG



12.JPG



13.JPG



14.JPG



15.JPG



16.JPG



17.JPG



18.JPG

438342-1-58-01 Savanna Road Sidewalk - LAP Project

6-23-20 Contract Day 23 Early Construction Photos



19.JPG



20.JPG



21.JPG



22.JPG



23.JPG



24.JPG



25.JPG



26.JPG



27.JPG

438342-1-58-01 Savanna Road Sidewalk - LAP Project

6-23-20 Contract Day 23 Early Construction Photos



28.JPG



29.JPG



30.JPG



31.JPG



32.JPG



33.JPG



34.JPG



35.JPG



36.JPG

438342-1-58-01 Savanna Road Sidewalk - LAP Project

6-23-20 Contract Day 23 Early Construction Photos



37.JPG



38.JPG



39.JPG



40.JPG



41.JPG



42.JPG



43.JPG



44.JPG



45.JPG

438342-1-58-01 Savanna Road Sidewalk - LAP Project

6-23-20 Contract Day 23 Early Construction Photos



46.JPG



47.JPG



48.JPG



49.JPG



50.JPG



51.JPG



52.JPG



53.JPG



54.JPG

438342-1-58-01 Savanna Road Sidewalk - LAP Project

6-23-20 Contract Day 23 Early Construction Photos



55.JPG



56.JPG



57.JPG




58 South end at begin
project.JPG

438342-1-58-01 Savanna Road Sidewalk - LAP Project


10-13-20 Conditional Acceptance



1 South End at Begin
Project.JPG

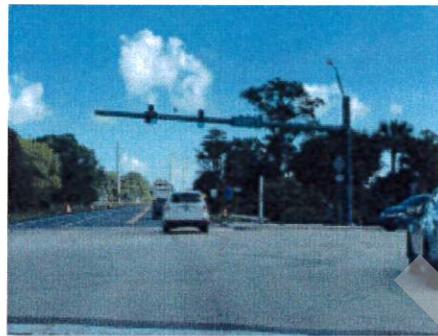

2.JPG

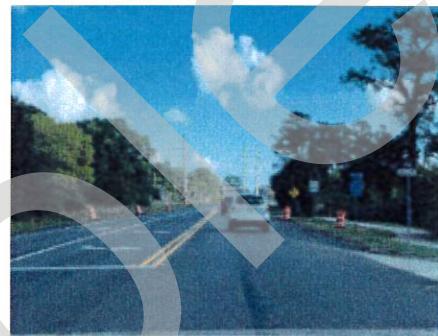

3.JPG



4.JPG



5.JPG



6.JPG



7.JPG



8.JPG



9.JPG

438342-1-58-01 Savanna Road Sidewalk - LAP Project

10-13-20 Conditional Acceptance



10.JPG



11.JPG



12.JPG




13.JPG



14.JPG




15.JPG

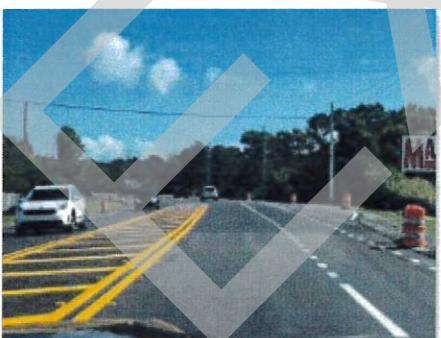

16.JPG




17.JPG

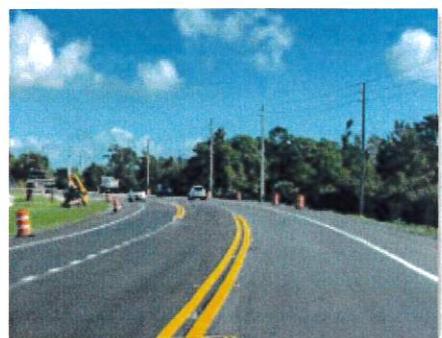

18.JPG

438342-1-58-01 Savanna Road Sidewalk - LAP Project

10-13-20 Conditional Acceptance

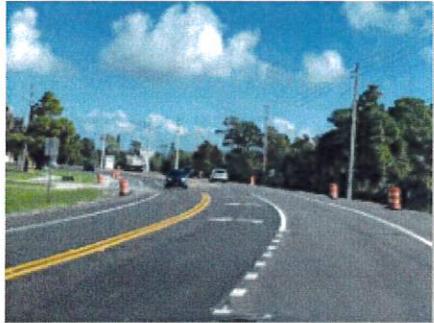

19.JPG



20.JPG



21.JPG




22.JPG



23.JPG



24.JPG

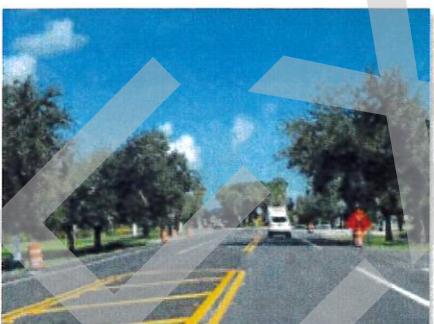

25.JPG



26.JPG



27 Mid-point at Traffic Circle.JPG

438342-1-58-01 Savanna Road Sidewalk - LAP Project

10-13-20 Conditional Acceptance



28.JPG



29.JPG



30.JPG



31.JPG



32.JPG



33.JPG



34.JPG



35.JPG



36.JPG

BOARD OF COUNTY COMMISSIONERS:

DISTRICT 1

DOUG SMITH

DISTRICT 2

STACEY HETHERINGTON

DISTRICT 3

HAROLD JENKINS

DISTRICT 4

SARAH HEARD

EDWARD CHAMP

INDEX OF SHEETS

SHEET NO.

COVER SHEET

TYPICAL SECTION

ROADWAY CROSS SECTIONS

**AS-BUILT SURVEY FOR
SAVANNAH ROAD RESURFACING & BIKE LANES FUNDED BY
MARTIN COUNTY IN PART WITH FDOT'S**

LOCAL AGENCY PROGRAM

(LAP) GRANT FM #438342-1-58-01

SECTIONS, 21, 22, 27 & 28, TOWNSHIP 37 SOUTH, RANGE 41 EAST

BEGIN PROJECT
AT SAVANNAH RD. & DIXIE HWY.
SURVEY STA 10+50

SURVEYORS NOTES

1. THIS IS NOT A BOUNDARY, THIS IS AN AS BUILT / RECORD SURVEY.
2. THE DATE OF COMPLETION OF THIS FIELD SURVEY WAS ON AUGUST 26, 2020

3. THE SURVEYOR IS COVERED BY PROFESSIONAL LIABILITY INSURANCE.
4. DISTANCES AND OFFSETS ARE BASED ON AS BUILT BASELINE.

5. THE SURVEY MAP IS INTENDED TO BE DISPLAYED AT THE STATED GRAPHIC SCALE IN THE US SURVEY IT OF MEASUREMENT AS DEPICTED ON THE SURVEY MAP ATTENTION IS DIRECTED TO THE FACT THAT SAID SURVEY MAP MAY BE ALREADY IN SCALE BY REPRODUCTION AND MUST BE CONSIDERED WHEN OBTAINING SCALED DATA.

6. THE ACCURACY IS DETERMINED BY FIELD MEASUREMENT METHODS AND OFFICE CALCULATION OF CLOSE GEOMETRY FIGURES NEEDS AND EXCEEDS THE REQUIREMENT FOR SUBURBAN AREA (LINEAR, 1 FOOT IN 750 FEET) AS DEFINED IN RULE 54-05 FLORIDA ADMINISTRATIVE CODE.

7. WELL IDENTIFIED FEATURES AS DEDUCED ON THE SURVEY MAP WERE MEASURED TO AN ESTIMATED HORIZONTAL POSITION ACCURACY OF 1/10 OF A FOOT. THIS MAP OF SURVEY IS INTENDED TO BE DISPLAYED AT A SCALE OF ONE INCH EQUALS TWENTY FEET.

8. ELEVATIONS AND COORDINATES ARE RELATIVE TO THE STATE PLANE COORDINATE SYSTEM, FLORIDA EAST ZONE (0801), NORTH AMERICAN DATUM (NAD 83), ADJUSTMENT OF 1983 (NAD 83 1980) EPOCH 1980.10000.

9. THIS AS BUILT SURVEY CONSISTS OF MULTIPLE (54) SHEETS AND SHALL NOT BE CONSIDERED FULL, VALID, AND COMPLETE UNLESS EACH SHEET IS ATTACHED TO THE OTHER.

10. ELEVATIONS AS SHOWN HEREON REFERENCED NORTH AMERICAN VERTICAL DATUM 1989 (N.A.V.D. 88). REFERENCE MARTIN COUNTY BENCHMARK "H754" ELEVATION 760 FEET, ELEVATION 760 FEET, ELEVATIONS AS SHOWN HAVE BEEN MEASURED TO AN ESTIMATED VERTICAL POSITIONAL ACCURACY OF 0.05 FEET.

SURVEYOR'S CERTIFICATE:

I HEREBY CERTIFY, THIS "BOUNDARY SURVEY" IS TRUE AND CORRECT TO THE BEST OF MY KNOWLEDGE AND STANDARDS OF PRACTICE SET FORTH BY THE FLORIDA STATE BOARD OF PROFESSIONAL SURVEYORS AND MAPPERS CONTAINED IN CHAPTER 54-17, FLORIDA ADMINISTRATIVE CODE, PURSUANT TO 472.027, FLORIDA STATUTES.

PEGASUS LAND SURVEYS INC., A FLORIDA CORPORATION

C/O

FLORIDA

CORPORATION

NUMBER L82025

FLORIDA

LICENSE NUMBER


L82025


FLORIDA



CORPORATION

NUMBER

L82025

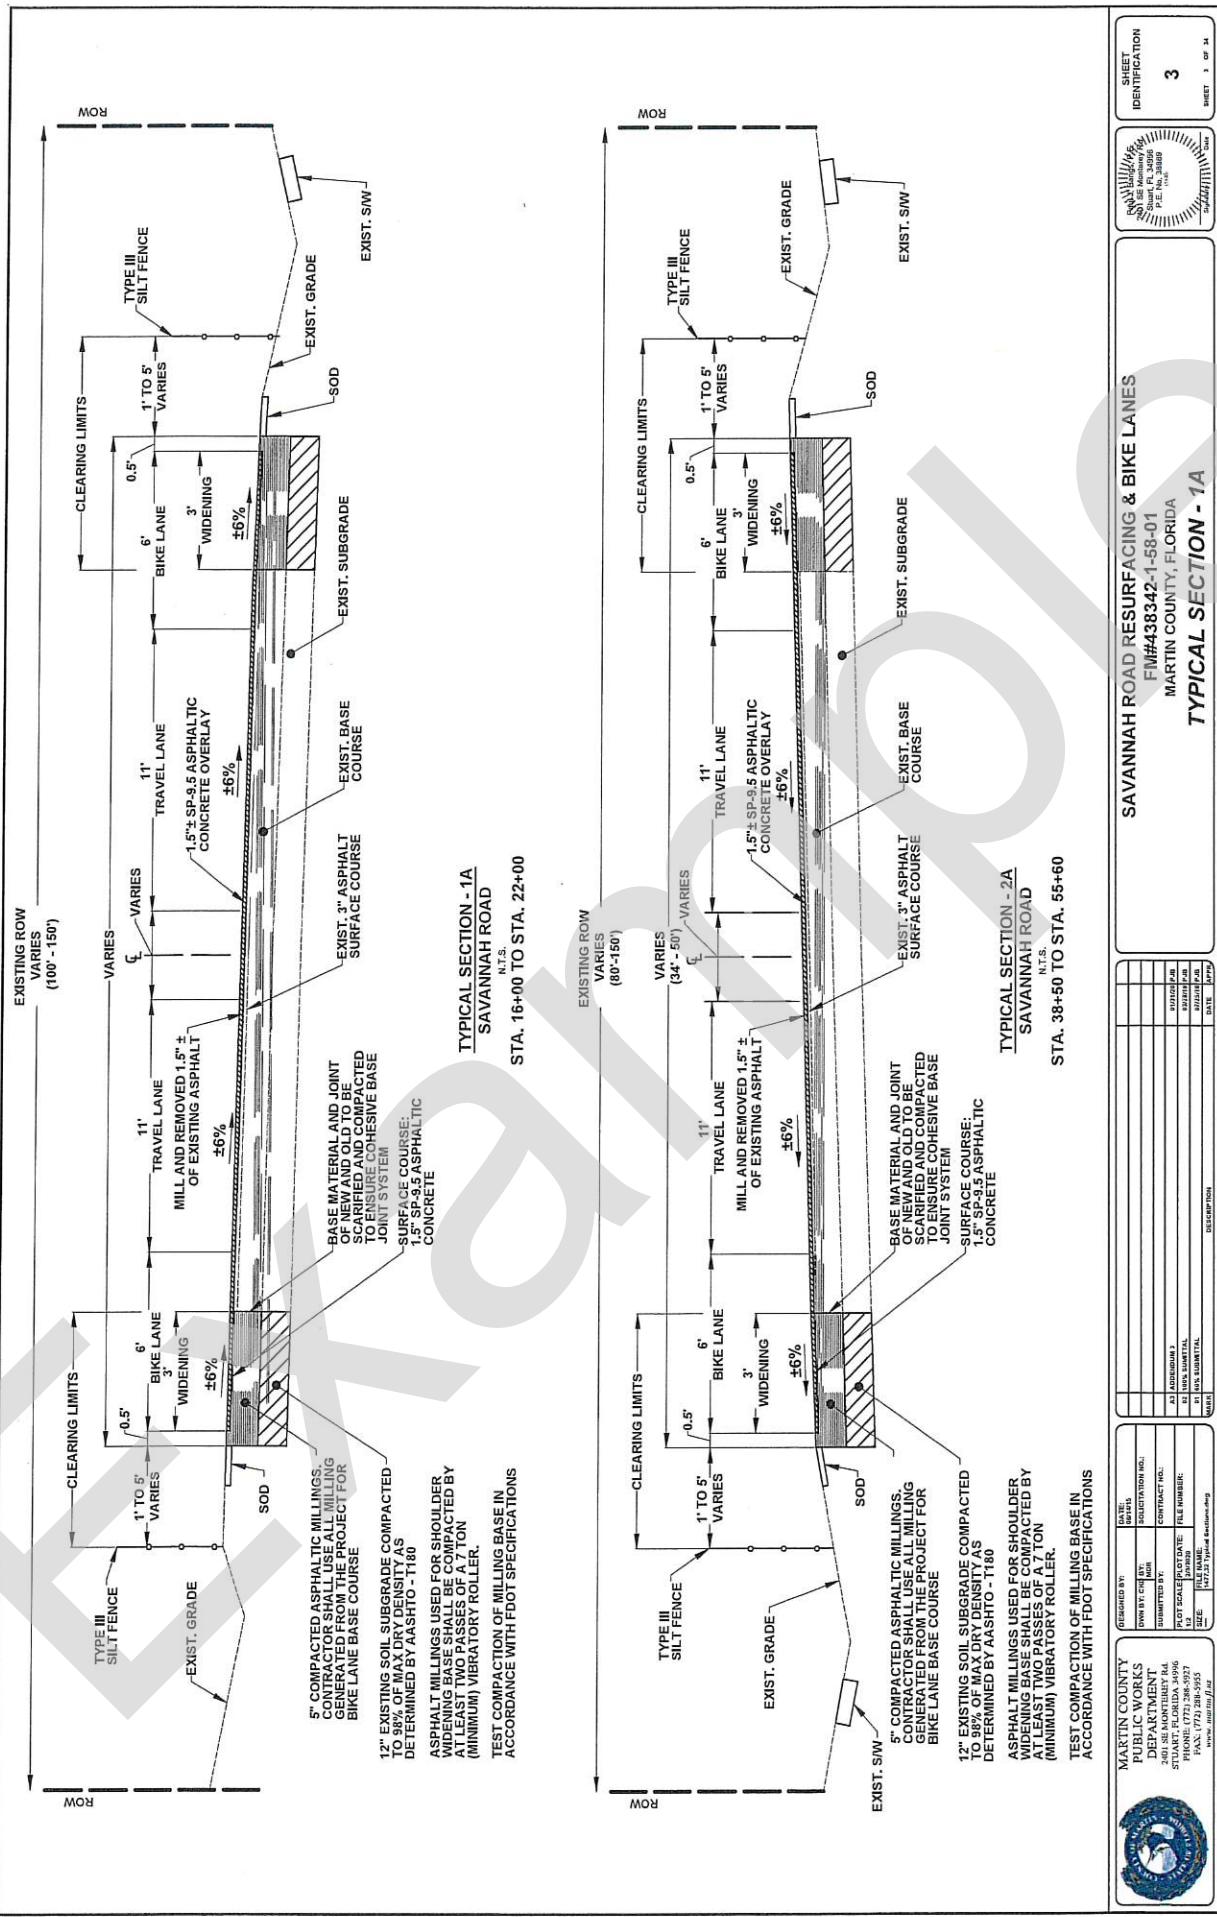

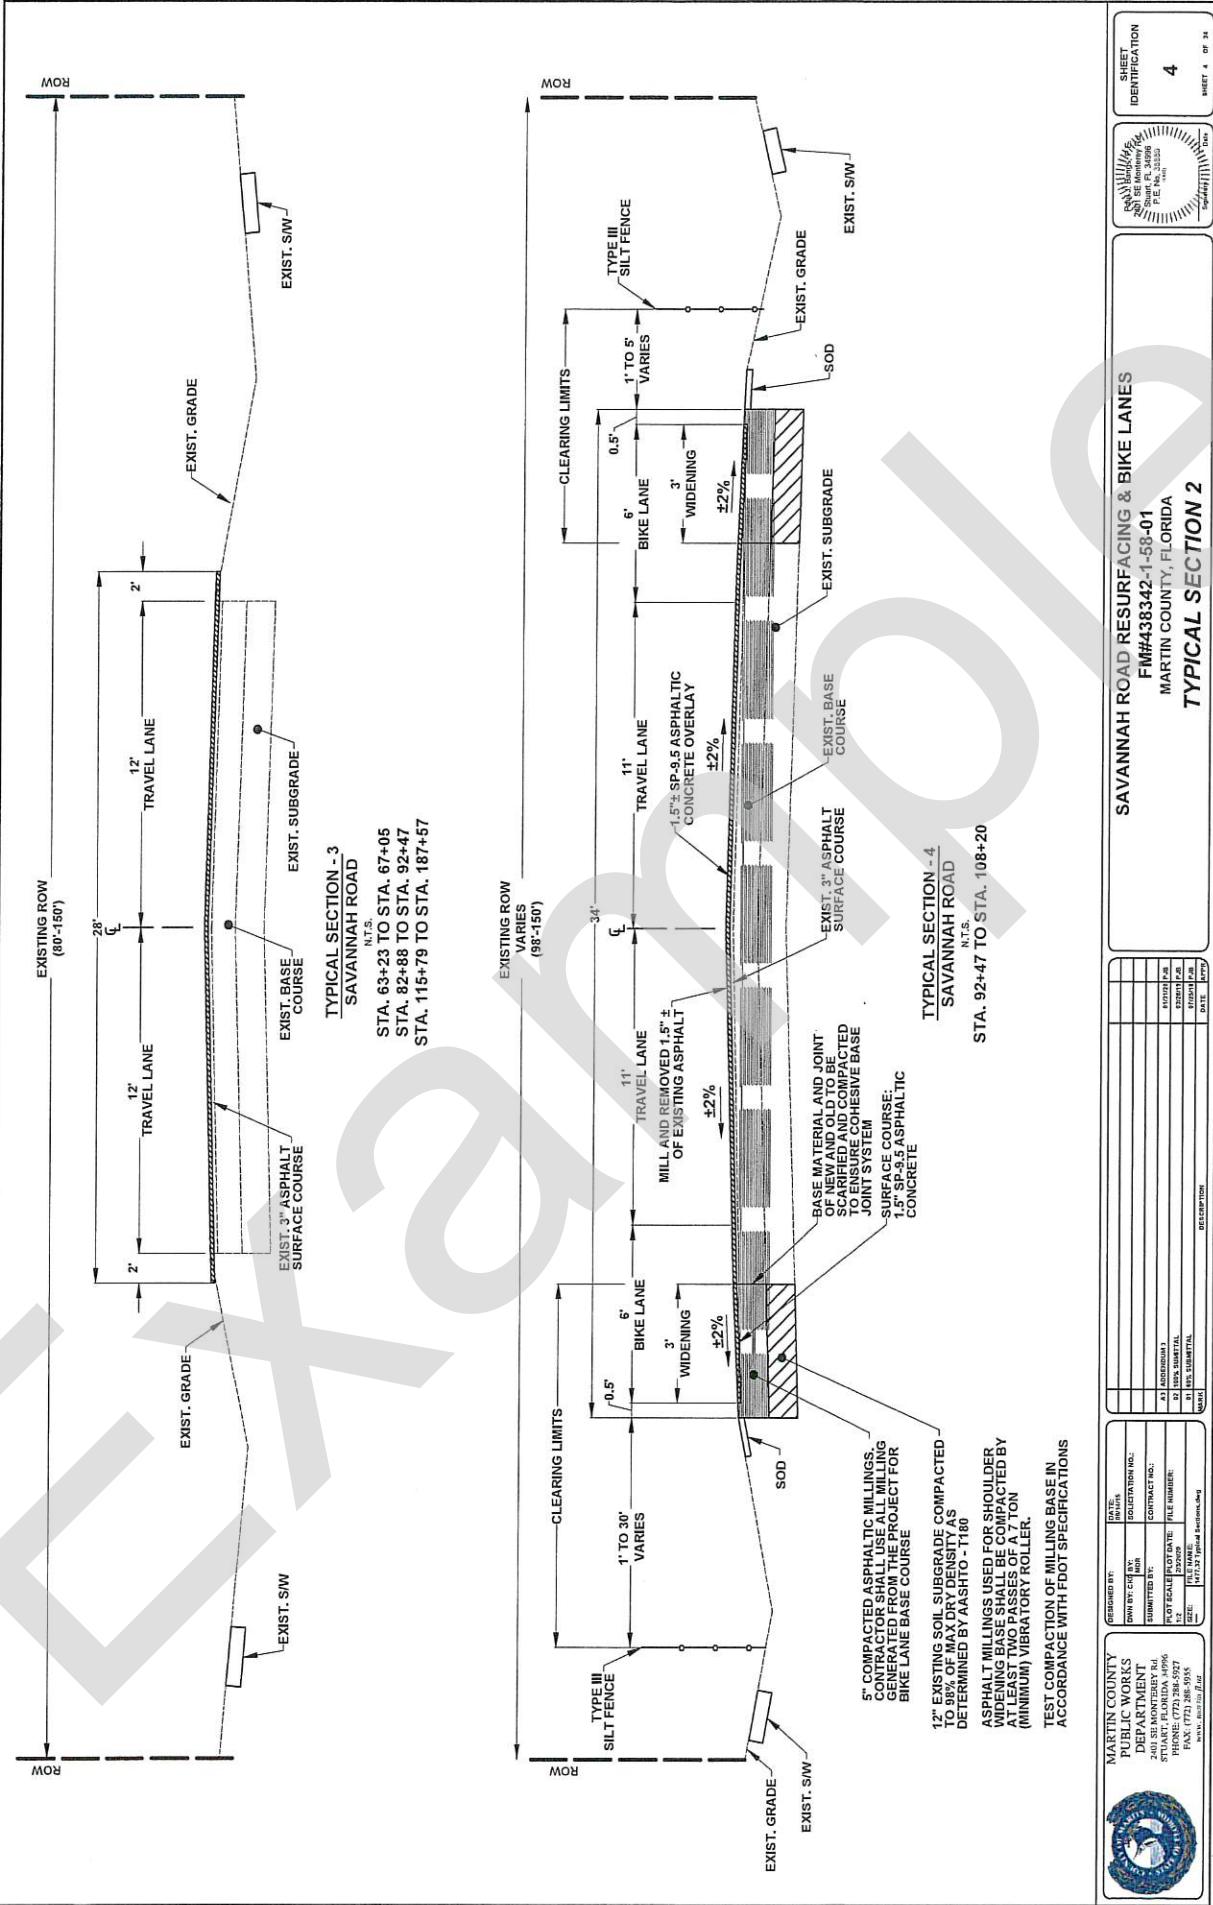

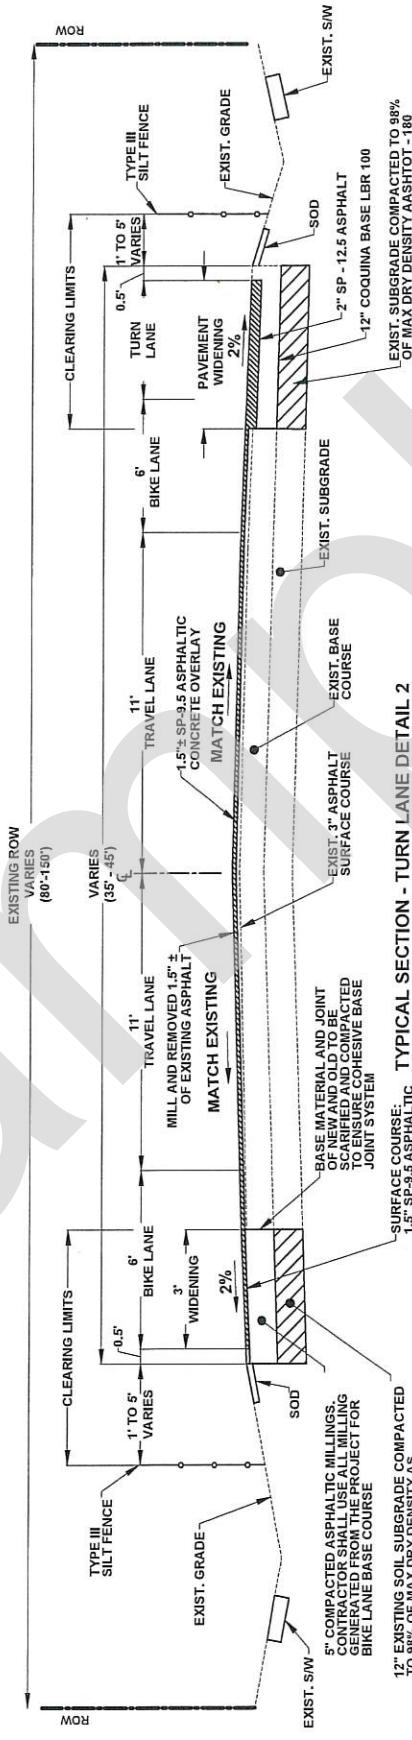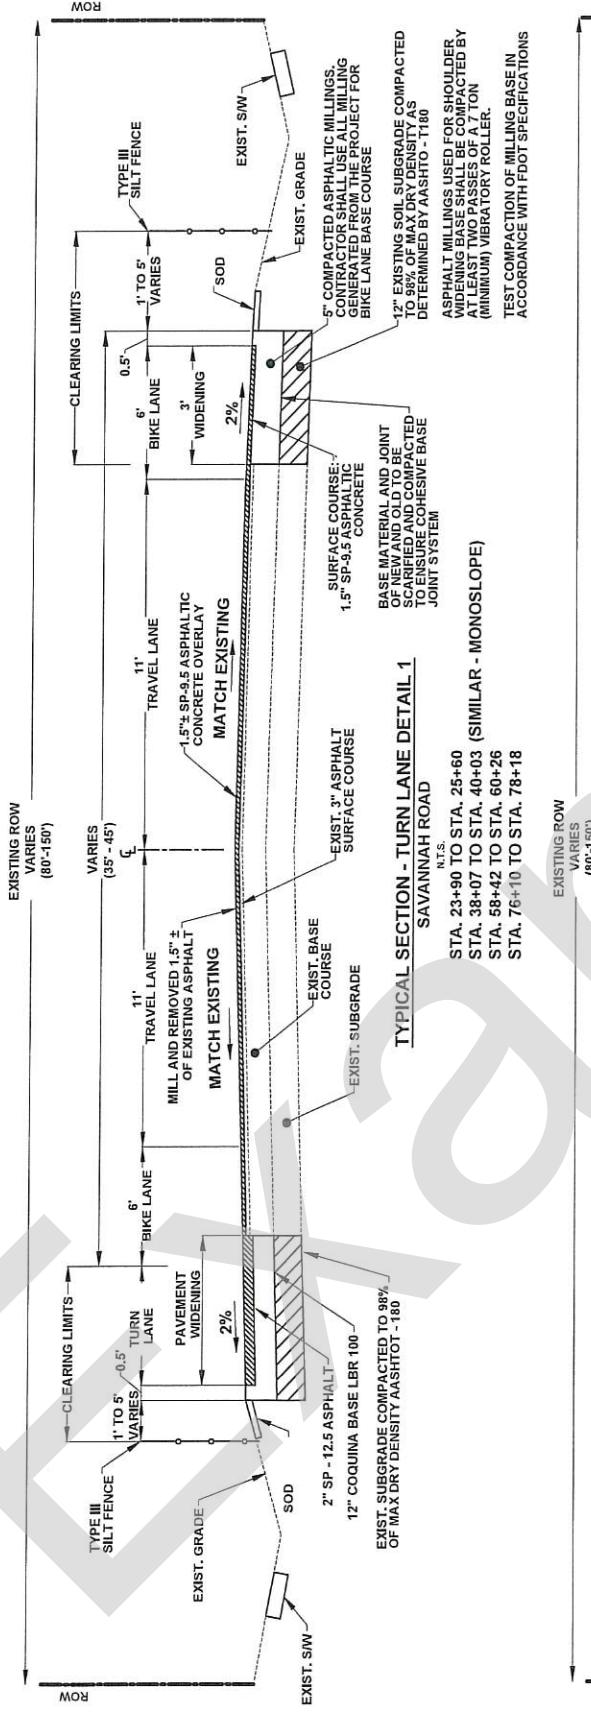

SAVANNAH ROAD RESURFACING & BIKE LANES
FM#433342-1-58-01
MARTIN COUNTY, FLORIDA
TYPICAL SECTION - TURN LANES DETAIL

SHEET 5 OF 14

5

5


5

5


5

5

**Match to Existing
Sta 10+71**

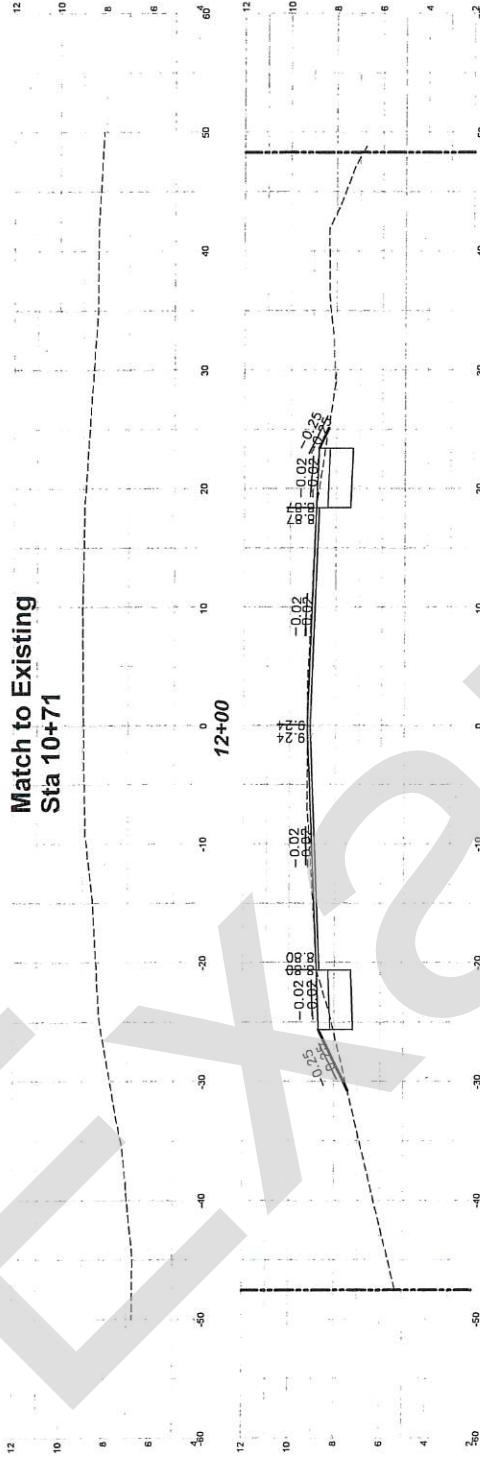


13+00

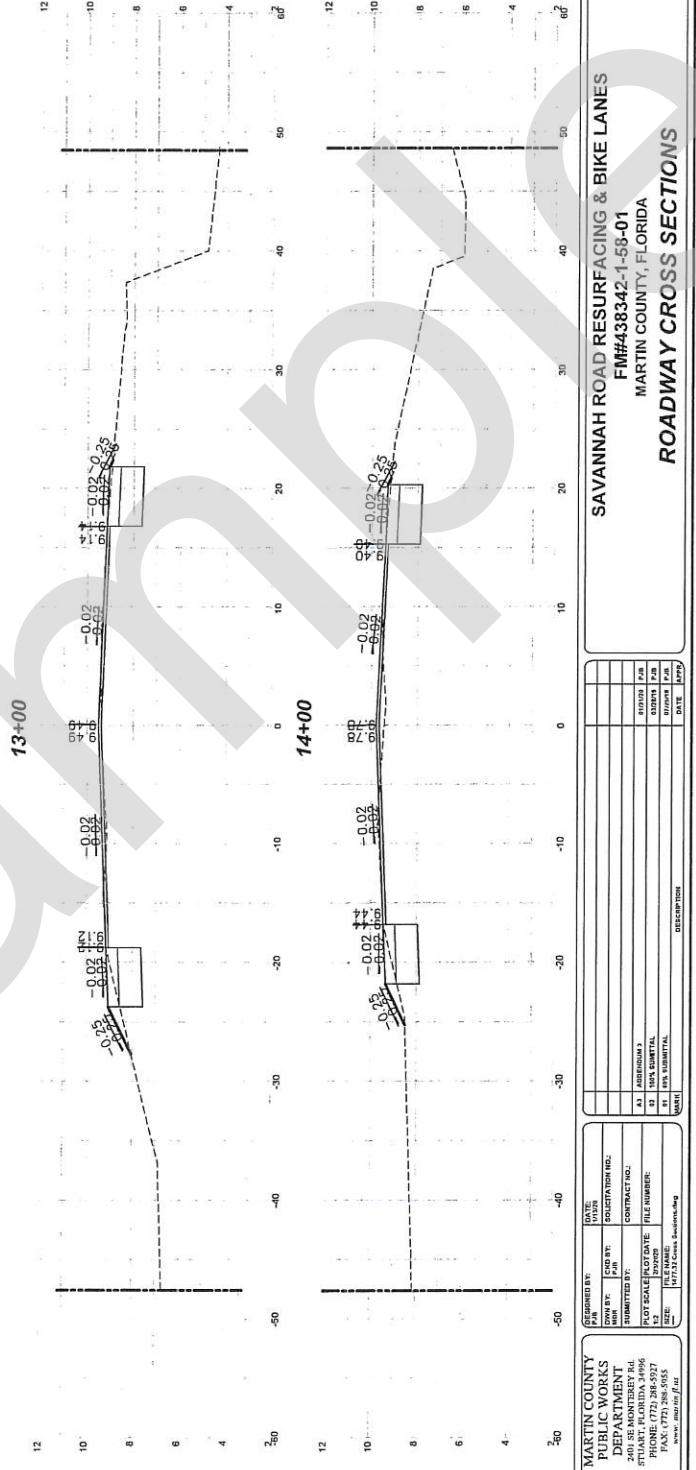


14+00

SAVANNAH ROAD RESURFACING & BIKE LANES	
FM#438342-1-58-01	
MARTIN COUNTY, FLORIDA	
ROADWAY CROSS SECTIONS	
<p>Project No.: 438342-1-58-01 Title: SAVANNAH ROAD RESURFACING & BIKE LANES Scale: 1:2000 Drawing No.: 6 Date: 08/20/2018 Prepared by: [Signature] Public Works Department 240 SE Montebello Rd. Stuart, Florida 34996 Phone: (772) 286-5055 Fax: (772) 286-5055 www.martin.fl.us</p>	
<p>Sheet No.: 6 Total Sheets: 6 Drawing No.: 6 Scale: 1:2000 Title: SAVANNAH ROAD RESURFACING & BIKE LANES Drawing No.: 6 Date: 08/20/2018 Prepared by: [Signature] Public Works Department 240 SE Montebello Rd. Stuart, Florida 34996 Phone: (772) 286-5055 Fax: (772) 286-5055 www.martin.fl.us</p>	


15+00

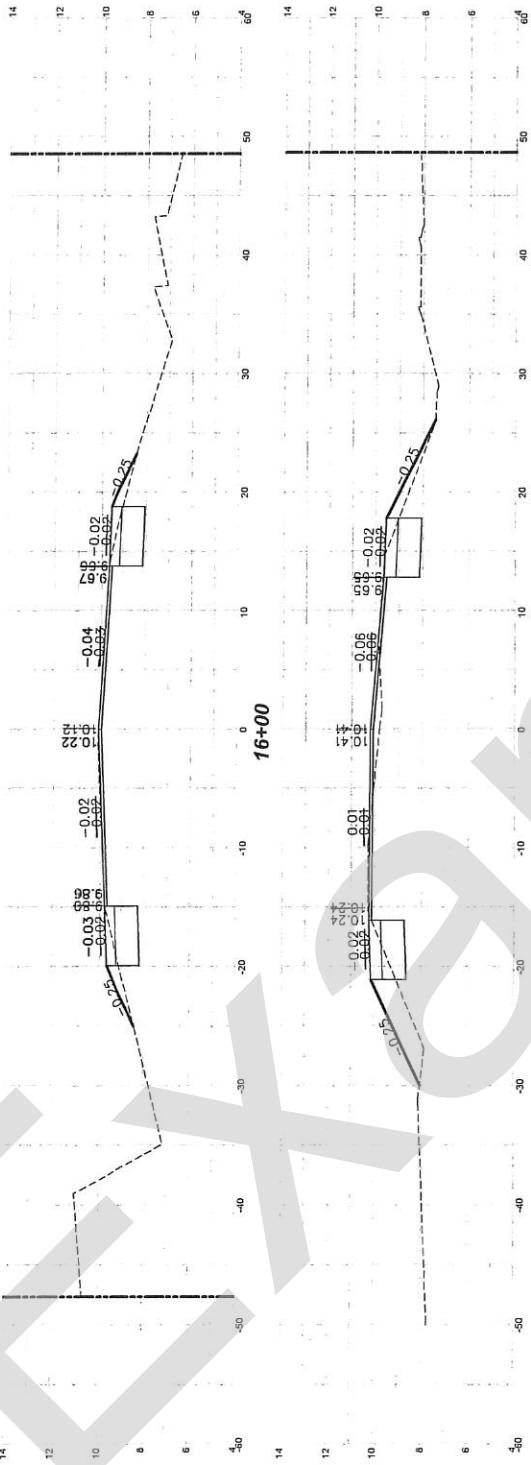


16+00

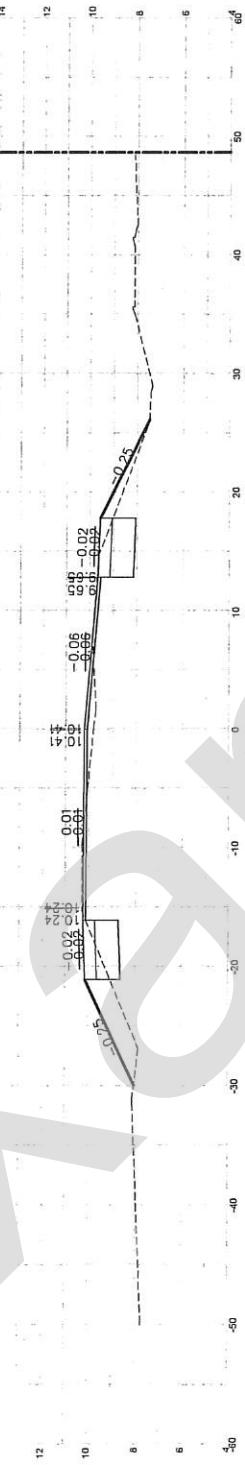

17+00

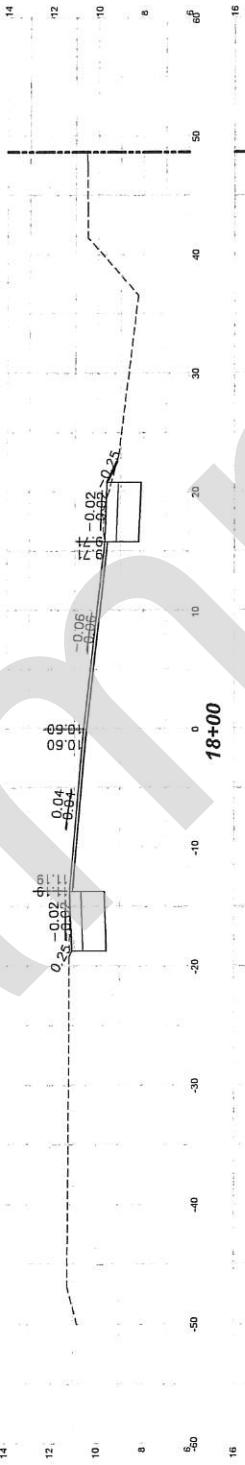

18+00

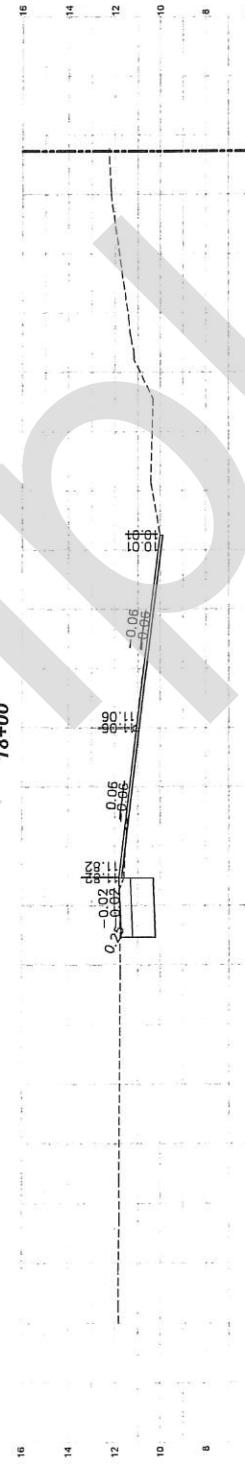

SAVANNAH ROAD RESURFACING & BIKE LANES

FMF#438-342-1-58-01

MARTIN COUNTY, FLORIDA


ROADWAY CROSS SECTIONS

DRAWN BY:		DATE:	
NAME:	SIGNATURE:	MONTH:	YEAR:
MARTIN COUNTY PUBLIC WORKS DEPARTMENT			
240 SE MONTBERRY RD. STUART, FL 34996			
PHONE: 772-288-3852 FAX: 772-288-3853			
SUBMITTED BY:			
CONTRACTING:			
PLOT SCALE PLAT DATE:			
FILE NUMBER:			
ACREAGE:			
TOWN & SECTION:			
CITY & STATE:			
ELEVATION:			
DESCRIPTION:			
NAME:			

DATE:	SCALE:	PLAT:	CONTRACTING:

SHEET IDENTIFICATION	
7	OF 14

PLAT INFORMATION	
Plot #:	Lot #:
Block #:	Block #:
Section #:	Section #:
Range #:	Range #:
Township #:	Township #:
County #:	County #:
State:	State:
Zip Code:	Zip Code:
Signature:	

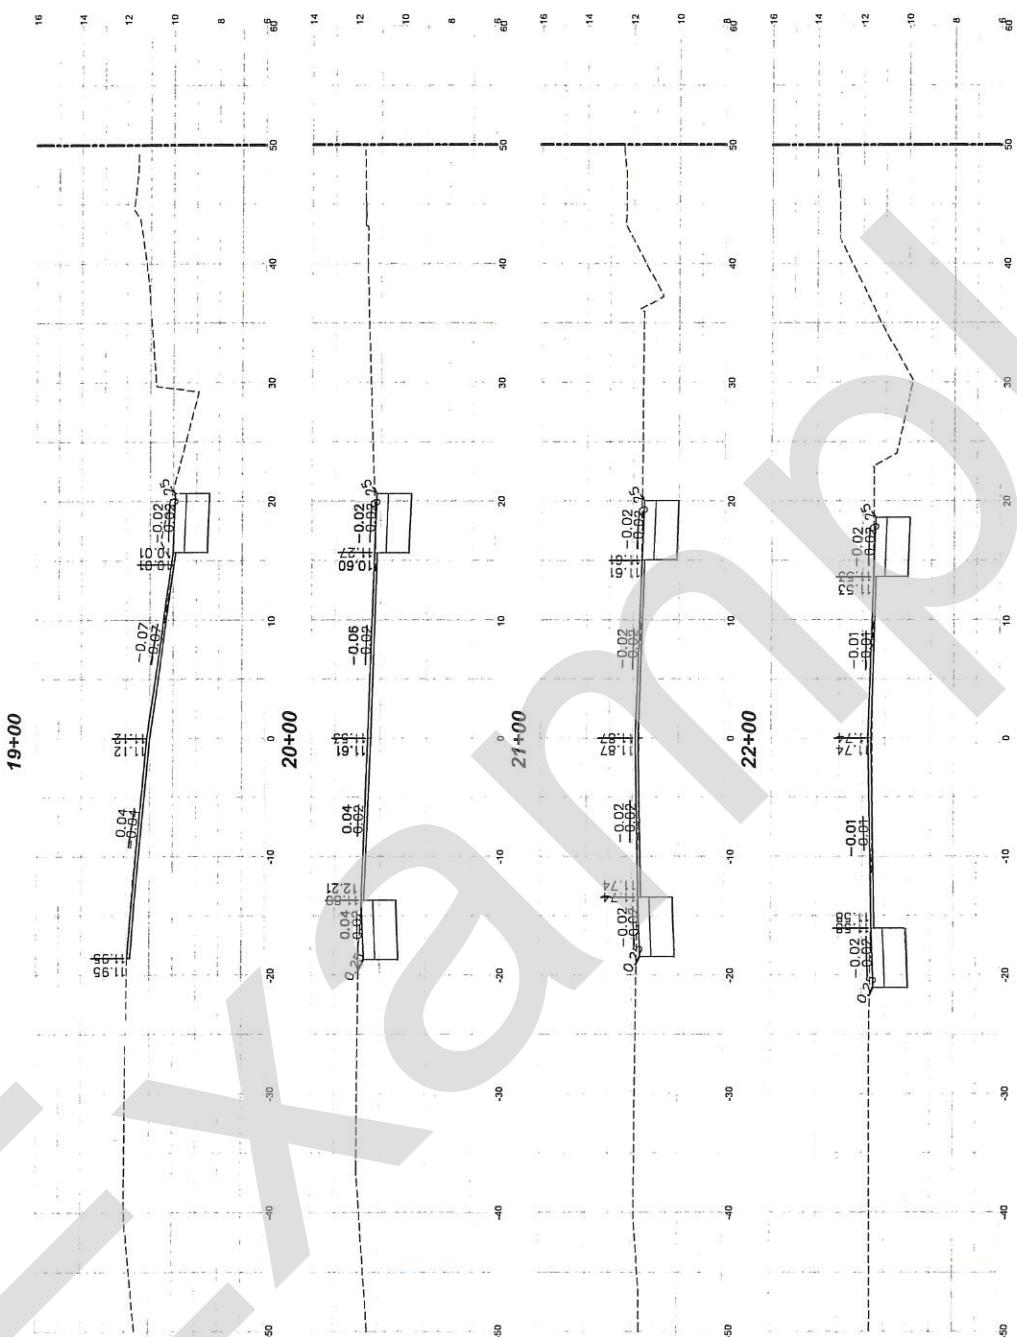

19+00


SAVANNAH ROAD RESURFACING & BIKE LANES


NNAH ROAD RESURFACING
FM#438342-1-58-01
MARTIN COUNTY, FLORIDA



SHEET
IDENTIFICATION

SHEET 1 OF 34

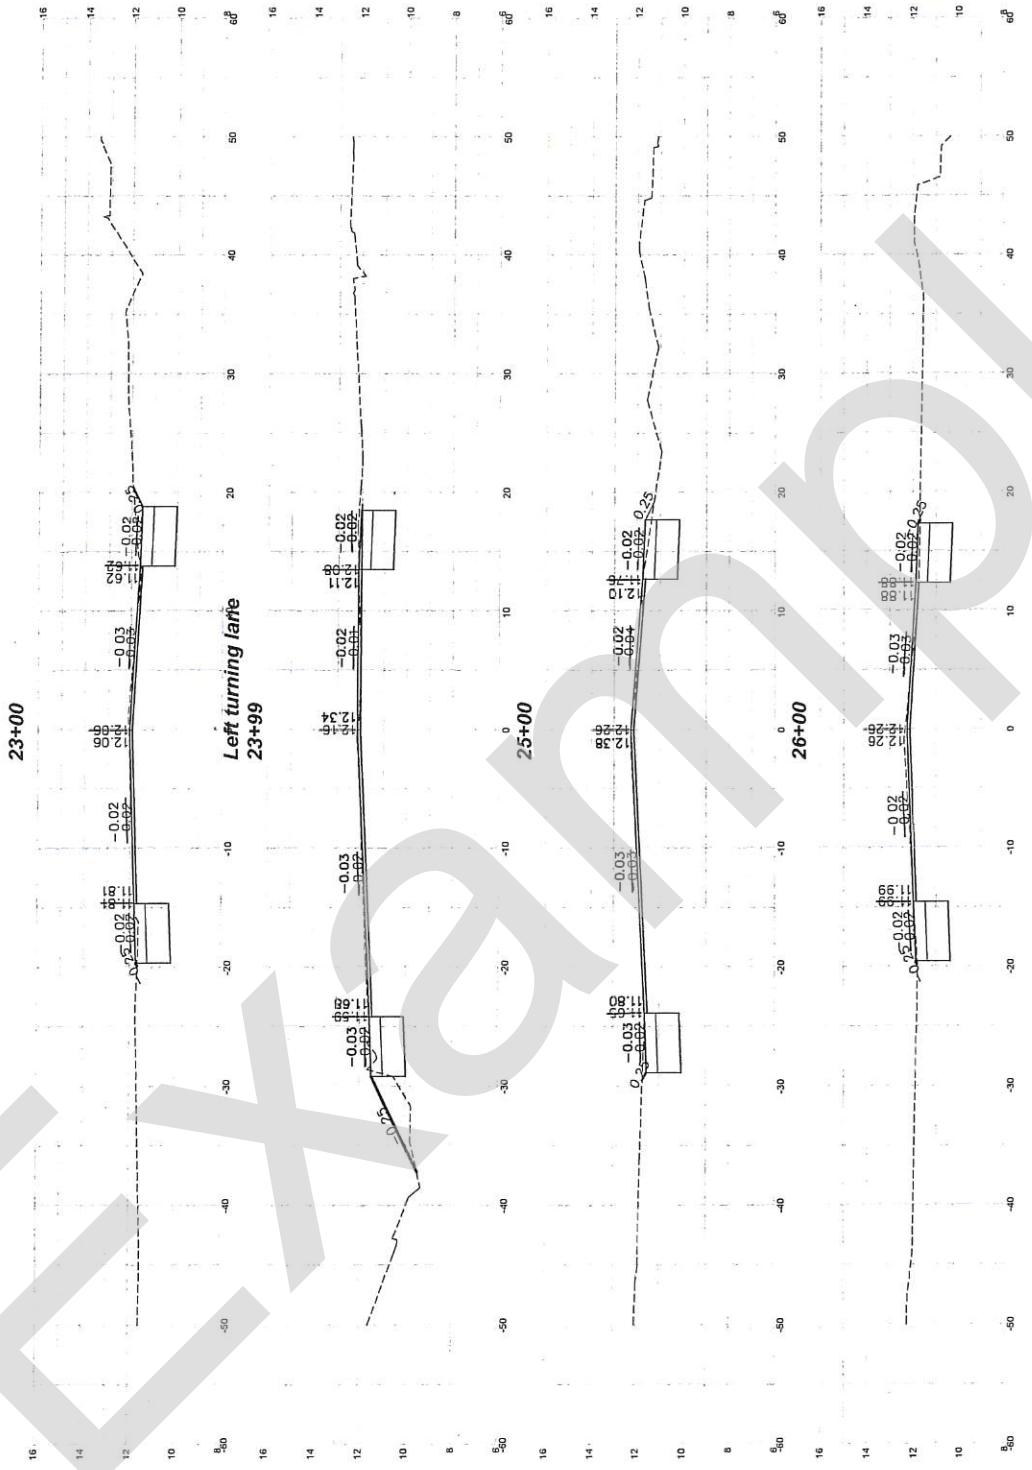

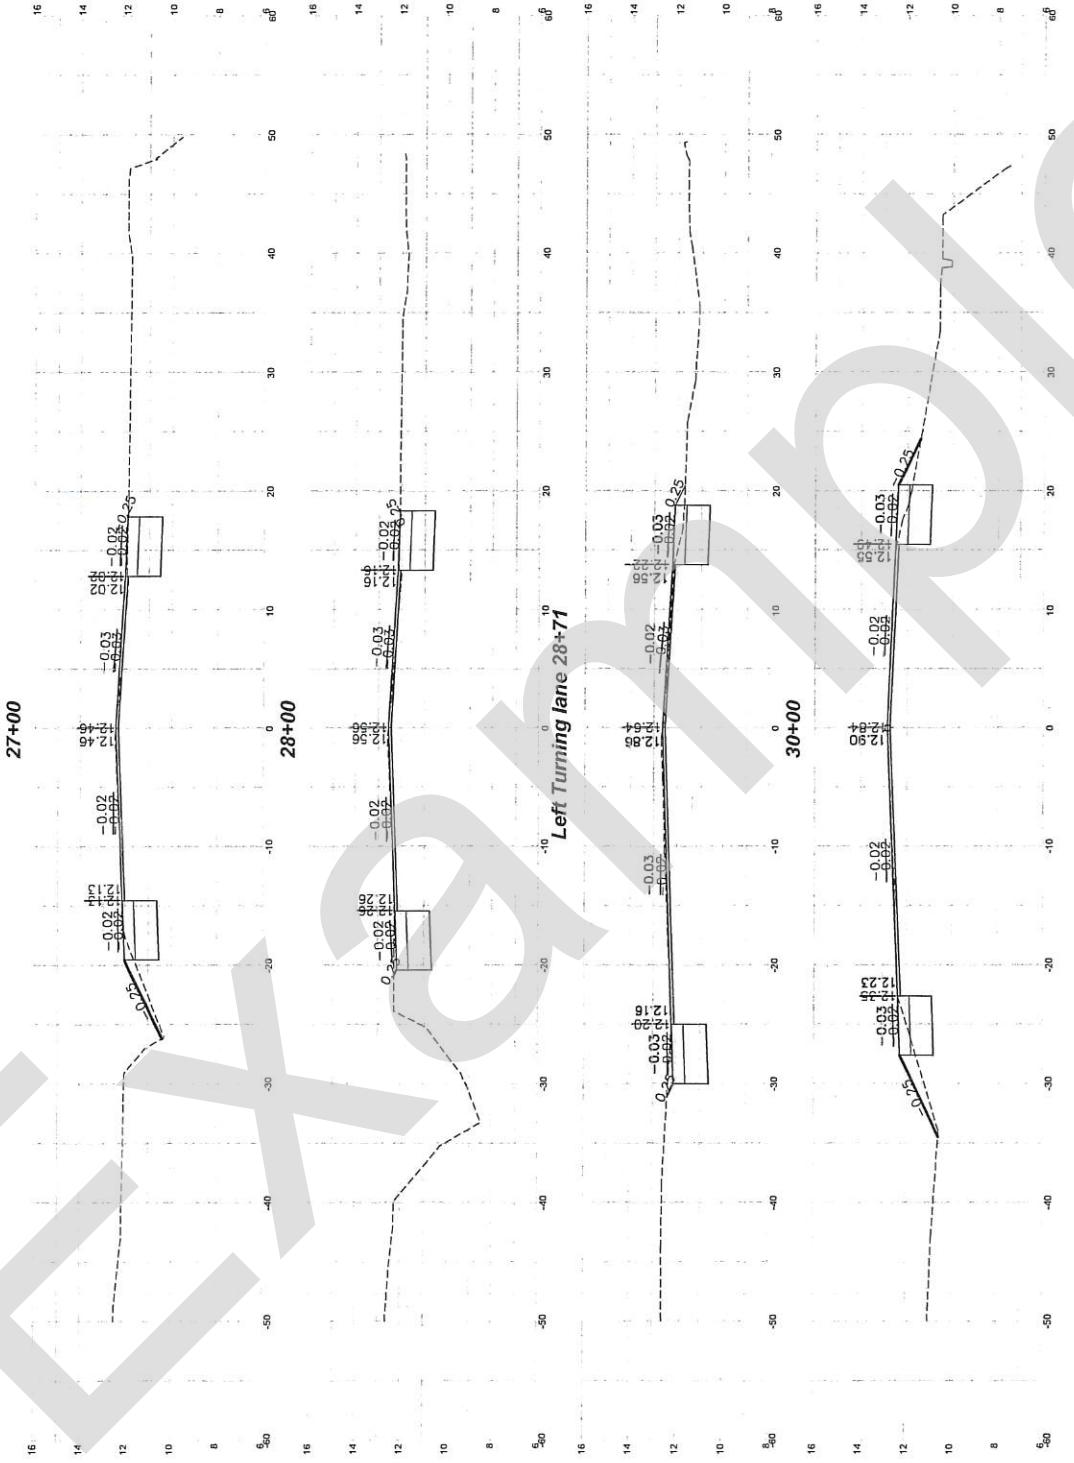

SAVANNAH ROAD RESURFACING & BIKE LANES

ROADWAY CROSSINGS
FM#4383342-1-58
MARTIN COUNTY, FLA.



DESIGNED BY:		DATE:	APPROVED BY:
DONALD HORN		2007-01-10	JOHN D. BROWN
SUBMITTED BY:		CONTRACT NO.:	DATE:
SUBMITTER:		A-3 ACQUISITION 3	02/09/19
PLOT SCALE/LENTH:		FILE NUMBER:	07/07/19
1:12 100' x 100'		42 1995-00001	
SIZE:		FILE NAME: 100x100ft_00001.dwg	DISCRETE
		FILE SIZE: 100x100ft_00001.dwg	FORMAT

SHEET
IDENTIFICATION
10
SHEET 10 CF 34





16

31+00

32+00

33+00

SAVANNAH ROAD RESURFACING & BIKE LANES
FIM#438342-1-58-01
MARTIN COUNTY, FLORIDA

ROADWAY CROSS SECTIONS



MARTIN COUNTY
PUBLIC WORKS
DEPARTMENT
2401 SH MONTEREY RD.
SUARST, FLORIDA 34996
PHONE: (772) 288-5927
FAX: (772) 288-5935
www.martin.fl.us

	8/12/2018	P-1B
	8/12/2018	P-1B
	8/12/2018	P-1B
	DATE	APPN

SAVANNAH ROAD RESURFACING & BIKE LANES

FM#438342-1-58

MARTIN COUNTY, FLORIDA

ROADWAY CROSS SECTIONS


SHEET
ENTERIC

EN IFCAI


11

EXHIBIT 11

35+00

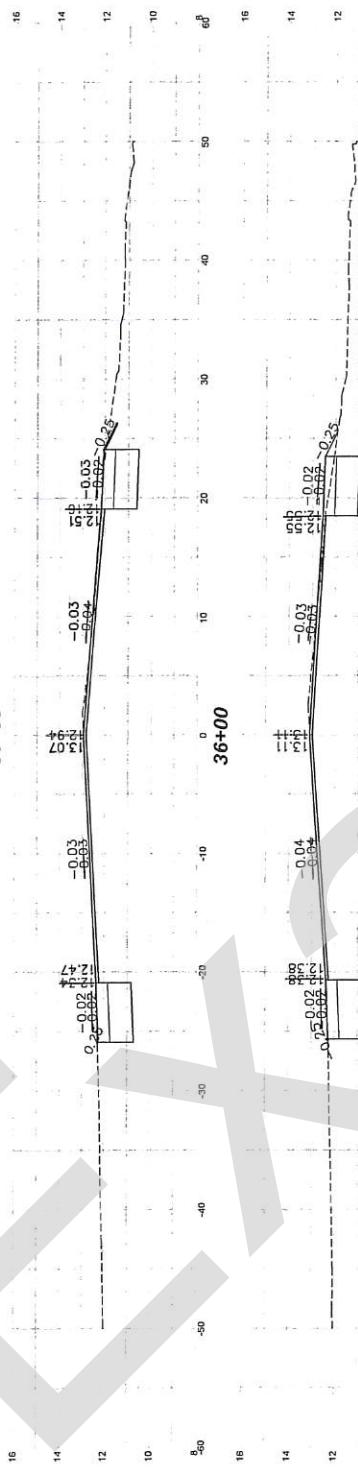


36+00

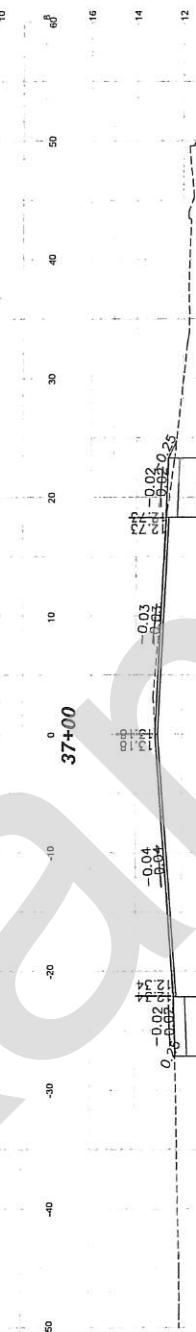

37+00



38+00

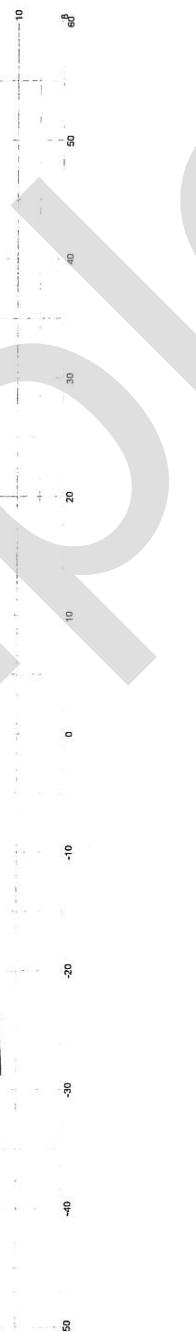

SAVANNAH ROAD RESURFACING & BIKE LANES

FM#438342-1-58-01


MARTIN COUNTY, FLORIDA

ROADWAY CROSS SECTIONS

SHEET IDENTIFICATION	PROJECT NUMBER		
	CONTRACT NO.	LOT NUMBER	SCALE
12	158	1	1:500
13	158	2	1:500
14	158	3	1:500
15	158	4	1:500
16	158	5	1:500

Permit No. 158-01
TODAY'S DATE: 10/26/2016
P.E. No. 38899
LOT SCALE: 1:500
LOT NUMBER: 1
SIZE: 120' x 200'
DESCRIPTION: SAVANNAH ROAD RESURFACING & BIKE LANES
SHEET 12 OF 16

Right turning lane 39+91

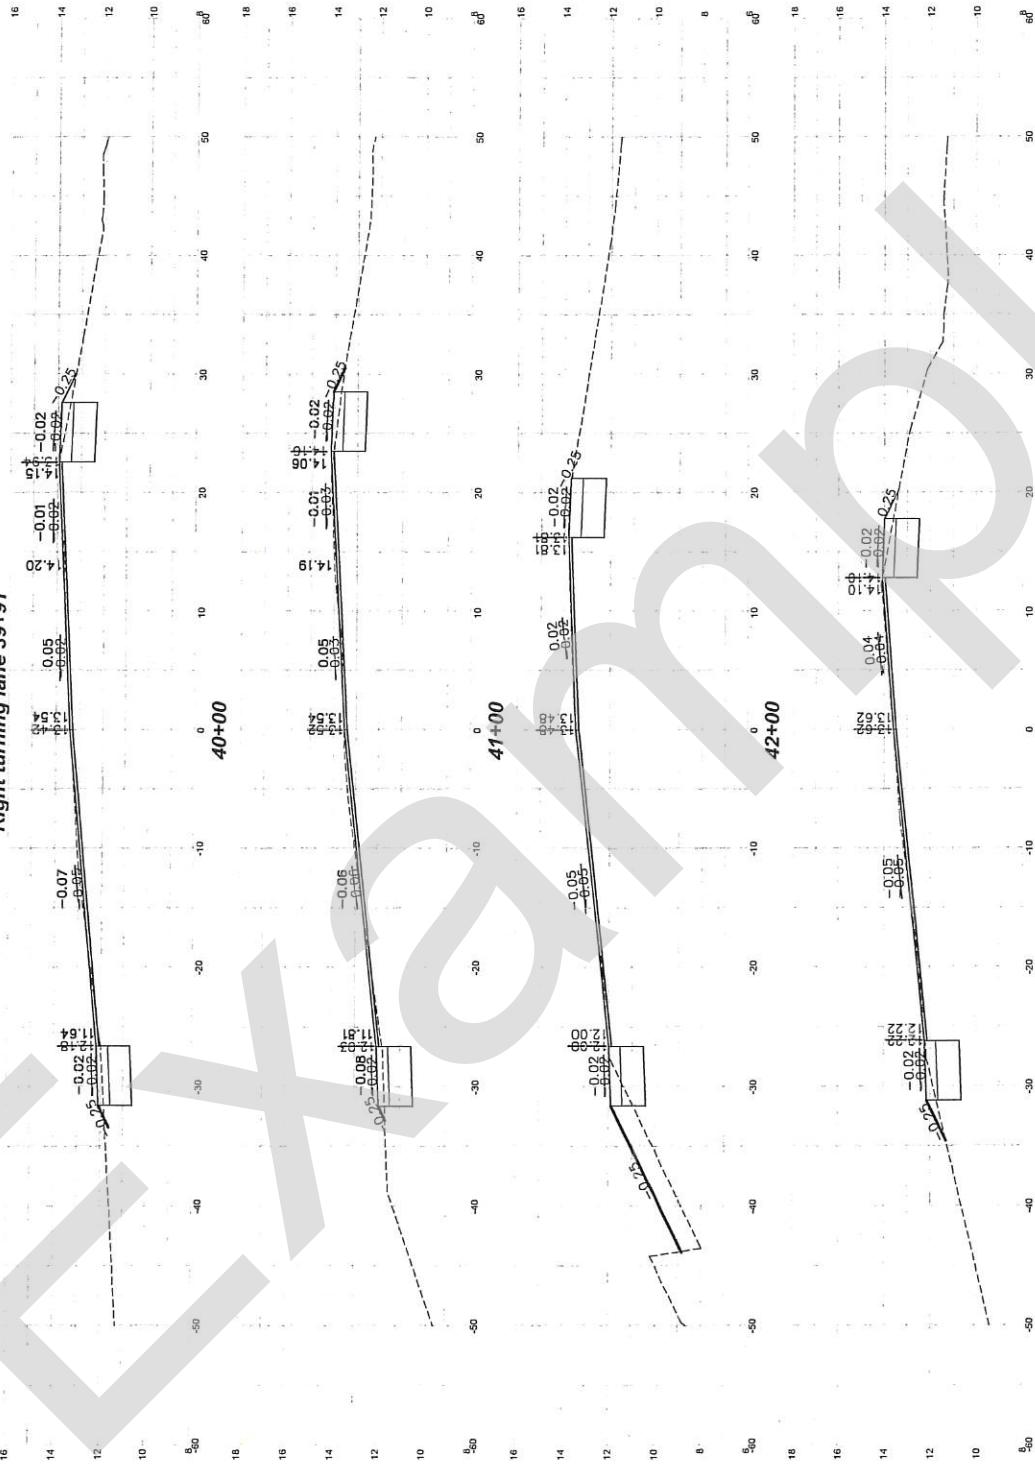

MARTIN COUNTY
PUBLIC WORKS
DEPARTMENT
2401 SIR MONTGOMERY RD.
STL. MARTIN COUNTY, FLORIDA
PHONE: (772) 286-5077
FAX: (772) 286-5955
www.martincountyfl.gov


DESIGNED BY:
DRAFTED BY:
SUBMITTED BY:
PLOT SCALE: PLATE DATE:
FILE NUMBER:
FILE NAME:
DATE APPROVED:

SAVANNAH ROAD RESURFACING & BIKE LANES
FM#438342-1-58-01
MARTIN COUNTY, FLORIDA
ROADWAY CROSS SECTIONS




SHEET
IDENTIFICATION
13

P&L-2013-01-C-CE
PL-2013-01-C-CE
SHEET 13 OF 14
P&L-2013-01-C-CE
SHEET 13 OF 14
SHEET 13 OF 14
SHEET 13 OF 14

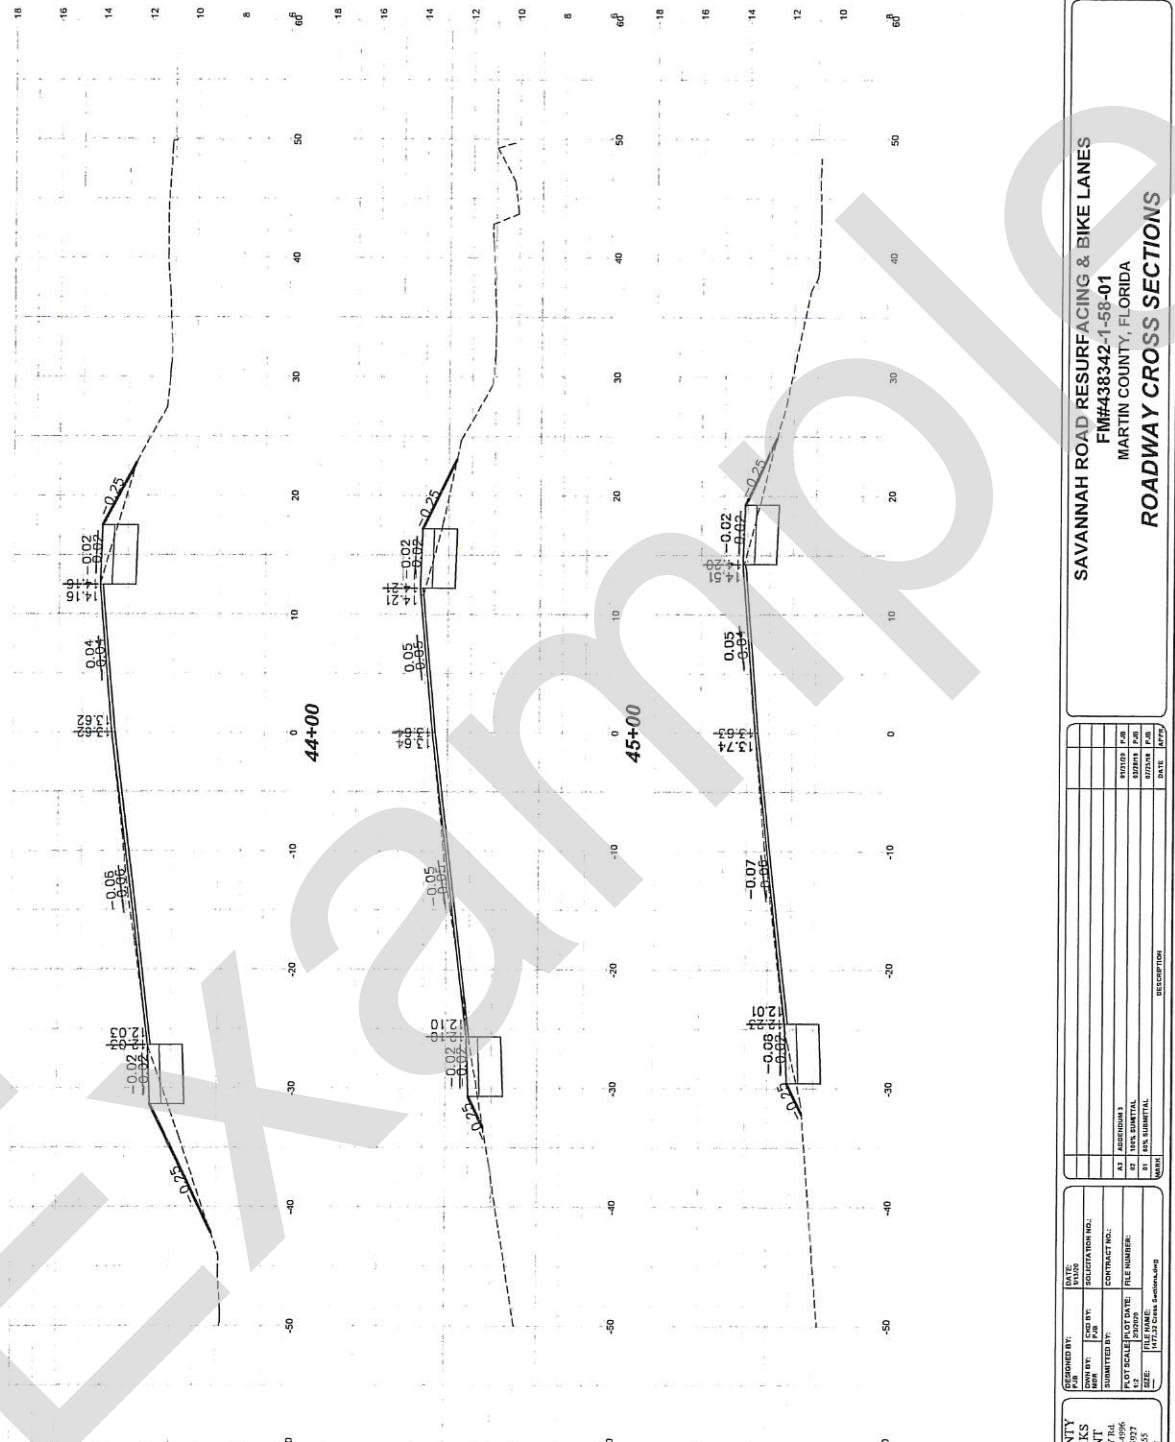

MARTIN COUNTY
PUBLIC WORKS
DEPARTMENT
2001 SE MONTEREY Rd.
STUART, FLORIDA 34996
PHONE: (772) 286-5077
FAX: (772) 286-5455
E-mail: WPS@MCOFL.GOV

DESIGNED BY:	DATE:
SUPERVISOR SIGN:	SIGNATURE:
CONTRACT NO.:	FILE NUMBER:
SUBMITTED BY:	DATE:
PLATE SCALE/PORT DATE:	PLATE NUMBER:
1:2000	100-2000
1:1000	100-1000
1:500	100-500
1:250	100-250
1:125	100-125
1:62.5	100-62.5
1:31.25	100-31.25
1:15.625	100-15.625
1:7.8125	100-7.8125
1:3.90625	100-3.90625
1:1.953125	100-1.953125
1:0.9765625	100-0.9765625
1:0.48828125	100-0.48828125
1:0.244140625	100-0.244140625
1:0.1220703125	100-0.1220703125
1:0.06103515625	100-0.06103515625
1:0.030517578125	100-0.030517578125
1:0.0152587890625	100-0.0152587890625
1:0.00762939453125	100-0.00762939453125
1:0.003814697265625	100-0.003814697265625
1:0.0019073486328125	100-0.0019073486328125
1:0.00095367431640625	100-0.00095367431640625
1:0.000476837158203125	100-0.000476837158203125
1:0.0002384185791015625	100-0.0002384185791015625
1:0.00011920928955078125	100-0.00011920928955078125
1:0.000059604644775390625	100-0.000059604644775390625
1:0.0000298023223876953125	100-0.0000298023223876953125
1:0.00001490116119384765625	100-0.00001490116119384765625
1:0.000007450580596923828125	100-0.000007450580596923828125
1:0.0000037252902984619140625	100-0.0000037252902984619140625
1:0.00000186264514923095703125	100-0.00000186264514923095703125
1:0.000000931322574615478515625	100-0.000000931322574615478515625
1:0.0000004656612873077392578125	100-0.0000004656612873077392578125
1:0.00000023283064365386962890625	100-0.00000023283064365386962890625
1:0.000000116415321826934814453125	100-0.000000116415321826934814453125
1:0.0000000582076609134674072265625	100-0.0000000582076609134674072265625
1:0.00000002910383045673370361328125	100-0.00000002910383045673370361328125
1:0.0000000145519152283668518064453125	100-0.0000000145519152283668518064453125
1:0.00000000727595761418342590322265625	100-0.00000000727595761418342590322265625
1:0.000000003637978807091712951611328125	100-0.000000003637978807091712951611328125
1:0.000000001818989403545856475855664453125	100-0.000000001818989403545856475855664453125
1:0.000000000909494701772928237927832265625	100-0.000000000909494701772928237927832265625
1:0.0000000004547473508864641189639161328125	100-0.0000000004547473508864641189639161328125
1:0.0000000002273736754432320594819580664453125	100-0.0000000002273736754432320594819580664453125
1:0.0000000001136868377216160297409790332265625	100-0.0000000001136868377216160297409790332265625
1:0.00000000005684341886080801487048951664453125	100-0.00000000005684341886080801487048951664453125
1:0.00000000002842170943040400743924475832265625	100-0.00000000002842170943040400743924475832265625
1:0.0000000000142108547152020037196223791328125	100-0.0000000000142108547152020037196223791328125
1:0.0000000000071054273576010018598111895664453125	100-0.0000000000071054273576010018598111895664453125
1:0.0000000000035527136788005009299555978332265625	100-0.0000000000035527136788005009299555978332265625
1:0.00000000000177635683940025046497779891664453125	100-0.00000000000177635683940025046497779891664453125
1:0.00000000000088817841970012523248889949332265625	100-0.00000000000088817841970012523248889949332265625
1:0.00000000000044408920985006261624444974664453125	100-0.00000000000044408920985006261624444974664453125
1:0.00000000000022204460492503130812222473332265625	100-0.00000000000022204460492503130812222473332265625
1:0.00000000000011102230246251565406111221664453125	100-0.00000000000011102230246251565406111221664453125
1:0.000000000000055511151231257827030556108332265625	100-0.000000000000055511151231257827030556108332265625
1:0.0000000000000277555756156289135152780541664453125	100-0.0000000000000277555756156289135152780541664453125
1:0.0000000000000138777878078144567585390270832265625	100-0.0000000000000138777878078144567585390270832265625
1:0.00000000000000693889390390722837926951354664453125	100-0.00000000000000693889390390722837926951354664453125
1:0.00000000000000346944695195361119663475677332265625	100-0.00000000000000346944695195361119663475677332265625
1:0.00000000000000173472347597680559831787838664453125	100-0.00000000000000173472347597680559831787838664453125
1:0.00000000000000086736173798840279915939194332265625	100-0.00000000000000086736173798840279915939194332265625
1:0.000000000000000433680868994201399597695971664453125	100-0.000000000000000433680868994201399597695971664453125
1:0.000000000000000216840434497100699798897958332265625	100-0.000000000000000216840434497100699798897958332265625
1:0.0000000000000001084202172485503498944949791664453125	100-0.0000000000000001084202172485503498944949791664453125
1:0.0000000000000000542101086242751994972474945832265625	100-0.0000000000000000542101086242751994972474945832265625
1:0.000000000000000027105054312137599748623747291664453125	100-0.000000000000000027105054312137599748623747291664453125
1:0.00000000000000001355252715606879982431887364664453125	100-0.00000000000000001355252715606879982431887364664453125
1:0.00000000000000000677626357803439941215943682332265625	100-0.00000000000000000677626357803439941215943682332265625
1:0.00000000000000000338813178901719920607971841664453125	100-0.00000000000000000338813178901719920607971841664453125
1:0.00000000000000000169406589450859910303985920832265625	100-0.00000000000000000169406589450859910303985920832265625
1:0.0000000000000000008470329472542990015079479041664453125	100-0.0000000000000000008470329472542990015079479041664453125
1:0.000000000000000000423516473627148998503723920832265625	100-0.000000000000000000423516473627148998503723920832265625
1:0.0000000000000000000000000031558249445068550231565592023832265625	100-0.0000000000000000000000000031558249445068550231565592023832265625
1:0.000000000000000000000000001577912472253427511578277911947832265625	100-0.000000000000000000000000001577912472253427511578277911947832265625
1:0.000000000000000000000000000788956236126713755889139056191664453125	100-0.000000000000000000000000000788956236126713755889139056191664453125
1:0.0000000000000000000000000003944781180633568	

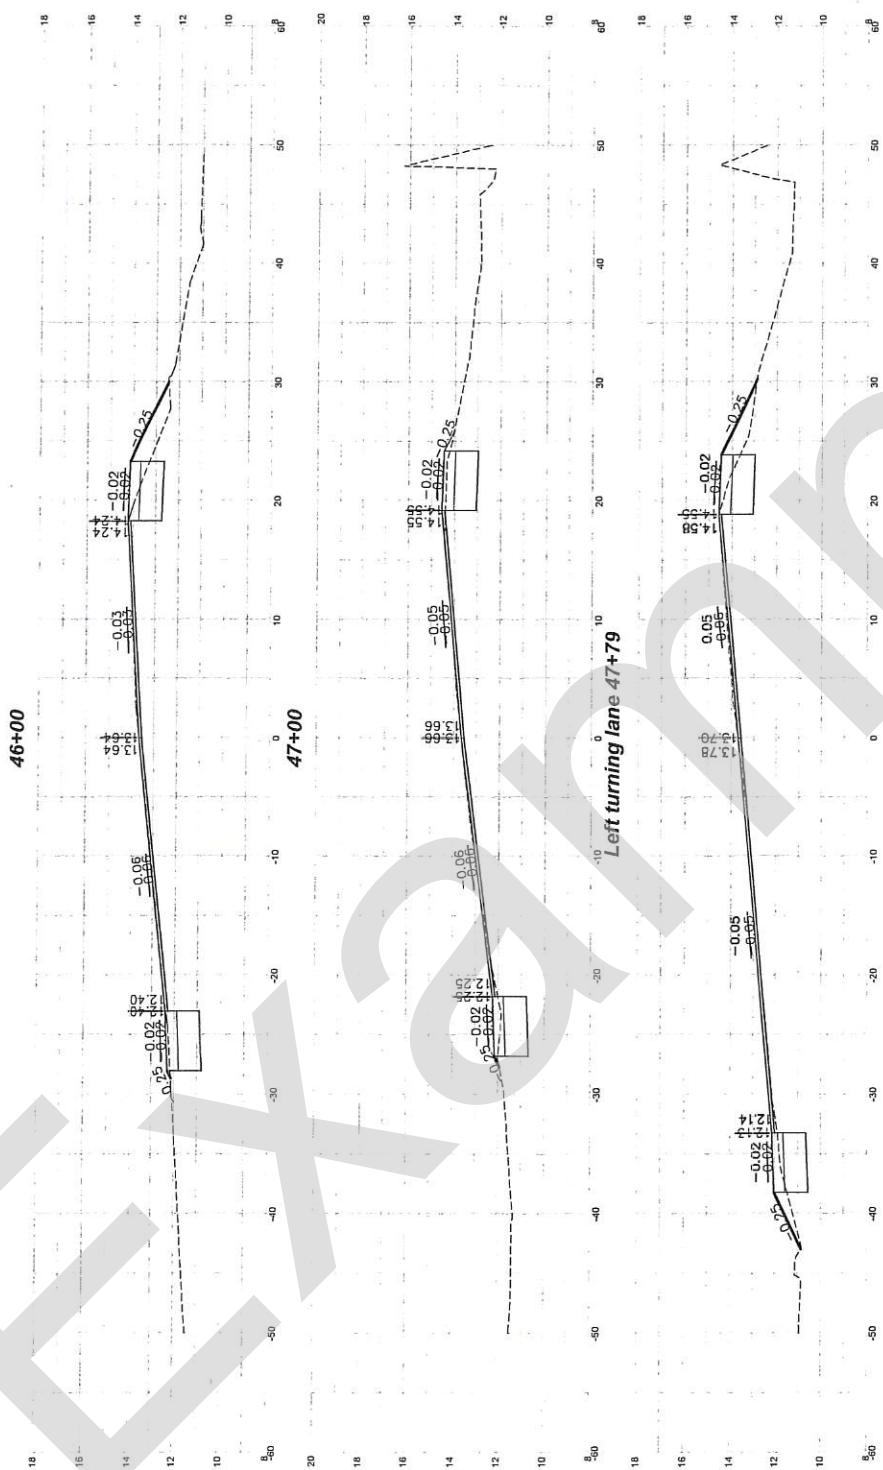

MARTIN COUNTY
PUBLIC WORKS
DEPARTMENT
2601 S. MONTEREY RD.
SUITE 100
STUART, FL 34997
PHONE: (772) 284-5977
FAX: (772) 284-5955
www.martincountyfl.gov


SAVANNAH ROAD RESURFACING & BIKE LANES
FM#438342-1-58-01
MARTIN COUNTY, FLORIDA
ROADWAY CROSS SECTIONS

DESIGNED BY:	TYPE:	TRANS.
DRW:	CURB & GUTTER:	SOLUTION NO.:
IN:	PER:	
SUBMITTED BY:	CONTRACT NO.:	
	A2 ADVERTISING	
	A3 1995 SUMMITAL	
	A4 FILE NUMBER:	
	A5 DATE:	
	A6 NAME:	
	A7 14722 Cross Section Drawing	
	NAME:	

SAVANNAH ROAD RESURFACING & BIKE LANES
FM#438342-1-58-01
MARTIN COUNTY, FLORIDA
ROADWAY CROSS SECTIONS



Right turning lane 53+30

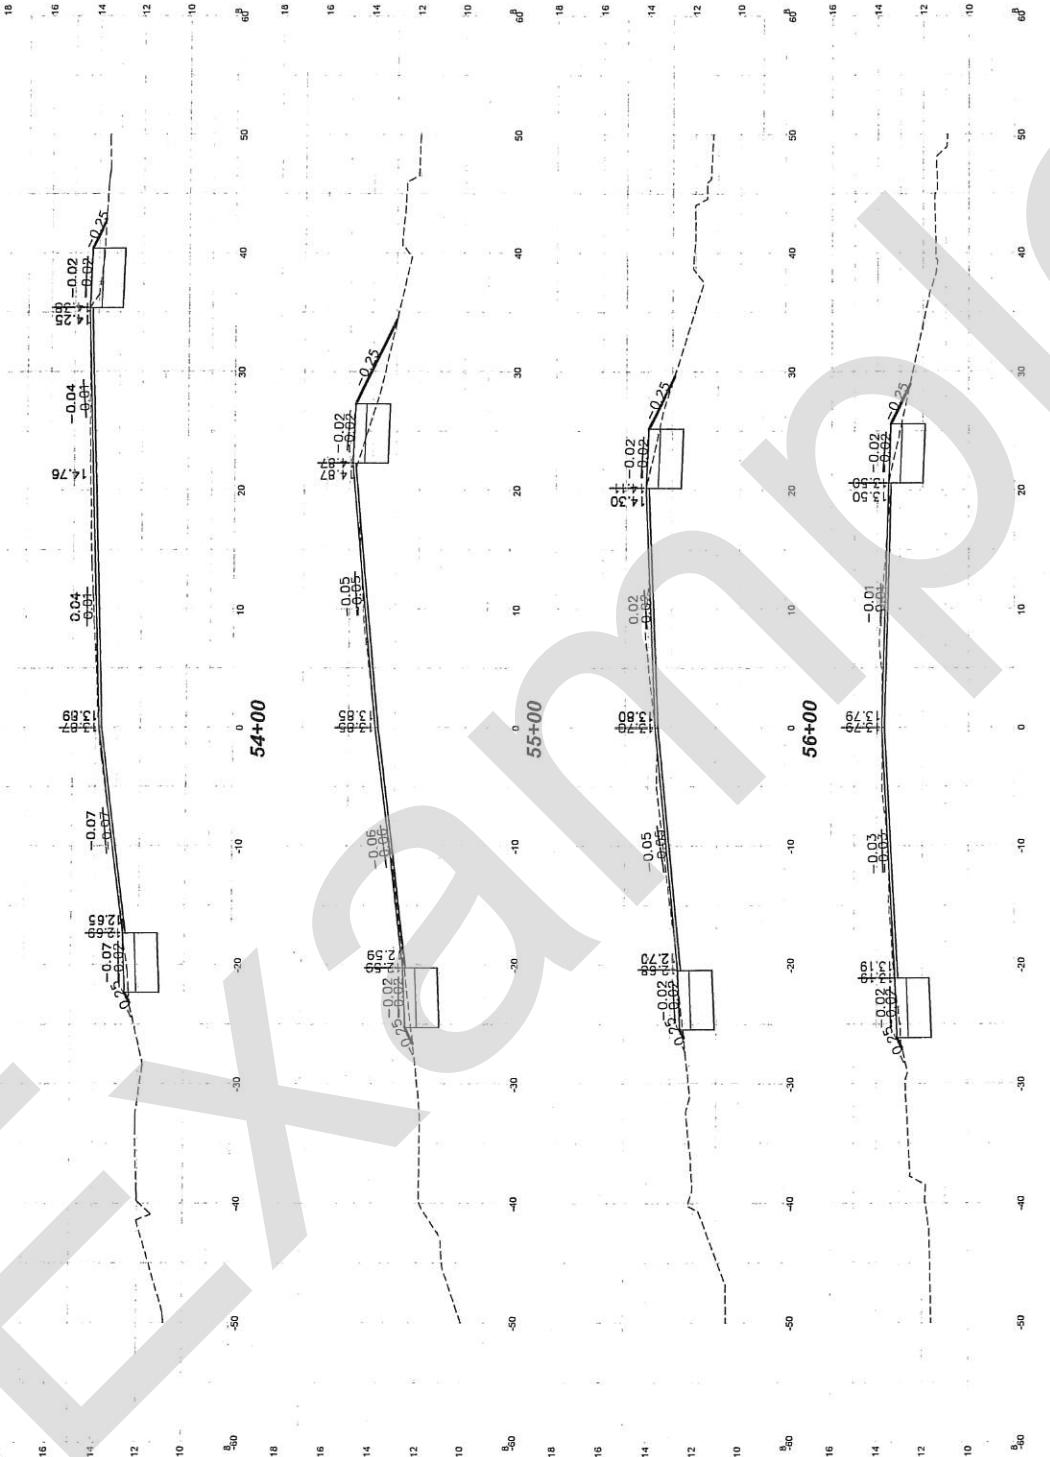

MARTIN COUNTY
PUBLIC WORKS
DEPARTMENT
2401 SE MONTEREY RD
STUART, FLORIDA 34996
PHONE: (772) 288-5927
FAX: (772) 288-5955
www.martin.fl.us





SEARCHED BY:	DATE: 1/17/20
SERIALIZED BY:	SPECIFICATION NO.: CONTRACT NO.:
INDEXED BY:	FILE NUMBER:
PLOTTED BY:	PLOT DATE: 2/28/01
FILE NAME:	147-22 Cris's Sweet Home.dwg

SAVANNAH ROAD RESURFACING & BIKE LANES	
FM#438342-1-58-01	
MARTIN COUNTY, FLORIDA	
ROADWAY CROSS SECTIONS	
<p>Project Engineer: R. E. S. Date: 10/10/19 Site ID: FL 438342 P.E. No. 3488</p>	
SHEET IDENTIFICATION	17
SHEET 17 OF 18	

	PJD
	PJB
	PJB
	PJB
	APPB

Left turning lane 57+12

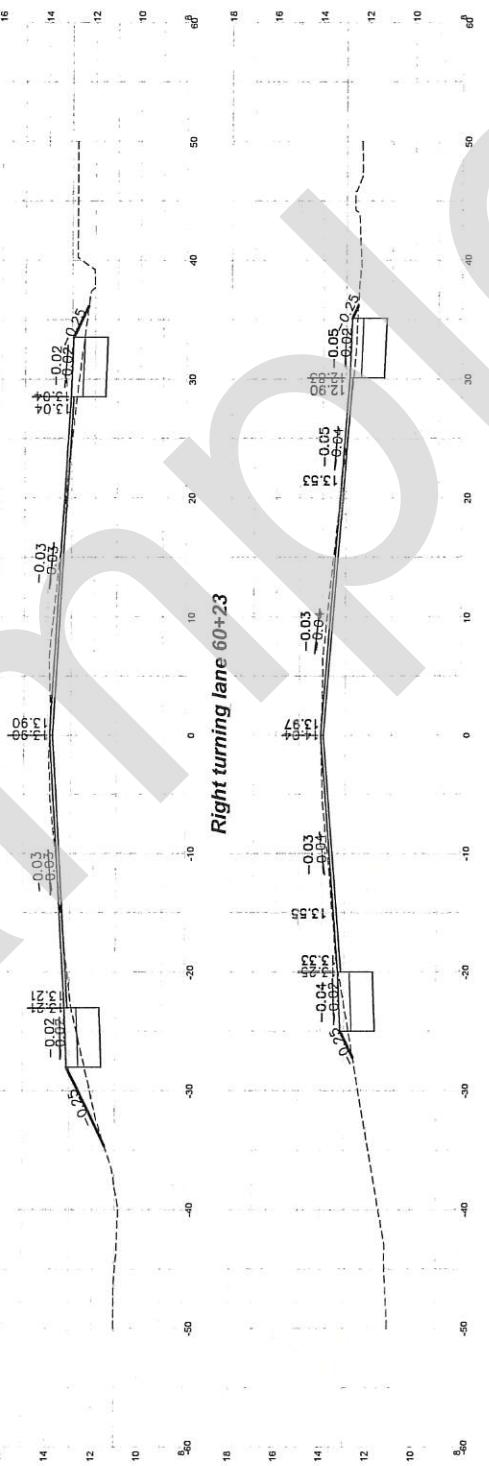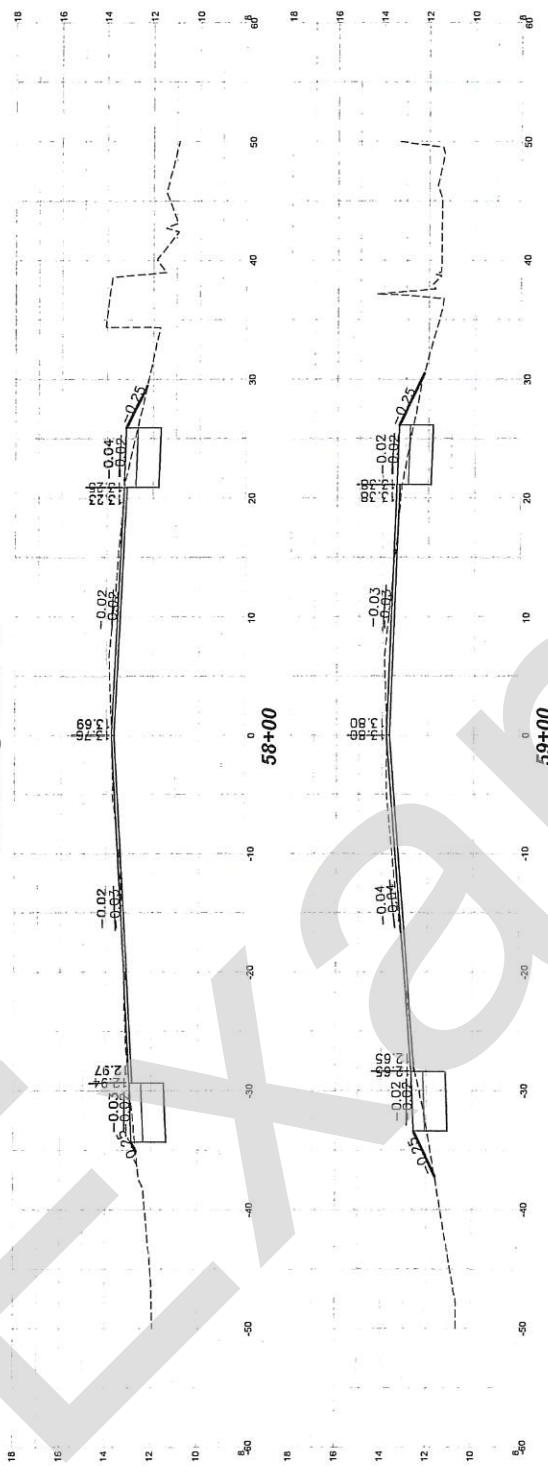


MARTIN COUNTY
PUBLIC WORKS
DEPARTMENT
2401 SE MONTEREY RD.
STUART, FLORIDA 34996
PHONE: (772) 288-5927
FAX: (772) 288-5935
www.martin.fl.us

			PJII
			PJII
			PJII
			APPR

18

18

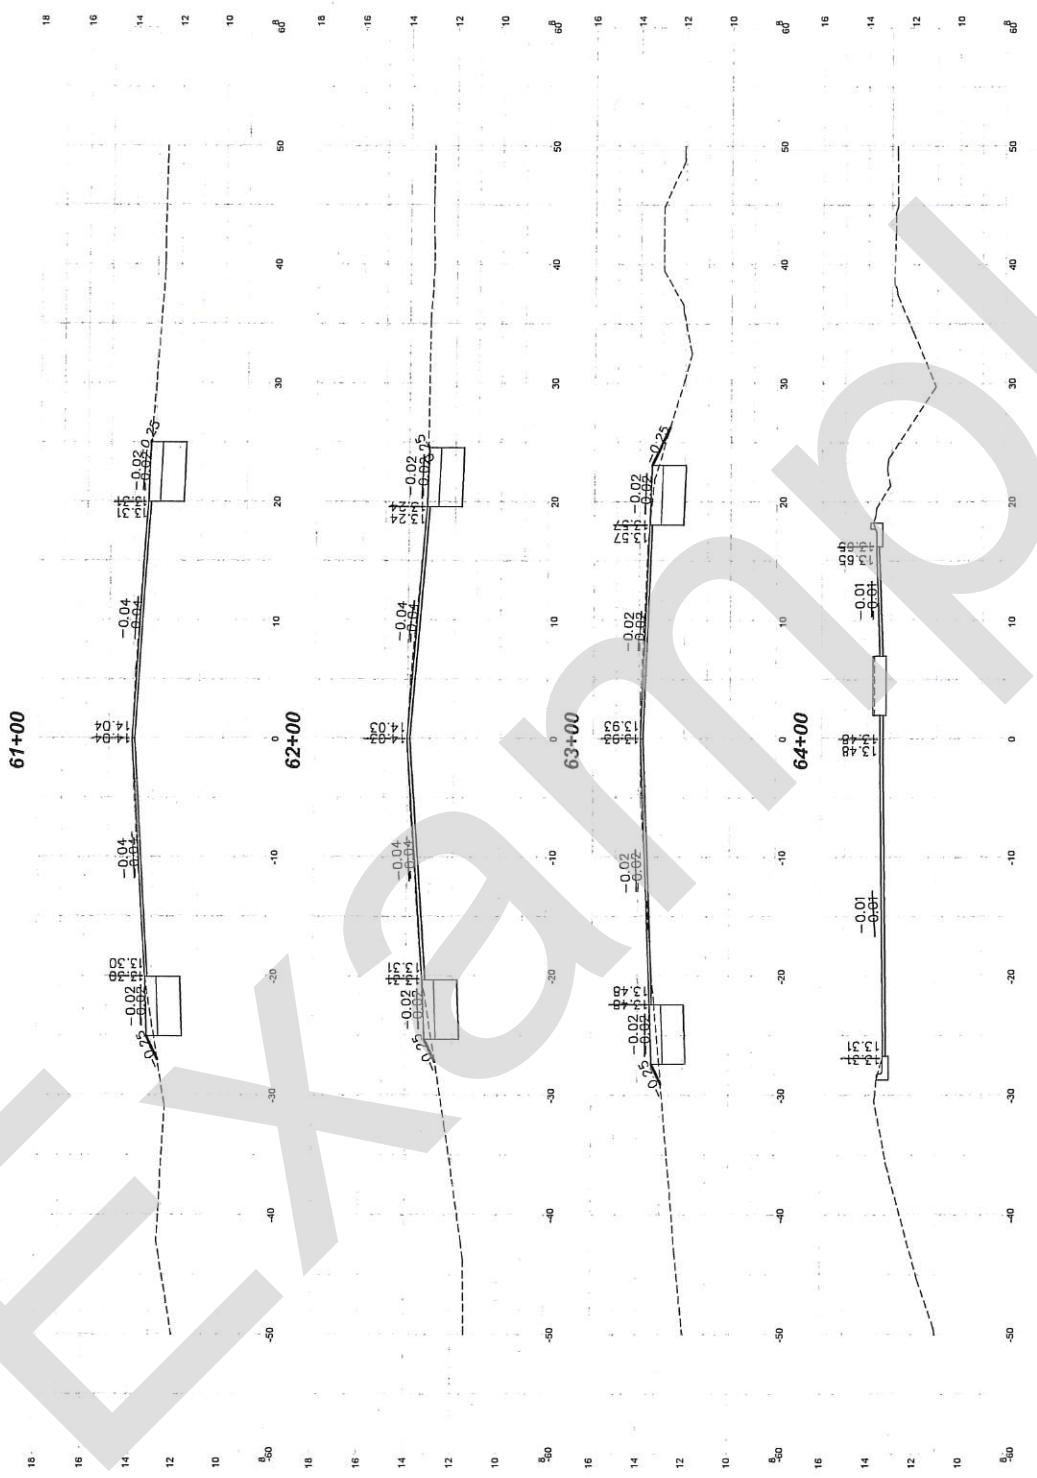

MARTIN COUNTY
PUBLIC WORKS
DEPARTMENT
2401 SE MONTBERRY RD.
STUART, FLORIDA 34996
PHONE: (772) 288-5927
FAX: (772) 288-5955
www.martin.fl.us




SAVANNAH ROAD RESURFACING & BIKE LANES
FM#438342-1-58-01
MARTIN COUNTY, FLORIDA

ROADWAY CROSS SECTIONS

INNAH ROAD RESURFACI
FM#438342-1-58-
MARTIN COUNTY, FLO

SHEET 19 OF 24

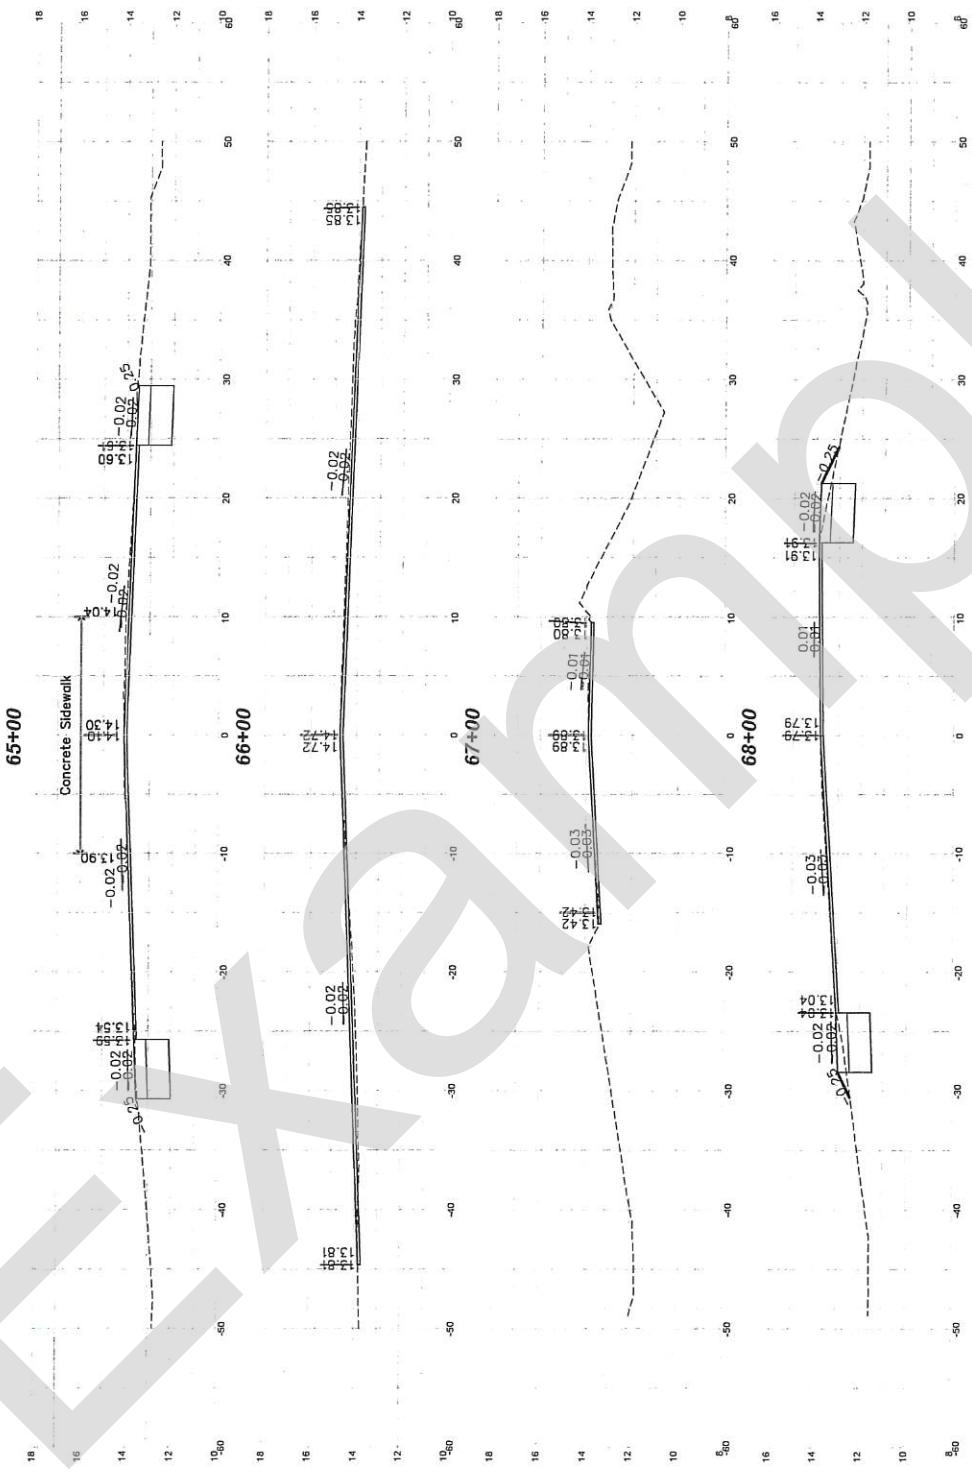

MARTIN COUNTY
PUBLIC WORKS
DEPARTMENT
2401 SE MONTEREY Rd.
STUART, FLORIDA 34996
PHONE: (772) 288-5927
FAX: (772) 288-5955
www.martin.fl.us




DESIGNED BY:	DATE:
115	11/15/2008
OWN BY:	SOLICITATION NO.:
P&H	
SUBMITTED BY:	CONTRACT NO.:
PILOT SCALE	PROD DATE:
1.2	20/02/09
SIZE:	FILE NAME:
	14817-2008-Submittal-001.qxd

SAVANNAH ROAD RESURFACING & BIKE LANES
FM#438342-1-58-01
MARTIN COUNTY, FLORIDA
ROADWAY CROSS SECTIONS

ROADWAY CROSSINGS
MARTIN COUNTY, FLC
FM#438342-1-38

20 OF 24

2

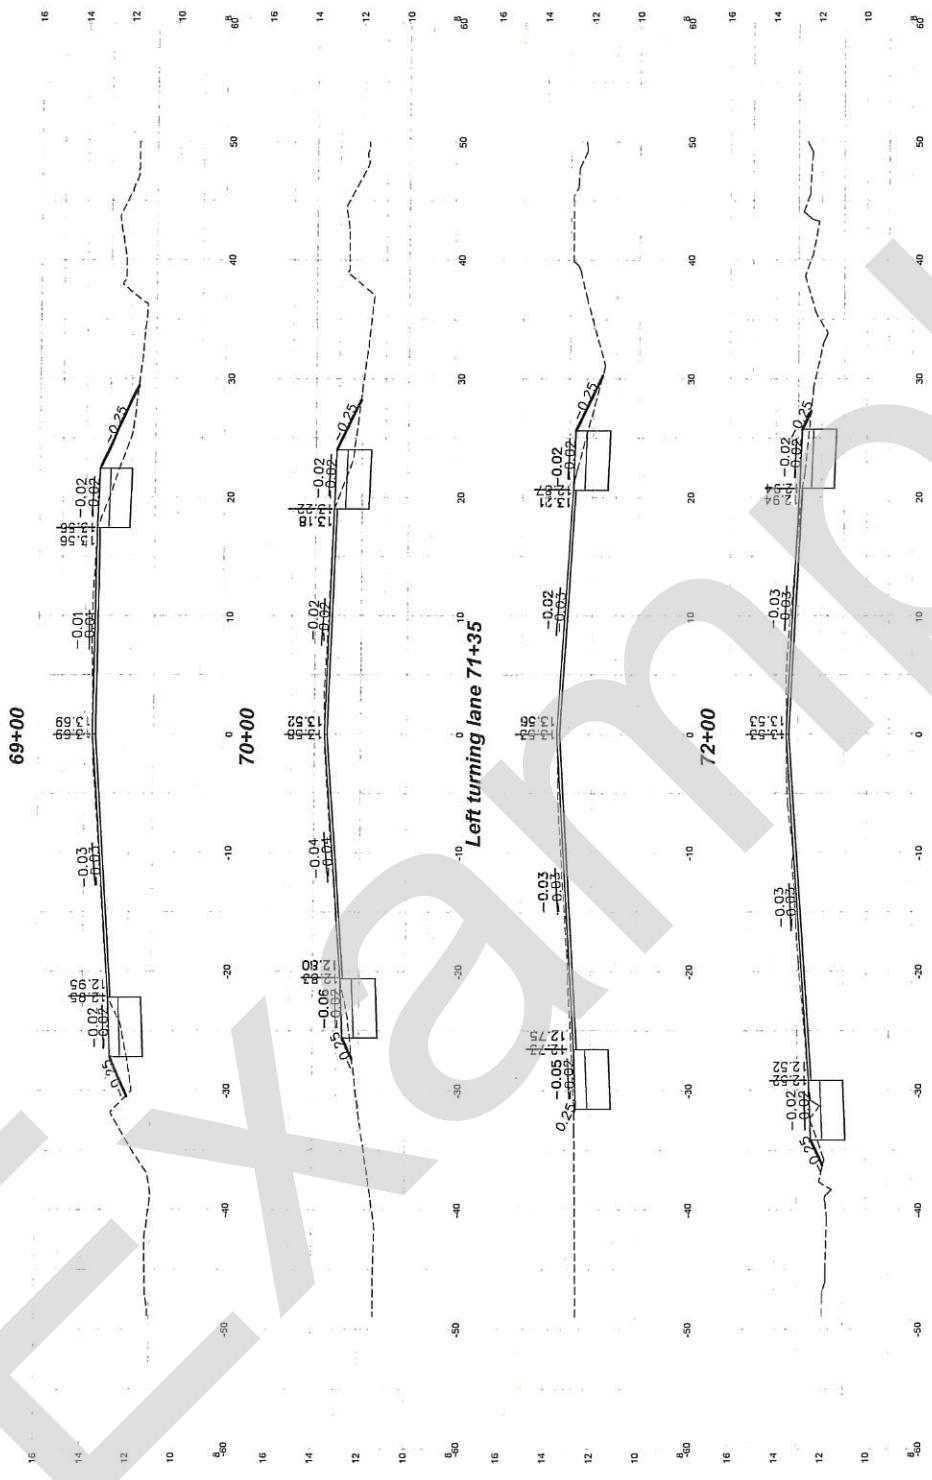

MARTIN COUNTY
PUBLIC WORKS
DEPARTMENT
2401 SE MONTEREY Rd.
STUART, FLORIDA 34996
PHONE: (772) 288-5927
FAX: (772) 288-5955
Please mention that you saw this ad in the newspaper.




SAVANNAH ROAD RESURFACING & BIKE LANES
FM#438342-1-58-01
MARTIN COUNTY, FLORIDA
ROADWAY CROSS SECTIONS

DESIGNED BY:	PJB	DATE:	1/15/20
DRAWN BY:	WHR	SOLICIT:	
SUBMITTED BY:		CONTR:	
PLOT SCALE:	1:2000	PLOT DATE:	2/12/99
SEZ:	147.13 Cross Sectioning		

SHEET IDENTIFICATION	
21	
Printed Name _____ 211 SE Munyon Rd. Stuart, FL 34996 P.E. No. 38096	
Date <i>[Signature]</i>	Date <i>[Signature]</i>

10

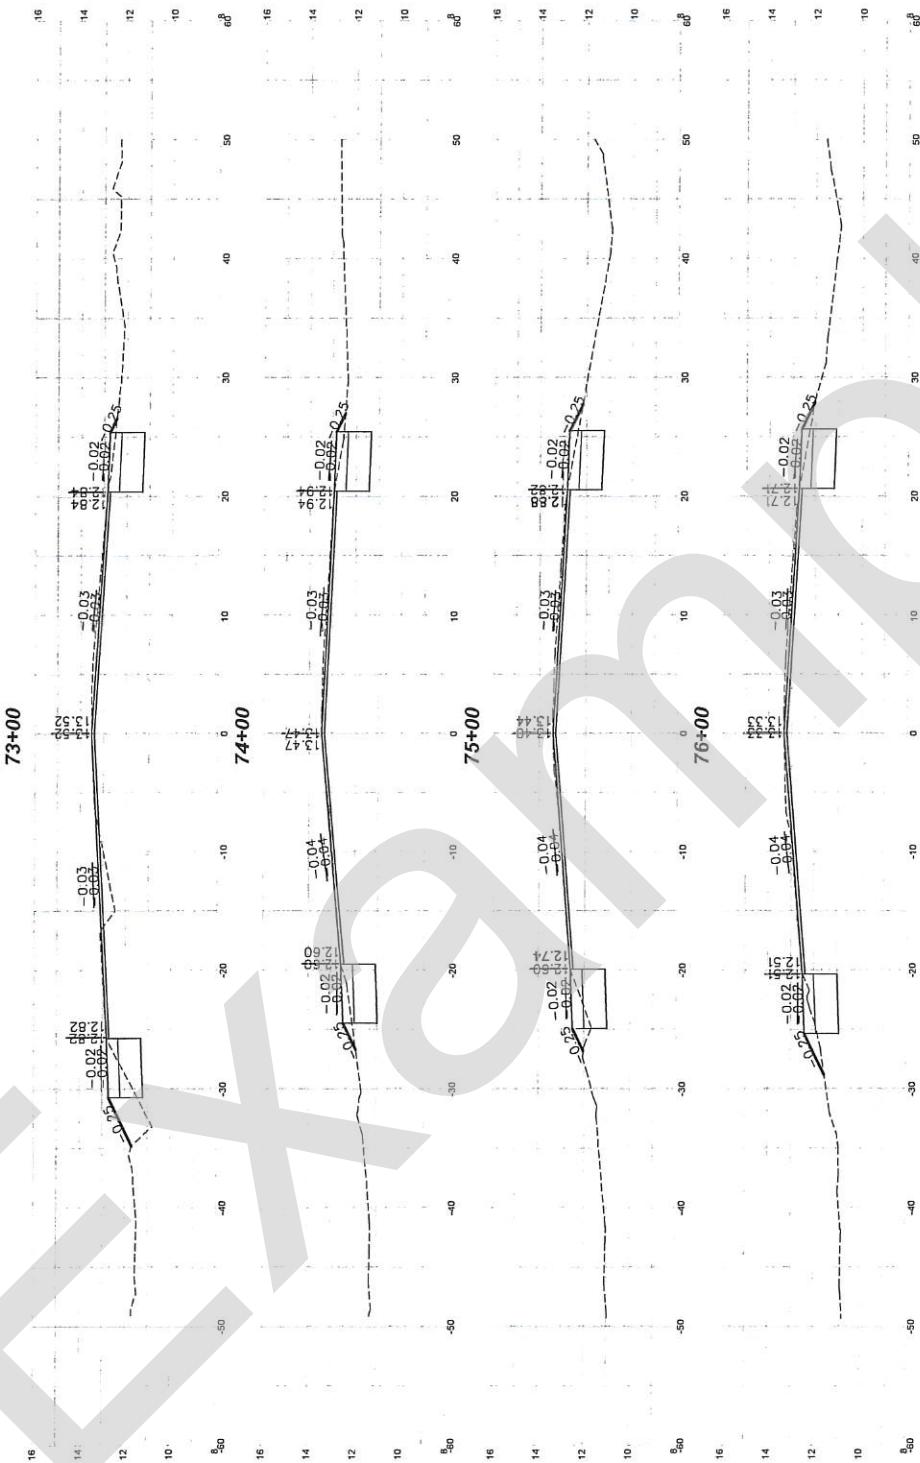


DESIGNED BY:		DATE:	
NAME	INITIALS	MONTH	YEAR
SCOTT A. TAYLOR	SAT	APR	2006
CONTRACT NO.:			
SUBMITTED BY:			
FOR SCALE TO DATE:			
2006			
PHONE: (772) 284-5927			
FAX: (772) 284-5925			
FILE NAME: 047321444			
WORKS: Martin Bldg			

SAVANNAH ROAD RESURFACING & BIKE LANES
FM#438342-1-58-01
MARTIN COUNTY, FLORIDA
ROADWAY CROSS SECTIONS



SHEET IDENTIFICATION
22
 SHEET 22 OF 24

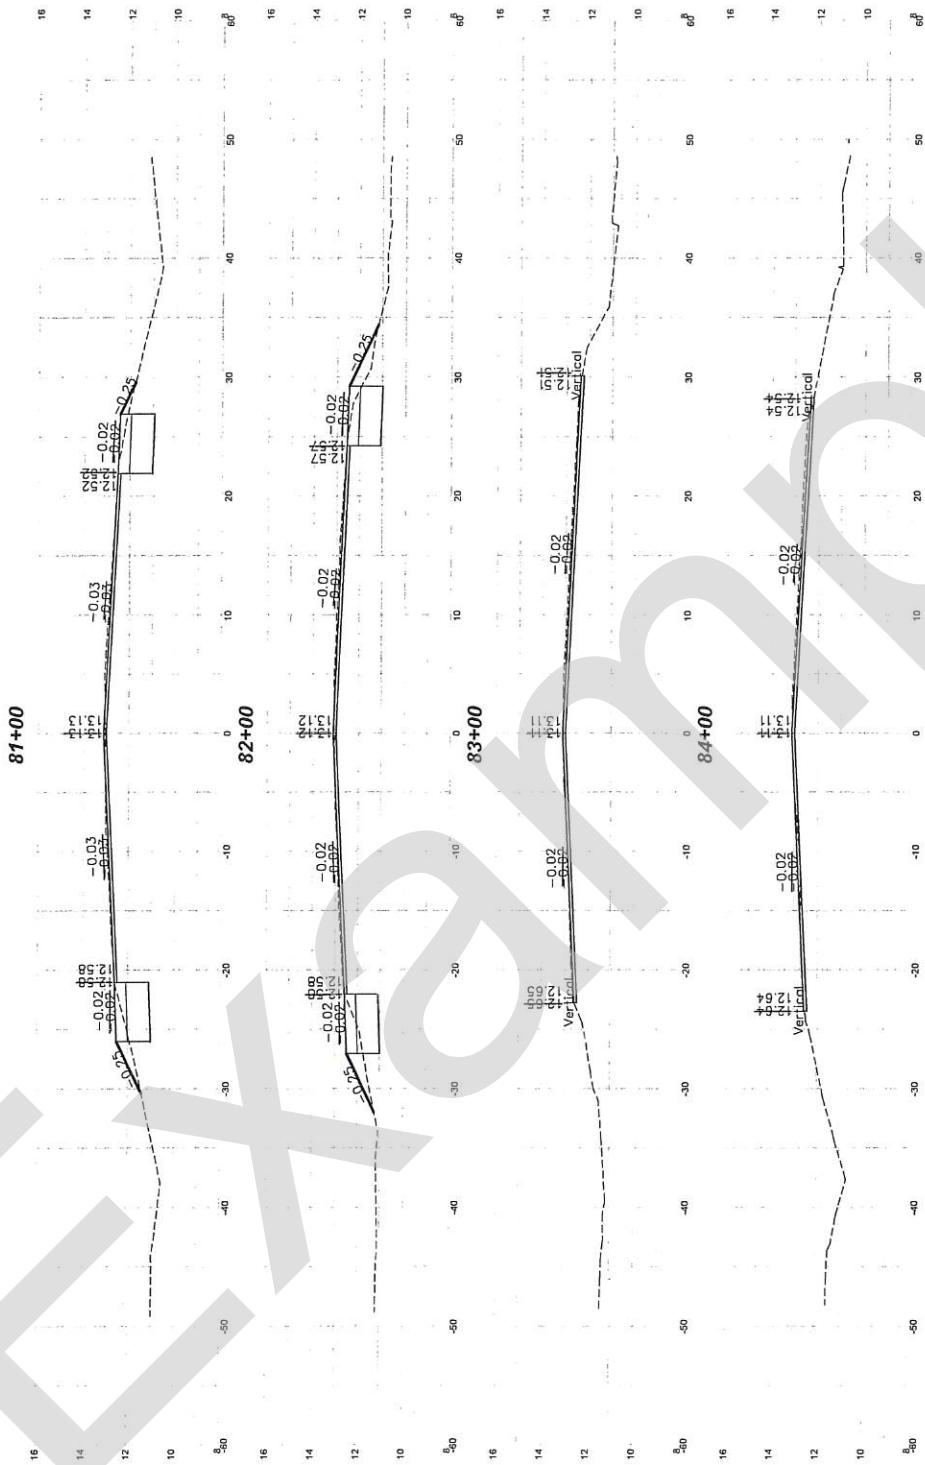

SAVANNAH ROAD RESURFACING & BIKE LANE
FM#438342-1-58-01
MARTIN COUNTY, FLORIDA

ADMISSIONS

A1	1954-55 SEMESTER	RECEIVED
B1	1954-55 SEMESTER	RECEIVED
SHEET
IDENTIFICATION
24

10

107176



SAVANNAH ROAD RESURFACING & BIKE LANES
FM#438342-1-58-01
MARTIN COUNTY, FLORIDA
ROADWAY CROSS SECTIONS


P-20	P-21
P-22	P-23
P-24	P-25

DESIGNED BY: F-JB	DATE: 11/20/20
DRAWN BY: F-JB	SOLICITATI CONTRACT
SUBMITTED BY: F-JB	
PLOT SCALE: 1/2	PLOT DATE: FILE NUMBER:
GAGE: 1/2	FILE NAME:



**MARTIN COUNTY
PUBLIC WORKS
DEPARTMENT**
2401 SE MONTBERRY Rd.
STUART, FLORIDA 34996
PHONE: (772) 288-5927
FAX: (772) 288-5955

1

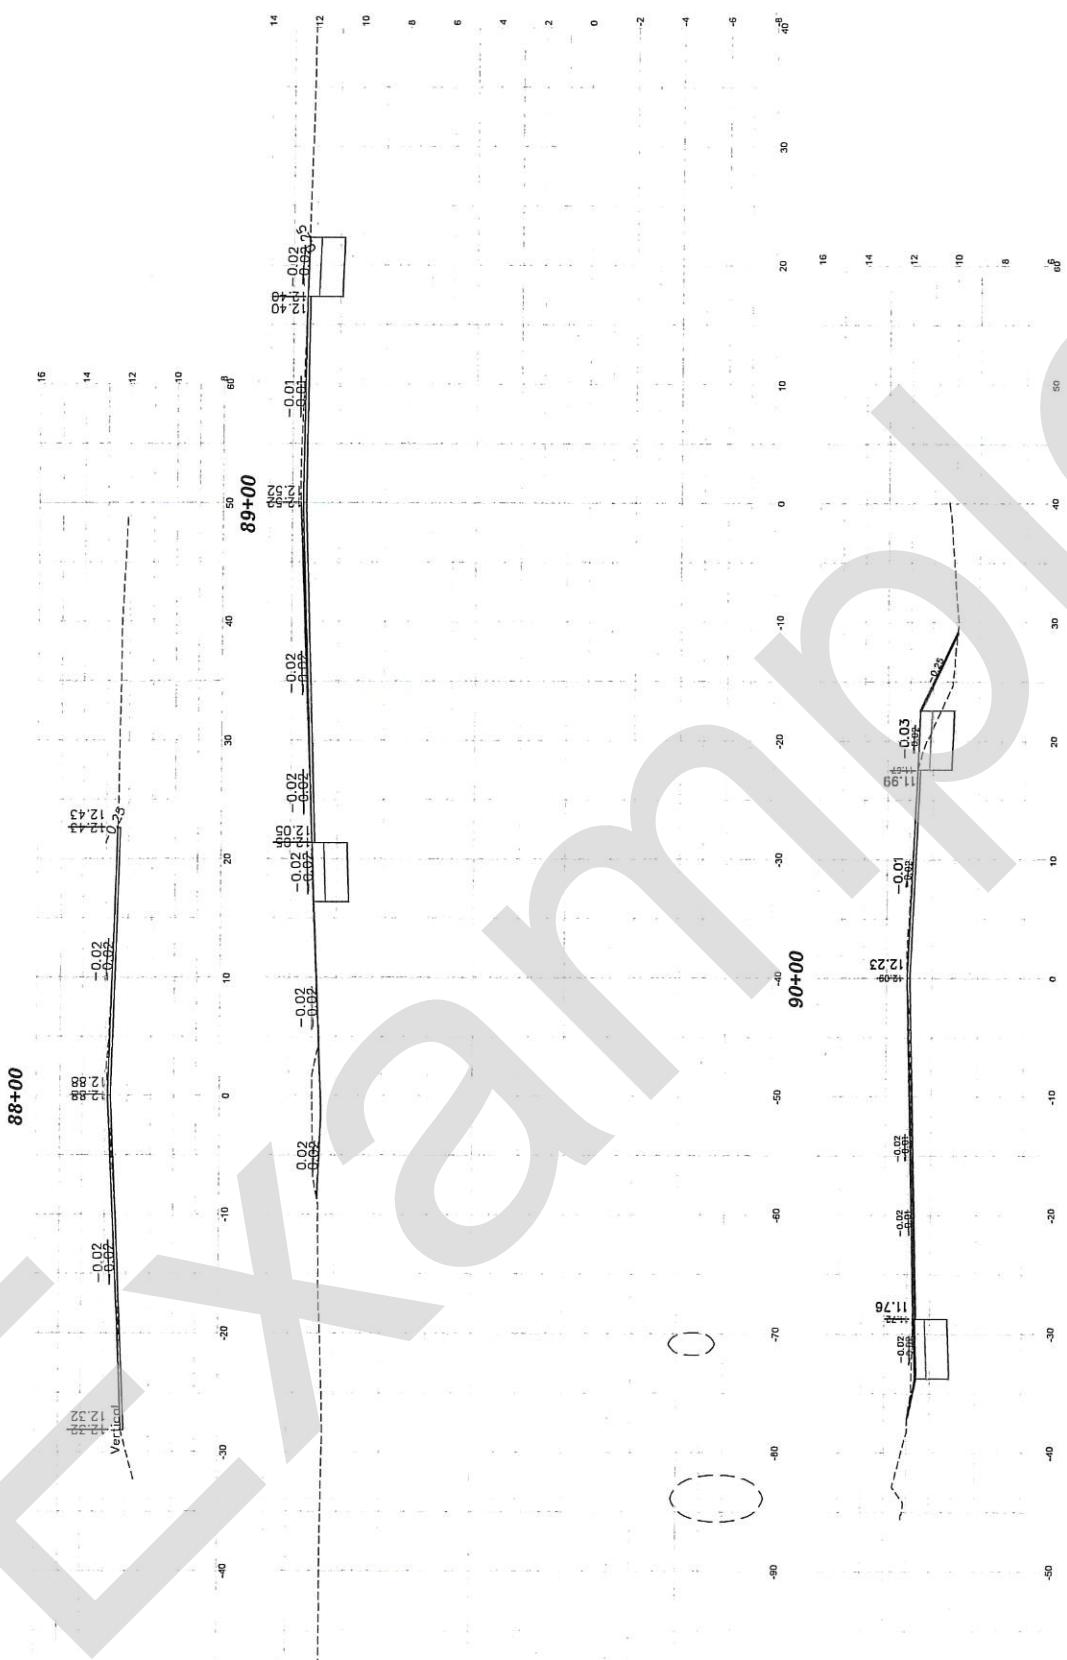

MARIN COUNTY
PUBLIC WORKS
DEPARTMENT
2401 SE MONTEREY Rd.
STUART, FLORIDA 34996
PHONE: (772) 288-5927
FAX: (772) 288-5955
www.marinfl.us




SAVANNAH ROAD RESURFACING & BIKE LANES

FM#438342-1-58-0
MARTIN COUNTY, FLORIDA
ROADWAY CROSS SECTION


SHEET 26 OF 34

100


91+00

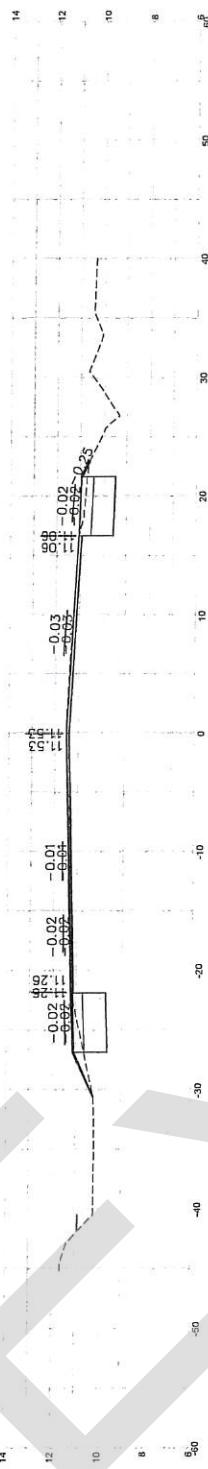


92+00

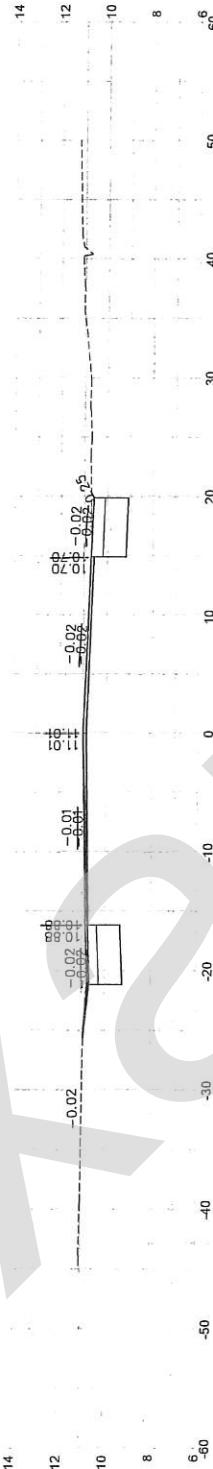


93+00

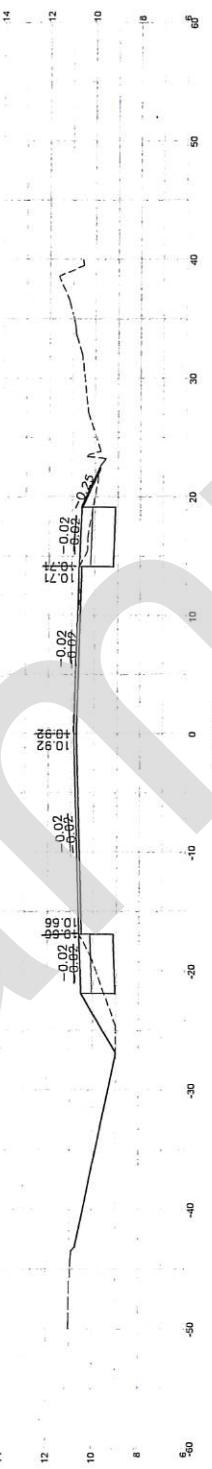


94+00

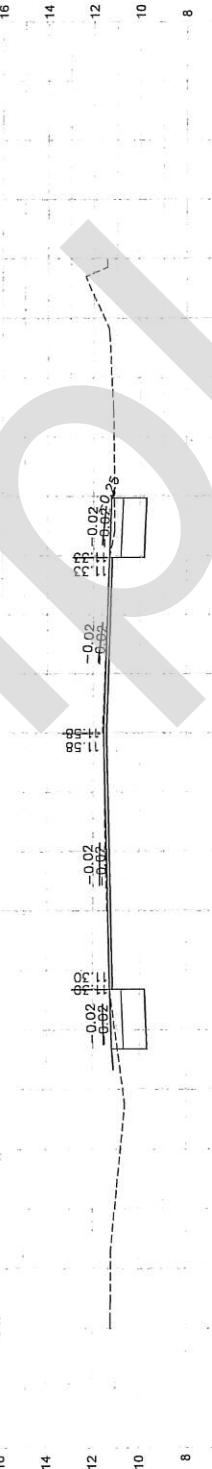

SAVANNAH ROAD RESURFACING & BIKE LANES	
FM#438342-1-58-01	
MARTIN COUNTY, FLORIDA	
ROADWAY CROSS SECTIONS	
Prepared by: MARTIN COUNTY PUBLIC WORKS DEPARTMENT Drawn by: CEDAR V. SAWYER Submitted by: PLATINUM CONTRACTING INC. Plot Scale: 1:2000 Plot Date: 10/20/2016 File Name: 142732 Cross Sections Size: 142732 Cross Sections	
SHEET IDENTIFICATION 27 Sheet 27 of 24	
Printed by: PLATINUM CONTRACTING INC. 7201 SE Moonlight Rd., Suite 100 Stuart, FL 34996 File No. 14298 Date: 10/20/2016 Signature: [Signature]	

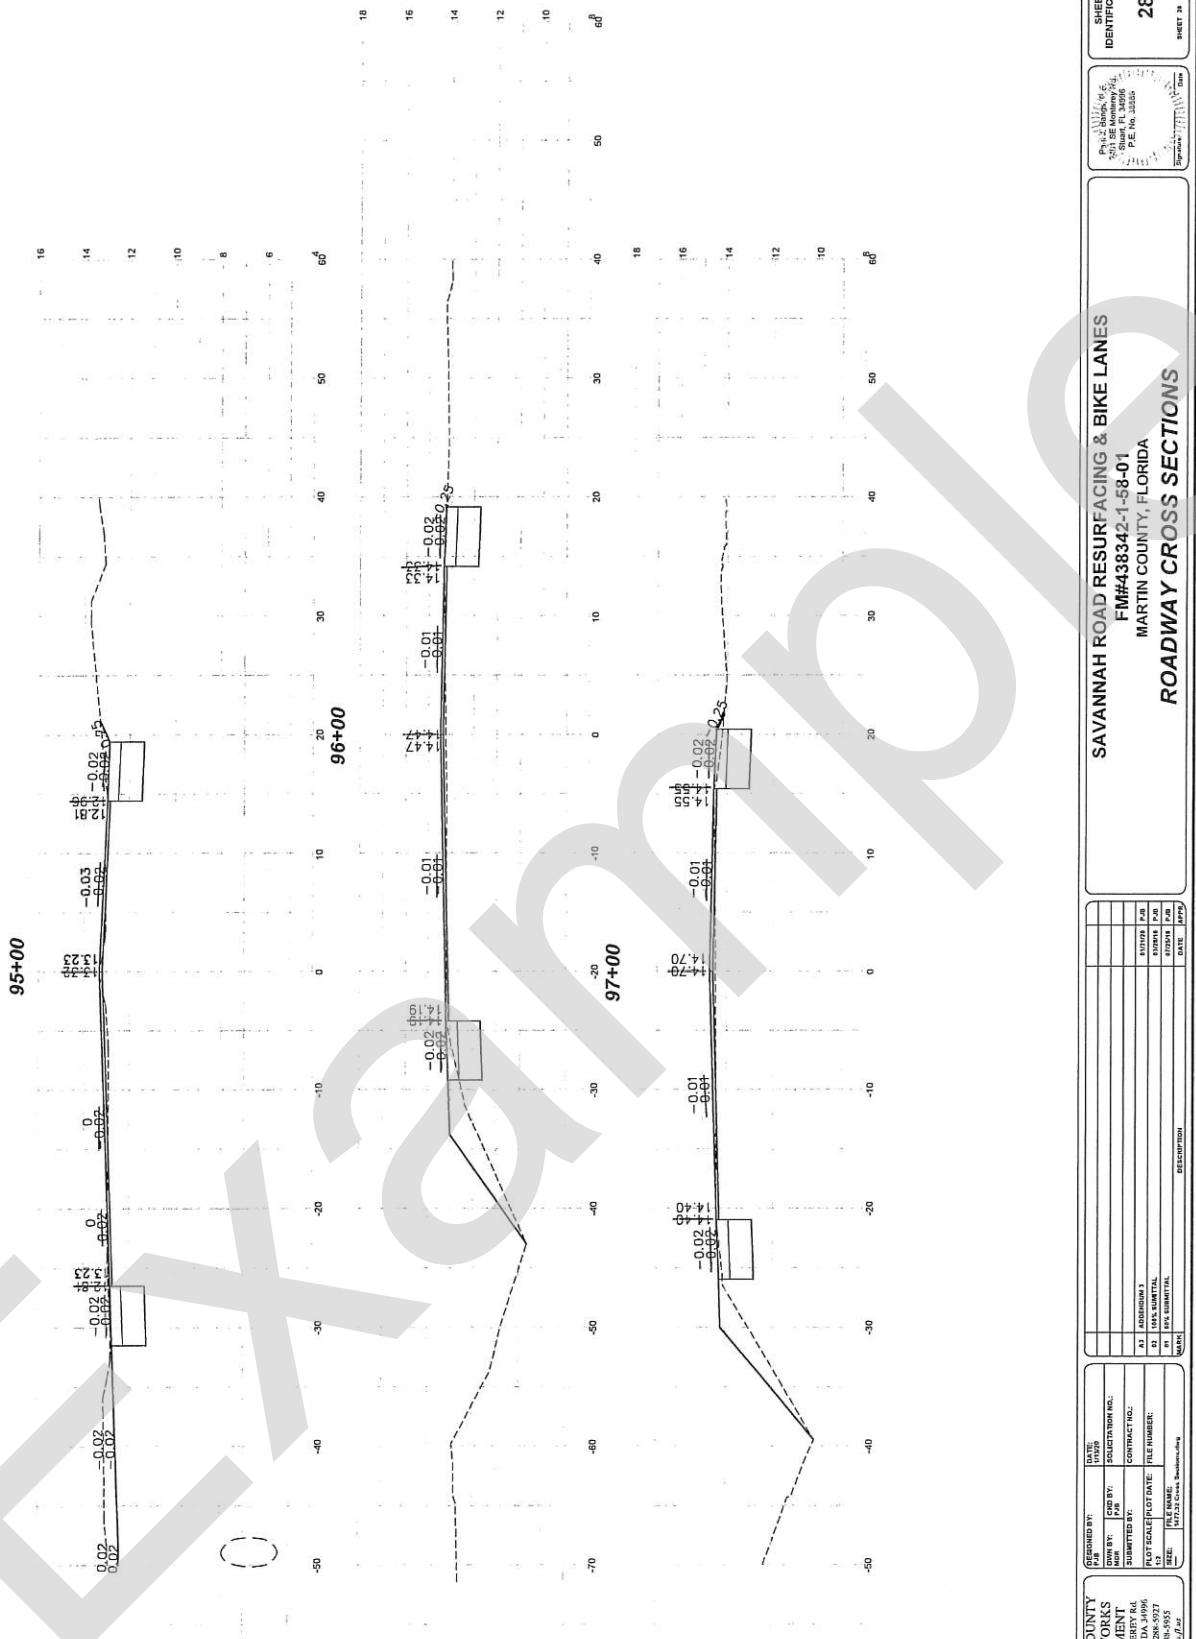

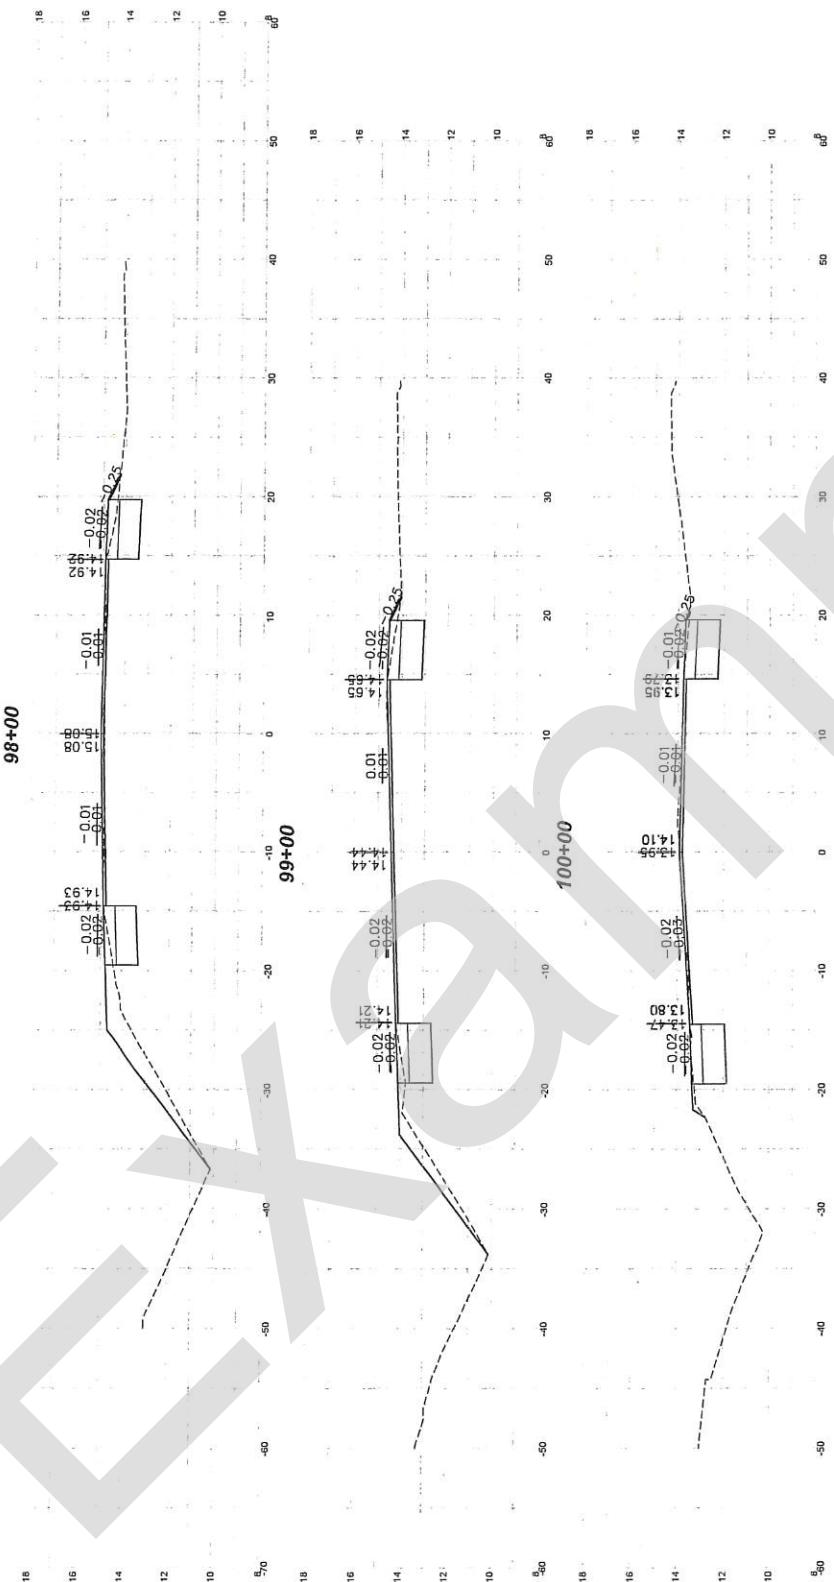


PLANNED BY:	DATE:
DRAWN BY: NAME:	REVISION NO.: PAGE
SUBMITTED BY:	CONTRACTOR INC.
PLATE SCALE/PILOT DATE:	STATION: R-00 ELEVATION: R-00 SLOPE: 0.00 GRADE: 0.00 FILE NAME: 1072-2 Cross Sections.dwg DATE: 10/25/2011
NAME:	DESCRIPTION


SAVANNAH ROAD RESURFACING & BIKE LANES	
FIM#438342-1-58-01	FILE NUMBER: 438342-1-58-01
MARTIN COUNTY, FLORIDA	DATE: 10/25/2011
ROADWAY CROSS SECTIONS	TIME: 10:45 AM

Planned by: Martin County, FL, 34996 Date: 10/25/2011 Drawing No.: 438342-1-58-01 Submitted by: Contract Inc. Contractor Inc.: Martin County, FL, 34996 Plot Scale/Pilot Date: Station: R-00 Elevation: R-00 Slope: 0.00 Grade: 0.00 File Name: 1072-2 Cross Sections.dwg Date: 10/25/2011	Sheet Identification 29
--	----------------------------


104+00

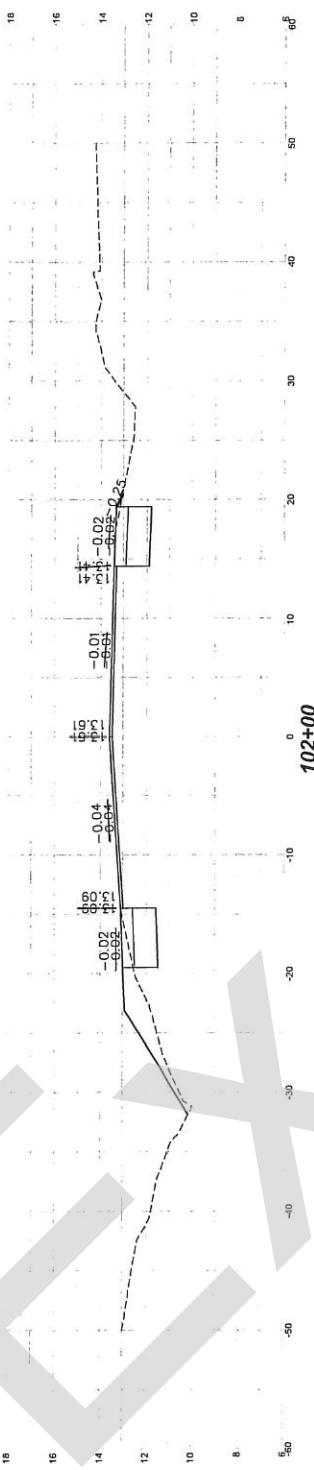


102+00

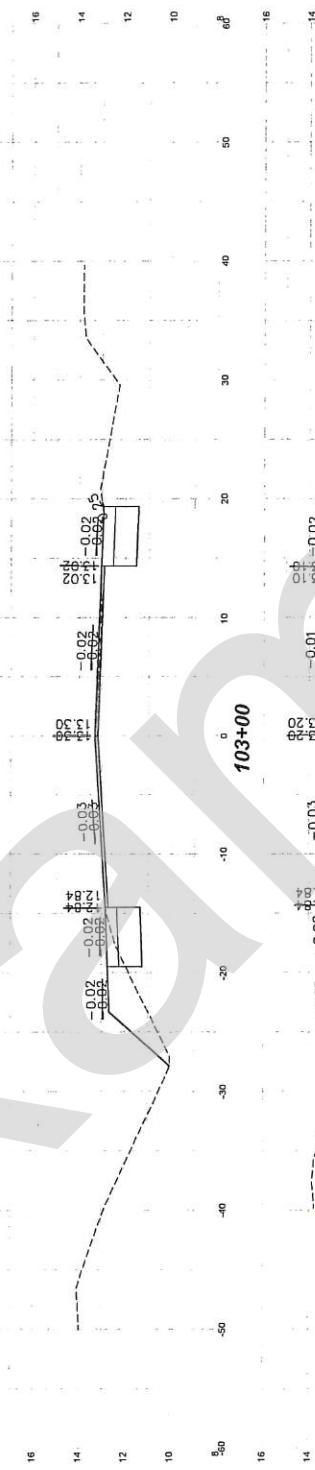

103+00

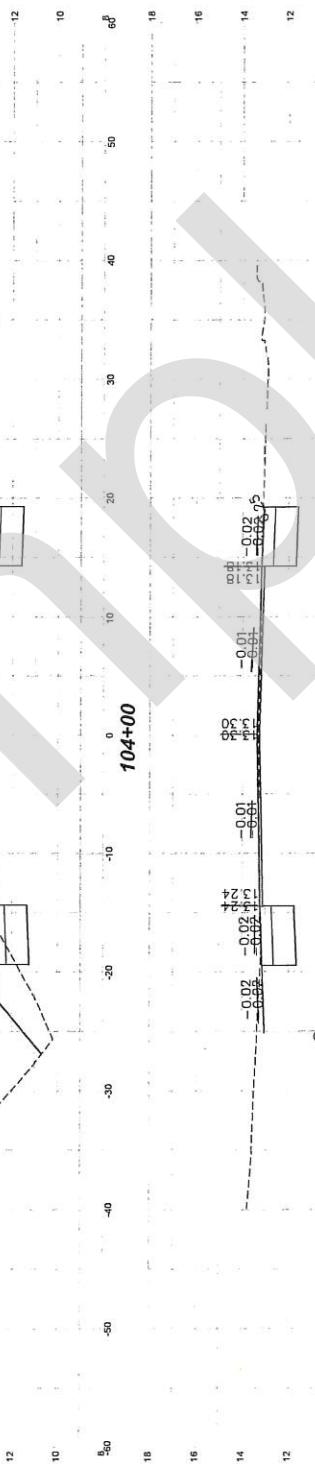

104+00

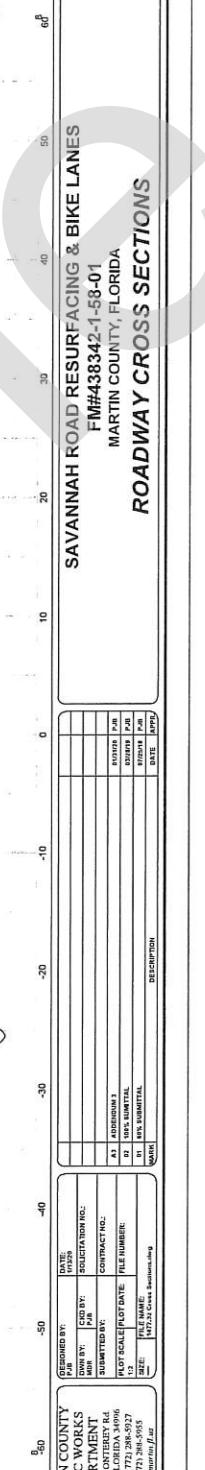

MARTIN COUNTY	
PUBLIC WORKS	
DEPARTMENT	
2611 SE MONTEREY RD	
SUITE 100	
STUART, FL 34996	
PHONE: (772) 286-8917	
FAX: (772) 286-9955	
www.martincountyfl.us	


PREPARED BY:	DATE:
NAME:	NAME:
SIGNATURE:	SIGNATURE:
CONTRACTOR:	FILE NUMBER:
NAME:	NAME:
SIGNATURE:	SIGNATURE:
PLOT SCALE/LOT DATE:	FILE NUMBER:
INCHES:	INCHES:
SIZE:	SIZE:
FILE NAME:	FILE NAME:
141723.dwg	141723.dwg

SAVANNAH ROAD RESURFACING & BIKE LANES


FM#438342-1-58-01
MARTIN COUNTY, FLORIDA
ROADWAY CROSS SECTIONS

Sheet 30 of 34
Scale 1:100
Drawing No. 141723
Date 10/10/2017
Prepared by: [Signature]
Reviewed by: [Signature]
Contractor: [Signature]
Submitted by: [Signature]

105+00

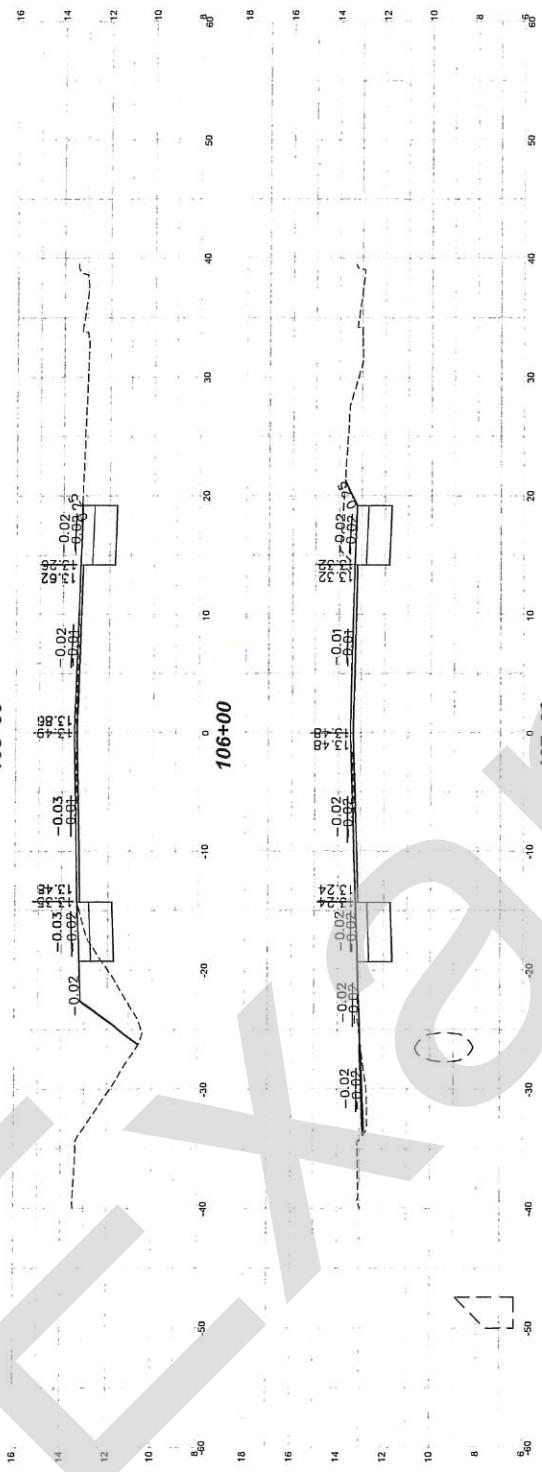


106+00

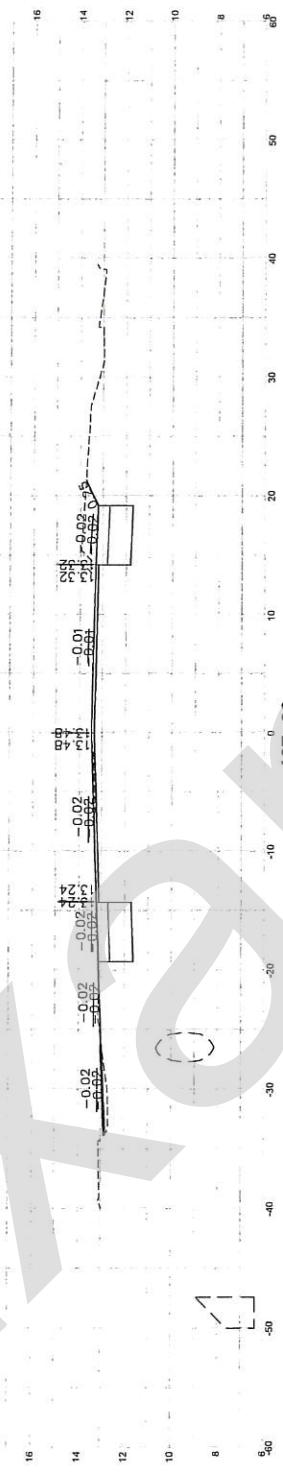

107+00



108+00

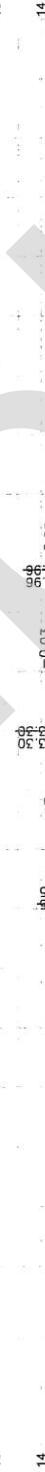

SAVANNAH ROAD RESURFACING & BIKE LANES	
FM#438342-1-58-01	
MARTIN COUNTY, FLORIDA	
ROADWAY CROSS SECTIONS	
DESIGNED BY:	DATE:
DRAWN BY:	CONTRACT NO.:
SUPERVISOR:	FILE NUMBER:
SUBMITTED BY:	FILE NAME:
PROJECT/LOT/DATE:	INTERFERENCES:
1.2	NAME:
MATERIALS:	REMARKS:
8-60	DATE:
-50	REMARKS:
-40	REMARKS:
-30	REMARKS:
-20	REMARKS:
-10	REMARKS:
0	REMARKS:
10	REMARKS:
20	REMARKS:
30	REMARKS:
40	REMARKS:
50	REMARKS:
60	REMARKS:
8	REMARKS:


MARTIN COUNTY
PUBLIC WORKS
DEPARTMENT
200 SE MONTGOMERY RD.
STUART, FLORIDA 34996
PHONE: (772) 285-5855
FAX: (772) 285-5855
E-MAIL: mw@mlco.org

PHOTO BY:
2001 SET MANUFACTURED
BY P.M. PHOTOGRAPHY
P.M. PHOTOGRAPHY
2001 SET MANUFACTURED
BY P.M. PHOTOGRAPHY
P.M. PHOTOGRAPHY

SHEET IDENTIFICATION:
31

SHEET 31 OF 34

109+00

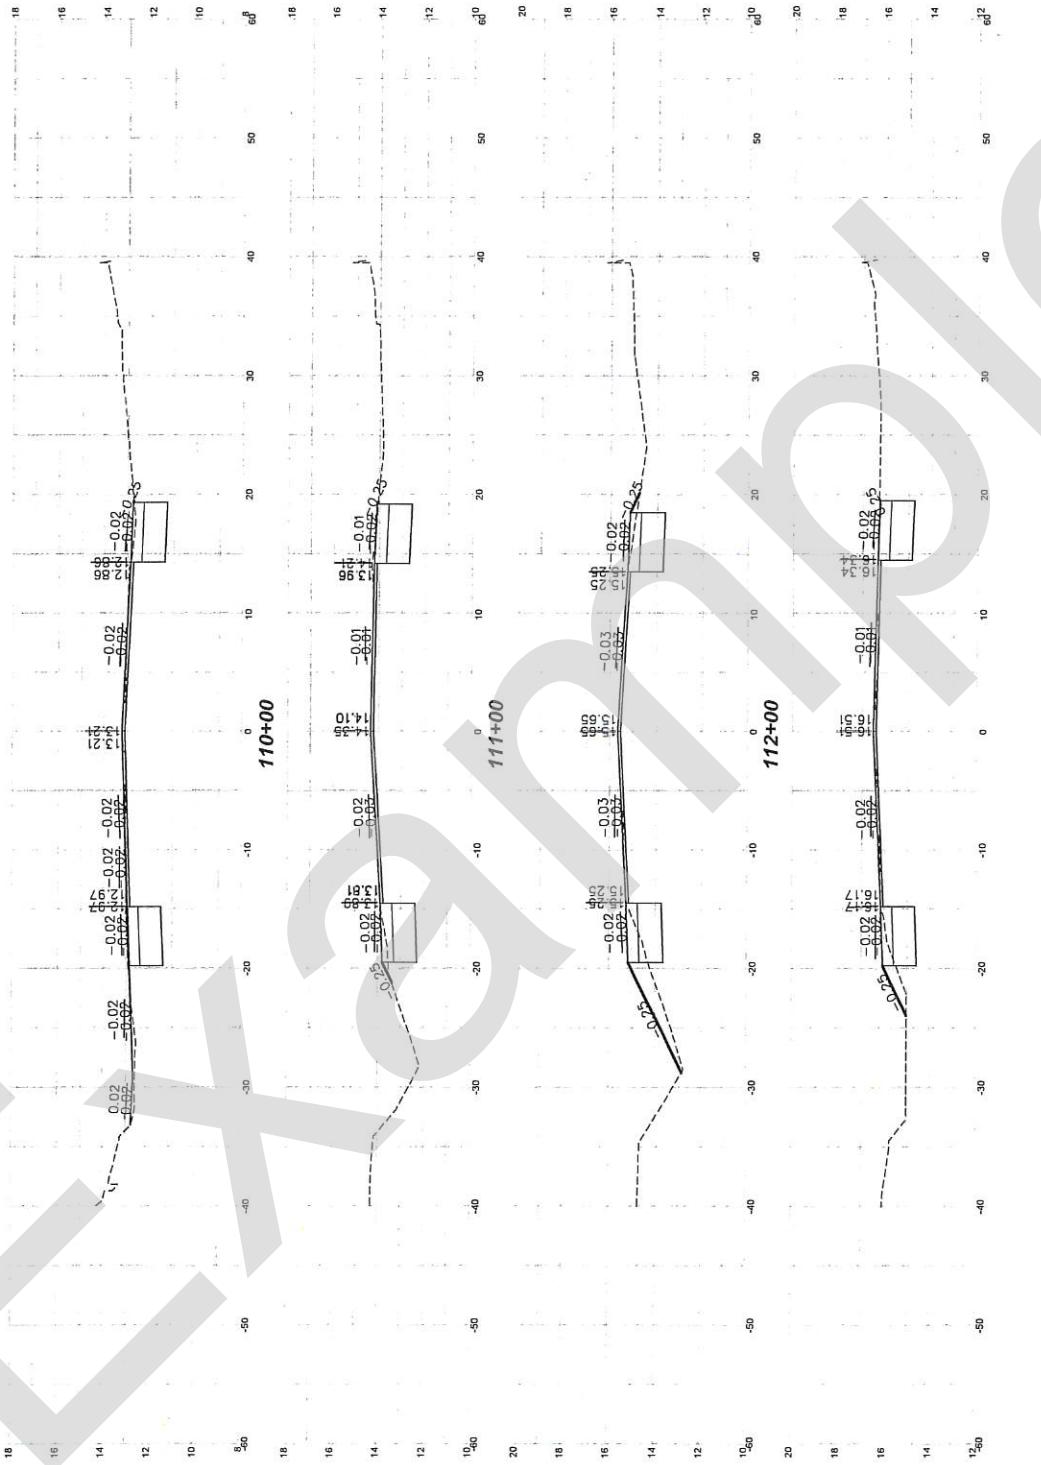


MARTIN COUNTY
PUBLIC WORKS
DEPARTMENT
2601 SE MONTEREY RD
STUART, FLORIDA 34996
PHONE: (772) 285-5527
FAX: (772) 285-5528
WEBSITE: www.martin.fl.us

DESIGNED BY: DATE: DRAWING NO.:
DRAFTER: CIV. ENG. PLS. CONTRACT NO.:
SUBMITTED BY: CONTRACT NO.:
PLOT SCALE/PLOT DATE: FILE NUMBER:
NAME: DATE: FILE NUMBER:
NAME: DATE: DESCRIPTION:
NAME: DATE:

SAVANNAH ROAD RESURFACING & BIKE LANES

FIM#A38342-1-5B-01
MARTIN COUNTY, FLORIDA
ROADWAY CROSS SECTIONS

Project No.: 38342-1-5B-01
Site No.: 342-1-5B-01
P.E. No.: 283010
Drawing No.: 32
Sheet No.: 14
Scale: 1:200
Date: 10/12/2010

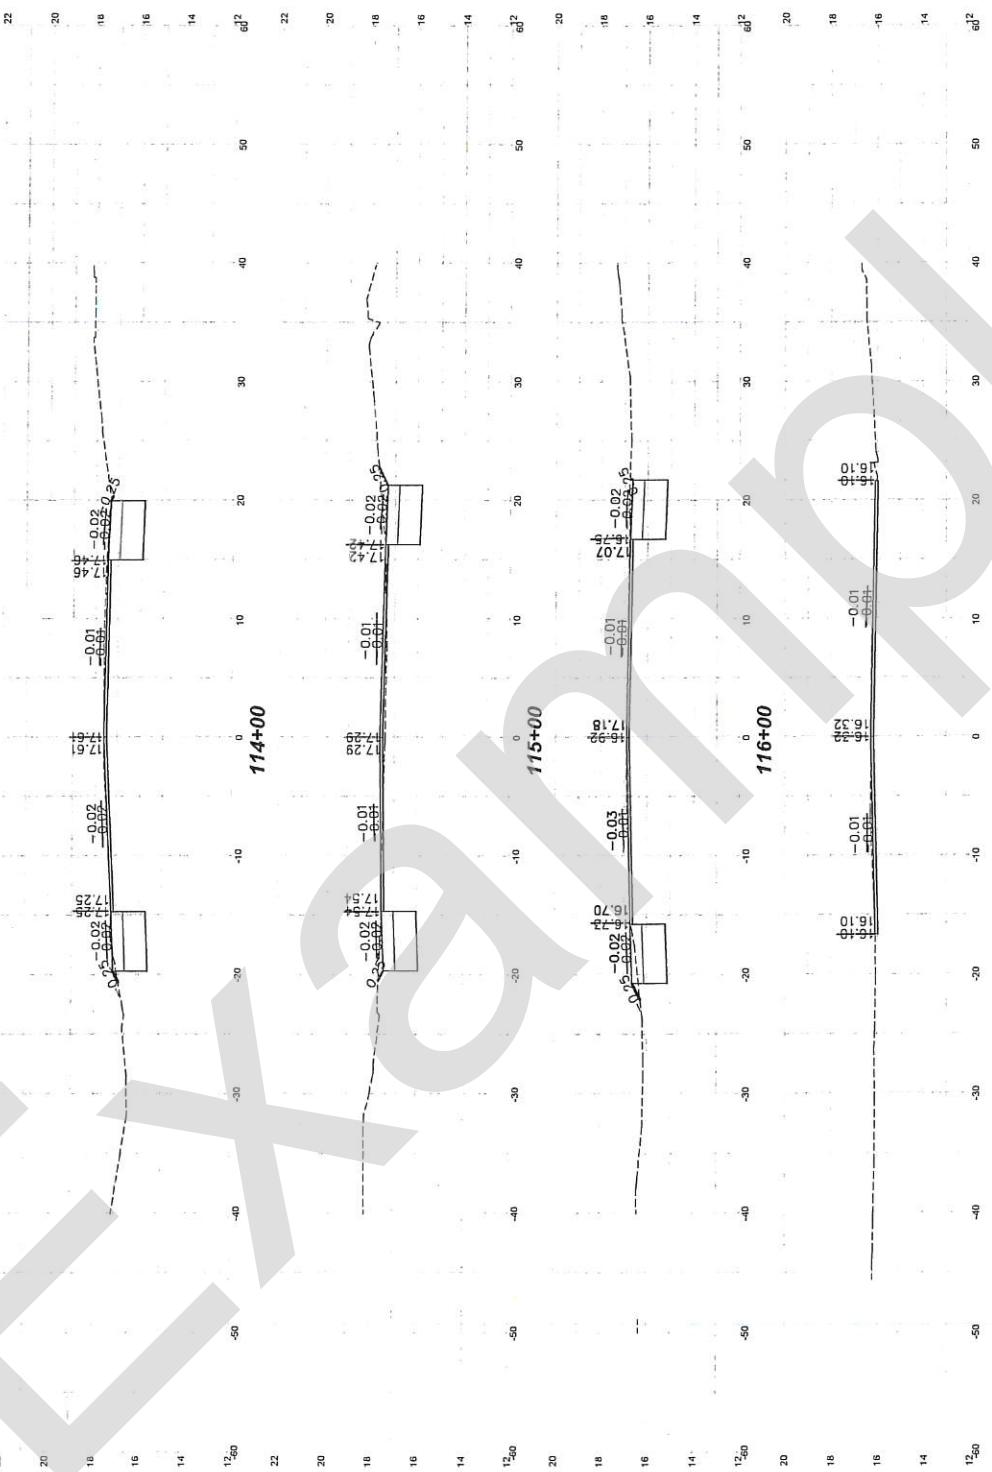

DESIGNED BY:	DATE:
	PAB
DRAWN BY:	GEND BY:
	DS
SUBMITTED BY:	CONT'D:
PLOT SCALE:	PLT DATE:
	1:12
SHE:	FILE NAME:
MARTIN COUNTY PUBLIC WORKS 2401 SE MONTBERRY RD. SUITE #100 PHONE: (772) 288-5927 FAX: (772) 288-5925 TELE: Martin County	

SAVANNAH ROAD RESURFACING & BIKE LANES

FIM#43834-1-58-01
MARTIN COUNTY, FLORIDA

ROADWAY CROSS SECTIONS

33
IDENTIFICATION

117+00



Match to Existing 118+28

MARTIN COUNTY PUBLIC WORKS DEPARTMENT STREETS & PLAZAS STREET NUMBER: 118 PHONE: (772) 288-5927 FAX: (772) 288-5935 <small>www.martincountyfl.gov</small>	DESIGNED BY: DATE: 1/26/2016 DRAWN BY: CAD: 000 SUBMITTED BY:	REVIEWED BY: DATE: 1/26/2016 DRAWN BY: CAD: 000 SUBMITTED BY:
CONTRACT NO.: FILE NUMBER: FILE NAME: <small>(1/17.5 Cross Section Drawing)</small>	CONTRACT NO.: FILE NUMBER: FILE NAME: <small>(1/17.5 Cross Section Drawing)</small>	CONTRACT NO.: FILE NUMBER: FILE NAME: <small>(1/17.5 Cross Section Drawing)</small>

SAVANNAH ROAD RESURFACING & BIKE LANES

FIM#438342-1-58-01
MARTIN COUNTY, FLORIDA
ROADWAY CROSS SECTIONS



SHEET
IDENTIFICATION
34
SHEET
NO. OR X

Project Name: SAVANNAH ROAD RESURFACING & BIKE LANES
Drawing No.: FIM#438342-1-58-01
Scale: 1:200
Date: 1/26/2016
Prepared by: CAD: 000
Reviewed by: CAD: 000
Submitted by: CAD: 000
P.E. No. 23853
P.L. No. 23853
Drawing No.: 1/17.5 Cross Section Drawing
Drawing Date: 1/26/2016
Drawing P.M.: CAD: 000
Drawing A.M.: CAD: 000
Drawing M.D.: CAD: 000