



DATE	09/27/2019	S.D. REV	09/07/2019	RWP	09/00	ENP	10/7/25	INV	10/11/2021	S.D. REV	11/30/2021 (F241)	SECTION STATUS	12	INT. or US ROUTE NO.		STATE ROAD NO.	SR 865/CR 865	COUNTY	LEE	DISTRICT	01	ROADWAY ID	12004000	SHEET NO.	1 OF 3
BY	FTE		FTE																						

FLORIDA DEPARTMENT OF TRANSPORTATION
STRAIGHT LINE DIAGRAM OF ROAD INVENTORY

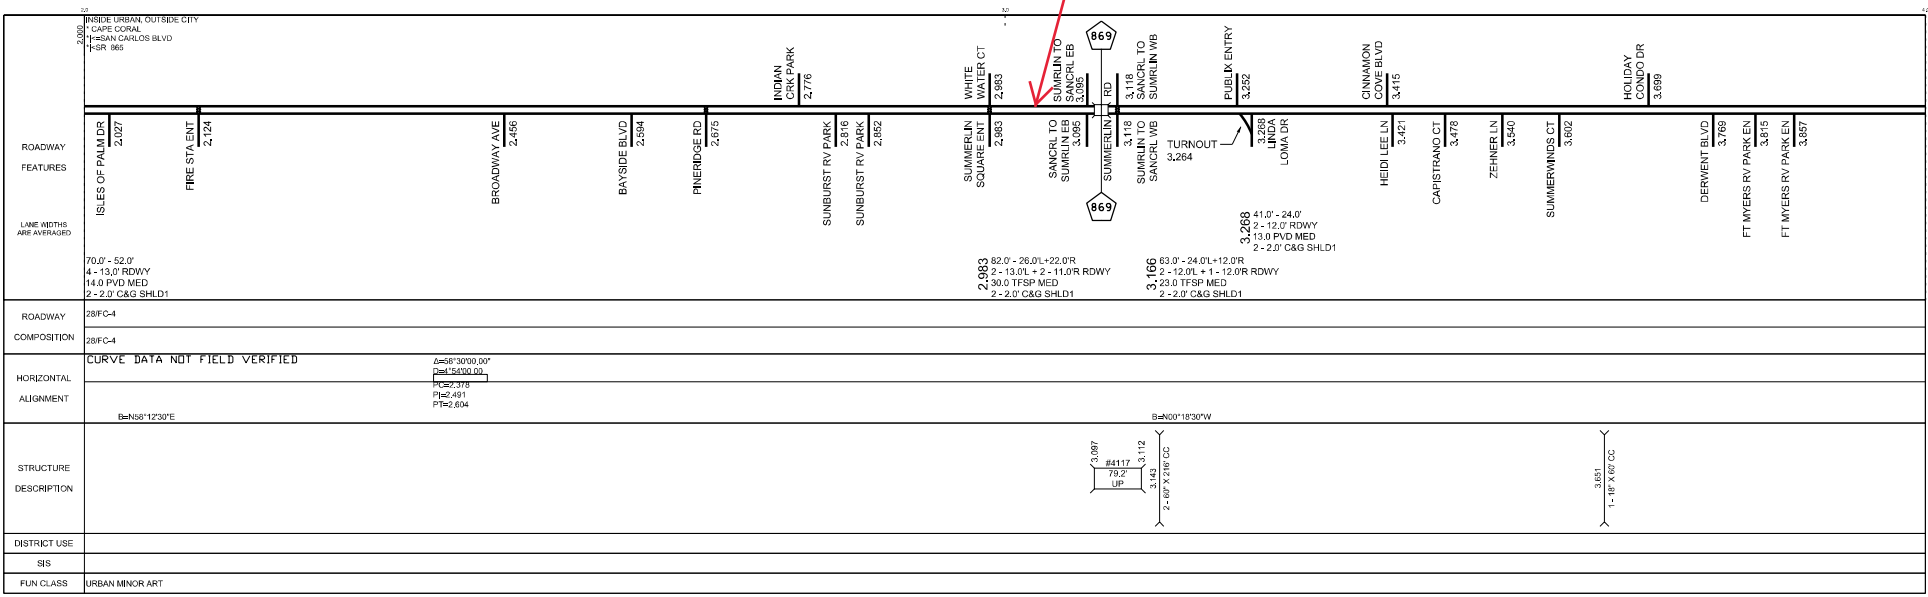

Version: 1.4.2.27_09/06/2019

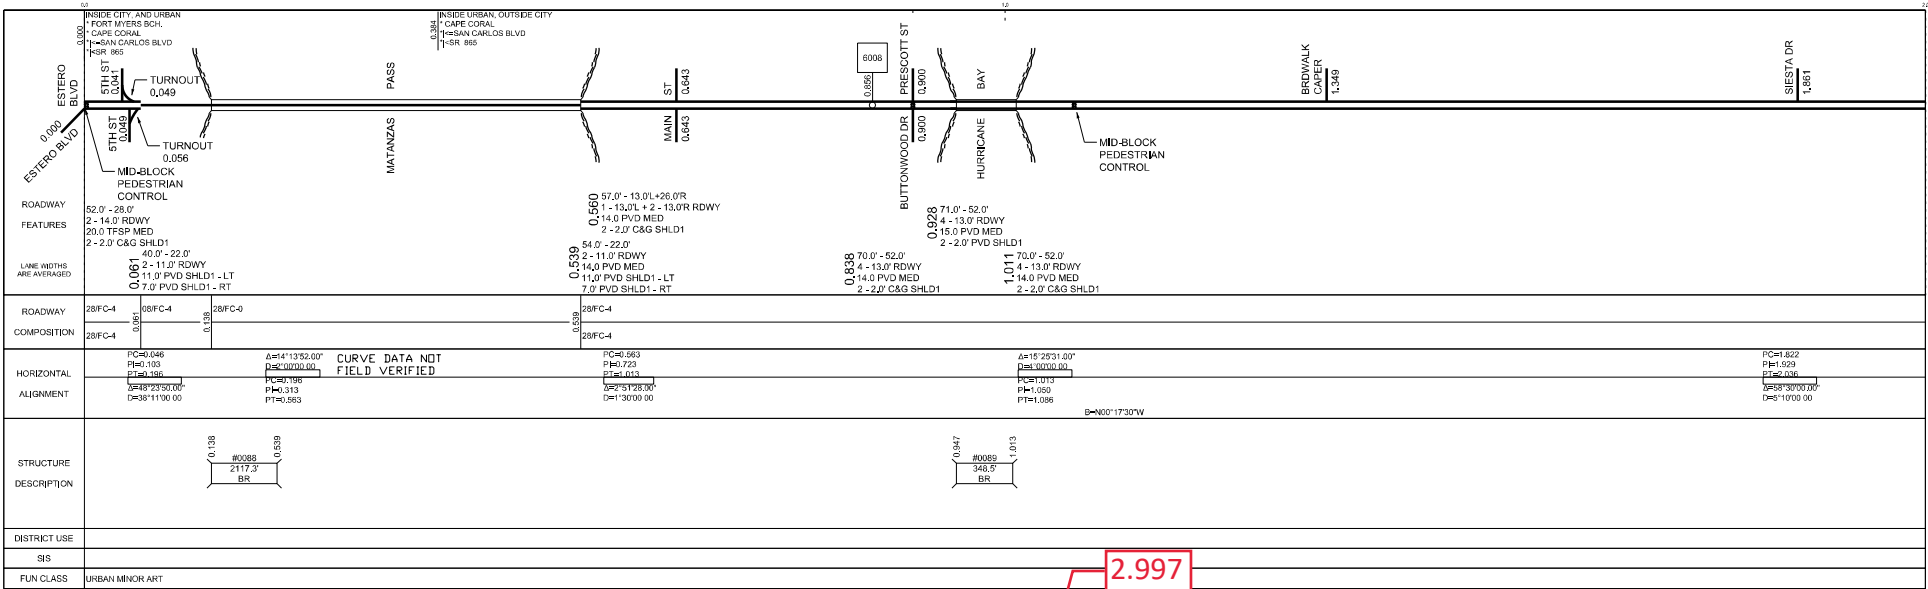