


STATE OF FLORIDA
DEPARTMENT OF TRANSPORTATION
FINAL AS-BUILT PLANS

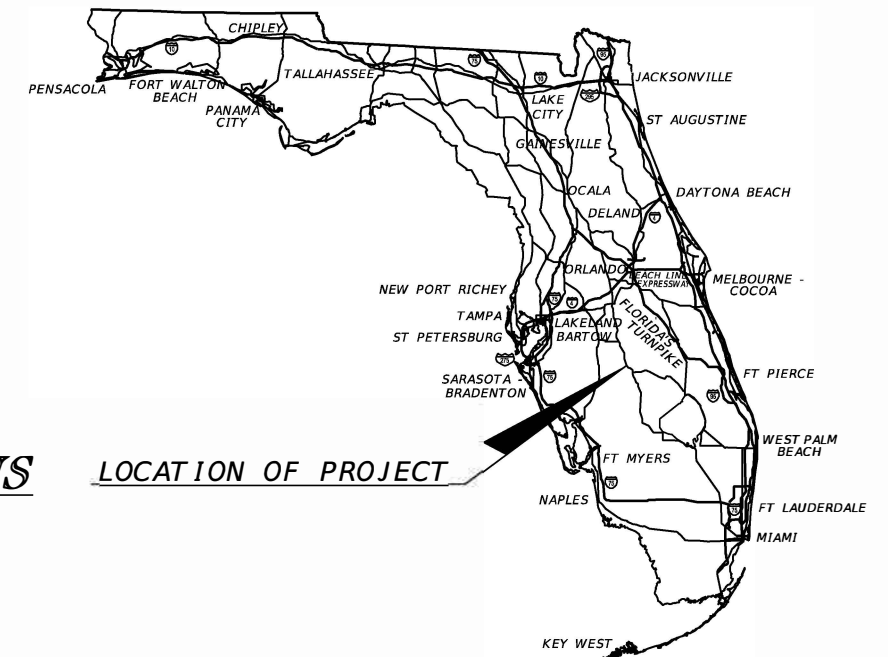

INDEX OF SIGNING AND PAVEMENT MARKING PLANS

SHEET NO.	SHEET DESCRIPTION
S-1	KEY SHEET
△ S-2 - S-2A	SIGNATURE SHEET
S-3 - S-4	TABULATION OF QUANTITIES
S-5	SIGNING AND PAVEMENT MARKING NOTES
S-6 - S-15	SIGNING AND PAVEMENT MARKING PLAN

FINANCIAL PROJECT ID 434986-1-52-01
(FEDERAL FUNDS)
HIGHLANDS COUNTY (09030000 & 09080000)
STATE ROAD NO. 25

SIGNING AND PAVEMENT MARKING PLANS

LOCATION OF PROJECT


END SIGNING AND PAVEMENT MARKINGS
B SURVEY SR 25
STA. 26+22.65, MP 14.724

BEGIN SIGNING AND PAVEMENT MARKINGS
B SURVEY SR 64
STA. 959+24.93, MP 2.719

B SURVEY SR 25
STA. 0+16.15 =
B SURVEY SR 64
STA. 978+44.31

B SURVEY SR 25
STA. 3568+98.63 =
B SURVEY SR 64
STA. 978+64.34

END SIGNING AND PAVEMENT MARKINGS
B SURVEY SR 64
STA. 977+70.02

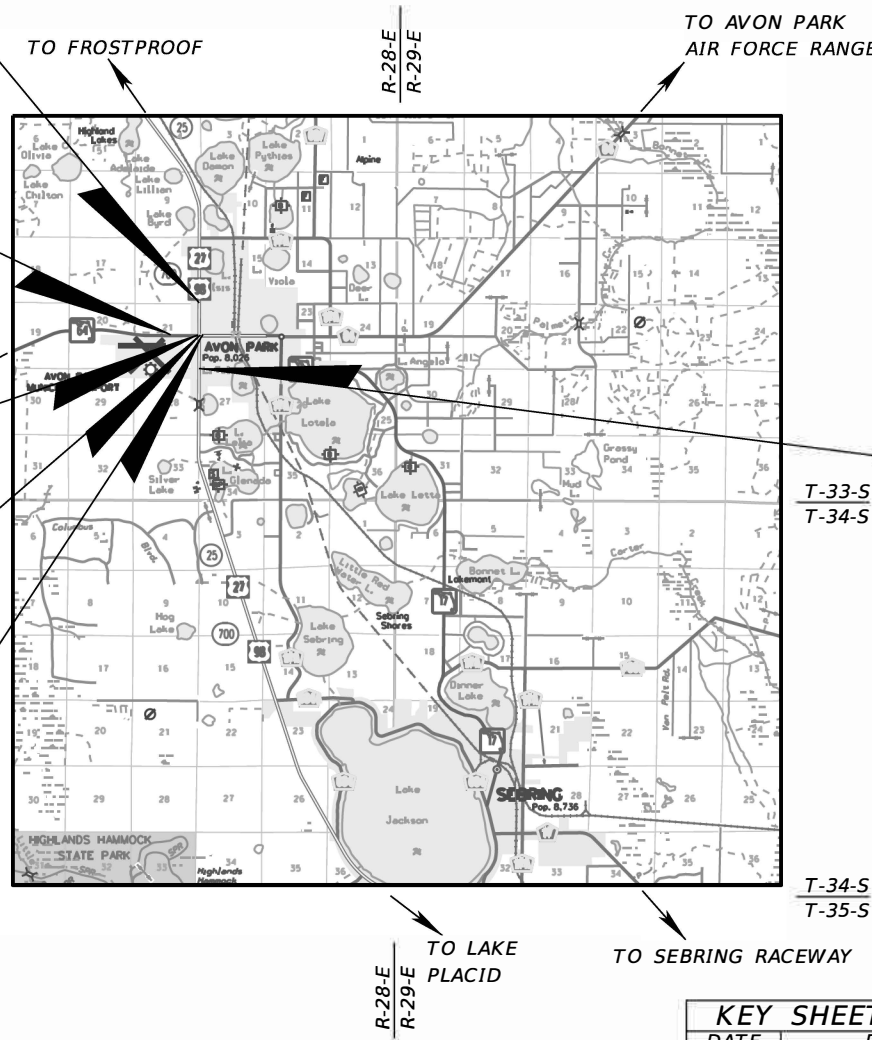

NAME OF PRIME CONTRACTOR: CONCRETE SERVICES, LLC
NAME OF PRIME CONSULTANT CONSTRUCTION ENGINEERING: WOOD E&I SOLUTIONS
DISTRICT SECRETARY: L.K. NANDAM, P.E.
RESIDENT ENGINEER: NIKESH PATEL
PROJECT MANAGER: SUSAN HINDMAN
PROJECT ADMINISTRATOR: TODD BOEHMER, P.E.
DATE WROK STARTED: JUNE 4, 2018
DATE OF FINAL ACCEPTANCE: OCTOBER 1, 2019

BEGIN SIGNING AND PAVEMENT MARKINGS
B SURVEY SR 25
STA. 3540+44.29, MP 13.689

SIGNING AND PAVEMENT MARKING PLANS
ENGINEER OF RECORD:

RYAN K. BADERSCHNEIDER, P.E.
P.E. NO.: 60851
COMPREHENSIVE ENGINEERING SERVICES, INC.
201 S. ORANGE AVENUE, SUITE 1300
ORLANDO FLORIDA, 32801
(407) 423-1600
CONTRACT NO.: C9H62
VENDOR NO.: F59347222001
CERTIFICATE OF AUTHORIZATION NO.: 7862

FDOT PROJECT MANAGER:
AMY E. BLAIR, P.E.

KEY SHEET REVISIONS	
DATE	DESCRIPTION
△ 05/18/18	ADDED SHEET S-2A


CONSTRUCTION CONTRACT NO.	FISCAL YEAR	SHEET NO.
T1701	18	S-1

THE OFFICIAL RECORD OF THIS SHEET IS THE ELECTRONIC FILE DIGITALLY SIGNED AND SEALED UNDER RULE 61G15-23.004, F.A.C.

**STATE OF FLORIDA
DEPARTMENT OF TRANSPORTATION**

CONTRACT PLANS

FINANCIAL PROJECT ID 434986-1-52-01
(FEDERAL FUNDS)
HIGHLANDS COUNTY (09030000 & 09080000)
STATE ROAD NO. 25

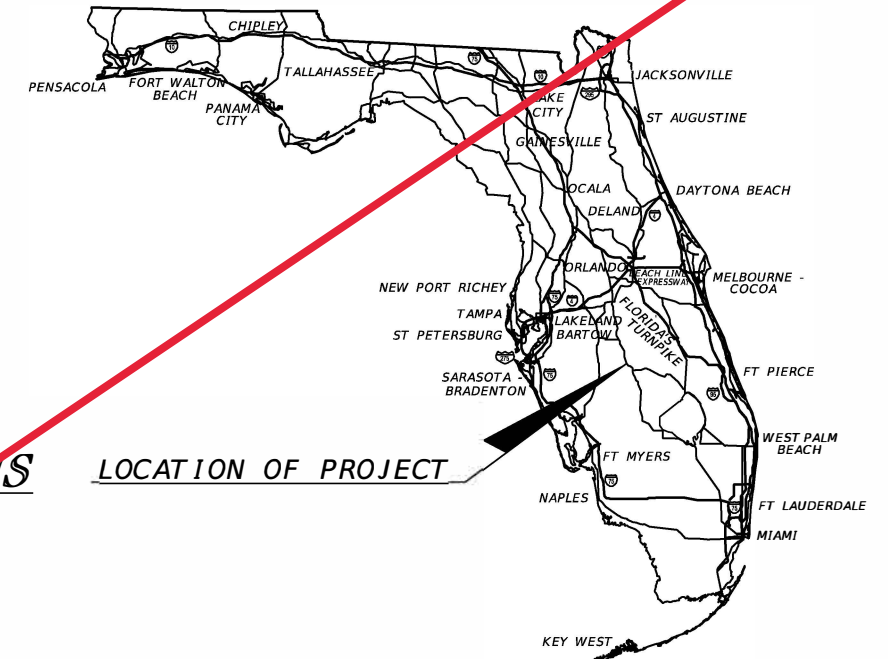

INDEX OF SIGNING AND PAVEMENT MARKING PLANS

SHEET NO.	SHEET DESCRIPTION
S-1	KEY SHEET
S-2	SIGNATURE SHEET
S-3 - S-4	TABULATION OF QUANTITIES
S-5	SIGNING AND PAVEMENT MARKING NOTES
S-6 - S-15	SIGNING AND PAVEMENT MARKING PLAN

SIGNING AND PAVEMENT MARKING PLANS

LOCATION OF PROJECT


END SIGNING AND PAVEMENT MARKINGS
B SURVEY SR 25
STA. 26+22.65, MP 14.724

BEGIN SIGNING AND PAVEMENT MARKINGS
B SURVEY SR 64
STA. 959+24.93, MP 2.719

B SURVEY SR 25
STA. 0+16.15 =
B SURVEY SR 64
STA. 978+44.31

B SURVEY SR 25
STA. 3568+98.63 =
B SURVEY SR 64
STA. 978+64.34

END SIGNING AND PAVEMENT MARKINGS
B SURVEY SR 64
STA. 977+70.02

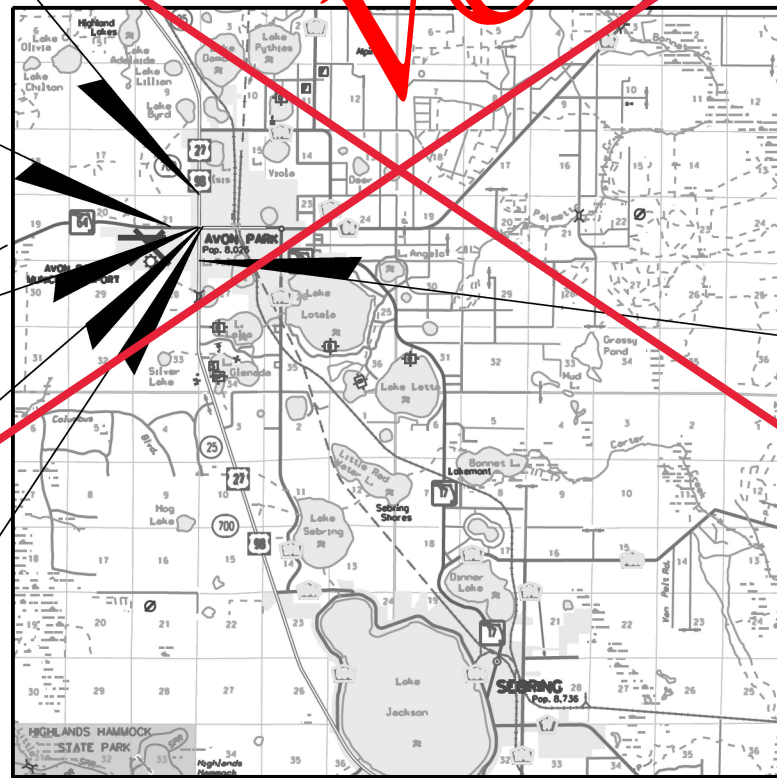

BEGIN SIGNING AND PAVEMENT MARKINGS
B SURVEY SR 25
STA. 3540+44.29, MP 13.689

**SIGNING AND PAVEMENT MARKING PLANS
ENGINEER OF RECORD:**

RYAN K. BADERSCHNEIDER, P.E.
P.E. NO.: 60851
COMPREHENSIVE ENGINEERING SERVICES, INC.
201 S. ORANGE AVENUE, SUITE 1300
ORLANDO FLORIDA, 32801
(407) 423-1600
CONTRACT NO.: C9H62
VENDOR NO.: F59347222001
CERTIFICATE OF AUTHORIZATION NO.: 7862


FDOT PROJECT MANAGER:

AMY E. BLAIR, P.E.

CONSTRUCTION CONTRACT NO.	FISCAL YEAR	SHEET NO.
T1701	18	S-1

VOID

THE OFFICIAL RECORD OF THIS SHEET IS THE ELECTRONIC FILE DIGITALLY SIGNED AND SEALED UNDER RULE 61G15-23.004, F.A.C.

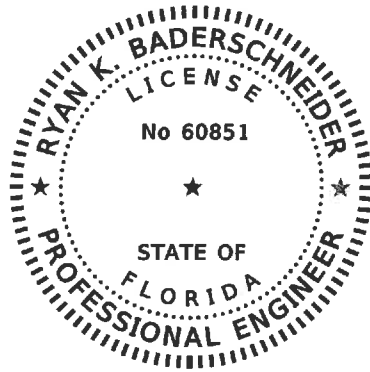

THIS DOCUMENT HAS BEEN DIGITALLY
SIGNED AND SEALED BY:

Digitally signed by Ryan K Baderschneider
Date: 2017.12.15 11:42:03 -05'00'

PRINTED COPIES OF THIS DOCUMENT ARE
NOT CONSIDERED SIGNED AND SEALED.
THE SIGNATURE MUST BE VERIFIED
ON THE ELECTRONIC DOCUMENTS.


COMPREHENSIVE ENGINEERING SERVICES, INC.
201 S. ORANGE AVENUE, SUITE 1300
ORLANDO, FLORIDA 32801
CERTIFICATE OF AUTHORIZATION NO.: 7862
RYAN K. BADERSCHNEIDER, P.E. NO. 60851

THE ABOVE NAMED PROFESSIONAL ENGINEER SHALL BE RESPONSIBLE FOR THE
FOLLOWING SHEETS IN ACCORDANCE WITH RULE 61G15-23.004, F.A.C.

SIGNING AND PAVEMENT MARKING PLANS

SHEET NO.	SHEET DESCRIPTION
S-1	KEY SHEET
S-2	SIGNATURE SHEET
S-3 - S-4	TABULATION OF QUANTITIES
S-5	SIGNING AND PAVEMENT MARKING NOTES
S-6 - S-15	SIGNING AND PAVEMENT MARKING PLAN

REVISIONS				Comprehensive Engineering Services, Inc. 201 S Orange Ave, Suite 1300 Orlando, FL 32801-3442 Certificate of Authorization No: 7862 Ryan K. Baderschneider, P.E., License No. 60851	STATE OF FLORIDA DEPARTMENT OF TRANSPORTATION			SIGNATURE SHEET	SHEET NO.
DATE	DESCRIPTION	DATE	DESCRIPTION		ROAD NO.	COUNTY	FINANCIAL PROJECT ID		
					SR 25	HIGHLANDS	434986-1-52-01		

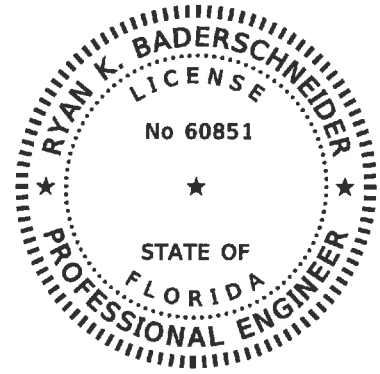

THIS DOCUMENT HAS BEEN DIGITALLY
SIGNED AND SEALED BY:

Digitally signed by Ryan K
Baderschneider
Date: 2018.05.18 15:46:01 -04'00'

PRINTED COPIES OF THIS DOCUMENT ARE
NOT CONSIDERED SIGNED AND SEALED.
THE SIGNATURE MUST BE VERIFIED
ON THE ELECTRONIC DOCUMENTS.

COMPREHENSIVE ENGINEERING SERVICES, INC.
201 S. ORANGE AVENUE, SUITE 1300
ORLANDO, FLORIDA 32801
CERTIFICATE OF AUTHORIZATION NO.: 7862
RYAN K. BADERSCHNEIDER, P.E. NO. 60851

THE ABOVE NAMED PROFESSIONAL ENGINEER SHALL BE RESPONSIBLE FOR THE
FOLLOWING SHEETS IN ACCORDANCE WITH RULE 61G15-23.004, F.A.C.

SIGNING AND PAVEMENT MARKING PLANS

SHEET NO.	SHEET DESCRIPTION
S-1	KEY SHEET
S-2A	SIGNATURE SHEET
S-3 - S-4	TABULATION OF QUANTITIES
S-14 - S-15	SIGNING AND PAVEMENT MARKING PLAN

REVISIONS				Comprehensive Engineering Services, Inc. 201 S Orange Ave, Suite 1300 Orlando, FL 32801-3442 Certificate of Authorization No: 7862 Ryan K. Baderschneider, P.E., License No. 60851	STATE OF FLORIDA DEPARTMENT OF TRANSPORTATION			SIGNATURE SHEET	SHEET NO.
DATE	DESCRIPTION	DATE	DESCRIPTION		ROAD NO.	COUNTY	FINANCIAL PROJECT ID		S-2A
05/18/18	RKB ADDED SHEET				SR 25	HIGHLANDS	434986-1-52-01		

STATE OF FLORIDA, PROFESSIONAL ENGINEER, LICENSE NO.

THIS ITEM HAS BEEN DIGITALLY SIGNED AND SEALED BY
ON THE DATE INDICATED HERE

PRINTED COPIES OF THIS DOCUMENT ARE NOT CONSIDERED SIGNED AND
SEALED AND THE SIGNATURE MUST BE VERIFIED ON ANY ELECTRONIC
COPIES.

Date	Name	Position (Title)	Review Type, If Applicable
RESIDENT OFFICE			
DISTRICT OFFICE			

REVISIONS				STATE OF FLORIDA DEPARTMENT OF TRANSPORTATION	FINAL "AS-BUILT" SIGNATURE SHEET	SHEET NO.
DATE	DESCRIPTION	DATE	DESCRIPTION			

TABULATION OF QUANTITIES

PAY ITEM NO.	DESCRIPTION	UNIT	SHEET NUMBERS												TOTAL THIS SHEET		GRAND TOTAL			
			S-6		S-7		S-8		S-9		S-10		S-11		S-12		PLAN	FINAL	PLAN	FINAL
			PLAN	FINAL	PLAN	FINAL	PLAN	FINAL	PLAN	FINAL	PLAN	FINAL	PLAN	FINAL						
700-1-11	SINGLE POST SIGN, F&I GROUND MOUNT, UP TO 12 SF	AS			6		5		6		5		3		1				26	
700-1-12	SINGLE POST SIGN, F&I GROUND MOUNT, 12-20 SF	AS			2		5		1		5		2						15	
700-1-13	SINGLE POST SIGN, F&I GROUND MOUNT, 21-30 SF	AS							2		1								3	
700-1-50	SINGLE POST SIGN, RELOCATE	AS			1				1										2	
700-1-60	SINGLE POST SIGN, REMOVE	AS			7		11		6		10		3						38	
700-2-50	MULTI- POST SIGN, F&I GROUND MOUNT, RELOCATE	AS																		
705-11-3	DELINEATOR, FLEXIBLE HIGH VISABILITY MEDIAN	EA	2		2				2		4		2		1				13	
710-11-190	PAINTED PAVEMENT MARKINGS, STANDARD, WHITE, ISLAND NOSE	SF									32								32	
710-11-290	PAINTED PAVEMENT MARKINGS, STANDARD, YELLOW, ISLAND NOSE	SF	8		8				4		4		8		7				39	
710-90	PAINTED PAVEMENT MARKINGS-FINAL SURFACE	LS																		
**	RETRO-REFLECTIVE PAVEMENT MARKERS	EA	176		69		74		86		96		75		155				731	
	STANDARD, WHITE, SOLID, 6"	GM	0.541		0.197		0.166		0.443		0.225		0.231		0.564				2.367	
	STANDARD, WHITE, SOLID, 8"	GM																		
	STANDARD, WHITE, SOLID, CROSSWALK, 12"	LF			185		360		692		334		170						1741	
	STANDARD, WHITE, SOLID, 18"	LF																		
	STANDARD, WHITE, SOLID, 24"	LF			44		61		795		63		37						1000	
	STANDARD, WHITE, SKIP, 10-30, 6"	GM	1.103		0.259		0.432		0.254		0.425		0.422		0.902				3.950	
	STANDARD, WHITE, 2-4 DOTTED GUIDELINE/6-10 DOTTED EXTENSION, 6"	GM																		
	STANDARD, WHITE, MESSAGE OR SYMBOL	EA							1										1	
	STANDARD, WHITE, ARROWS	EA	8		3		1		8		4		5		11				40	
	STANDARD, YELLOW, SOLID, 6"	GM	0.467		0.248		0.364		0.212		0.329		0.248		0.423				2.291	
	STANDARD, YELLOW, SOLID, 18"	LF																		
	STANDARD, YELLOW, SKIP, 10-30, 6"	GM																		
	STANDARD, YELLOW, 2-4 DOTTED GUIDELINE/6-10 DOTTED EXTENSION, 6"	GM	0.085		0.040						0.021		0.036		0.015				0.197	
	STANDARD, BLACK, SKIP/DOTTED, 6"	GM			0.162		0.211		0.241		0.212		0.159						0.985	
711-11-123	THERMOPLASTIC, STANDARD, WHITE, SOLID, 12" FOR CROSSWALK AND ROUNDABOUT	LF			185		186				249								620	
711-11-124	THERMOPLASTIC, STANDARD, WHITE, SOLID, 18" FOR DIAGONALS AND CHEVRONS	LF																		
711-11-125	THERMOPLASTIC, STANDARD, WHITE, SOLID, 24" FOR STOP LINE AND CROSSWALK	LF			44		61		45		49		37						236	
711-11-170	THERMOPLASTIC, STANDARD, WHITE, ARROWS	EA	8		3		1						4		11				27	
711-11-224	THERMOPLASTIC, STANDARD, YELLOW, SOLID 18" FOR DIAGONAL OR CHEVRON	LF																		
711-11-241	THERMOPLASTIC, STANDARD, YELLOW, 2-4 DOTTED GUIDE LINE/6-10 DOTTED EXTENSION LINE, 6"	GM	0.085		0.040						0.021		0.036		0.015				0.197	
711-14-123	THERMOPLASTIC, PREFORMED, WHITE, SOLID, 12" FOR CROSSWALK	LF					174		692		85		170						1121	
711-14-125	THERMOPLASTIC, PREFORMED, WHITE, SOLID, 24" FOR CROSSWALK	LF							750		14								764	
711-14-141	THERMOPLASTIC, PREFORMED, WHITE, 2-4 DOTTED GUIDELINE ON CONCRETE SURFACES	GM																		
711-14-160	THERMOPLASTIC, PREFORMED, WHITE, MESSAGE OR SYMBOL	EA							1										1	
711-14-170	THERMOPLASTIC, PREFORMED, WHITE, ARROWS	EA							8		4		1						13	
711-16-101	THERMOPLASTIC, STANDARD-OTHER SURFACES, WHITE, SOLID, 6"	GM	0.541		0.197		0.166		0.443		0.225		0.231		0.564				2.367	
711-16-102	THERMOPLASTIC, STANDARD-OTHER SURFACES, WHITE, SOLID, 8"	GM																		
711-16-131	THERMOPLASTIC, OTHER SURFACES, WHITE, SKIP, 6", 10-30 SKIP OR LANE DROP	GM	1.103		0.259		0.212		0.012		0.213		0.263		0.902				2.964	
711-16-201	THERMOPLASTIC, STANDARD-OTHER SURFACES, YELLOW, SOLID, 6"	GM	0.467		0.248		0.364		0.212		0.329		0.248		0.423				2.291	
711-16-231	THERMOPLASTIC, STANDARD-OTHER SURFACES, YELLOW, SKIP, 6"	GM																		
713-103-131	PERMANENT TAPE, WHITE, SKIP/DOTTED, 6" FOR CONCRETE SURFACES	GM			0.162		0.211		0.241		0.212		0.159						0.985	
713-103-331	PERMANENT TAPE, BLACK, SKIP/DOTTED, 6" FOR CONCRETE SURFACES	GM			0.162		0.211		0.241		0.212		0.159						0.985	

** THESE QUANTITIES ARE PAID FOR UNDER PAINTED PAVEMENT MARKINGS (FINAL SURFACE), LUMP SUM - ITEM NO. 710-90. THESE QUANTITIES ARE FOR ONE APPLICATION; SEE SPECIFICATION 710 FOR THE NUMBER OF APPLICATIONS REQUIRED.

<table border="1"> <thead> <tr> <th colspan="4">REVISIONS</th> </tr> <tr> <th>DATE</th> <th>DESCRIPTION</th> <th>DATE</th> <th>DESCRIPTION</th> </tr> </thead> <tbody> <tr> <td> </td> <td> </td> <td> </td> <td> </td> </tr> </tbody> </table>				REVISIONS				DATE	DESCRIPTION	DATE	DESCRIPTION					Comprehensive Engineering Services, Inc. 201 S Orange Ave, Suite 1300 Orlando, FL 32801-3442 Certificate of Authorization No. 7862 Ryan K. Baderschneider, P.E., License No. 60851			STATE OF FLORIDA DEPARTMENT OF TRANSPORTATION <table border="1"> <thead> <tr> <th>ROAD NO.</th> <th>COUNTY</th> <th>FINANCIAL PROJECT ID</th> </tr> </thead> <tbody> <tr> <td>SR 25</td> <td>HIGHLANDS</td> <td>434986-1-52-01</td> </tr> </tbody> </table>			ROAD NO.	COUNTY	FINANCIAL PROJECT ID	SR 25	HIGHLANDS	434986-1-52-01	SHEET NO. S-3	
REVISIONS																													
DATE	DESCRIPTION	DATE	DESCRIPTION																										
ROAD NO.	COUNTY	FINANCIAL PROJECT ID																											
SR 25	HIGHLANDS	434986-1-52-01																											

THE OFFICIAL RECORD OF THIS SHEET IS THE ELECTRONIC FILE DIGITALLY SIGNED AND SEALED UNDER RULE 61G15-23.004, F.A.C.

TABULATION OF QUANTITIES

PAY ITEM NO.	DESCRIPTION	UNIT	SHEET NUMBERS														TOTAL THIS SHEET		GRAND TOTAL	
			S-6		S-7		S-8		S-9		S-10		S-11		S-12		PLAN	FINAL	PLAN	FINAL
			PLAN	FINAL	PLAN	FINAL	PLAN	FINAL	PLAN	FINAL	PLAN	FINAL	PLAN	FINAL	PLAN	FINAL				
700-1-11	SINGLE POST SIGN, F&I GROUND MOUNT, UP TO 12 SF	AS			6	7	5	✓	6	✓	5	✓	3	✓	1	✓	26	28		
700-1-12	SINGLE POST SIGN, F&I GROUND MOUNT, 12-20 SF	AS			2	✓	5	✓	1	✓	5	✓	2	✓			15	✓		
700-1-13	SINGLE POST SIGN, F&I GROUND MOUNT, 21-30 SF	AS							2	✓	1	✓					3	✓		
700-1-50	SINGLE POST SIGN, RELOCATE	AS			1	0			1	✓							2	✓		
700-1-60	SINGLE POST SIGN, REMOVE	AS			7	✓	11	✓	6	✓	10	9	3	4	1	✓	38	✓		
700-2-50	MULTI- POST SIGN, F&I GROUND MOUNT, RELOCATE	AS																		
705-11-3	DELINEATOR, FLEXIBLE HIGH VISABILITY MEDIAN	EA	2	✓	2	✓			2	✓	4	✓	2	✓	1	✓	13	✓		
710-11-190	PAINTED PAVEMENT MARKINGS, STANDARD, WHITE, ISLAND NOSE	SF									32						32			
710-11-290	PAINTED PAVEMENT MARKINGS, STANDARD, YELLOW, ISLAND NOSE	SF	8		8				4		4		8		7		39			
710-90	PAINTED PAVEMENT MARKINGS-FINAL SURFACE	LS																		
**	RETRO-REFLECTIVE PAVEMENT MARKERS	EA	176		69		74		86		96		75		155		731			
	STANDARD, WHITE, SOLID, 6"	GM	0.541		0.197		0.166		0.443		0.225		0.231		0.564		2.367			
	STANDARD, WHITE, SOLID, 8"	GM									0.022	△			0.009	△	0.031	△		
	STANDARD, WHITE, SOLID, CROSSWALK, 12"	LF			185		360		692		334		170				1741			
	STANDARD, WHITE, SOLID, 18"	LF																		
	STANDARD, WHITE, SOLID, 24"	LF			44		61		795		63		37				1000			
	STANDARD, WHITE, SKIP, 10-30, 6"	GM	1.103		0.421		0.423		0.254		0.425		0.422		0.902		3.950			
	STANDARD, WHITE, 2-4 DOTTED GUIDELINE/6-10 DOTTED EXTENSION, 6"	GM																		
	STANDARD, WHITE, MESSAGE OR SYMBOL	EA							1								1			
	STANDARD, WHITE, ARROWS	EA	8		3		1		8		4		5		11		40			
	STANDARD, YELLOW, SOLID, 6"	GM	0.467		0.248		0.364		0.212		0.329		0.248		0.423		2.291			
	STANDARD, YELLOW, SOLID, 18"	LF																		
	STANDARD, YELLOW, SKIP, 10-30, 6"	GM																		
	STANDARD, YELLOW, 2-4 DOTTED GUIDELINE/6-10 DOTTED EXTENSION, 6"	GM	0.085		0.040						0.021		0.036		0.015		0.197			
	STANDARD, BLACK, SKIP/DOTTED, 6"	GM			0.162		0.211		0.241		0.212		0.159				0.985			
711-11-123	THERMOPLASTIC, STANDARD, WHITE, SOLID, 12" FOR CROSSWALK AND ROUNDABOUT	LF			185		186				249						620			
711-11-124	THERMOPLASTIC, STANDARD, WHITE, SOLID, 18" FOR DIAGONALS AND CHEVRONS	LF																		
711-11-125	THERMOPLASTIC, STANDARD, WHITE, SOLID, 24" FOR STOP LINE AND CROSSWALK	LF			44		61		45		49		37				236			
711-11-170	THERMOPLASTIC, STANDARD, WHITE, ARROWS	EA	8		3		1						4		11		27			
711-11-224	THERMOPLASTIC, STANDARD, YELLOW, SOLID 18" FOR DIAGONAL OR CHEVRON	LF																		
711-11-241	THERMOPLASTIC, STANDARD, YELLOW, 2-4 DOTTED GUIDE LINE/6-10 DOTTED EXTENSION LINE, 6"	GM	0.085		0.040						0.021		0.036		0.015		0.197			
711-14-123	THERMOPLASTIC, PREFORMED, WHITE, SOLID, 12" FOR CROSSWALK	LF					174		692		85		170				1121			
711-14-125	THERMOPLASTIC, PREFORMED, WHITE, SOLID, 24" FOR CROSSWALK	LF							750		14						764			
711-14-141	THERMOPLASTIC, PREFORMED, WHITE, 2-4 DOTTED GUIDELINE ON CONCRETE SURFACES	GM																		
711-14-160	THERMOPLASTIC, PREFORMED, WHITE, MESSAGE OR SYMBOL	EA							1								1			
711-14-170	THERMOPLASTIC, PREFORMED, WHITE, ARROWS	EA							8		4		1				13			
711-16-101	THERMOPLASTIC, STANDARD-OTHER SURFACES, WHITE, SOLID, 6"	GM	0.541		0.197		0.166		0.443		0.225		0.231		0.564		2.367			
711-16-102	THERMOPLASTIC, STANDARD-OTHER SURFACES, WHITE, SOLID, 8"	GM									0.022	△			0.009	△	0.031	△		
711-16-131	THERMOPLASTIC, OTHER SURFACES, WHITE, SKIP, 6", 10-30 SKIP OR LANE DROP	GM	1.103		0.259		0.212		0.012		0.213		0.263		0.902		2.964			
711-16-201	THERMOPLASTIC, STANDARD-OTHER SURFACES, YELLOW, SOLID, 6"	GM	0.467		0.248		0.364		0.212		0.329		0.248		0.423		2.291			
711-16-231	THERMOPLASTIC, STANDARD-OTHER SURFACES, YELLOW, SKIP, 6"	GM																		
713-103-131	PERMANENT TAPE, WHITE, SKIP/DOTTED, 6" FOR CONCRETE SURFACES	GM			0.162		0.211		0.241		0.212		0.159				0.985			
713-103-331	PERMANENT TAPE, BLACK, SKIP/DOTTED, 6" FOR CONCRETE SURFACES	GM			0.162		0.211		0.241		0.212		0.159				0.985			

** THESE QUANTITIES ARE PAID FOR UNDER PAINTED PAVEMENT MARKINGS (FINAL SURFACE), LUMP SUM - ITEM NO. 710-90. THESE QUANTITIES ARE FOR ONE APPLICATION; SEE SPECIFICATION 710 FOR THE NUMBER OF APPLICATIONS REQUIRED.

REVISIONS				Comprehensive Engineering Services, Inc. 201 S Orange Ave, Suite 1300 Orlando, FL 32801-3442 Certificate of Authorization No. 7862 Ryan K. Baderschneider, P.E., License No. 60851	STATE OF FLORIDA DEPARTMENT OF TRANSPORTATION			TABULATION OF QUANTITIES	SHEET NO. S-3
DATE	DESCRIPTION	DATE	DESCRIPTION		ROAD NO.	COUNTY	FINANCIAL PROJECT ID		
05/18/18	RKB △ UPDATED QUANTITY				SR 25	HIGHLANDS	434986-1-52-01		

THE OFFICIAL RECORD OF THIS SHEET IS THE ELECTRONIC FILE DIGITALLY SIGNED AND SEALED UNDER RULE 61G15-23-.004, F.A.C.

TABULATION OF QUANTITIES

PAY ITEM NO.	DESCRIPTION	UNIT	SHEET NUMBERS												TOTAL THIS SHEET		GRAND TOTAL	
			S-13		S-14		S-15											
			PLAN	FINAL	PLAN	FINAL	PLAN	FINAL	PLAN	FINAL	PLAN	FINAL	PLAN	FINAL	PLAN	FINAL	PLAN	FINAL
700-1-11	SINGLE POST SIGN, F&I GROUND MOUNT, UP TO 12 SF	AS			5		4									9		35
700-1-12	SINGLE POST SIGN, F&I GROUND MOUNT, 12-20 SF	AS			1											1		16
700-1-13	SINGLE POST SIGN, F&I GROUND MOUNT, 21-30 SF	AS					2									2		5
700-1-50	SINGLE POST SIGN, RELOCATE	AS	2		6		2									10		12
700-1-60	SINGLE POST SIGN, REMOVE	AS			4		6									10		48
700-2-50	MULTI- POST SIGN, F&I GROUND MOUNT, RELOCATE	AS			1											1		1
705-11-3	DELINEATOR, FLEXIBLE HIGH VISABILITY MEDIAN	EA																13
710-11-190	PAINTED PAVEMENT MARKINGS, STANDARD, WHITE, ISLAND NOSE	SF																32
710-11-290	PAINTED PAVEMENT MARKINGS, STANDARD, YELLOW, ISLAND NOSE	SF																39
710-90	PAINTED PAVEMENT MARKINGS-FINAL SURFACE	LS																1
**	RETRO-REFLECTIVE PAVEMENT MARKERS	EA	25		66		57									148		
	STANDARD, WHITE, SOLID, 6"	GM	0.271		0.217		0.298									0.786		
	STANDARD, WHITE, SOLID, 8"	GM			0.024											0.024		
	STANDARD, WHITE, SOLID, CROSSWALK, 12"	LF																
	STANDARD, WHITE, SOLID, 18"	LF				58										58		
	STANDARD, WHITE, SOLID, 24"	LF	26		26											52		
	STANDARD, WHITE, SKIP, 10-30, 6"	GM																
	STANDARD, WHITE, 2-4 DOTTED GUIDELINE/6-10 DOTTED EXTENSION, 6"	GM					0.031									0.031		
	STANDARD, WHITE, MESSAGE OR SYMBOL	EA			1		1									2		
	STANDARD, WHITE, ARROWS	EA			5		10									15		
	STANDARD, YELLOW, SOLID, 6"	GM	0.191		0.338		0.186									0.715		
	STANDARD, YELLOW, SOLID, 18"	LF	26		87											113		
	STANDARD, YELLOW, SKIP, 10-30, 6"	GM	0.156				0.115									0.271		
	STANDARD, YELLOW, 2-4 DOTTED GUIDELINE/6-10 DOTTED EXTENSION, 6"	GM			0.026											0.026		
	STANDARD, BLACK, SKIP/DOTTED, 6"	GM																
711-11-123	THERMOPLASTIC, STANDARD, WHITE, SOLID, 12" FOR CROSSWALK AND ROUNDABOUT	LF																620
711-11-124	THERMOPLASTIC, STANDARD, WHITE, SOLID, 18" FOR DIAGONALS AND CHEVRONS	LF				58										58		58
711-11-125	THERMOPLASTIC, STANDARD, WHITE, SOLID, 24" FOR STOP LINE AND CROSSWALK	LF	26		26											52		288
711-11-170	THERMOPLASTIC, STANDARD, WHITE, ARROWS	EA																27
711-11-224	THERMOPLASTIC, STANDARD, YELLOW, SOLID 18" FOR DIAGONAL OR CHEVRON	LF	26		87											113		113
711-11-241	THERMOPLASTIC, STANDARD, YELLOW, 2-4 DOTTED GUIDE LINE/6-10 DOTTED EXTENSION LINE, 6"	GM			0.026											0.026		0.223
711-14-123	THERMOPLASTIC, PREFORMED, WHITE, SOLID, 12" FOR CROSSWALK	LF																1121
711-14-125	THERMOPLASTIC, PREFORMED, WHITE, SOLID, 24" FOR CROSSWALK	LF																764
711-14-141	THERMOPLASTIC, PREFORMED, WHITE, 2-4 DOTTED GUIDELINE ON CONCRETE SURFACES	GM					0.031									0.031		0.031
711-14-160	THERMOPLASTIC, PREFORMED, WHITE, MESSAGE OR SYMBOL	EA			1		1									2		3
711-14-170	THERMOPLASTIC, PREFORMED, WHITE, ARROWS	EA			5		10									15		28
711-16-101	THERMOPLASTIC, STANDARD-OTHER SURFACES, WHITE, SOLID, 6"	GM	0.271		0.217		0.298									0.786		3.153
711-16-102	THERMOPLASTIC, STANDARD-OTHER SURFACES, WHITE, SOLID, 8"	GM			0.024											0.024		0.024
711-16-131	THERMOPLASTIC, OTHER SURFACES, WHITE, SKIP, 6", 10-30 SKIP OR LANE DROP	GM																2.964
711-16-201	THERMOPLASTIC, STANDARD-OTHER SURFACES, YELLOW, SOLID, 6"	GM	0.191		0.338		0.186									0.715		3.006
711-16-231	THERMOPLASTIC, STANDARD-OTHER SURFACES, YELLOW, SKIP, 6"	GM	0.156				0.115									0.271		0.271
713-103-131	PERMANENT TAPE, WHITE, SKIP/DOTTED, 6" FOR CONCRETE SURFACES	GM																0.985
713-103-331	PERMANENT TAPE, BLACK, SKIP/DOTTED, 6" FOR CONCRETE SURFACES	GM																0.985

VOID

** THESE QUANTITIES ARE PAID FOR UNDER PAINTED PAVEMENT MARKINGS (FINAL SURFACE), LUMP SUM - ITEM NO. 710-90. THESE QUANTITIES ARE FOR ONE APPLICATION; SEE SPECIFICATION 710 FOR THE NUMBER OF APPLICATIONS REQUIRED.

<table border="1" style="width: 100%;"> <thead> <tr> <th colspan="4">REVISIONS</th> </tr> <tr> <th>DATE</th> <th>DESCRIPTION</th> <th>DATE</th> <th>DESCRIPTION</th> </tr> </thead> <tbody> <tr> <td> </td> <td> </td> <td> </td> <td> </td> </tr> </tbody> </table>				REVISIONS				DATE	DESCRIPTION	DATE	DESCRIPTION					Comprehensive Engineering Services, Inc. 201 S Orange Ave, Suite 1300 Orlando, FL 32801-3442 Certificate of Authorization No. 7862 Ryan K. Baderschneider, P.E., License No. 60851			STATE OF FLORIDA DEPARTMENT OF TRANSPORTATION <table border="1" style="width: 100%;"> <tr> <th>ROAD NO.</th> <th>COUNTY</th> <th>FINANCIAL PROJECT ID</th> </tr> <tr> <td>SR 25</td> <td>HIGHLANDS</td> <td>434986-1-52-01</td> </tr> </table>			ROAD NO.	COUNTY	FINANCIAL PROJECT ID	SR 25	HIGHLANDS	434986-1-52-01	TABULATION OF QUANTITIES				SHEET NO. S-4
REVISIONS																																
DATE	DESCRIPTION	DATE	DESCRIPTION																													
ROAD NO.	COUNTY	FINANCIAL PROJECT ID																														
SR 25	HIGHLANDS	434986-1-52-01																														

THE OFFICIAL RECORD OF THIS SHEET IS THE ELECTRONIC FILE DIGITALLY SIGNED AND SEALED UNDER RULE 61G15-23.004, F.A.C.

TABULATION OF QUANTITIES

PAY ITEM NO.	DESCRIPTION	UNIT	SHEET NUMBERS												TOTAL THIS SHEET		GRAND TOTAL	
			5-13		5-14		5-15											
			PLAN	FINAL	PLAN	FINAL	PLAN	FINAL	PLAN	FINAL	PLAN	FINAL	PLAN	FINAL	PLAN	FINAL	PLAN	FINAL
700-1-11	SINGLE POST SIGN, F&I GROUND MOUNT, UP TO 12 SF	AS			5	✓	4	✓							9	✓	35	37
700-1-12	SINGLE POST SIGN, F&I GROUND MOUNT, 12-20 SF	AS			1	✓									1	✓	16	✓
700-1-13	SINGLE POST SIGN, F&I GROUND MOUNT, 21-30 SF	AS					2	✓							2	✓	5	✓
700-1-50	SINGLE POST SIGN, RELOCATE	AS	2	3	6	5	2	✓							10	✓	12	11
700-1-60	SINGLE POST SIGN, REMOVE	AS			4	✓	6	✓							10	✓	48	✓
700-2-50	MULTI- POST SIGN, F&I GROUND MOUNT, RELOCATE	AS			1	✓									1	✓	1	✓
705-11-3	DELINEATOR, FLEXIBLE HIGH VISABILITY MEDIAN	EA															13	✓
710-11-190	PAINTED PAVEMENT MARKINGS, STANDARD, WHITE, ISLAND NOSE	SF															32	0
710-11-290	PAINTED PAVEMENT MARKINGS, STANDARD, YELLOW, ISLAND NOSE	SF															39	0
710-90	PAINTED PAVEMENT MARKINGS-FINAL SURFACE	LS															1	✓
**	RETRO-REFLECTIVE PAVEMENT MARKERS	EA	25		66		57								148			
	STANDARD, WHITE, SOLID, 6"	GM	0.271		0.217		0.298								0.786			
	STANDARD, WHITE, SOLID, 8"	GM			{0.017}^A		{0.025}^A								{0.042}^A			
	STANDARD, WHITE, SOLID, CROSSWALK, 12"	LF																
	STANDARD, WHITE, SOLID, 18"	LF			58										58			
	STANDARD, WHITE, SOLID, 24"	LF	26		26										52			
	STANDARD, WHITE, SKIP, 10-30, 6"	GM																
	STANDARD, WHITE, 2-4 DOTTED GUIDELINE/6-10 DOTTED EXTENSION, 6"	GM					0.031								0.031			
	STANDARD, WHITE, MESSAGE OR SYMBOL	EA			1		1								2			
	STANDARD, WHITE, ARROWS	EA			5		10								15			
	STANDARD, YELLOW, SOLID, 6"	GM	0.191		0.338		0.186								0.715			
	STANDARD, YELLOW, SOLID, 18"	LF	26		87										113			
	STANDARD, YELLOW, SKIP, 10-30, 6"	GM	0.156				0.115								0.271			
	STANDARD, YELLOW, 2-4 DOTTED GUIDELINE/6-10 DOTTED EXTENSION, 6"	GM			0.026										0.026			
	STANDARD, BLACK, SKIP/DOTTED, 6"	GM																
711-11-123	THERMOPLASTIC, STANDARD, WHITE, SOLID, 12" FOR CROSSWALK AND ROUNDABOUT	LF															620	618
711-11-124	THERMOPLASTIC, STANDARD, WHITE, SOLID, 18" FOR DIAGONALS AND CHEVRONS	LF			58										58		58	0
711-11-125	THERMOPLASTIC, STANDARD, WHITE, SOLID, 24" FOR STOP LINE AND CROSSWALK	LF	26		26										52		288	285
711-11-170	THERMOPLASTIC, STANDARD, WHITE, ARROWS	EA															27	✓
711-11-224	THERMOPLASTIC, STANDARD, YELLOW, SOLID 18" FOR DIAGONAL OR CHEVRON	LF	26		87										113		113	128
711-11-241	THERMOPLASTIC, STANDARD, YELLOW, 2-4 DOTTED GUIDE LINE/6-10 DOTTED EXTENSION LINE, 6"	GM			0.026										0.026		0.223	0.212
711-14-123	THERMOPLASTIC, PREFORMED, WHITE, SOLID, 12" FOR CROSSWALK	LF															1121	1212
711-14-125	THERMOPLASTIC, PREFORMED, WHITE, SOLID, 24" FOR CROSSWALK	LF															764	875
711-14-141	THERMOPLASTIC, PREFORMED, WHITE, 2-4 DOTTED GUIDELINE ON CONCRETE SURFACES	GM					0.031								0.031		0.031	0
711-14-160	THERMOPLASTIC, PREFORMED, WHITE, MESSAGE OR SYMBOL	EA			1		1								2		3	✓
711-14-170	THERMOPLASTIC, PREFORMED, WHITE, ARROWS	EA			5		10								15		28	✓
711-16-101	THERMOPLASTIC, STANDARD-OTHER SURFACES, WHITE, SOLID, 6"	GM	0.271		0.217		0.298								0.786		3.153	3.212
711-16-102	THERMOPLASTIC, STANDARD-OTHER SURFACES, WHITE, SOLID, 8"	GM			{0.017}^A		{0.025}^A								{0.042}^A		{0.073}^A	0.064
711-16-131	THERMOPLASTIC, OTHER SURFACES, WHITE, SKIP, 6", 10-30 SKIP OR LANE DROP	GM															2.964	3.145
711-16-201	THERMOPLASTIC, STANDARD-OTHER SURFACES, YELLOW, SOLID, 6"	GM	0.191		0.338		0.186								0.715		3.006	3.306
711-16-231	THERMOPLASTIC, STANDARD-OTHER SURFACES, YELLOW, SKIP, 6"	GM	0.156				0.115								0.271		0.271	0.288
713-103-131	PERMANENT TAPE, WHITE, SKIP/DOTTED, 6" FOR CONCRETE SURFACES	GM															0.985	✓
713-103-331	PERMANENT TAPE, BLACK, SKIP/DOTTED, 6" FOR CONCRETE SURFACES	GM															0.985	✓

** THESE QUANTITIES ARE PAID FOR UNDER PAINTED PAVEMENT MARKINGS (FINAL SURFACE), LUMP SUM - ITEM NO. 710-90. THESE QUANTITIES ARE FOR ONE APPLICATION; SEE SPECIFICATION 710 FOR THE NUMBER OF APPLICATIONS REQUIRED.

CONTRACTORS CERTIFICATION OF STRIPING
SUMMARY SHEET BACKUP DATA - EDMS NO. 1274494

<p>REVISIONS</p> <table border="1"> <thead> <tr> <th>DATE</th> <th>DESCRIPTION</th> <th>DATE</th> <th>DESCRIPTION</th> </tr> </thead> <tbody> <tr> <td>05/18/18</td> <td>RKB Δ UPDATED QUANTITY</td> <td></td> <td></td> </tr> </tbody> </table>				DATE	DESCRIPTION	DATE	DESCRIPTION	05/18/18	RKB Δ UPDATED QUANTITY			<p>Comprehensive Engineering Services, Inc. 201 S Orange Ave, Suite 1300 Orlando, FL 32801-3442 Certificate of Authorization No. 7862 Ryan K. Baderschneider, P.E., License No. 60851</p>			<p>STATE OF FLORIDA DEPARTMENT OF TRANSPORTATION</p> <table border="1"> <thead> <tr> <th>ROAD NO.</th> <th>COUNTY</th> <th>FINANCIAL PROJECT ID</th> </tr> </thead> <tbody> <tr> <td>SR 25</td> <td>HIGHLANDS</td> <td>434986-1-52-01</td> </tr> </tbody> </table>			ROAD NO.	COUNTY	FINANCIAL PROJECT ID	SR 25	HIGHLANDS	434986-1-52-01	<p>SHEET NO. 5-4</p>	
DATE	DESCRIPTION	DATE	DESCRIPTION																						
05/18/18	RKB Δ UPDATED QUANTITY																								
ROAD NO.	COUNTY	FINANCIAL PROJECT ID																							
SR 25	HIGHLANDS	434986-1-52-01																							



THE OFFICIAL RECORD OF THIS SHEET IS THE ELECTRONIC FILE DIGITALLY SIGNED AND SEALED UNDER RULE 61G15-23.004, F.A.C.

SIGNING AND PAVEMENT MARKING NOTES

1. ALL SIGNS MOUNTED OVER SIDEWALKS SHALL HAVE A VERTICAL CLEARANCE OF EIGHT FEET (8') STANDARD.
2. UNLESS OTHERWISE NOTED ON PLAN SHEETS, ALL CROSSWALKS ACROSS MAJOR STREET SHALL BE TEN FEET (10') IN WIDTH AND ALL CROSSWALKS ACROSS SIDE STREET SHALL BE SIX FEET (6') IN WIDTH. MEASUREMENTS SHALL BE FROM INSIDE TO INSIDE OF 12" STRIPES.
3. PAY ITEM 700-1-11: WHERE APPLICABLE, REMOVE THE STREET NAME PANELS AND/OR OTHER SPECIFIED SIGN PANELS FROM EXISTING STOP SIGN ASSEMBLIES THAT ARE BEING REMOVED AND INSTALL THEM ON NEW SIGN ASSEMBLIES AS CALLED FOR IN PLANS. IF EXISTING MOUNTING BRACKETS ARE UNUSABLE, PURCHASE APPROVED BRACKETS FOR ATTACHMENT OF RELOCATED SIGN PANELS TO ENSURE PROPER INSTALLATION OF COMPLETE ASSEMBLY FOR THE POST USED.

<u>ABBREVIATION</u>	<u>DEFINITION</u>
W-R	BI-DIRECTIONAL WHITE-RED
Y-Y	BI-DIRECTIONAL YELLOW-YELLOW
Y	MONO-DIRECTIONAL YELLOW
THERMO.	THERMOPLASTIC

<u>REVISIONS</u>				Comprehensive Engineering Services, Inc. 201 S Orange Ave, Suite 1300 Orlando, FL 32801-3442 Certificate of Authorization No: 7862 Ryan K. Baderschneider, P.E., License No. 60851	<i>STATE OF FLORIDA</i> <i>DEPARTMENT OF TRANSPORTATION</i>			<i>SIGNING AND PAVEMENT</i> <i>MARKING NOTES</i>	SHEET NO.
<u>DATE</u>	<u>DESCRIPTION</u>	<u>DATE</u>	<u>DESCRIPTION</u>		<u>ROAD NO.</u>	<u>COUNTY</u>	<u>FINANCIAL PROJECT ID</u>		S-5
					SR 25	HIGHLANDS	434986-1-52-01		

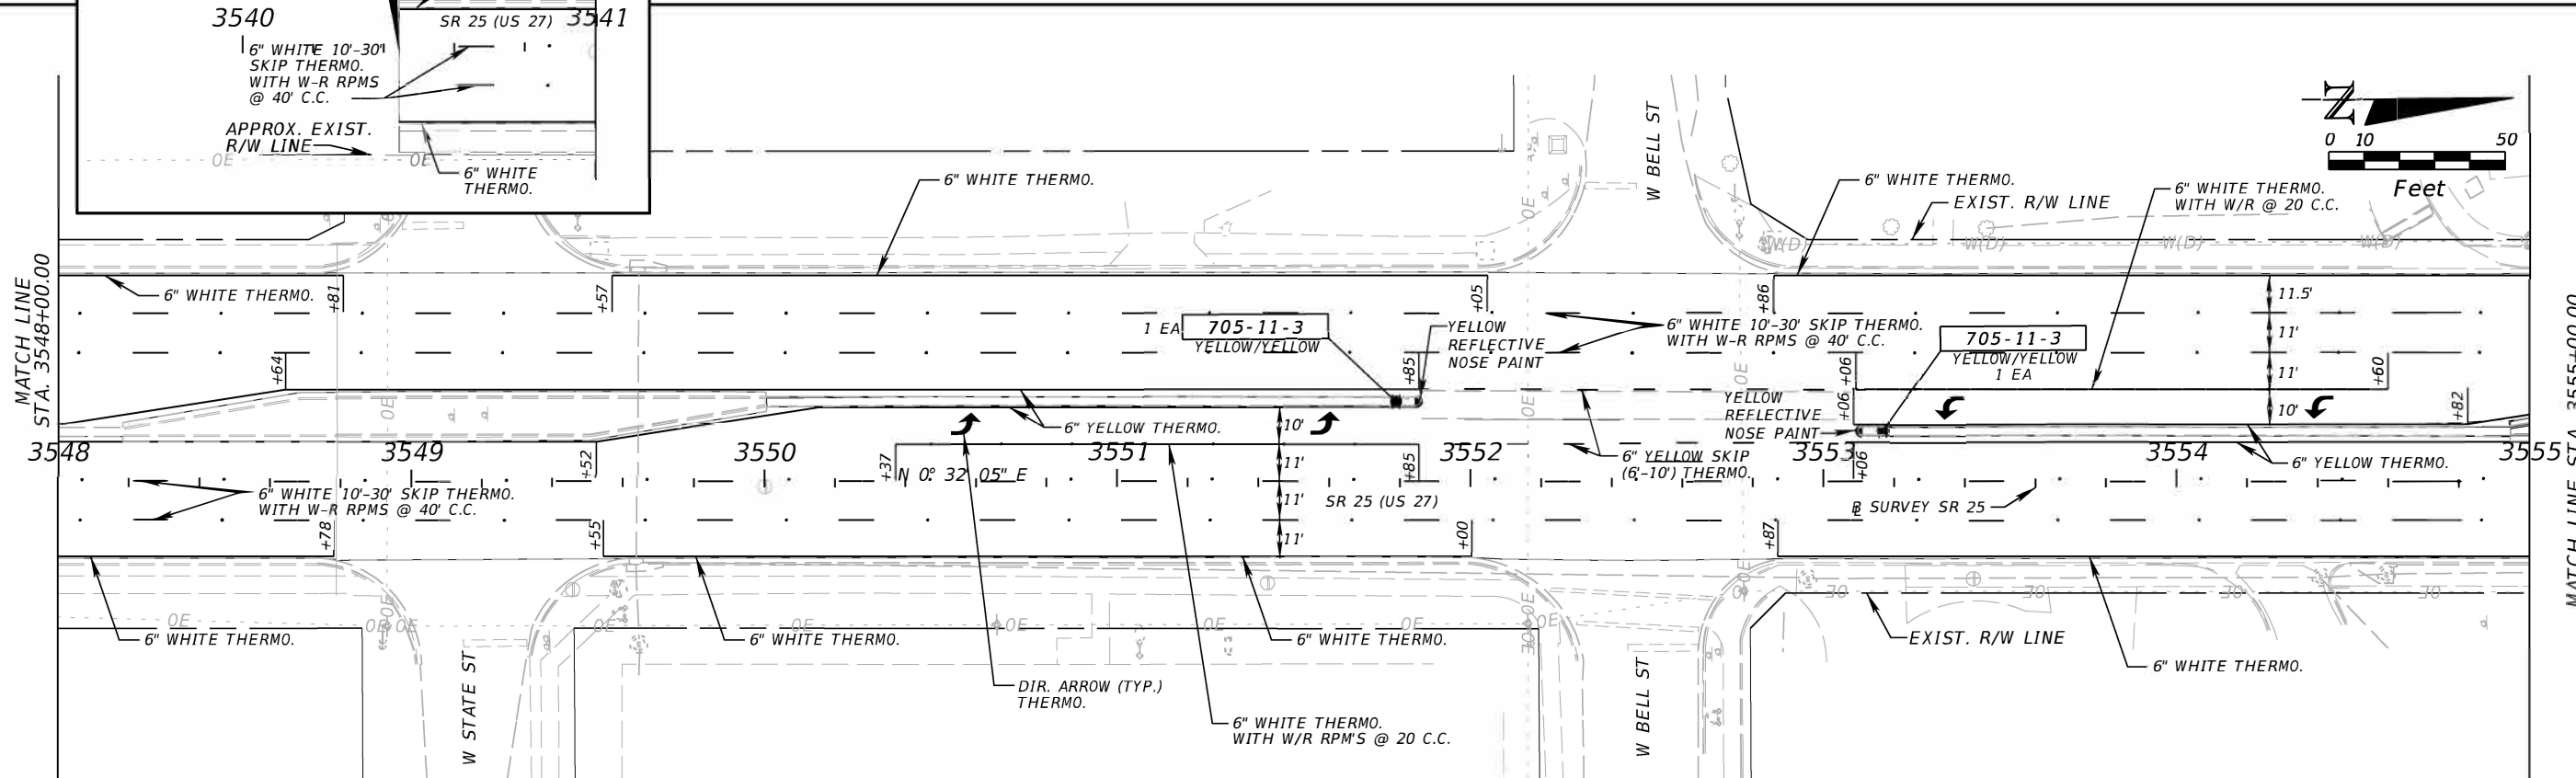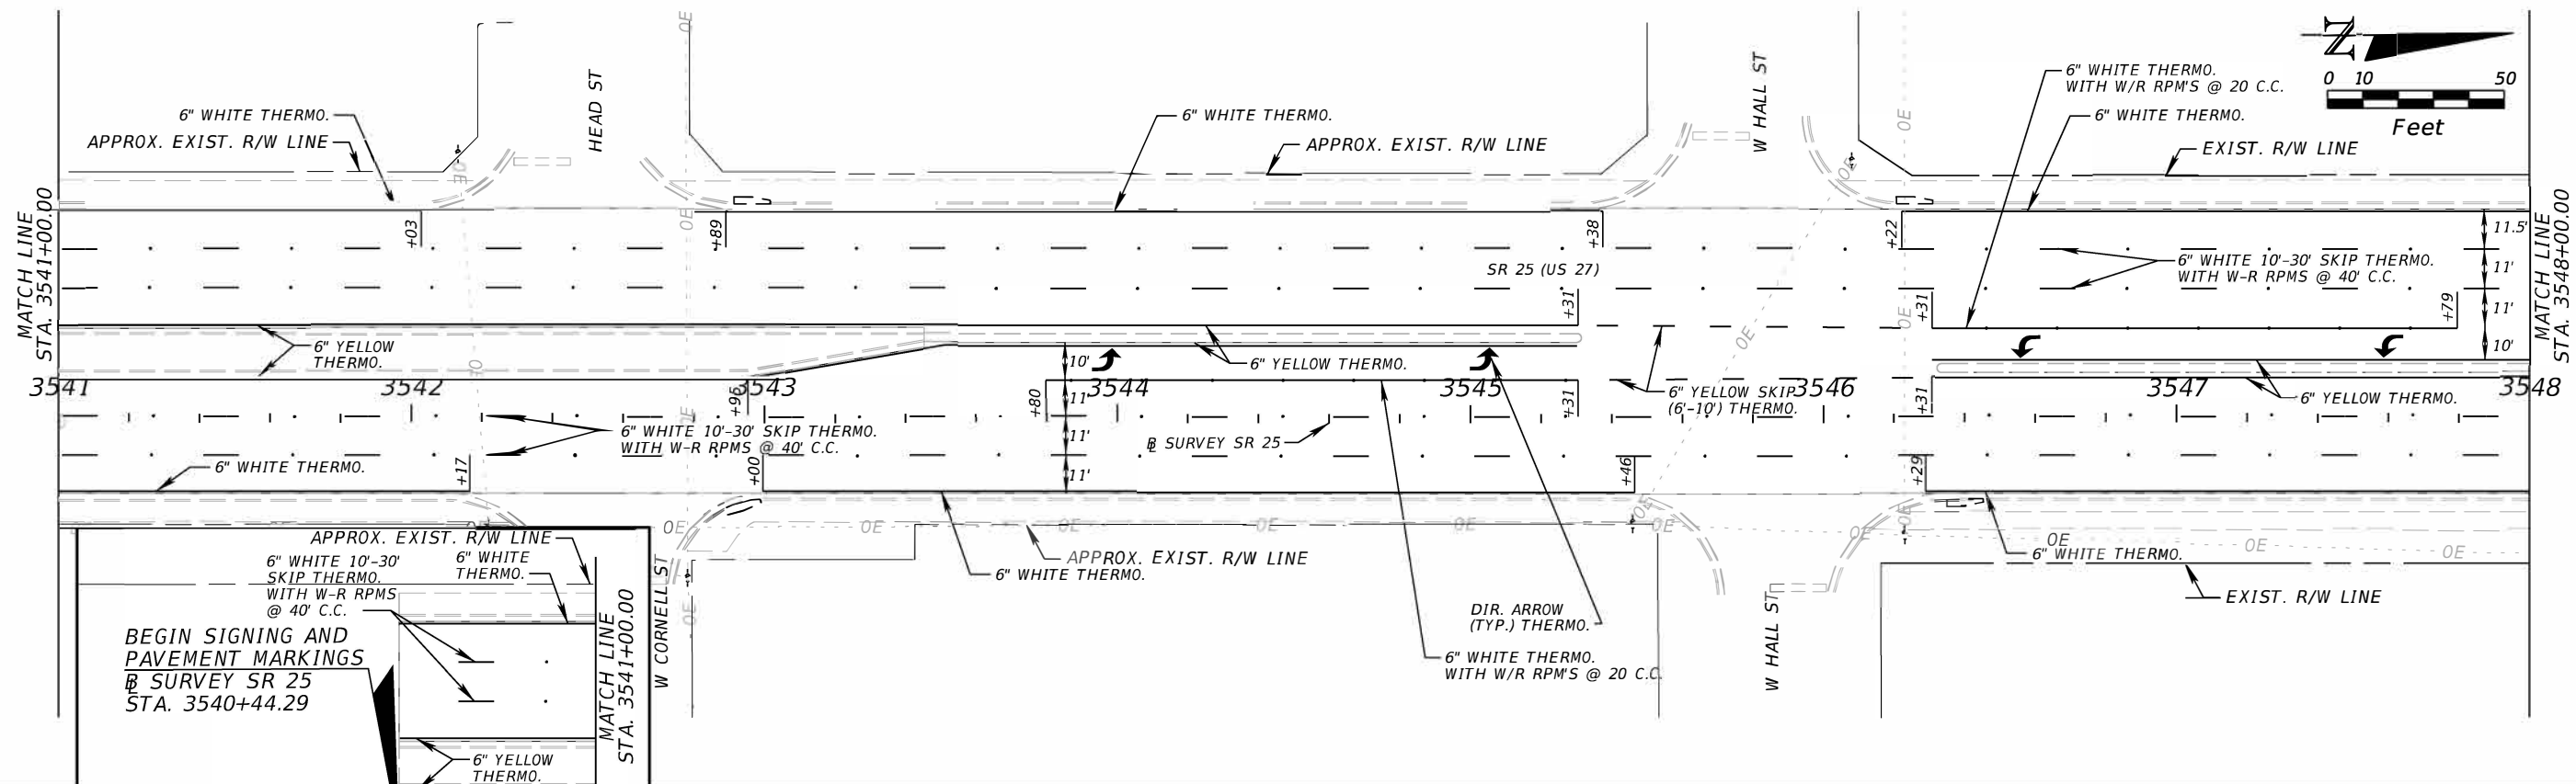

BEGIN SIGNING AND PAVEMENT MARKINGS
 @ SURVEY SR 25
 STA. 3540+44.29

APPROX. EXIST. R/W LINE
 6" WHITE 10'-30' SKIP THERMO. WITH W-R RPMS @ 40' C.C.
 6" WHITE THERMO.

3540
 6" WHITE 10'-30' SKIP THERMO. WITH W-R RPMS @ 40' C.C.
 APPROX. EXIST. R/W LINE
 6" WHITE THERMO.

APPROX. EXIST. R/W LINE
 6" WHITE 10'-30' SKIP THERMO. WITH W-R RPMS @ 40' C.C.
 6" WHITE THERMO.

SR 25 (US 27)
 6" YELLOW THERMO.

REVISIONS			
DATE	DESCRIPTION	DATE	DESCRIPTION

Comprehensive Engineering Services, Inc.
 201 S Orange Ave, Suite 1300
 Orlando, FL 32801-3442
 Certificate of Authorization No: 7862
 Ryan K. Baderschneider, P.E., License No. 60851

STATE OF FLORIDA DEPARTMENT OF TRANSPORTATION		
ROAD NO.	COUNTY	FINANCIAL PROJECT ID
SR 25	HIGHLANDS	434986-1-52-01



**SIGNING AND PAVEMENT
MARKING PLAN**

SHEET NO.
S-6

THE OFFICIAL RECORD OF THIS SHEET IS THE ELECTRONIC FILE DIGITALLY SIGNED AND SEALED UNDER RULE 61G15-23.004, F.A.C.

MATCH LINE STA. 3555+00.00

MATCH LINE STA. 3560+60.00

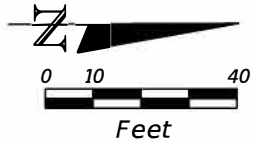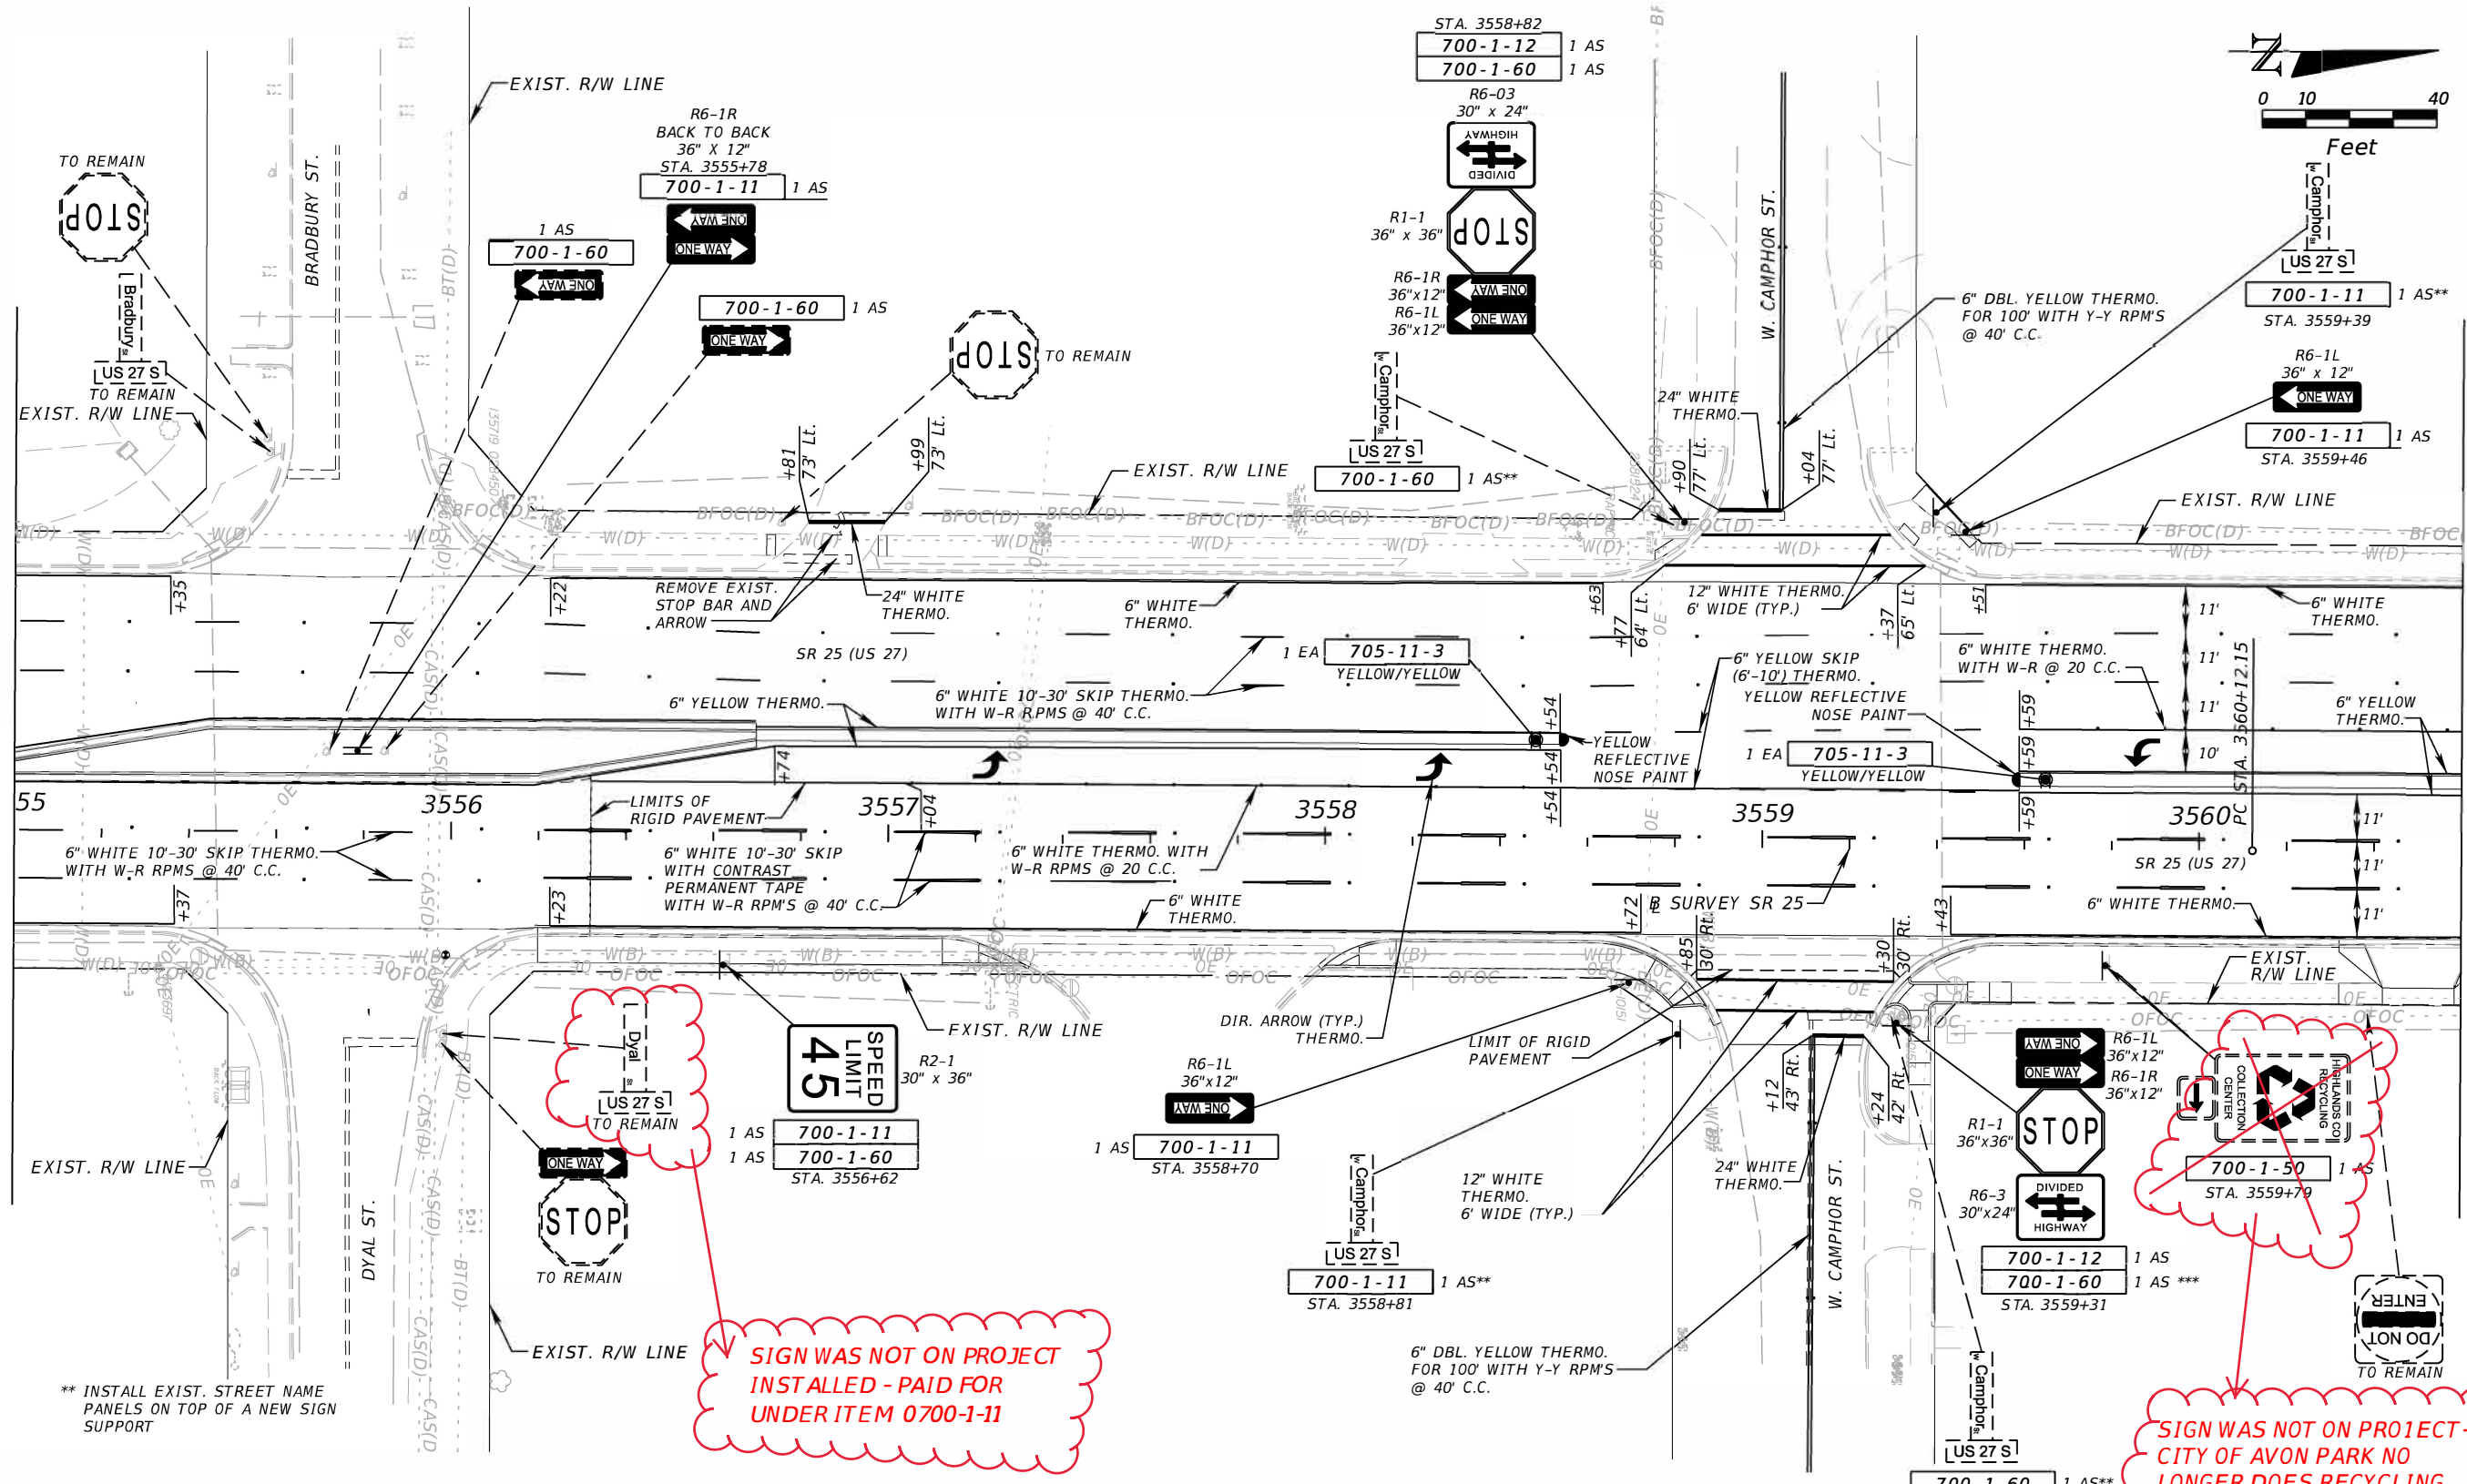

** INSTALL EXIST. STREET NAME PANELS ON TOP OF A NEW SIGN SUPPORT

SIGN WAS NOT ON PROJECT INSTALLED - PAID FOR UNDER ITEM 0700-1-11

SIGN WAS NOT ON PROJECT - CITY OF AVON PARK NO LONGER DOES RECYCLING

REVISIONS			
DATE	DESCRIPTION	DATE	DESCRIPTION

Comprehensive Engineering Services, Inc.
 201 S Orange Ave, Suite 1300
 Orlando, FL 32801-3442
 Certificate of Authorization No. 7862
 Ryan K. Baderschneider, P.E., License No. 60851

STATE OF FLORIDA DEPARTMENT OF TRANSPORTATION		
ROAD NO.	COUNTY	FINANCIAL PROJECT ID
SR 25	HIGHLANDS	434986-1-52-01


**SIGNING AND PAVEMENT
MARKING PLAN**

SHEET NO.
S-7


THE OFFICIAL RECORD OF THIS SHEET IS THE ELECTRONIC FILE DIGITALLY SIGNED AND SEALED UNDER RULE 61G15-23.004, F.A.C.

MATCH LINE STA. 3560+60.00

MATCH LINE STA. 3566+20.00

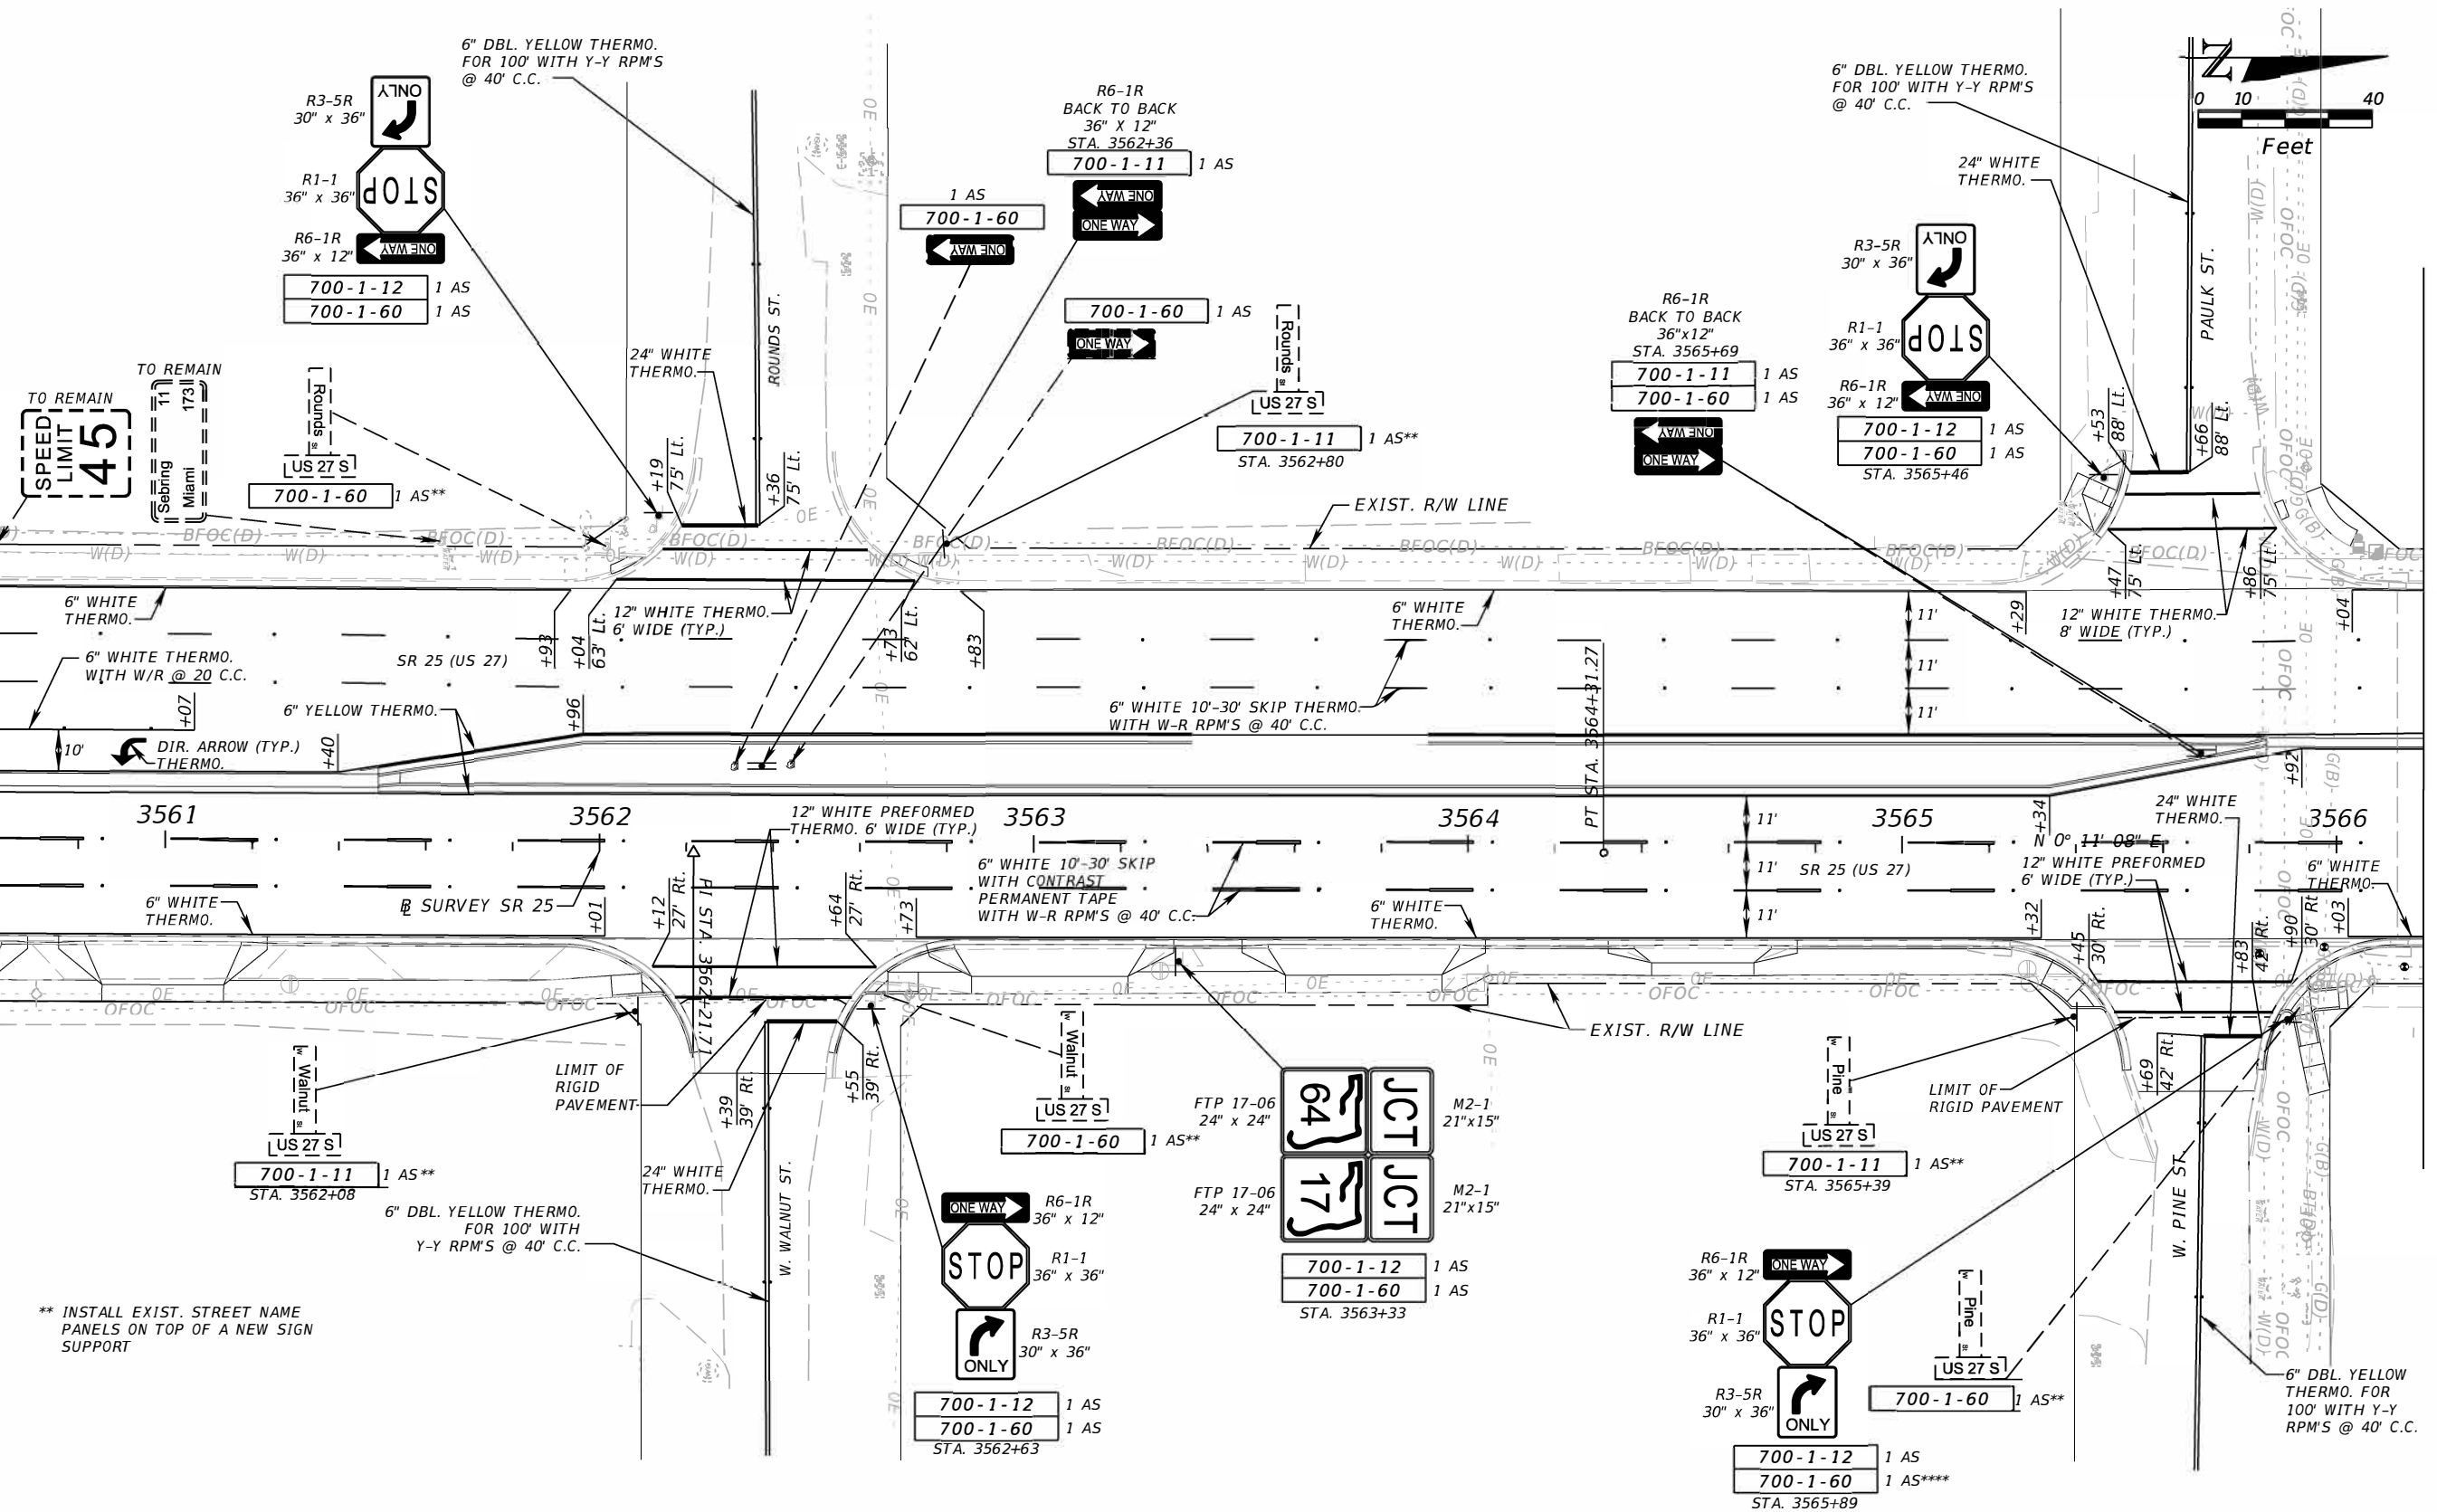

** INSTALL EXIST. STREET NAME PANELS ON TOP OF A NEW SIGN SUPPORT

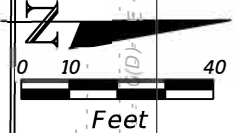

REVISIONS			
DATE	DESCRIPTION	DATE	DESCRIPTION

Comprehensive Engineering Services, Inc.
 201 S Orange Ave, Suite 1300
 Orlando, FL 32801-3442
 Certificate of Authorization No. 7862
 Ryan K. Baderschneider, P.E., License No. 60851



STATE OF FLORIDA DEPARTMENT OF TRANSPORTATION		
ROAD NO.	COUNTY	FINANCIAL PROJECT ID
SR 25	HIGHLANDS	434986-1-52-01

**SIGNING AND PAVEMENT
MARKING PLAN**

SHEET NO.
S-8

THE OFFICIAL RECORD OF THIS SHEET IS THE ELECTRONIC FILE DIGITALLY SIGNED AND SEALED UNDER RULE 61G15-23.004, F.A.C.

MATCH LINE STA. 977+50.00
SEE SHEET S-15

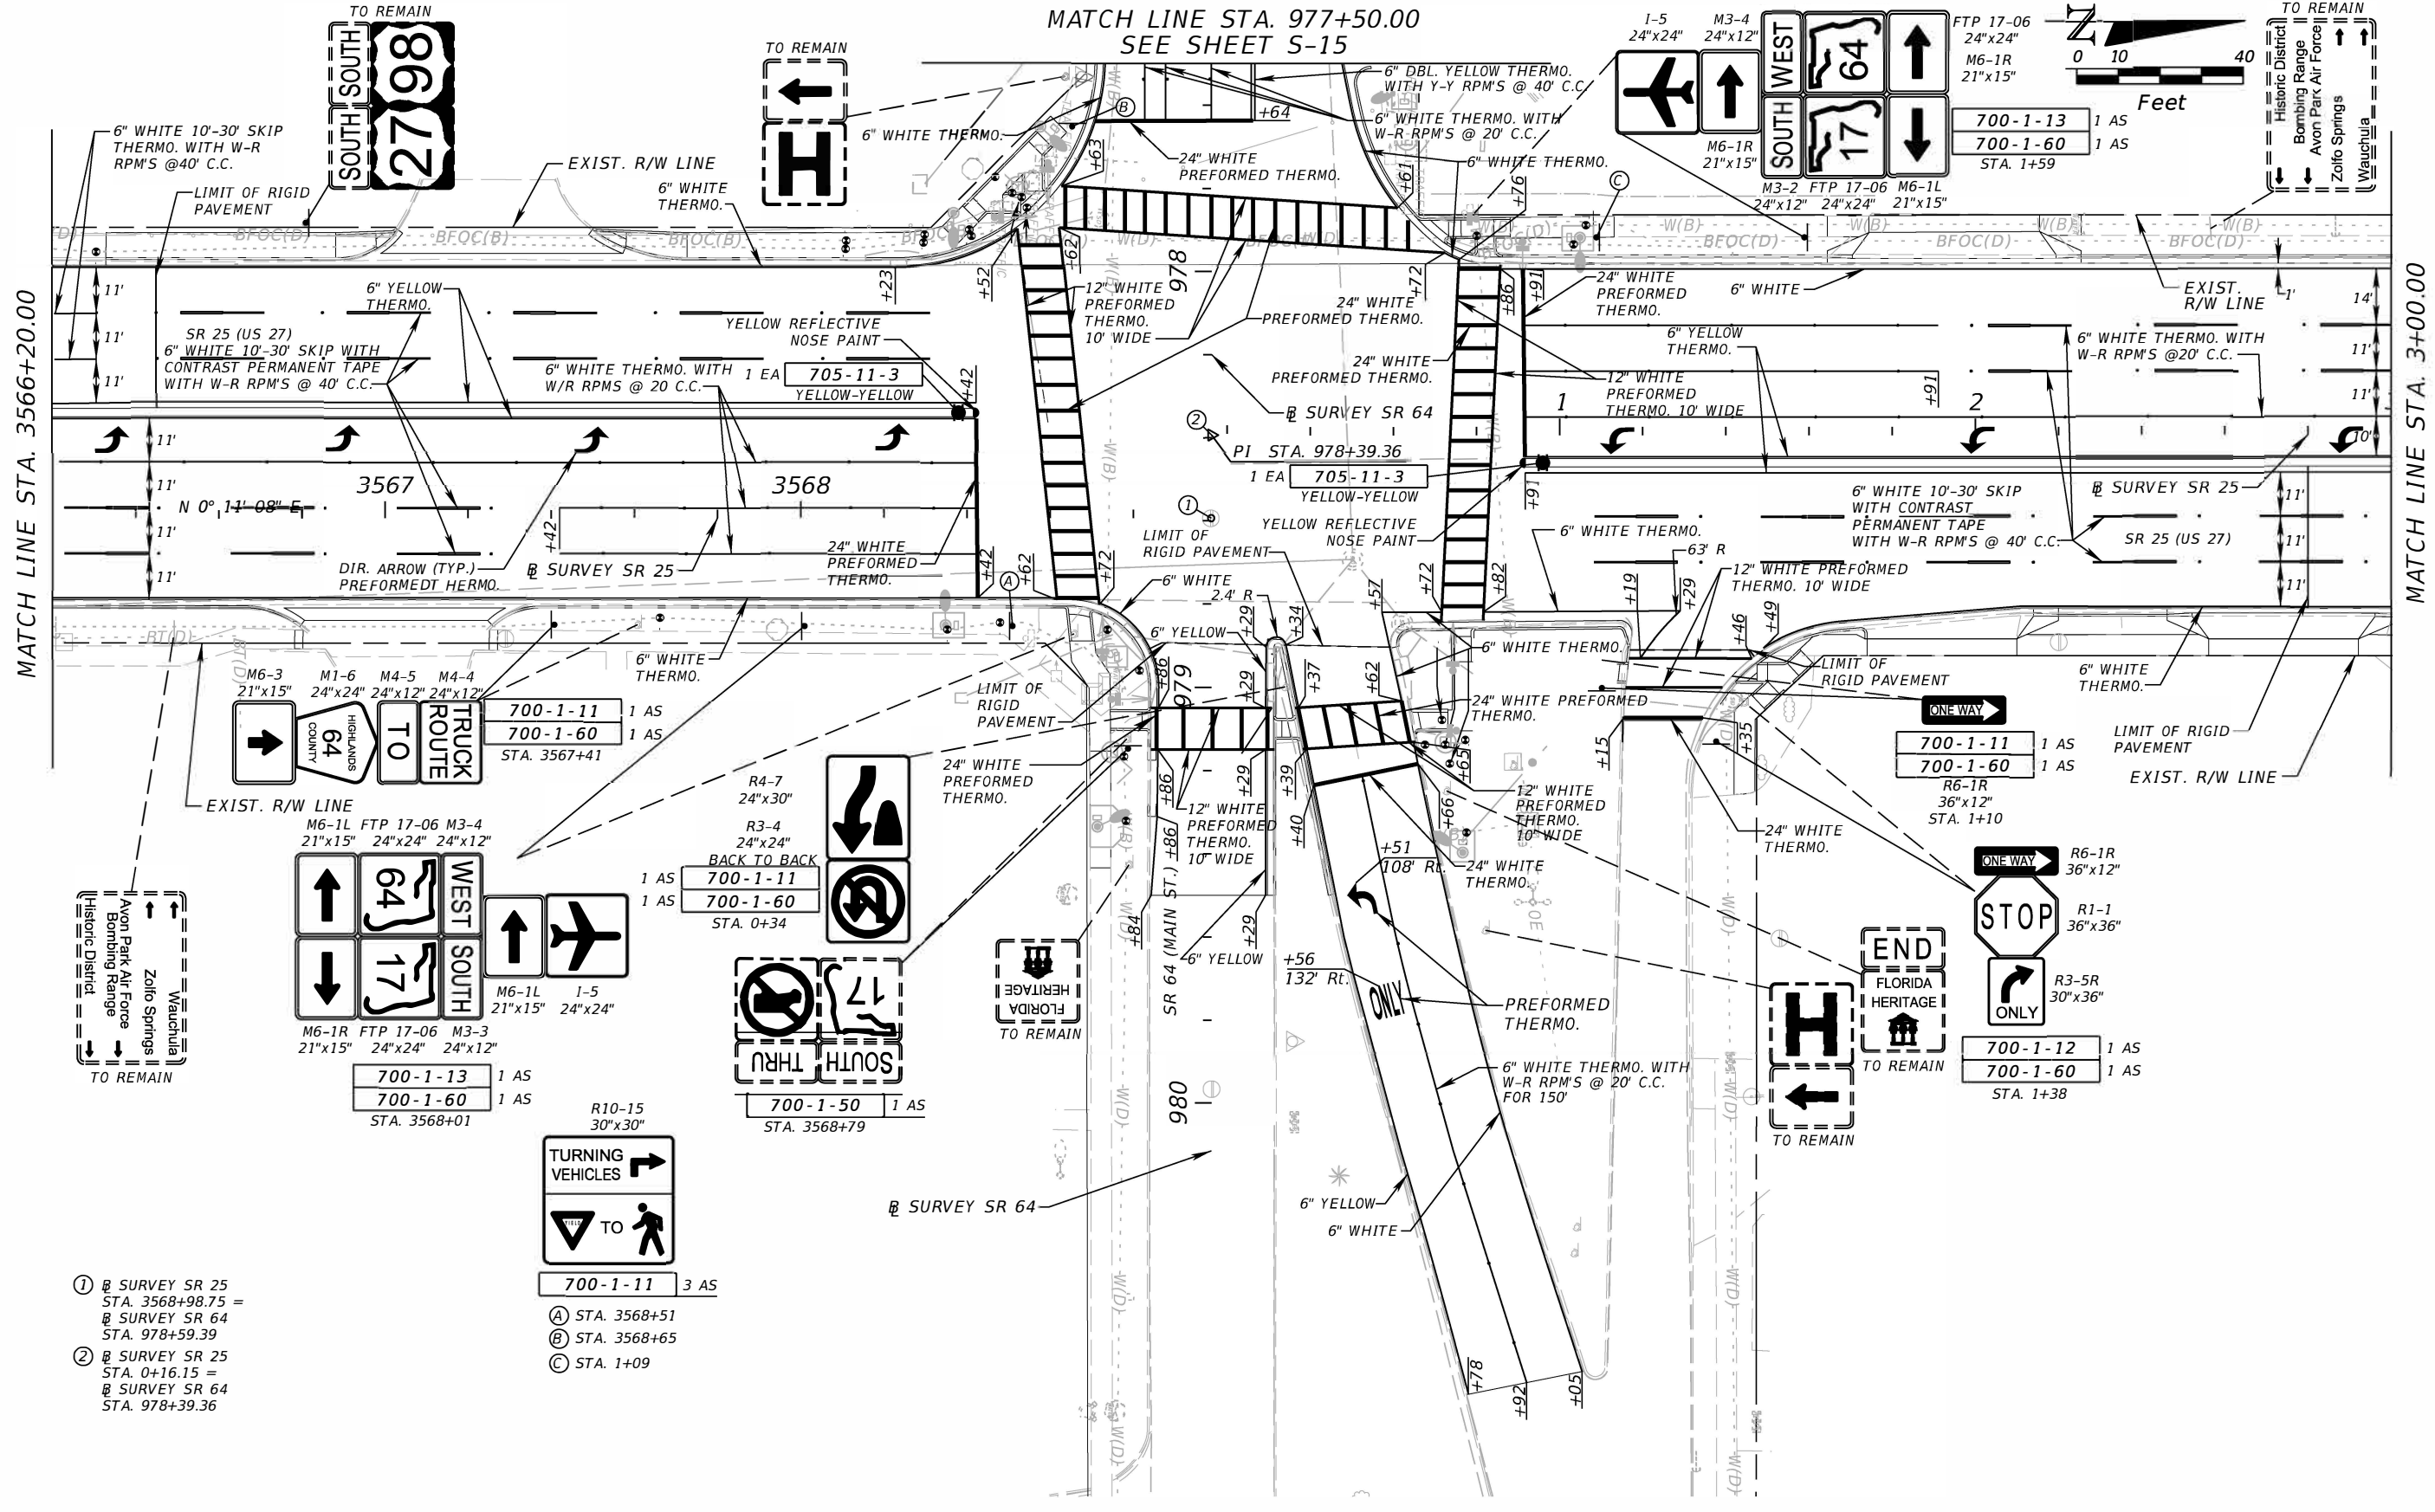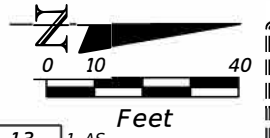

MATCH LINE STA. 3566+20.00

MATCH LINE STA. 3+00.00

- ① @ SURVEY SR 25
STA. 3568+98.75 =
@ SURVEY SR 64
STA. 978+59.39
- ② @ SURVEY SR 25
STA. 0+16.15 =
@ SURVEY SR 64
STA. 978+39.36

- R10-15
30"x30"
- TURNING VEHICLES
- TO
- 700-1-11 3 AS
- (A) STA. 3568+51
- (B) STA. 3568+65
- (C) STA. 1+09

- R4-7
24"x30"
- R3-4
24"x24"
- BACK TO BACK
700-1-11
700-1-60
STA. 0+34
- 700-1-50 1 AS
STA. 3568+79

- M6-3
21"x15"
- M1-6
24"x24"
- M4-5
24"x12"
- M4-4
24"x12"
- 700-1-11 1 AS
700-1-60 1 AS
STA. 3567+41
- M6-1L
21"x15"
- M3-4
24"x24"
- 700-1-13 1 AS
700-1-60 1 AS
STA. 3568+01
- M6-1R
21"x15"
- FTP 17-06
24"x24"
- M3-3
24"x12"
- 700-1-12 1 AS
700-1-60 1 AS
STA. 1+38

REVISIONS			
DATE	DESCRIPTION	DATE	DESCRIPTION

Comprehensive Engineering Services, Inc.
201 S Orange Ave, Suite 1300
Orlando, FL 32801-3442
Certificate of Authorization No. 7862
Ryan K. Baderschneider, P.E., License No. 60851



STATE OF FLORIDA DEPARTMENT OF TRANSPORTATION		
ROAD NO.	COUNTY	FINANCIAL PROJECT ID
SR 25	HIGHLANDS	434986-1-52-01

**SIGNING AND PAVEMENT
MARKING PLAN**

SHEET NO.
S-9

THE OFFICIAL RECORD OF THIS SHEET IS THE ELECTRONIC FILE DIGITALLY SIGNED AND SEALED UNDER RULE 61G15-23.004, F.A.C.

RELOCATED TO STA 9+00

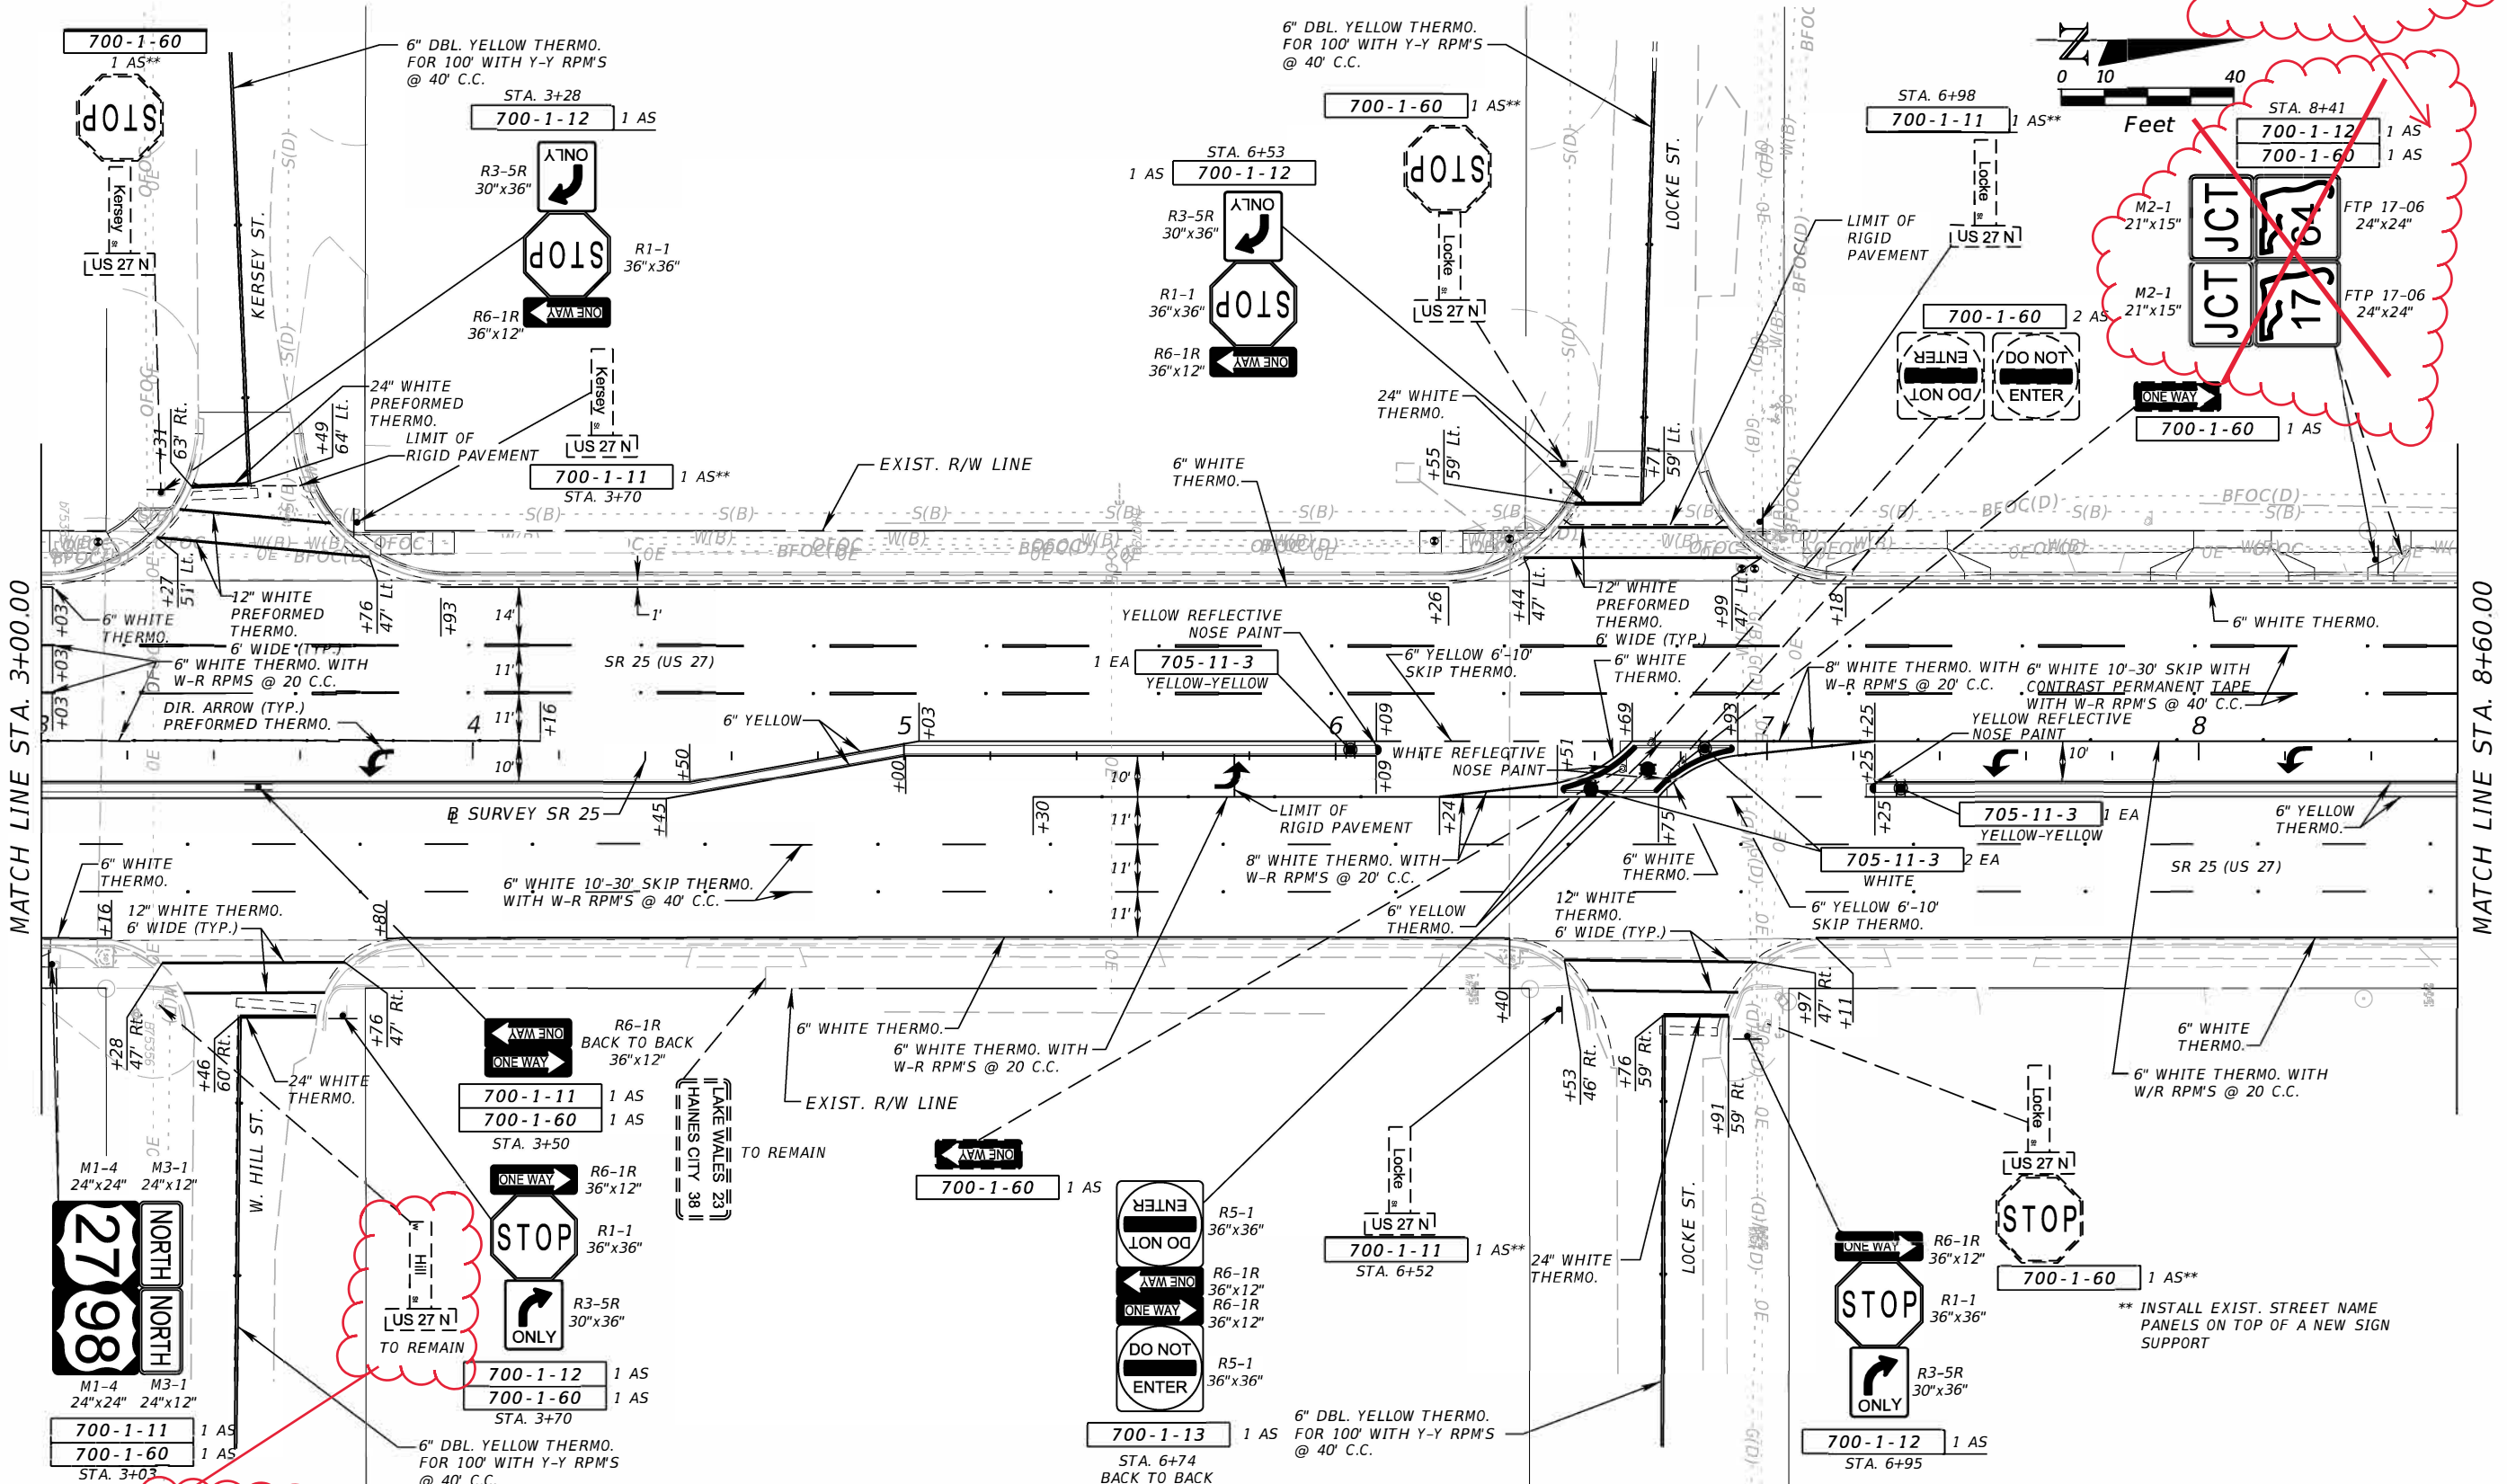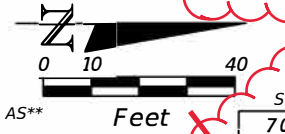

SIGN WAS NOT ON PROJECT
 INSTALLED - PAID FOR UNDER
 ITEM 0700-1-11

REVISIONS

DATE	DESCRIPTION	DATE	DESCRIPTION

Comprehensive Engineering Services, Inc.
 201 S Orange Ave, Suite 1300
 Orlando, FL 32801-3442
 Certificate of Authorization No. 7862
 Ryan K. Baderschneider, P.E., License No. 60851


STATE OF FLORIDA DEPARTMENT OF TRANSPORTATION		
ROAD NO.	COUNTY	FINANCIAL PROJECT ID
SR 25	HIGHLANDS	434986-1-52-01

**SIGNING AND PAVEMENT
 MARKING PLAN**

SHEET
 NO.
 S-10


THE OFFICIAL RECORD OF THIS SHEET IS THE ELECTRONIC FILE DIGITALLY SIGNED AND SEALED UNDER RULE 61G15-23.004, F.A.C.

JCT JCT RELOCATED FROM
17 64 STA 8+41 TO 9+00

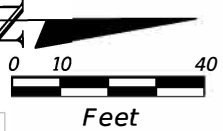

MATCH LINE STA. 8+60.00

MATCH LINE STA. 14+20.00

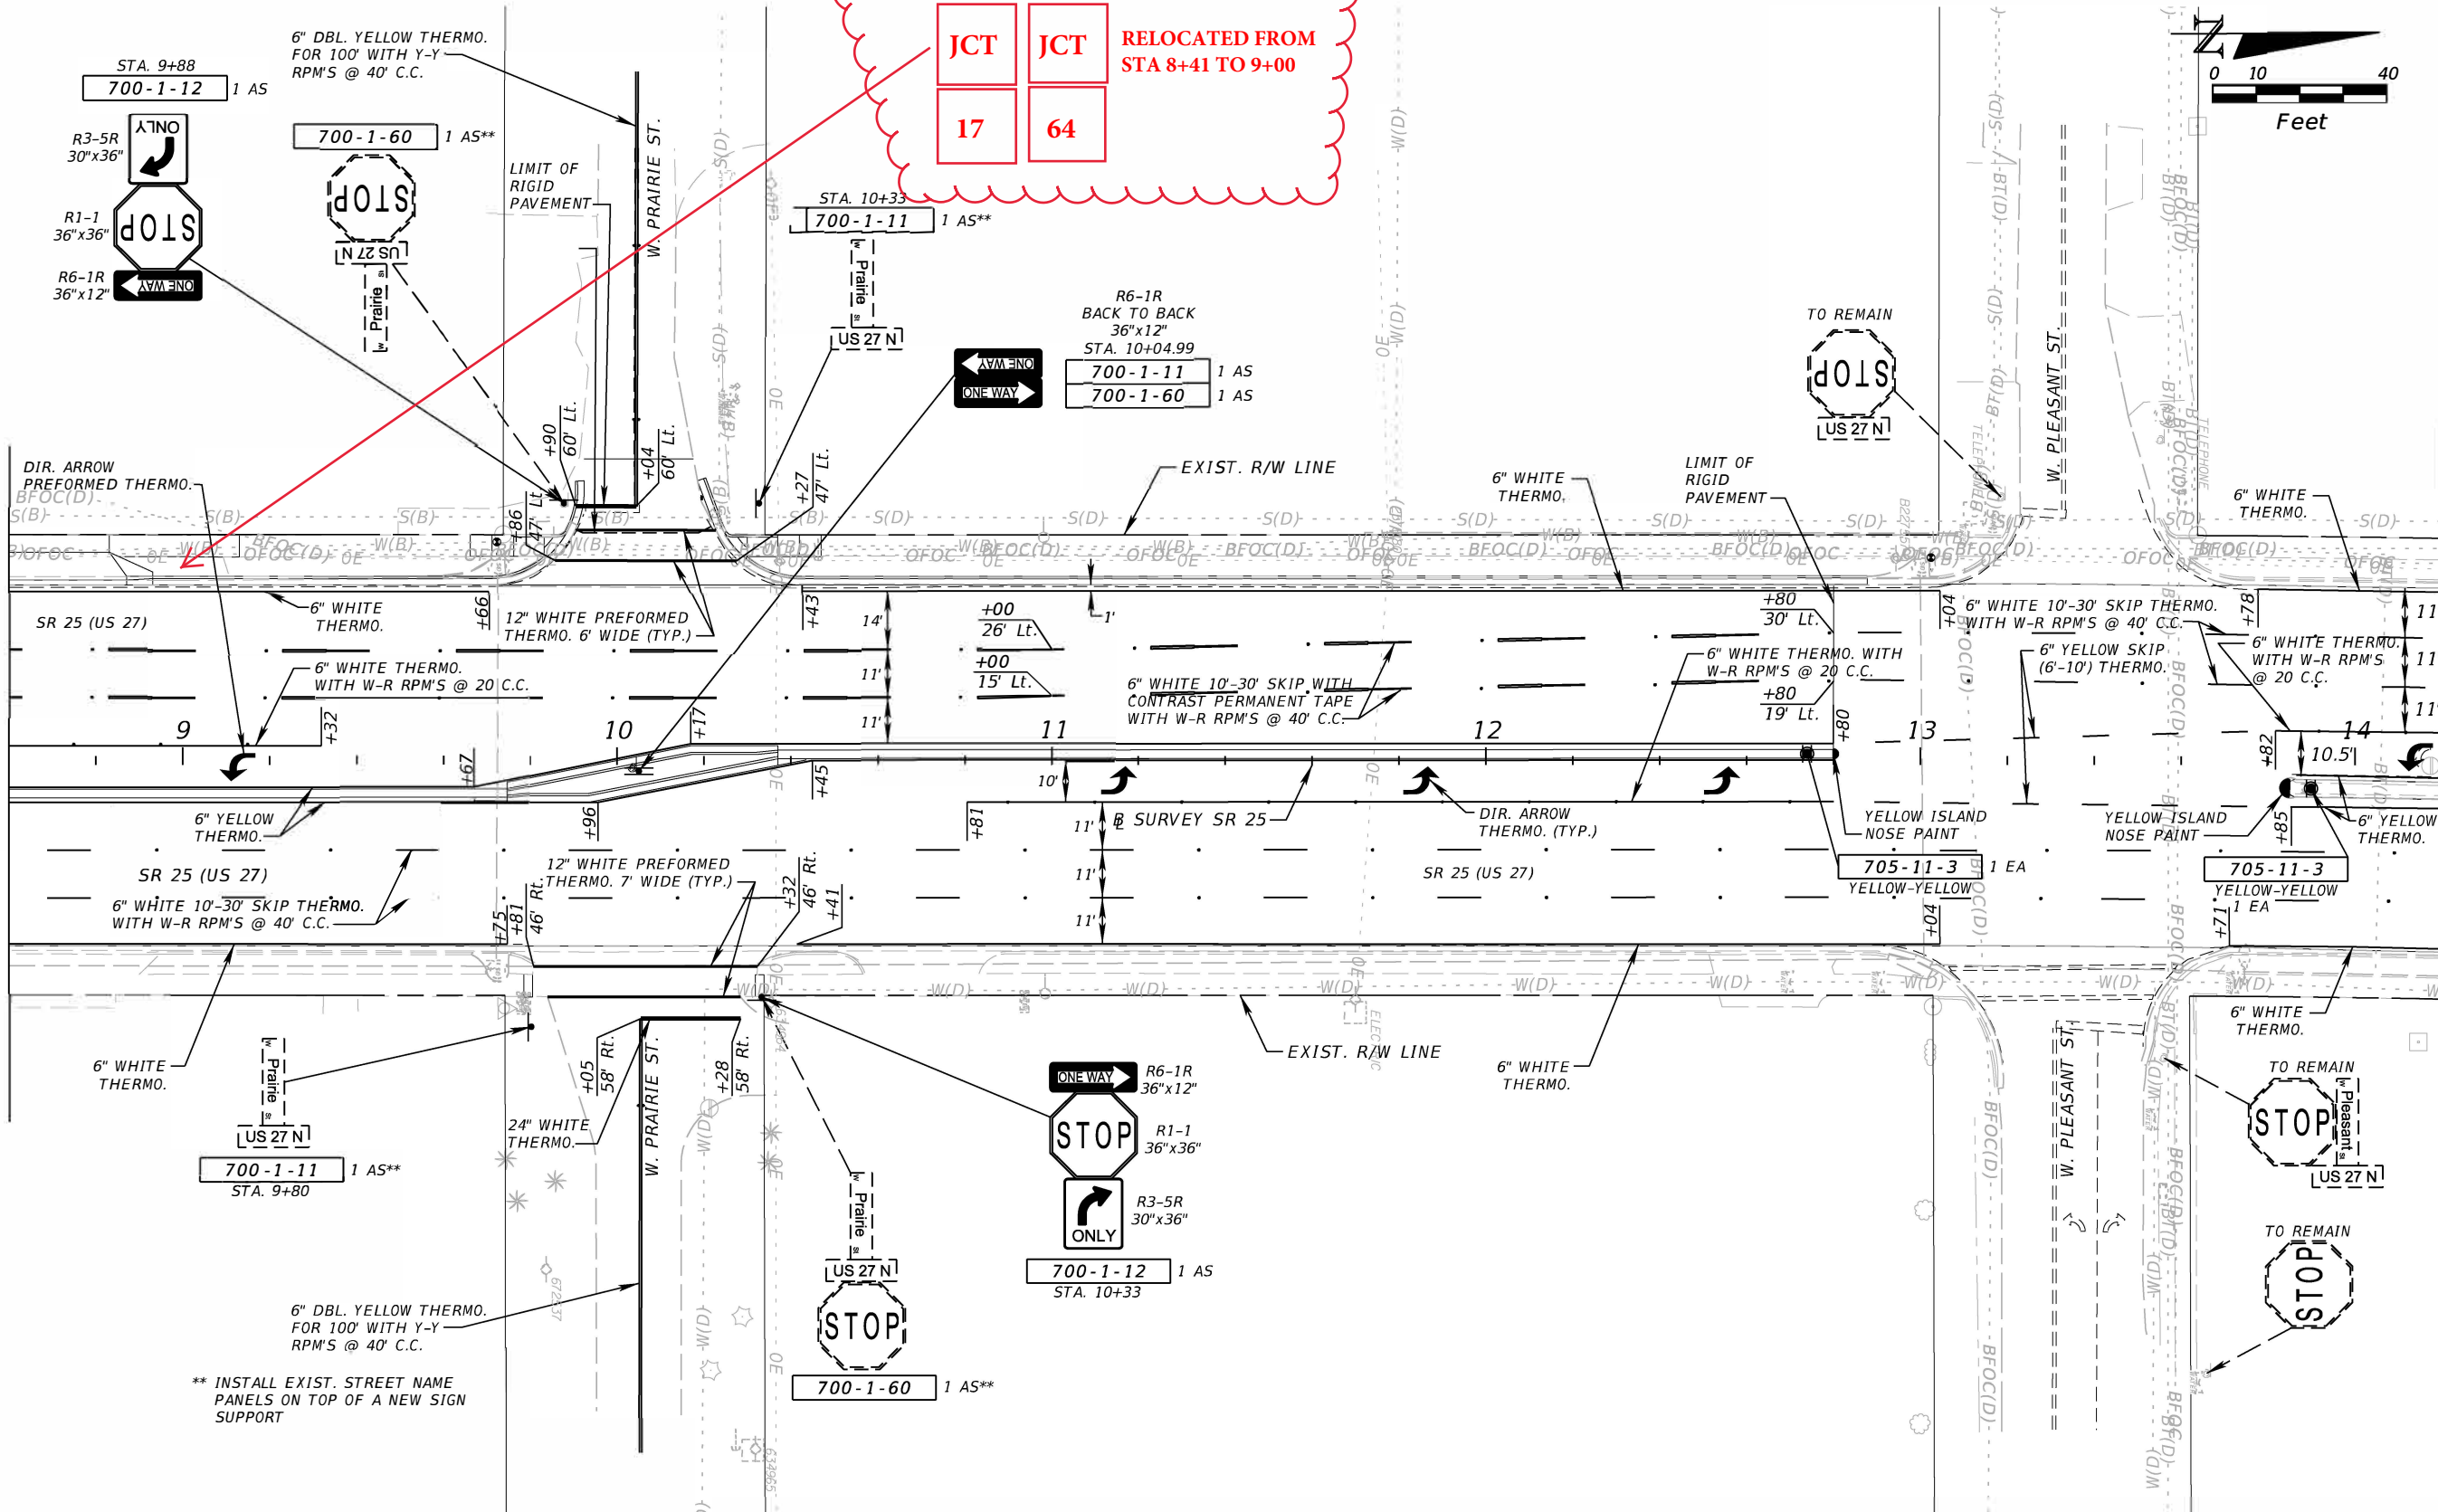

** INSTALL EXIST. STREET NAME PANELS ON TOP OF A NEW SIGN SUPPORT

REVISIONS			
DATE	DESCRIPTION	DATE	DESCRIPTION



Comprehensive Engineering Services, Inc.
 201 S Orange Ave, Suite 1300
 Orlando, FL 32801-3442
 Certificate of Authorization No. 7862
 Ryan K. Baderschneider, P.E., License No. 60851

STATE OF FLORIDA DEPARTMENT OF TRANSPORTATION		
ROAD NO.	COUNTY	FINANCIAL PROJECT ID
SR 25	HIGHLANDS	434986-1-52-01

**SIGNING AND PAVEMENT
MARKING PLAN**

SHEET
NO.
S-11

THE OFFICIAL RECORD OF THIS SHEET IS THE ELECTRONIC FILE DIGITALLY SIGNED AND SEALED UNDER RULE 61G15-23.004, F.A.C.

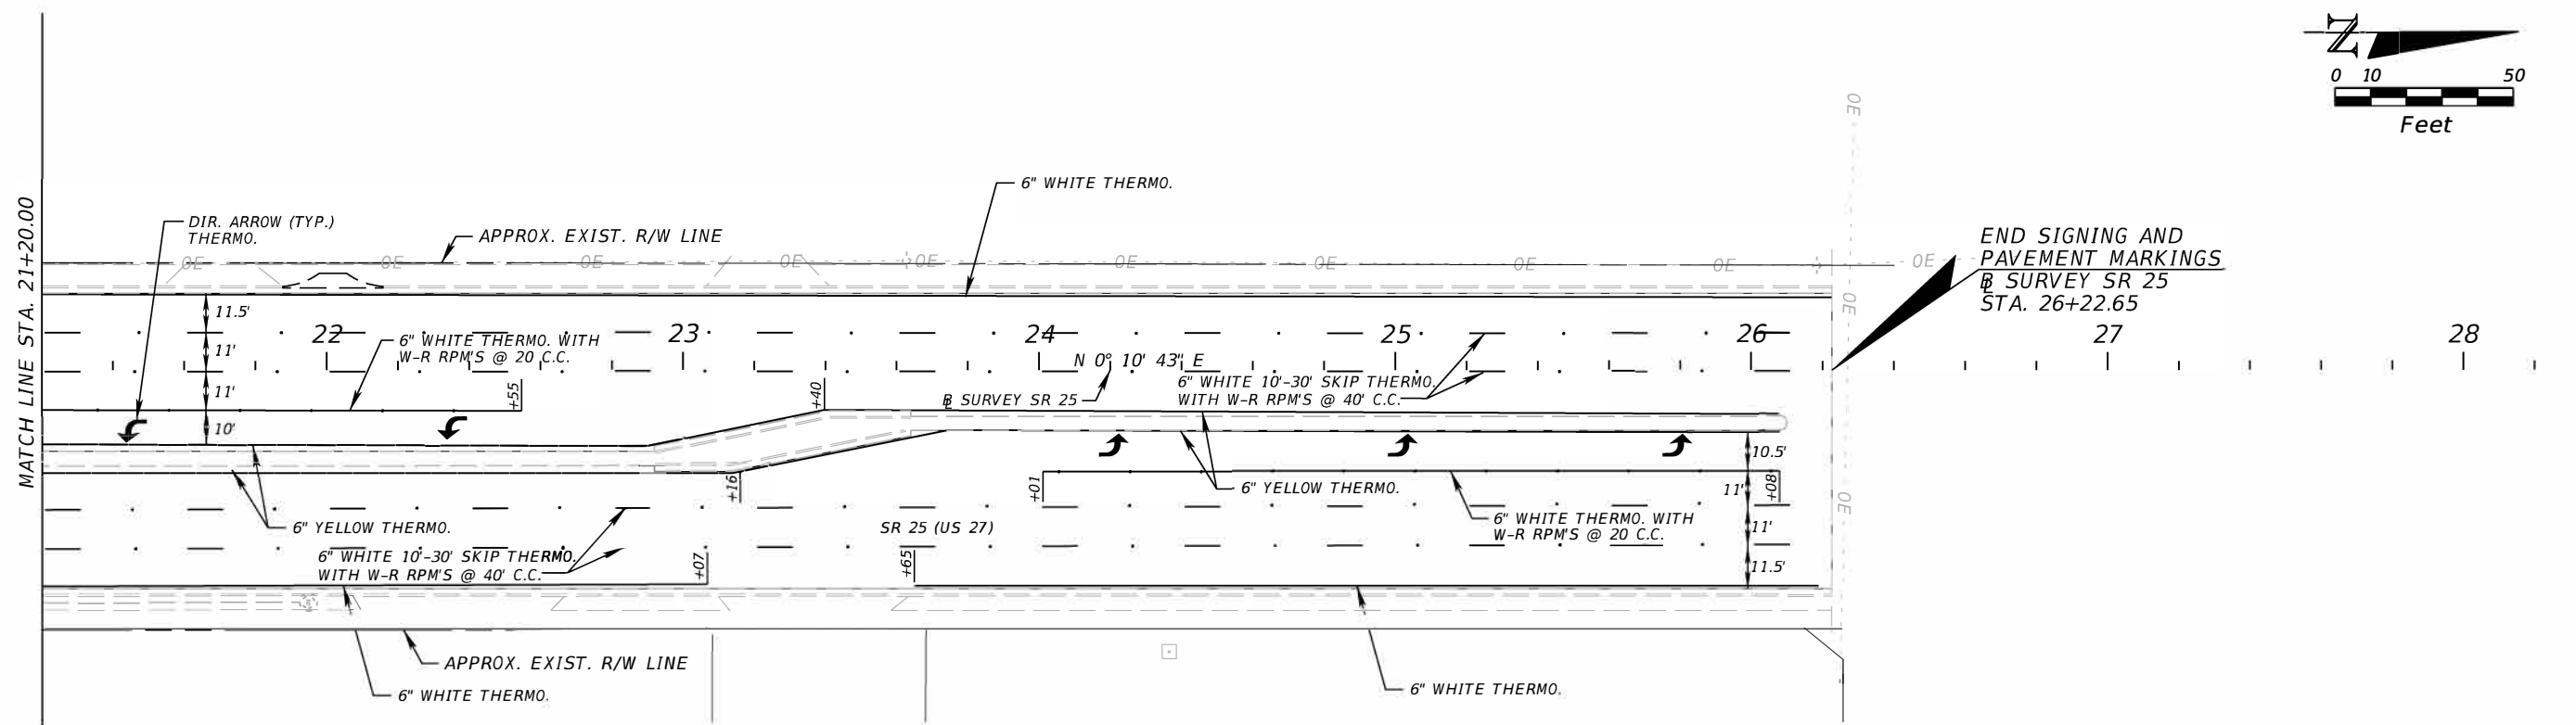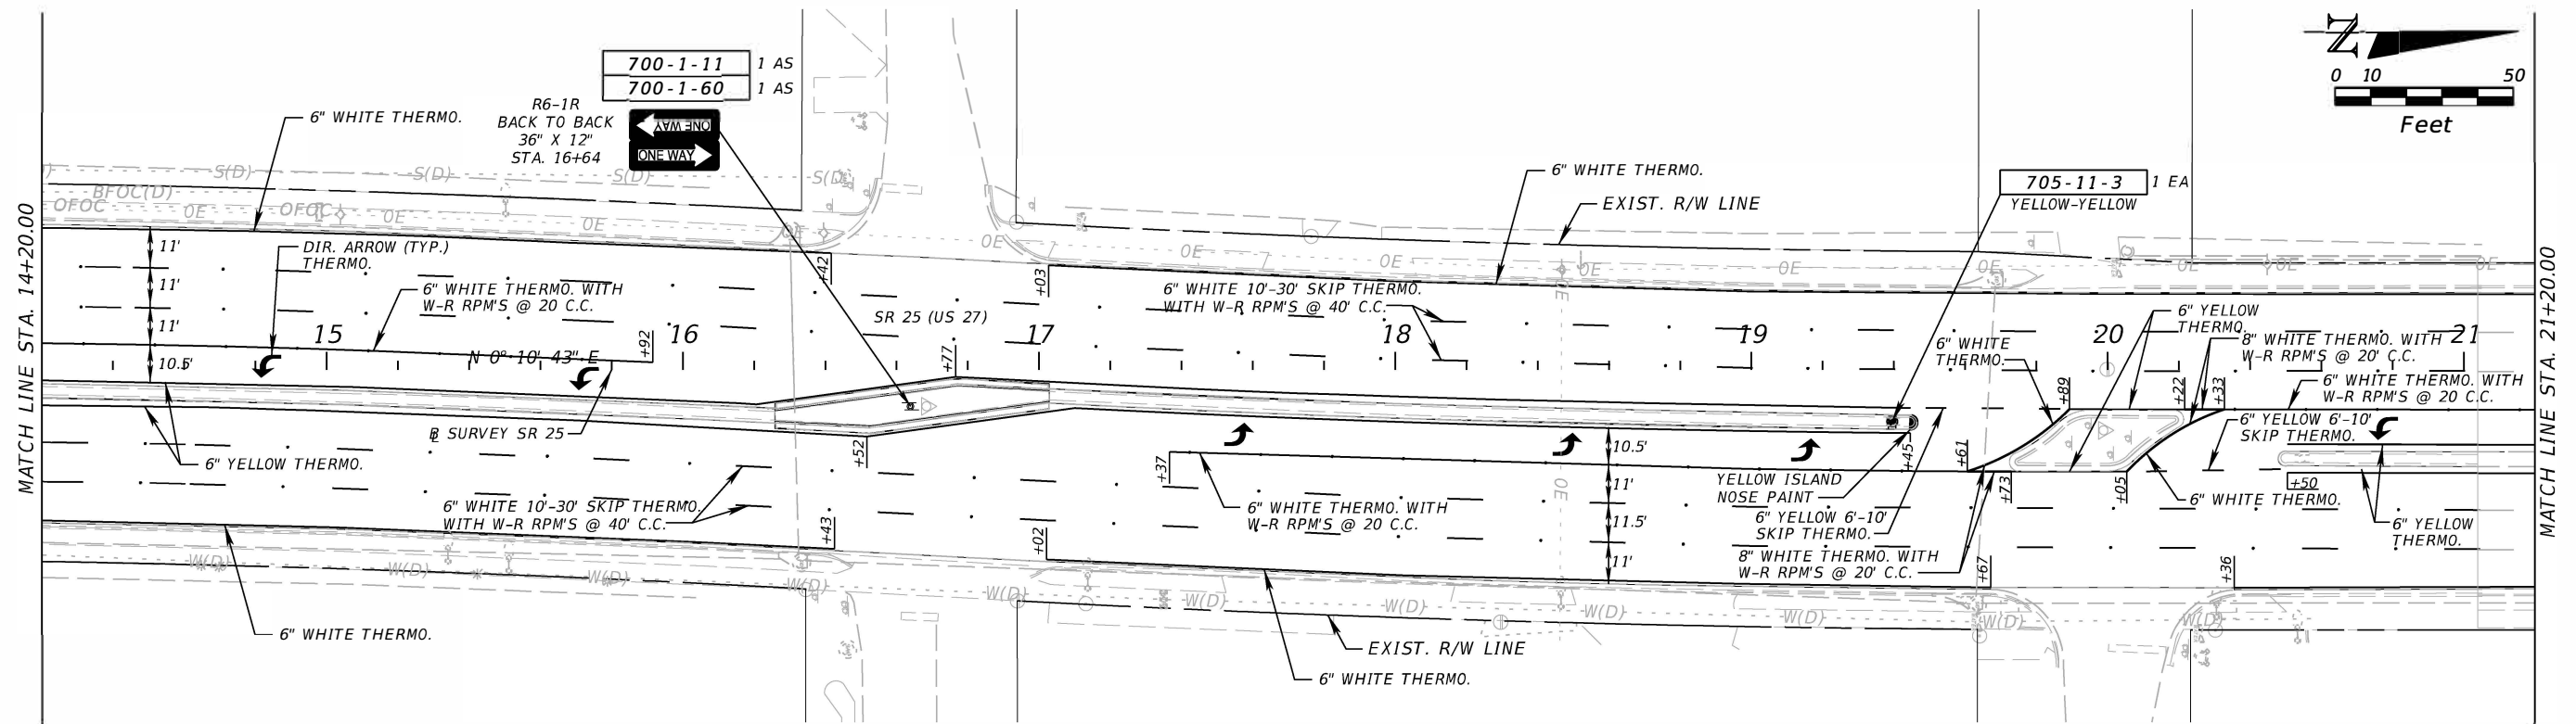

REVISIONS			
DATE	DESCRIPTION	DATE	DESCRIPTION


Comprehensive Engineering Services, Inc.
 201 S Orange Ave, Suite 1300
 Orlando, FL 32801-3442
 Certificate of Authorization No: 7862
 Ryan K. Baderschneider, P.E., License No. 60851

STATE OF FLORIDA DEPARTMENT OF TRANSPORTATION		
ROAD NO.	COUNTY	FINANCIAL PROJECT ID
SR 25	HIGHLANDS	434986-1-52-01

**SIGNING AND PAVEMENT
MARKING PLAN**

SHEET NO.
S-12

THE OFFICIAL RECORD OF THIS SHEET IS THE ELECTRONIC FILE DIGITALLY SIGNED AND SEALED UNDER RULE 61G15-23.004, F.A.C.

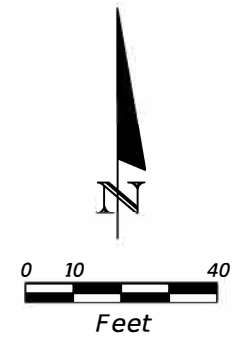

MATCH LINE STA. 961+40.00

MATCH LINE STA. 967+00.00



SIGN WAS RELOCATED PAID FOR UNDER ITEM 0700-1-50.

TO REMAIN
NO PARKING ON RIGHT OF WAY

STOP

NO PARKING ON RIGHT OF WAY
700-1-50 1 AS

NO PARKING ON RIGHT OF WAY
700-1-50 1 AS
STA. 966+63

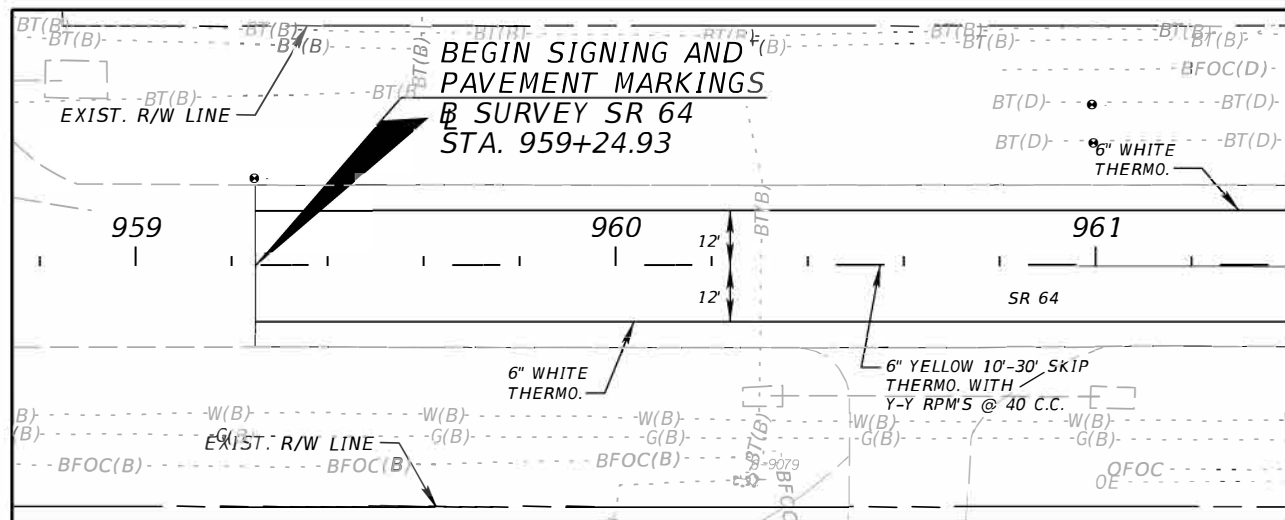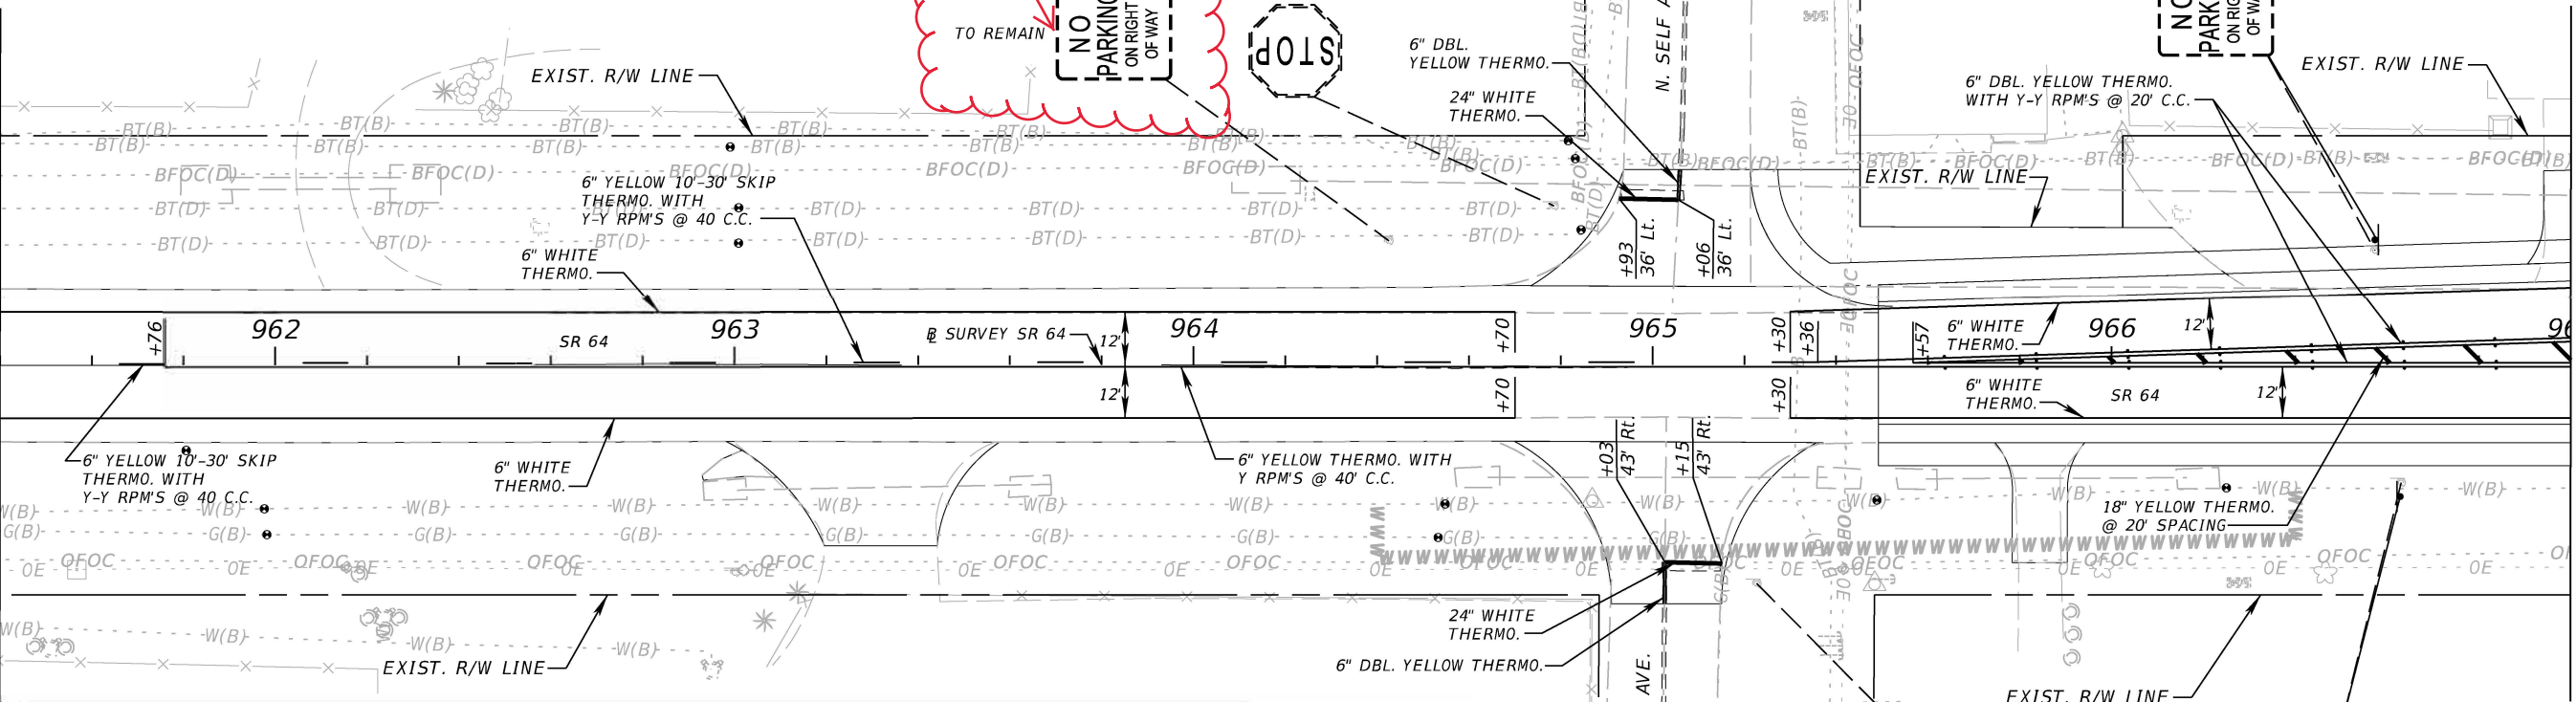

REVISIONS			
DATE	DESCRIPTION	DATE	DESCRIPTION

Comprehensive Engineering Services, Inc.
201 S Orange Ave, Suite 1300
Orlando, FL 32801-3442
Certificate of Authorization No. 7862
Ryan K. Baderschneider, P.E., License No. 60851

STATE OF FLORIDA DEPARTMENT OF TRANSPORTATION		
ROAD NO.	COUNTY	FINANCIAL PROJECT ID
SR 25	HIGHLANDS	434986-1-52-01


SIGNING AND PAVEMENT
MARKING PLAN

SHEET
NO.
S-13

THE OFFICIAL RECORD OF THIS SHEET IS THE ELECTRONIC FILE DIGITALLY SIGNED AND SEALED UNDER RULE 61G15-23.004, F.A.C.

MATCH LINE STA. 967+00.00

MATCH LINE STA. 972+60.00

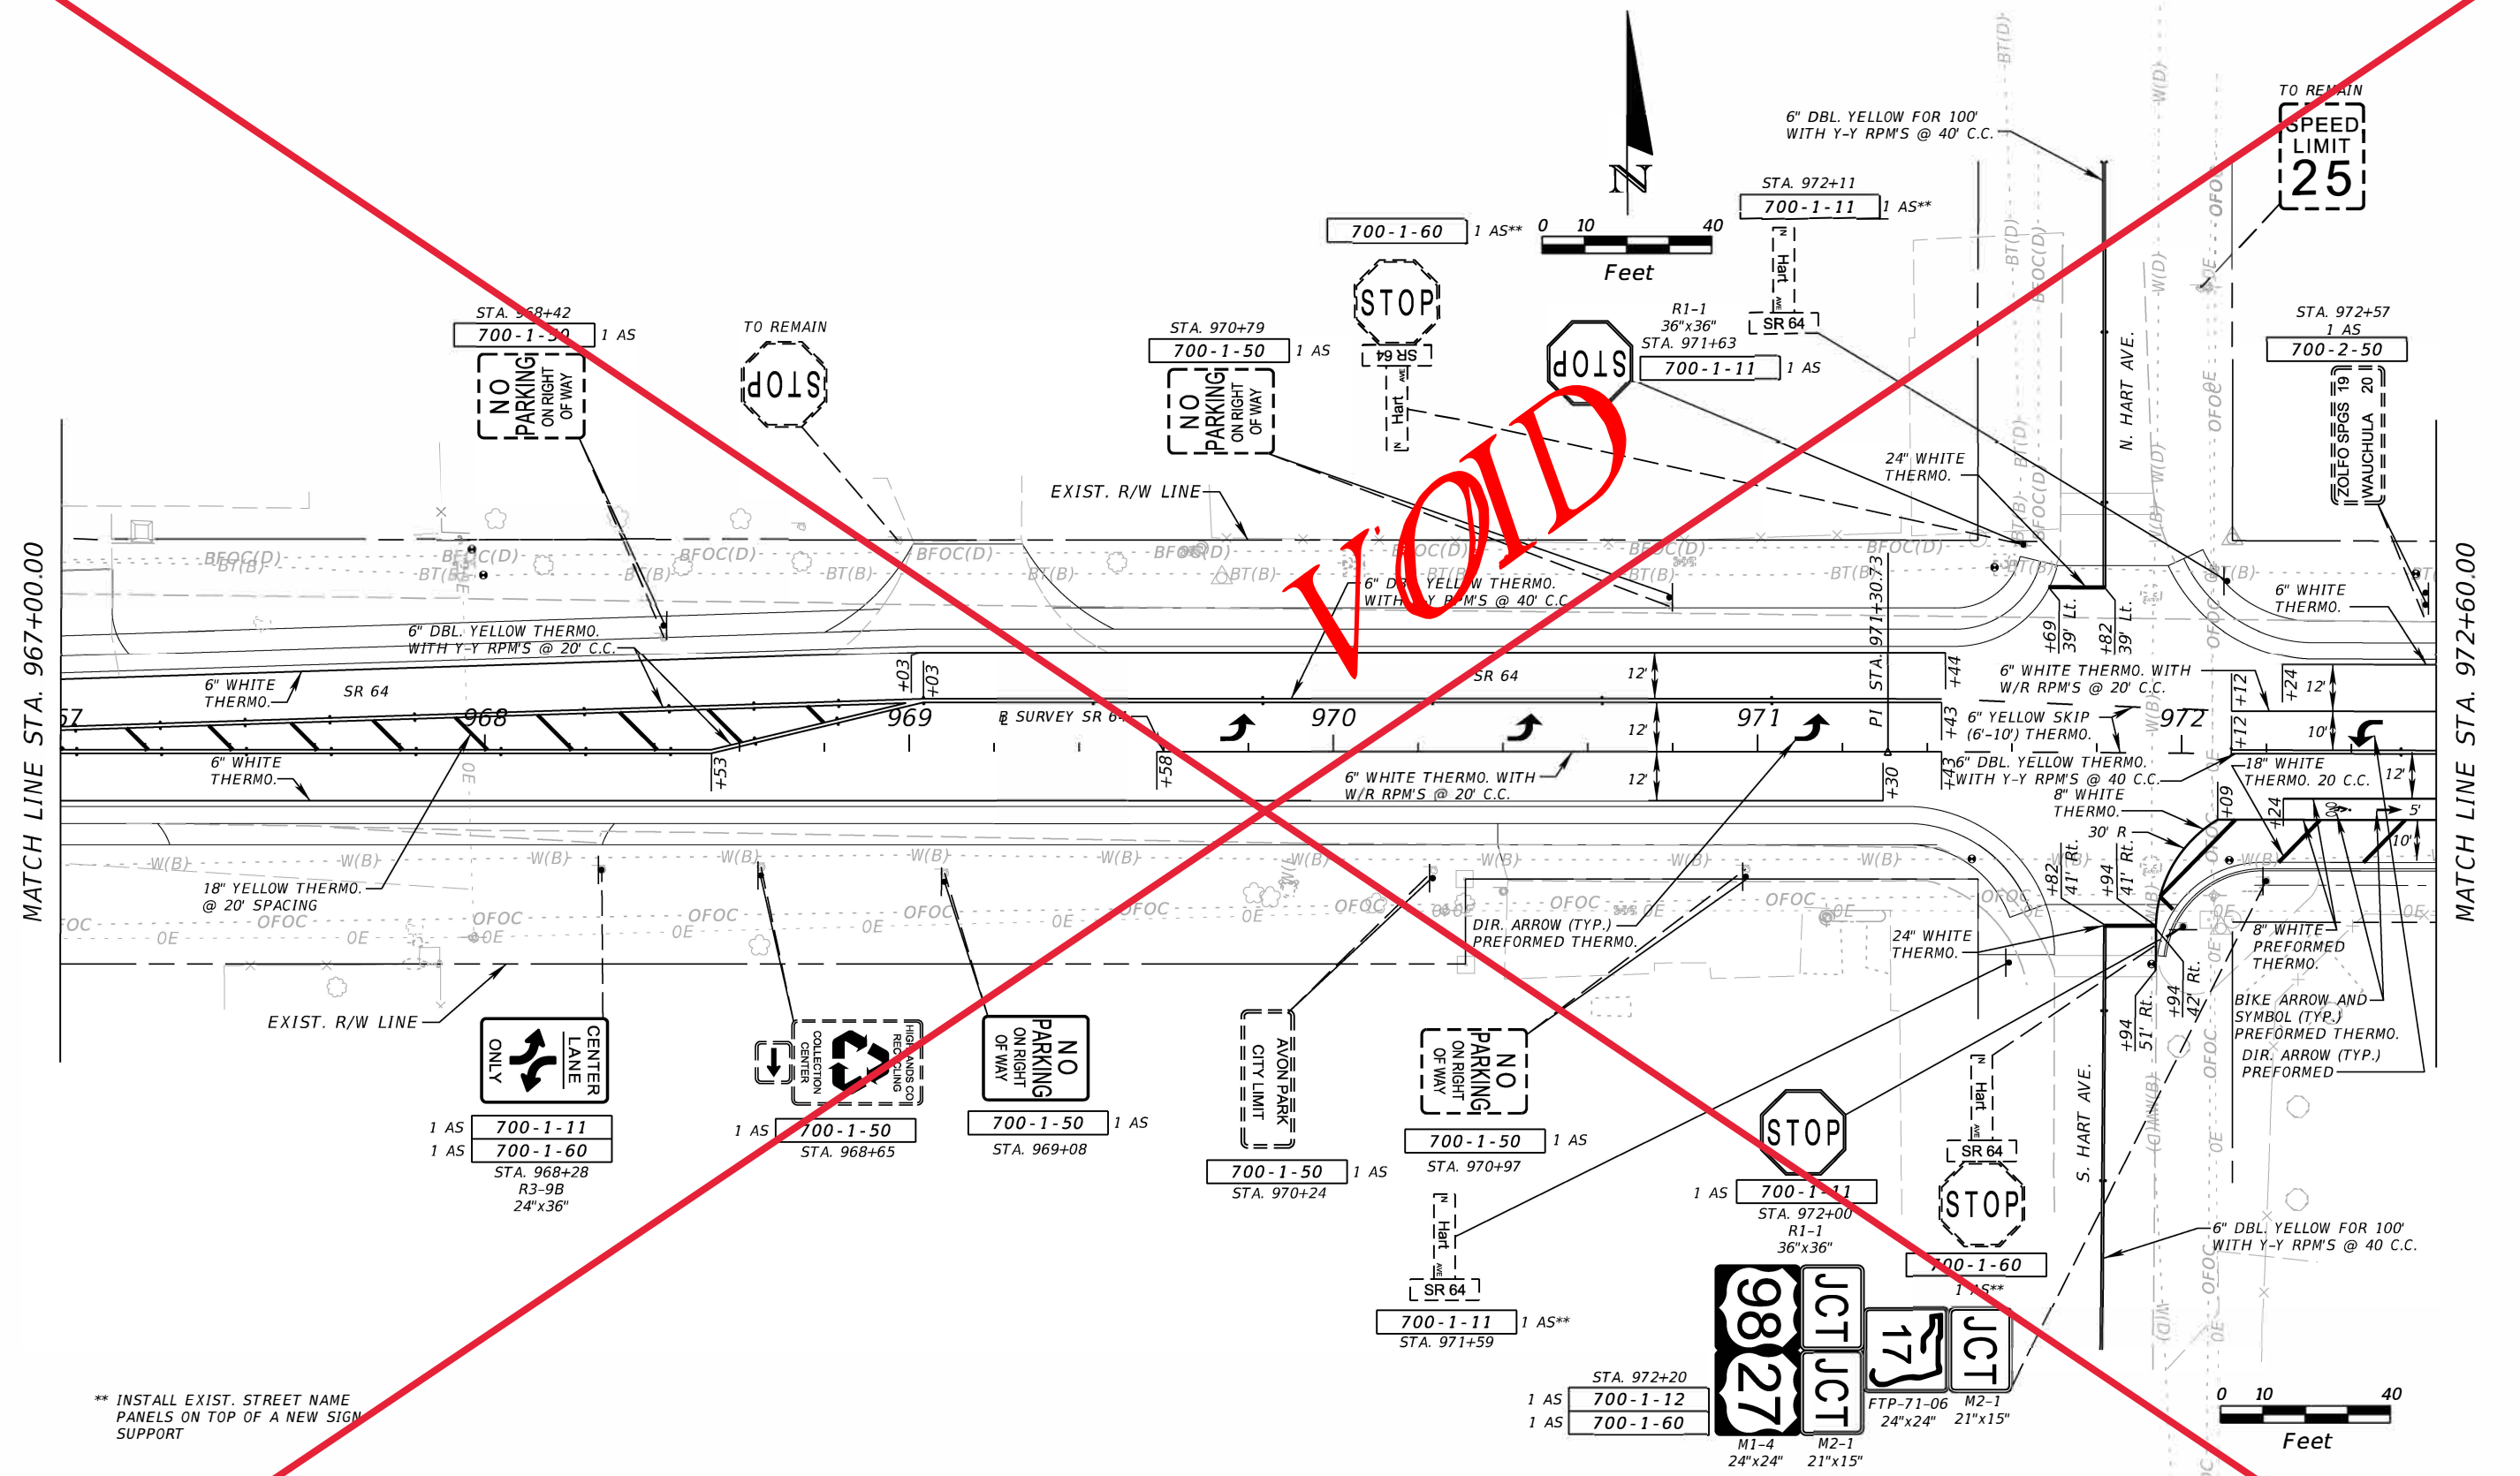

VOID

** INSTALL EXIST. STREET NAME PANELS ON TOP OF A NEW SIGN SUPPORT

REVISIONS			
DATE	DESCRIPTION	DATE	DESCRIPTION

Comprehensive Engineering Services, Inc.
 201 S Orange Ave, Suite 1300
 Orlando, FL 32801-3442
 Certificate of Authorization No. 7862
 Ryan K. Baderschneider, P.E., License No. 60851

STATE OF FLORIDA DEPARTMENT OF TRANSPORTATION		
ROAD NO.	COUNTY	FINANCIAL PROJECT ID
SR 25	HIGHLANDS	434986-1-52-01


SIGNING AND PAVEMENT
MARKING PLAN

SHEET NO.
S-14

THE OFFICIAL RECORD OF THIS SHEET IS THE ELECTRONIC FILE DIGITALLY SIGNED AND SEALED UNDER RULE 61G15-23.004, F.A.C.

MATCH LINE STA. 967+00.00

MATCH LINE STA. 972+60.00

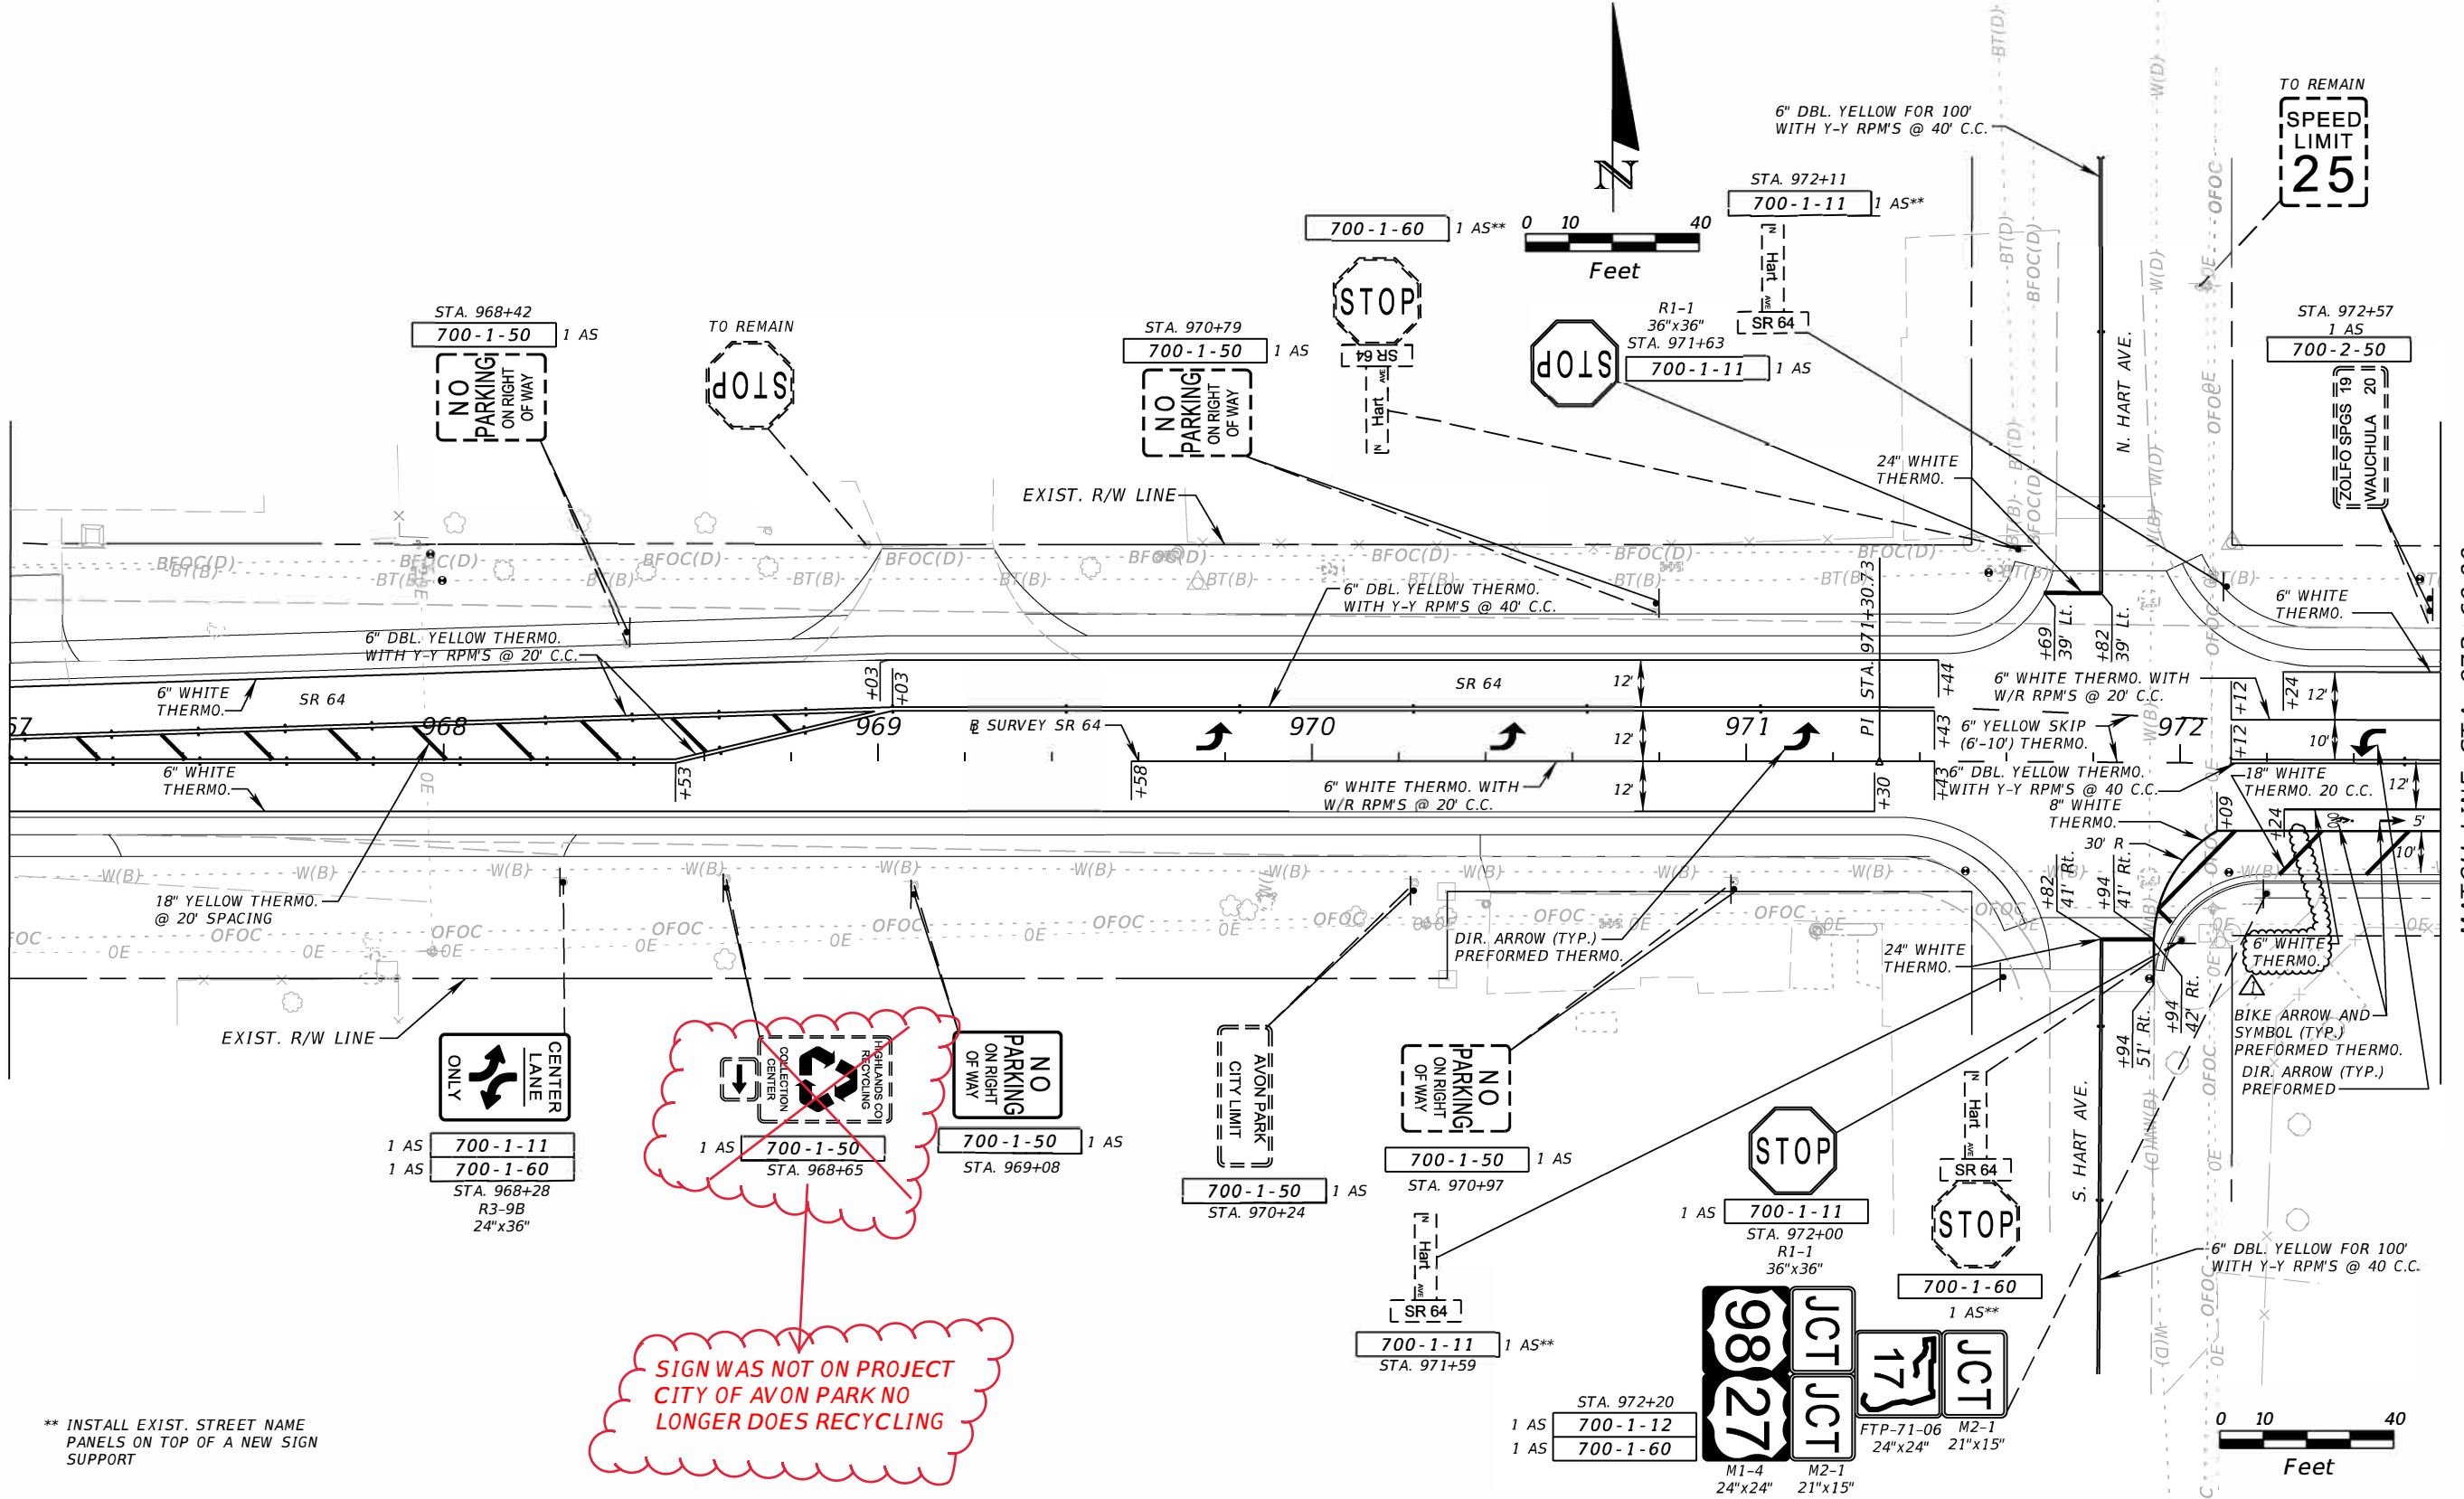

*SIGN WAS NOT ON PROJECT
CITY OF AVON PARK NO
LONGER DOES RECYCLING*

** INSTALL EXIST. STREET NAME
PANELS ON TOP OF A NEW SIGN
SUPPORT

REVISIONS			
DATE	DESCRIPTION	DATE	DESCRIPTION
05/18/18	RKB CORRECTED CALLOUT		

Comprehensive Engineering Services, Inc.
201 S Orange Ave, Suite 1300
Orlando, FL 32801-3442
Certificate of Authorization No. 7862
Ryan K. Baderschneider, P.E., License No. 60851


STATE OF FLORIDA DEPARTMENT OF TRANSPORTATION		
ROAD NO.	COUNTY	FINANCIAL PROJECT ID
SR 25	HIGHLANDS	434986-1-52-01

**SIGNING AND PAVEMENT
MARKING PLAN**

SHEET
NO.
S-14


THE OFFICIAL RECORD OF THIS SHEET IS THE ELECTRONIC FILE DIGITALLY SIGNED AND SEALED UNDER RULE 61G15-23.004, F.A.C.

VOID

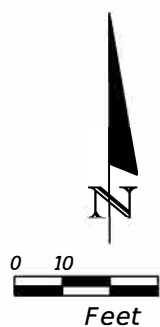

MATCH LINE STA. 972+60.00

MATCH LINE STA. 977+50.00
SEE SHEET S-9

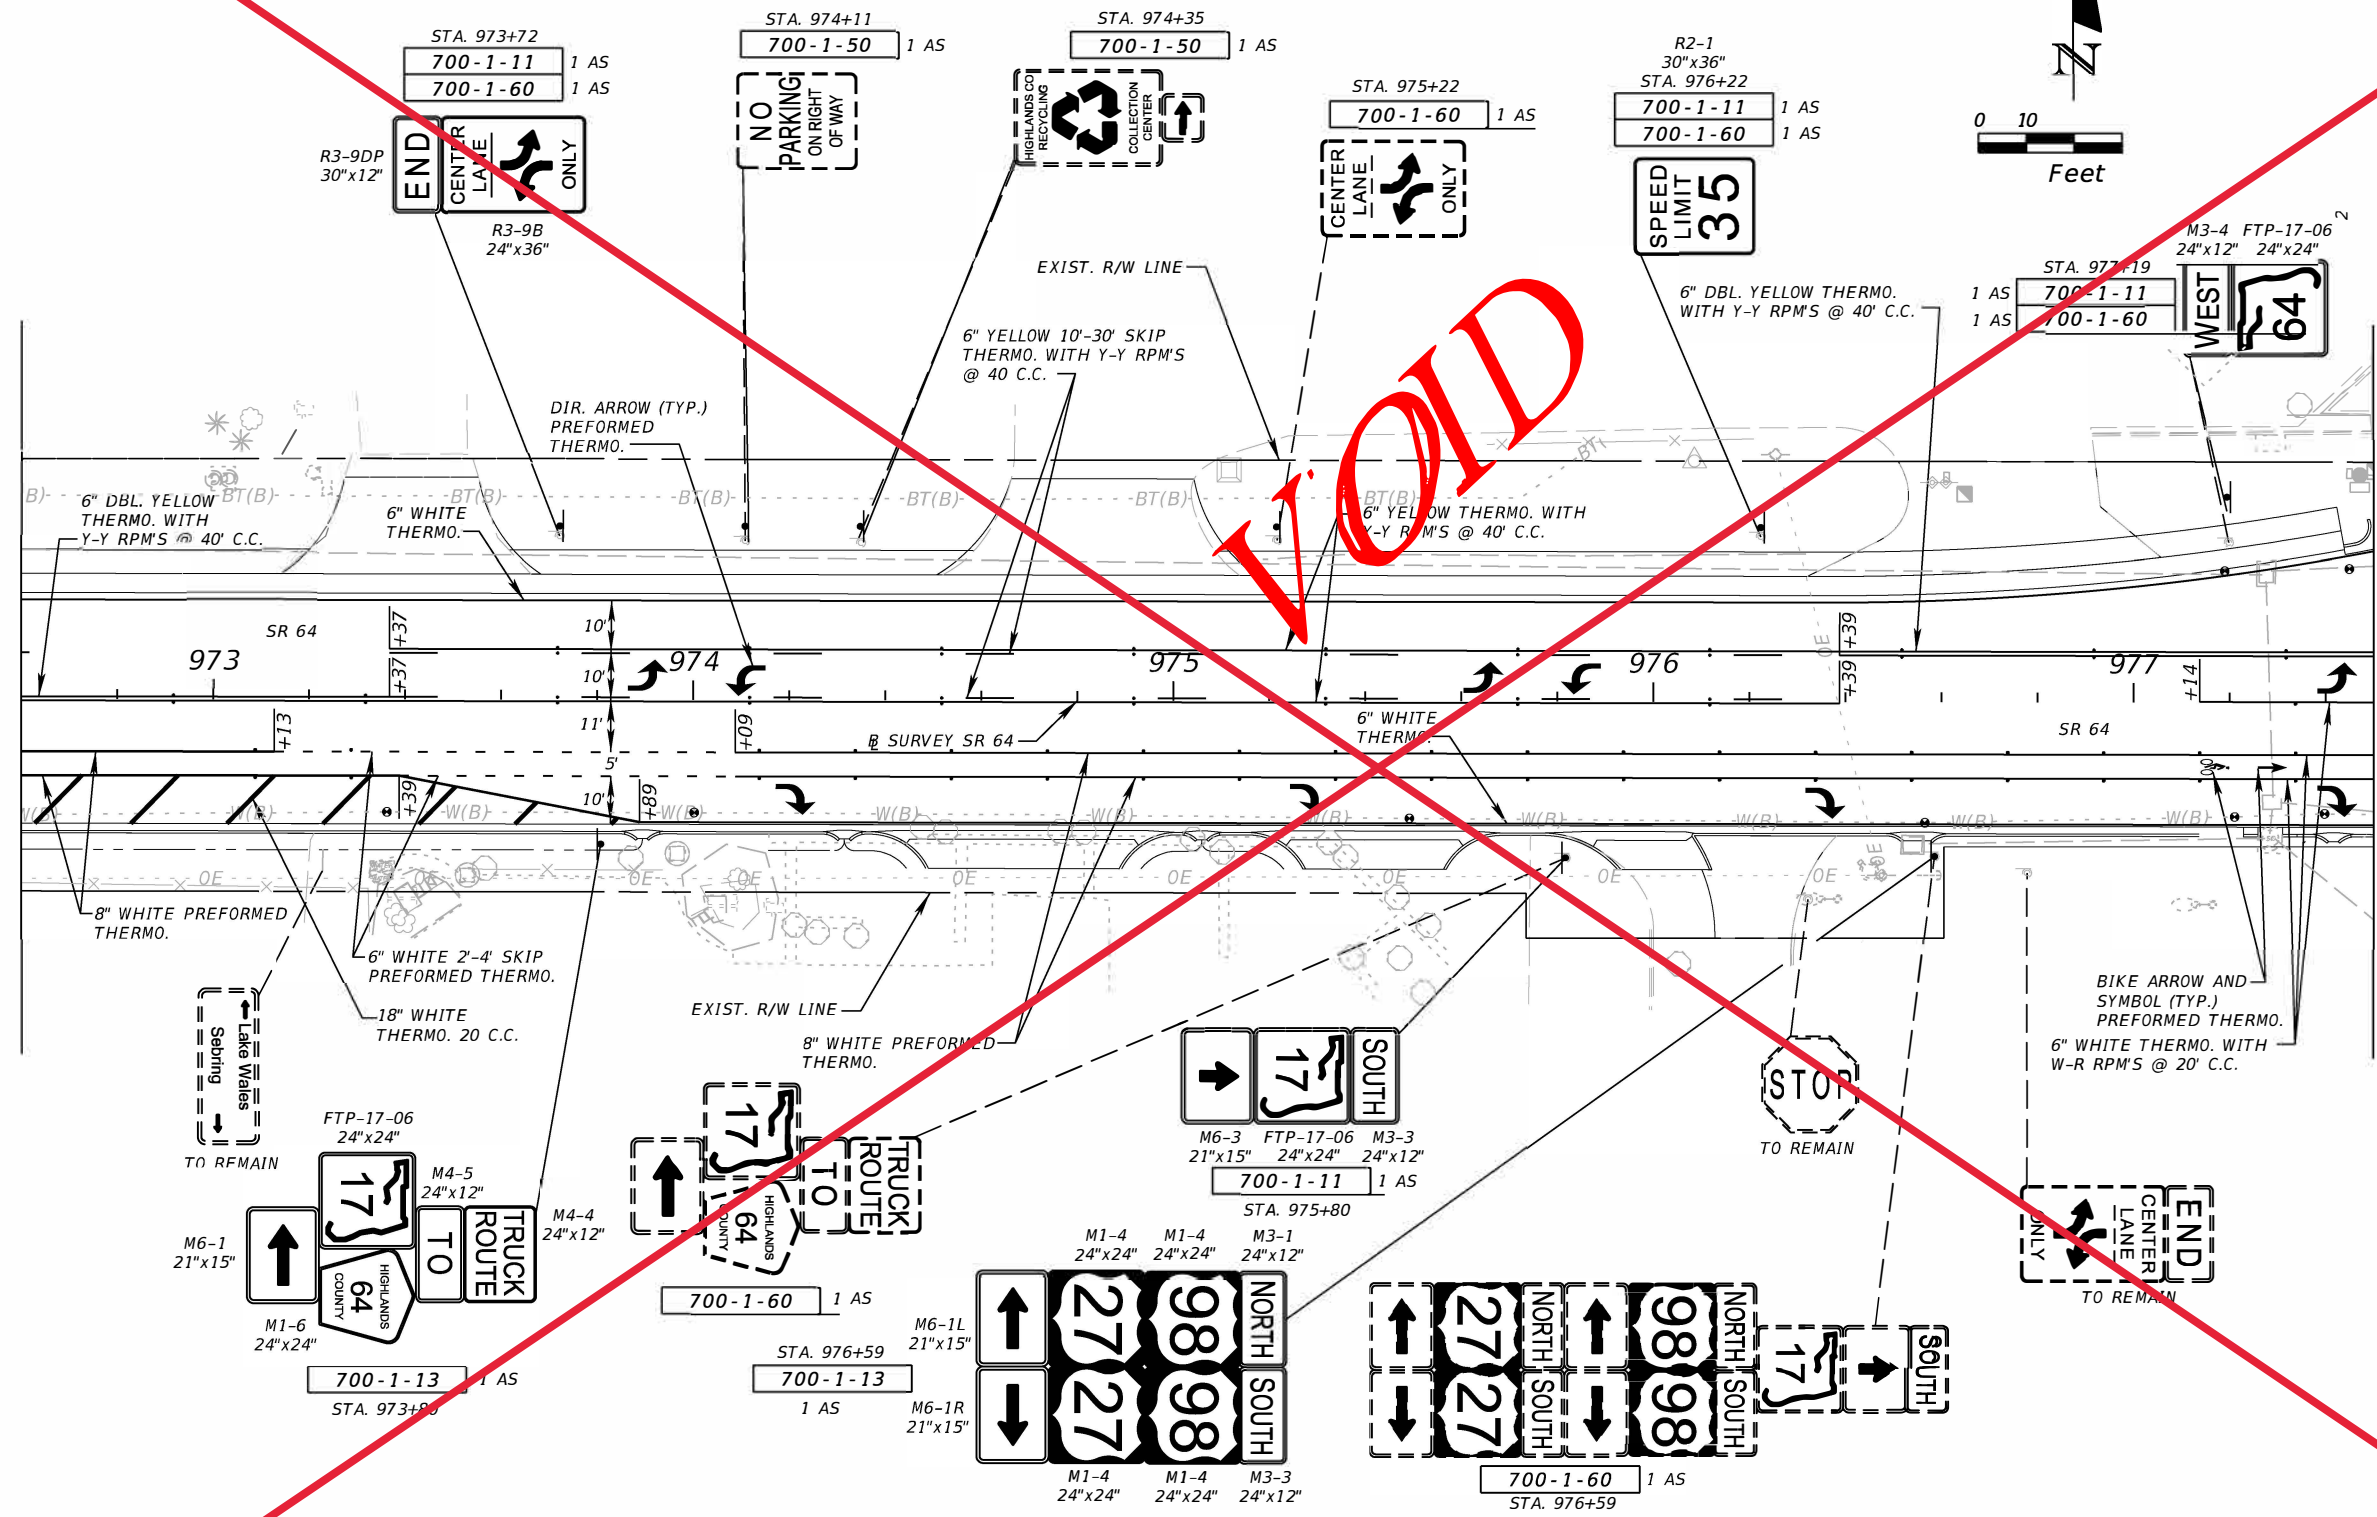

REVISIONS			
DATE	DESCRIPTION	DATE	DESCRIPTION

Comprehensive Engineering Services, Inc.
201 S Orange Ave, Suite 1300
Orlando, FL 32801-3442
Certificate of Authorization No. 7862
Ryan K. Baderschneider, P.E., License No. 60851


STATE OF FLORIDA DEPARTMENT OF TRANSPORTATION		
ROAD NO.	COUNTY	FINANCIAL PROJECT ID
SR 25	HIGHLANDS	434986-1-52-01

SIGNING AND PAVEMENT
MARKING PLAN

SHEET
NO.
S-15

THE OFFICIAL RECORD OF THIS SHEET IS THE ELECTRONIC FILE DIGITALLY SIGNED AND SEALED UNDER RULE 61G15-23.004, F.A.C.


MATCH LINE STA. 972+60.00

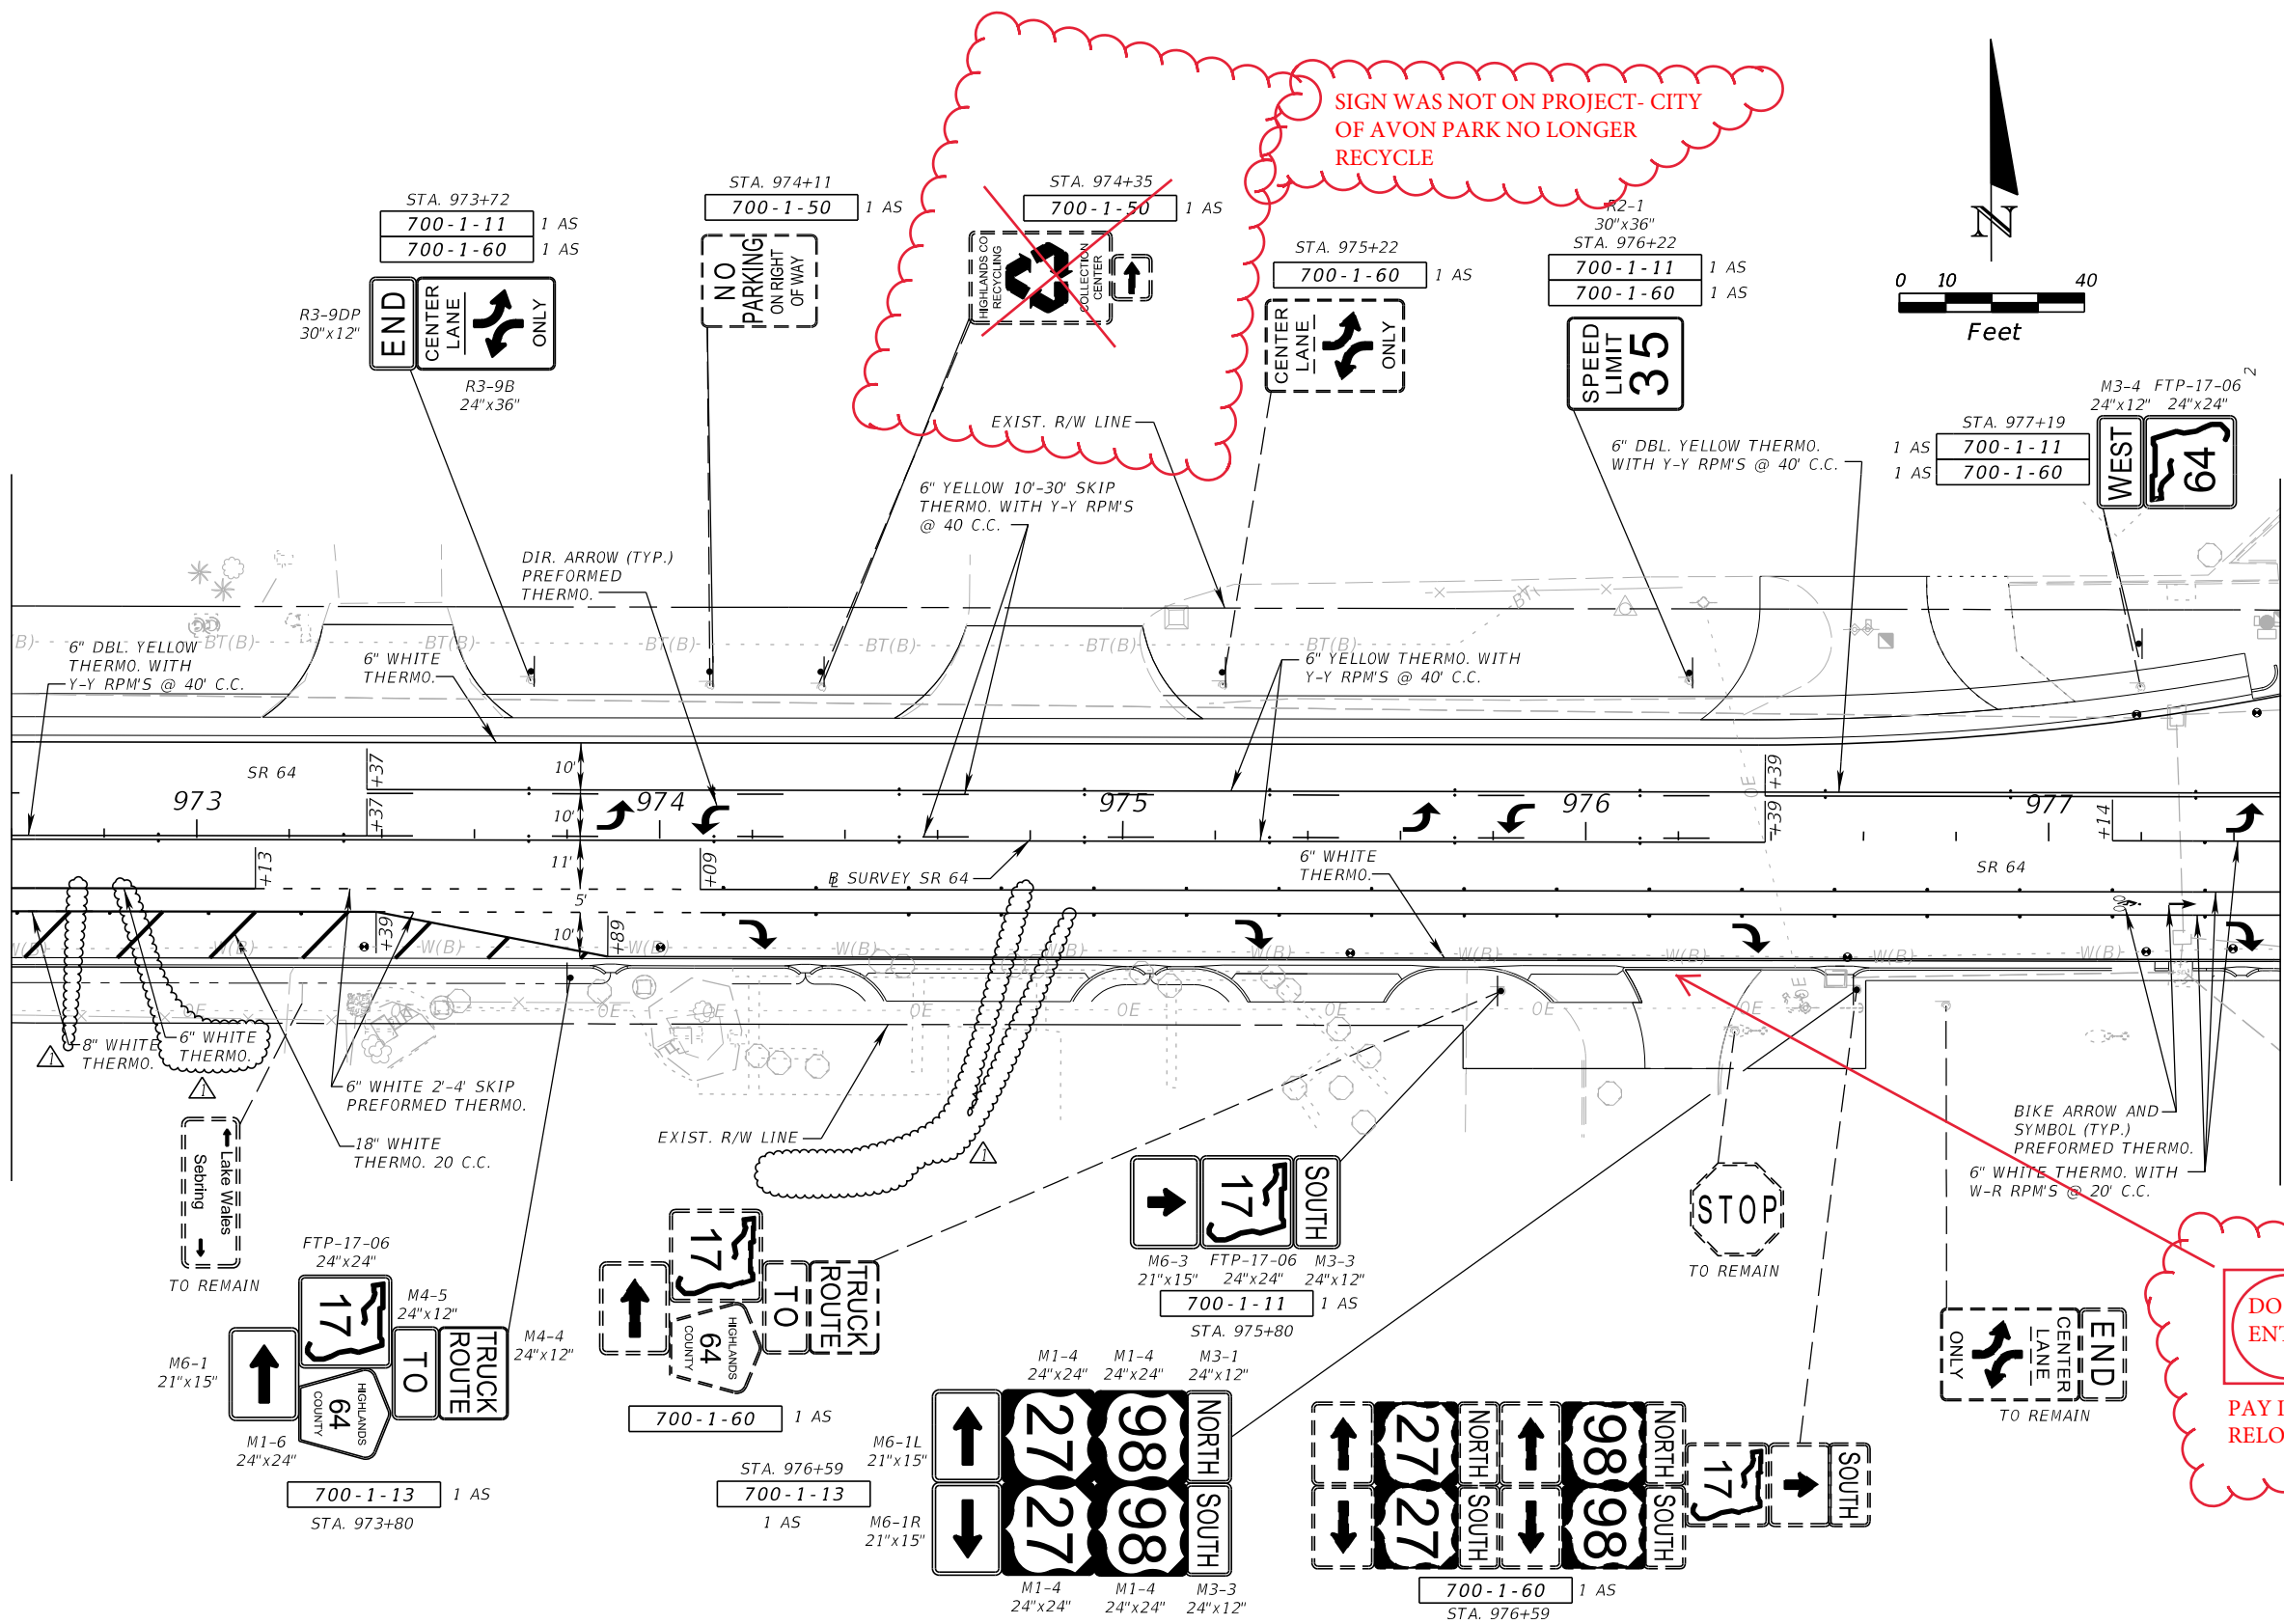

MATCH LINE STA. 977+50.00
SEE SHEET S-9

SIGN WAS NOT ON PROJECT- CITY OF AVON PARK NO LONGER RECYCLE

DO NOT ENTER
PAY ITEM 700-1-50
RELOCATE

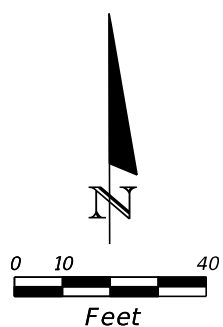

REVISIONS			
DATE	DESCRIPTION	DATE	DESCRIPTION
05/18/18	RKB CORRECTED CALLOUT		

Comprehensive Engineering Services, Inc.
201 S Orange Ave, Suite 1300
Orlando, FL 32801-3442
Certificate of Authorization No. 7862
Ryan K. Baderschneider, P.E., License No. 60851

STATE OF FLORIDA DEPARTMENT OF TRANSPORTATION		
ROAD NO.	COUNTY	FINANCIAL PROJECT ID
SR 25	HIGHLANDS	434986-1-52-01

**SIGNING AND PAVEMENT
MARKING PLAN**

SHEET NO.
S-15

THE OFFICIAL RECORD OF THIS SHEET IS THE ELECTRONIC FILE DIGITALLY SIGNED AND SEALED UNDER RULE 61G15-23.004, F.A.C.