


STATE OF FLORIDA
 DEPARTMENT OF TRANSPORTATION
CONTRACTOR AS-BUILT PLANS
CONTRACT PLANS

FINANCIAL PROJECT ID 444008-3-52-01

COLLIER COUNTY (03175)
 STATE ROAD NO. 93 (INTERSTATE 75)

SIGNING AND PAVEMENT MARKING PLANS


LOCATION OF PROJECT
<https://goo.gl/maps/FtAWmbZZeyNNFGbG6>

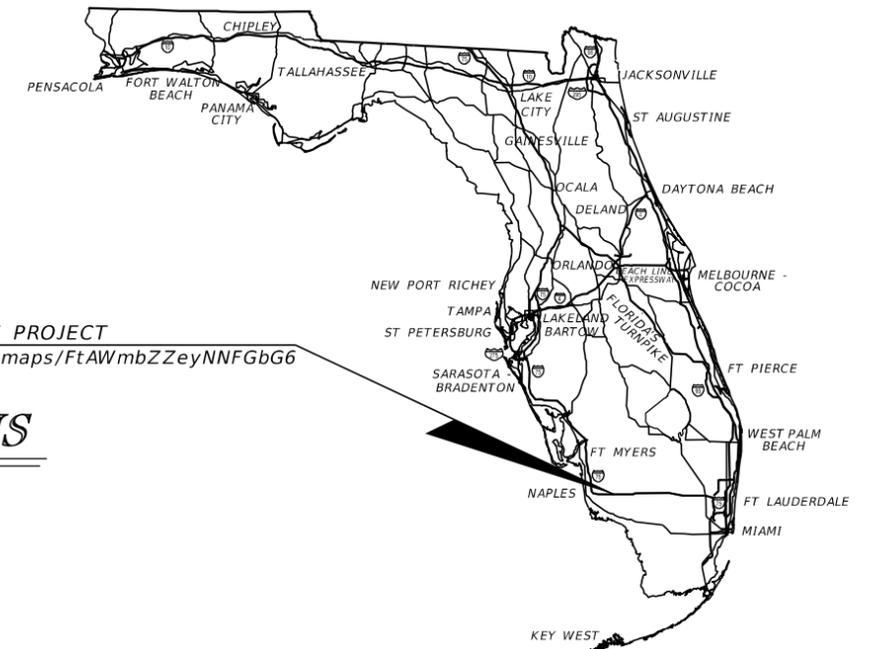

INDEX OF SIGNING AND PAVEMENT MARKING PLANS

SHEET NO.	SHEET DESCRIPTION
S-1	KEY SHEET
S-2,	SIGNATURE SHEET
S-3 - S-8A	TABULATION OF QUANTITIES
S-9	GENERAL NOTES
S-10 - S-53	SIGNING AND PAVEMENT MARKING PLAN
S-54 -	GUIDE SIGN WORKSHEET
S-59 - S-75	SIGN CROSS SECTION SHEET

KEY SHEET REVISIONS	
DATE	DESCRIPTION
10/28/22	ADDED SHEET S-2A, S-58A, S-58B.

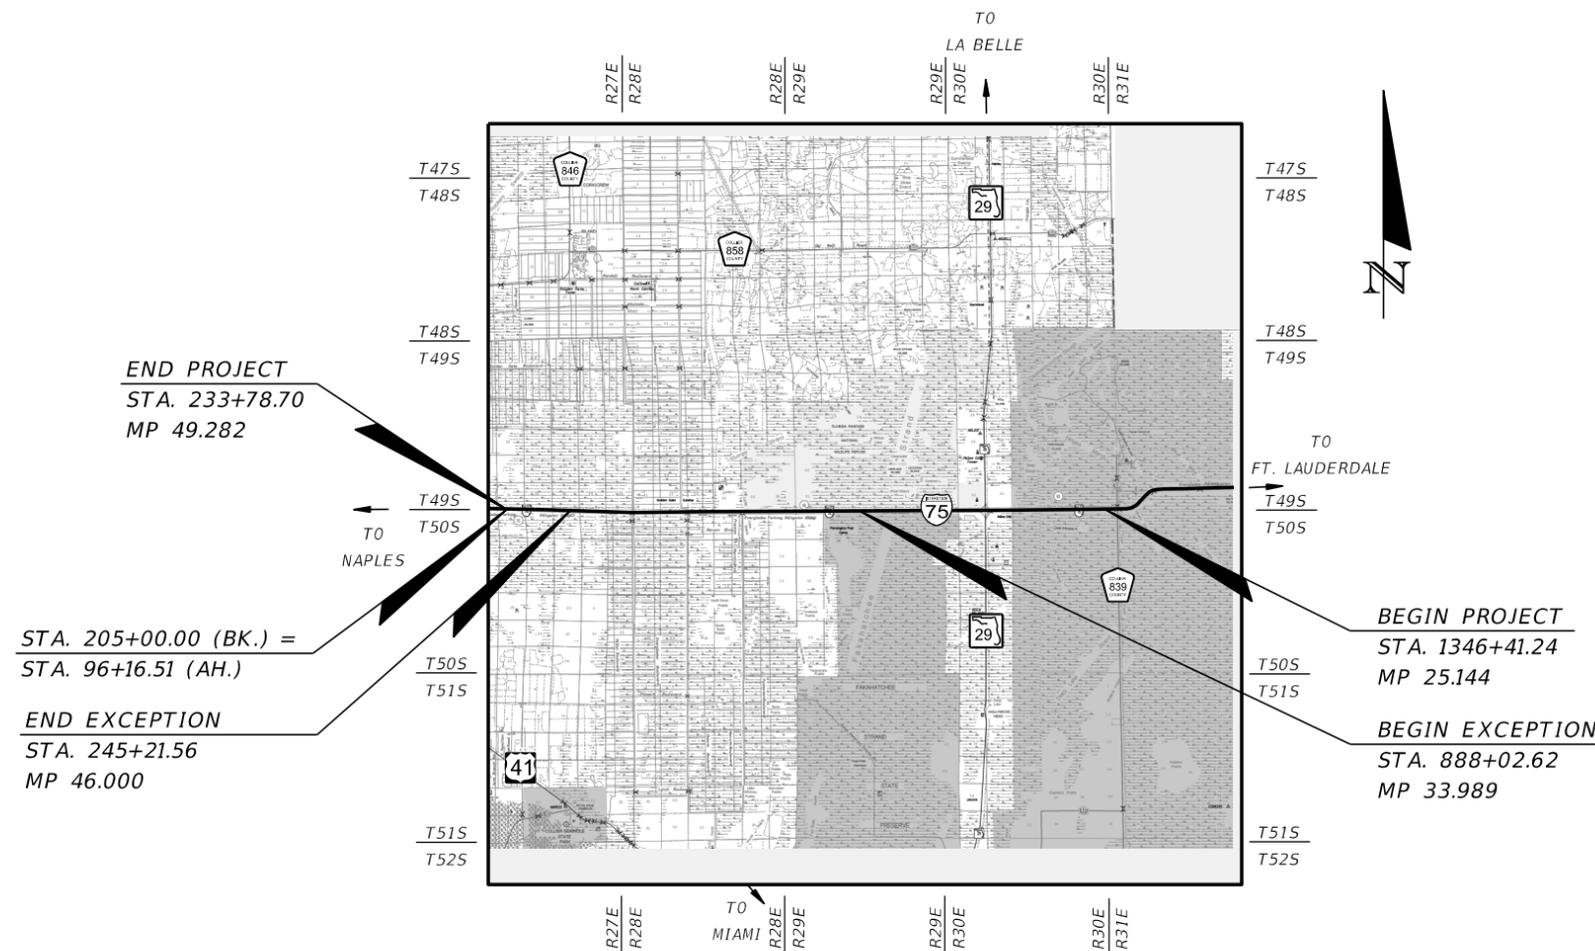


SIGNING AND PAVEMENT MARKING PLANS
 ENGINEER OF RECORD:

PATRICIA T. CHRISTIE, P.E. NO.: 60049
 FALLER, DAVIS & ASSOCIATES, INC.
 4200 W. CYPRESS ST., SUITE 500
 TAMPA, FLORIDA 33607-4168
 (813) 261-5136
 CONTRACT NO. CA632
 VENDOR NO. F592594956001


FDOT PROJECT MANAGER:
 SEAN PUGH, P.E.

CONSTRUCTION CONTRACT NO.	FISCAL YEAR	SHEET NO.
E1V05	23	S-1

THE OFFICIAL RECORD OF THIS SHEET IS THE ELECTRONIC FILE DIGITALLY SIGNED AND SEALED UNDER RULE 61G15-23.004, F.A.C.

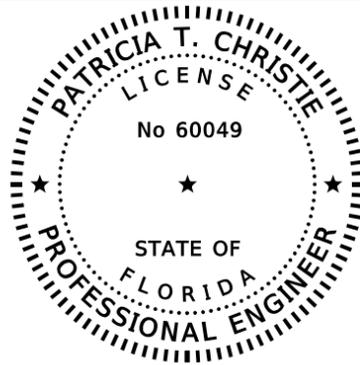

THIS ITEM HAS BEEN DIGITALLY
SIGNED AND SEALED BY

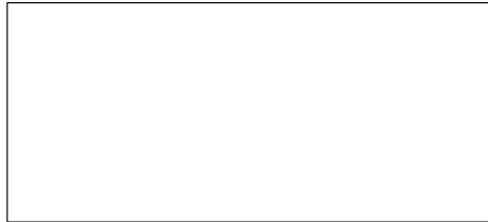

ON THE DATE ADJACENT TO THE SEAL

PRINTED COPIES OF THIS DOCUMENT ARE
NOT CONSIDERED SIGNED AND SEALED
AND THE SIGNATURE MUST BE VERIFIED
ON ANY ELECTRONIC COPIES.

FALLER, DAVIS & ASSOCIATES, INC
4200 W. CYPRESS ST., SUITE 500
TAMPA, FLORIDA 33607-4168
PATRICIA T. CHRISTIE, P.E. NO.: 60049



THIS ITEM HAS BEEN DIGITALLY
SIGNED AND SEALED BY

ON THE DATE ADJACENT TO THE SEAL

PRINTED COPIES OF THIS DOCUMENT ARE
NOT CONSIDERED SIGNED AND SEALED
AND THE SIGNATURE MUST BE VERIFIED
ON ANY ELECTRONIC COPIES.

OHLA USA, INC.
9875 NW 117 AVE, SUITE 108
MIAMI, FL 33178
KRISTIAN M. NAVARRO, P.E. NO. 80471

As-Builts

THE ABOVE NAMED PROFESSIONAL ENGINEER SHALL BE RESPONSIBLE FOR THE
FOLLOWING SHEETS IN ACCORDANCE WITH RULE 61G15-23.004, F.A.C.

<u>SHEET NO.</u>	<u>SHEET DESCRIPTION</u>
S-1	KEY SHEET
S-2A	SIGNATURE SHEET
S-3, S-4, S-5, S-6, S-7, S-8	TABULATION OF QUANTITIES
S-9	GENERAL NOTES
S-11, S-34, S-35, S-37, S-38, S-41, S-43, S-44	SIGNING AND PAVEMENT MARKING PLAN
S-58A, S-58B	GUIDE SIGN WORKSHEET

REVISIONS				PATRICIA T. CHRISTIE, P.E. P.E. NO.: 60049 FALLER, DAVIS & ASSOCIATES, INC. 4200 W. CYPRESS ST., SUITE 500 TAMPA, FLORIDA 33607-4168	STATE OF FLORIDA DEPARTMENT OF TRANSPORTATION			SIGNATURE SHEET	SHEET NO. S-2A
DATE	DESCRIPTION	DATE	DESCRIPTION		ROAD NO.	COUNTY	FINANCIAL PROJECT ID		
10/28/22	△ ADDED SHEET.				SR 93	COLLIER	444008-3-52-01		

TABULATION OF QUANTITIES

PAY ITEM NO.	DESCRIPTION	UNIT	SHEET NUMBERS																TOTAL THIS SHEET	
			S-10		S-11		S-12		S-13		S-14		S-15		S-16		S-17		PLAN	FINAL
			PLAN	FINAL	PLAN	FINAL	PLAN	FINAL	PLAN	FINAL	PLAN	FINAL	PLAN	FINAL	PLAN	FINAL	PLAN	FINAL		
700-1-11	SINGLE POST SIGN (F&I) (UP TO 12 SF)	AS	1		2		10		16		12		2						43	
700-1-12	SINGLE POST SIGN (F&I) (12-20 SF)	AS	1		7		3												11	
700-1-13	SINGLE POST SIGN (F&I) (21-30 SF)	AS																		
700-1-14	SINGLE POST SIGN (F&I) (31+ SF)	AS																		
700-1-60	SINGLE POST SIGN (REMOVE)	AS	2		7		7		8		4								28	
700-2-12	MULTI-POST SIGN (F&I) (12-20 SF)	AS							2										2	
700-2-14	MULTI-POST SIGN (F&I) (31-50 SF)	AS					1												1	
700-2-15	MULTI-POST SIGN (F&I) (51-100 SF)	AS					2				1								3	
700-2-16	MULTI-POST SIGN (F&I) (101-200 SF)	AS					2												2	
700-2-17	MULTI-POST SIGN (F&I) (201-300 SF)	AS																		
700-2-60	MULTI-POST SIGN (REMOVE)	AS					6		2		1								9	
700-3-106	SIGN PANEL (F&I GROUND MOUNT) (101-200 SF)	EA																		
700-3-602	SIGN PANEL (REMOVE) (12-20 SF)	EA			2														2	
700-3-606	SIGN PANEL (REMOVE) (101-200 SF)	EA																		
700-13-15	RETROREFLECTIVE SIGN STRIP (F&I) (5')	EA																		
701-18-101	PROFILED THERMOPLASTIC (STD) (ASPHALT) (WHITE) (SOLID) (6")	GM	0.109		0.132		1.697		2.121		2.121		0.273						6.453	
701-18-201	PROFILED THERMOPLASTIC (STD) (ASPHALT) (YELLOW) (SOLID) (6")	GM	0.109		0.132		1.697		2.121		2.121		0.273						6.453	
704-1-1	TUBULAR MARKER (36") (WHITE POST)	EA	58																58	
705-10-3	OBJECT MARKER (TYPE 3)	EA																		
705-11-2	DELINEATOR (NON-FLEXIBLE)	EA	3		5														8	
706-1-3	RAISED PAVEMENT MARKER (TYPE B) (W/R)	EA	144		26		230		280		280		36						996	
	RAISED PAVEMENT MARKER (TYPE B) (Y/Y)	EA																		
	RAISED PAVEMENT MARKER (TYPE B) (Y/R)	EA	36																36	
710-90	PAINTED PAVEMENT MARKINGS - FINAL SURFACE	LS																		
*	PAINTED PAVEMENT MARKINGS (WHITE) (SOLID) (12")	GM	0.019		0.010														0.029	
*	PAINTED PAVEMENT MARKINGS (WHITE) (SOLID) (18")	LF	564																564	
*	PAINTED PAVEMENT MARKINGS (WHITE) (ARROW) (WRONG WAY)	EA																		
*	PAINTED PAVEMENT MARKINGS (WHITE) (SOLID) (6")	GM	0.254		0.265		1.737		2.121		2.121		0.273						6.771	
*	PAINTED PAVEMENT MARKINGS (WHITE) (SOLID) (8")	GM	0.229																0.229	
*	PAINTED PAVEMENT MARKINGS (WHITE) (SKIP) (6") (10'-30')	GM	0.174		0.201		1.737		2.121		2.121		0.273						6.627	
*	PAINTED PAVEMENT MARKINGS (WHITE) (SKIP) (6") (3'-9')	GM																		
*	PAINTED PAVEMENT MARKINGS (YELLOW) (SOLID) (6")	GM	0.037		0.265		1.737		2.121		2.121		0.273						6.554	
*	PAINTED PAVEMENT MARKINGS (YELLOW) (SOLID) (8")	GM	0.072																0.072	
*	PAINTED PAVEMENT MARKINGS (YELLOW) (SOLID) (18")	LF	432																432	
711-11-103	THERMOPLASTIC (STD) (WHITE) (SOLID) (12" FOR INTERCHANGE MARKINGS)	GM	0.019		0.010														0.029	
711-11-124	THERMOPLASTIC (STD) (WHITE) (SOLID) (18")	LF	564																564	
711-11-170	THERMOPLASTIC (STD) (WHITE) (ARROW) (WRONG WAY)	EA																		
711-11-224	THERMOPLASTIC (STD) (YELLOW) (SOLID) (18")	LF	432																432	

* THESE QUANTITIES ARE PAID FOR UNDER PAINTED PAVEMENT MARKINGS (FINAL SURFACE) LUMP SUM - ITEM NO. 710-90. THE QUANTITIES SHOWN ARE FOR ONE APPLICATION; SEE SPECIFICATION 710 FOR THE NUMBER OF APPLICATIONS REQUIRED.

<table border="1"> <thead> <tr> <th colspan="4">REVISIONS</th> </tr> <tr> <th>DATE</th> <th>DESCRIPTION</th> <th>DATE</th> <th>DESCRIPTION</th> </tr> </thead> <tbody> <tr> <td>10/28/22</td> <td>ADDED PAY ITEM. UPDATED QUANTITIES.</td> <td></td> <td></td> </tr> </tbody> </table>				REVISIONS				DATE	DESCRIPTION	DATE	DESCRIPTION	10/28/22	ADDED PAY ITEM. UPDATED QUANTITIES.			PATRICIA T. CHRISTIE, P.E. P.E. NO.: 60049 FALLER, DAVIS & ASSOCIATES, INC. 4200 W. CYPRESS ST., SUITE 500 TAMPA, FLORIDA 33607-4168			STATE OF FLORIDA DEPARTMENT OF TRANSPORTATION <table border="1"> <thead> <tr> <th>ROAD NO.</th> <th>COUNTY</th> <th>FINANCIAL PROJECT ID</th> </tr> </thead> <tbody> <tr> <td>SR 93</td> <td>COLLIER</td> <td>444008-3-52-01</td> </tr> </tbody> </table>			ROAD NO.	COUNTY	FINANCIAL PROJECT ID	SR 93	COLLIER	444008-3-52-01	SHEET NO. S-3	
REVISIONS																													
DATE	DESCRIPTION	DATE	DESCRIPTION																										
10/28/22	ADDED PAY ITEM. UPDATED QUANTITIES.																												
ROAD NO.	COUNTY	FINANCIAL PROJECT ID																											
SR 93	COLLIER	444008-3-52-01																											

TABULATION OF QUANTITIES

PAY ITEM NO.	DESCRIPTION	UNIT	SHEET NUMBERS																TOTAL THIS SHEET	
			S-10		S-11		S-12		S-13		S-14		S-15		S-16		S-17		PLAN	FINAL
			PLAN	FINAL	PLAN	FINAL	PLAN	FINAL	PLAN	FINAL	PLAN	FINAL	PLAN	FINAL	PLAN	FINAL				
711-14-160	THERMOPLASTIC (PREFORMED) (WHITE) (MSG) (EXIT NUMBER)	EA																		
711-15-101	THERMOPLASTIC (STD-OPEN) (WHITE) (SOLID) (6")	GM	0.254		0.133		0.040												0.427	
711-15-102	THERMOPLASTIC (STD-OPEN) (WHITE) (SOLID) (8")	GM	0.229																0.229	
711-15-131	THERMOPLASTIC (STD-OPEN) (WHITE) (SKIP) (6") (10'-30')	GM	0.174		0.201		1.737		2.121		2.121		0.273						6.627	
	THERMOPLASTIC (STD-OPEN) (WHITE) (SKIP) (6") (3'-9')	GM																		
711-15-201	THERMOPLASTIC (STD-OPEN) (YELLOW) (SOLID) (6")	GM	0.037		0.133		0.040												0.210	
711-15-202	THERMOPLASTIC (STD-OPEN) (YELLOW) (SOLID) (8")	GM	0.072																0.072	
711-17-1	THERMOPLASTIC (REMOVE EXISTING THERMOPLASTIC PAVEMENT MARKINGS- SURFACE TO REMAIN)	SF	1130																1130	
713-103-101	PERMANENT TAPE (WHITE) (SOLID) (6")	GM																		
713-103-131	PERMANENT TAPE (WHITE) (SKIP/DOTTED) (6" FOR CONCRETE SURFACES)	GM																		
713-103-201	PERMANENT TAPE (YELLOW) (SOLID) (6")	GM																		
713-103-331	PERMANENT TAPE (BLACK) (SKIP/DOTTED) (6" FOR CONCRETE SURFACES)	GM																		

(This area is intentionally left blank for project details or notes.)																			
---	--	--	--	--	--	--	--	--	--	--	--	--	--	--	--	--	--	--	--

REVISIONS <table border="1"> <thead> <tr> <th>DATE</th> <th>DESCRIPTION</th> <th>DATE</th> <th>DESCRIPTION</th> </tr> </thead> <tbody> <tr> <td> </td> <td> </td> <td> </td> <td> </td> </tr> </tbody> </table>				DATE	DESCRIPTION	DATE	DESCRIPTION					PATRICIA T. CHRISTIE, P.E. P.E. NO.: 60049 FALLER, DAVIS & ASSOCIATES, INC. 4200 W. CYPRESS ST., SUITE 500 TAMPA, FLORIDA 33607-4168				STATE OF FLORIDA DEPARTMENT OF TRANSPORTATION <table border="1"> <thead> <tr> <th>ROAD NO.</th> <th>COUNTY</th> <th>FINANCIAL PROJECT ID</th> </tr> </thead> <tbody> <tr> <td>SR 93</td> <td>COLLIER</td> <td>444008-3-52-01</td> </tr> </tbody> </table>				ROAD NO.	COUNTY	FINANCIAL PROJECT ID	SR 93	COLLIER	444008-3-52-01	TABULATION OF QUANTITIES (1A)				SHEET NO. S-3A	
DATE	DESCRIPTION	DATE	DESCRIPTION																												
ROAD NO.	COUNTY	FINANCIAL PROJECT ID																													
SR 93	COLLIER	444008-3-52-01																													

THE OFFICIAL RECORD OF THIS SHEET IS THE ELECTRONIC FILE DIGITALLY SIGNED AND SEALED UNDER RULE 61G15-23.004, F.A.C.

TABULATION OF QUANTITIES

PAY ITEM NO.	DESCRIPTION	UNIT	SHEET NUMBERS																TOTAL THIS SHEET	
			S-18		S-19		S-20		S-21		S-22		S-23		S-24		S-25		PLAN	FINAL
			PLAN	FINAL	PLAN	FINAL	PLAN	FINAL	PLAN	FINAL	PLAN	FINAL	PLAN	FINAL	PLAN	FINAL				
700-1-11	SINGLE POST SIGN (F&I) (UP TO 12 SF)	AS																		
700-1-12	SINGLE POST SIGN (F&I) (12-20 SF)	AS																		
700-1-13	SINGLE POST SIGN (F&I) (21-30 SF)	AS																		
700-1-14	SINGLE POST SIGN (F&I) (31+ SF)	AS																		
700-1-60	SINGLE POST SIGN (REMOVE)	AS																		
700-2-12	MULTI-POST SIGN (F&I) (12-20 SF)	AS																		
700-2-14	MULTI-POST SIGN (F&I) (31-50 SF)	AS																		
700-2-15	MULTI-POST SIGN (F&I) (51-100 SF)	AS																		
700-2-16	MULTI-POST SIGN (F&I) (101-200 SF)	AS																		
700-2-17	MULTI-POST SIGN (F&I) (201-300 SF)	AS																		
700-2-60	MULTI-POST SIGN (REMOVE)	AS																		
700-3-106	SIGN PANEL (F&I GROUND MOUNT) (101-200 SF)	EA																		
700-3-602	SIGN PANEL (REMOVE) (12-20 SF) 	EA																		
700-3-606	SIGN PANEL (REMOVE) (101-200 SF)	EA																		
700-13-15	RETROREFLECTIVE SIGN STRIP (F&I) (5')	EA																		
701-18-101	PROFILED THERMOPLASTIC (STD) (ASPHALT) (WHITE) (SOLID) (6")	GM																		
701-18-201	PROFILED THERMOPLASTIC (STD) (ASPHALT) (YELLOW) (SOLID) (6")	GM																		
704-1-1	TUBULAR MARKER (36") (WHITE POST)	EA																		
705-10-3	OBJECT MARKER (TYPE 3)	EA																		
705-11-2	DELINEATOR (NON-FLEXIBLE)	EA																		
706-1-3	RAISED PAVEMENT MARKER (TYPE B) (W/R)	EA																		
	RAISED PAVEMENT MARKER (TYPE B) (Y/Y)	EA																		
	RAISED PAVEMENT MARKER (TYPE B) (Y/R)	EA																		
710-90	PAINTED PAVEMENT MARKINGS - FINAL SURFACE	LS																		
*	PAINTED PAVEMENT MARKINGS (WHITE) (SOLID) (12")	GM																		
*	PAINTED PAVEMENT MARKINGS (WHITE) (SOLID) (18")	LF																		
*	PAINTED PAVEMENT MARKINGS (WHITE) (ARROW) (WRONG WAY)	EA																		
*	PAINTED PAVEMENT MARKINGS (WHITE) (SOLID) (6")	GM																		
*	PAINTED PAVEMENT MARKINGS (WHITE) (SOLID) (8")	GM																		
*	PAINTED PAVEMENT MARKINGS (WHITE) (SKIP) (6") (10'-30')	GM																		
*	PAINTED PAVEMENT MARKINGS (WHITE) (SKIP) (6") (3'-9')	GM																		
*	PAINTED PAVEMENT MARKINGS (YELLOW) (SOLID) (6")	GM																		
*	PAINTED PAVEMENT MARKINGS (YELLOW) (SOLID) (8")	GM																		
*	PAINTED PAVEMENT MARKINGS (YELLOW) (SOLID) (18")	LF																		
711-11-103	THERMOPLASTIC (STD) (WHITE) (SOLID) (12" FOR INTERCHANGE MARKINGS)	GM																		
711-11-124	THERMOPLASTIC (STD) (WHITE) (SOLID) (18")	LF																		
711-11-170	THERMOPLASTIC (STD) (WHITE) (ARROW) (WRONG WAY)	EA																		
711-11-224	THERMOPLASTIC (STD) (YELLOW) (SOLID) (18")	LF																		

* THESE QUANTITIES ARE PAID FOR UNDER PAINTED PAVEMENT MARKINGS (FINAL SURFACE) LUMP SUM - ITEM NO. 710-90. THE QUANTITIES SHOWN ARE FOR ONE APPLICATION; SEE SPECIFICATION 710 FOR THE NUMBER OF APPLICATIONS REQUIRED.

<table border="1"> <thead> <tr> <th colspan="4">REVISIONS</th> </tr> <tr> <th>DATE</th> <th>DESCRIPTION</th> <th>DATE</th> <th>DESCRIPTION</th> </tr> </thead> <tbody> <tr> <td>10/28/22</td> <td> ADDED PAY ITEM.</td> <td></td> <td></td> </tr> </tbody> </table>				REVISIONS				DATE	DESCRIPTION	DATE	DESCRIPTION	10/28/22	 ADDED PAY ITEM.			PATRICIA T. CHRISTIE, P.E. P.E. NO.: 60049 FALLER, DAVIS & ASSOCIATES, INC. 4200 W. CYPRESS ST., SUITE 500 TAMPA, FLORIDA 33607-4168			STATE OF FLORIDA DEPARTMENT OF TRANSPORTATION <table border="1"> <tr> <th>ROAD NO.</th> <th>COUNTY</th> <th>FINANCIAL PROJECT ID</th> </tr> <tr> <td>SR 93</td> <td>COLLIER</td> <td>444008-3-52-01</td> </tr> </table>			ROAD NO.	COUNTY	FINANCIAL PROJECT ID	SR 93	COLLIER	444008-3-52-01	SHEET NO. S-4	
REVISIONS																													
DATE	DESCRIPTION	DATE	DESCRIPTION																										
10/28/22	 ADDED PAY ITEM.																												
ROAD NO.	COUNTY	FINANCIAL PROJECT ID																											
SR 93	COLLIER	444008-3-52-01																											

TABULATION OF QUANTITIES

PAY ITEM NO.	DESCRIPTION	UNIT	SHEET NUMBERS																TOTAL THIS SHEET	
			S-18		S-19		S-20		S-21		S-22		S-23		S-24		S-25		PLAN	FINAL
			PLAN	FINAL	PLAN	FINAL	PLAN	FINAL	PLAN	FINAL	PLAN	FINAL	PLAN	FINAL	PLAN	FINAL				
711-14-160	THERMOPLASTIC (PREFORMED) (WHITE) (MSG) (EXIT NUMBER)	EA																		
711-15-101	THERMOPLASTIC (STD-OPEN) (WHITE) (SOLID) (6")	GM																		
711-15-102	THERMOPLASTIC (STD-OPEN) (WHITE) (SOLID) (8")	GM																		
711-15-131	THERMOPLASTIC (STD-OPEN) (WHITE) (SKIP) (6") (10'-30')	GM																		
	THERMOPLASTIC (STD-OPEN) (WHITE) (SKIP) (6") (3'-9')	GM																		
711-15-201	THERMOPLASTIC (STD-OPEN) (YELLOW) (SOLID) (6")	GM																		
711-15-202	THERMOPLASTIC (STD-OPEN) (YELLOW) (SOLID) (8")	GM																		
711-17-1	THERMOPLASTIC (REMOVE EXISTING THERMOPLASTIC PAVEMENT MARKINGS- SURFACE TO REMAIN)	SF																		
713-103-101	PERMANENT TAPE (WHITE) (SOLID) (6")	GM																		
713-103-131	PERMANENT TAPE (WHITE) (SKIP/DOTTED) (6" FOR CONCRETE SURFACES)	GM																		
713-103-201	PERMANENT TAPE (YELLOW) (SOLID) (6")	GM																		
713-103-331	PERMANENT TAPE (BLACK) (SKIP/DOTTED) (6" FOR CONCRETE SURFACES)	GM																		

--	--	--	--

REVISIONS				PATRICIA T. CHRISTIE, P.E. P.E. NO.: 60049 FALLER, DAVIS & ASSOCIATES, INC. 4200 W. CYPRESS ST., SUITE 500 TAMPA, FLORIDA 33607-4168	STATE OF FLORIDA DEPARTMENT OF TRANSPORTATION			TABULATION OF QUANTITIES (2A)	SHEET NO.
DATE	DESCRIPTION	DATE	DESCRIPTION		ROAD NO.	COUNTY	FINANCIAL PROJECT ID		S-4A
					SR 93	COLLIER	444008-3-52-01		

THE OFFICIAL RECORD OF THIS SHEET IS THE ELECTRONIC FILE DIGITALLY SIGNED AND SEALED UNDER RULE 61G15-23.004, F.A.C.

TABULATION OF QUANTITIES

PAY ITEM NO.	DESCRIPTION	UNIT	SHEET NUMBERS																TOTAL THIS SHEET	
			S-26		S-27		S-28		S-29		S-30		S-31		S-32		S-33		PLAN	FINAL
			PLAN	FINAL	PLAN	FINAL	PLAN	FINAL	PLAN	FINAL	PLAN	FINAL	PLAN	FINAL	PLAN	FINAL				
700-1-11	SINGLE POST SIGN (F&I) (UP TO 12 SF)	AS									6		10		10		11		37	
700-1-12	SINGLE POST SIGN (F&I) (12-20 SF)	AS											2		1		2		5	
700-1-13	SINGLE POST SIGN (F&I) (21-30 SF)	AS																		
700-1-14	SINGLE POST SIGN (F&I) (31+ SF)	AS												1					1	
700-1-60	SINGLE POST SIGN (REMOVE)	AS									2		7		5		6		20	
700-2-12	MULTI-POST SIGN (F&I) (12-20 SF)	AS																		
700-2-14	MULTI-POST SIGN (F&I) (31-50 SF)	AS																		
700-2-15	MULTI-POST SIGN (F&I) (51-100 SF)	AS																		
700-2-16	MULTI-POST SIGN (F&I) (101-200 SF)	AS																		
700-2-17	MULTI-POST SIGN (F&I) (201-300 SF)	AS													1		2		3	
700-2-60	MULTI-POST SIGN (REMOVE)	AS													1		3		4	
700-3-106	SIGN PANEL (F&I GROUND MOUNT) (101-200 SF)	EA																		
700-3-602	SIGN PANEL (REMOVE) (12-20 SF)	EA																		
700-3-606	SIGN PANEL (REMOVE) (101-200 SF)	EA																		
700-13-15	RETROREFLECTIVE SIGN STRIP (F&I) (5')	EA																		
701-18-101	PROFILED THERMOPLASTIC (STD) (ASPHALT) (WHITE) (SOLID) (6")	GM									0.828		2.098		2.075		2.060		7.061	
701-18-201	PROFILED THERMOPLASTIC (STD) (ASPHALT) (YELLOW) (SOLID) (6")	GM									0.828		2.098		2.075		2.060		7.061	
704-1-1	TUBULAR MARKER (36") (WHITE POST)	EA																		
705-10-3	OBJECT MARKER (TYPE 3)	EA									6		8		8		6		28	
705-11-2	DELINEATOR (NON-FLEXIBLE)	EA																		
706-1-3	RAISED PAVEMENT MARKER (TYPE B) (W/R)	EA									110		280		280		280		950	
	RAISED PAVEMENT MARKER (TYPE B) (Y/Y)	EA																		
	RAISED PAVEMENT MARKER (TYPE B) (Y/R)	EA																		
710-90	PAINTED PAVEMENT MARKINGS - FINAL SURFACE	LS																		
*	PAINTED PAVEMENT MARKINGS (WHITE) (SOLID) (12")	GM																		
*	PAINTED PAVEMENT MARKINGS (WHITE) (SOLID) (18")	LF																		
*	PAINTED PAVEMENT MARKINGS (WHITE) (ARROW) (WRONG WAY)	EA																		
*	PAINTED PAVEMENT MARKINGS (WHITE) (SOLID) (6")	GM									0.828		2.098		2.075		2.060		7.061	
*	PAINTED PAVEMENT MARKINGS (WHITE) (SOLID) (8")	GM																		
*	PAINTED PAVEMENT MARKINGS (WHITE) (SKIP) (6") (10'-30')	GM									0.828		2.098		2.075		2.060		7.061	
*	PAINTED PAVEMENT MARKINGS (WHITE) (SKIP) (6") (3'-9')	GM																		
*	PAINTED PAVEMENT MARKINGS (YELLOW) (SOLID) (6")	GM									0.828		2.098		2.075		2.060		7.061	
*	PAINTED PAVEMENT MARKINGS (YELLOW) (SOLID) (8")	GM																		
*	PAINTED PAVEMENT MARKINGS (YELLOW) (SOLID) (18")	LF																		
711-11-103	THERMOPLASTIC (STD) (WHITE) (SOLID) (12" FOR INTERCHANGE MARKINGS)	GM																		
711-11-124	THERMOPLASTIC (STD) (WHITE) (SOLID) (18")	LF																		
711-11-170	THERMOPLASTIC (STD) (WHITE) (ARROW) (WRONG WAY)	EA																		
711-11-224	THERMOPLASTIC (STD) (YELLOW) (SOLID) (18")	LF																		

* THESE QUANTITIES ARE PAID FOR UNDER PAINTED PAVEMENT MARKINGS (FINAL SURFACE) LUMP SUM - ITEM NO. 710-90. THE QUANTITIES SHOWN ARE FOR ONE APPLICATION; SEE SPECIFICATION 710 FOR THE NUMBER OF APPLICATIONS REQUIRED.

<table border="1"> <thead> <tr> <th colspan="4">REVISIONS</th> </tr> <tr> <th>DATE</th> <th>DESCRIPTION</th> <th>DATE</th> <th>DESCRIPTION</th> </tr> </thead> <tbody> <tr> <td>10/28/22</td> <td>△ ADDED PAY ITEM.</td> <td></td> <td></td> </tr> </tbody> </table>				REVISIONS				DATE	DESCRIPTION	DATE	DESCRIPTION	10/28/22	△ ADDED PAY ITEM.			PATRICIA T. CHRISTIE, P.E. P.E. NO.: 60049 FALLER, DAVIS & ASSOCIATES, INC. 4200 W. CYPRESS ST., SUITE 500 TAMPA, FLORIDA 33607-4168			STATE OF FLORIDA DEPARTMENT OF TRANSPORTATION <table border="1"> <tr> <th>ROAD NO.</th> <th>COUNTY</th> <th>FINANCIAL PROJECT ID</th> </tr> <tr> <td>SR 93</td> <td>COLLIER</td> <td>444008-3-52-01</td> </tr> </table>			ROAD NO.	COUNTY	FINANCIAL PROJECT ID	SR 93	COLLIER	444008-3-52-01	SHEET NO. S-5	
REVISIONS																													
DATE	DESCRIPTION	DATE	DESCRIPTION																										
10/28/22	△ ADDED PAY ITEM.																												
ROAD NO.	COUNTY	FINANCIAL PROJECT ID																											
SR 93	COLLIER	444008-3-52-01																											

TABULATION OF QUANTITIES

PAY ITEM NO.	DESCRIPTION	UNIT	SHEET NUMBERS																TOTAL THIS SHEET	
			S-26		S-27		S-28		S-29		S-30		S-31		S-32		S-33		PLAN	FINAL
			PLAN	FINAL	PLAN	FINAL	PLAN	FINAL	PLAN	FINAL	PLAN	FINAL	PLAN	FINAL	PLAN	FINAL				
711-14-160	THERMOPLASTIC (PREFORMED) (WHITE) (MSG) (EXIT NUMBER)	EA																		
711-15-101	THERMOPLASTIC (STD-OPEN) (WHITE) (SOLID) (6")	GM																		
711-15-102	THERMOPLASTIC (STD-OPEN) (WHITE) (SOLID) (8")	GM																		
711-15-131	THERMOPLASTIC (STD-OPEN) (WHITE) (SKIP) (6") (10'-30')	GM									0.828		2.098		2.075		2.060		7.061	
	THERMOPLASTIC (STD-OPEN) (WHITE) (SKIP) (6") (3'-9')	GM																		
711-15-201	THERMOPLASTIC (STD-OPEN) (YELLOW) (SOLID) (6")	GM																		
711-15-202	THERMOPLASTIC (STD-OPEN) (YELLOW) (SOLID) (8")	GM																		
711-17-1	THERMOPLASTIC (REMOVE EXISTING THERMOPLASTIC PAVEMENT MARKINGS- SURFACE TO REMAIN)	SF																		
713-103-101	PERMANENT TAPE (WHITE) (SOLID) (6")	GM											0.023		0.046		0.062		0.131	
713-103-131	PERMANENT TAPE (WHITE) (SKIP/DOTTED) (6" FOR CONCRETE SURFACES)	GM											0.017		0.041		0.050		0.108	
713-103-201	PERMANENT TAPE (YELLOW) (SOLID) (6")	GM											0.023		0.046		0.062		0.131	
713-103-331	PERMANENT TAPE (BLACK) (SKIP/DOTTED) (6" FOR CONCRETE SURFACES)	GM											0.017		0.041		0.042		0.100	

--	--	--	--

REVISIONS				PATRICIA T. CHRISTIE, P.E. P.E. NO.: 60049 FALLER, DAVIS & ASSOCIATES, INC. 4200 W. CYPRESS ST., SUITE 500 TAMPA, FLORIDA 33607-4168	STATE OF FLORIDA DEPARTMENT OF TRANSPORTATION			TABULATION OF QUANTITIES (3A)	SHEET NO.
DATE	DESCRIPTION	DATE	DESCRIPTION		ROAD NO.	COUNTY	FINANCIAL PROJECT ID		S-5A
					SR 93	COLLIER	444008-3-52-01		

THE OFFICIAL RECORD OF THIS SHEET IS THE ELECTRONIC FILE DIGITALLY SIGNED AND SEALED UNDER RULE 61G15-23.004, F.A.C.

TABULATION OF QUANTITIES

PAY ITEM NO.	DESCRIPTION	UNIT	SHEET NUMBERS																TOTAL THIS SHEET	
			S-34		S-35		S-36		S-37		S-38		S-39		S-40		S-41		PLAN	FINAL
			PLAN	FINAL	PLAN	FINAL	PLAN	FINAL	PLAN	FINAL	PLAN	FINAL	PLAN	FINAL	PLAN	FINAL				
700-1-11	SINGLE POST SIGN (F&I) (UP TO 12 SF)	AS	4		2		2					2					2		14	
700-1-12	SINGLE POST SIGN (F&I) (12-20 SF)	AS	2	2	3	2		3	1								4	13		
700-1-13	SINGLE POST SIGN (F&I) (21-30 SF)	AS																		
700-1-14	SINGLE POST SIGN (F&I) (31+ SF)	AS	1																1	
700-1-60	SINGLE POST SIGN (REMOVE)	AS	3		2		2	2									2	11		
700-2-12	MULTI-POST SIGN (F&I) (12-20 SF)	AS																		
700-2-14	MULTI-POST SIGN (F&I) (31-50 SF)	AS	2					1									1	4		
700-2-15	MULTI-POST SIGN (F&I) (51-100 SF)	AS																		
700-2-16	MULTI-POST SIGN (F&I) (101-200 SF)	AS			1							1		1				3		
700-2-17	MULTI-POST SIGN (F&I) (201-300 SF)	AS	1					1										2		
700-2-60	MULTI-POST SIGN (REMOVE)	AS	3				1	1		1				1		1		8		
700-3-106	SIGN PANEL (F&I GROUND MOUNT) (101-200 SF)	EA																		
700-3-602	SIGN PANEL (REMOVE) (12-20 SF)	EA	2		1			2		1							3	9		
700-3-606	SIGN PANEL (REMOVE) (101-200 SF)	EA																		
700-13-15	RETROREFLECTIVE SIGN STRIP (F&I) (5')	EA																		
701-18-101	PROFILED THERMOPLASTIC (STD) (ASPHALT) (WHITE) (SOLID) (6")	GM	0.709		0.211		0.133		0.101		0.265		0.265		0.265		0.197	2.146		
701-18-201	PROFILED THERMOPLASTIC (STD) (ASPHALT) (YELLOW) (SOLID) (6")	GM	0.709		0.265		0.265		0.265		0.265		0.265		0.265		0.265	2.564		
704-1-1	TUBULAR MARKER (36") (WHITE POST)	EA																		
705-10-3	OBJECT MARKER (TYPE 3)	EA	2															2		
705-11-2	DELINEATOR (NON-FLEXIBLE)	EA			1		3		3								4	11		
706-1-3	RAISED PAVEMENT MARKER (TYPE B) (W/R)	EA	94		44		83		128		35		36		34		82	536		
	RAISED PAVEMENT MARKER (TYPE B) (Y/Y)	EA																		
	RAISED PAVEMENT MARKER (TYPE B) (Y/R)	EA																		
710-90	PAINTED PAVEMENT MARKINGS - FINAL SURFACE	LS																		
*	PAINTED PAVEMENT MARKINGS (WHITE) (SOLID) (12")	GM																		
*	PAINTED PAVEMENT MARKINGS (WHITE) (SOLID) (18")	LF					43		599		37					470		1149		
*	PAINTED PAVEMENT MARKINGS (WHITE) (ARROW) (WRONG WAY)	EA																		
*	PAINTED PAVEMENT MARKINGS (WHITE) (SOLID) (6")	GM	0.709		0.265		0.265		0.265		0.265		0.265		0.265		0.265	2.564		
*	PAINTED PAVEMENT MARKINGS (WHITE) (SOLID) (8")	GM					0.107		0.255								0.136	0.498		
*	PAINTED PAVEMENT MARKINGS (WHITE) (SKIP) (6") (10'-30')	GM	0.709		0.265		0.265		0.265		0.265		0.265		0.265		0.265	2.564		
*	PAINTED PAVEMENT MARKINGS (WHITE) (SKIP) (6") (3'-9')	GM					0.028		0.035									0.063		
*	PAINTED PAVEMENT MARKINGS (YELLOW) (SOLID) (6")	GM	0.709		0.265		0.265		0.265		0.265		0.265		0.265		0.265	2.564		
*	PAINTED PAVEMENT MARKINGS (YELLOW) (SOLID) (8")	GM																		
*	PAINTED PAVEMENT MARKINGS (YELLOW) (SOLID) (18")	LF																		
711-11-103	THERMOPLASTIC (STD) (WHITE) (SOLID) (12" FOR INTERCHANGE MARKINGS)	GM																		
711-11-124	THERMOPLASTIC (STD) (WHITE) (SOLID) (18")	LF					43		599		37					470		1149		
711-11-170	THERMOPLASTIC (STD) (WHITE) (ARROW) (WRONG WAY)	EA																		
711-11-224	THERMOPLASTIC (STD) (YELLOW) (SOLID) (18")	LF																		

* THESE QUANTITIES ARE PAID FOR UNDER PAINTED PAVEMENT MARKINGS (FINAL SURFACE) LUMP SUM - ITEM NO. 710-90. THE QUANTITIES SHOWN ARE FOR ONE APPLICATION; SEE SPECIFICATION 710 FOR THE NUMBER OF APPLICATIONS REQUIRED.

<p>REVISIONS</p> <table border="1"> <thead> <tr> <th>DATE</th> <th>DESCRIPTION</th> <th>DATE</th> <th>DESCRIPTION</th> </tr> </thead> <tbody> <tr> <td>10/28/22</td> <td>ADDED PAY ITEM. UPDATED QUANTITIES.</td> <td></td> <td></td> </tr> </tbody> </table>				DATE	DESCRIPTION	DATE	DESCRIPTION	10/28/22	ADDED PAY ITEM. UPDATED QUANTITIES.			<p>PATRICIA T. CHRISTIE, P.E. P.E. NO.: 60049 FALLER, DAVIS & ASSOCIATES, INC. 4200 W. CYPRESS ST., SUITE 500 TAMPA, FLORIDA 33607-4168</p>			<p>STATE OF FLORIDA DEPARTMENT OF TRANSPORTATION</p> <table border="1"> <thead> <tr> <th>ROAD NO.</th> <th>COUNTY</th> <th>FINANCIAL PROJECT ID</th> </tr> </thead> <tbody> <tr> <td>SR 93</td> <td>COLLIER</td> <td>444008-3-52-01</td> </tr> </tbody> </table>			ROAD NO.	COUNTY	FINANCIAL PROJECT ID	SR 93	COLLIER	444008-3-52-01	<p>TABULATION OF QUANTITIES (4)</p>		<p>SHEET NO. S-6</p>
DATE	DESCRIPTION	DATE	DESCRIPTION																							
10/28/22	ADDED PAY ITEM. UPDATED QUANTITIES.																									
ROAD NO.	COUNTY	FINANCIAL PROJECT ID																								
SR 93	COLLIER	444008-3-52-01																								

TABULATION OF QUANTITIES

PAY ITEM NO.	DESCRIPTION	UNIT	SHEET NUMBERS																TOTAL THIS SHEET	
			S-34		S-35		S-36		S-37		S-38		S-39		S-40		S-41		PLAN	FINAL
			PLAN	FINAL	PLAN	FINAL	PLAN	FINAL	PLAN	FINAL	PLAN	FINAL	PLAN	FINAL	PLAN	FINAL				
711-14-160	THERMOPLASTIC (PREFORMED) (WHITE) (MSG) (EXIT NUMBER)	EA					1												1	
711-15-101	THERMOPLASTIC (STD-OPEN) (WHITE) (SOLID) (6")	GM			0.054		0.132		0.164								0.068		0.418	
711-15-102	THERMOPLASTIC (STD-OPEN) (WHITE) (SOLID) (8")	GM					0.107		0.255								0.136		0.498	
711-15-131	THERMOPLASTIC (STD-OPEN) (WHITE) (SKIP) (6") (10'-30')	GM	0.709		0.265		0.265		0.265		0.265		0.265		0.265		0.265		2.564	
	THERMOPLASTIC (STD-OPEN) (WHITE) (SKIP) (6") (3'-9')	GM					0.028		0.035										0.063	
711-15-201	THERMOPLASTIC (STD-OPEN) (YELLOW) (SOLID) (6")	GM																		
711-15-202	THERMOPLASTIC (STD-OPEN) (YELLOW) (SOLID) (8")	GM																		
711-17-1	THERMOPLASTIC (REMOVE EXISTING THERMOPLASTIC PAVEMENT MARKINGS- SURFACE TO REMAIN)	SF																		
713-103-101	PERMANENT TAPE (WHITE) (SOLID) (6")	GM	0.011																0.011	
713-103-131	PERMANENT TAPE (WHITE) (SKIP/DOTTED) (6" FOR CONCRETE SURFACES)	GM	0.009																0.009	
713-103-201	PERMANENT TAPE (YELLOW) (SOLID) (6")	GM	0.011																0.011	
713-103-331	PERMANENT TAPE (BLACK) (SKIP/DOTTED) (6" FOR CONCRETE SURFACES)	GM	0.002																0.002	

REVISIONS				PATRICIA T. CHRISTIE, P.E. P.E. NO.: 60049 FALLER, DAVIS & ASSOCIATES, INC. 4200 W. CYPRESS ST., SUITE 500 TAMPA, FLORIDA 33607-4168		STATE OF FLORIDA DEPARTMENT OF TRANSPORTATION			TABULATION OF QUANTITIES (4A)		SHEET NO.
DATE	DESCRIPTION	DATE	DESCRIPTION			ROAD NO.	COUNTY	FINANCIAL PROJECT ID			S-6A

TABULATION OF QUANTITIES

PAY ITEM NO.	DESCRIPTION	UNIT	SHEET NUMBERS																TOTAL THIS SHEET	
			S-42		S-43		S-44		S-45		S-46		S-47		S-48		S-49		PLAN	FINAL
			PLAN	FINAL	PLAN	FINAL	PLAN	FINAL	PLAN	FINAL	PLAN	FINAL	PLAN	FINAL	PLAN	FINAL				
711-14-160	THERMOPLASTIC (PREFORMED) (WHITE) (MSG) (EXIT NUMBER)	EA	1																1	
711-15-101	THERMOPLASTIC (STD-OPEN) (WHITE) (SOLID) (6")	GM	0.187		0.086														0.273	
711-15-102	THERMOPLASTIC (STD-OPEN) (WHITE) (SOLID) (8")	GM	0.187																0.187	
711-15-131	THERMOPLASTIC (STD-OPEN) (WHITE) (SKIP) (6") (10'-30')	GM	0.265		0.265		1.136		2.121		2.097		1.643						7.527	
	THERMOPLASTIC (STD-OPEN) (WHITE) (SKIP) (6") (3'-9')	GM	0.065																0.065	
711-15-201	THERMOPLASTIC (STD-OPEN) (YELLOW) (SOLID) (6")	GM																		
711-15-202	THERMOPLASTIC (STD-OPEN) (YELLOW) (SOLID) (8")	GM																		
711-17-1	THERMOPLASTIC (REMOVE EXISTING THERMOPLASTIC PAVEMENT MARKINGS- SURFACE TO REMAIN)	SF																		
713-103-101	PERMANENT TAPE (WHITE) (SOLID) (6")	GM								0.025		0.027							0.052	
713-103-131	PERMANENT TAPE (WHITE) (SKIP/DOTTED) (6" FOR CONCRETE SURFACES)	GM								0.023		0.017							0.040	
713-103-201	PERMANENT TAPE (YELLOW) (SOLID) (6")	GM								0.025		0.027							0.052	
713-103-331	PERMANENT TAPE (BLACK) (SKIP/DOTTED) (6" FOR CONCRETE SURFACES)	GM								0.024		0.017							0.041	

REVISIONS DATE DESCRIPTION DATE DESCRIPTION				PATRICIA T. CHRISTIE, P.E. P.E. NO.: 60049 FALLER, DAVIS & ASSOCIATES, INC. 4200 W. CYPRESS ST., SUITE 500 TAMPA, FLORIDA 33607-4168	STATE OF FLORIDA DEPARTMENT OF TRANSPORTATION			TABULATION OF QUANTITIES (5A)	SHEET NO.	
ROAD NO.		COUNTY	FINANCIAL PROJECT ID		SR 93	COLLIER	444008-3-52-01		S-7A	

TABULATION OF QUANTITIES

PAY ITEM NO.	DESCRIPTION	UNIT	SHEET NUMBERS																TOTAL THIS SHEET	
			S-42		S-43		S-44		S-45		S-46		S-47		S-48		S-49		PLAN	FINAL
			PLAN	FINAL	PLAN	FINAL	PLAN	FINAL	PLAN	FINAL	PLAN	FINAL	PLAN	FINAL	PLAN	FINAL	PLAN	FINAL		
700-1-11	SINGLE POST SIGN (F&I) (UP TO 12 SF)	AS	2					6	10	10			14					42		
700-1-12	SINGLE POST SIGN (F&I) (12-20 SF)	AS		2		5							9					16		
700-1-13	SINGLE POST SIGN (F&I) (21-30 SF)	AS																		
700-1-14	SINGLE POST SIGN (F&I) (31+ SF)	AS											1					1		
700-1-60	SINGLE POST SIGN (REMOVE)	AS		2		4		4		18			7					35		
700-2-12	MULTI-POST SIGN (F&I) (12-20 SF)	AS																		
700-2-14	MULTI-POST SIGN (F&I) (31-50 SF)	AS				1		1										2		
700-2-15	MULTI-POST SIGN (F&I) (51-100 SF)	AS				2												2		
700-2-16	MULTI-POST SIGN (F&I) (101-200 SF)	AS								1								1		
700-2-17	MULTI-POST SIGN (F&I) (201-300 SF)	AS	1			1		2		1								5		
700-2-60	MULTI-POST SIGN (REMOVE)	AS	1			4		4		2								11		
700-3-106	SIGN PANEL (F&I GROUND MOUNT) (101-200 SF)	EA								1								1		
700-3-602	SIGN PANEL (REMOVE) (12-20 SF)	EA		2		1												3		
700-3-606	SIGN PANEL (REMOVE) (101-200 SF)	EA								1								1		
700-13-15	RETROREFLECTIVE SIGN STRIP (F&I) (5')	EA											8					8		
701-18-101	PROFILED THERMOPLASTIC (STD) (ASPHALT) (WHITE) (SOLID) (6")	GM	0.078		0.179		1.136		2.121		2.097		1.643					7.254		
701-18-201	PROFILED THERMOPLASTIC (STD) (ASPHALT) (YELLOW) (SOLID) (6")	GM	0.265		0.265		1.136		2.121		2.097		1.643					7.527		
704-1-1	TUBULAR MARKER (36") (WHITE POST)	EA																		
705-10-3	OBJECT MARKER (TYPE 3)	EA							4		4		2					10		
705-11-2	DELINEATOR (NON-FLEXIBLE)	EA	5		2								2					9		
706-1-3	RAISED PAVEMENT MARKER (TYPE B) (W/R)	EA	111		48		150		280		280		222				17	1108		
	RAISED PAVEMENT MARKER (TYPE B) (Y/Y)	EA									5		7					12		
	RAISED PAVEMENT MARKER (TYPE B) (Y/R)	EA																		
710-90	PAINTED PAVEMENT MARKINGS - FINAL SURFACE	LS																		
*	PAINTED PAVEMENT MARKINGS (WHITE) (SOLID) (12")	GM																		
*	PAINTED PAVEMENT MARKINGS (WHITE) (SOLID) (18")	LF	132															132		
*	PAINTED PAVEMENT MARKINGS (WHITE) (ARROW) (WRONG WAY)	EA															1	1		
*	PAINTED PAVEMENT MARKINGS (WHITE) (SOLID) (6")	GM	0.265		0.265		1.136		2.121		2.097		1.643					7.527		
*	PAINTED PAVEMENT MARKINGS (WHITE) (SOLID) (8")	GM	0.187															0.187		
*	PAINTED PAVEMENT MARKINGS (WHITE) (SKIP) (6") (10'-30')	GM	0.265		0.265		1.136		2.121		2.097		1.643					7.527		
*	PAINTED PAVEMENT MARKINGS (WHITE) (SKIP) (6") (3'-9')	GM	0.065															0.065		
*	PAINTED PAVEMENT MARKINGS (YELLOW) (SOLID) (6")	GM	0.265		0.265		1.136		2.121		2.097		1.643					7.527		
*	PAINTED PAVEMENT MARKINGS (YELLOW) (SOLID) (8")	GM																		
*	PAINTED PAVEMENT MARKINGS (YELLOW) (SOLID) (18")	LF																		
711-11-103	THERMOPLASTIC (STD) (WHITE) (SOLID) (12" FOR INTERCHANGE MARKINGS)	GM																		
711-11-124	THERMOPLASTIC (STD) (WHITE) (SOLID) (18")	LF	132															132		
711-11-170	THERMOPLASTIC (STD) (WHITE) (ARROW) (WRONG WAY)	EA															1	1		
711-11-224	THERMOPLASTIC (STD) (YELLOW) (SOLID) (18")	LF																		

* THESE QUANTITIES ARE PAID FOR UNDER PAINTED PAVEMENT MARKINGS (FINAL SURFACE) LUMP SUM - ITEM NO. 710-90. THE QUANTITIES SHOWN ARE FOR ONE APPLICATION; SEE SPECIFICATION 710 FOR THE NUMBER OF APPLICATIONS REQUIRED.

<p>REVISIONS</p> <table border="1"> <thead> <tr> <th>DATE</th> <th>DESCRIPTION</th> <th>DATE</th> <th>DESCRIPTION</th> </tr> </thead> <tbody> <tr> <td>10/28/22</td> <td>ADDED PAY ITEM. UPDATED QUANTITIES.</td> <td></td> <td></td> </tr> </tbody> </table>				DATE	DESCRIPTION	DATE	DESCRIPTION	10/28/22	ADDED PAY ITEM. UPDATED QUANTITIES.			<p>PATRICIA T. CHRISTIE, P.E. P.E. NO.: 60049 FALLER, DAVIS & ASSOCIATES, INC. 4200 W. CYPRESS ST., SUITE 500 TAMPA, FLORIDA 33607-4168</p>			<p>STATE OF FLORIDA DEPARTMENT OF TRANSPORTATION</p> <table border="1"> <thead> <tr> <th>ROAD NO.</th> <th>COUNTY</th> <th>FINANCIAL PROJECT ID</th> </tr> </thead> <tbody> <tr> <td>SR 93</td> <td>COLLIER</td> <td>444008-3-52-01</td> </tr> </tbody> </table>			ROAD NO.	COUNTY	FINANCIAL PROJECT ID	SR 93	COLLIER	444008-3-52-01	<p>TABULATION OF QUANTITIES (5)</p>		<p>SHEET NO. S-7</p>
DATE	DESCRIPTION	DATE	DESCRIPTION																							
10/28/22	ADDED PAY ITEM. UPDATED QUANTITIES.																									
ROAD NO.	COUNTY	FINANCIAL PROJECT ID																								
SR 93	COLLIER	444008-3-52-01																								

TABULATION OF QUANTITIES

PAY ITEM NO.	DESCRIPTION	UNIT	SHEET NUMBERS																TOTAL THIS SHEET		GRAND TOTAL	
			S-50		S-51		S-52		S-53													
			PLAN	FINAL	PLAN	FINAL	PLAN	FINAL	PLAN	FINAL	PLAN	FINAL	PLAN	FINAL	PLAN	FINAL	PLAN	FINAL	PLAN	FINAL		
711-14-160	THERMOPLASTIC (PREFORMED) (WHITE) (MSG) (EXIT NUMBER)	EA																				2
711-15-101	THERMOPLASTIC (STD-OPEN) (WHITE) (SOLID) (6")	GM																				1.118
711-15-102	THERMOPLASTIC (STD-OPEN) (WHITE) (SOLID) (8")	GM																				0.914
711-15-131	THERMOPLASTIC (STD-OPEN) (WHITE) (SKIP) (6") (10'-30')	GM																				23.907
	THERMOPLASTIC (STD-OPEN) (WHITE) (SKIP) (6") (3'-9')	GM																				
711-15-201	THERMOPLASTIC (STD-OPEN) (YELLOW) (SOLID) (6")	GM																				0.210
711-15-202	THERMOPLASTIC (STD-OPEN) (YELLOW) (SOLID) (8")	GM																				0.072
711-17-1	THERMOPLASTIC (REMOVE EXISTING THERMOPLASTIC PAVEMENT MARKINGS- SURFACE TO REMAIN)	SF																				1130
713-103-101	PERMANENT TAPE (WHITE) (SOLID) (6")	GM																				0.194
713-103-131	PERMANENT TAPE (WHITE) (SKIP/DOTTED) (6" FOR CONCRETE SURFACES)	GM																				0.157
713-103-201	PERMANENT TAPE (YELLOW) (SOLID) (6")	GM																				0.194
713-103-331	PERMANENT TAPE (BLACK) (SKIP/DOTTED) (6" FOR CONCRETE SURFACES)	GM																				0.143

REVISIONS				PATRICIA T. CHRISTIE, P.E. P.E. NO.: 60049 FALLER, DAVIS & ASSOCIATES, INC. 4200 W. CYPRESS ST., SUITE 500 TAMPA, FLORIDA 33607-4168	STATE OF FLORIDA DEPARTMENT OF TRANSPORTATION			TABULATION OF QUANTITIES (6A)	SHEET NO. S-8A
DATE	DESCRIPTION	DATE	DESCRIPTION		ROAD NO.	COUNTY	FINANCIAL PROJECT ID		

GENERAL NOTES:

1. REFERENCE THE ROADWAY GENERAL NOTES FOR LIST OF UTILITY OWNERS.
2. ALL LANES ARE 12 FEET WIDE UNLESS OTHERWISE NOTED.

PAY ITEM NOTES:

1. 705-11-2:
INSTALL OR REPLACE IF MISSING OR DAMAGED FROM LOCATIONS SHOWN IN THE PLANS.
2. 700-13-15:
PROVIDE RED RETROREFLECTIVE SIGN STRIPS FOR R5-1 AND R5-1A SIGN ASSEMBLIES.
3. 700-3-602:
INCLUDES REMOVAL OF PANEL AND ALL ASSOCIATED HARDWARE FOR ALL ESU SIGNS ONLY.

ABBREVIATIONS:

PERM. PERMANENT
THERMO THERMOPLASTIC

NORTHBOUND BRIDGE DATA


No.	Bridge No.	Direction	Begin Bridge		End Bridge		Deck Surface
			Station	MM	Station	MM	
1	030225	NB	900+40.00	84.32	901+60.00	84.30	Asphalt
2	030227	NB	932+40.00	83.72	933+60.00	83.69	Asphalt
3	030229	NB	955+50.00	83.28	956+70.00	83.26	Concrete
4	030230	NB	983+94.12	82.74	986+34.12	82.69	Concrete
5	030232	NB	1016+40.00	82.13	1017+60.00	82.10	Asphalt
6	030233	NB	1044+49.84	81.59	1045+79.84	81.57	Concrete
7	030235	NB	1077+40.00	80.97	1078+60.00	80.95	Asphalt
8	030239	NB	1242+40.00	77.84	1243+60.00	77.82	Asphalt
9	030241	NB	1294+40.00	76.86	1295+60.00	76.84	Concrete
10	030243	NB	1345+40.00	75.89	1346+60.00	75.87	Concrete

SOUTHBOUND BRIDGE DATA

No.	Bridge No.	Direction	Begin Bridge		End Bridge		Deck Surface
			Station	MM	Station	MM	
1	030224	SB	900+40.00	84.32	901+60.00	84.30	Asphalt
2	030226	SB	932+40.00	83.72	933+60.00	83.69	Asphalt
3	030228	SB	955+50.00	83.28	956+70.00	83.26	Asphalt
4	030006	SB	983+94.12	82.74	986+34.12	82.69	Asphalt
5	030231	SB	1016+40.00	82.13	1017+60.00	82.10	Asphalt
6	030007	SB	1044+49.84	81.59	1045+79.84	81.57	Concrete
7	030234	SB	1077+40.00	80.97	1078+60.00	80.95	Concrete
8	030240	SB	1242+40.00	77.84	1243+60.00	77.82	Asphalt
9	030242	SB	1294+40.00	76.86	1295+60.00	76.84	Asphalt
10	030244	SB	1345+40.00	75.89	1346+60.00	75.87	Asphalt

REVISIONS				PATRICIA T. CHRISTIE, P.E. P.E. NO.: 60049 FALLER, DAVIS & ASSOCIATES, INC. 4200 W. CYPRESS ST., SUITE 500 TAMPA, FLORIDA 33607-4168	STATE OF FLORIDA DEPARTMENT OF TRANSPORTATION			SHEET NO. S-9
DATE	DESCRIPTION	DATE	DESCRIPTION		ROAD NO.	COUNTY	FINANCIAL PROJECT ID	
10/28/22	△ ADDED PAY ITEM NOTE.				SR 93	COLLIER	444008-3-52-01	

GENERAL NOTES

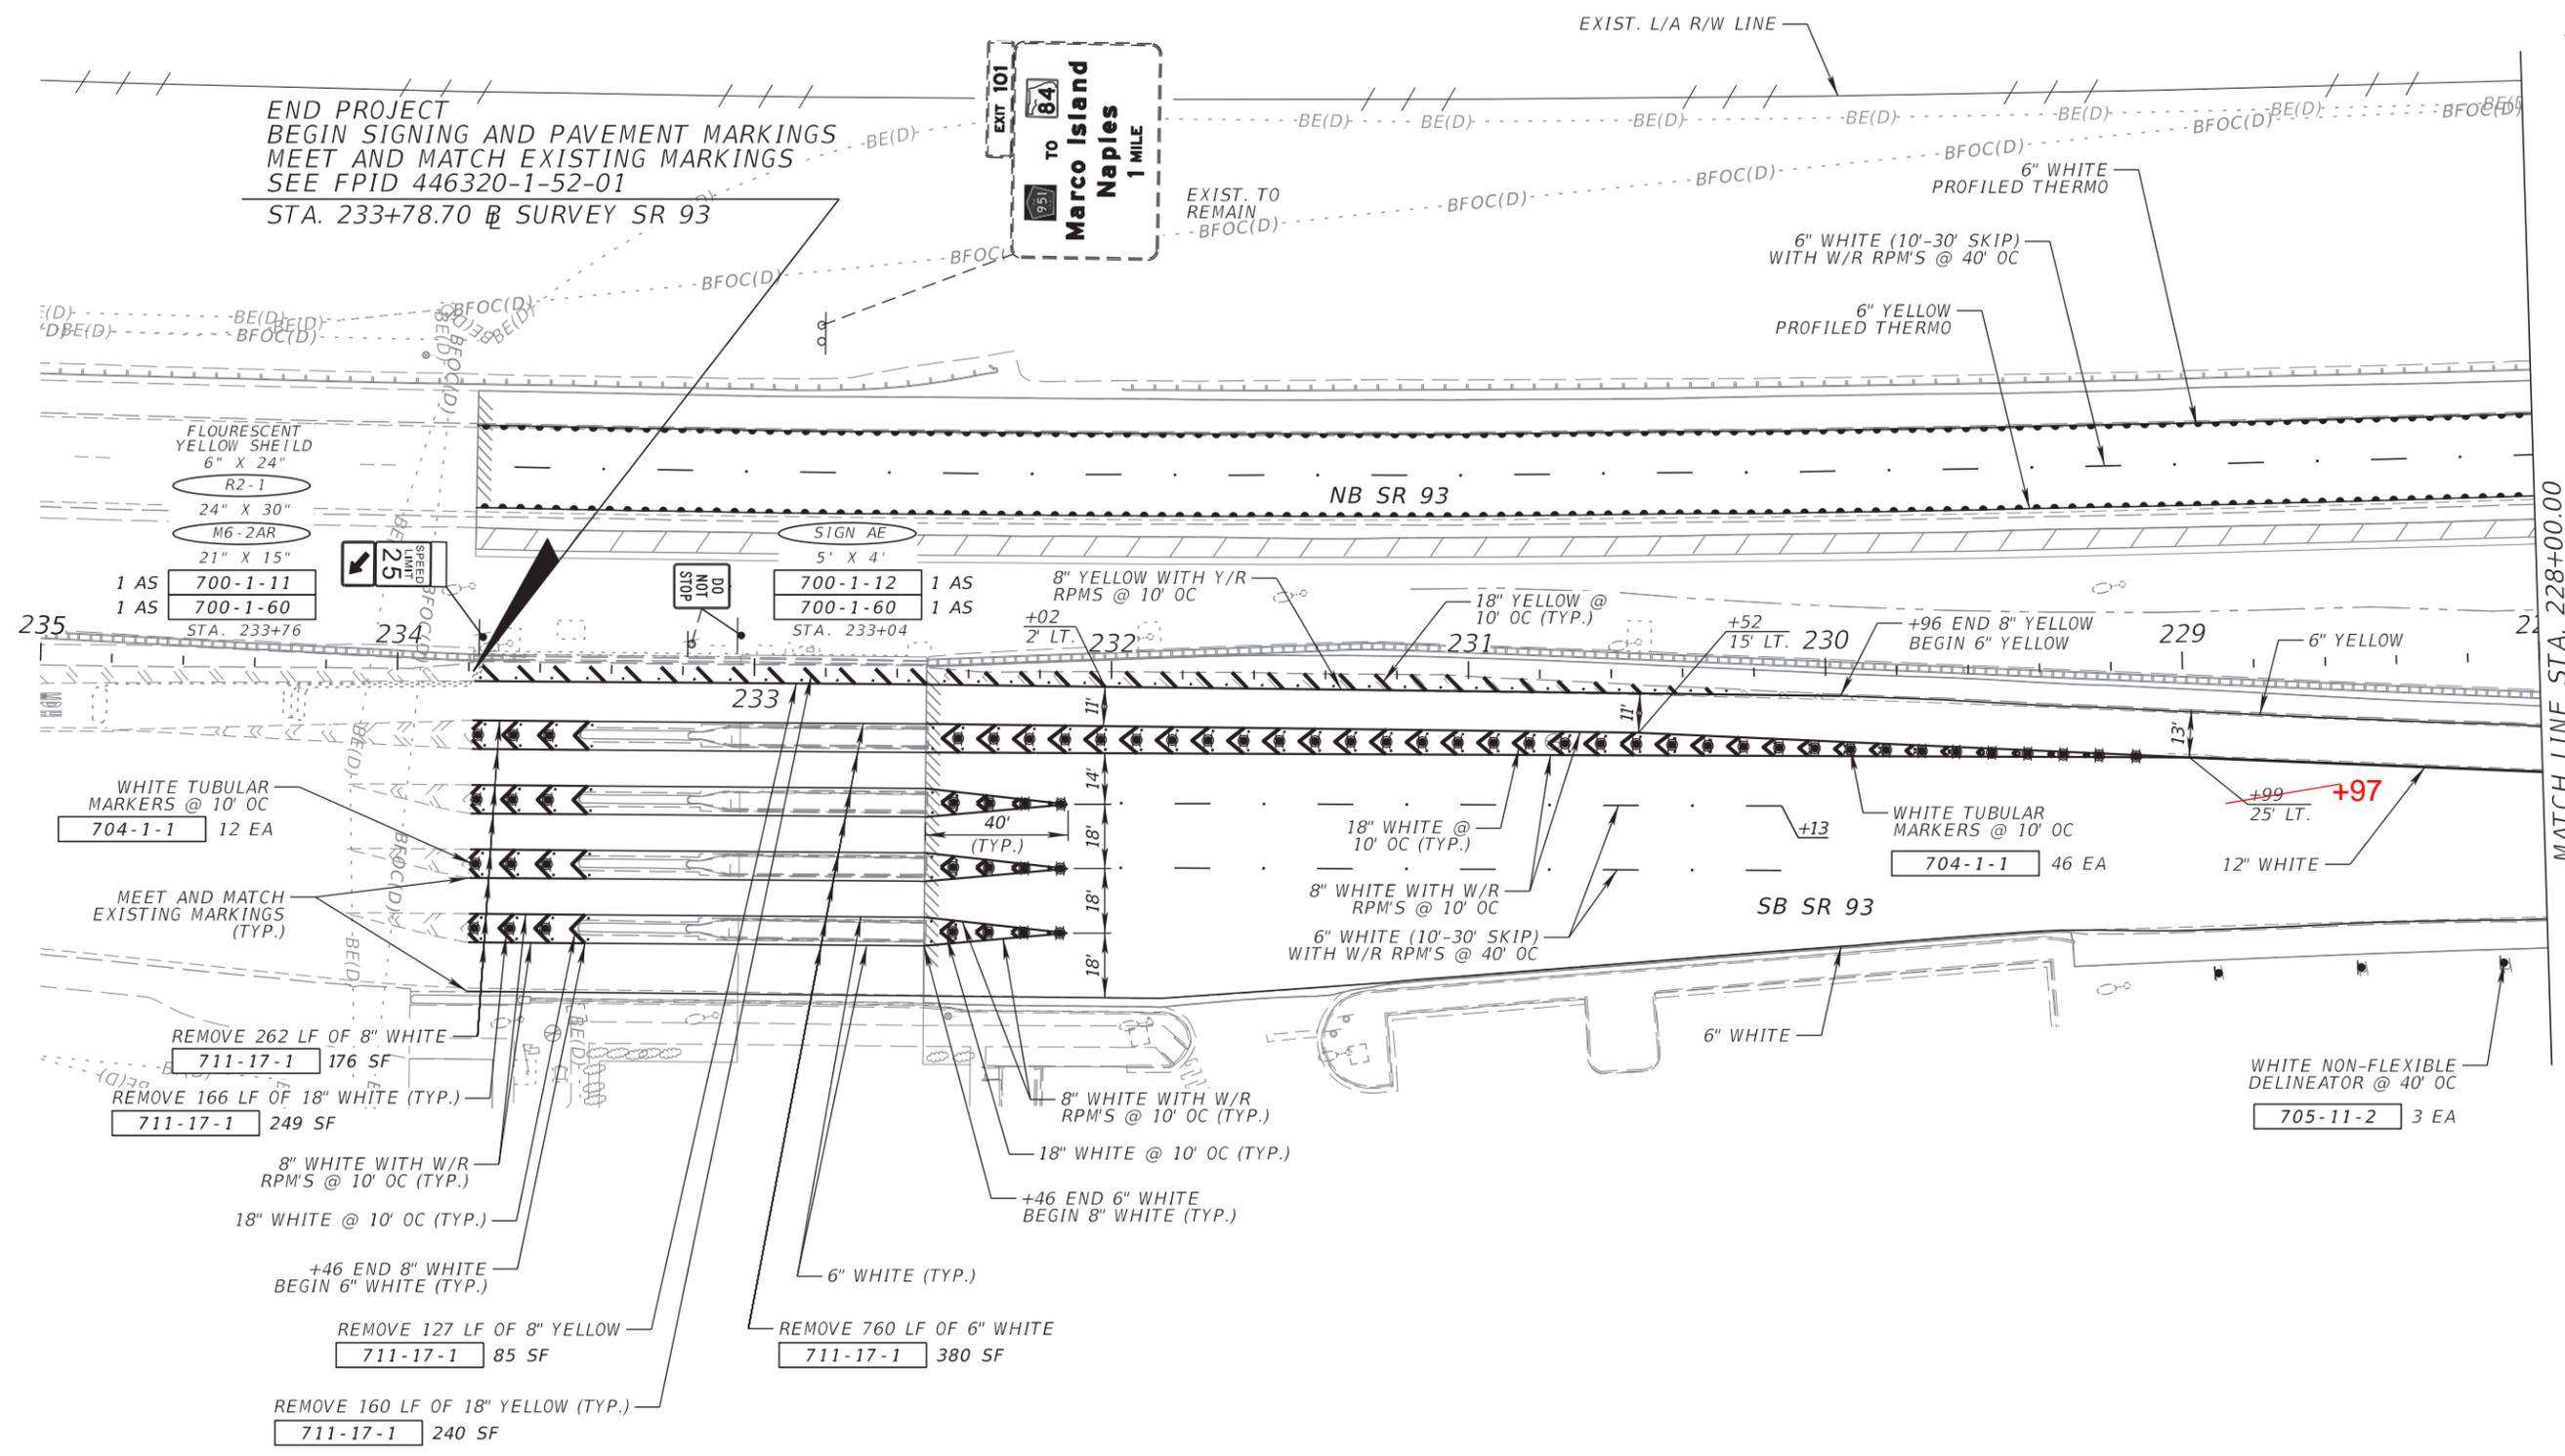

END PROJECT
 BEGIN SIGNING AND PAVEMENT MARKINGS
 MEET AND MATCH EXISTING MARKINGS
 SEE FPID 446320-1-52-01
 STA. 233+78.70 @ SURVEY SR 93

MATCH LINE STA. 228+00.00

FLOURESCENT YELLOW SHEILD
 6" X 24"
 R2-1
 24" X 30"
 M6-2AR
 21" X 15"
 1 AS 700-1-11
 1 AS 700-1-60
 STA. 233+76

SIGN AE
 5' X 4'
 700-1-12 1 AS
 700-1-60 1 AS
 STA. 233+04

WHITE TUBULAR MARKERS @ 10' OC
 704-1-1 12 EA

MEET AND MATCH EXISTING MARKINGS (TYP.)

REMOVE 262 LF OF 8" WHITE
 711-17-1 176 SF
 REMOVE 166 LF OF 18" WHITE (TYP.)
 711-17-1 249 SF

8" WHITE WITH W/R RPM'S @ 10' OC (TYP.)
 18" WHITE @ 10' OC (TYP.)

+46 END 8" WHITE BEGIN 6" WHITE (TYP.)

REMOVE 127 LF OF 8" YELLOW
 711-17-1 85 SF

REMOVE 160 LF OF 18" YELLOW (TYP.)
 711-17-1 240 SF

REMOVE 760 LF OF 6" WHITE
 711-17-1 380 SF

8" WHITE WITH W/R RPM'S @ 10' OC (TYP.)
 18" WHITE @ 10' OC (TYP.)
 +46 END 6" WHITE BEGIN 8" WHITE (TYP.)

6" WHITE (TYP.)



18" WHITE @ 10' OC (TYP.)
 8" WHITE WITH W/R RPM'S @ 10' OC
 6" WHITE (10'-30' SKIP) WITH W/R RPM'S @ 40' OC

WHITE TUBULAR MARKERS @ 10' OC
 704-1-1 46 EA

WHITE NON-FLEXIBLE DELINEATOR @ 40' OC
 705-11-2 3 EA

REVISIONS				PATRICIA T. CHRISTIE, P.E. P.E. NO.: 60049 FALLER, DAVIS & ASSOCIATES, INC. 4200 W. CYPRESS ST., SUITE 500 TAMPA, FLORIDA 33607-4168	STATE OF FLORIDA DEPARTMENT OF TRANSPORTATION			SIGNING AND PAVEMENT MARKING PLAN (1)	SHEET NO.
DATE	DESCRIPTION	DATE	DESCRIPTION		ROAD NO.	COUNTY	FINANCIAL PROJECT ID		
						SR 93	COLLIER		444008-3-52-01

THE OFFICIAL RECORD OF THIS SHEET IS THE ELECTRONIC FILE DIGITALLY SIGNED AND SEALED UNDER RULE 61G15-23.004, F.A.C.

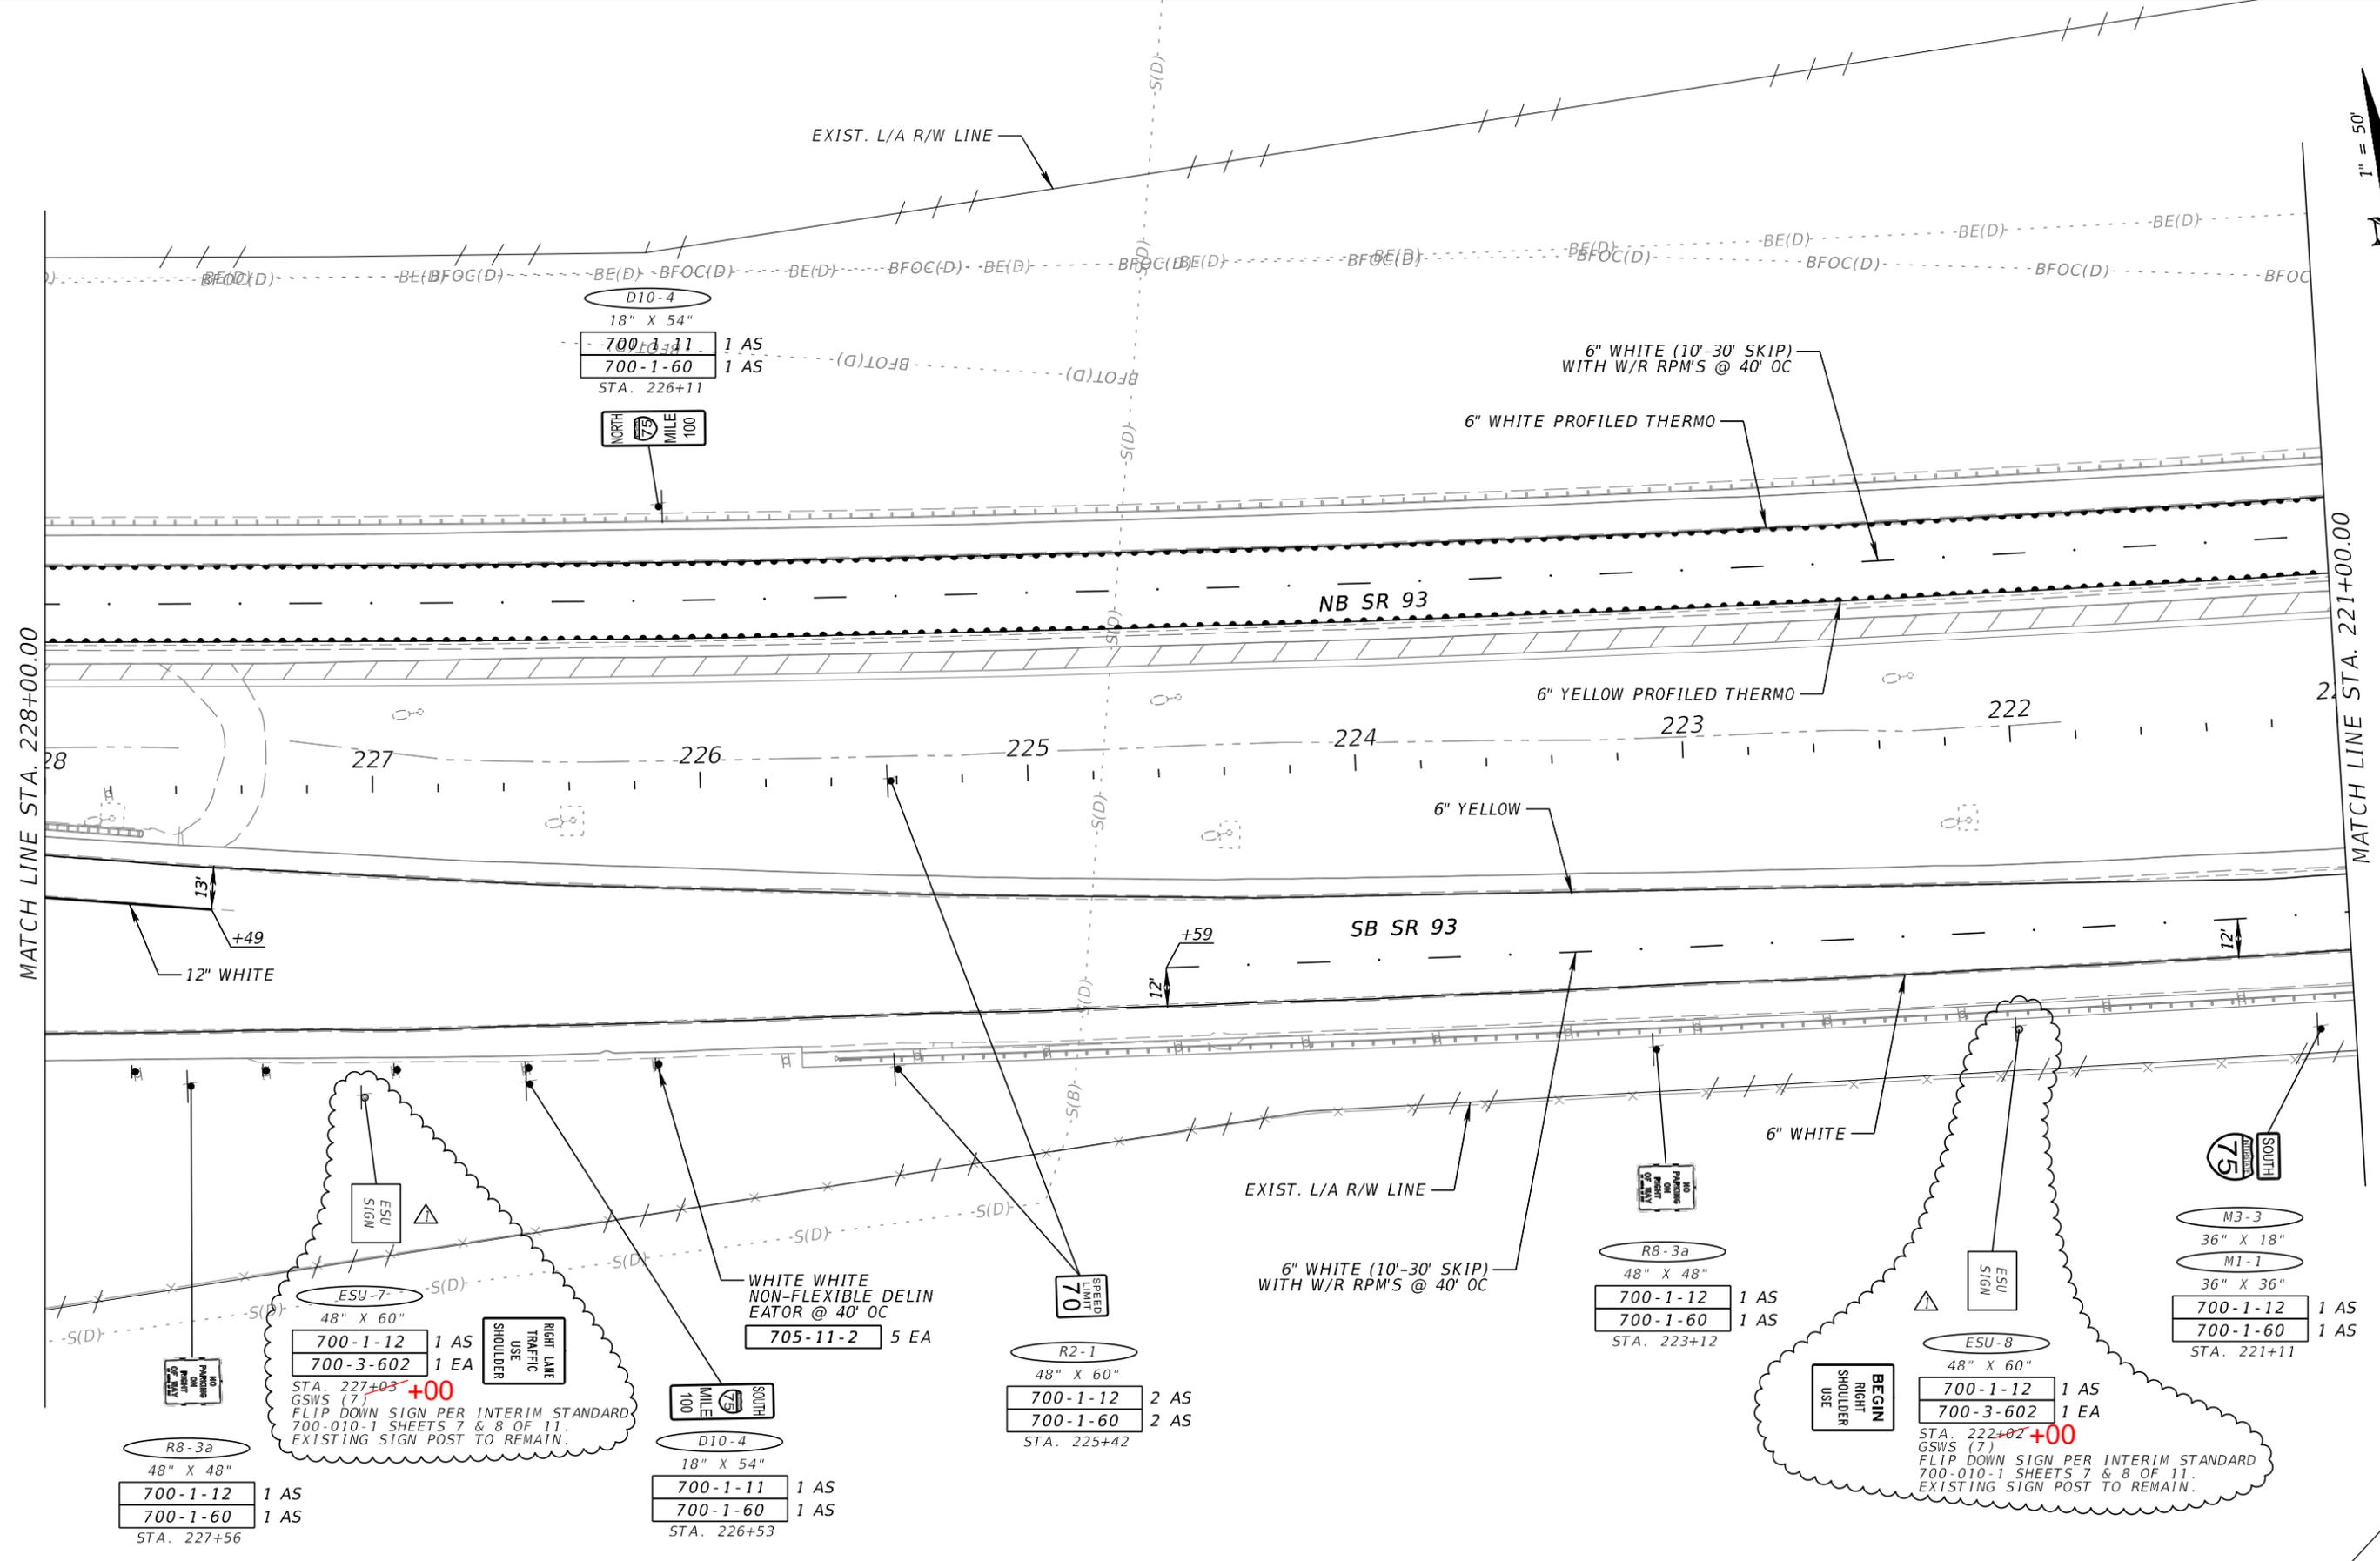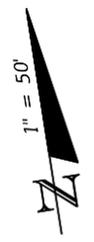

MATCH LINE STA. 221+00.00

MATCH LINE STA. 228+00.00

REVISIONS		DATE	DESCRIPTION
10/28/22	REPLACED EXISTING SIGN PANELS.		



PATRICIA T. CHRISTIE, P.E.
 P.E. NO.: 60049
 FALLER, DAVIS & ASSOCIATES, INC.
 4200 W. CYPRESS ST., SUITE 500
 TAMPA, FLORIDA 33607-4168

STATE OF FLORIDA DEPARTMENT OF TRANSPORTATION		
ROAD NO.	COUNTY	FINANCIAL PROJECT ID
SR 93	COLLIER	444008-3-52-01



**SIGNING AND PAVEMENT
MARKING PLAN (2)**

SHEET NO.
S-11




THE OFFICIAL RECORD OF THIS SHEET IS THE ELECTRONIC FILE DIGITALLY SIGNED AND SEALED UNDER RULE 61G15-23.004, F.A.C.

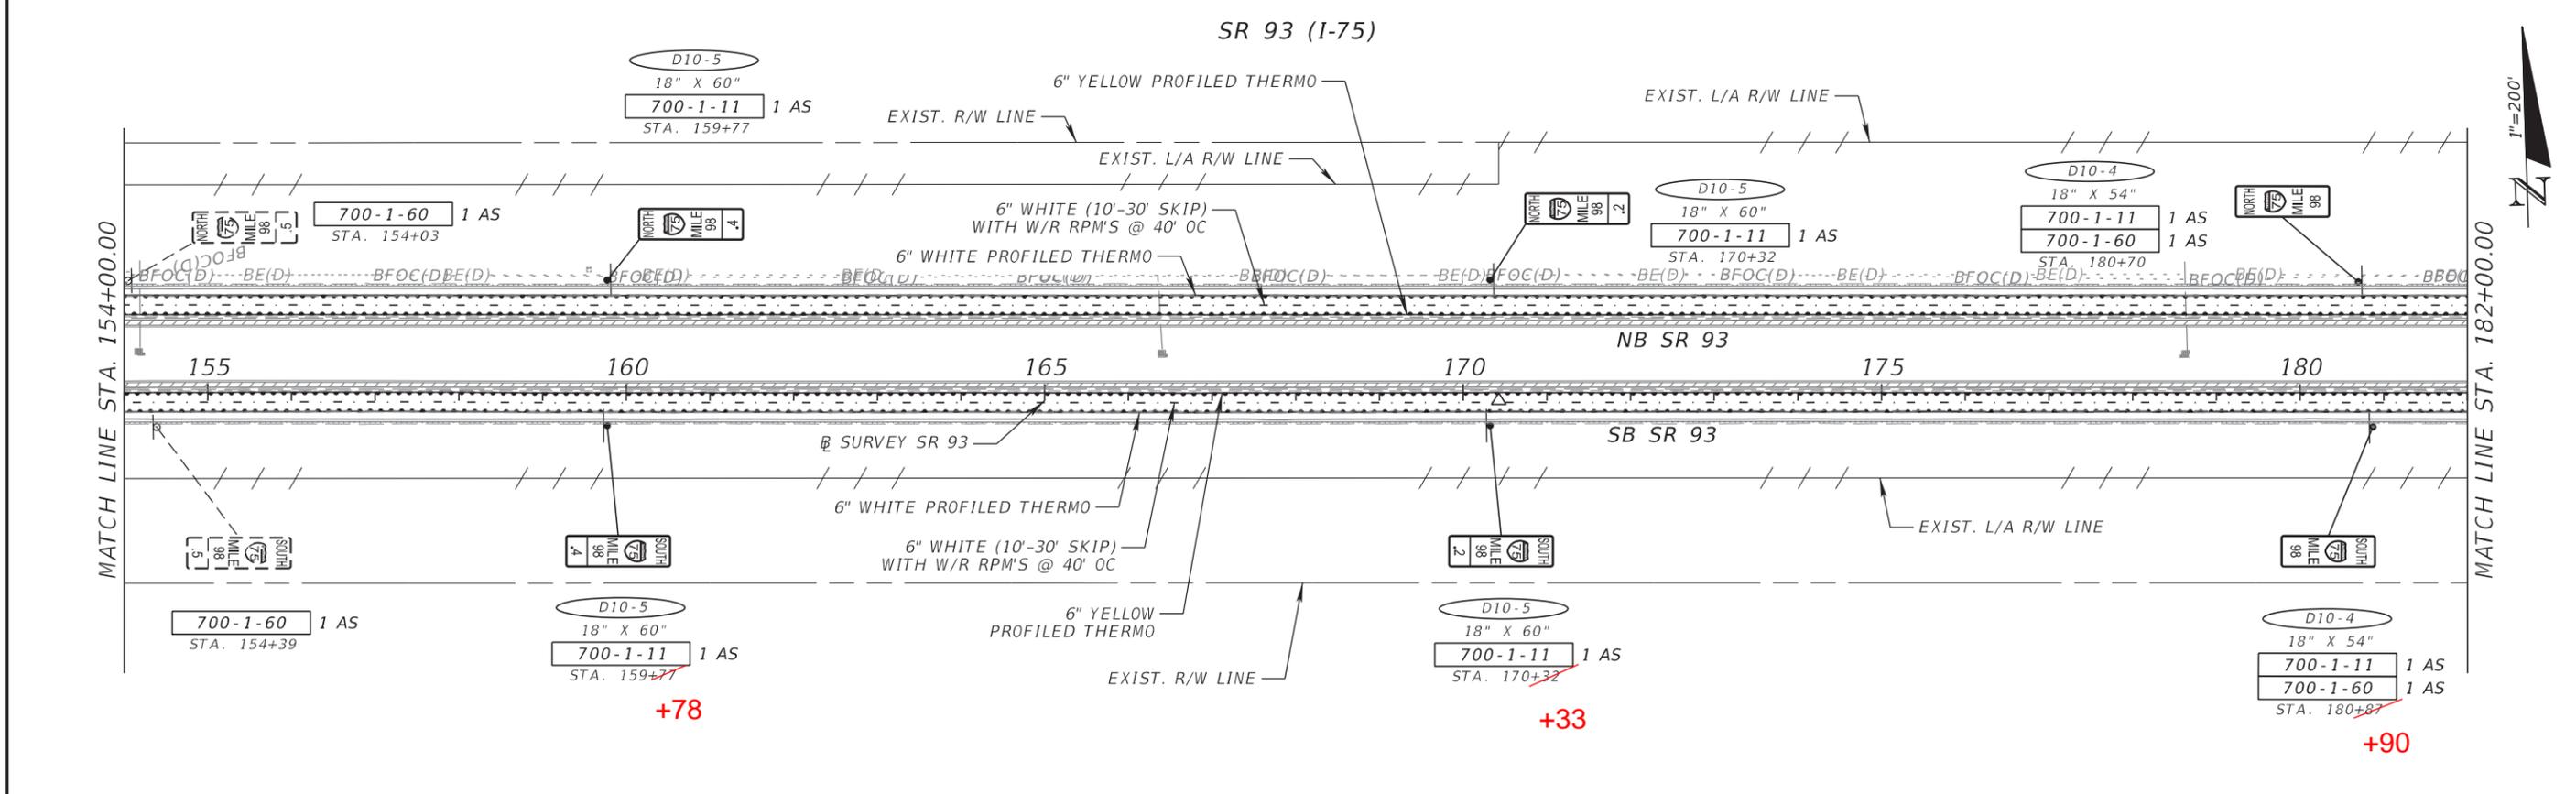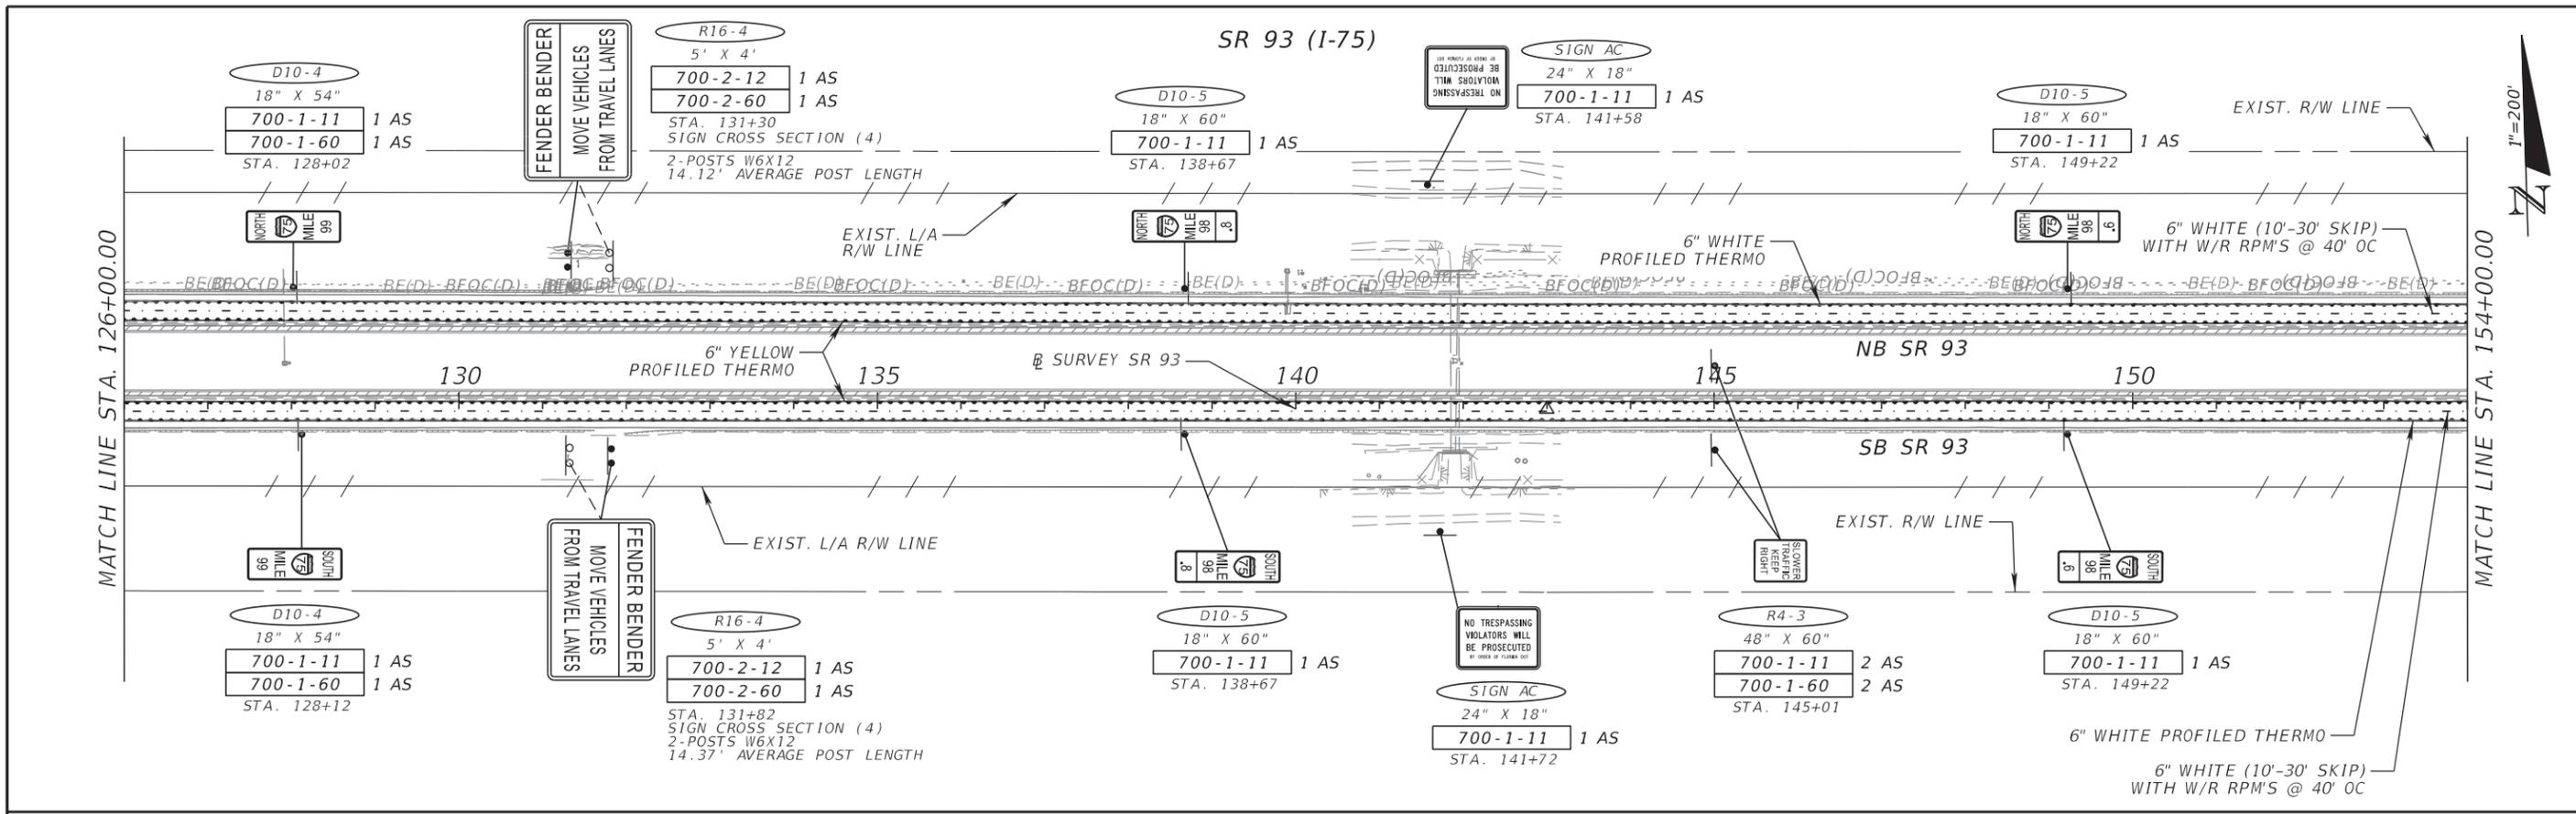

REVISIONS				PATRICIA T. CHRISTIE, P.E. P.E. NO.: 60049 FALLER, DAVIS & ASSOCIATES, INC. 4200 W. CYPRESS ST., SUITE 500 TAMPA, FLORIDA 33607-4168	STATE OF FLORIDA DEPARTMENT OF TRANSPORTATION			SIGNING AND PAVEMENT MARKING PLAN (4)	SHEET NO.
DATE	DESCRIPTION	DATE	DESCRIPTION		ROAD NO.	COUNTY	FINANCIAL PROJECT ID		
					SR 93	COLLIER	444008-3-52-01		S-13

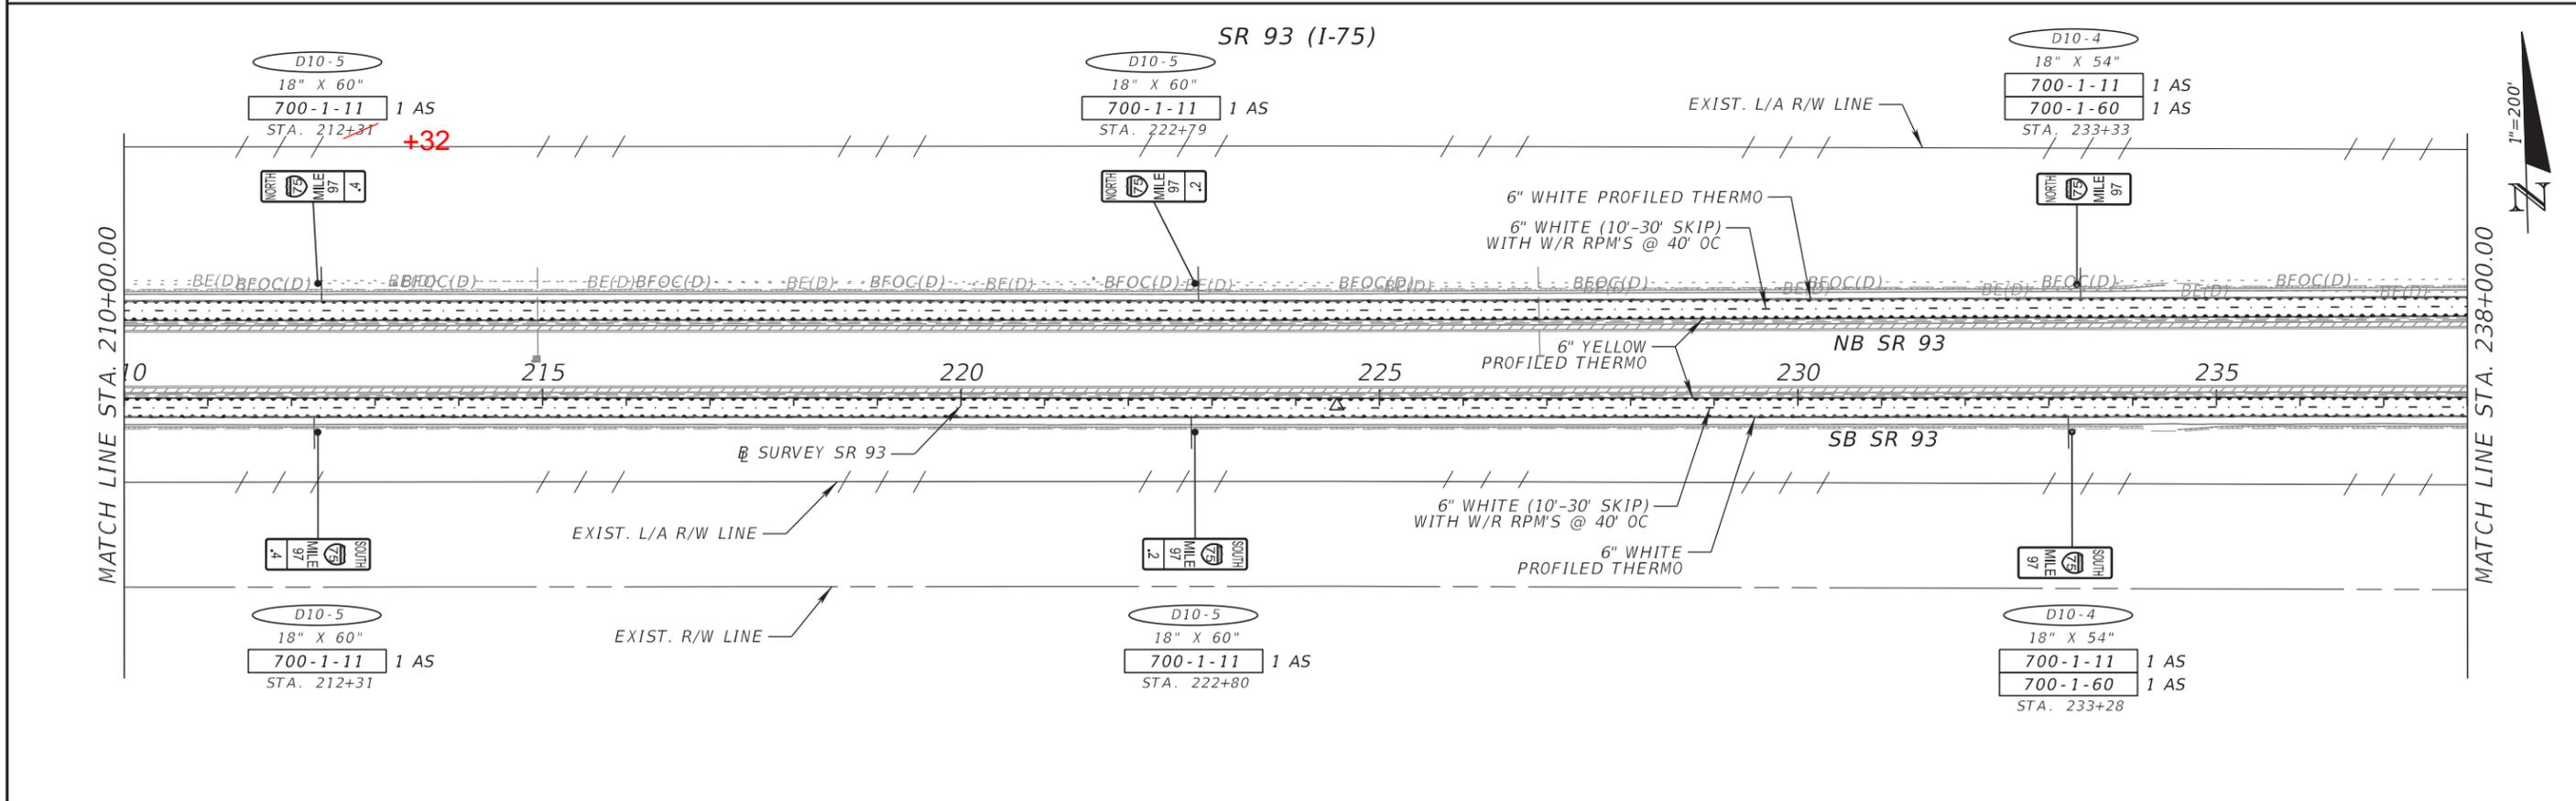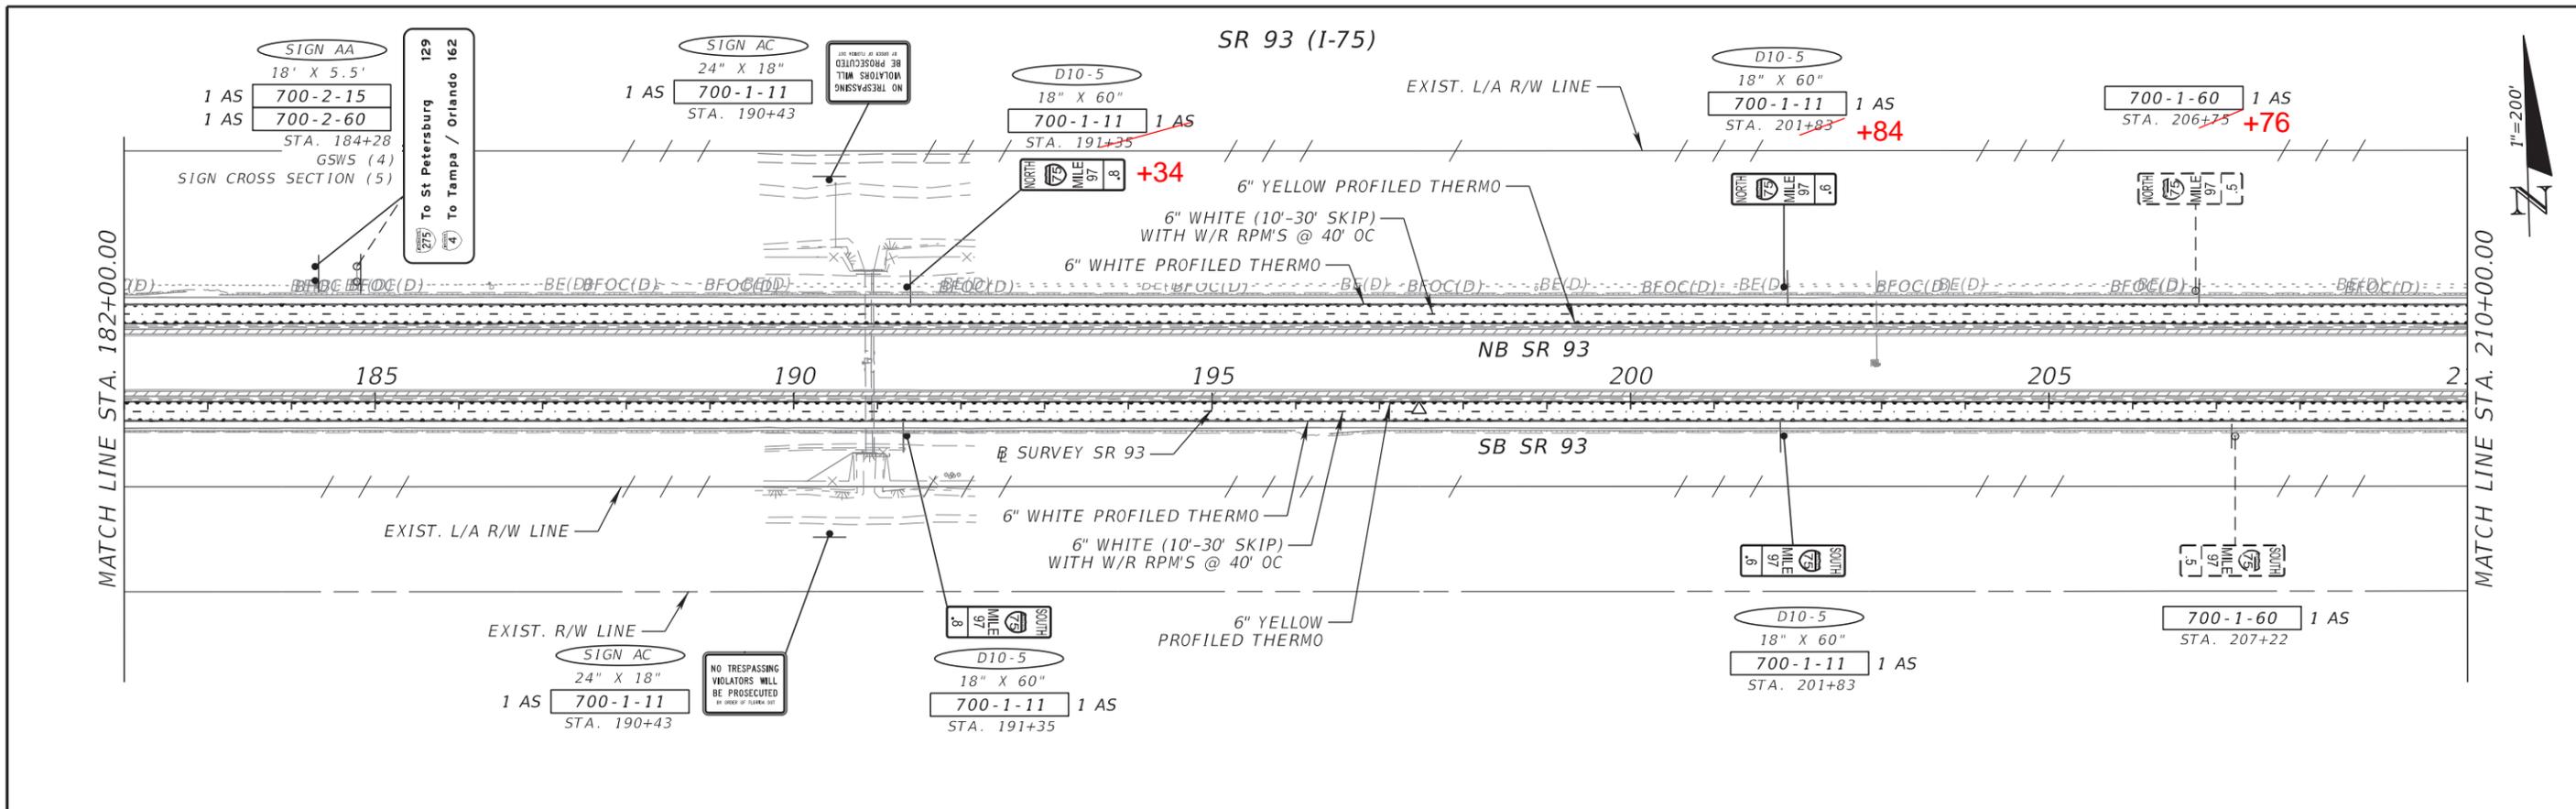


REVISIONS				PATRICIA T. CHRISTIE, P.E. P.E. NO.: 60049 FALLER, DAVIS & ASSOCIATES, INC. 4200 W. CYPRESS ST., SUITE 500 TAMPA, FLORIDA 33607-4168	STATE OF FLORIDA DEPARTMENT OF TRANSPORTATION			SIGNING AND PAVEMENT MARKING PLAN (5)	SHEET NO.
DATE	DESCRIPTION	DATE	DESCRIPTION		ROAD NO.	COUNTY	FINANCIAL PROJECT ID		
					SR 93	COLLIER	444008-3-52-01		5-14

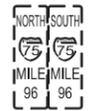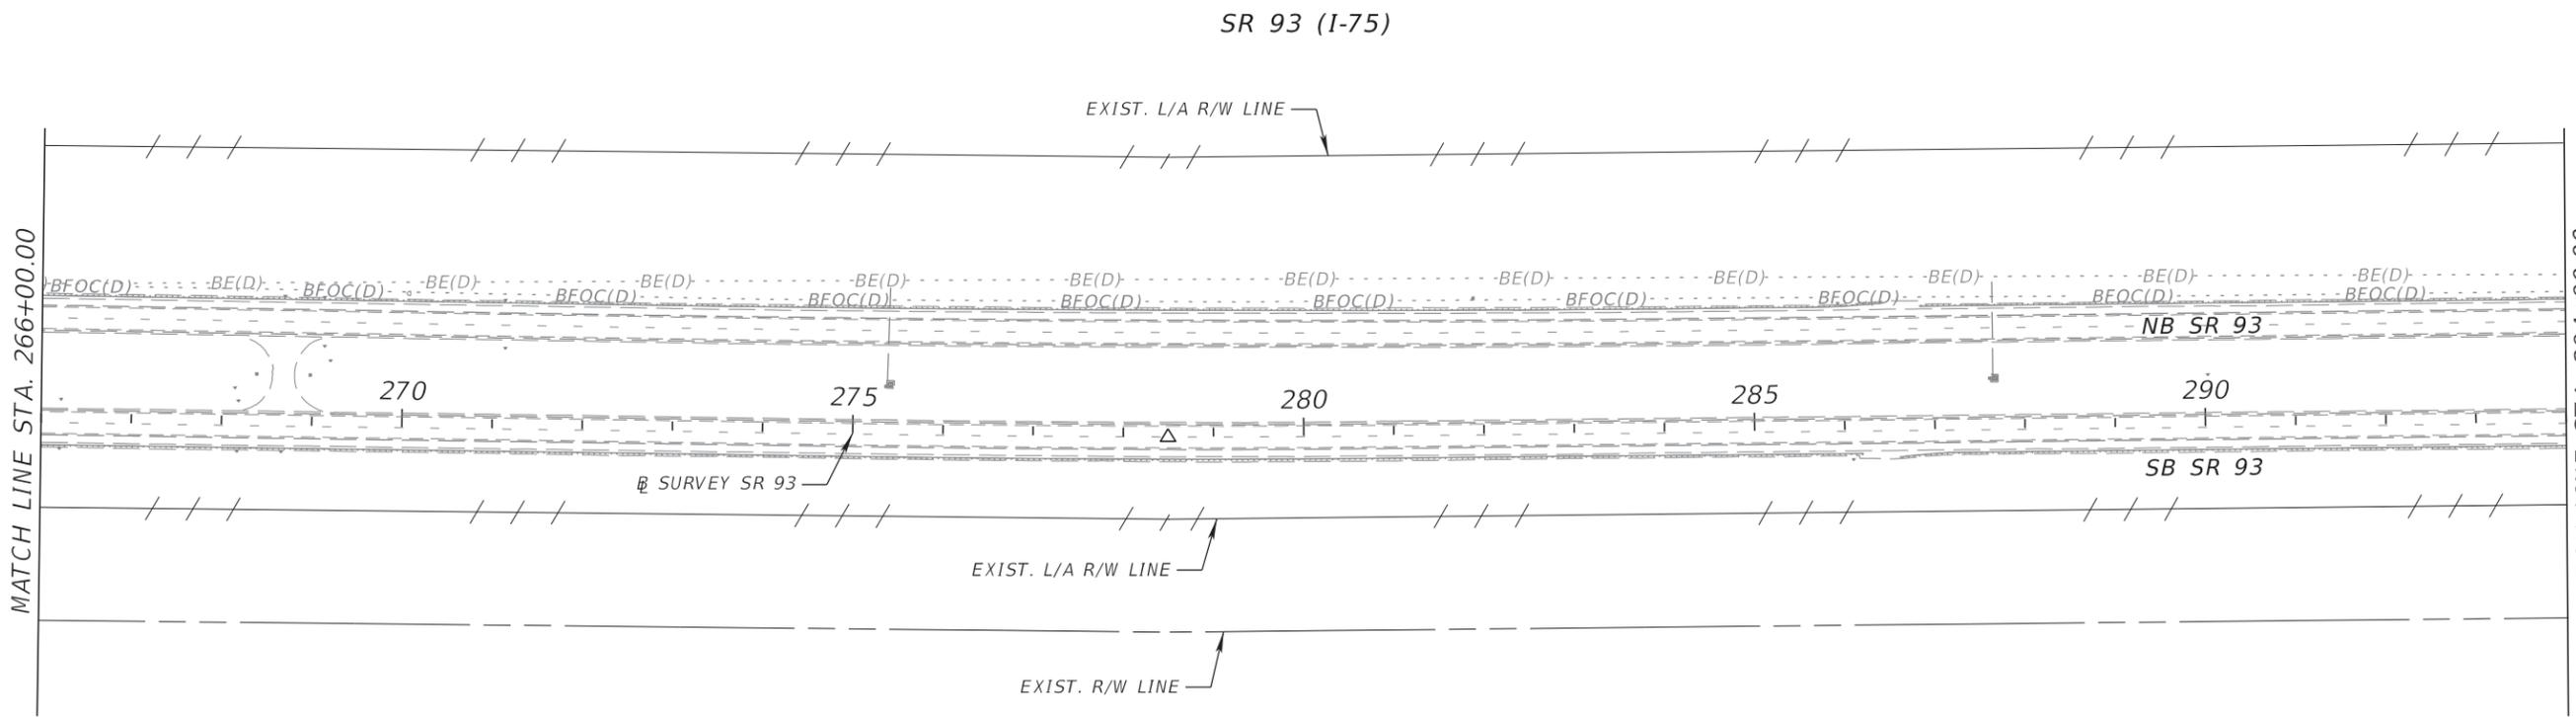
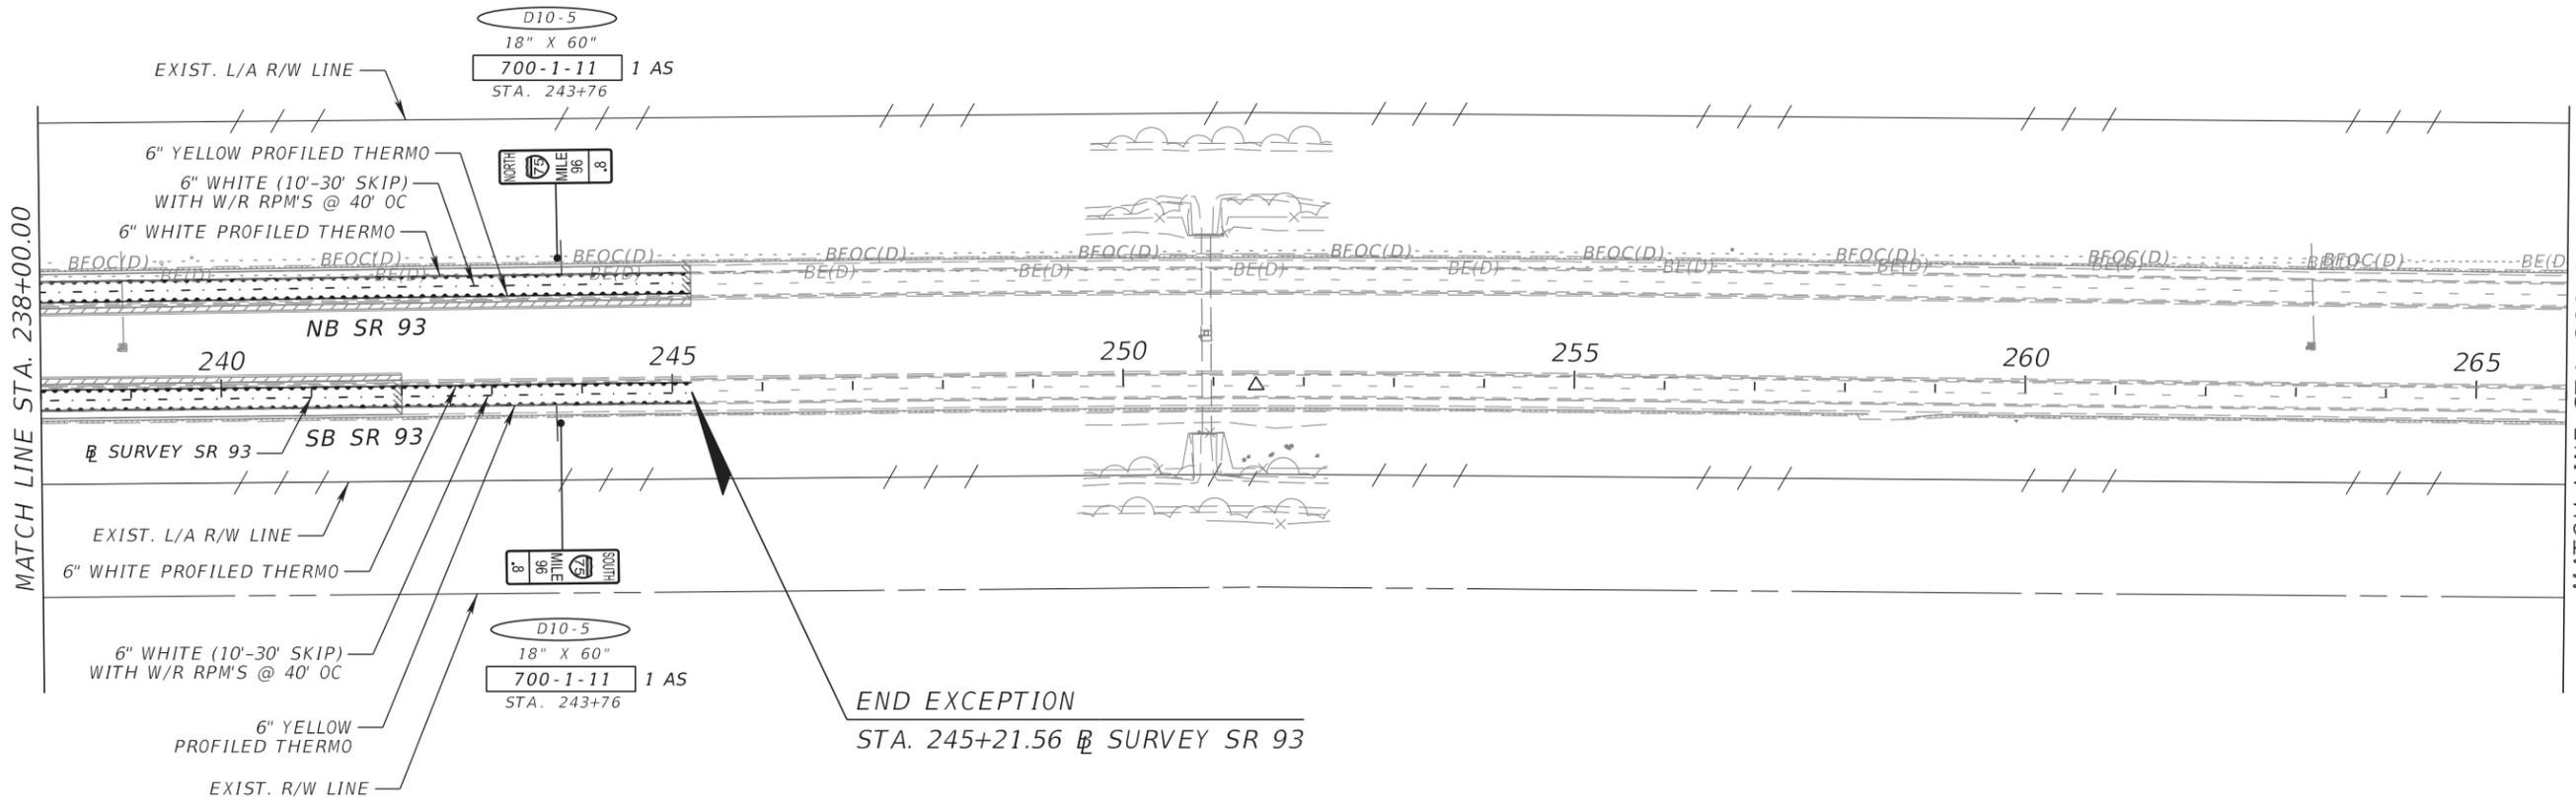


REVISIONS				PATRICIA T. CHRISTIE, P.E. P.E. NO.: 60049 FALLER, DAVIS & ASSOCIATES, INC. 4200 W. CYPRESS ST., SUITE 500 TAMPA, FLORIDA 33607-4168	STATE OF FLORIDA DEPARTMENT OF TRANSPORTATION			SIGNING AND PAVEMENT MARKING PLAN (6)	SHEET NO.
DATE	DESCRIPTION	DATE	DESCRIPTION		ROAD NO.	COUNTY	FINANCIAL PROJECT ID		
						SR 93	COLLIER		444008-3-52-01

SR 93 (I-75)

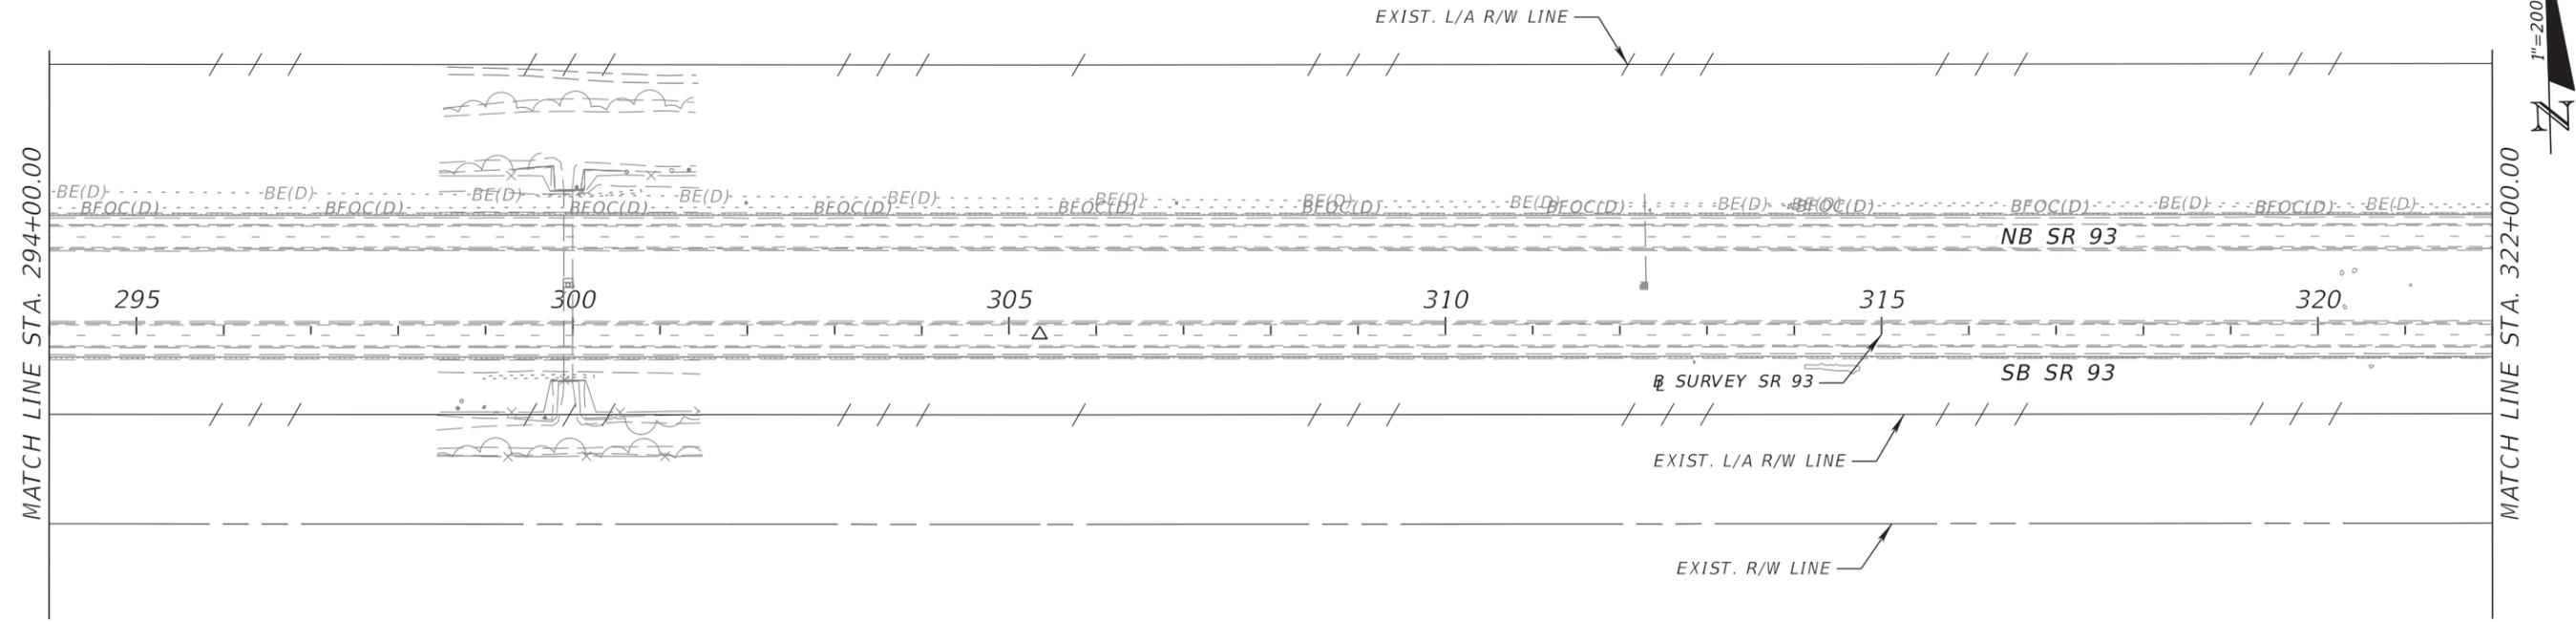


SR 93 (I-75)

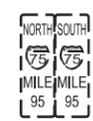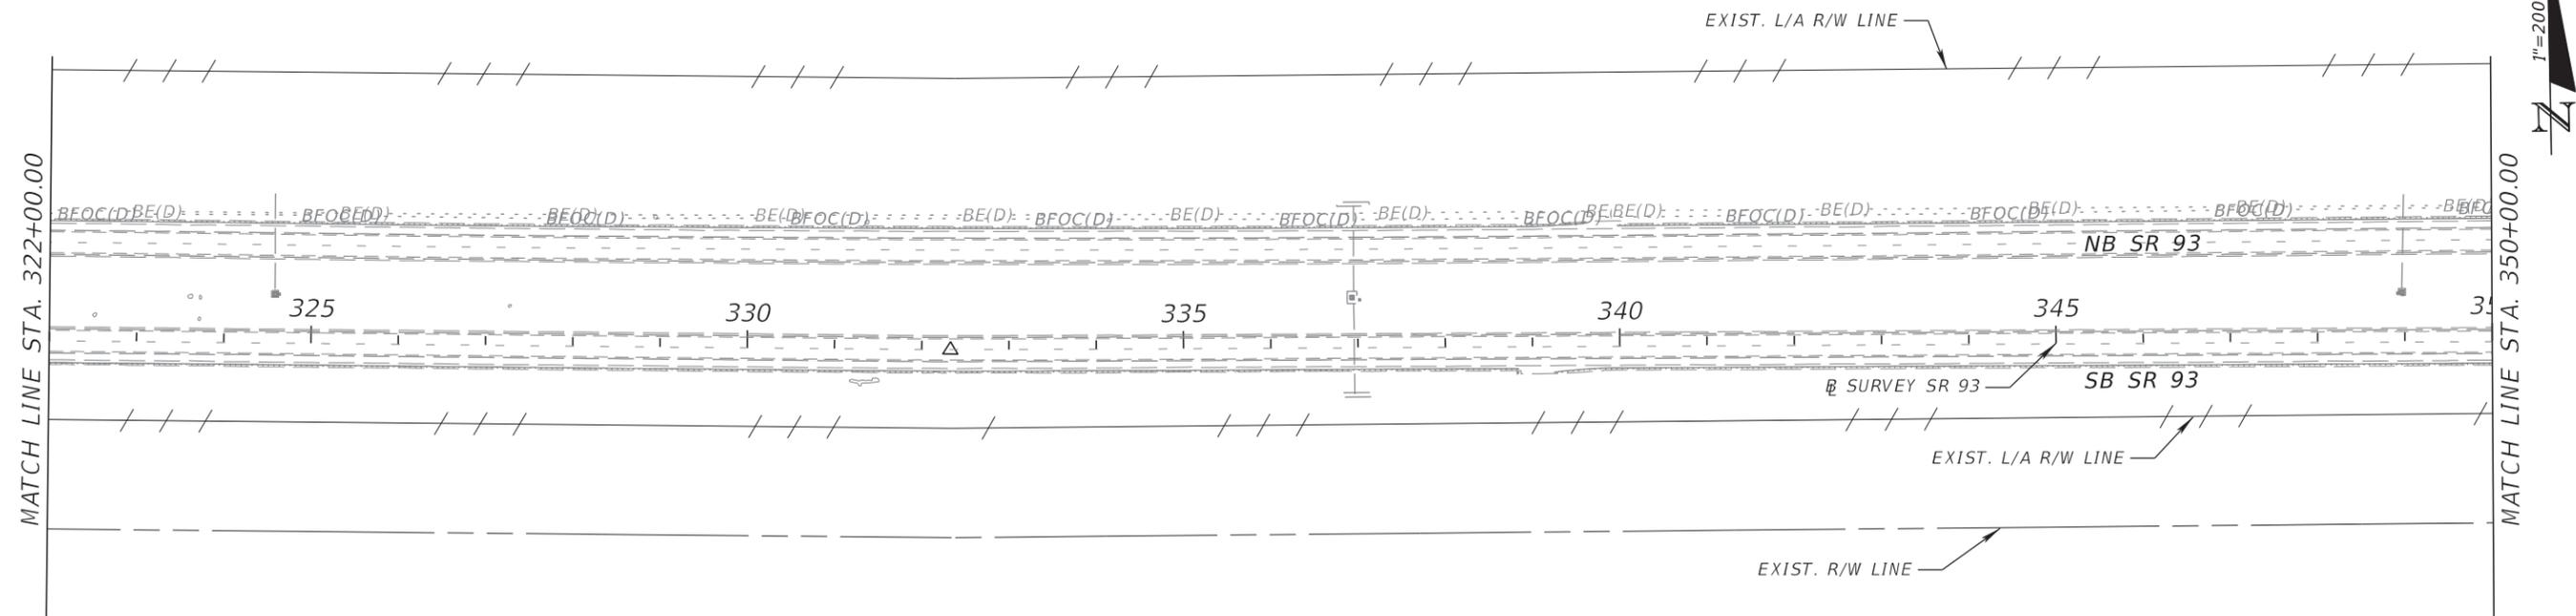


REVISIONS				PATRICIA T. CHRISTIE, P.E. P.E. NO.: 60049 FALLER, DAVIS & ASSOCIATES, INC. 4200 W. CYPRESS ST., SUITE 500 TAMPA, FLORIDA 33607-4168	STATE OF FLORIDA DEPARTMENT OF TRANSPORTATION			SIGNING AND PAVEMENT MARKING PLAN (7)	SHEET NO.
DATE	DESCRIPTION	DATE	DESCRIPTION		ROAD NO.	COUNTY	FINANCIAL PROJECT ID		
					SR 93	COLLIER	444008-3-52-01		S-16

THE OFFICIAL RECORD OF THIS SHEET IS THE ELECTRONIC FILE DIGITALLY SIGNED AND SEALED UNDER RULE 61G15-23.004, F.A.C.

SR 93 (I-75)

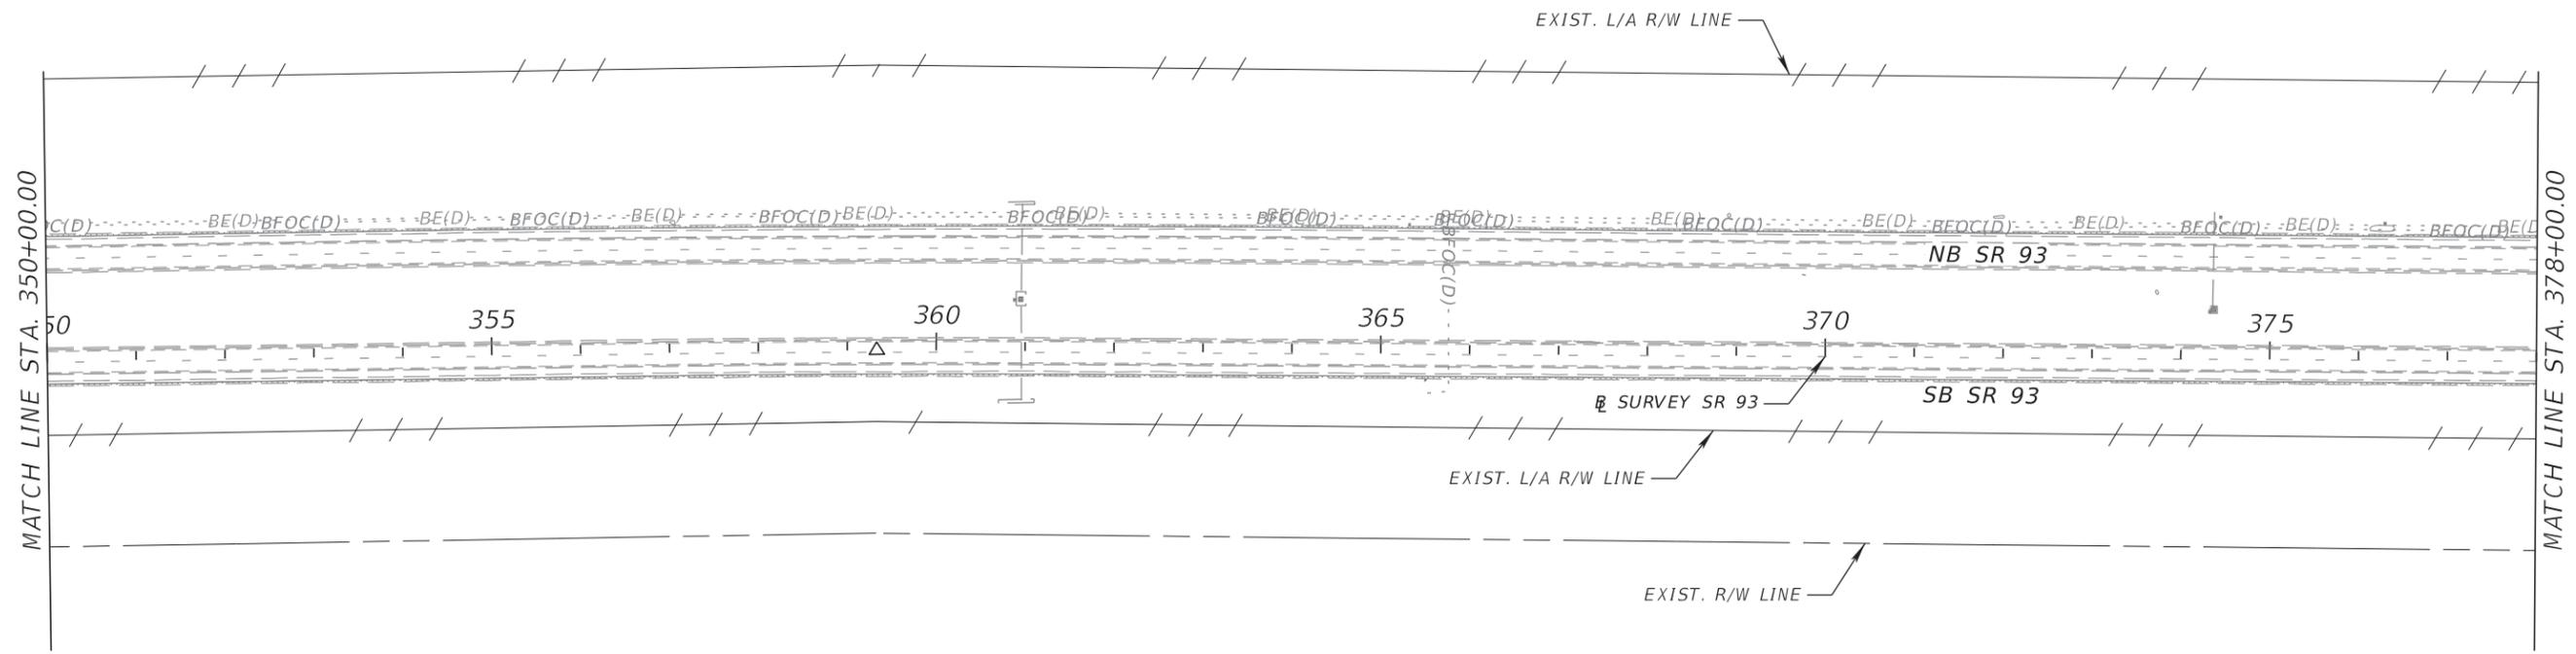


SR 93 (I-75)

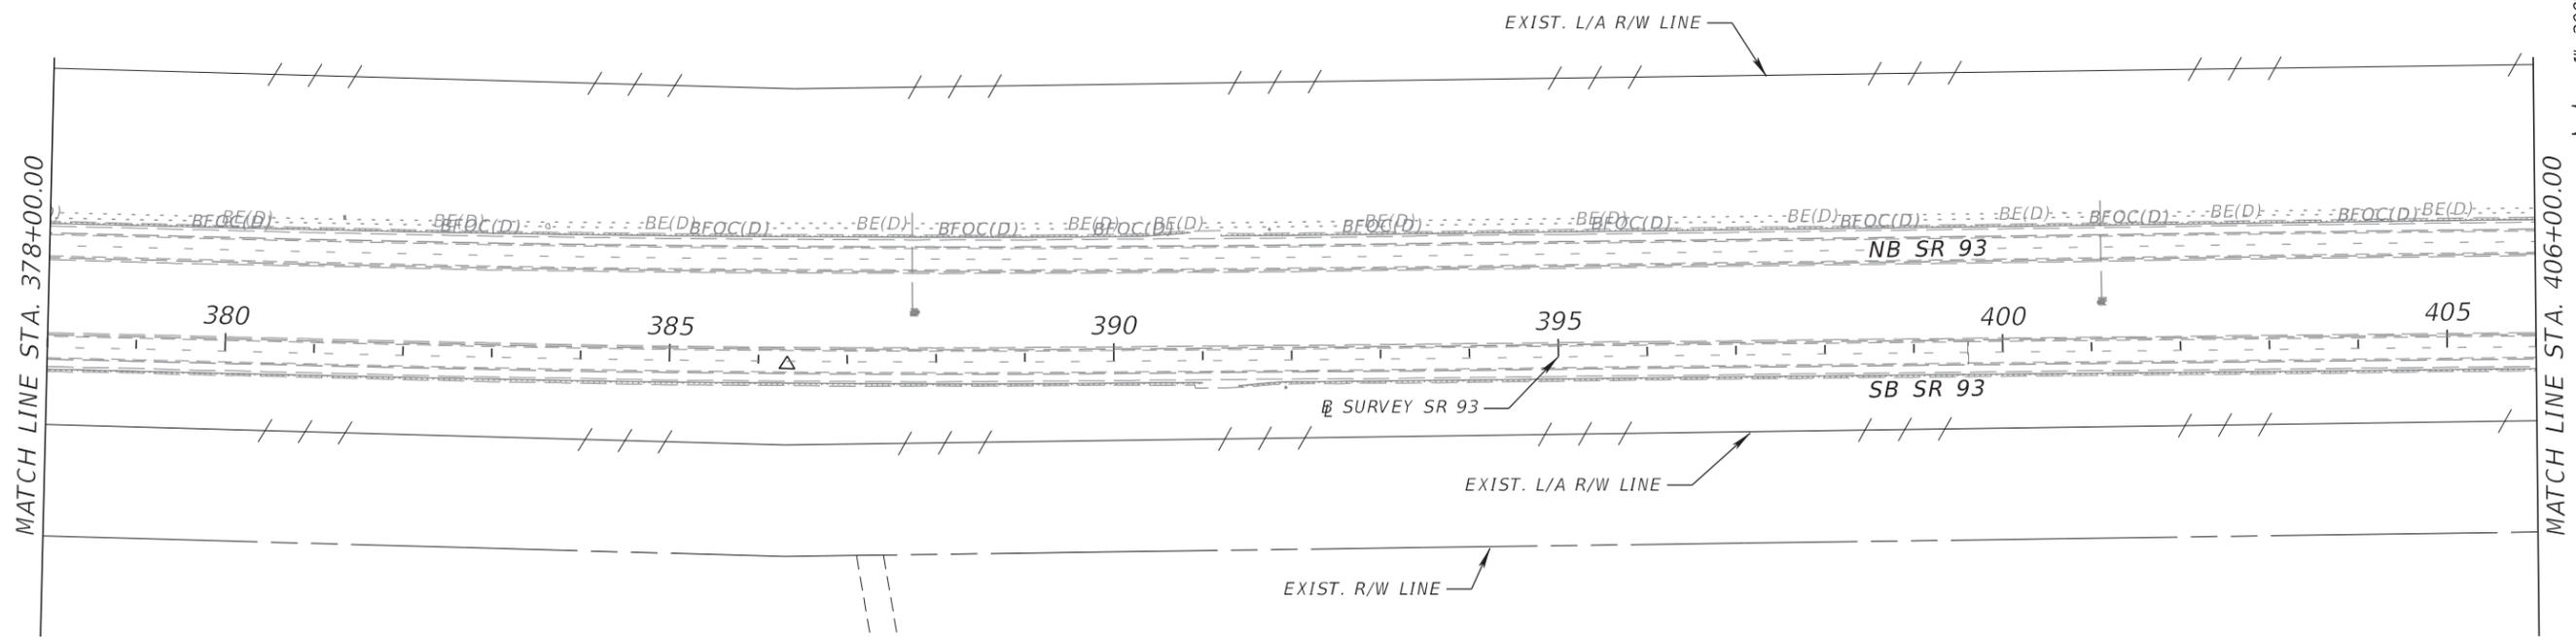


REVISIONS				PATRICIA T. CHRISTIE, P.E. P.E. NO.: 60049 FALLER, DAVIS & ASSOCIATES, INC. 4200 W. CYPRESS ST., SUITE 500 TAMPA, FLORIDA 33607-4168	STATE OF FLORIDA DEPARTMENT OF TRANSPORTATION			SIGNING AND PAVEMENT MARKING PLAN (8)	SHEET NO. S-17
DATE	DESCRIPTION	DATE	DESCRIPTION		ROAD NO.	COUNTY	FINANCIAL PROJECT ID		
					SR 93	COLLIER	444008-3-52-01		

THE OFFICIAL RECORD OF THIS SHEET IS THE ELECTRONIC FILE DIGITALLY SIGNED AND SEALED UNDER RULE 61G15-23.004, F.A.C.

SR 93 (I-75)

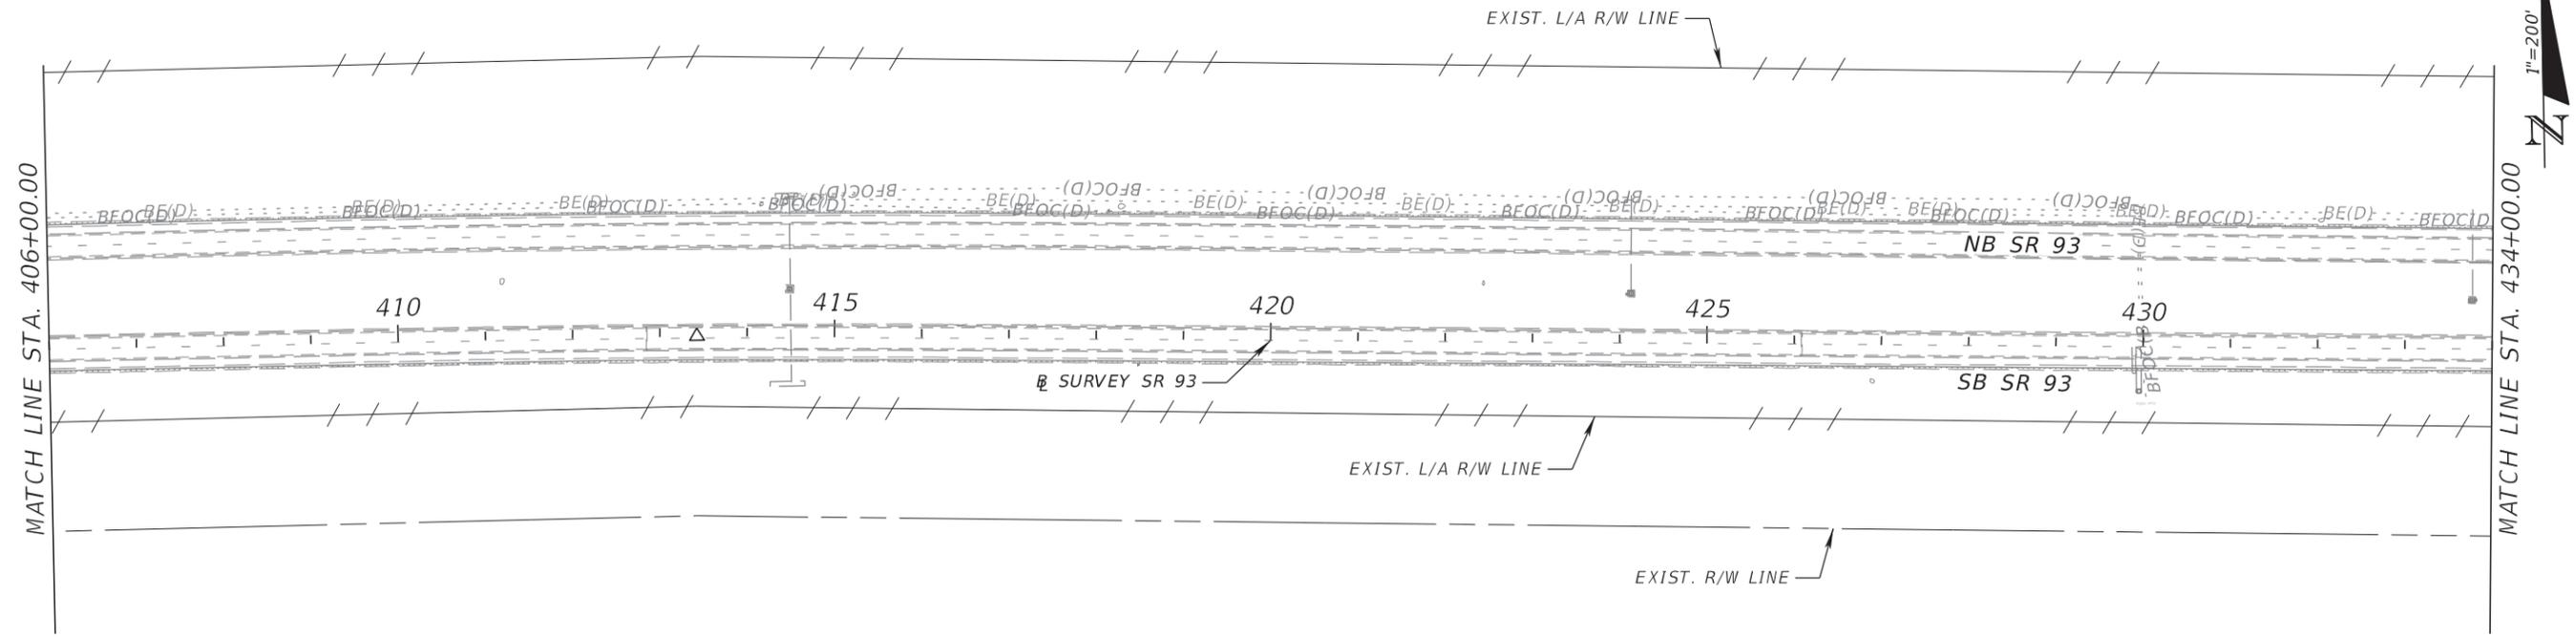


SR 93 (I-75)

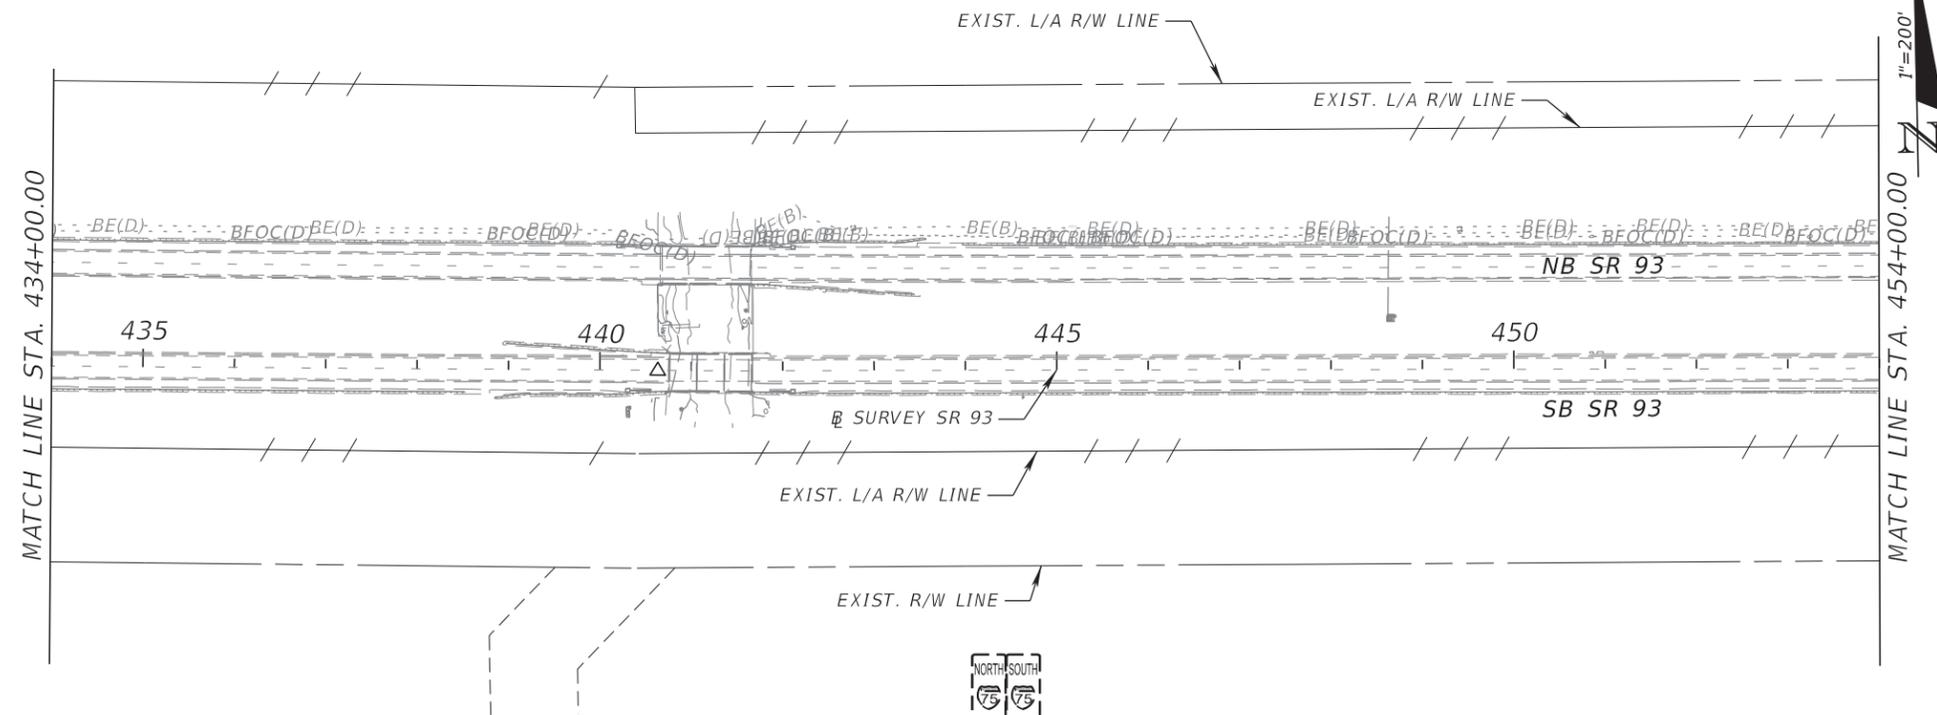


REVISIONS				PATRICIA T. CHRISTIE, P.E. P.E. NO.: 60049 FALLER, DAVIS & ASSOCIATES, INC. 4200 W. CYPRESS ST., SUITE 500 TAMPA, FLORIDA 33607-4168	STATE OF FLORIDA DEPARTMENT OF TRANSPORTATION			SIGNING AND PAVEMENT MARKING PLAN (9)	SHEET NO.
DATE	DESCRIPTION	DATE	DESCRIPTION		ROAD NO.	COUNTY	FINANCIAL PROJECT ID		S-18
					SR 93	COLLIER	444008-3-52-01		

THE OFFICIAL RECORD OF THIS SHEET IS THE ELECTRONIC FILE DIGITALLY SIGNED AND SEALED UNDER RULE 61G15-23.004, F.A.C.

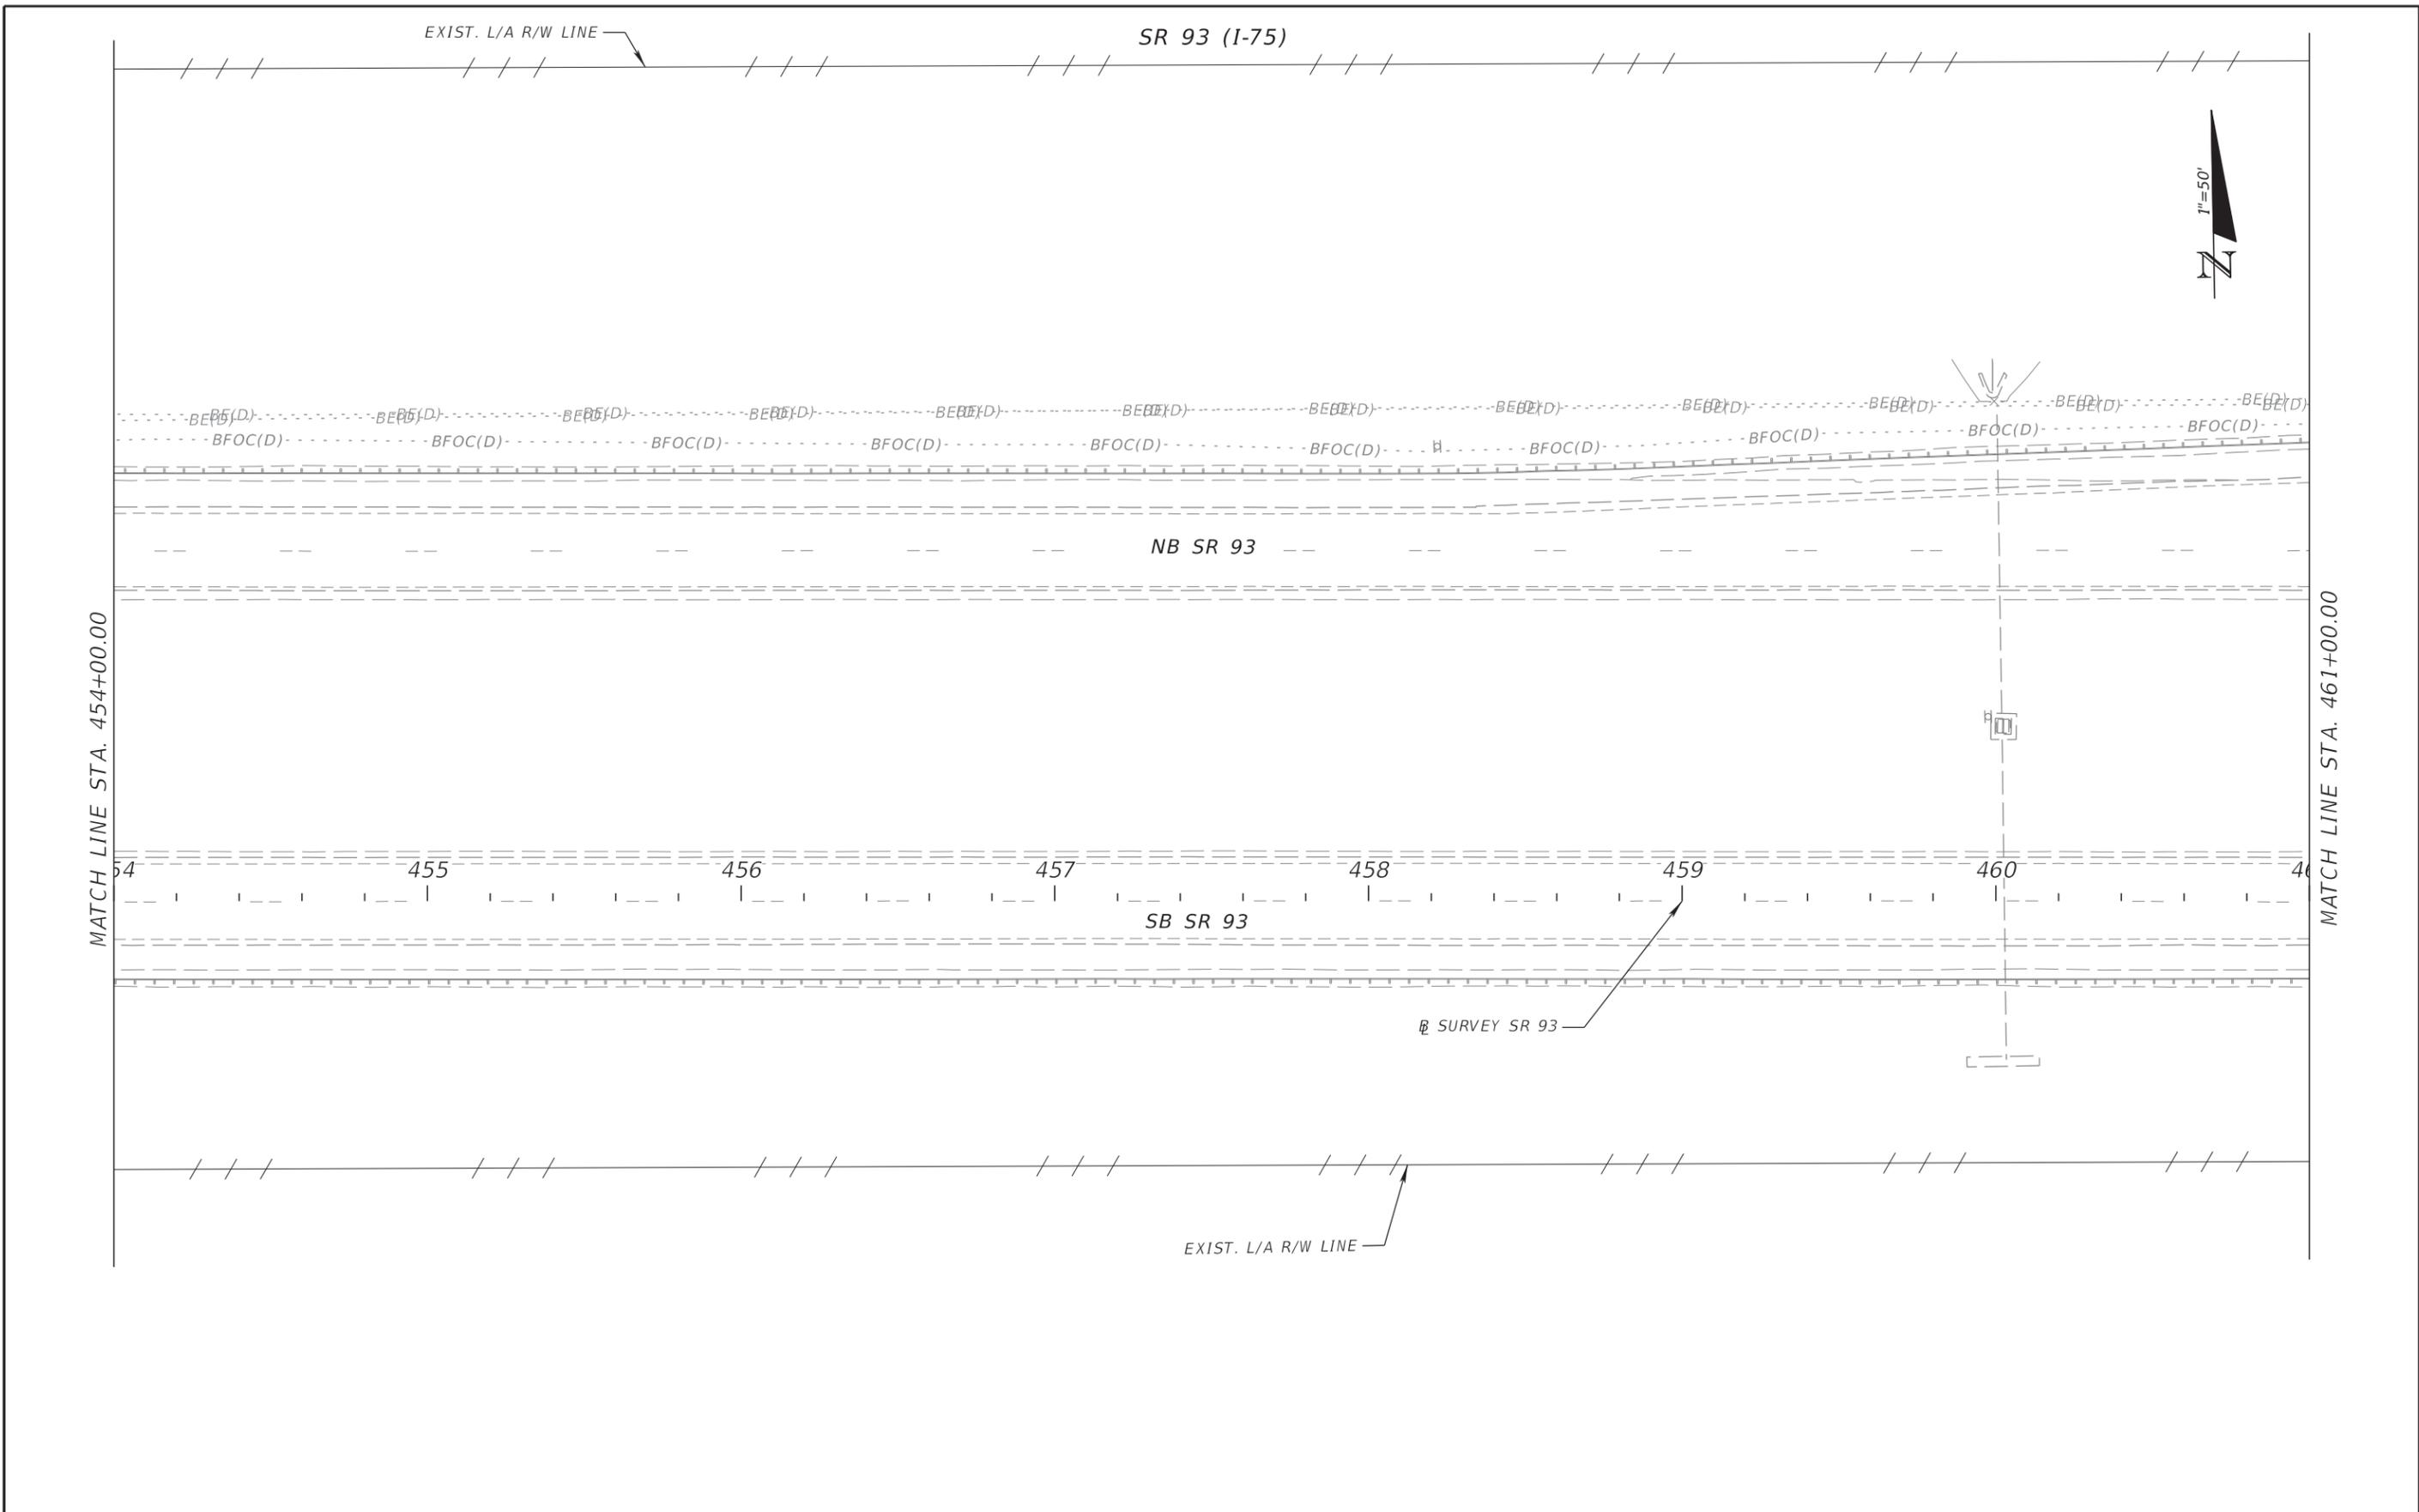

THE OFFICIAL RECORD OF THIS SHEET IS THE ELECTRONIC FILE DIGITALLY SIGNED AND SEALED UNDER RULE 61G15-23.004, F.A.C.

REVISIONS				PATRICIA T. CHRISTIE, P.E. P.E. NO.: 60049 FALLER, DAVIS & ASSOCIATES, INC. 4200 W. CYPRESS ST., SUITE 500 TAMPA, FLORIDA 33607-4168	STATE OF FLORIDA DEPARTMENT OF TRANSPORTATION			SIGNING AND PAVEMENT MARKING PLAN (10)	SHEET NO.
DATE	DESCRIPTION	DATE	DESCRIPTION		ROAD NO.	COUNTY	FINANCIAL PROJECT ID		S-19
					SR 93	COLLIER	444008-3-52-01		

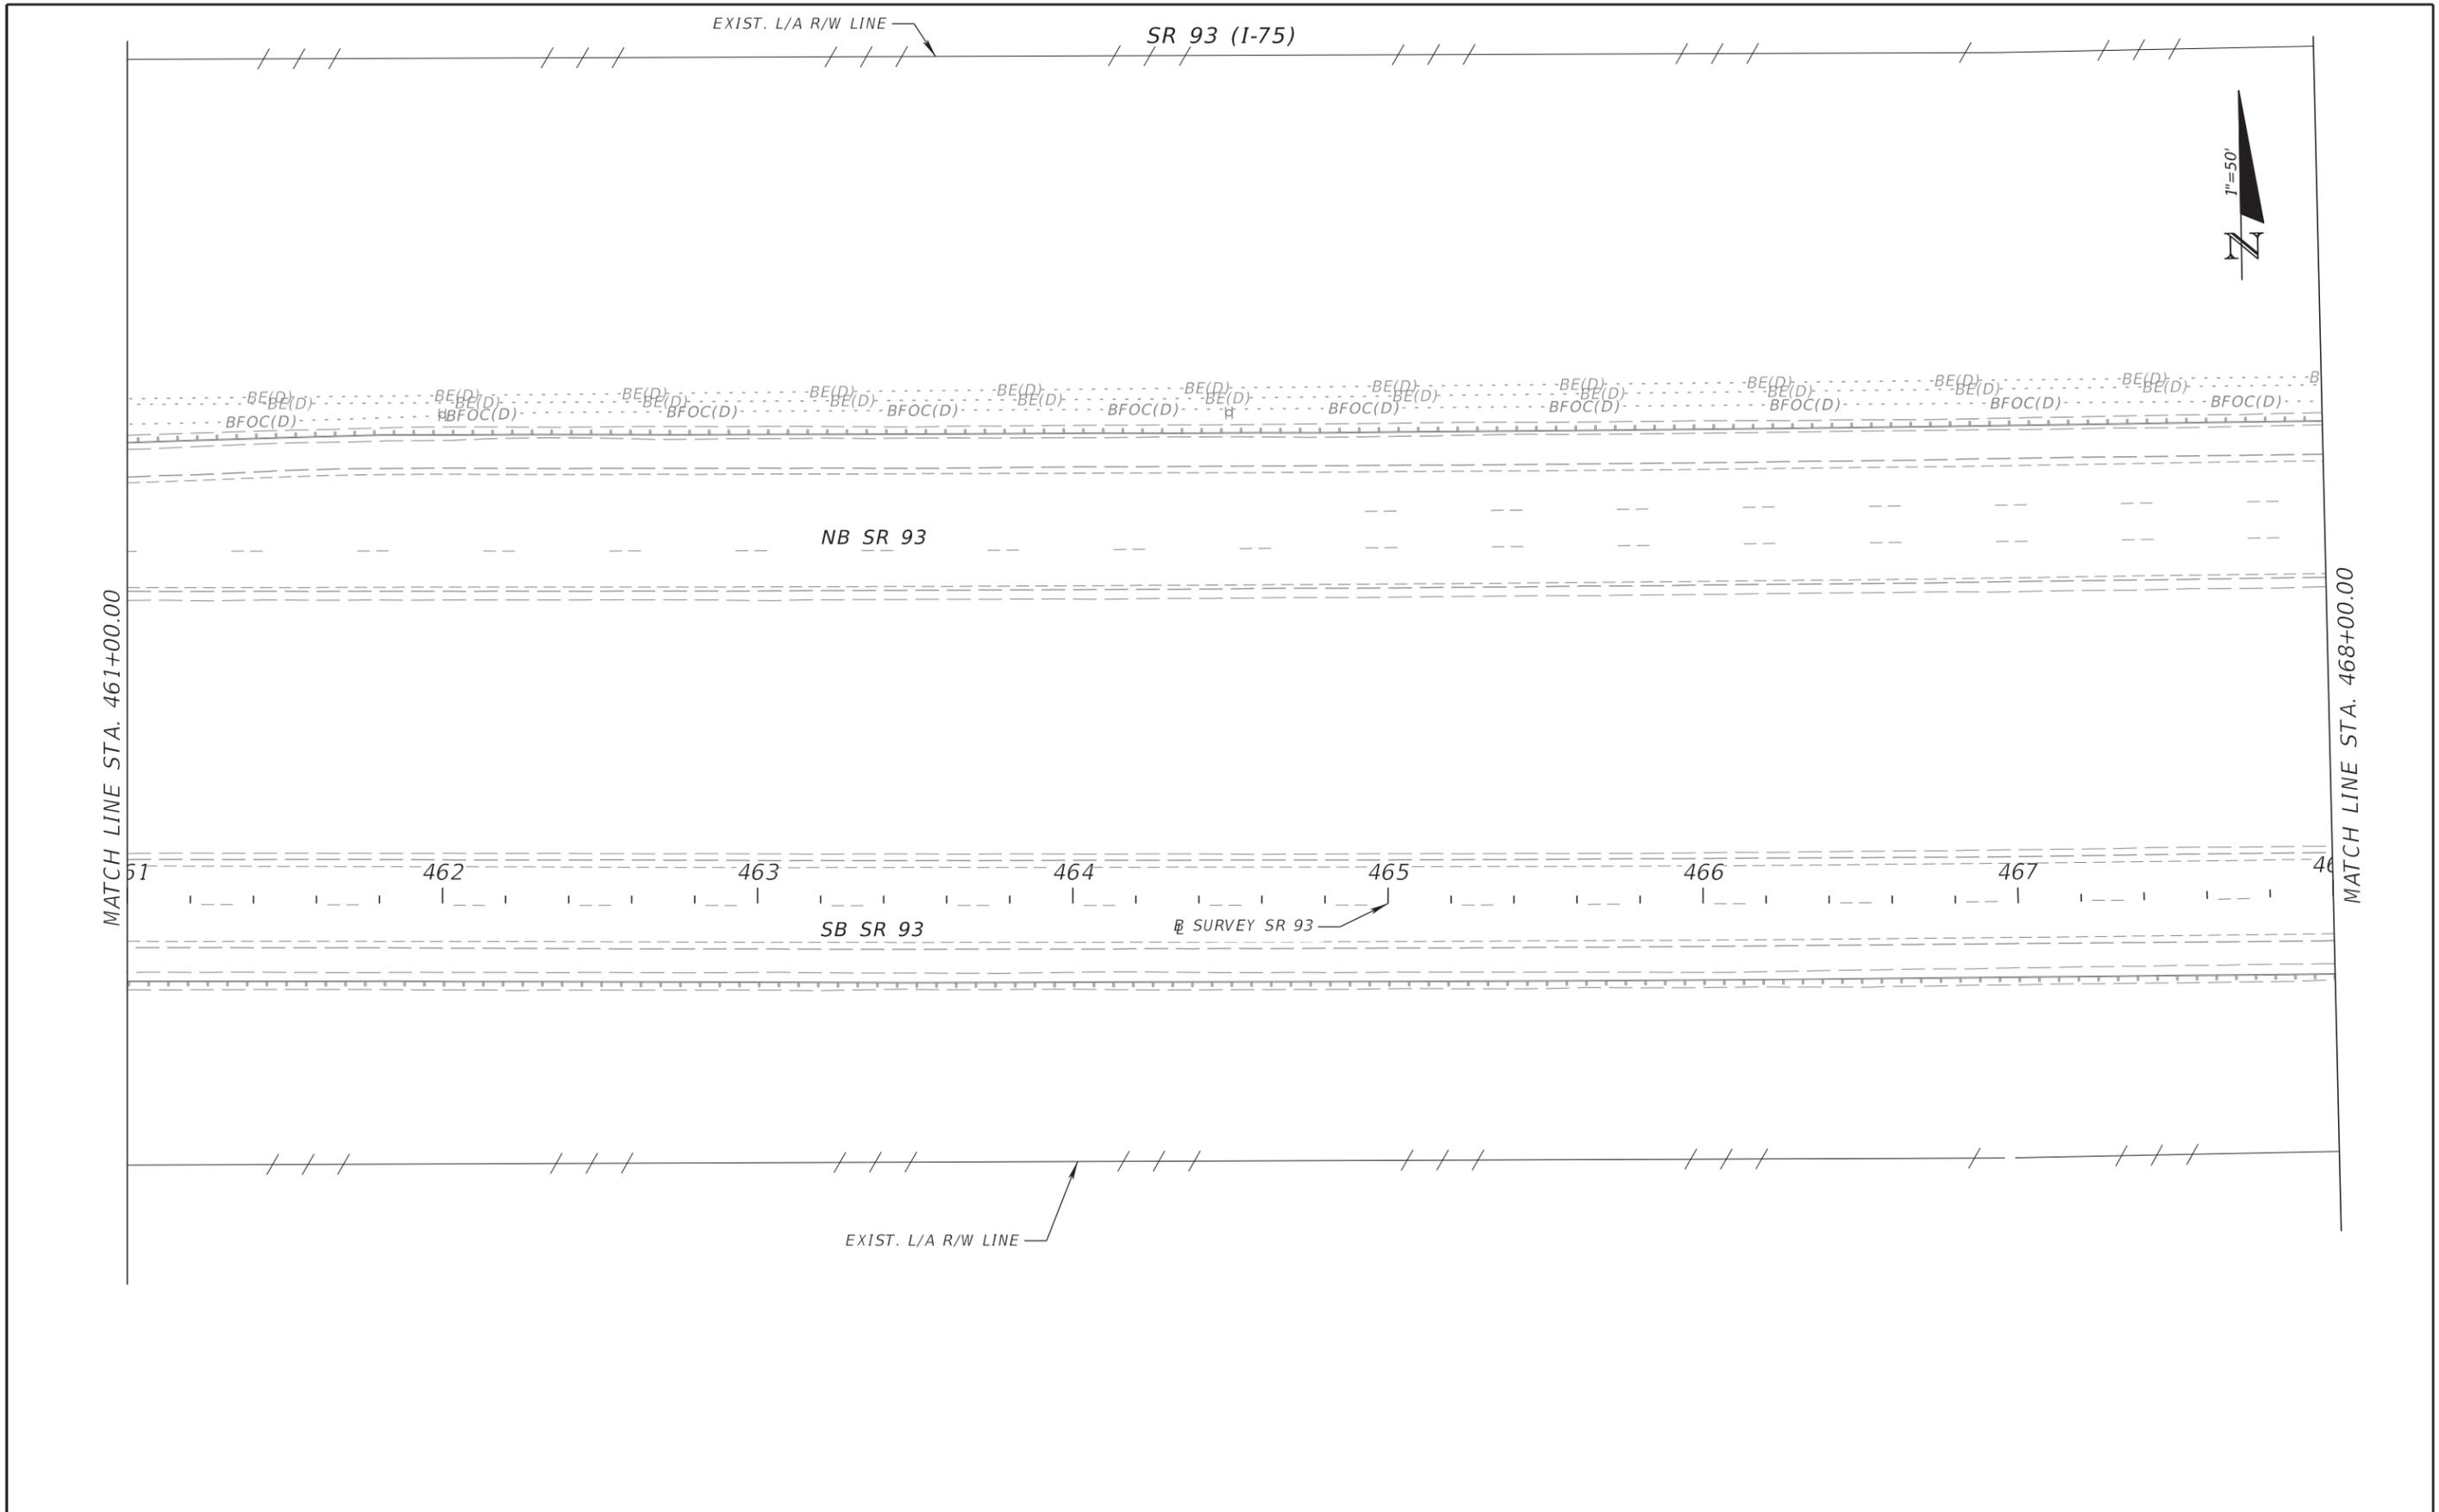


THE OFFICIAL RECORD OF THIS SHEET IS THE ELECTRONIC FILE DIGITALLY SIGNED AND SEALED UNDER RULE 61G15-23.004, F.A.C.


REVISIONS				PATRICIA T. CHRISTIE, P.E. P.E. NO.: 60049 FALLER, DAVIS & ASSOCIATES, INC. 4200 W. CYPRESS ST., SUITE 500 TAMPA, FLORIDA 33607-4168	STATE OF FLORIDA DEPARTMENT OF TRANSPORTATION			SIGNING AND PAVEMENT MARKING PLAN (11)	SHEET NO.
DATE	DESCRIPTION	DATE	DESCRIPTION		ROAD NO.	COUNTY	FINANCIAL PROJECT ID		S-20
					SR 93	COLLIER	444008-3-52-01		

SR 93 (I-75)

EXIST. L/A R/W LINE

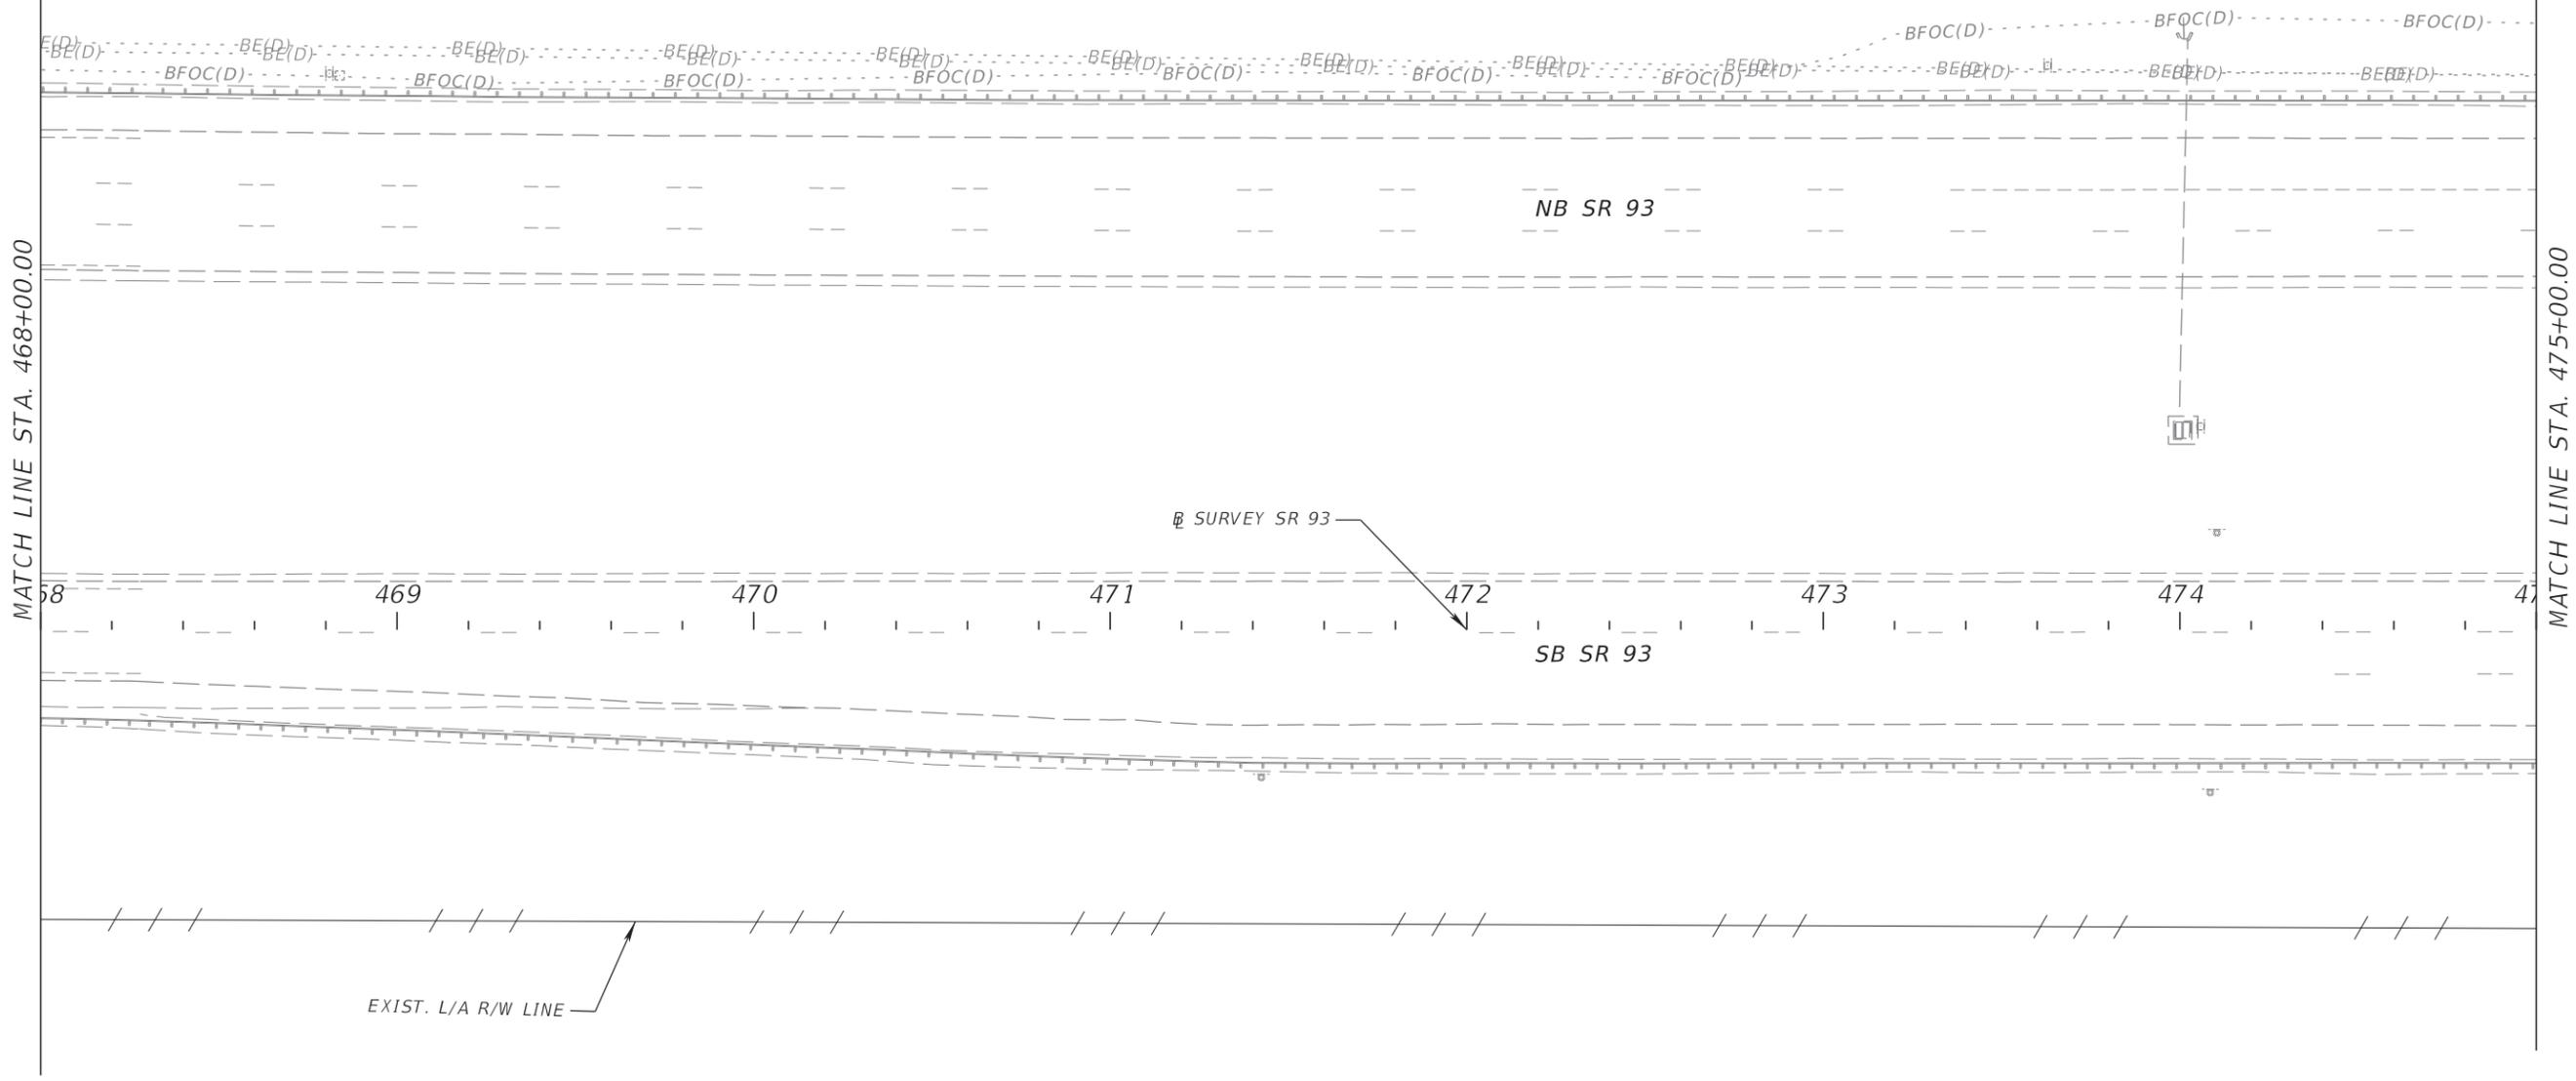


REVISIONS				PATRICIA T. CHRISTIE, P.E. P.E. NO.: 60049 FALLER, DAVIS & ASSOCIATES, INC. 4200 W. CYPRESS ST., SUITE 500 TAMPA, FLORIDA 33607-4168	STATE OF FLORIDA DEPARTMENT OF TRANSPORTATION			SIGNING AND PAVEMENT MARKING PLAN (12)	SHEET NO.
DATE	DESCRIPTION	DATE	DESCRIPTION		ROAD NO.	COUNTY	FINANCIAL PROJECT ID		
					SR 93	COLLIER	444008-3-52-01		S-21

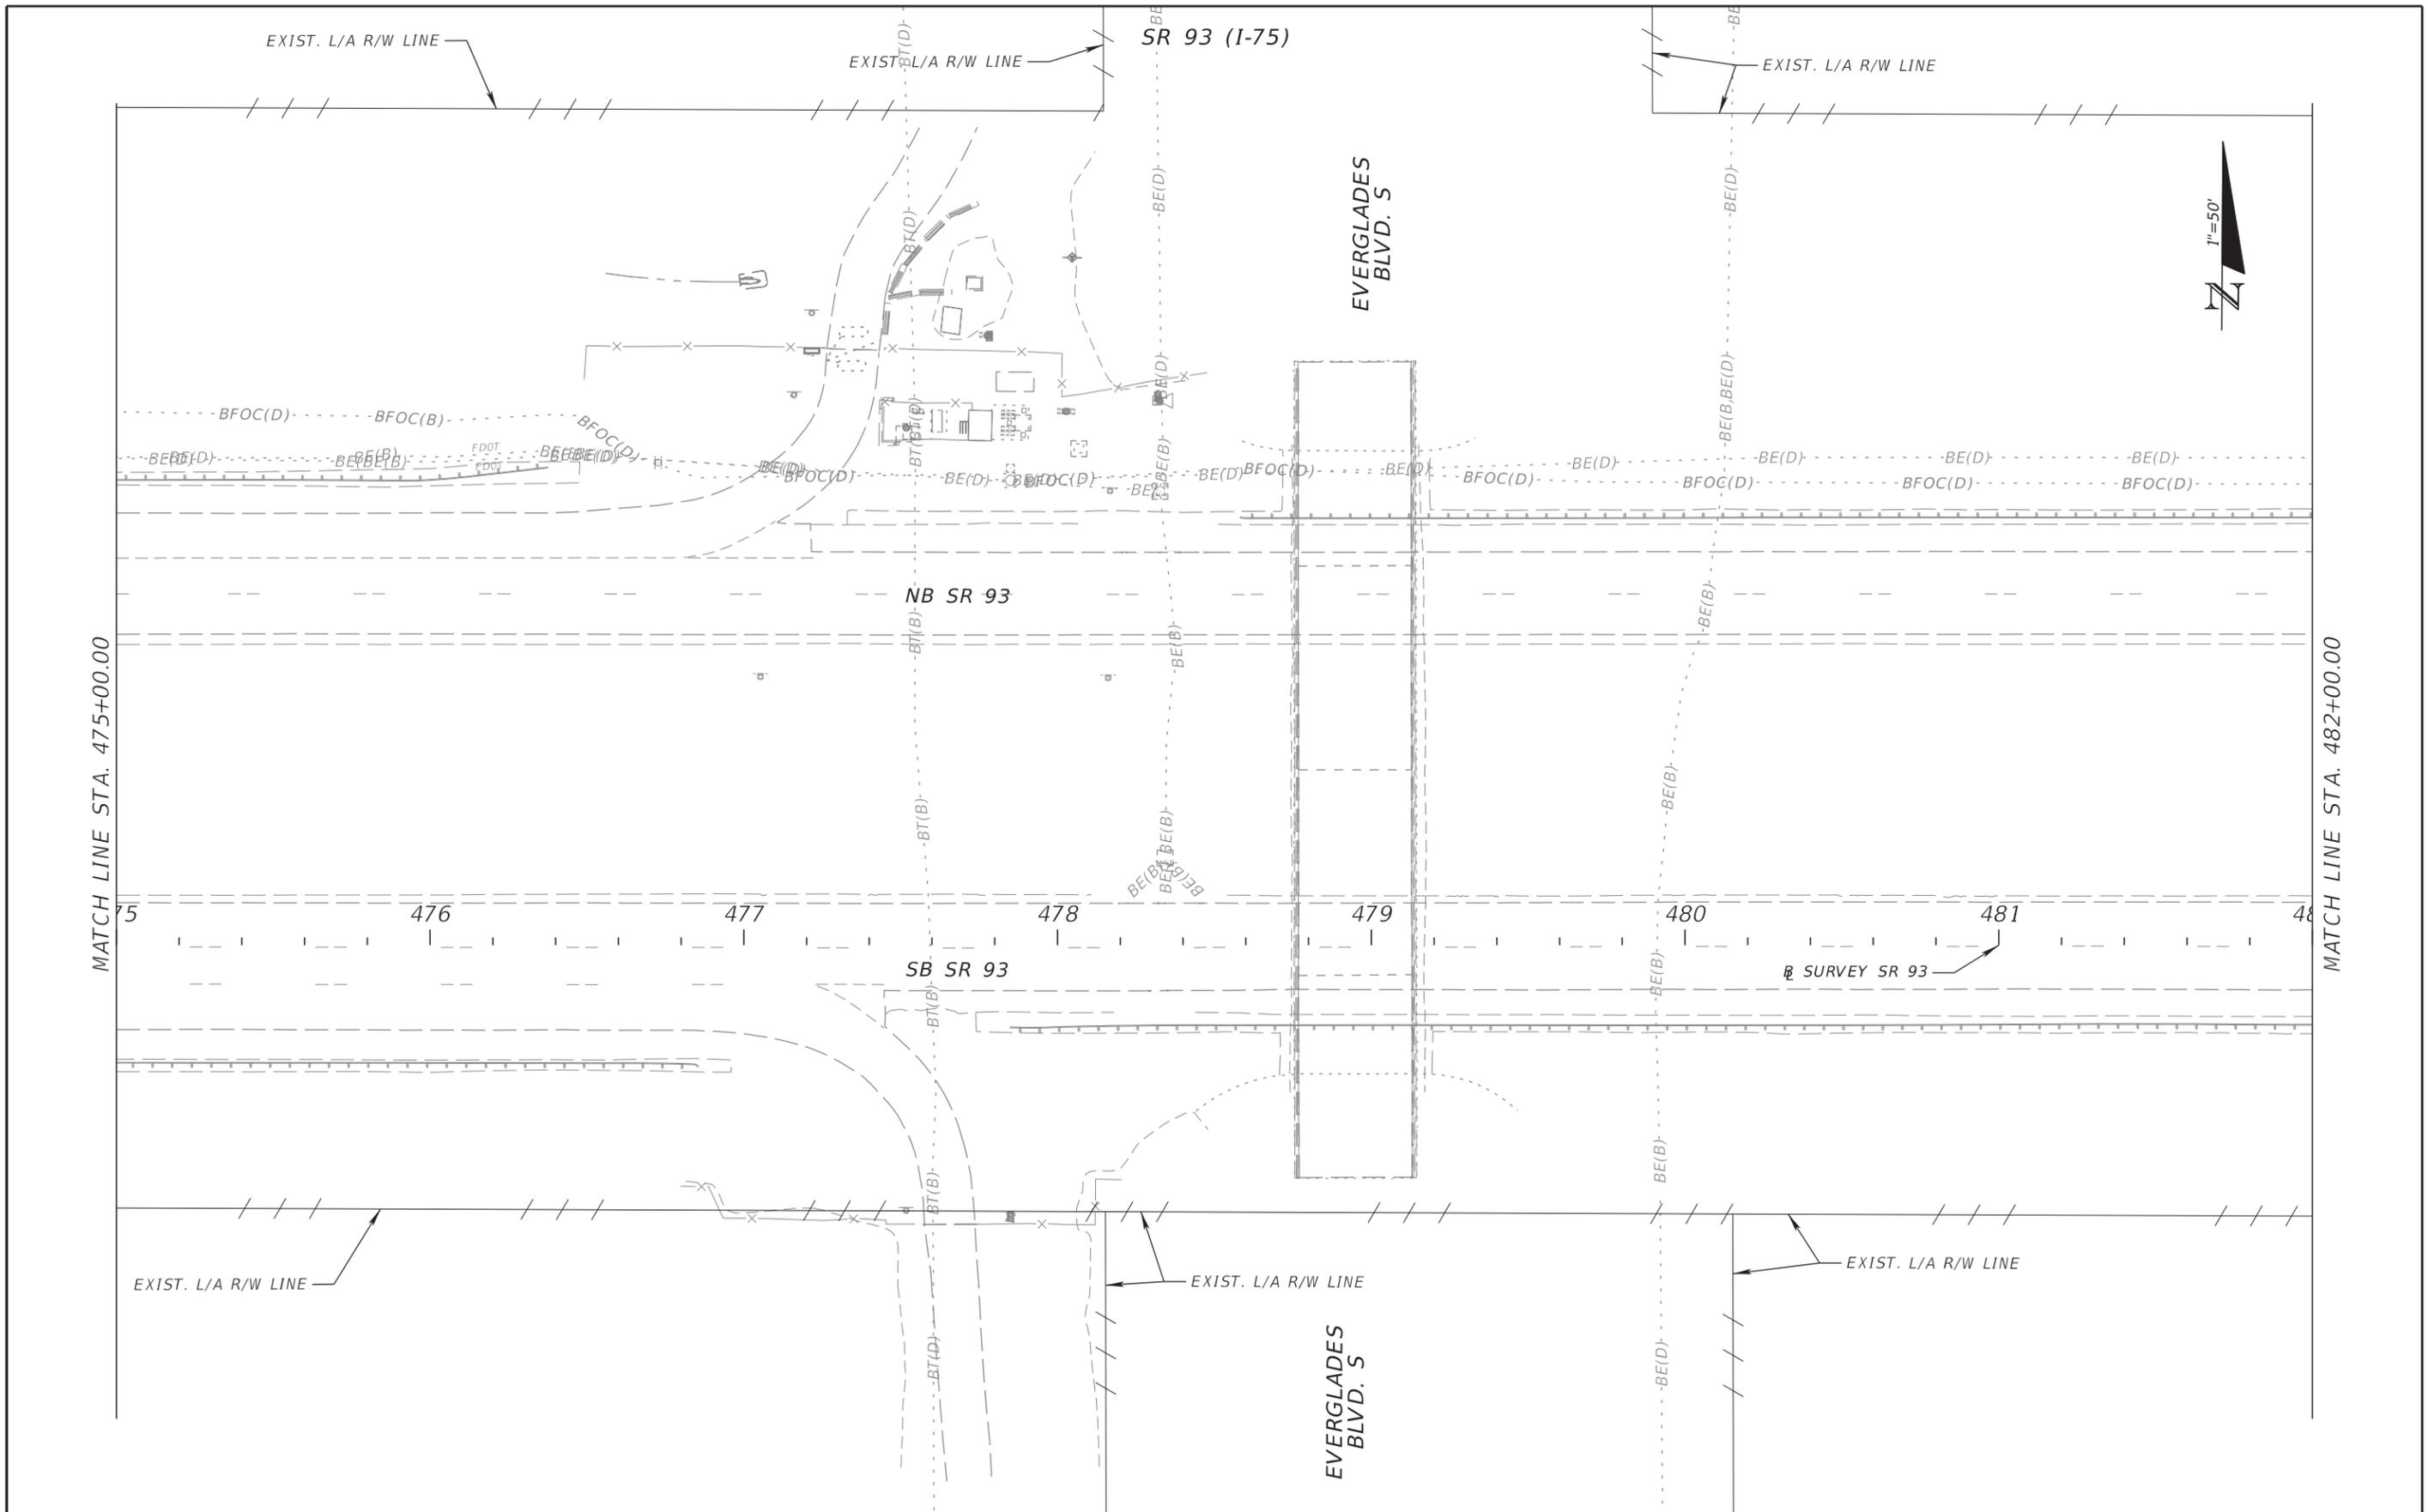


THE OFFICIAL RECORD OF THIS SHEET IS THE ELECTRONIC FILE DIGITALLY SIGNED AND SEALED UNDER RULE 61G15-23.004, F.A.C.

REVISIONS				PATRICIA T. CHRISTIE, P.E. P.E. NO.: 60049 FALLER, DAVIS & ASSOCIATES, INC. 4200 W. CYPRESS ST., SUITE 500 TAMPA, FLORIDA 33607-4168	STATE OF FLORIDA DEPARTMENT OF TRANSPORTATION			SIGNING AND PAVEMENT MARKING PLAN (13)	SHEET NO.
DATE	DESCRIPTION	DATE	DESCRIPTION		ROAD NO.	COUNTY	FINANCIAL PROJECT ID		S-22
					SR 93	COLLIER	444008-3-52-01		



SR 93 (I-75)

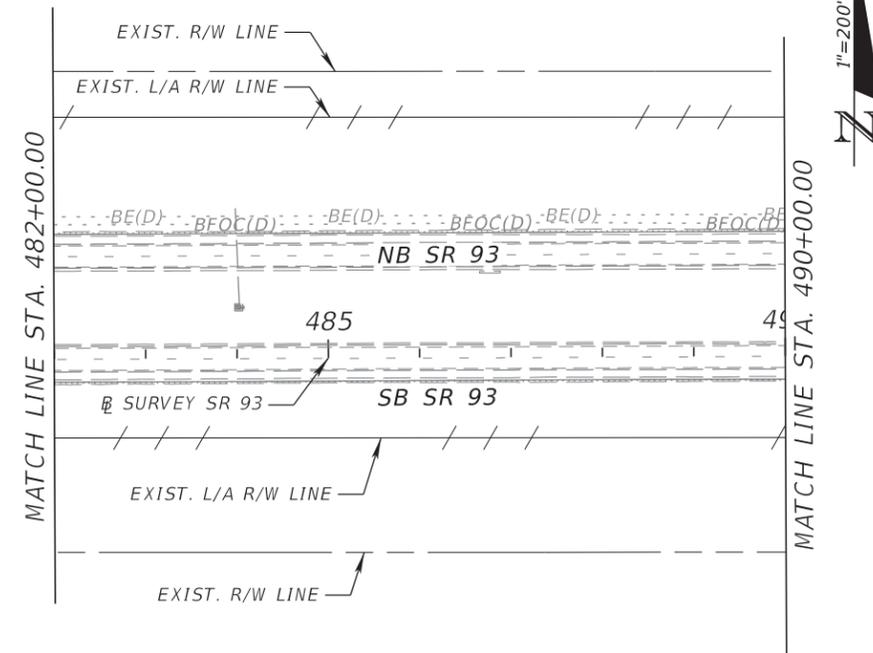

SR 93 (I-75)


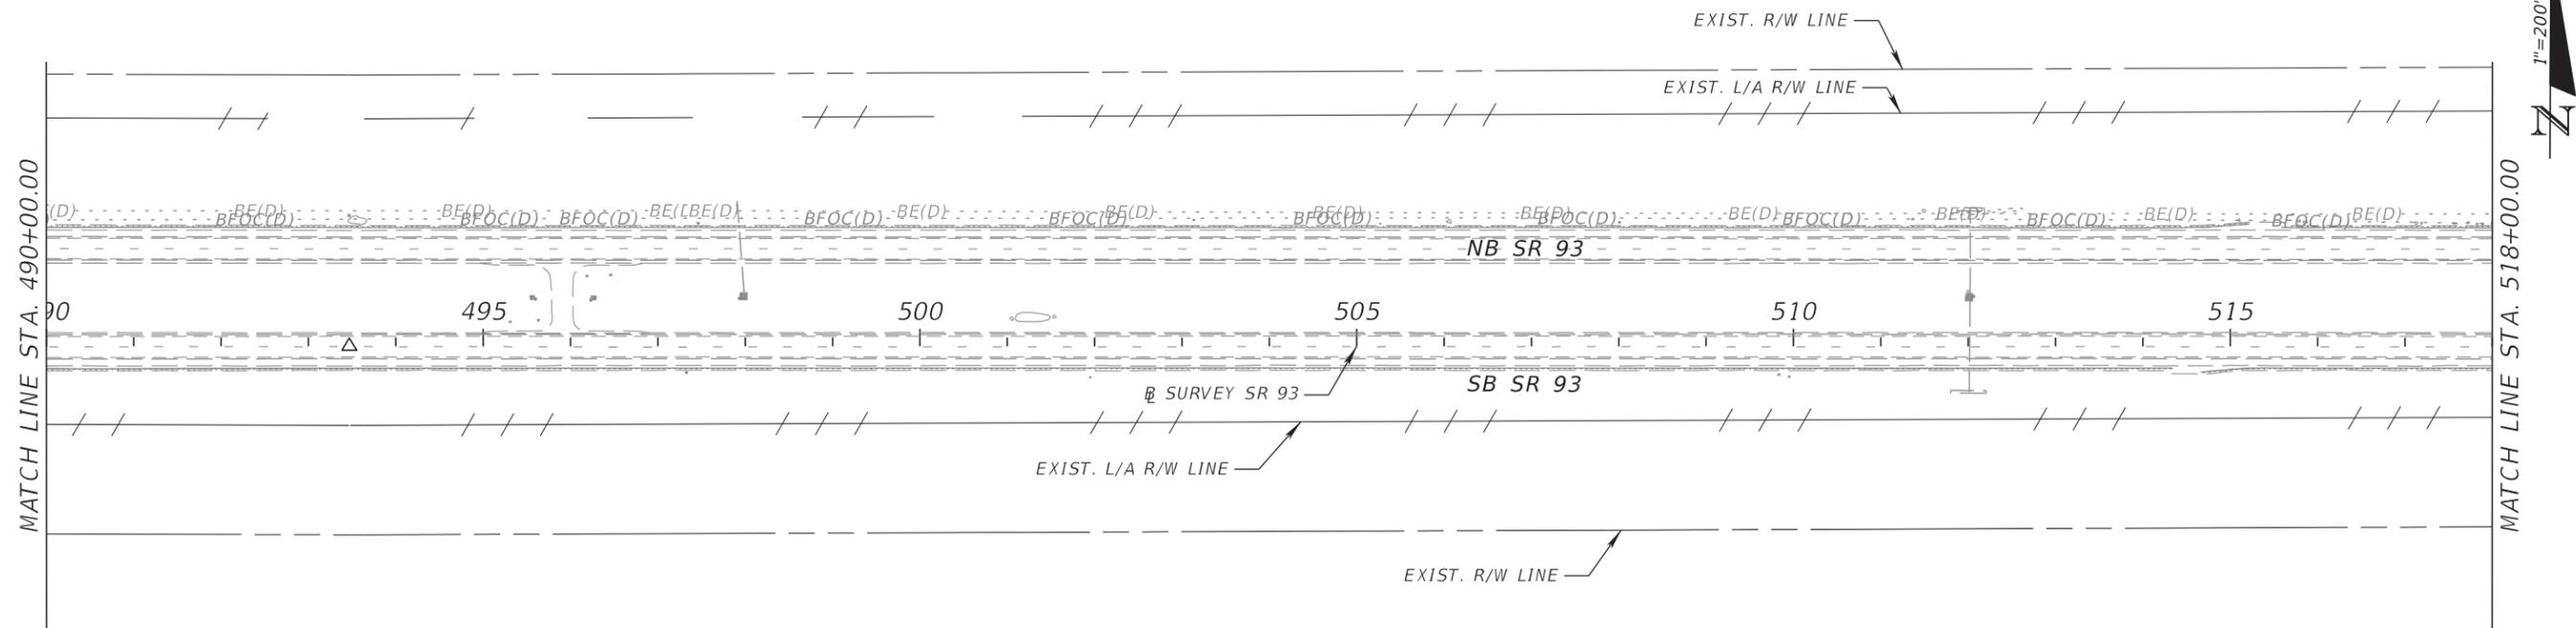


REVISIONS				PATRICIA T. CHRISTIE, P.E. P.E. NO.: 60049 FALLER, DAVIS & ASSOCIATES, INC. 4200 W. CYPRESS ST., SUITE 500 TAMPA, FLORIDA 33607-4168	STATE OF FLORIDA DEPARTMENT OF TRANSPORTATION			SIGNING AND PAVEMENT MARKING PLAN (14)	SHEET NO.
DATE	DESCRIPTION	DATE	DESCRIPTION		ROAD NO.	COUNTY	FINANCIAL PROJECT ID		
					SR 93	COLLIER	444008-3-52-01		S-23

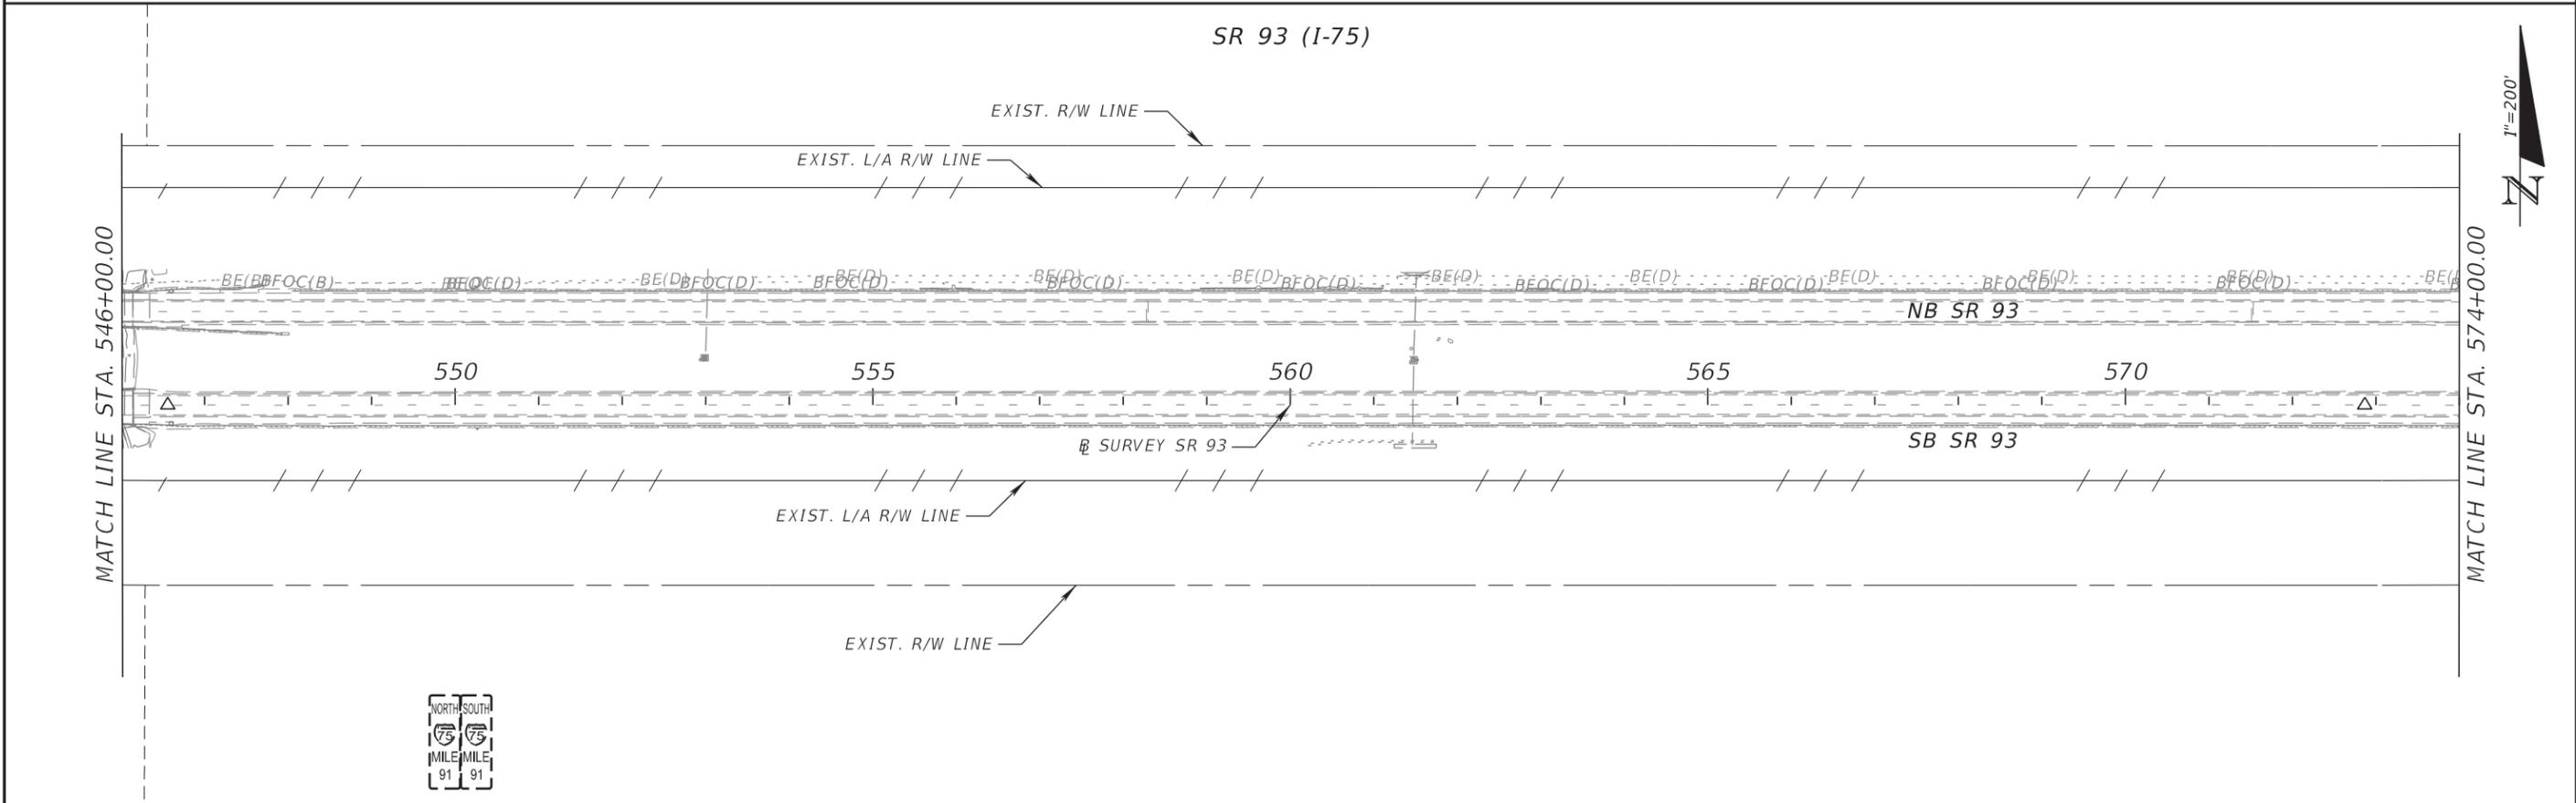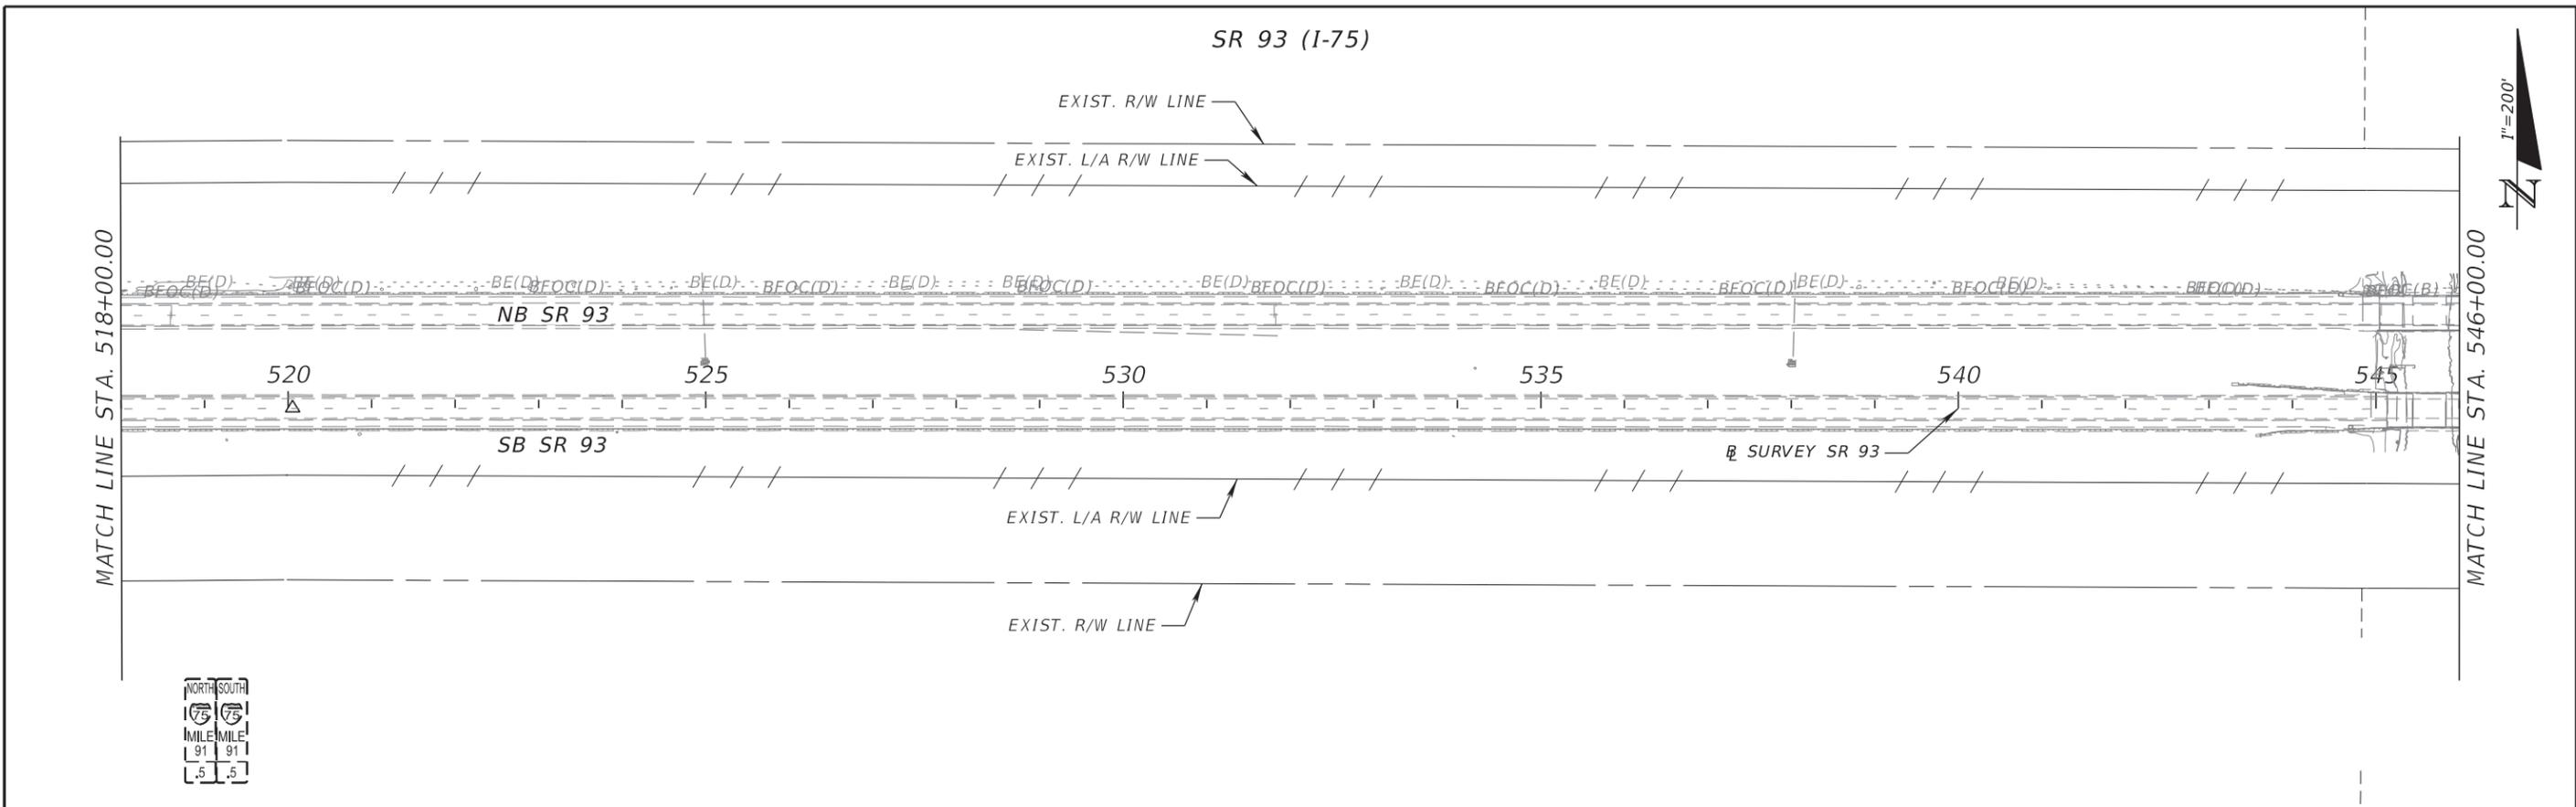

REVISIONS				PATRICIA T. CHRISTIE, P.E. P.E. NO.: 60049 FALLER, DAVIS & ASSOCIATES, INC. 4200 W. CYPRESS ST., SUITE 500 TAMPA, FLORIDA 33607-4168	STATE OF FLORIDA DEPARTMENT OF TRANSPORTATION			SIGNING AND PAVEMENT MARKING PLAN (15)	SHEET NO. S-24
DATE	DESCRIPTION	DATE	DESCRIPTION		ROAD NO.	COUNTY	FINANCIAL PROJECT ID		
					SR 93	COLLIER	444008-3-52-01		


THE OFFICIAL RECORD OF THIS SHEET IS THE ELECTRONIC FILE DIGITALLY SIGNED AND SEALED UNDER RULE 61G15-23.004, F.A.C.

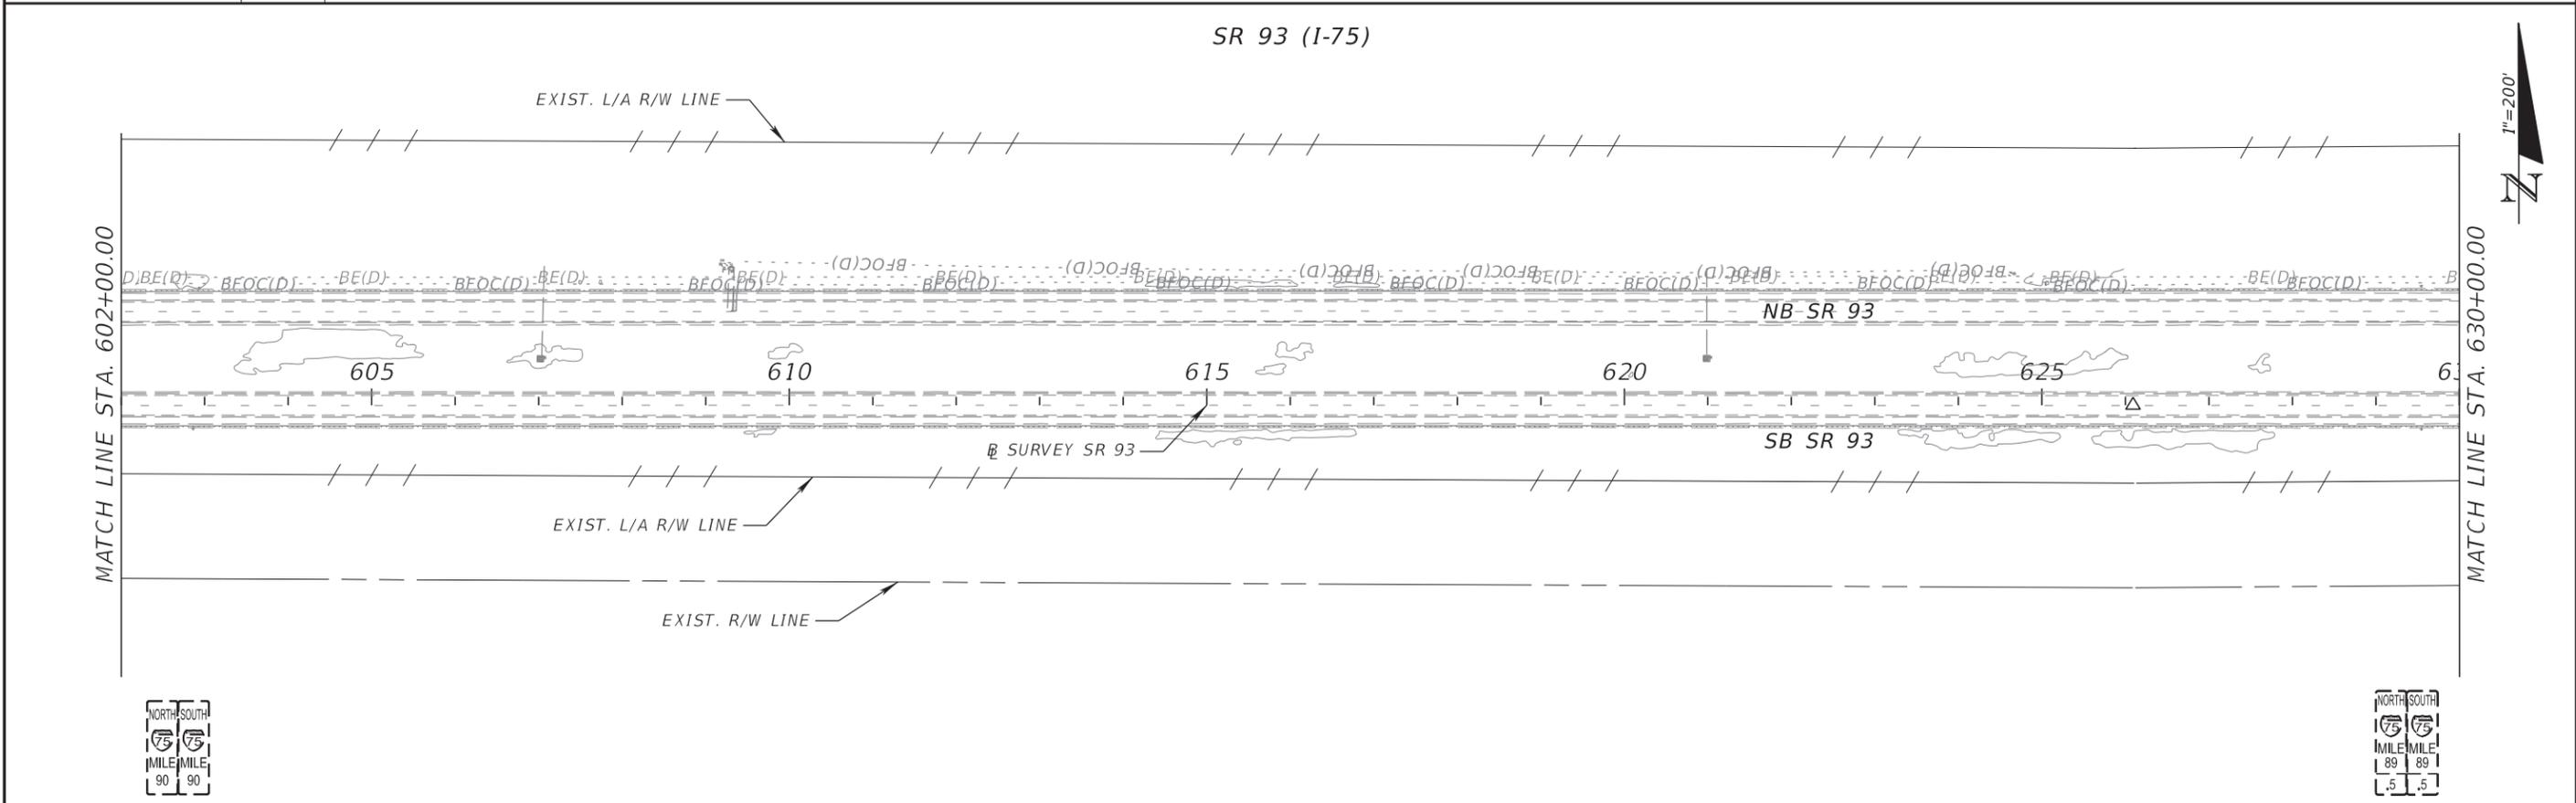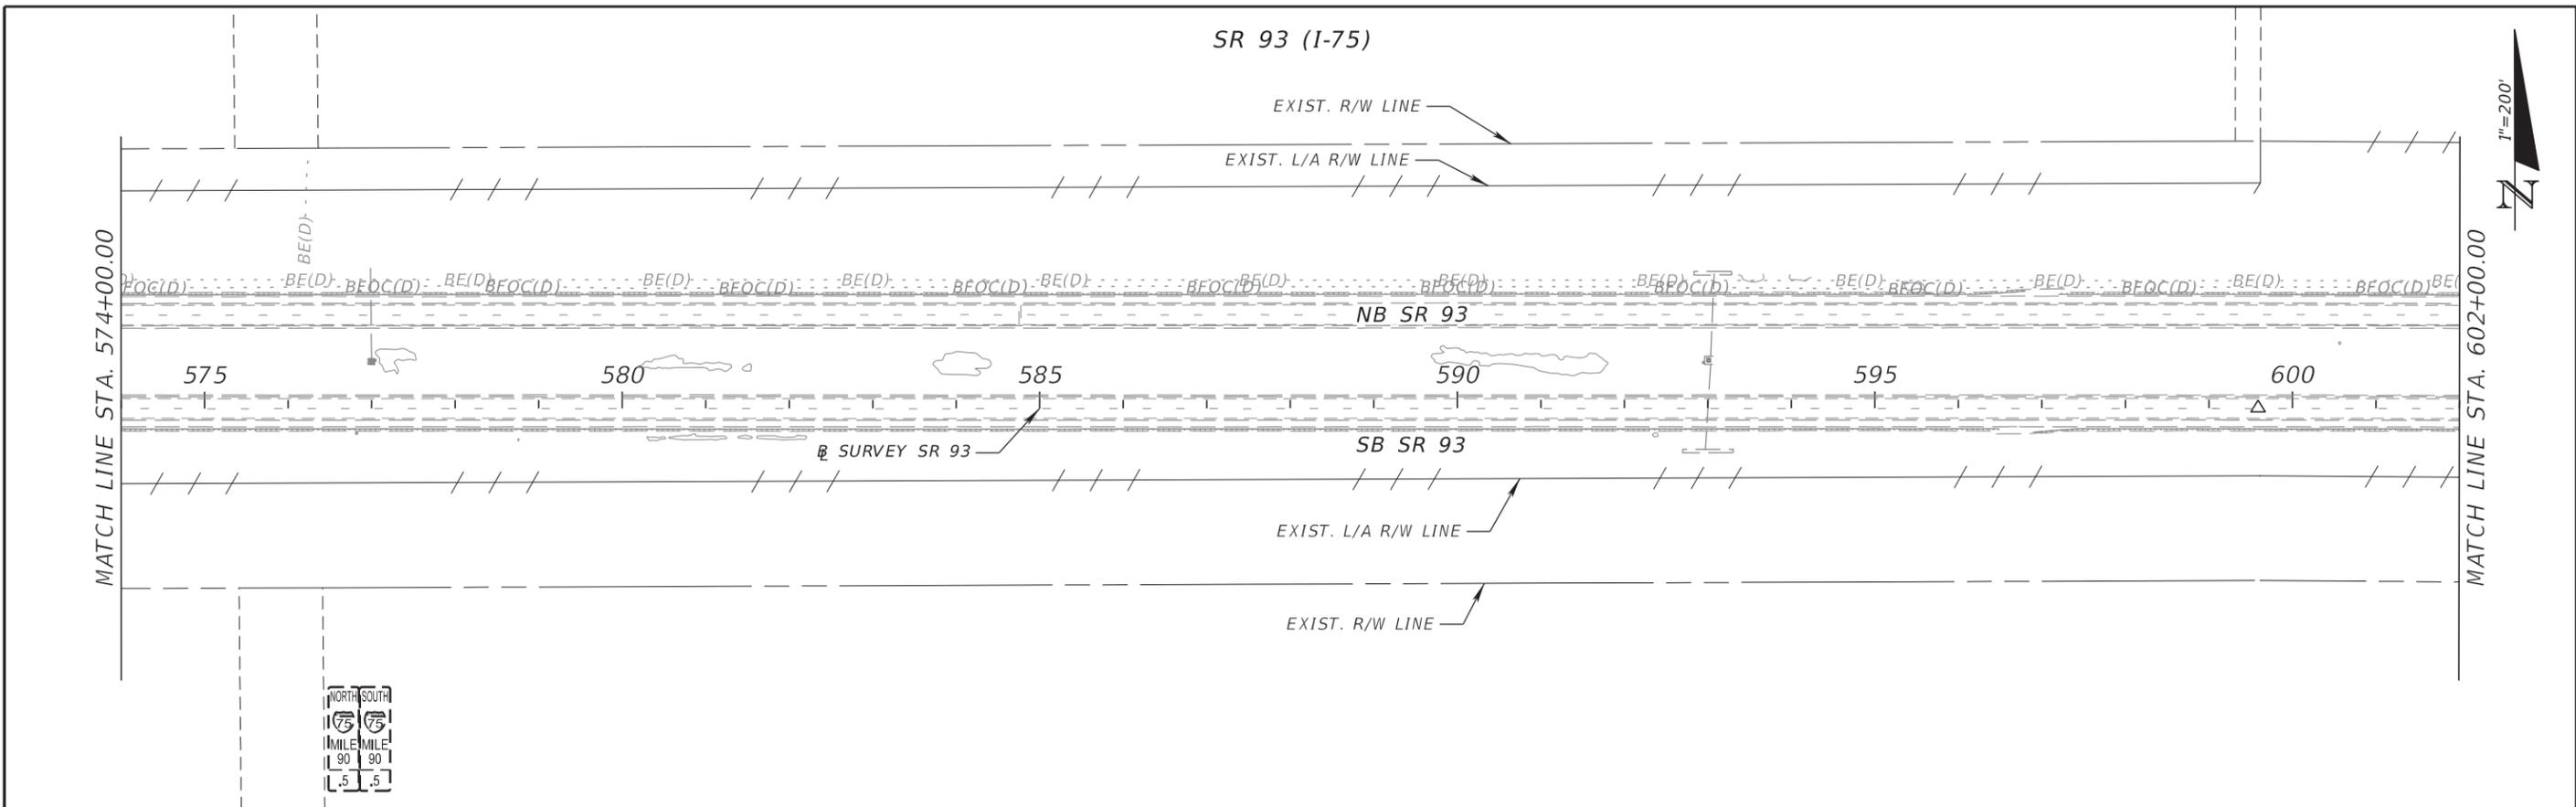


REVISIONS				PATRICIA T. CHRISTIE, P.E. P.E. NO.: 60049 FALLER, DAVIS & ASSOCIATES, INC. 4200 W. CYPRESS ST., SUITE 500 TAMPA, FLORIDA 33607-4168	STATE OF FLORIDA DEPARTMENT OF TRANSPORTATION			SIGNING AND PAVEMENT MARKING PLAN (16)	SHEET NO. S-25
DATE	DESCRIPTION	DATE	DESCRIPTION		ROAD NO.	COUNTY	FINANCIAL PROJECT ID		
					SR 93	COLLIER	444008-3-52-01		

THE OFFICIAL RECORD OF THIS SHEET IS THE ELECTRONIC FILE DIGITALLY SIGNED AND SEALED UNDER RULE 61G15-23.004, F.A.C.

SR 93 (I-75)

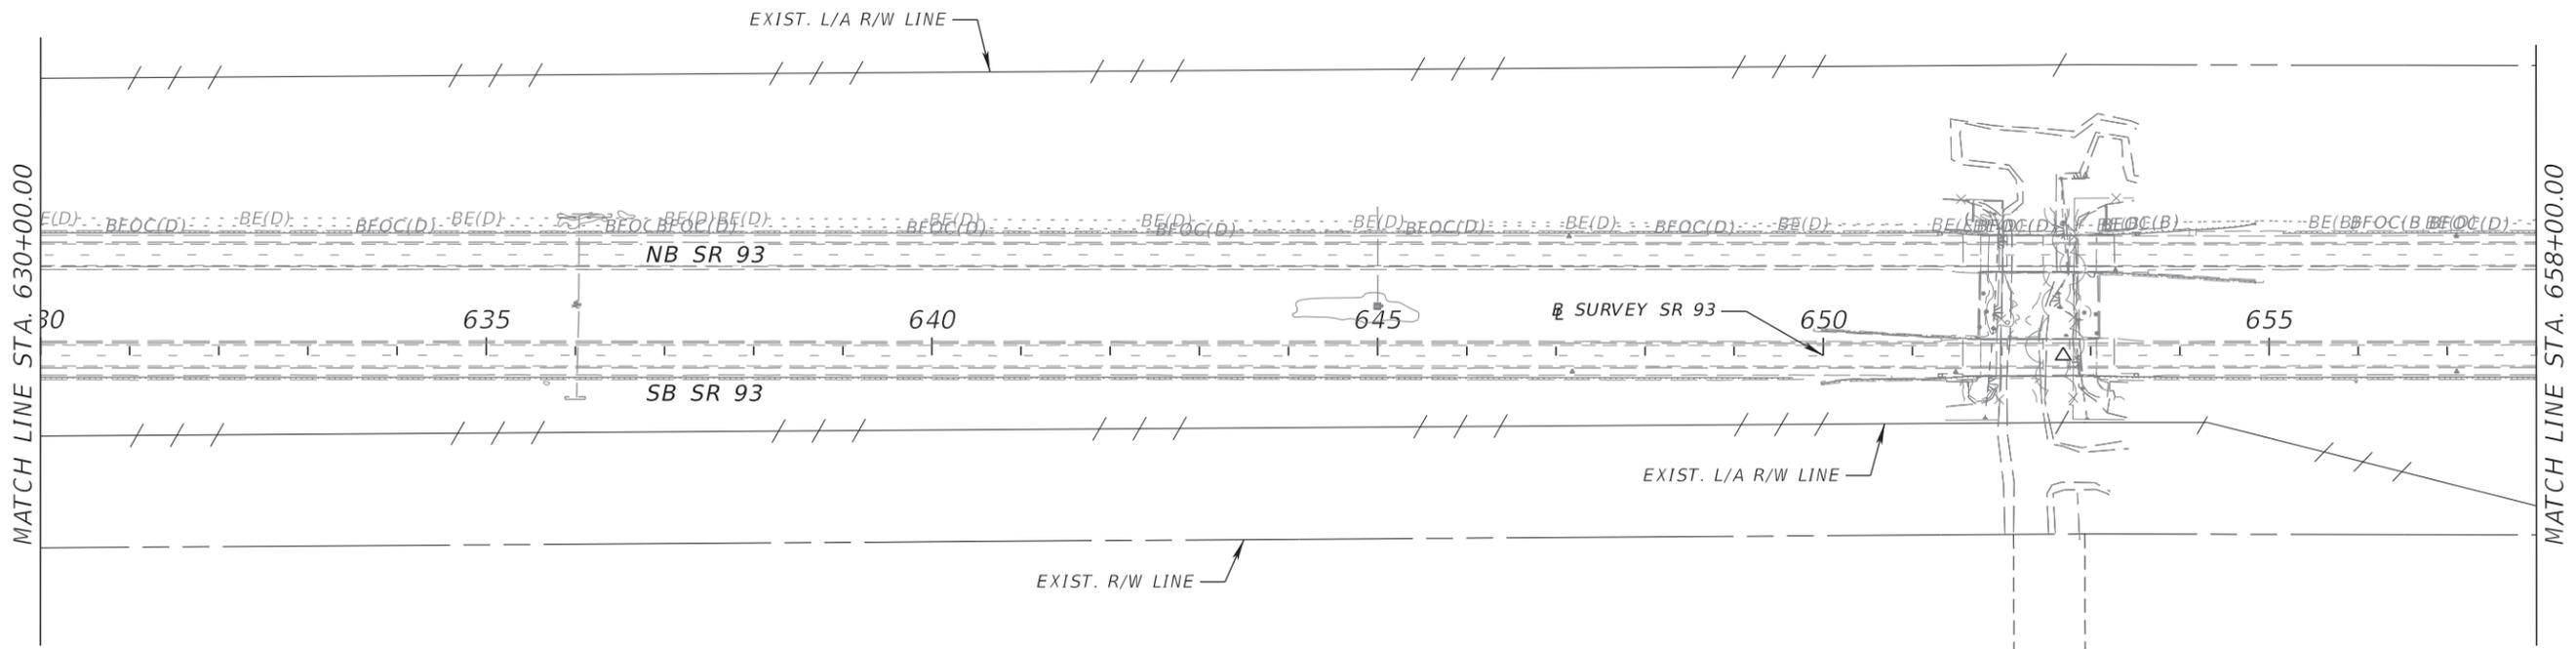

SR 93 (I-75)

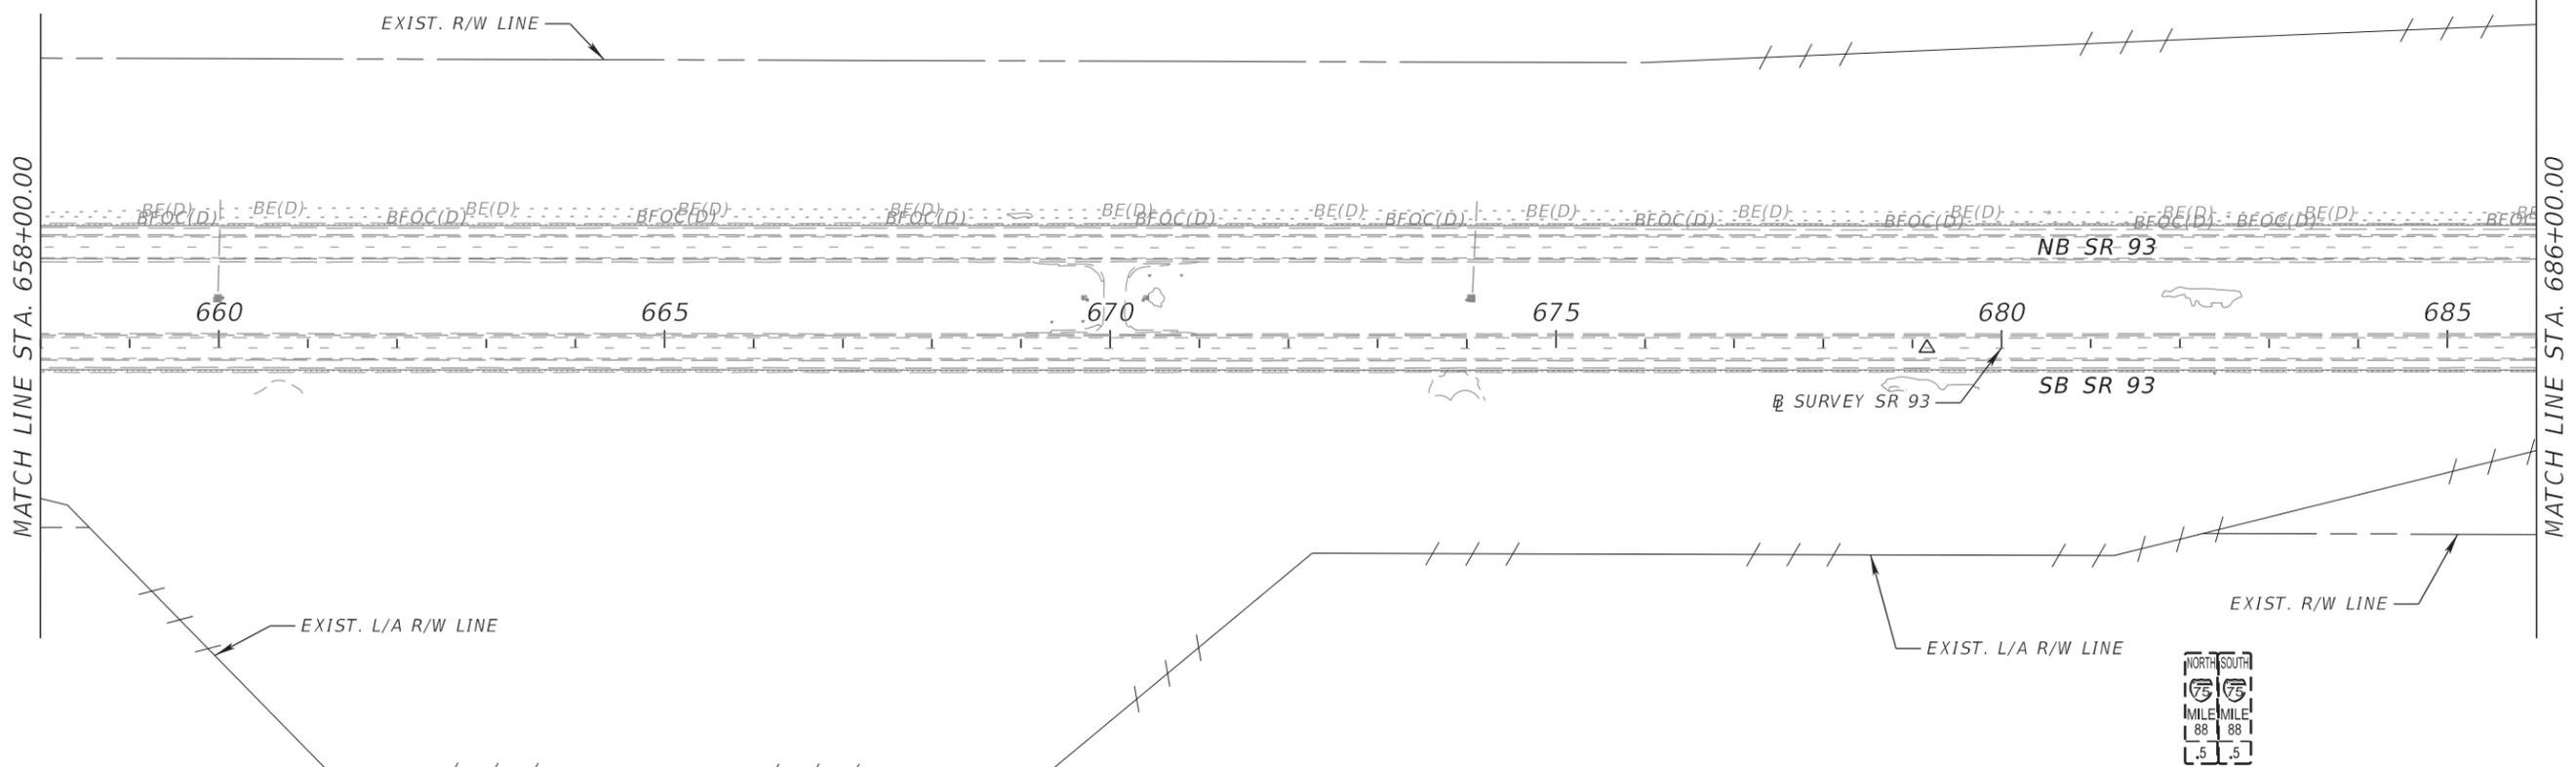

REVISIONS			
DATE	DESCRIPTION	DATE	DESCRIPTION



PATRICIA T. CHRISTIE, P.E.
 P.E. NO.: 60049
 FALLER, DAVIS & ASSOCIATES, INC.
 4200 W. CYPRESS ST., SUITE 500
 TAMPA, FLORIDA 33607-4168

STATE OF FLORIDA DEPARTMENT OF TRANSPORTATION		
ROAD NO.	COUNTY	FINANCIAL PROJECT ID
SR 93	COLLIER	444008-3-52-01

**SIGNING AND PAVEMENT
 MARKING PLAN (17)**

SHEET NO.
 S-26


THE OFFICIAL RECORD OF THIS SHEET IS THE ELECTRONIC FILE DIGITALLY SIGNED AND SEALED UNDER RULE 61G15-23.004, F.A.C.

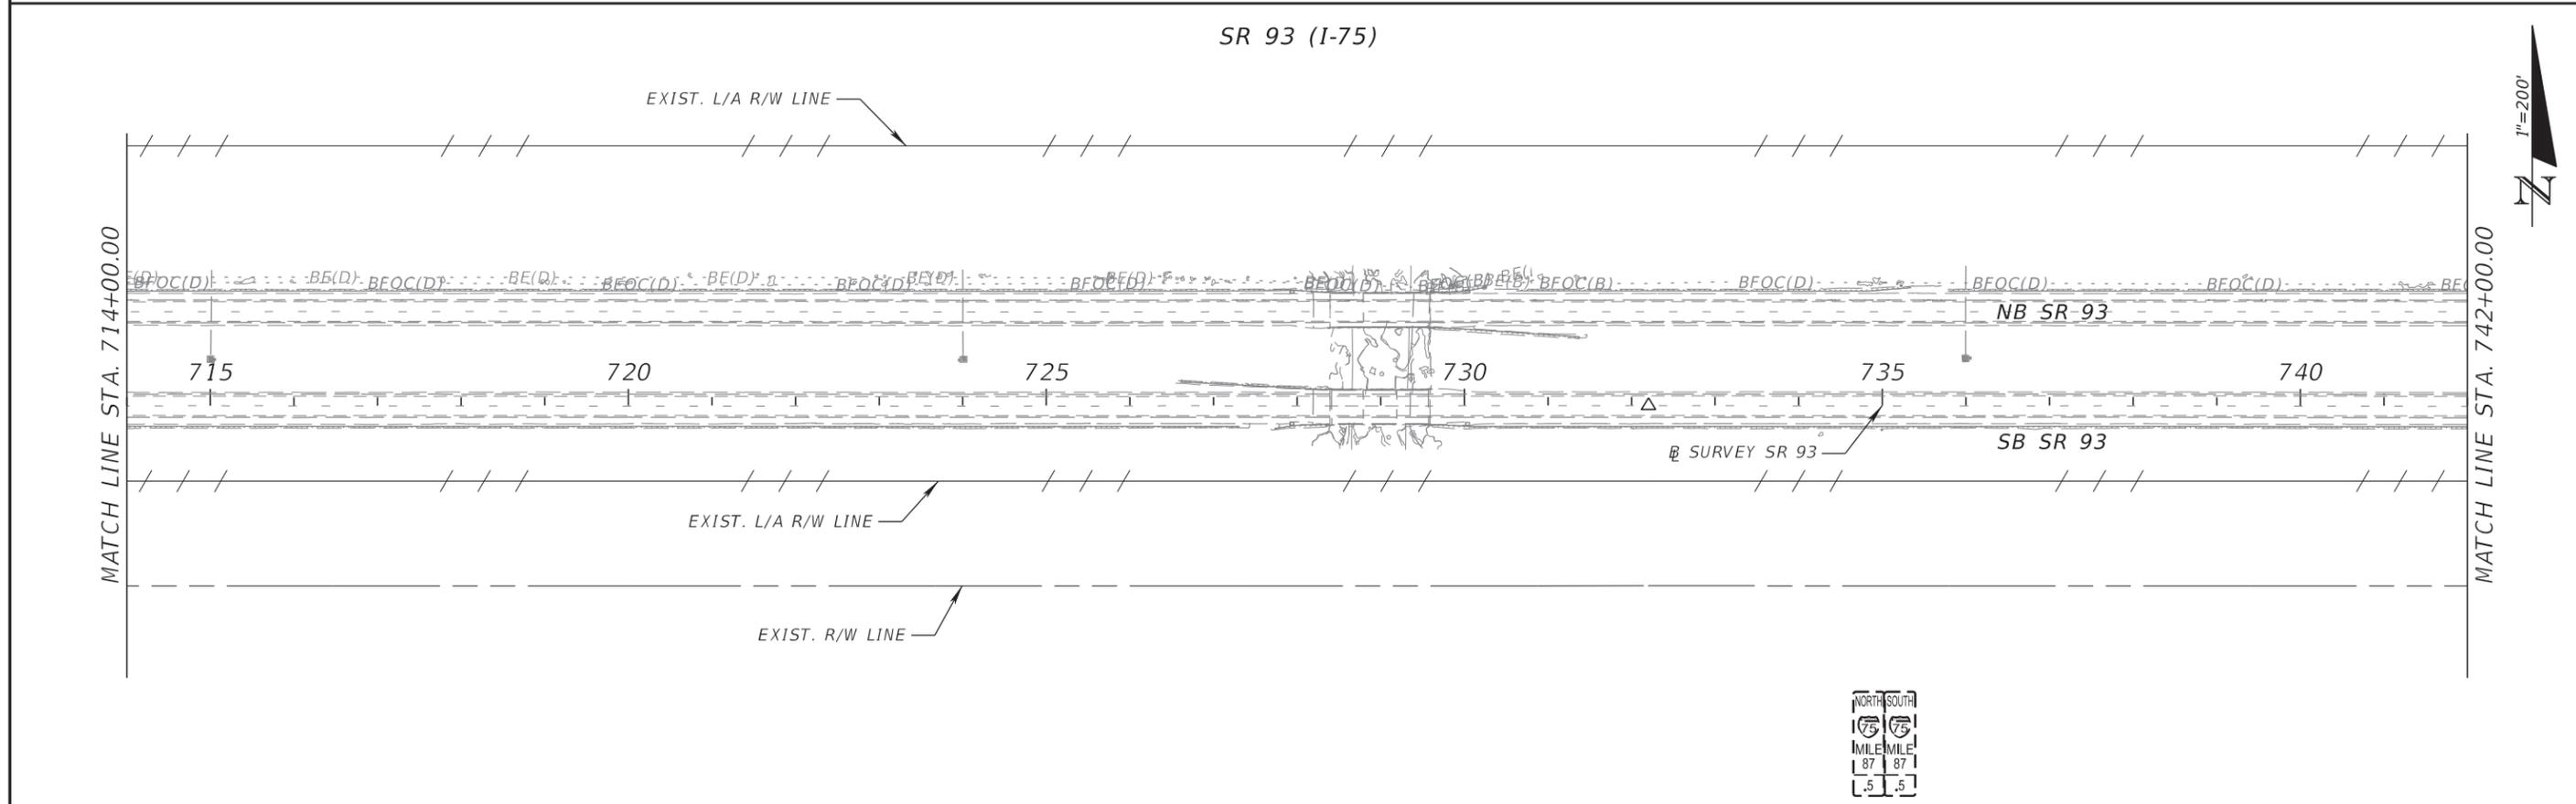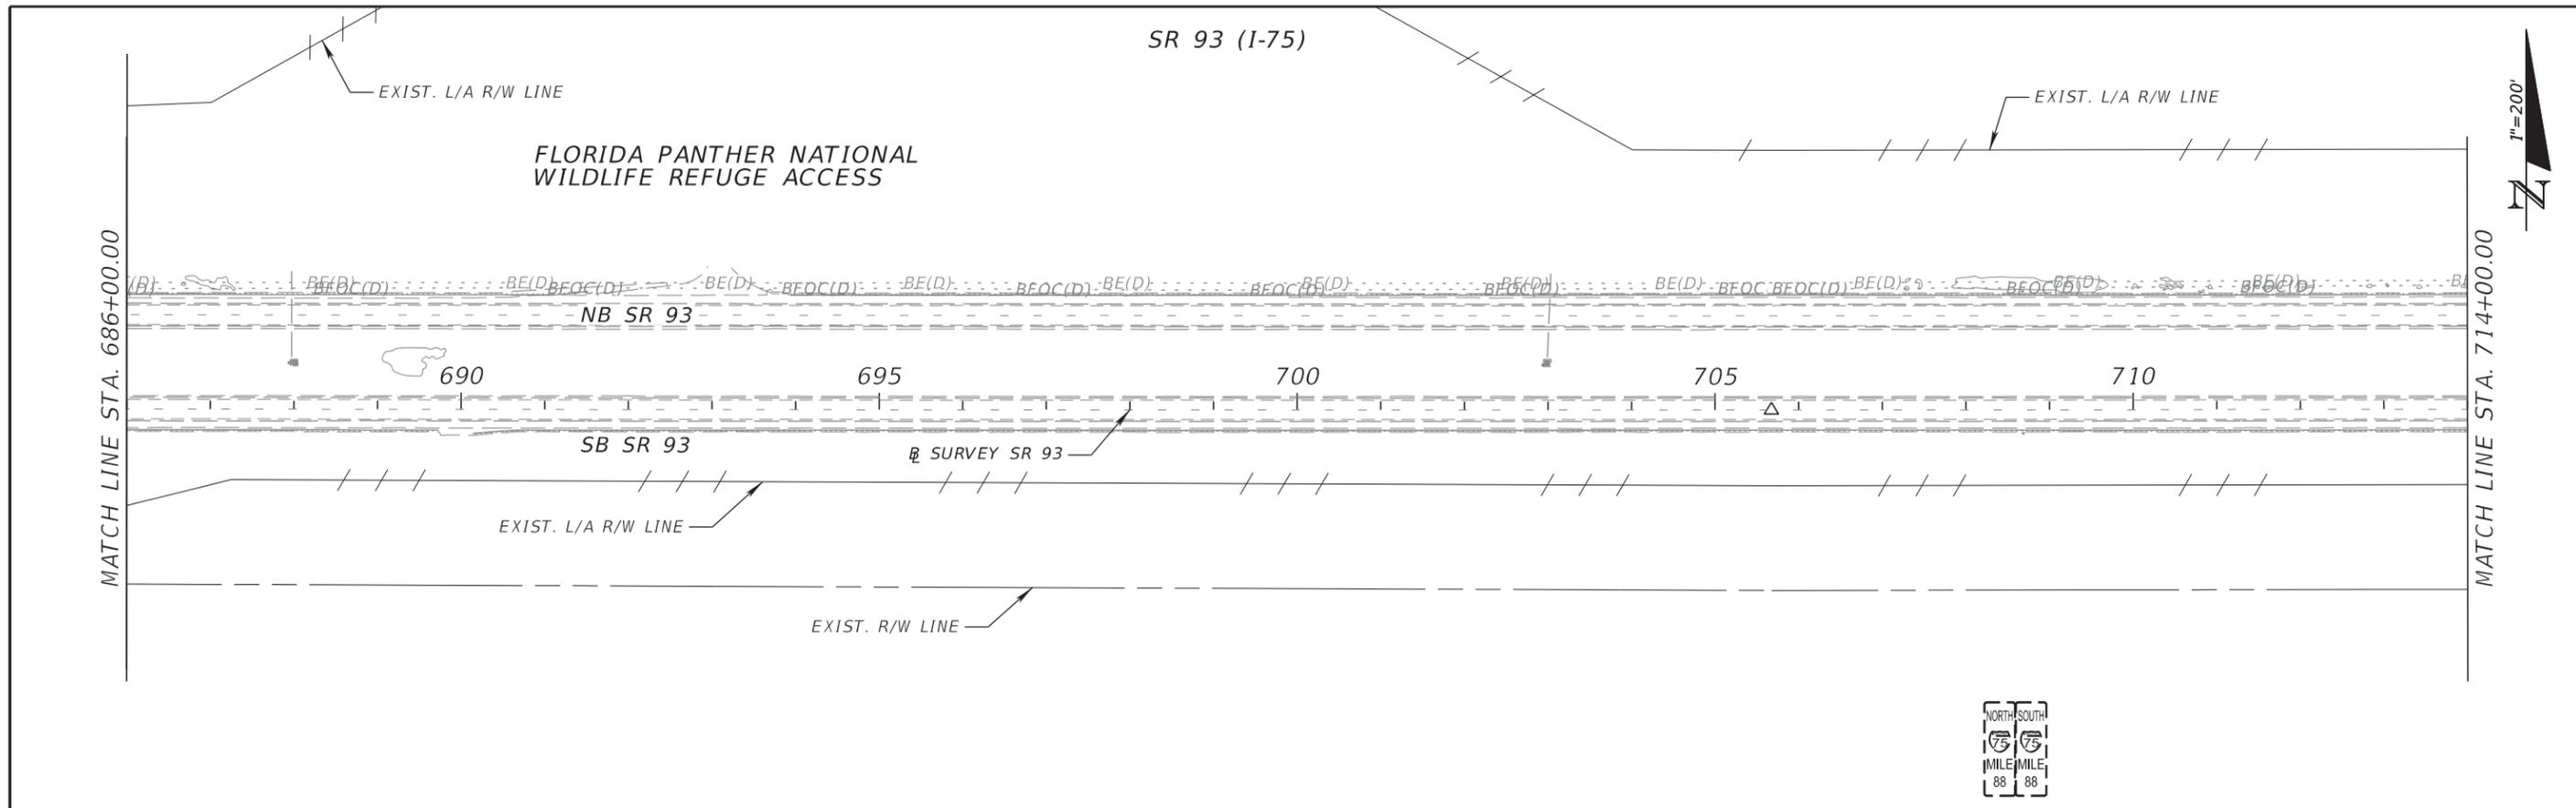


REVISIONS				PATRICIA T. CHRISTIE, P.E. P.E. NO.: 60049 FALLER, DAVIS & ASSOCIATES, INC. 4200 W. CYPRESS ST., SUITE 500 TAMPA, FLORIDA 33607-4168	STATE OF FLORIDA DEPARTMENT OF TRANSPORTATION			SHEET NO. S-27
DATE	DESCRIPTION	DATE	DESCRIPTION		ROAD NO.	COUNTY	FINANCIAL PROJECT ID	
					SR 93	COLLIER	444008-3-52-01	

THE OFFICIAL RECORD OF THIS SHEET IS THE ELECTRONIC FILE DIGITALLY SIGNED AND SEALED UNDER RULE 61G15-23.004, F.A.C.

SR 93 (I-75)


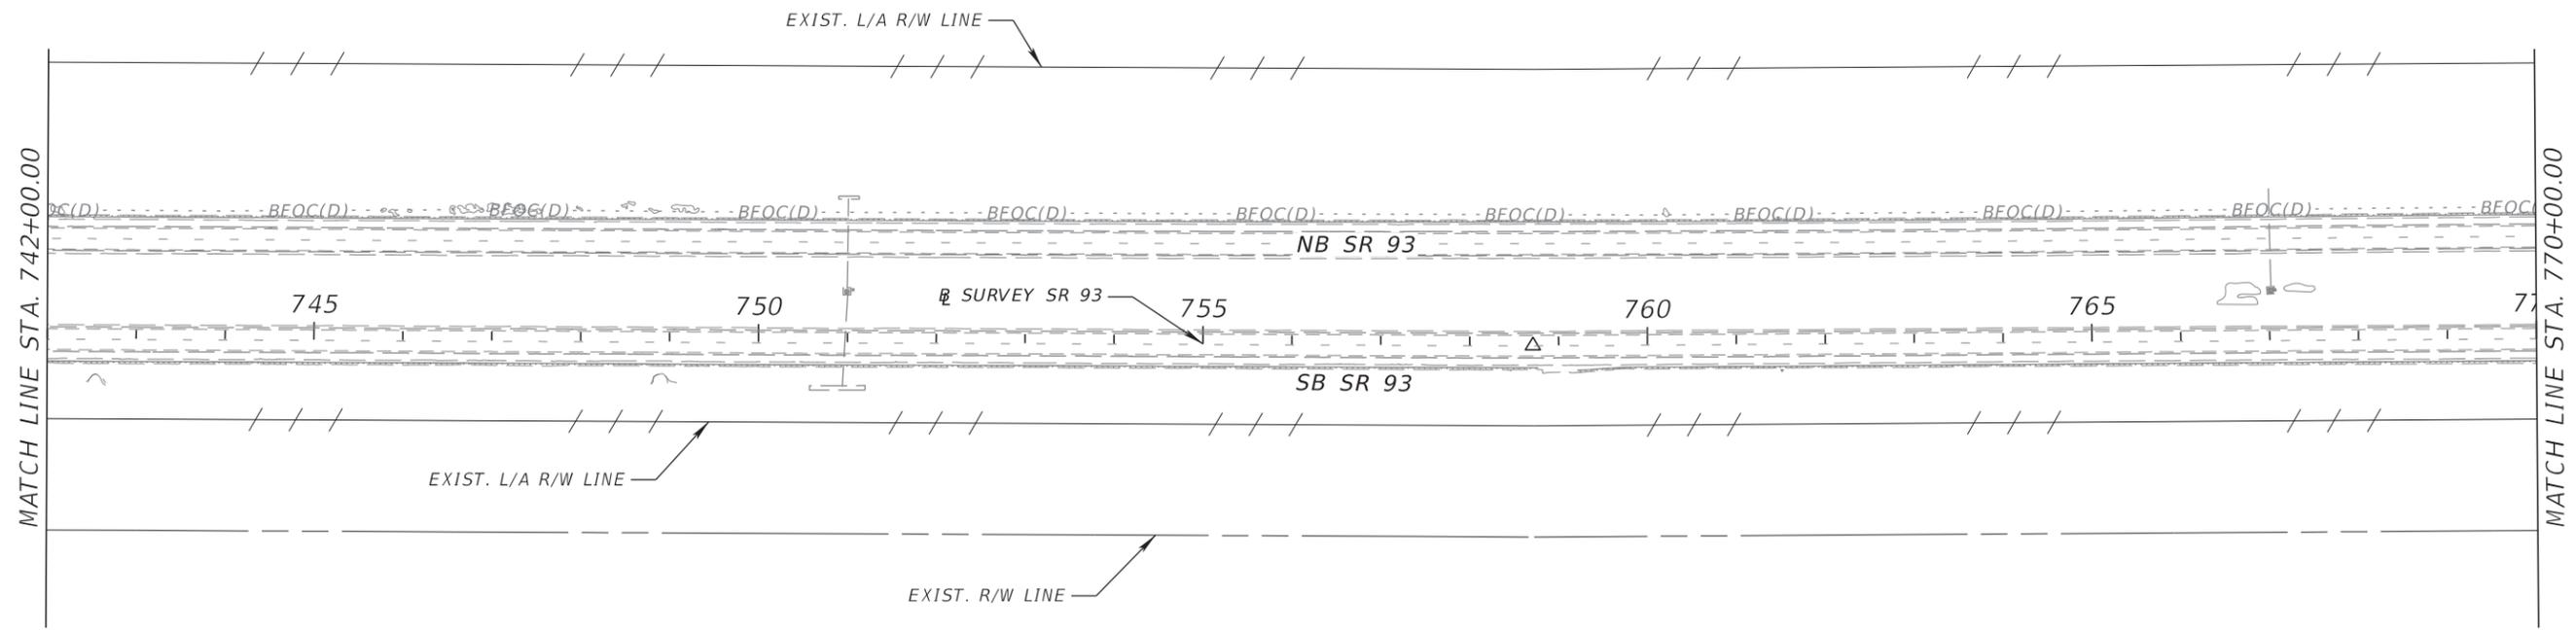


SR 93 (I-75)

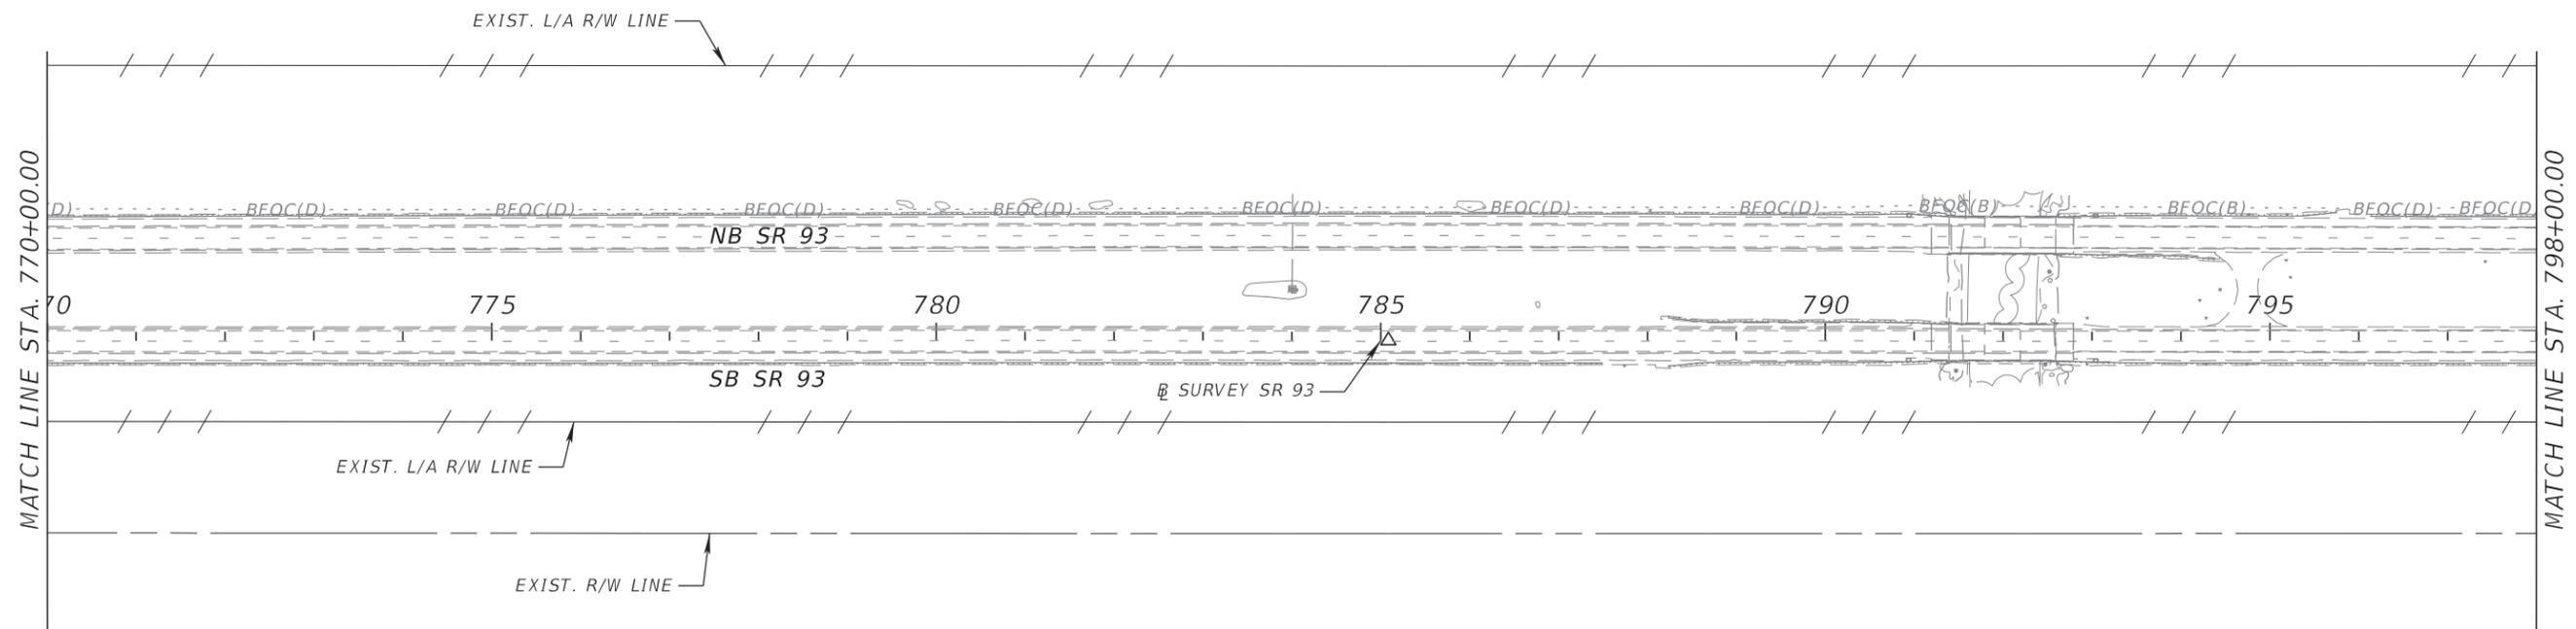


REVISIONS				PATRICIA T. CHRISTIE, P.E. P.E. NO.: 60049 FALLER, DAVIS & ASSOCIATES, INC. 4200 W. CYPRESS ST., SUITE 500 TAMPA, FLORIDA 33607-4168	STATE OF FLORIDA DEPARTMENT OF TRANSPORTATION			SIGNING AND PAVEMENT MARKING PLAN (19)	SHEET NO.
DATE	DESCRIPTION	DATE	DESCRIPTION		ROAD NO.	COUNTY	FINANCIAL PROJECT ID		
						SR 93	COLLIER		444008-3-52-01

SR 93 (I-75)

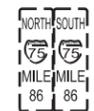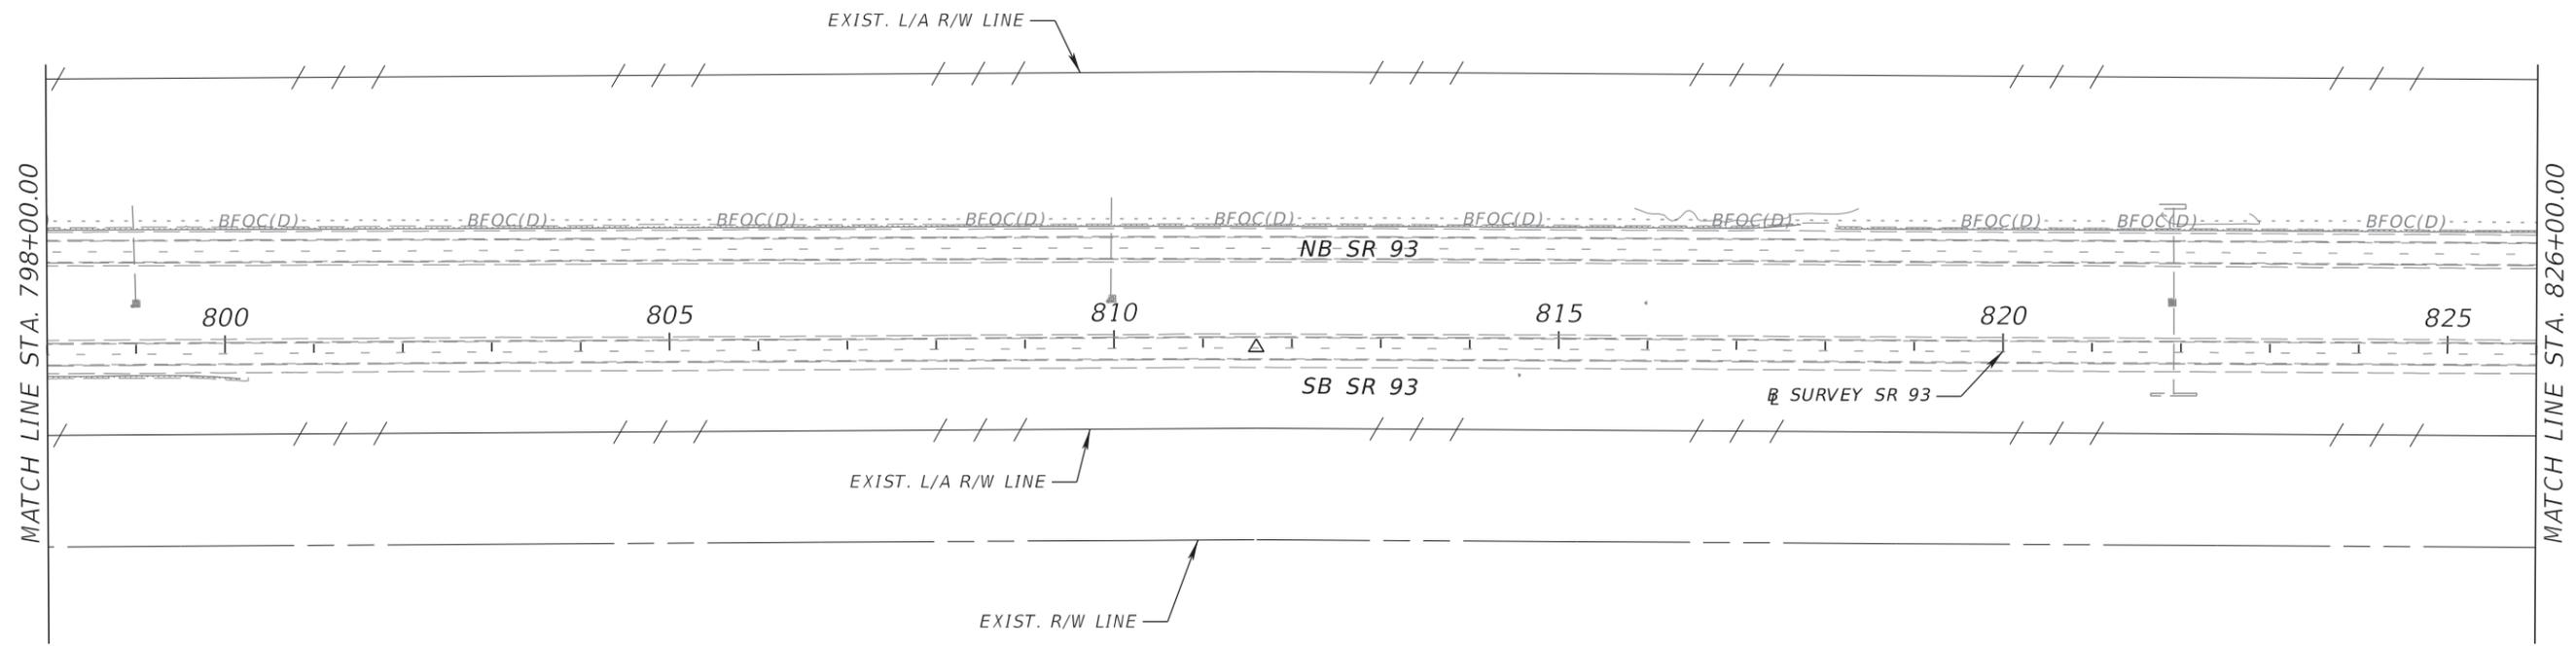



SR 93 (I-75)

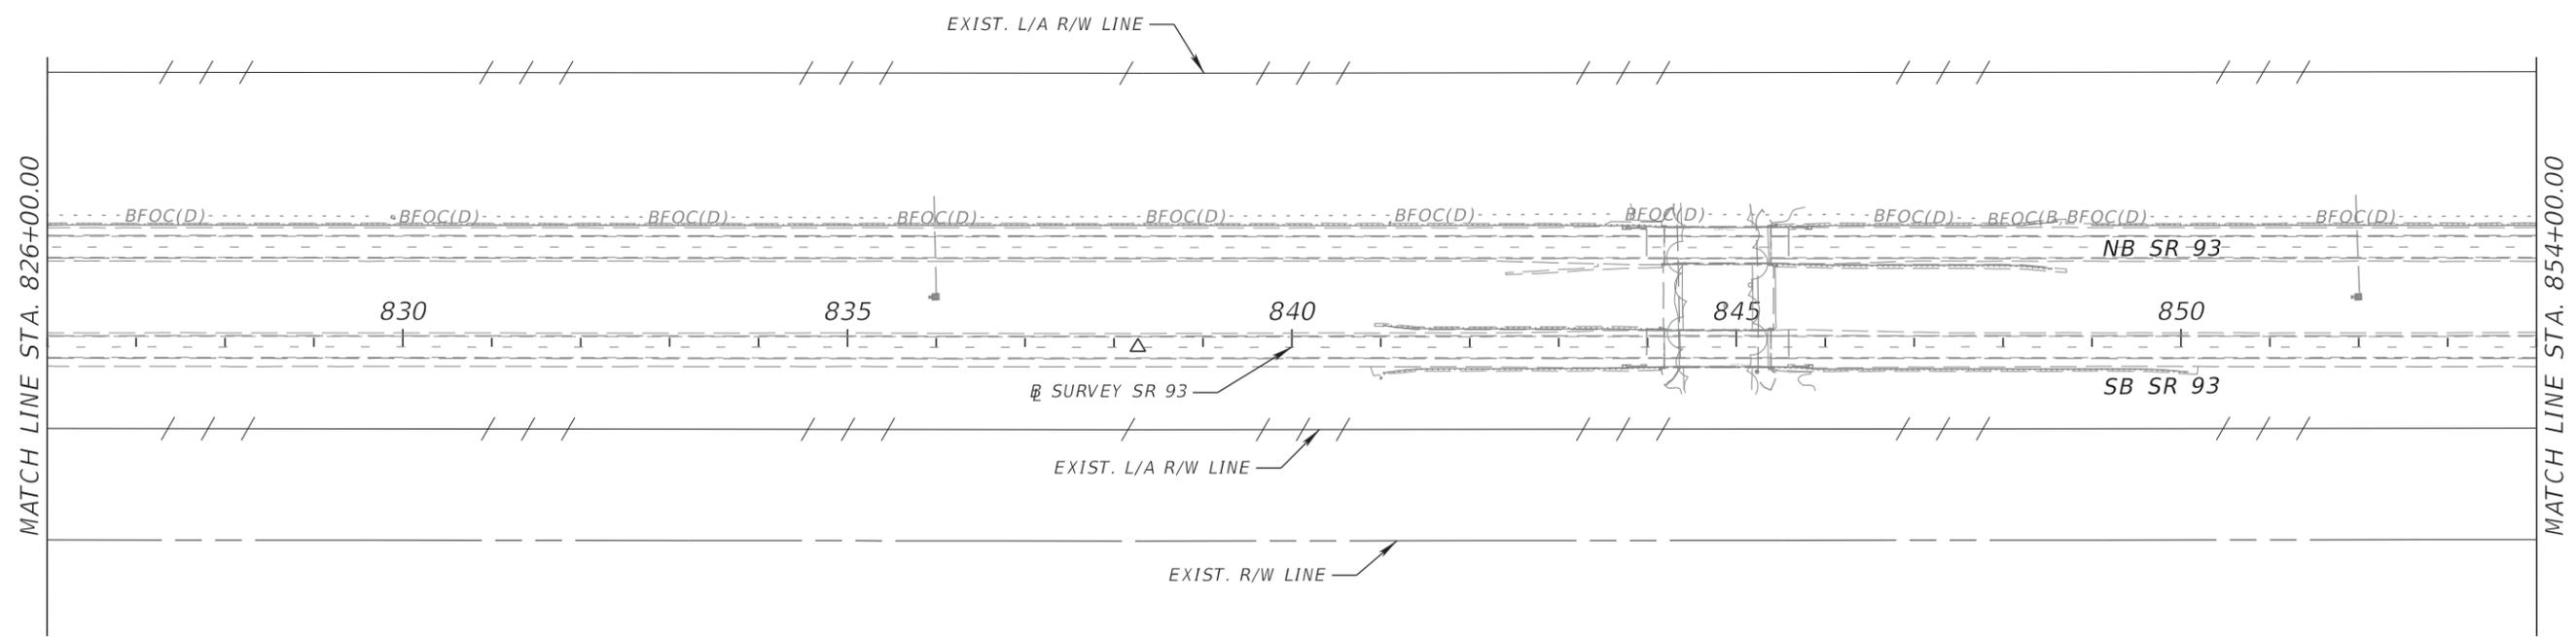

REVISIONS				PATRICIA T. CHRISTIE, P.E. P.E. NO.: 60049 FALLER, DAVIS & ASSOCIATES, INC. 4200 W. CYPRESS ST., SUITE 500 TAMPA, FLORIDA 33607-4168	STATE OF FLORIDA DEPARTMENT OF TRANSPORTATION			SIGNING AND PAVEMENT MARKING PLAN (20)	SHEET NO.
DATE	DESCRIPTION	DATE	DESCRIPTION		ROAD NO.	COUNTY	FINANCIAL PROJECT ID		S-29
					SR 93	COLLIER	444008-3-52-01		

THE OFFICIAL RECORD OF THIS SHEET IS THE ELECTRONIC FILE DIGITALLY SIGNED AND SEALED UNDER RULE 61G15-23.004, F.A.C.

SR 93 (I-75)

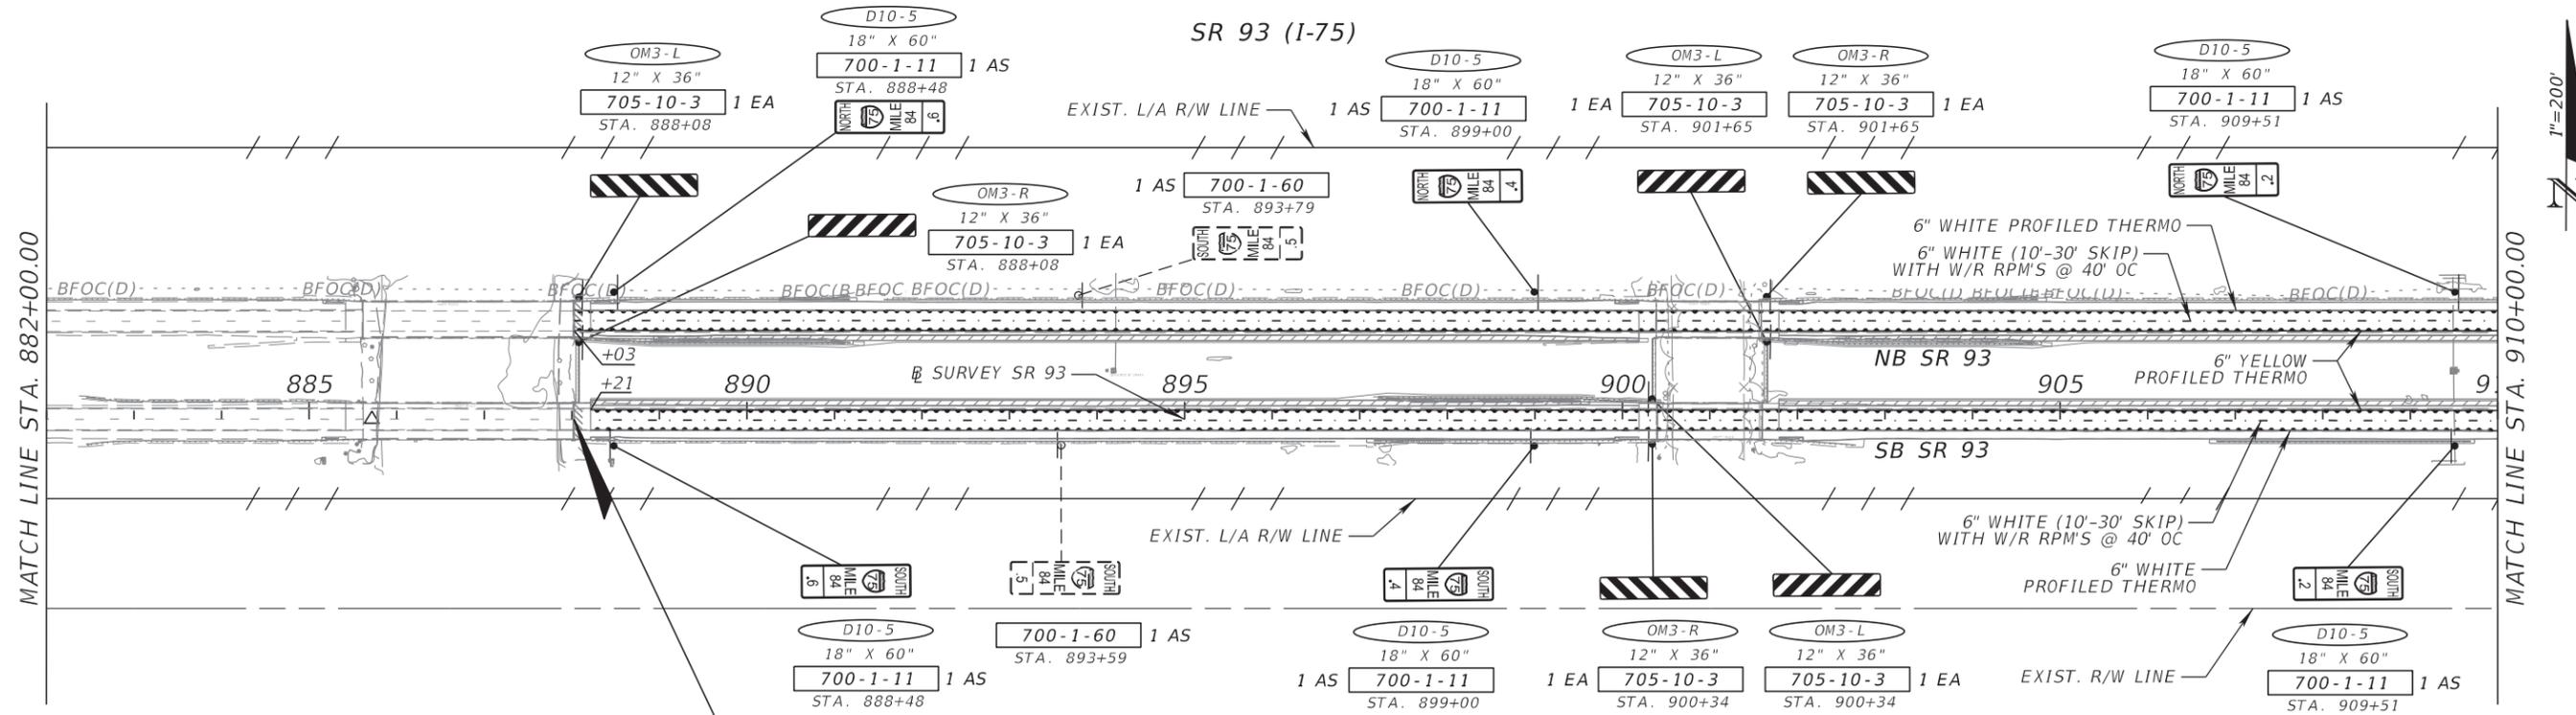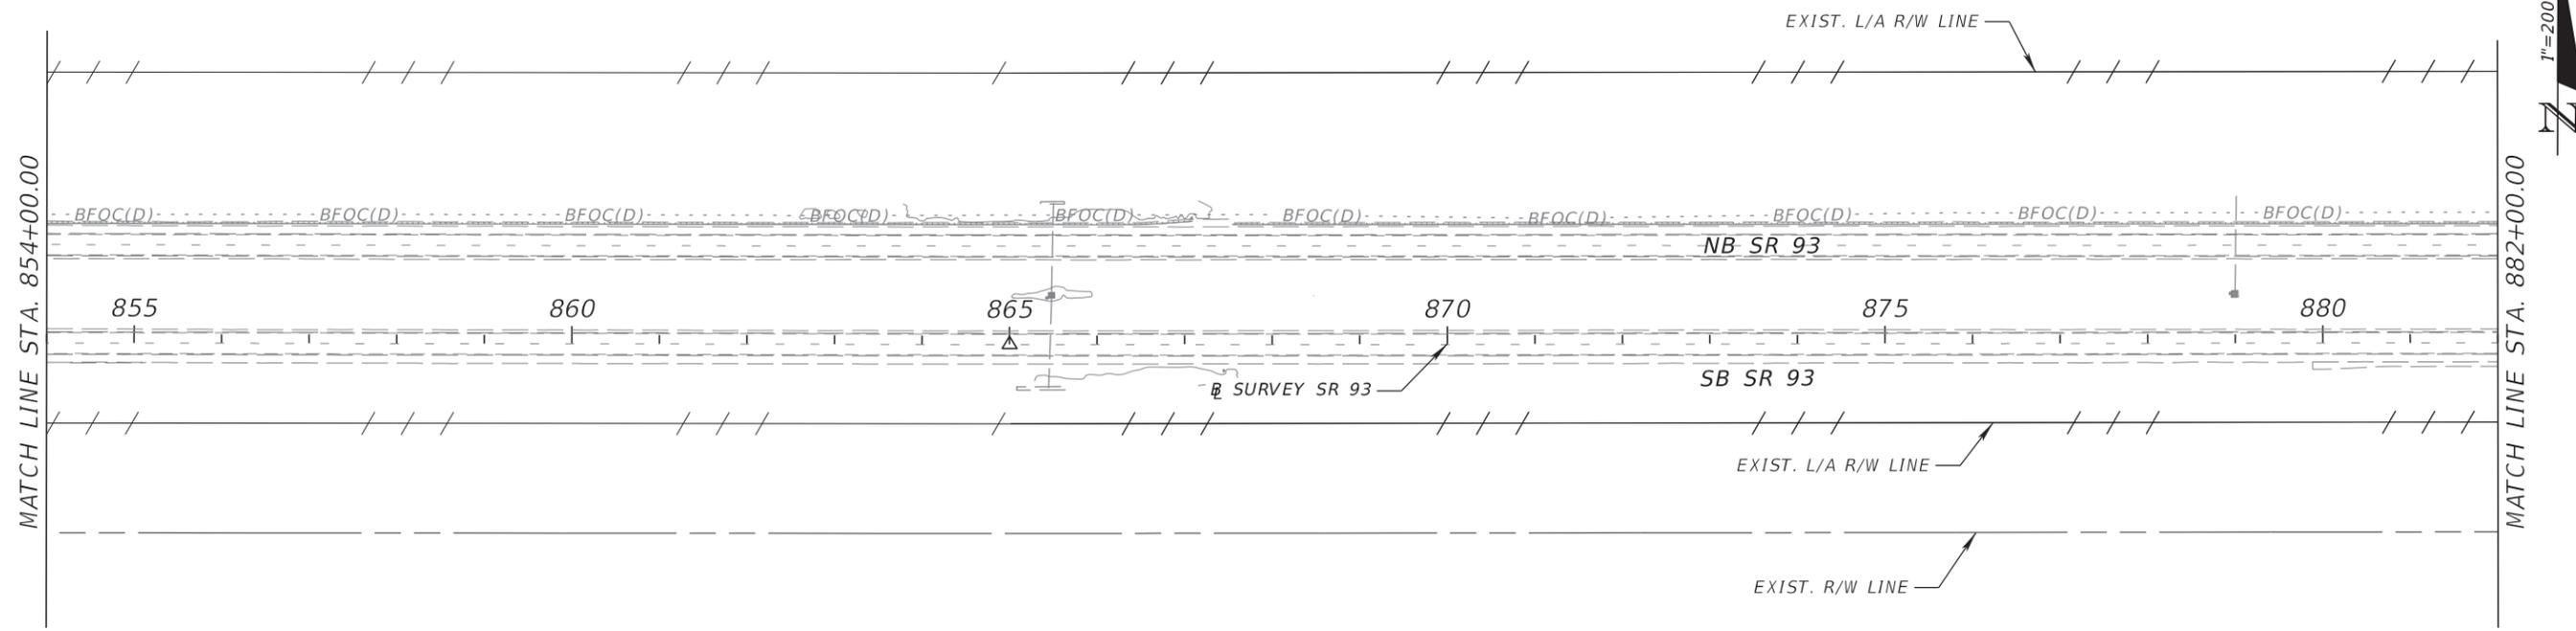

BEGIN EXCEPTION
 STA. 888+02.62 @ SURVEY SR 93

REVISIONS			
DATE	DESCRIPTION	DATE	DESCRIPTION



PATRICIA T. CHRISTIE, P.E.
 P.E. NO.: 60049
 FALLER, DAVIS & ASSOCIATES, INC.
 4200 W. CYPRESS ST., SUITE 500
 TAMPA, FLORIDA 33607-4168

STATE OF FLORIDA DEPARTMENT OF TRANSPORTATION		
ROAD NO.	COUNTY	FINANCIAL PROJECT ID
SR 93	COLLIER	444008-3-52-01

**SIGNING AND PAVEMENT
 MARKING PLAN (21)**



SHEET NO.
 S-30

THE OFFICIAL RECORD OF THIS SHEET IS THE ELECTRONIC FILE DIGITALLY SIGNED AND SEALED UNDER RULE 61G15-23.004, F.A.C.

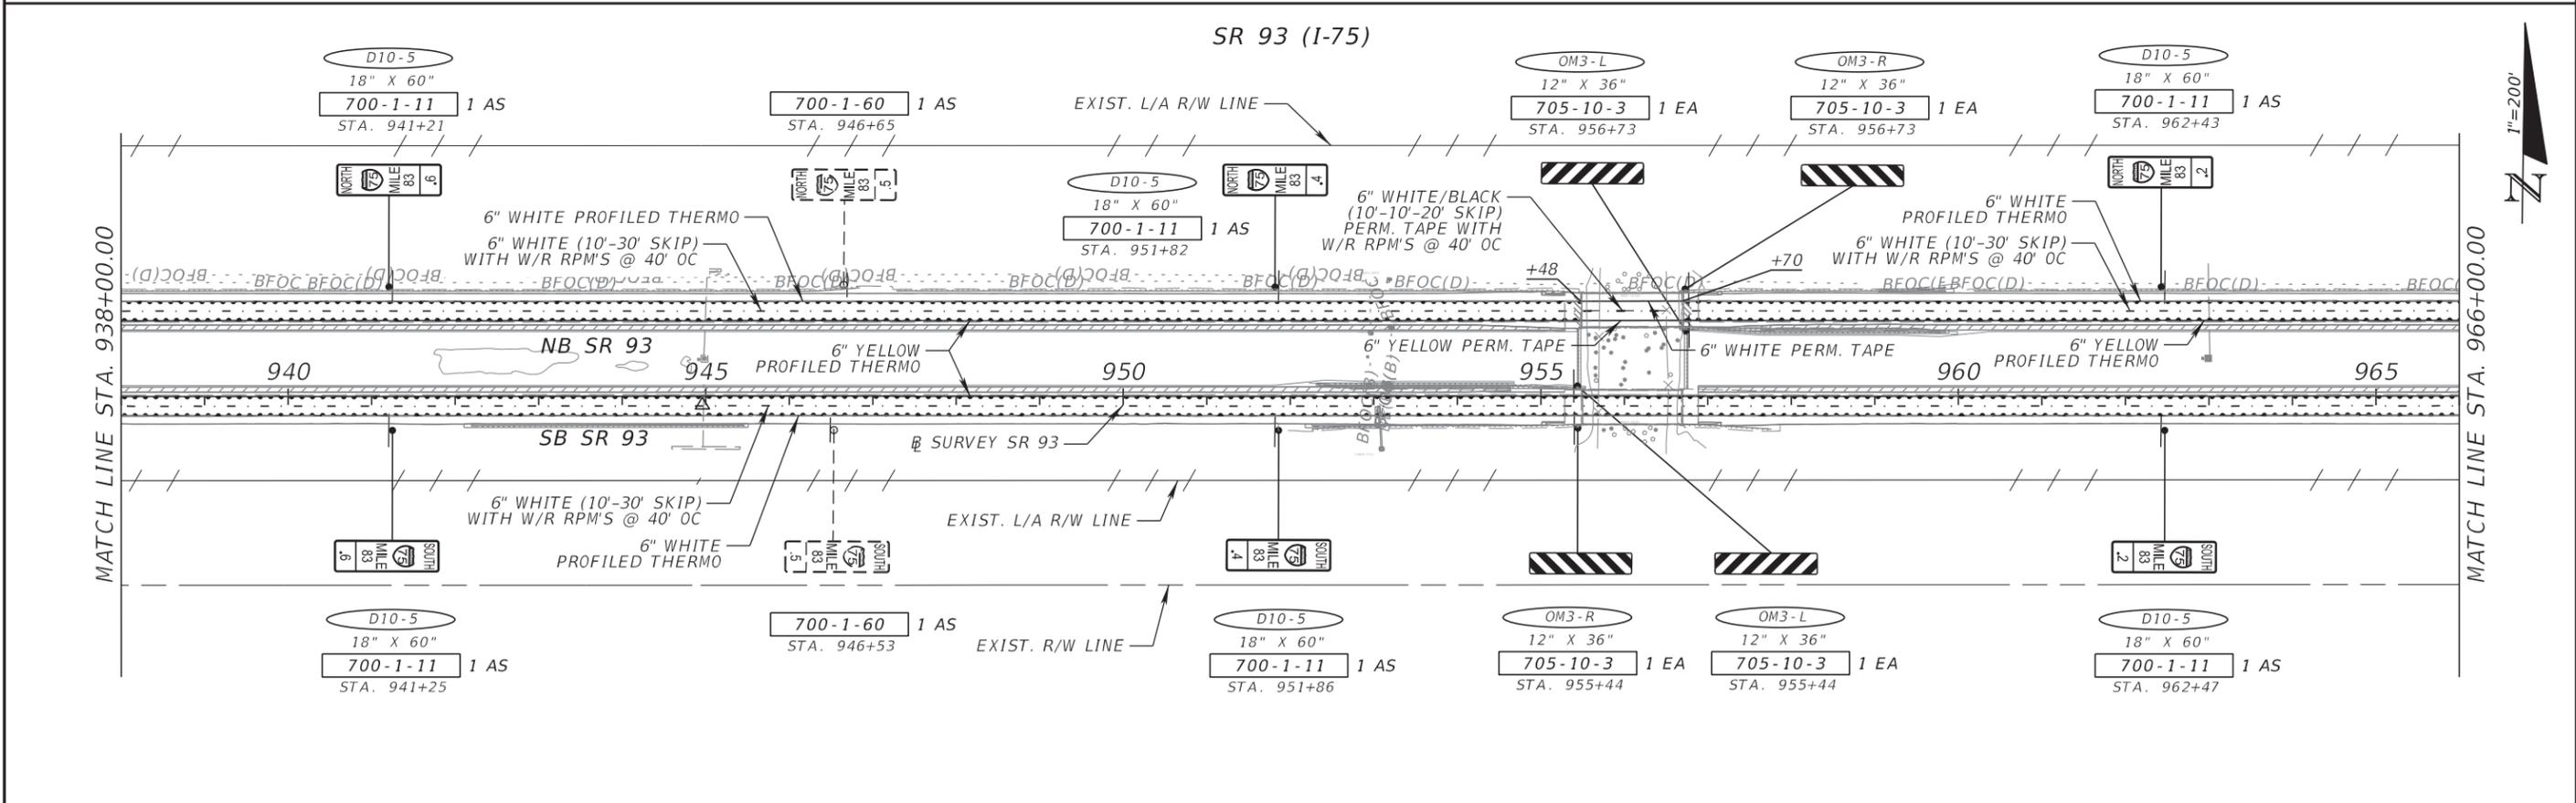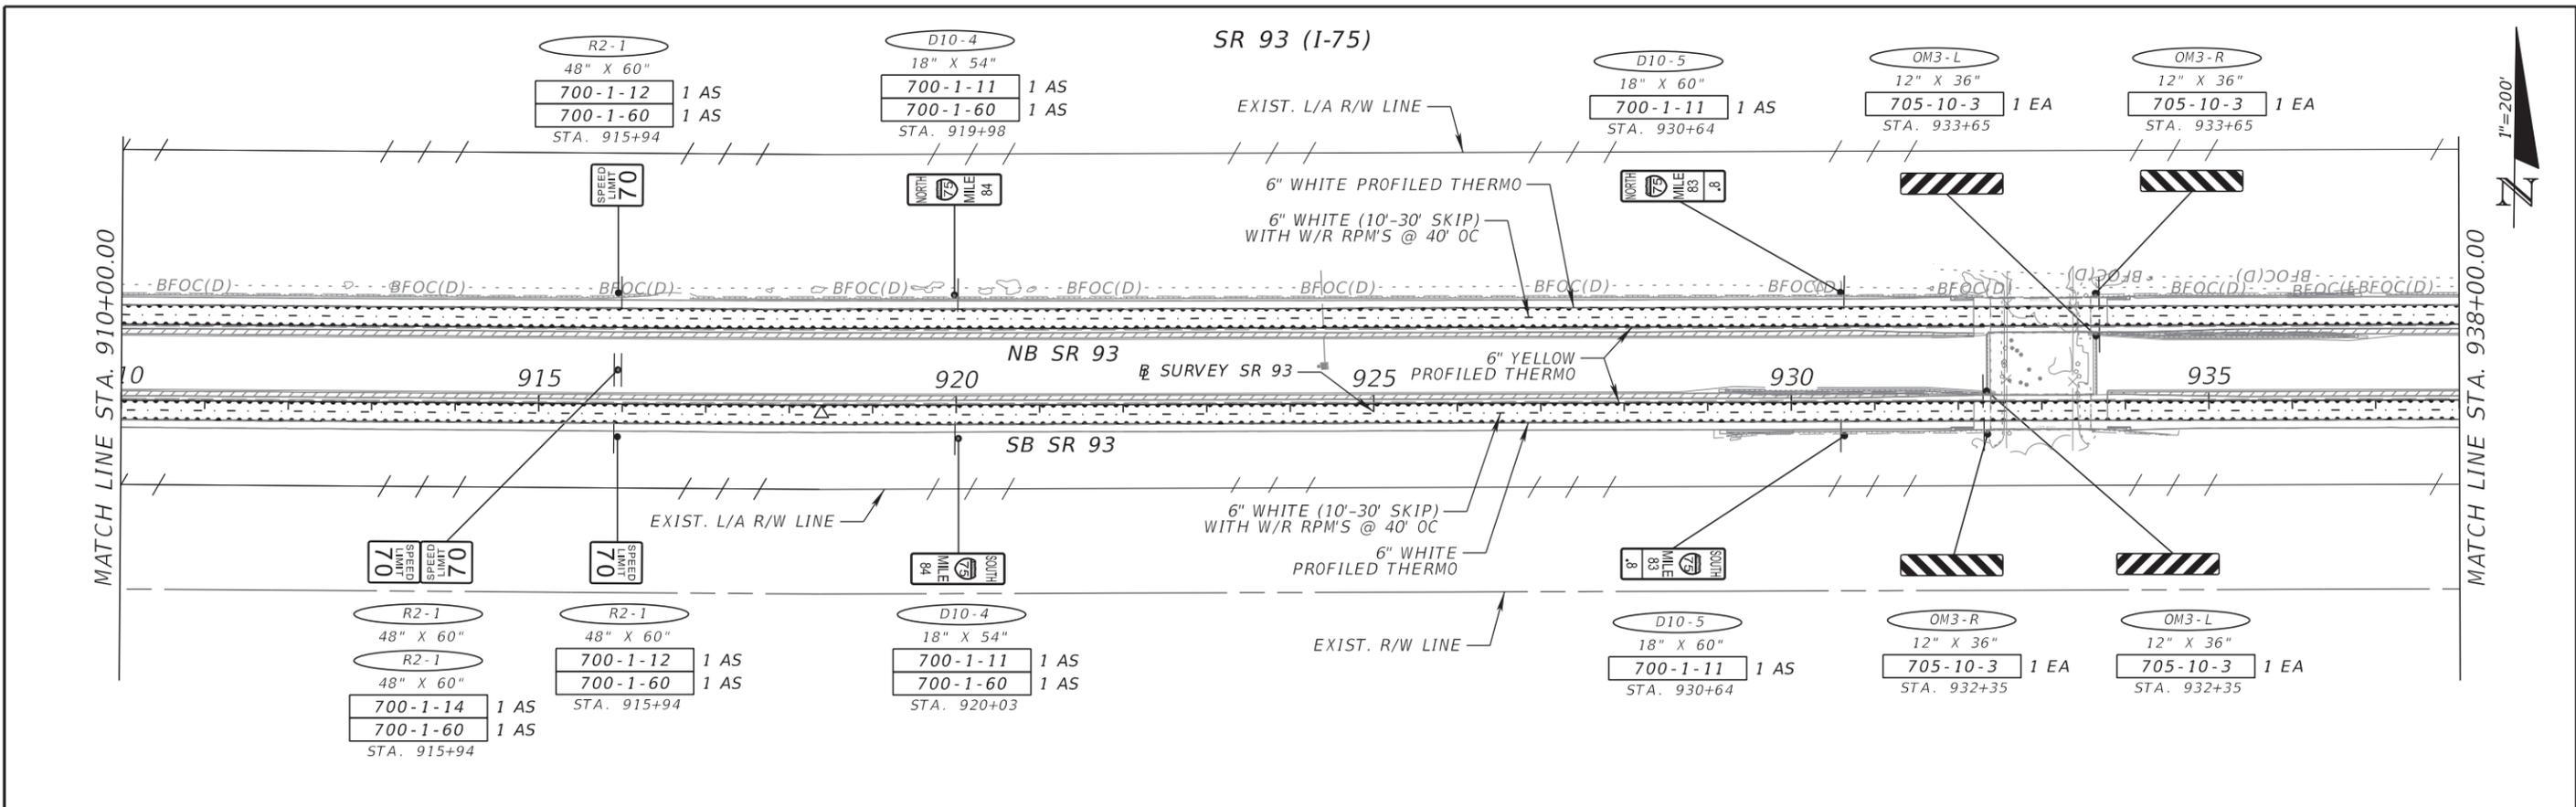



REVISIONS				PATRICIA T. CHRISTIE, P.E. P.E. NO.: 60049 FALLER, DAVIS & ASSOCIATES, INC. 4200 W. CYPRESS ST., SUITE 500 TAMPA, FLORIDA 33607-4168	STATE OF FLORIDA DEPARTMENT OF TRANSPORTATION			SIGNING AND PAVEMENT MARKING PLAN (22)	SHEET NO.
DATE	DESCRIPTION	DATE	DESCRIPTION		ROAD NO.	COUNTY	FINANCIAL PROJECT ID		
						SR 93	COLLIER		444008-3-52-01

THE OFFICIAL RECORD OF THIS SHEET IS THE ELECTRONIC FILE DIGITALLY SIGNED AND SEALED UNDER RULE 61G15-23.004, F.A.C.

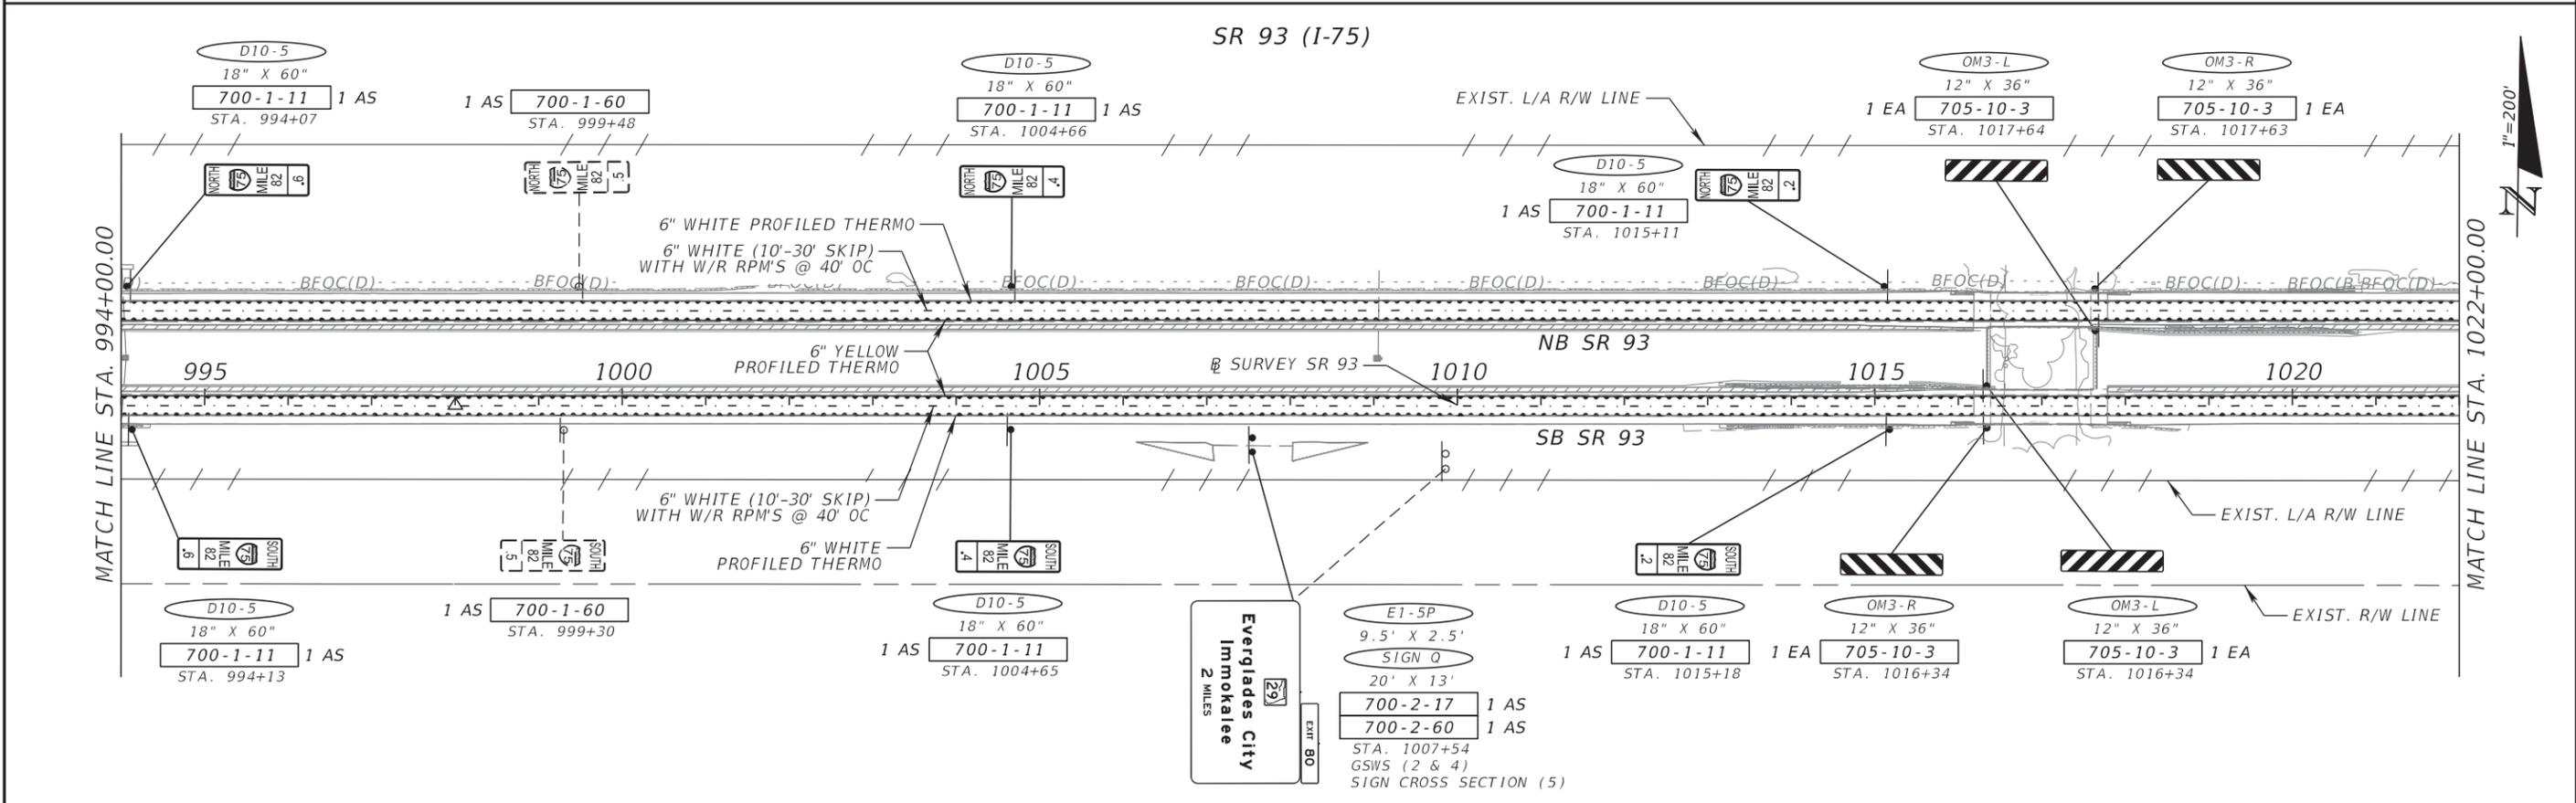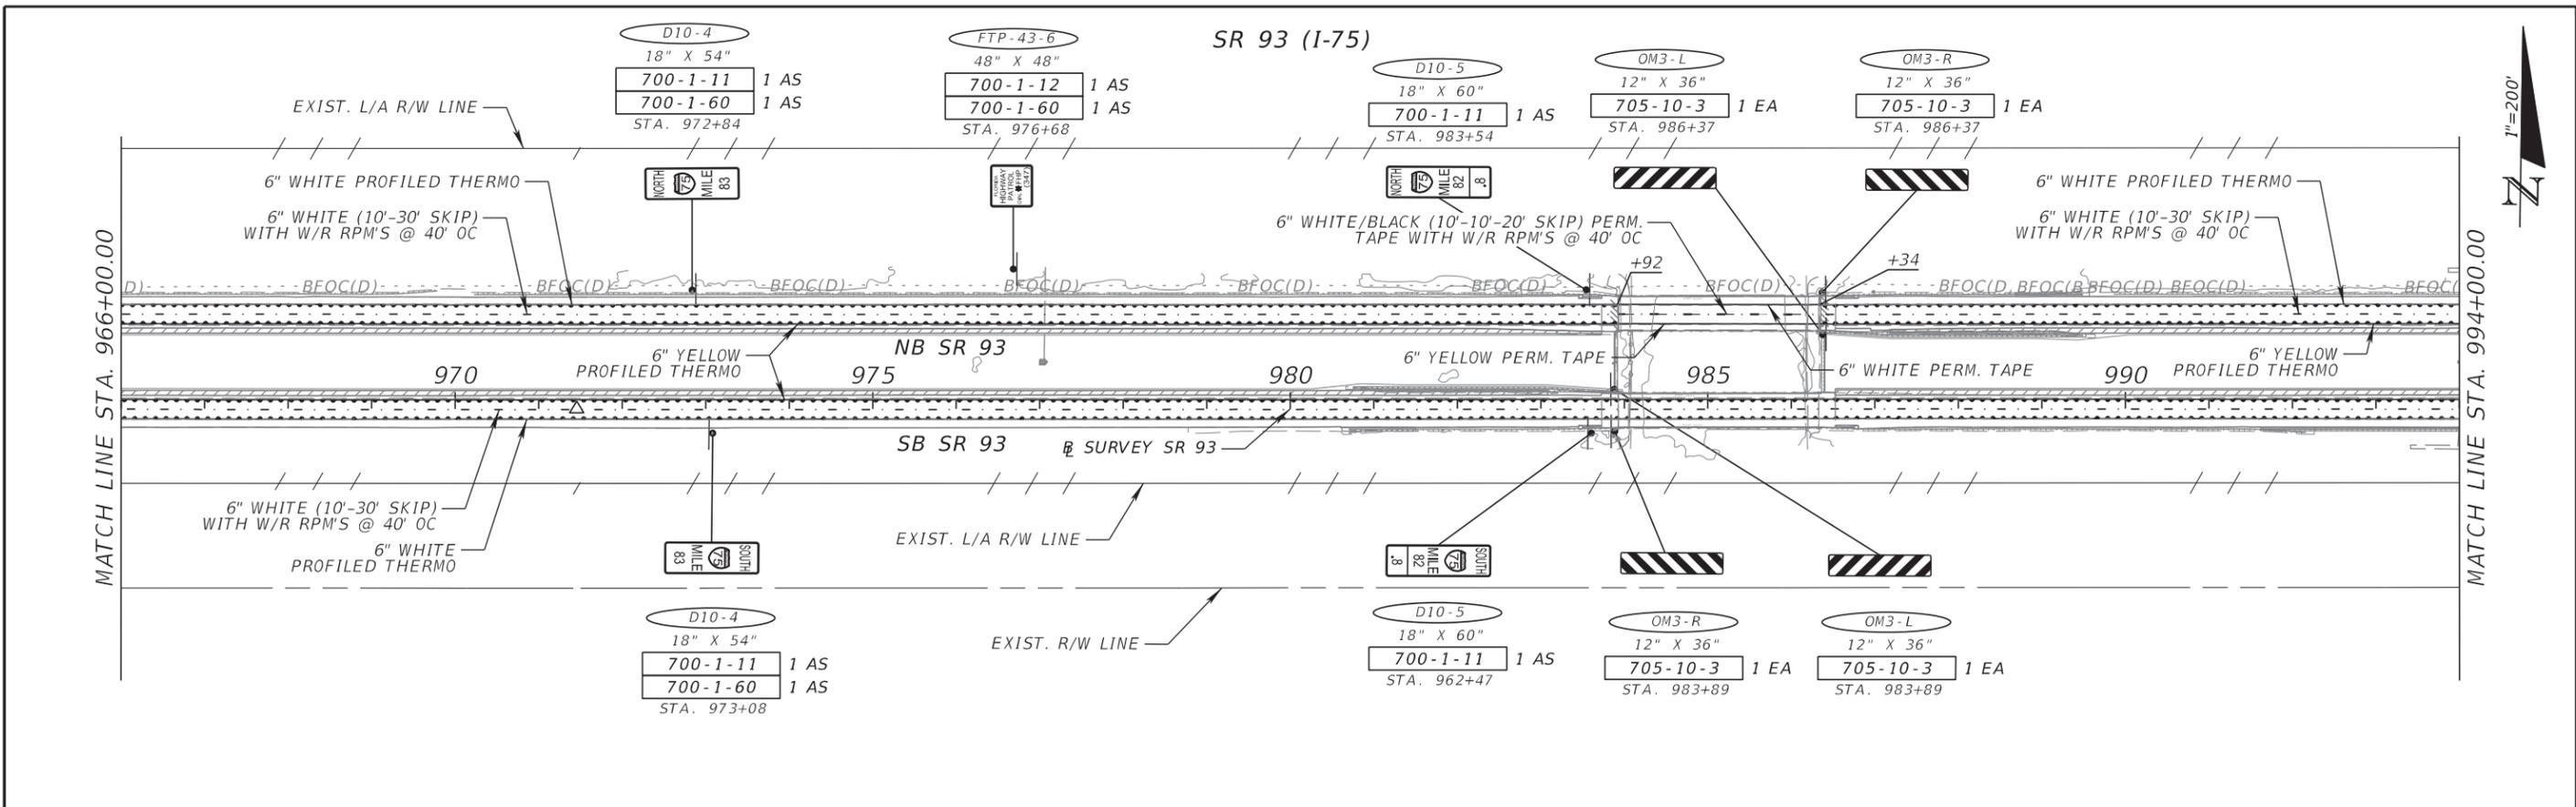

REVISIONS				PATRICIA T. CHRISTIE, P.E. P.E. NO.: 60049 FALLER, DAVIS & ASSOCIATES, INC. 4200 W. CYPRESS ST., SUITE 500 TAMPA, FLORIDA 33607-4168	STATE OF FLORIDA DEPARTMENT OF TRANSPORTATION			SIGNING AND PAVEMENT MARKING PLAN (23)	SHEET NO.
DATE	DESCRIPTION	DATE	DESCRIPTION		ROAD NO.	COUNTY	FINANCIAL PROJECT ID		
					SR 93	COLLIER	444008-3-52-01		S-32




THE OFFICIAL RECORD OF THIS SHEET IS THE ELECTRONIC FILE DIGITALLY SIGNED AND SEALED UNDER RULE 61G15-23.004, F.A.C.

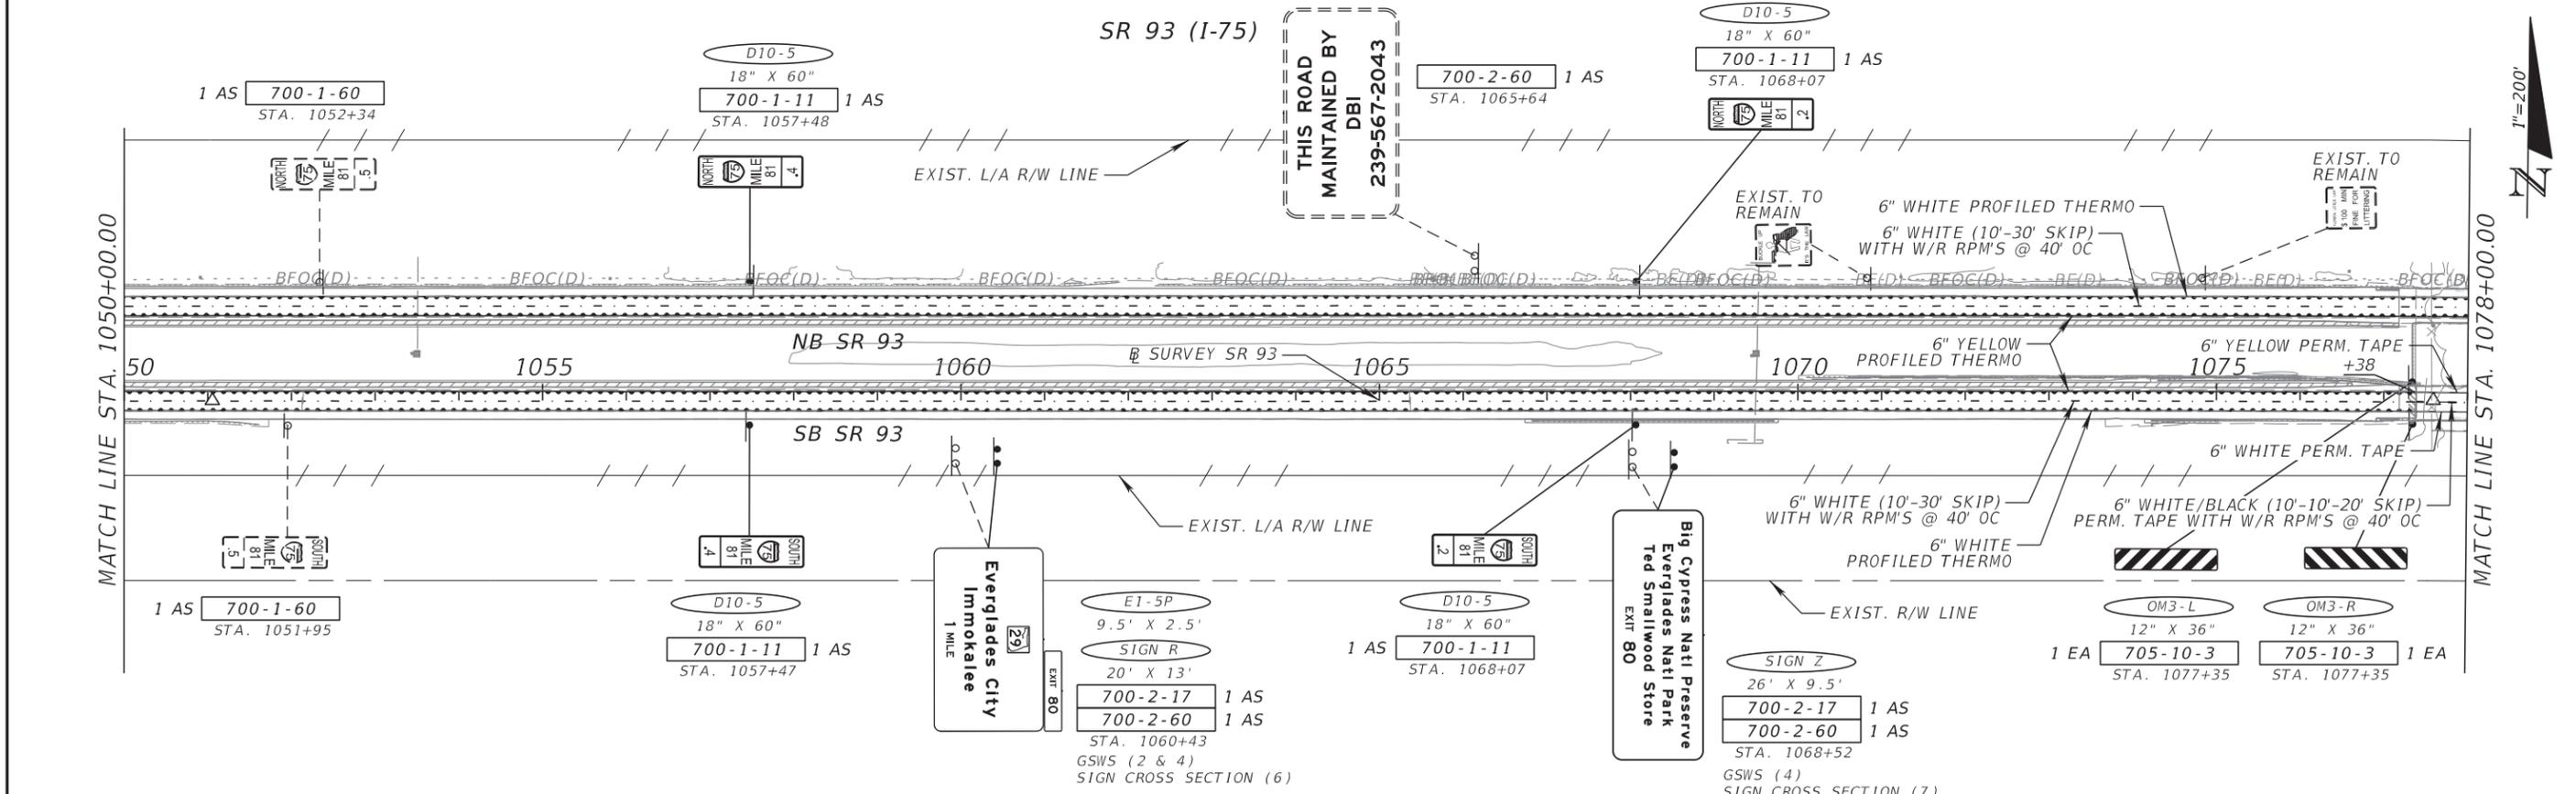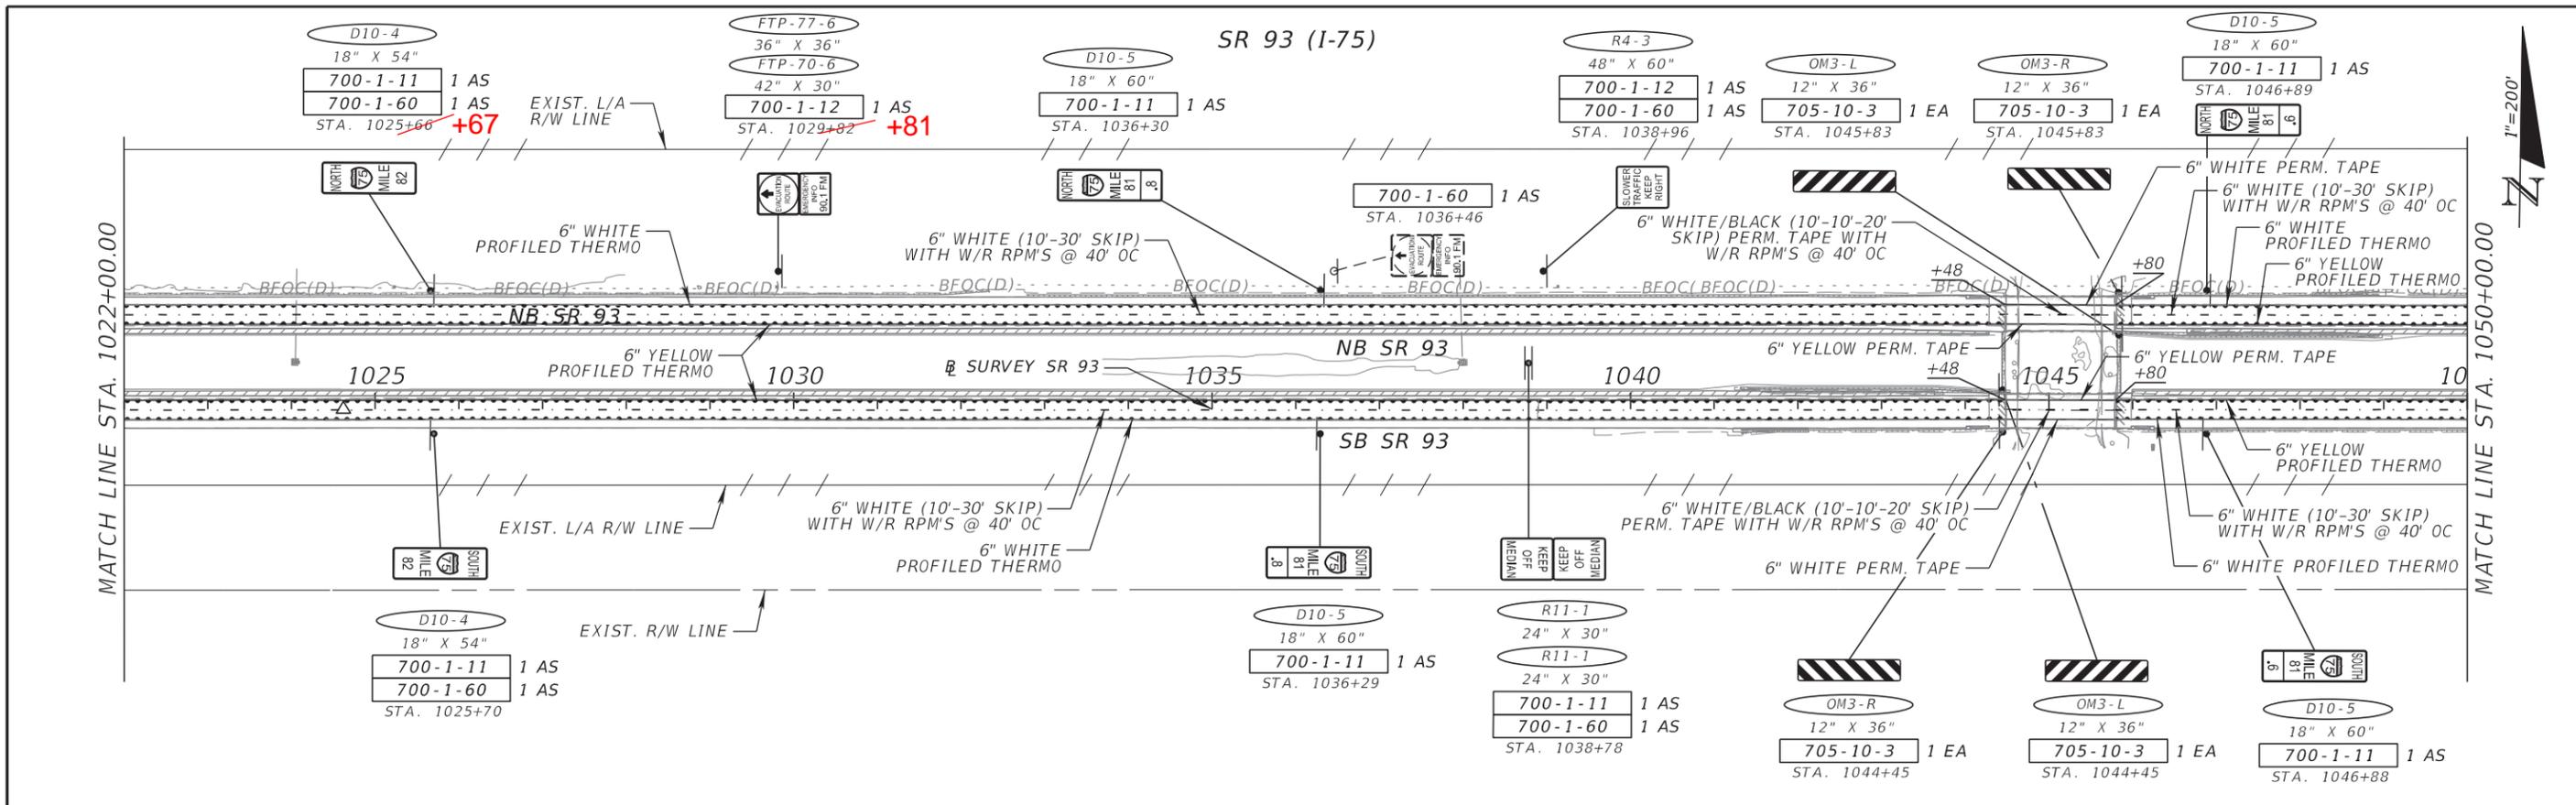

REVISIONS				PATRICIA T. CHRISTIE, P.E. P.E. NO.: 60049 FALLER, DAVIS & ASSOCIATES, INC. 4200 W. CYPRESS ST., SUITE 500 TAMPA, FLORIDA 33607-4168	STATE OF FLORIDA DEPARTMENT OF TRANSPORTATION			SHEET NO. S-33
DATE	DESCRIPTION	DATE	DESCRIPTION		ROAD NO.	COUNTY	FINANCIAL PROJECT ID	
					SR 93	COLLIER	444008-3-52-01	

**SIGNING AND PAVEMENT
MARKING PLAN (2A)**

THE OFFICIAL RECORD OF THIS SHEET IS THE ELECTRONIC FILE DIGITALLY SIGNED AND SEALED UNDER RULE 61G15-23.004, F.A.C.

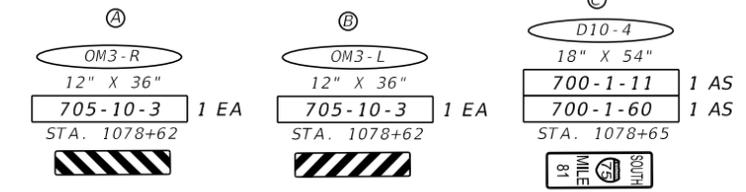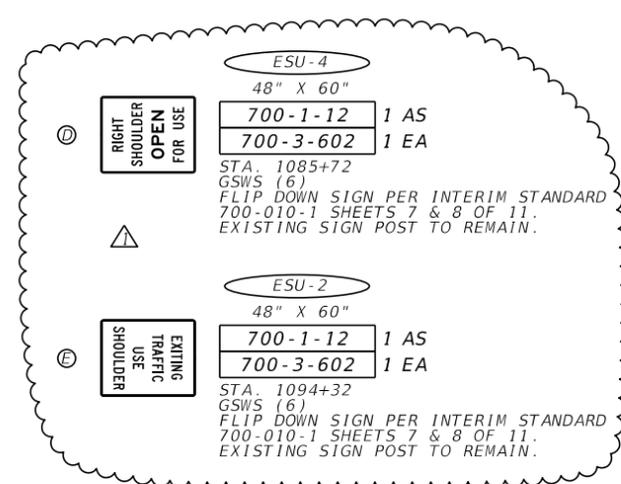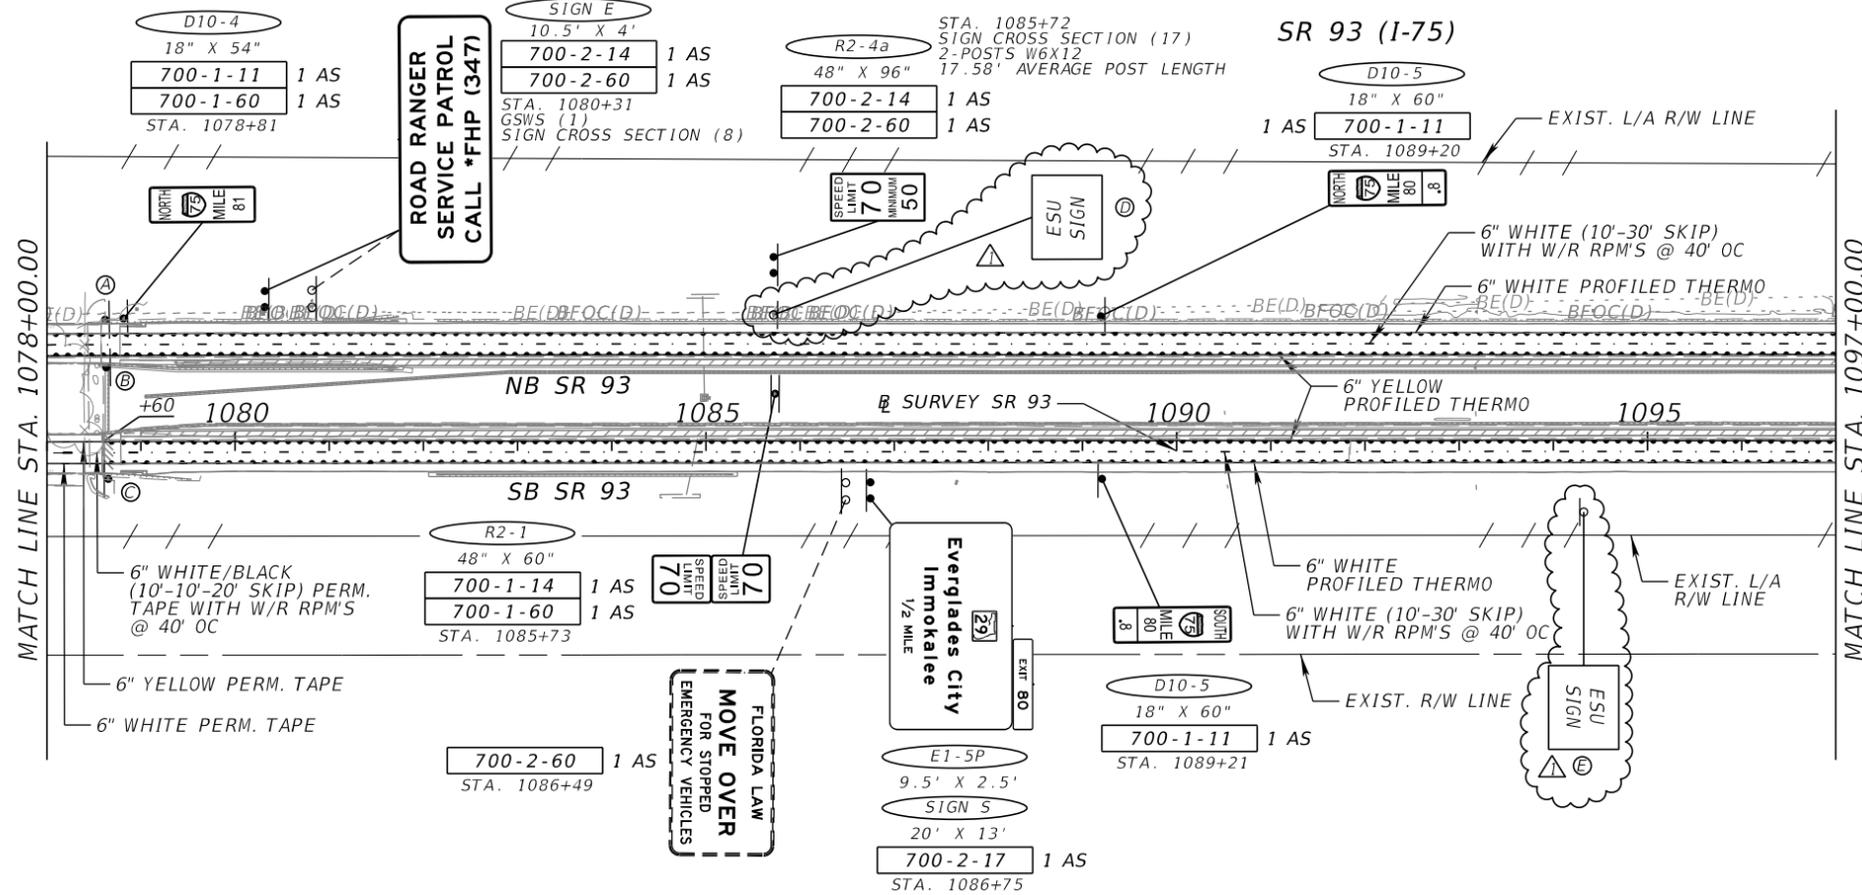

REVISIONS				PATRICIA T. CHRISTIE, P.E. P.E. NO.: 60049 FALLER, DAVIS & ASSOCIATES, INC. 4200 W. CYPRESS ST., SUITE 500 TAMPA, FLORIDA 33607-4168	STATE OF FLORIDA DEPARTMENT OF TRANSPORTATION			SIGNING AND PAVEMENT MARKING PLAN (25)	SHEET NO.
DATE	DESCRIPTION	DATE	DESCRIPTION		ROAD NO.	COUNTY	FINANCIAL PROJECT ID		
10/28/22	REPLACED EXISTING SIGN PANELS.					SR 93	COLLIER		444008-3-52-01

THE OFFICIAL RECORD OF THIS SHEET IS THE ELECTRONIC FILE DIGITALLY SIGNED AND SEALED UNDER RULE 61G15-23.004, F.A.C.

EXIST. L/A R/W LINE

SR 93 (I-75)

M3-1
36" X 18"
M1-1
36" X 36"
700-1-12 1 AS
700-1-60 1 AS
STA. 1098+89



D10-5
18" X 60"
700-1-11 1 AS
STA. 1099+76



ESU-3
48" X 60"
700-1-12 1 AS
700-3-602 1 EA

STA. 1100+64
GSWS (6)
FLIP DOWN SIGN PER INTERIM STANDARD
700-010-1 SHEETS 7 & 8 OF 11.
EXISTING SIGN POST TO REMAIN.



NO TRUCKS OR BUSES ON SHOULDER

705-11-2 1 EA
WHITE NON-FLEXIBLE DELINEATOR @ 300' OC

+14 END 6" WHITE PROFILED THERMO
BEGIN 6" WHITE W/ W/R RPM'S @ 40' OC (D)

6" WHITE WITH W/R RPM'S @ 40' OC



MATCH LINE STA. 1097+00.00

MATCH LINE STA. 1104+00.00

NB SR 93

SB SR 93

6" YELLOW PROFILED THERMO
6" WHITE (10'-30' SKIP) WITH W/R RPM'S @ 40' OC
6" YELLOW PROFILED THERMO


6" WHITE PROFILED THERMO



FTP-77R-6
36" X 36"
FTP-70-6
42" X 30"
700-1-12 1 AS
700-1-60 1 AS
STA. 1098+89



D10-5
18" X 60"
700-1-11 1 AS
STA. 1099+76

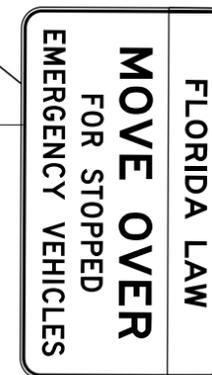

SIGN AD
15' X 8.5'
700-2-16 1 AS
STA. 1101+56

GSWS (5)
SIGN CROSS SECTION (9)

EXIST. L/A R/W LINE

REVISIONS		DATE	DESCRIPTION
DATE	DESCRIPTION	DATE	DESCRIPTION
10/28/22	REPLACED EXISTING SIGN PANEL.		

PATRICIA T. CHRISTIE, P.E.
P.E. NO.: 60049
FALLER, DAVIS & ASSOCIATES, INC.
4200 W. CYPRESS ST., SUITE 500
TAMPA, FLORIDA 33607-4168

STATE OF FLORIDA DEPARTMENT OF TRANSPORTATION		
ROAD NO.	COUNTY	FINANCIAL PROJECT ID
SR 93	COLLIER	444008-3-52-01

SIGNING AND PAVEMENT
MARKING PLAN (26)

SHEET NO.
S-35

THE OFFICIAL RECORD OF THIS SHEET IS THE ELECTRONIC FILE DIGITALLY SIGNED AND SEALED UNDER RULE 61G15-23.004, F.A.C.

SR 93 (I-75)

EXIST. L/A R/W LINE

D10-5
18" X 60"
700-1-11 1 AS
STA. 1110+30

NORTH
75
MILE
80
.4



700-1-60 1 AS
STA. 1104+99

NORTH
75
MILE
80
.5

705-11-2 3 EA
WHITE NON-FLEXIBLE
DELINEATOR @ 300' OC

6" WHITE (3'-9" SKIP)
WITH W/R RPM'S @ 24' OC

6" WHITE WITH W/R
RPM'S @ 40' OC

8" WHITE WITH W/R
RPM'S @ 20' OC

18" WHITE (TYP.)

NB SR 93

6" YELLOW
PROFILED THERMO

6" WHITE (10'-30" SKIP)
WITH W/R RPM'S @ 40' OC

6" YELLOW
PROFILED THERMO

SB SR 93

6" WHITE
PROFILED THERMO

D10-5
18" X 60"
700-1-11 1 AS
STA. 1110+32

SOUTH
75
MILE
80
.4

SOUTH
75
MILE
80
.5

700-1-60 1 AS
STA. 1104+89



EXIST. TO
REMAIN

EXIST. L/A R/W LINE

PAVEMENT MESSAGE (80)

Everglades City
Immokalee

29


EXIT
80

700-2-60 1 AS
STA. 1110+89

MATCH LINE STA. 1104+00.00

MATCH LINE STA. 1111+00.00

REVISIONS				PATRICIA T. CHRISTIE, P.E. P.E. NO.: 60049 FALLER, DAVIS & ASSOCIATES, INC. 4200 W. CYPRESS ST., SUITE 500 TAMPA, FLORIDA 33607-4168	STATE OF FLORIDA DEPARTMENT OF TRANSPORTATION			SIGNING AND PAVEMENT MARKING PLAN (27)	SHEET NO.
DATE	DESCRIPTION	DATE	DESCRIPTION		ROAD NO.	COUNTY	FINANCIAL PROJECT ID		
						SR 93	COLLIER		444008-3-52-01

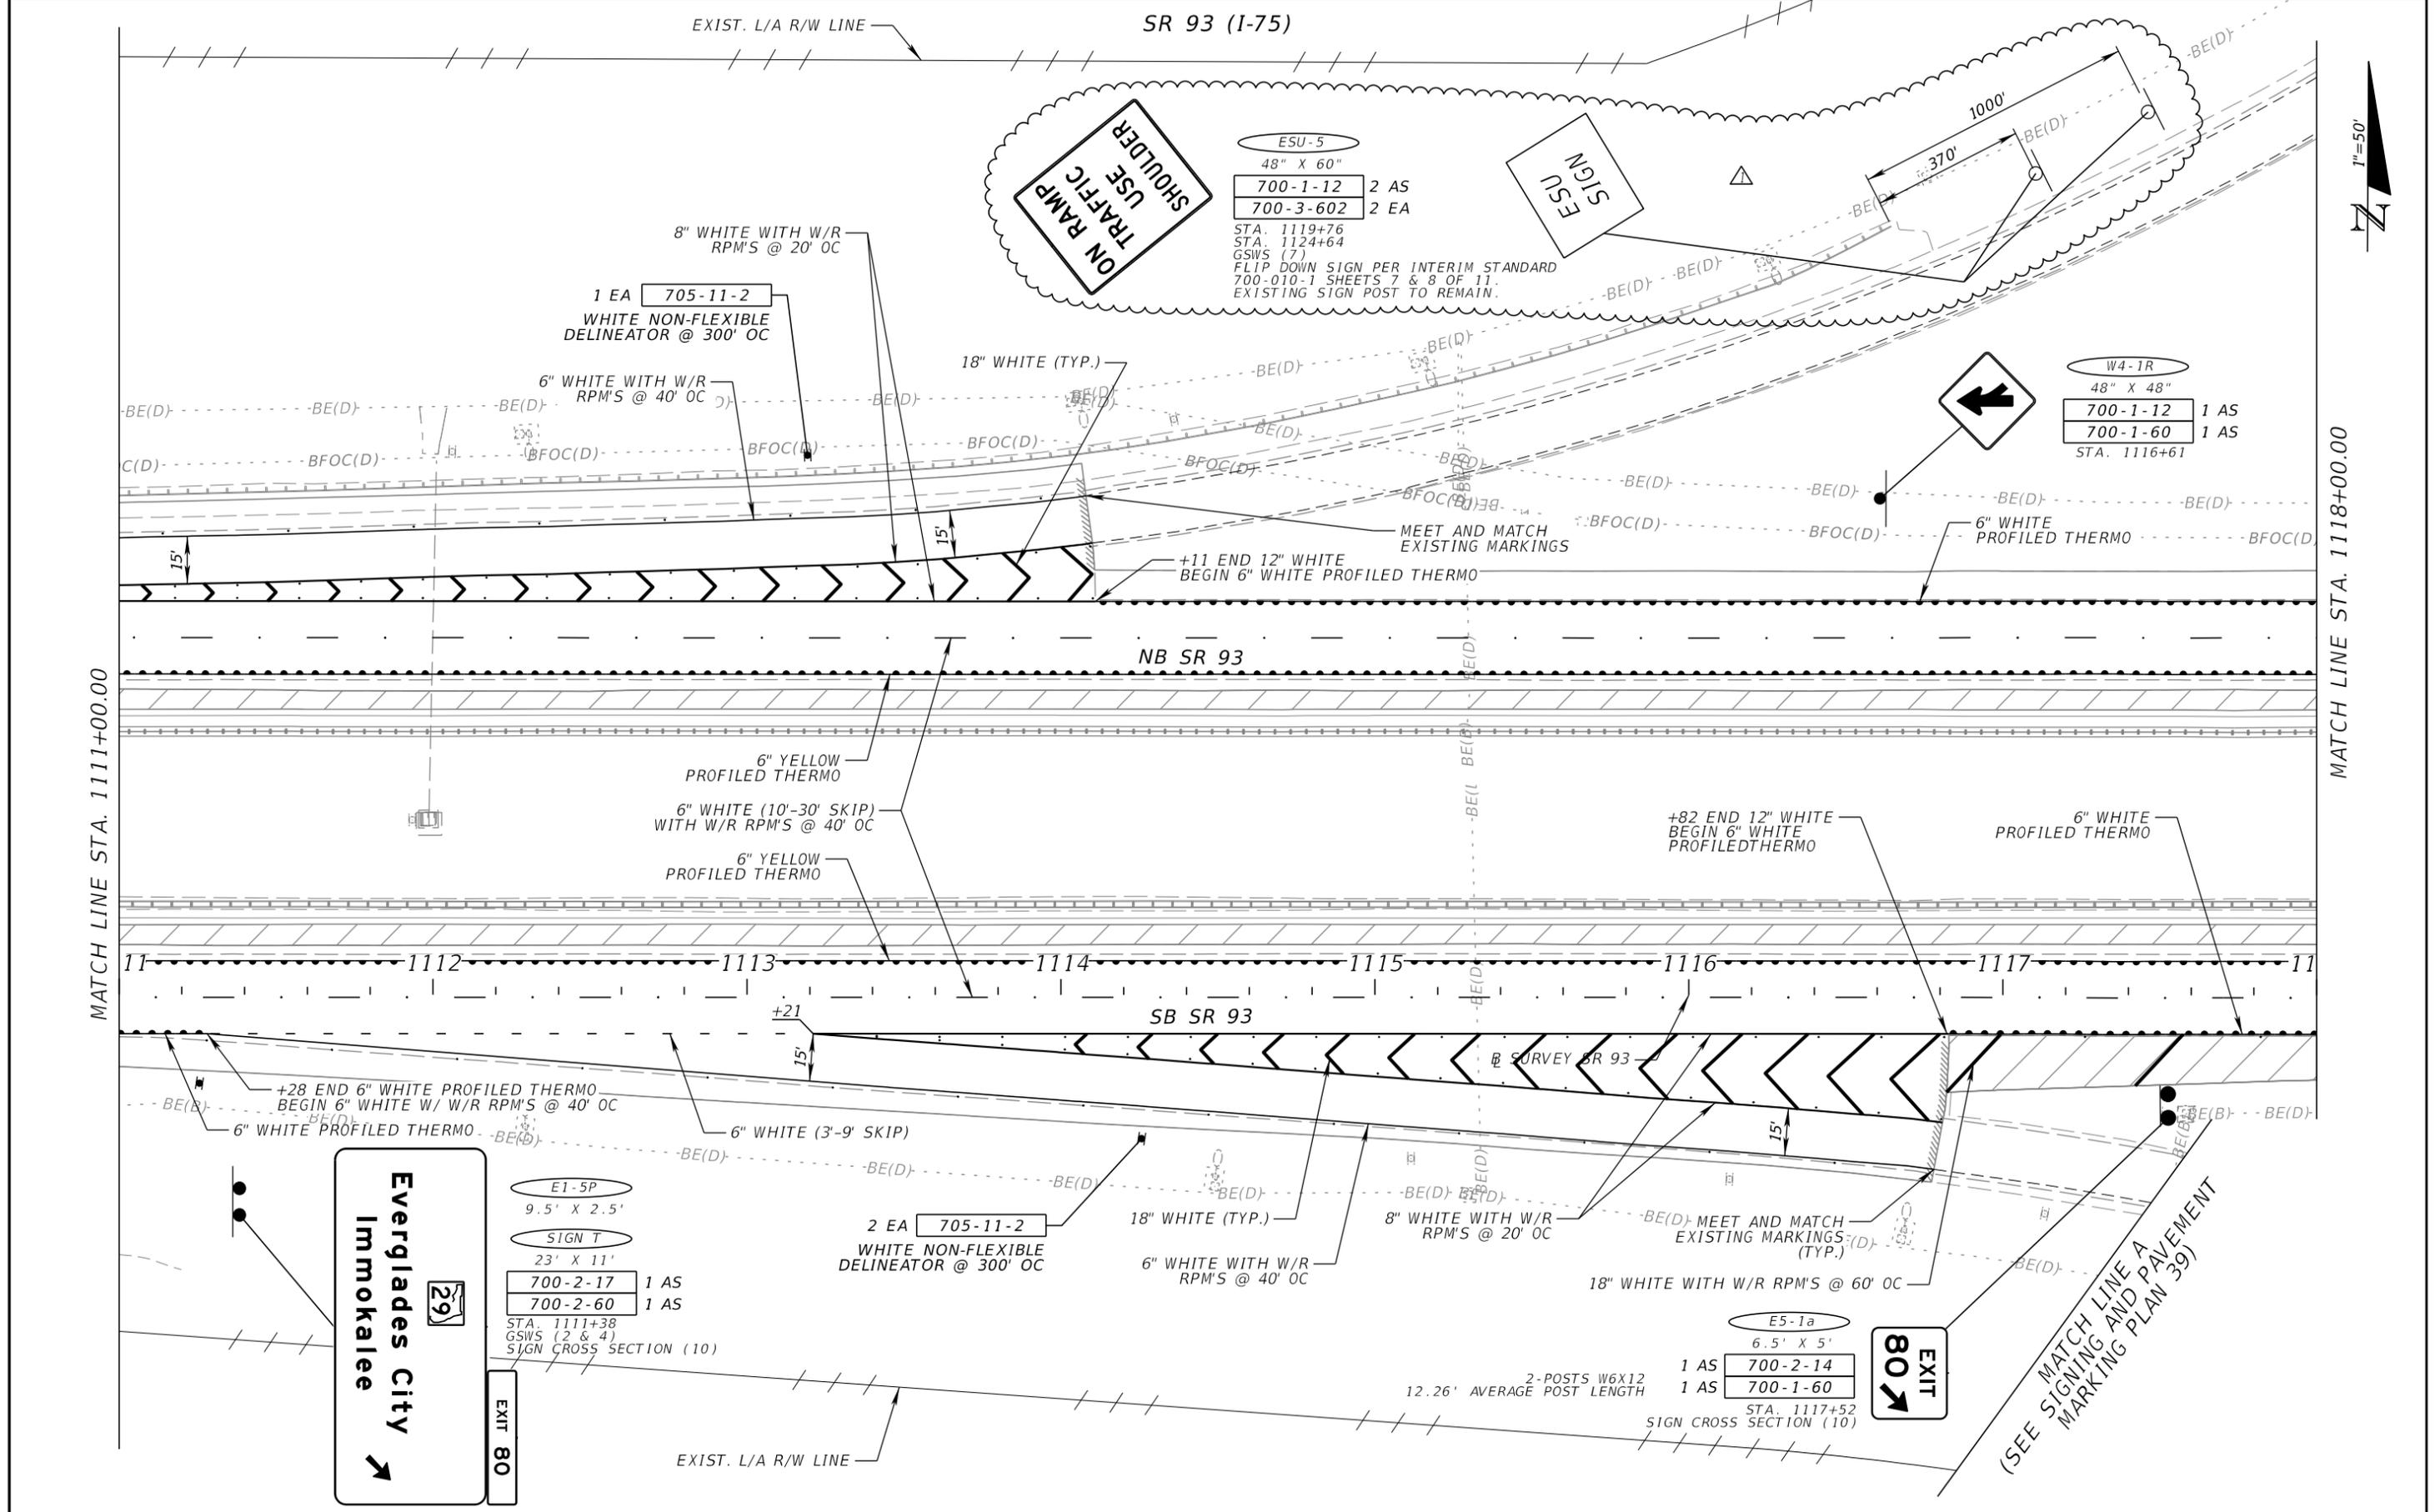

MATCH LINE STA. 1111+00.00

MATCH LINE STA. 1118+00.00


REVISIONS	
DATE	DESCRIPTION
10/28/22	REPLACED EXISTING SIGN PANELS.

PATRICIA T. CHRISTIE, P.E.
 P.E. NO.: 60049
 FALLER, DAVIS & ASSOCIATES, INC.
 4200 W. CYPRESS ST., SUITE 500
 TAMPA, FLORIDA 33607-4168

STATE OF FLORIDA DEPARTMENT OF TRANSPORTATION		
ROAD NO.	COUNTY	FINANCIAL PROJECT ID
SR 93	COLLIER	444008-3-52-01

**SIGNING AND PAVEMENT
MARKING PLAN (28)**





SHEET NO.
S-37

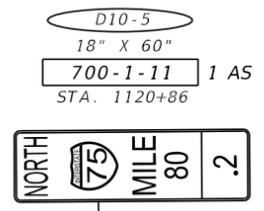

6" WHITE
PROFILED THERMO


6" YELLOW
PROFILED THERMO
6" WHITE (10'-30' SKIP)
WITH W/R RPM'S @ 40' OC
6" YELLOW
PROFILED THERMO

6" WHITE
PROFILED THERMO

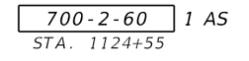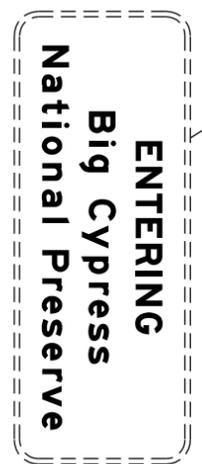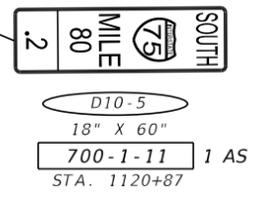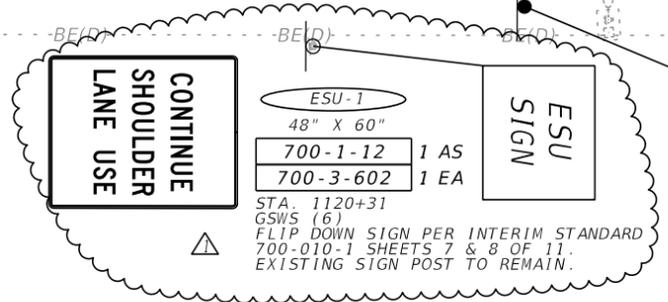


MATCH LINE STA. 1118+00.00

MATCH LINE STA. 1125+00.00

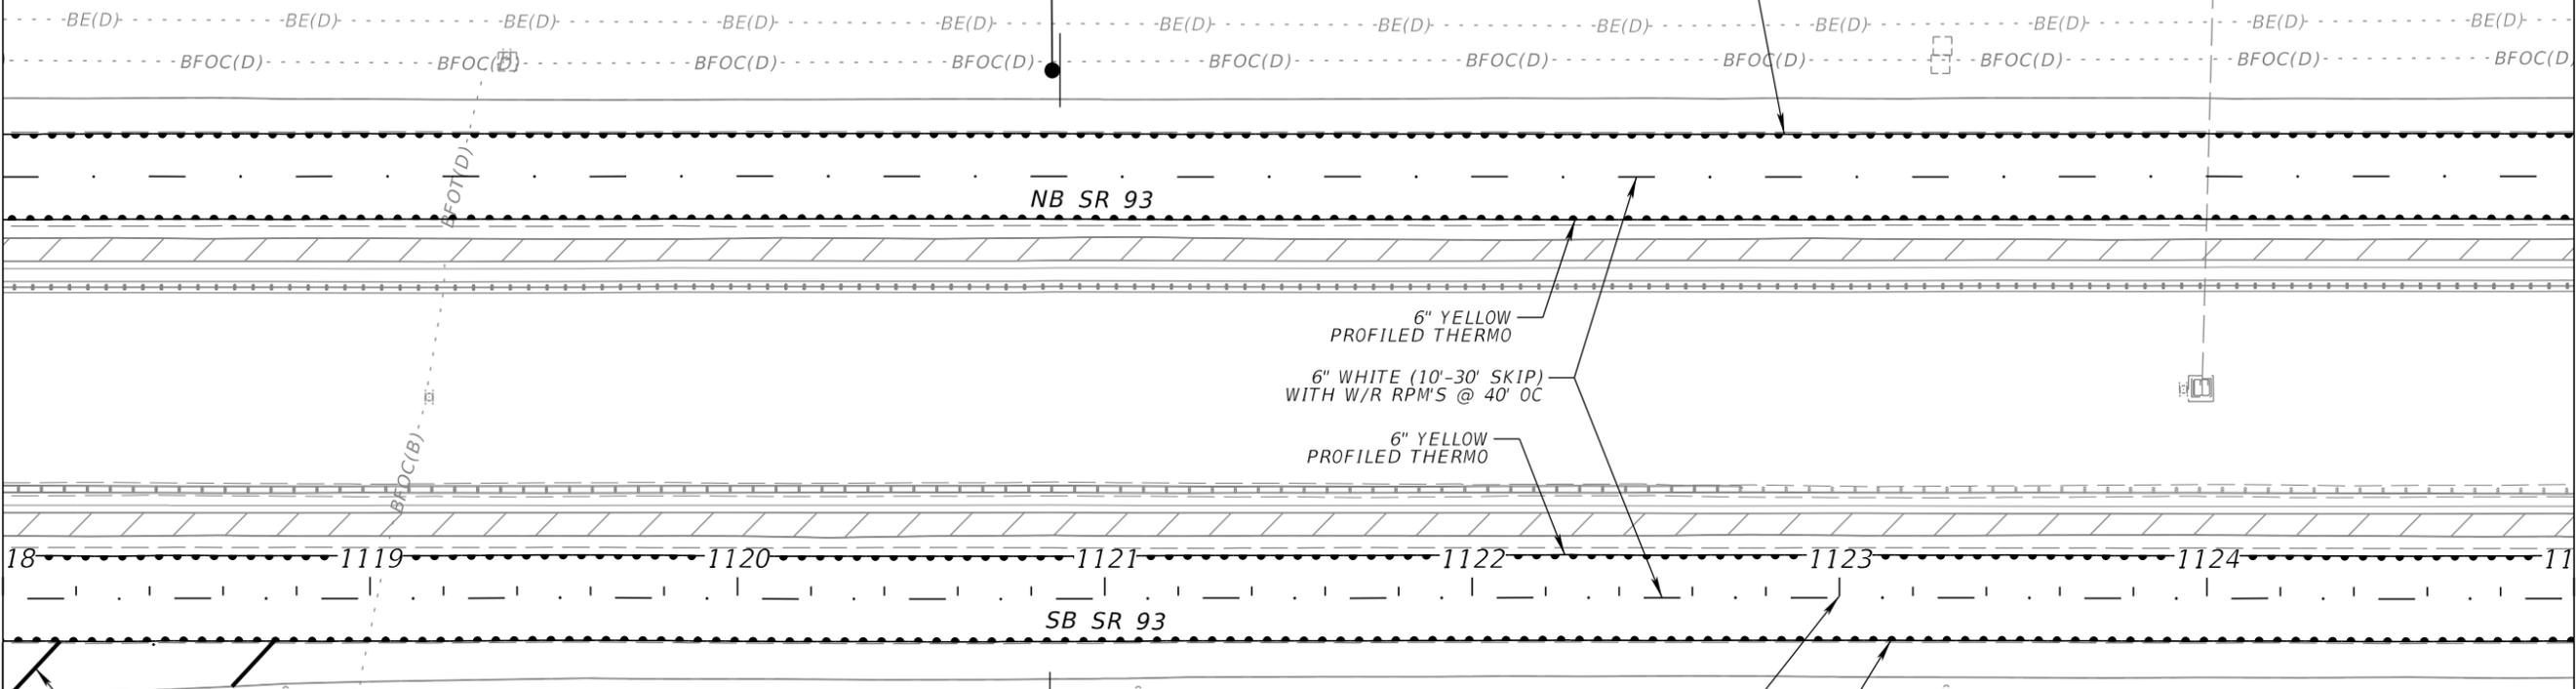

REVISIONS				PATRICIA T. CHRISTIE, P.E. P.E. NO.: 60049 FALLER, DAVIS & ASSOCIATES, INC. 4200 W. CYPRESS ST., SUITE 500 TAMPA, FLORIDA 33607-4168	STATE OF FLORIDA DEPARTMENT OF TRANSPORTATION			SIGNING AND PAVEMENT MARKING PLAN (29)	SHEET NO.
DATE	DESCRIPTION	DATE	DESCRIPTION		ROAD NO.	COUNTY	FINANCIAL PROJECT ID		
10/28/22	REPLACED EXISTING SIGN PANEL.					SR 93	COLLIER		444008-3-52-01

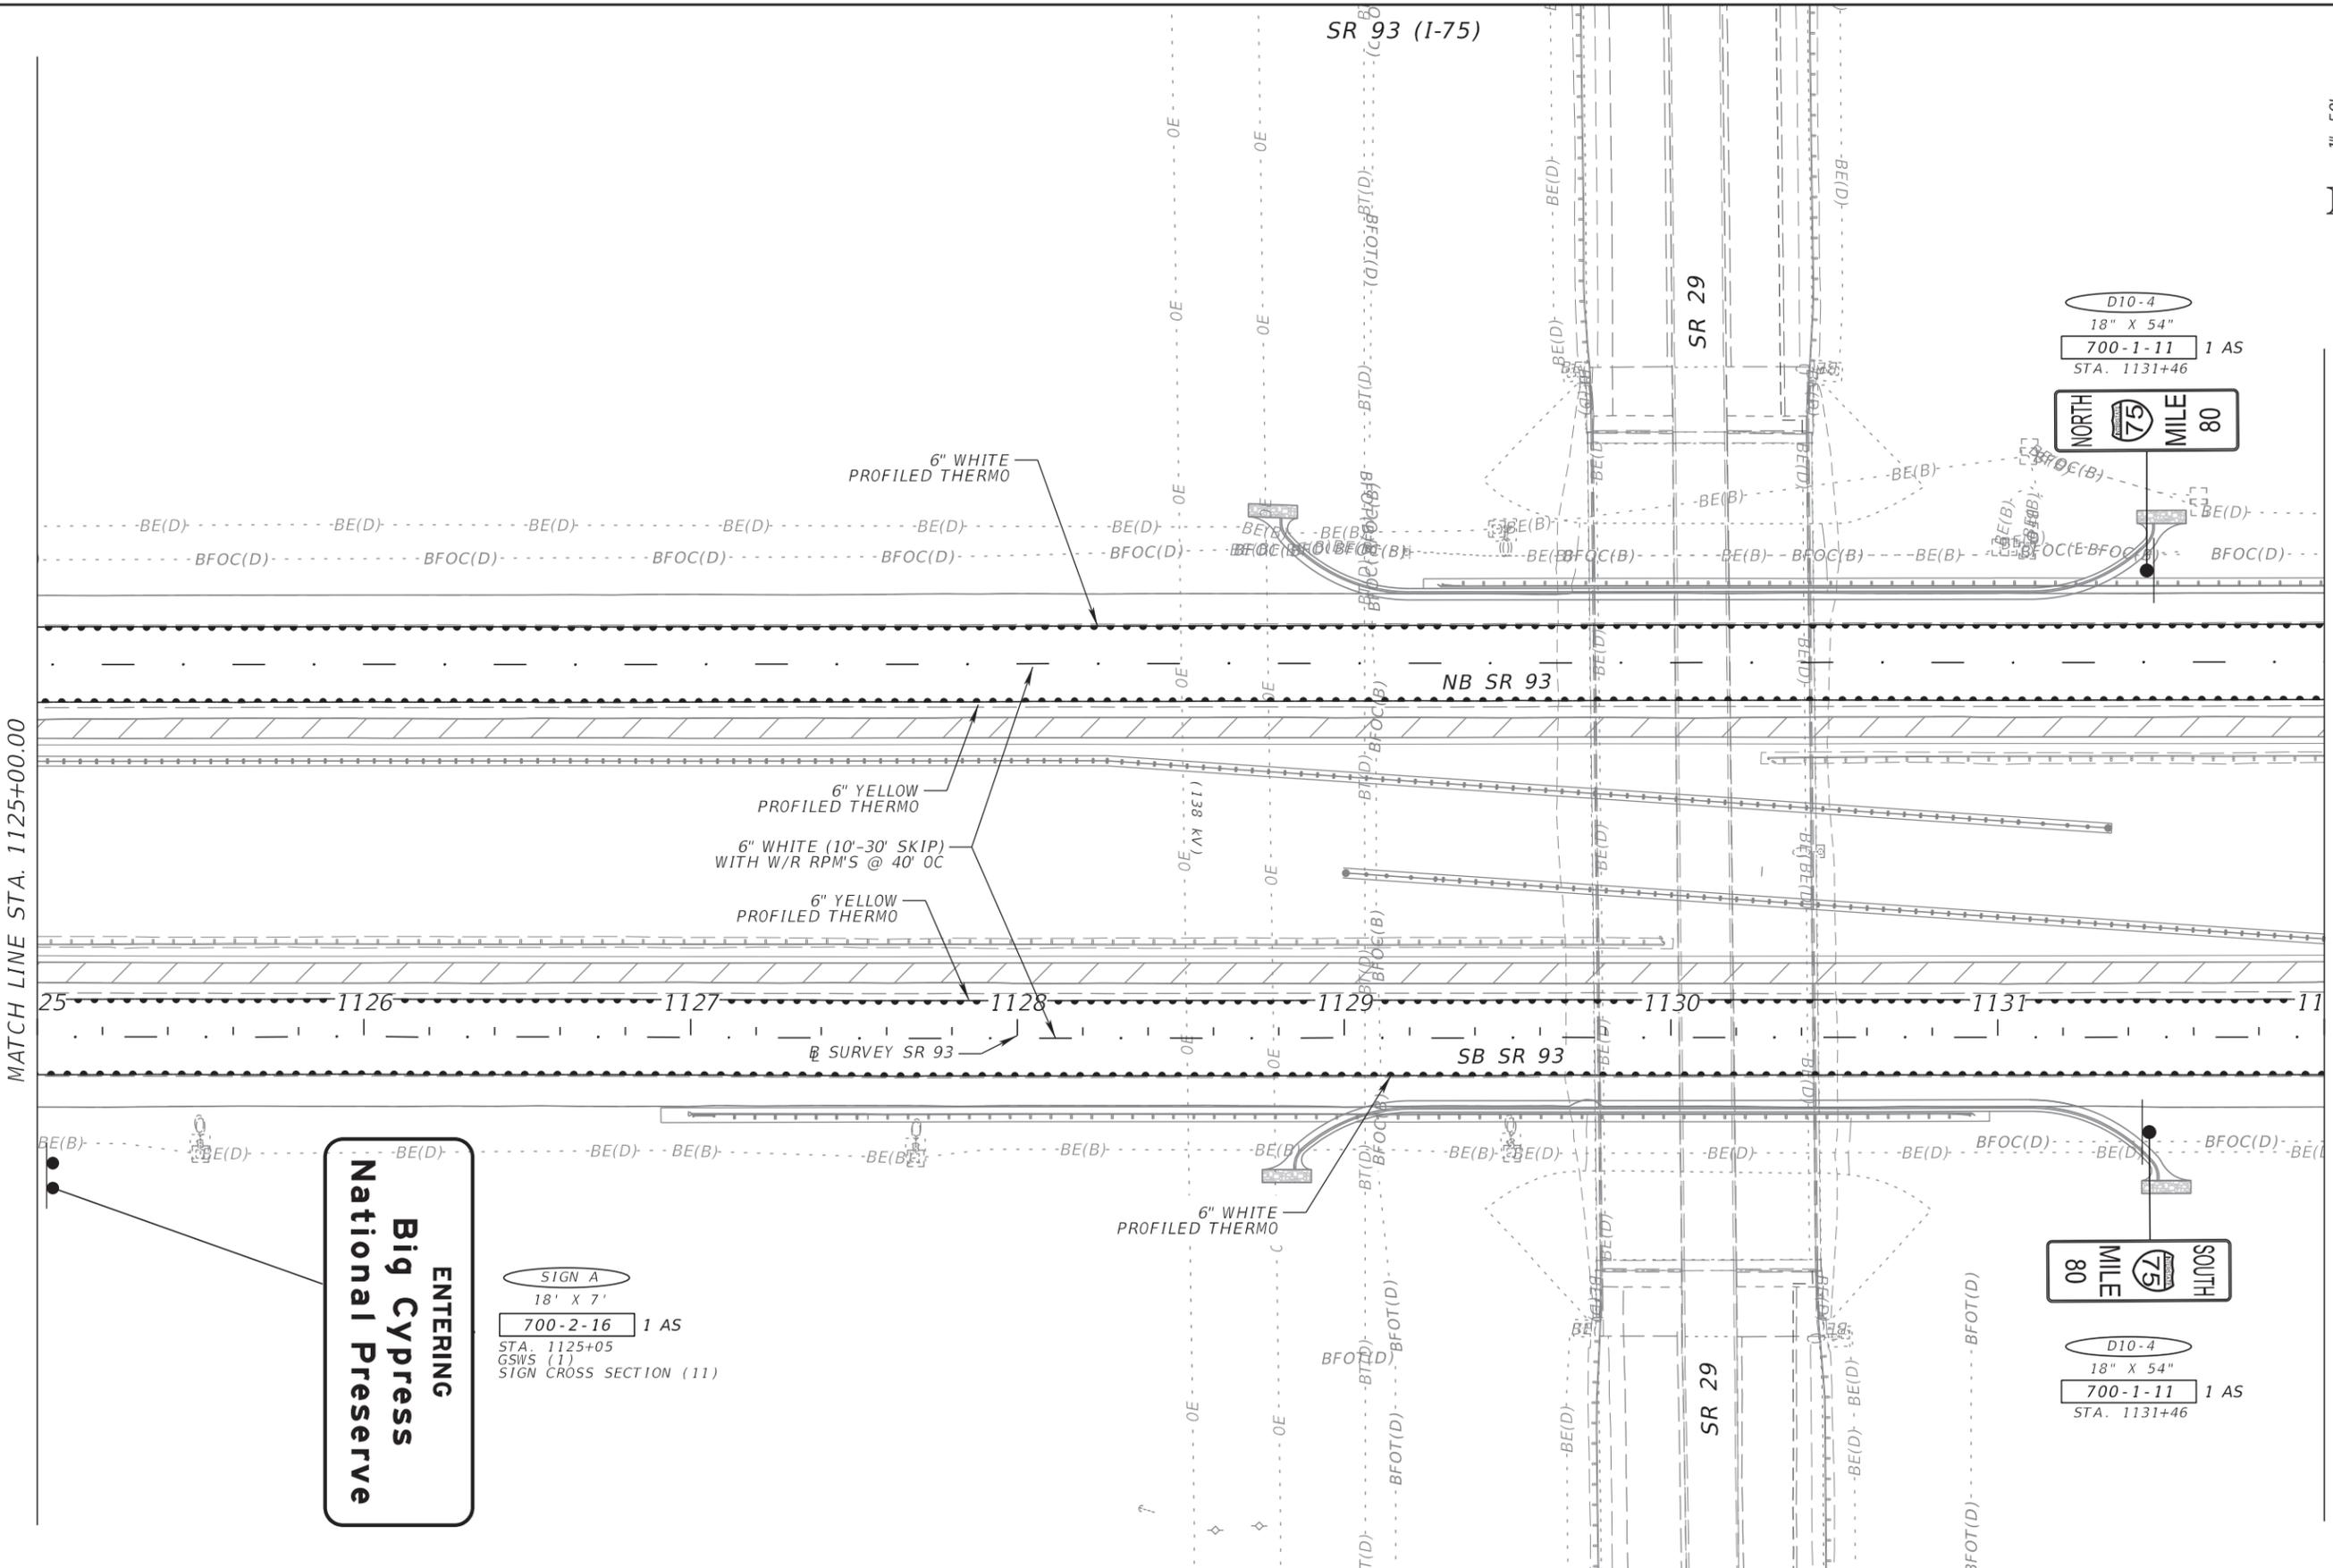

**ENTERING
Big Cypress
National Preserve**

SIGN A
18' X 7'
700-2-16 1 AS
STA. 1125+05
GSWS (1)
SIGN CROSS SECTION (11)

D10-4
18" X 54"
700-1-11 1 AS
STA. 1131+46

NORTH
75
MILE
80

80
MILE
75
SOUTH

D10-4
18" X 54"
700-1-11 1 AS
STA. 1131+46

REVISIONS				STATE OF FLORIDA DEPARTMENT OF TRANSPORTATION			SIGNING AND PAVEMENT MARKING PLAN (30)	SHEET NO. S-39
DATE	DESCRIPTION	DATE	DESCRIPTION	ROAD NO.	COUNTY	FINANCIAL PROJECT ID		
				SR 93	COLLIER	444008-3-52-01		


PATRICIA T. CHRISTIE, P.E.
P.E. NO.: 60049
FALLER, DAVIS & ASSOCIATES, INC.
4200 W. CYPRESS ST., SUITE 500
TAMPA, FLORIDA 33607-4168

THE OFFICIAL RECORD OF THIS SHEET IS THE ELECTRONIC FILE DIGITALLY SIGNED AND SEALED UNDER RULE 61G15-23.004, F.A.C.



**LEAVING
Big Cypress
National Preserve**

SIGN U
 18' X 7'
 700-2-16 1 AS
 700-2-60 1 AS
 STA. 1137+00 **+10**
 GWS (3)
 SIGN CROSS SECTION (11)

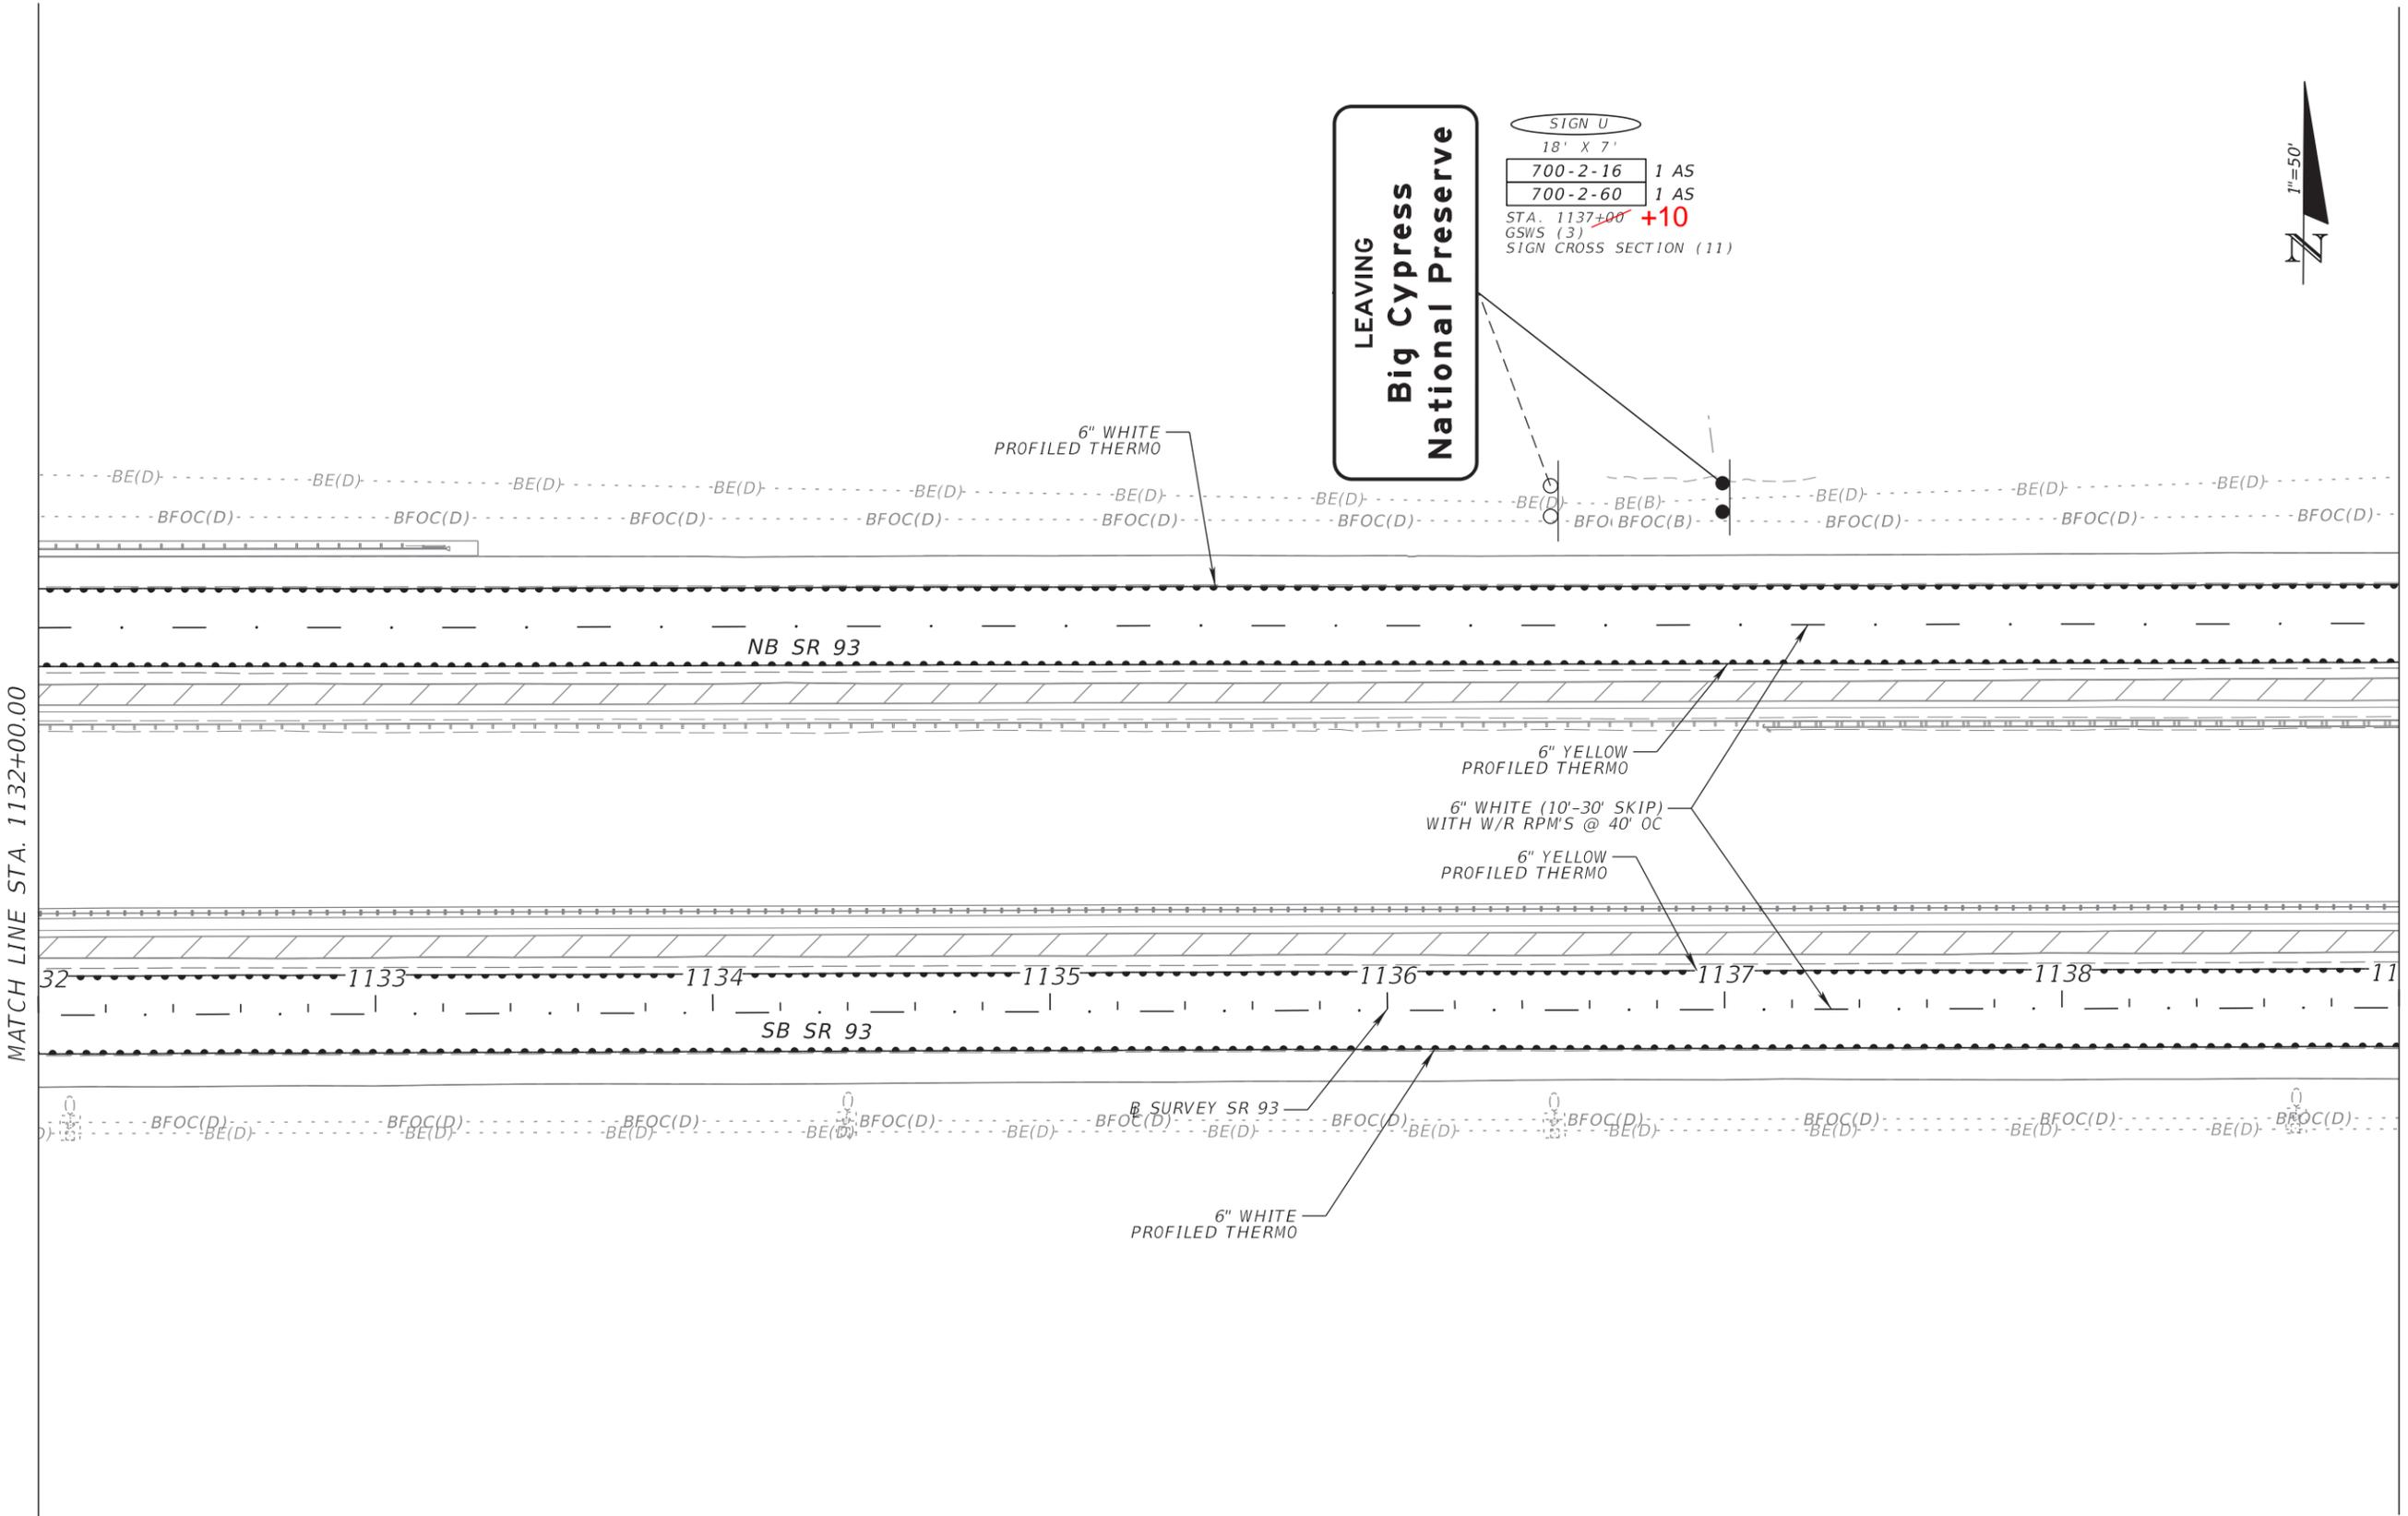

MATCH LINE STA. 1132+00.00

MATCH LINE STA. 1139+00.00

REVISIONS				PATRICIA T. CHRISTIE, P.E. P.E. NO.: 60049 FALLER, DAVIS & ASSOCIATES, INC. 4200 W. CYPRESS ST., SUITE 500 TAMPA, FLORIDA 33607-4168	STATE OF FLORIDA DEPARTMENT OF TRANSPORTATION			SIGNING AND PAVEMENT MARKING PLAN (31)	SHEET NO.
DATE	DESCRIPTION	DATE	DESCRIPTION		ROAD NO.	COUNTY	FINANCIAL PROJECT ID		S-40
					SR 93	COLLIER	444008-3-52-01		

THE OFFICIAL RECORD OF THIS SHEET IS THE ELECTRONIC FILE DIGITALLY SIGNED AND SEALED UNDER RULE 61G15-23.004, F.A.C.

SR 93 (I-75)



D10-5
18" X 60"
700-1-11 1 AS
STA. 1141+96

NORTH
MILE 79.8

E5-1a
6.5' X 5'
700-2-14 1 AS
700-2-60 1 AS
STA. 1142+51
SIGN CROSS SECTION (12)
2-POSTS W6X12
12.52' AVERAGE POST LENGTH

EXIT 80


(SEE MATCH LINE F
SIGNING AND PAVEMENT
MARKING PLAN 44)

CONTINUE
SHOULDER
LANE USE

ESU-1
48" X 60"
700-1-12 1 AS
700-3-602 1 EA
STA. 1140+48
GSWS (6)
FLIP DOWN SIGN PER INTERIM
STANDARD 700-010-1 SHEETS
7 & 8 OF 11.
EXISTING SIGN POST TO REMAIN.

ESU SIGN


2 EA 705-11-2
WHITE
NON-FLEXIBLE
DELINEATOR
@ 300' OC

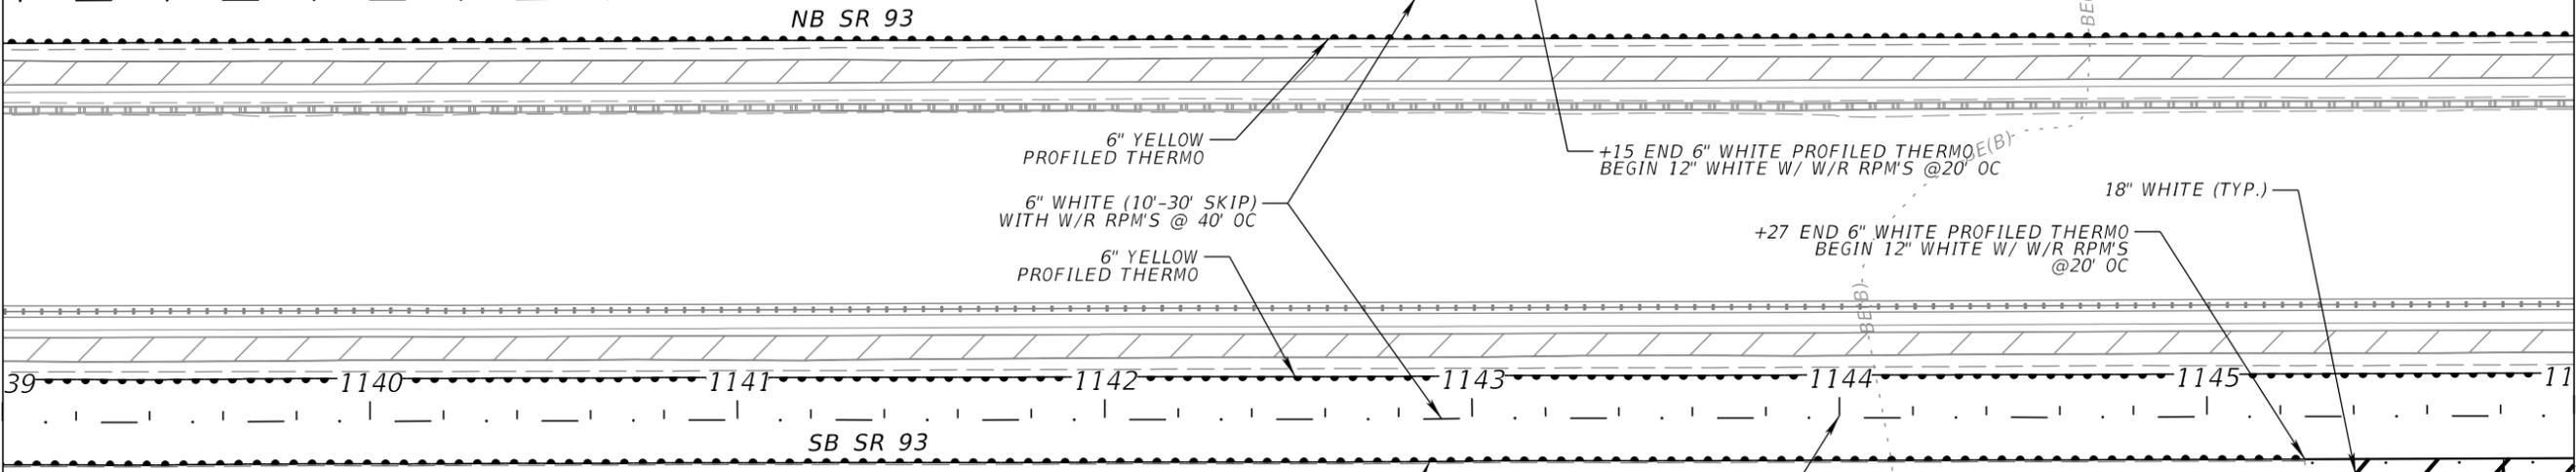

SOUTH
MILE 79.8

D10-5
18" X 60"
700-1-11 1 AS
STA. 1141+98

W4-1R
48" X 48"
700-1-12 1 AS
700-1-60 1 AS
STA. 1144+30

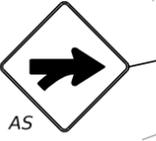

ON RAMP
TRAFFIC
USE
SHOULDER

ESU-5
48" X 60"
700-1-12 2 AS
700-3-602 2 EA
STA. 1137+56
STA. 1141+26
GSWS (7)
FLIP DOWN SIGN PER INTERIM STANDARD
700-010-1 SHEETS 7 & 8 OF 11.
EXISTING SIGN POST TO REMAIN.

ESU SIGN

1 AS 700-1-60
2 EA 705-11-2
WHITE NON-FLEXIBLE
DELINEATOR @ 40' OC
6" WHITE WITH W/R
RPM'S @ 40' OC
8" WHITE WITH W/R
RPM'S @ 20' OC

REVISIONS			
DATE	DESCRIPTION	DATE	DESCRIPTION
10/28/22	REPLACED EXISTING SIGN PANELS. REMOVED YIELD SIGN ASSEMBLY.		

PATRICIA T. CHRISTIE, P.E.
P.E. NO.: 60049
FALLER, DAVIS & ASSOCIATES, INC.
4200 W. CYPRESS ST., SUITE 500
TAMPA, FLORIDA 33607-4168

STATE OF FLORIDA DEPARTMENT OF TRANSPORTATION		
ROAD NO.	COUNTY	FINANCIAL PROJECT ID
SR 93	COLLIER	444008-3-52-01

**SIGNING AND PAVEMENT
MARKING PLAN (32)**

SHEET
NO.
S-41

THE OFFICIAL RECORD OF THIS SHEET IS THE ELECTRONIC FILE DIGITALLY SIGNED AND SEALED UNDER RULE 61G15-23.004, F.A.C.

SR 93 (I-75)

EXIT 80


Everglades City
Immokalee

- E1-5P
9.5' X 2.5'
- SIGN T
23' X 11'
- 700-2-17 1 AS
- 700-2-60 1 AS
- STA. 1148+97
- GSWS (2 & 4)
- SIGN CROSS SECTION (12)

- D10-5
18" X 60"
- 700-1-11 1 AS
- STA. 1152+52

NORTH

75 MILE 79 .6

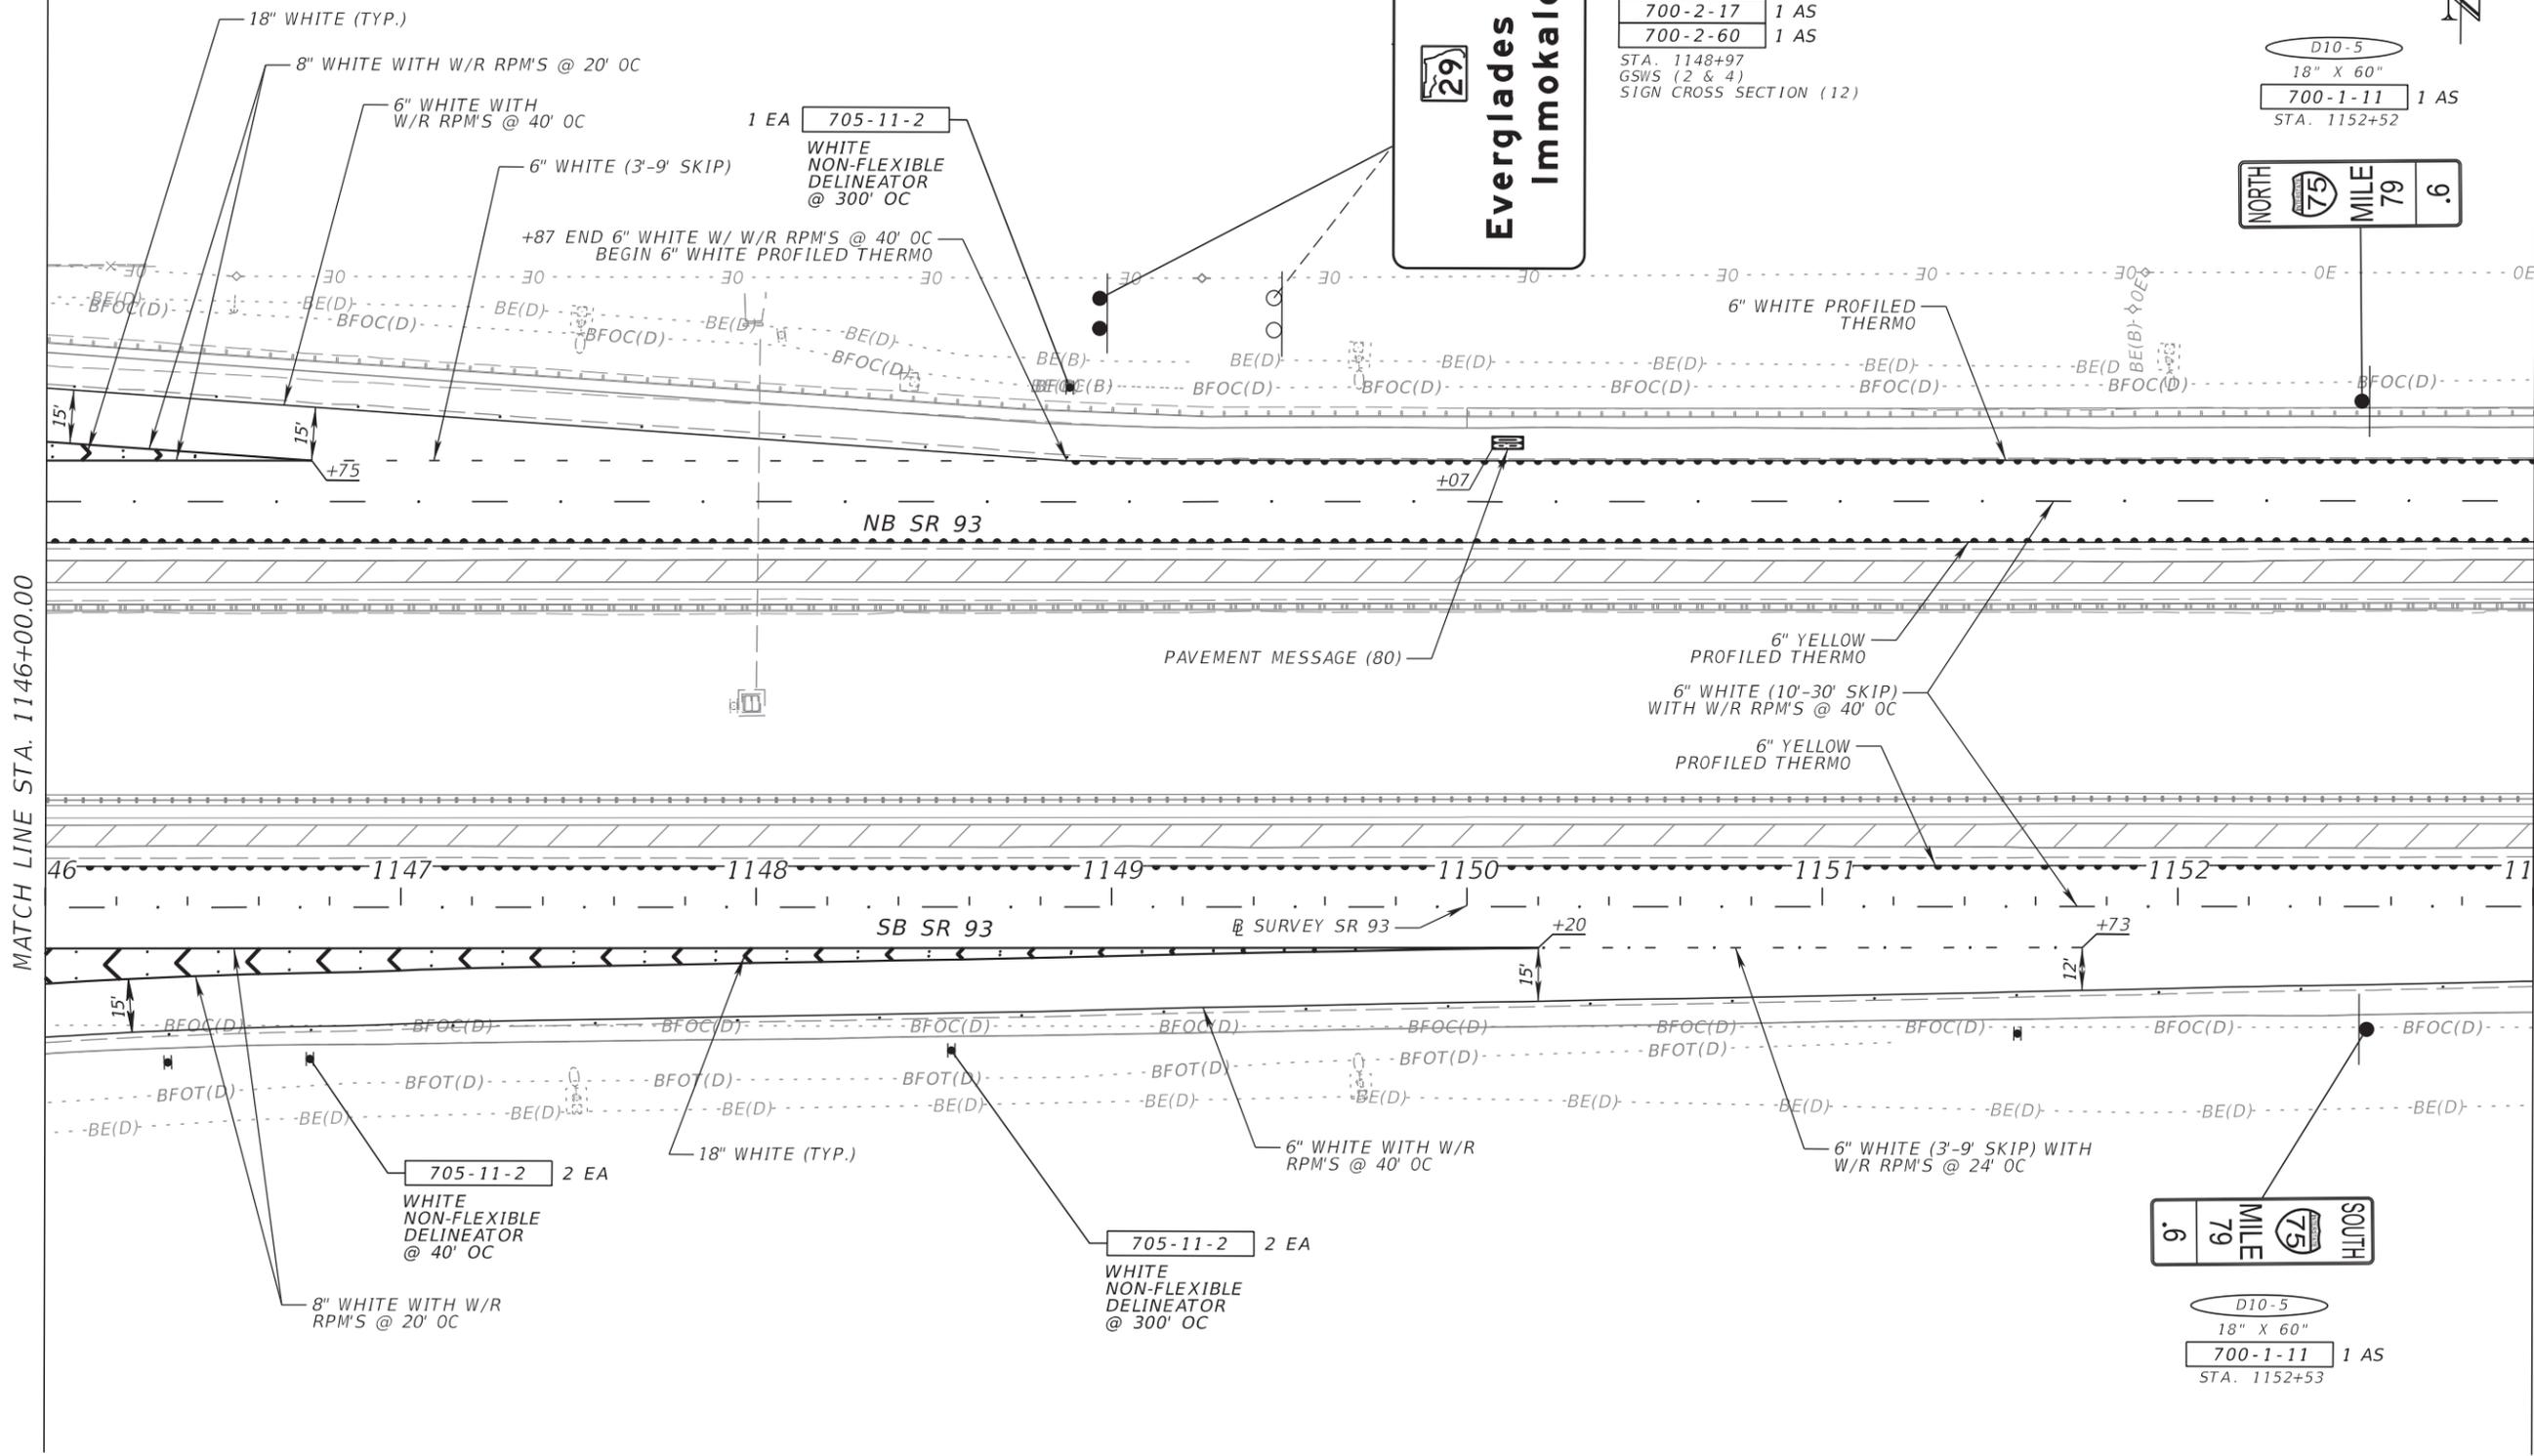


MATCH LINE STA. 1146+00.00

MATCH LINE STA. 1153+00.00

REVISIONS				PATRICIA T. CHRISTIE, P.E. P.E. NO.: 60049 FALLER, DAVIS & ASSOCIATES, INC. 4200 W. CYPRESS ST., SUITE 500 TAMPA, FLORIDA 33607-4168	STATE OF FLORIDA DEPARTMENT OF TRANSPORTATION			SIGNING AND PAVEMENT MARKING PLAN (33)	SHEET NO. S-42
DATE	DESCRIPTION	DATE	DESCRIPTION		ROAD NO.	COUNTY	FINANCIAL PROJECT ID		
					SR 93	COLLIER	444008-3-52-01		

THE OFFICIAL RECORD OF THIS SHEET IS THE ELECTRONIC FILE DIGITALLY SIGNED AND SEALED UNDER RULE 61G15-23.004, F.A.C.

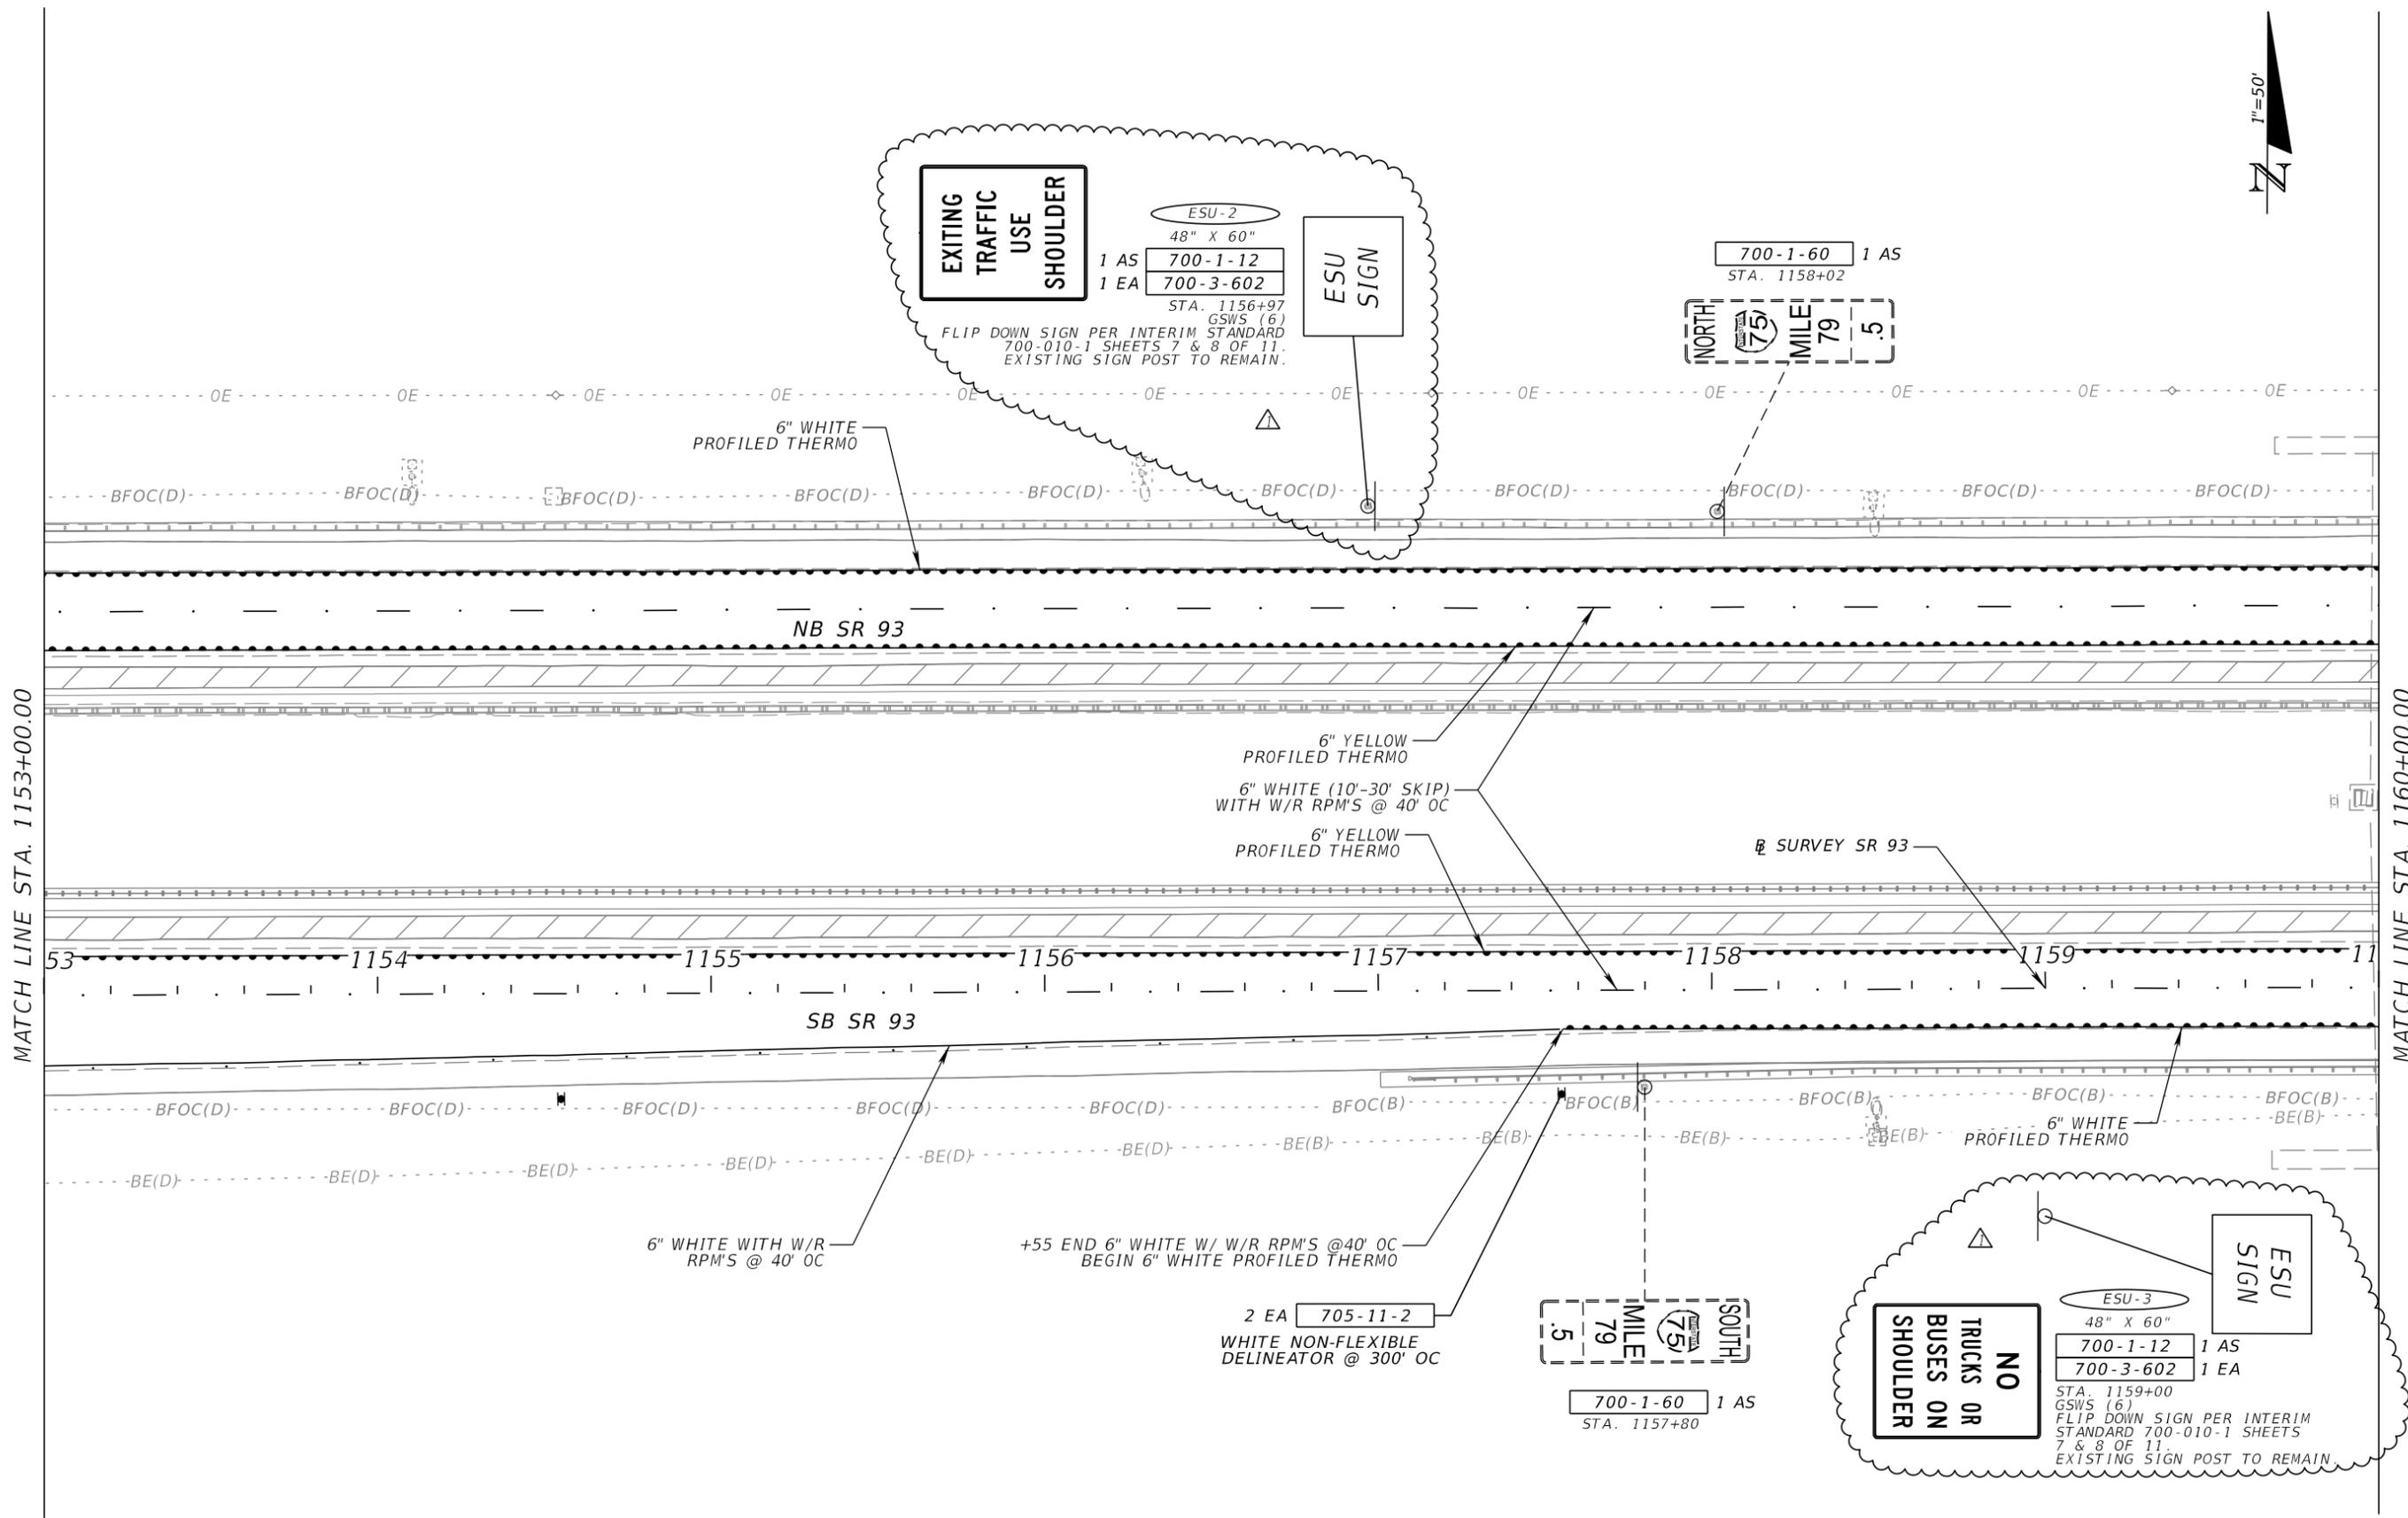

MATCH LINE STA. 1153+00.00

MATCH LINE STA. 1160+00.00

REVISIONS	
DATE	DESCRIPTION
10/28/22	REPLACED EXISTING SIGN PANELS.

PATRICIA T. CHRISTIE, P.E.
 P.E. NO.: 60049
 FALLER, DAVIS & ASSOCIATES, INC.
 4200 W. CYPRESS ST., SUITE 500
 TAMPA, FLORIDA 33607-4168




STATE OF FLORIDA DEPARTMENT OF TRANSPORTATION		
ROAD NO.	COUNTY	FINANCIAL PROJECT ID
SR 93	COLLIER	444008-3-52-01

**SIGNING AND PAVEMENT
 MARKING PLAN (34)**

SHEET NO.
 S-43

THE OFFICIAL RECORD OF THIS SHEET IS THE ELECTRONIC FILE DIGITALLY SIGNED AND SEALED UNDER RULE 61G15-23.004, F.A.C.

SR 93 (I-75)

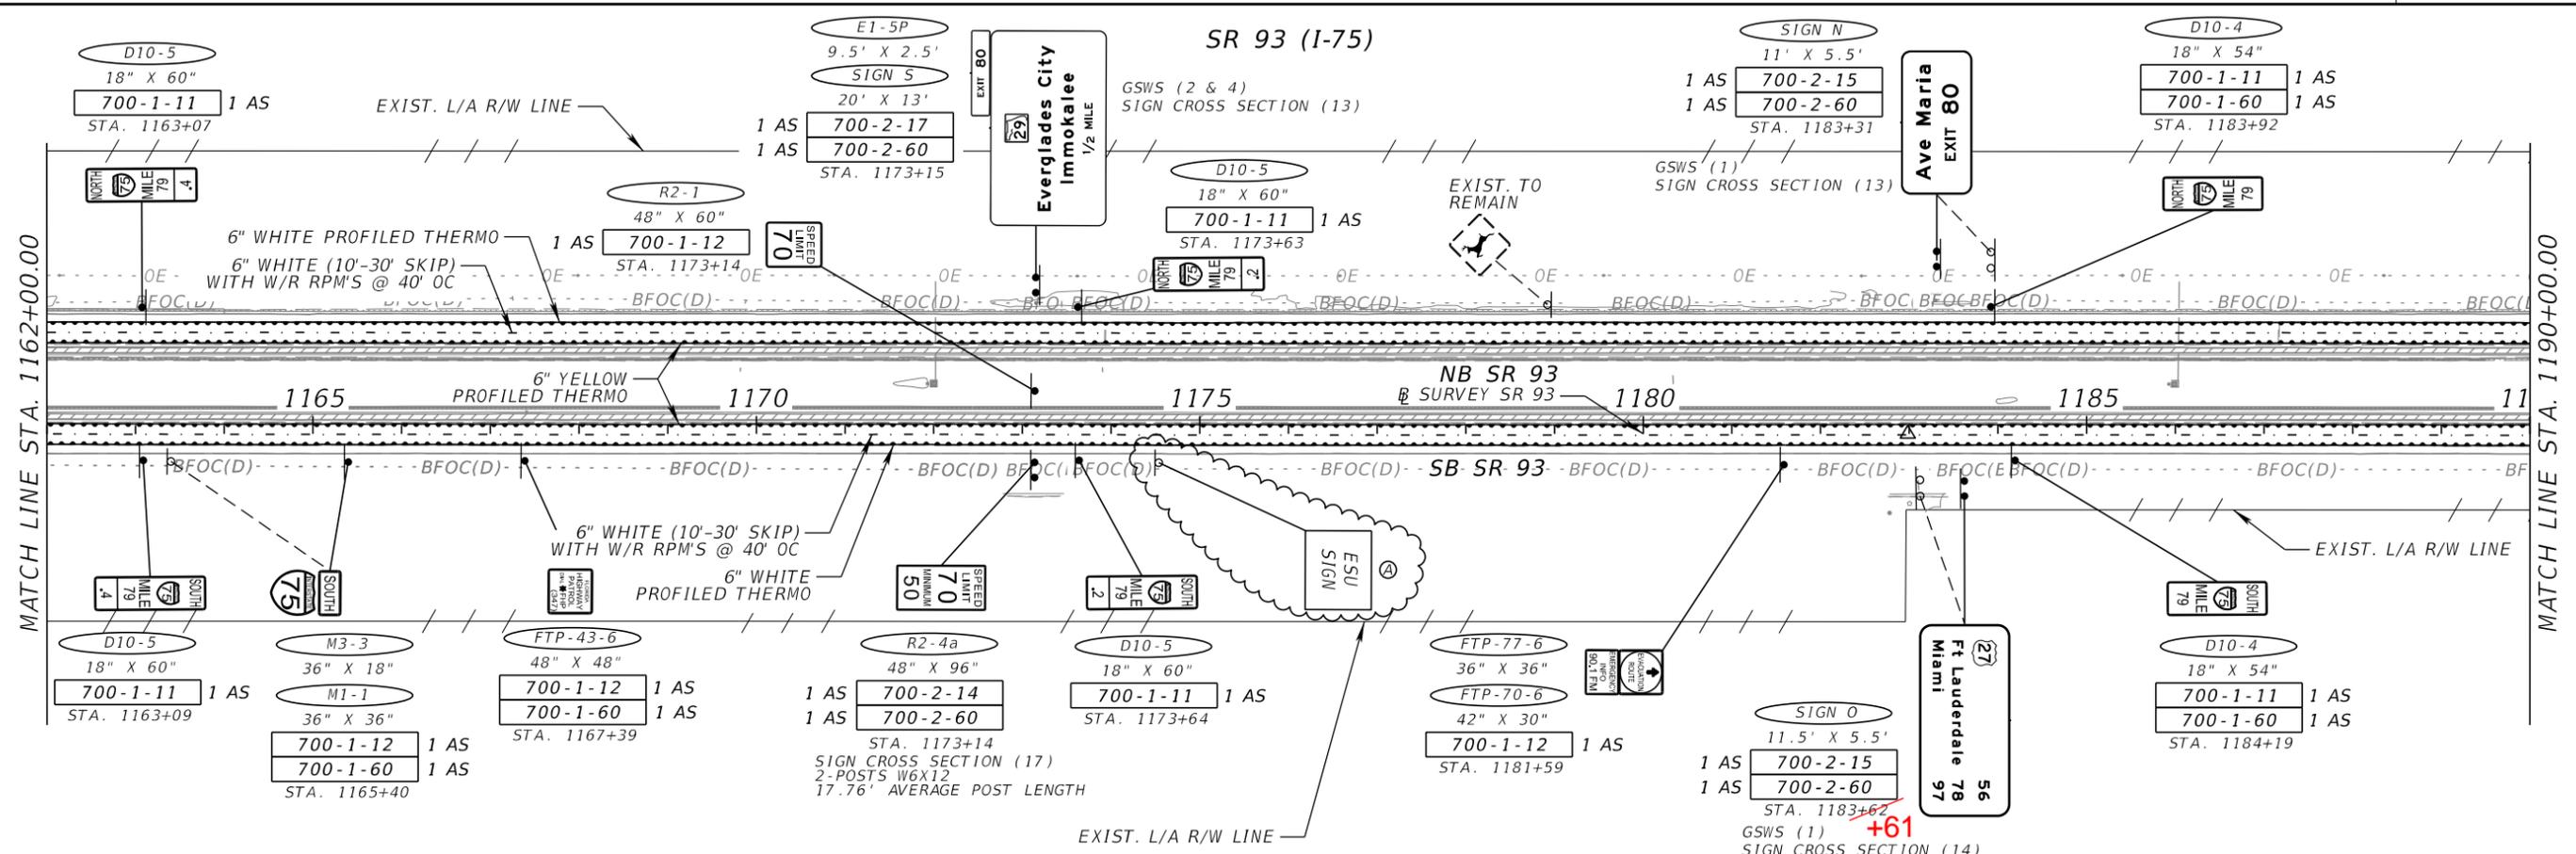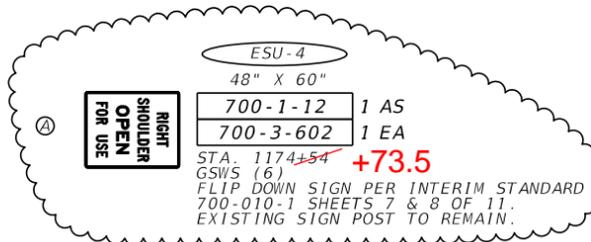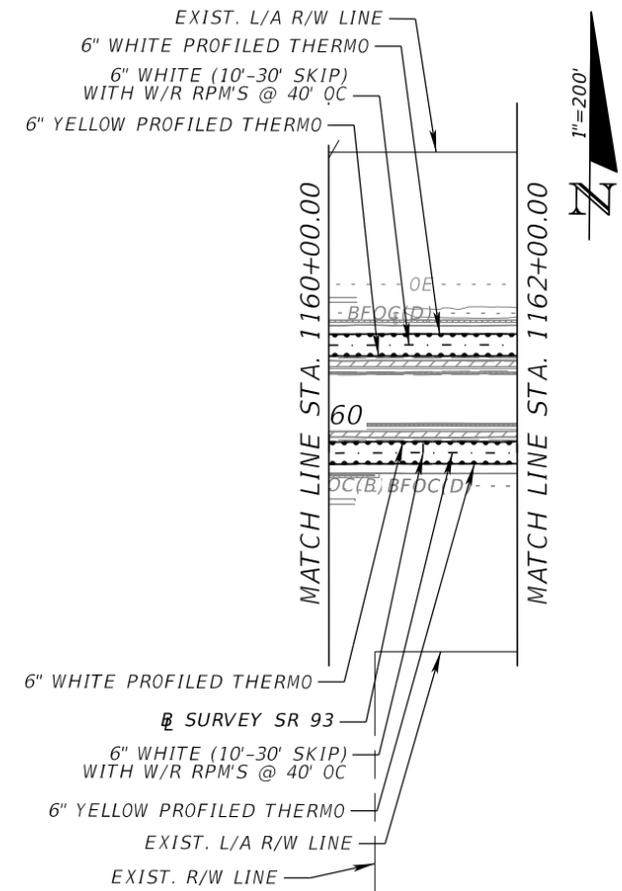

REVISIONS	
DATE	DESCRIPTION
10/28/22	REPLACED EXISTING SIGN PANEL.



PATRICIA T. CHRISTIE, P.E.
 P.E. NO.: 60049
 FALLER, DAVIS & ASSOCIATES, INC.
 4200 W. CYPRESS ST., SUITE 500
 TAMPA, FLORIDA 33607-4168

STATE OF FLORIDA DEPARTMENT OF TRANSPORTATION		
ROAD NO.	COUNTY	FINANCIAL PROJECT ID
SR 93	COLLIER	444008-3-52-01

**SIGNING AND PAVEMENT
 MARKING PLAN (35)**

SHEET NO.
 S-44

THE OFFICIAL RECORD OF THIS SHEET IS THE ELECTRONIC FILE DIGITALLY SIGNED AND SEALED UNDER RULE 61G15-23.004, F.A.C.

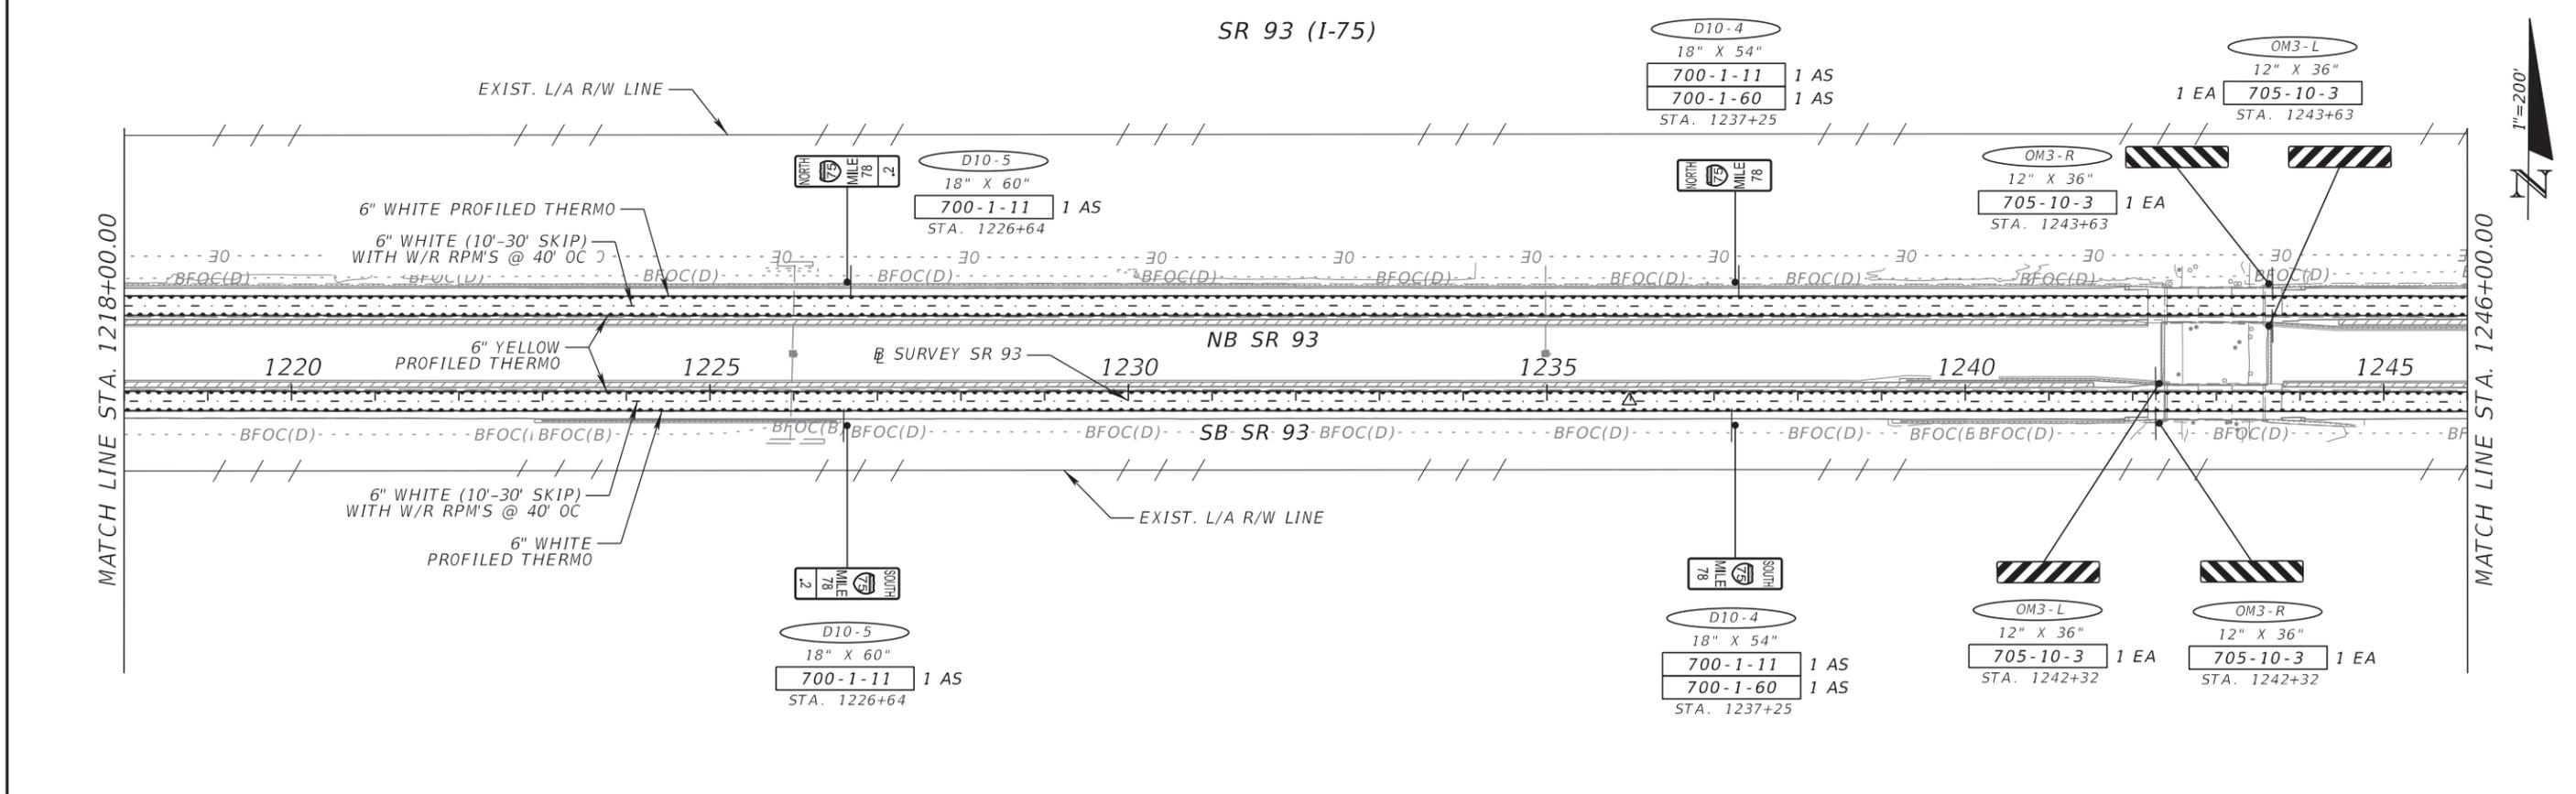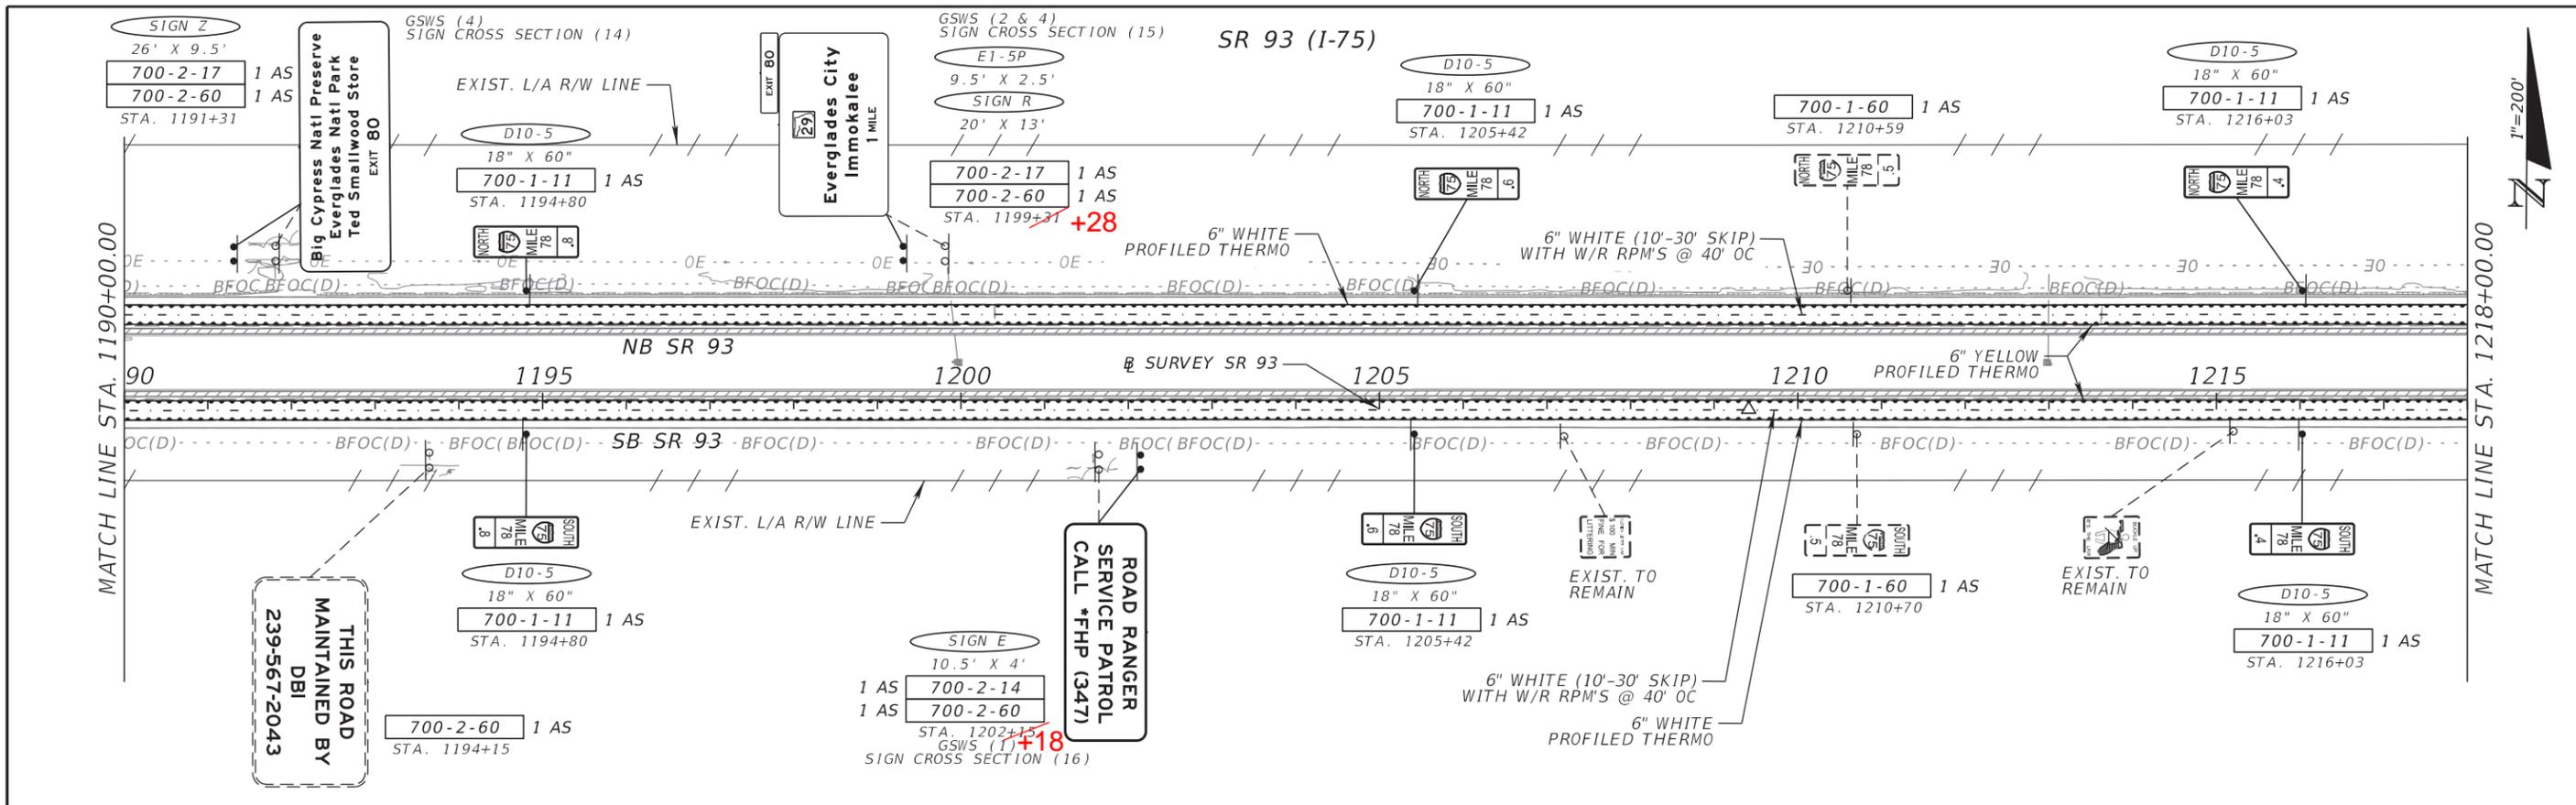

REVISIONS			
DATE	DESCRIPTION	DATE	DESCRIPTION



PATRICIA T. CHRISTIE, P.E.
P.E. NO.: 60049
FALLER, DAVIS & ASSOCIATES, INC.
4200 W. CYPRESS ST., SUITE 500
TAMPA, FLORIDA 33607-4168

STATE OF FLORIDA DEPARTMENT OF TRANSPORTATION		
ROAD NO.	COUNTY	FINANCIAL PROJECT ID
SR 93	COLLIER	444008-3-52-01

**SIGNING AND PAVEMENT
MARKING PLAN (36)**


SHEET NO.
S-45

THE OFFICIAL RECORD OF THIS SHEET IS THE ELECTRONIC FILE DIGITALLY SIGNED AND SEALED UNDER RULE 61G15-23.004, F.A.C.

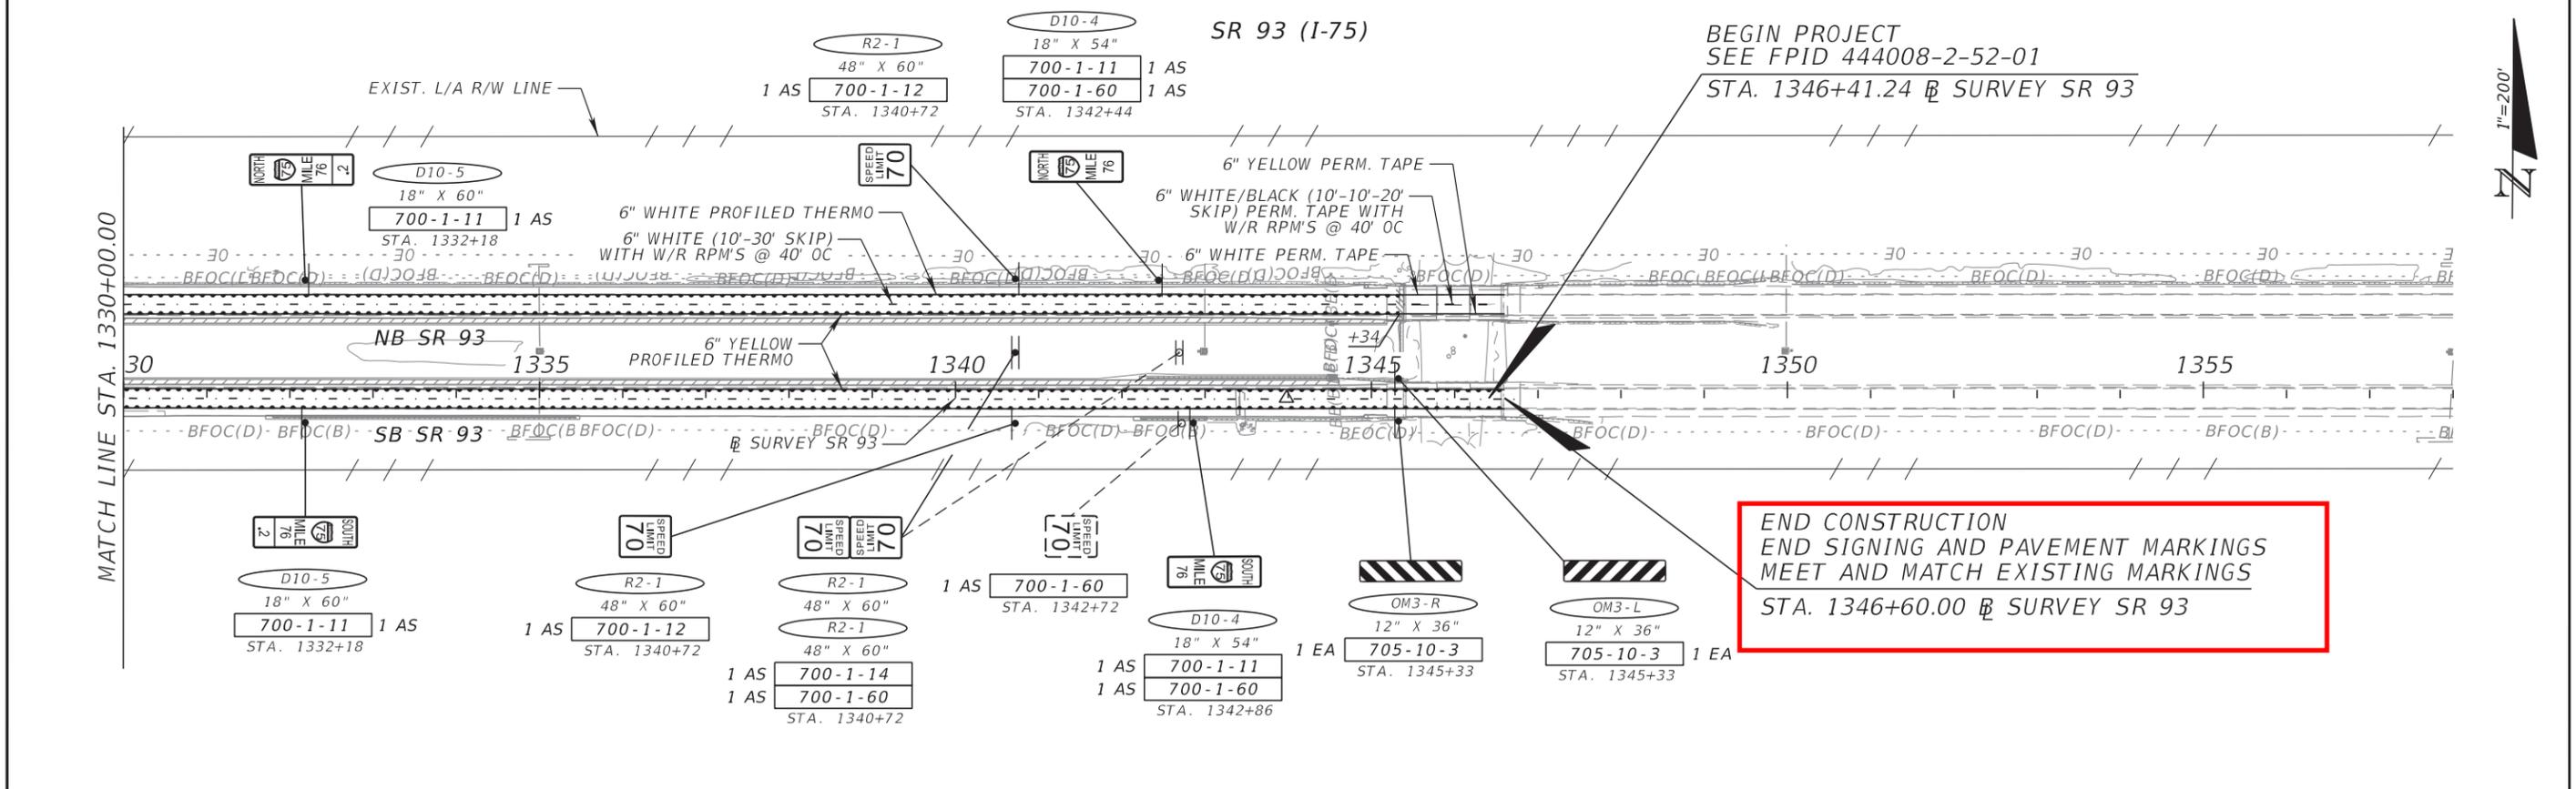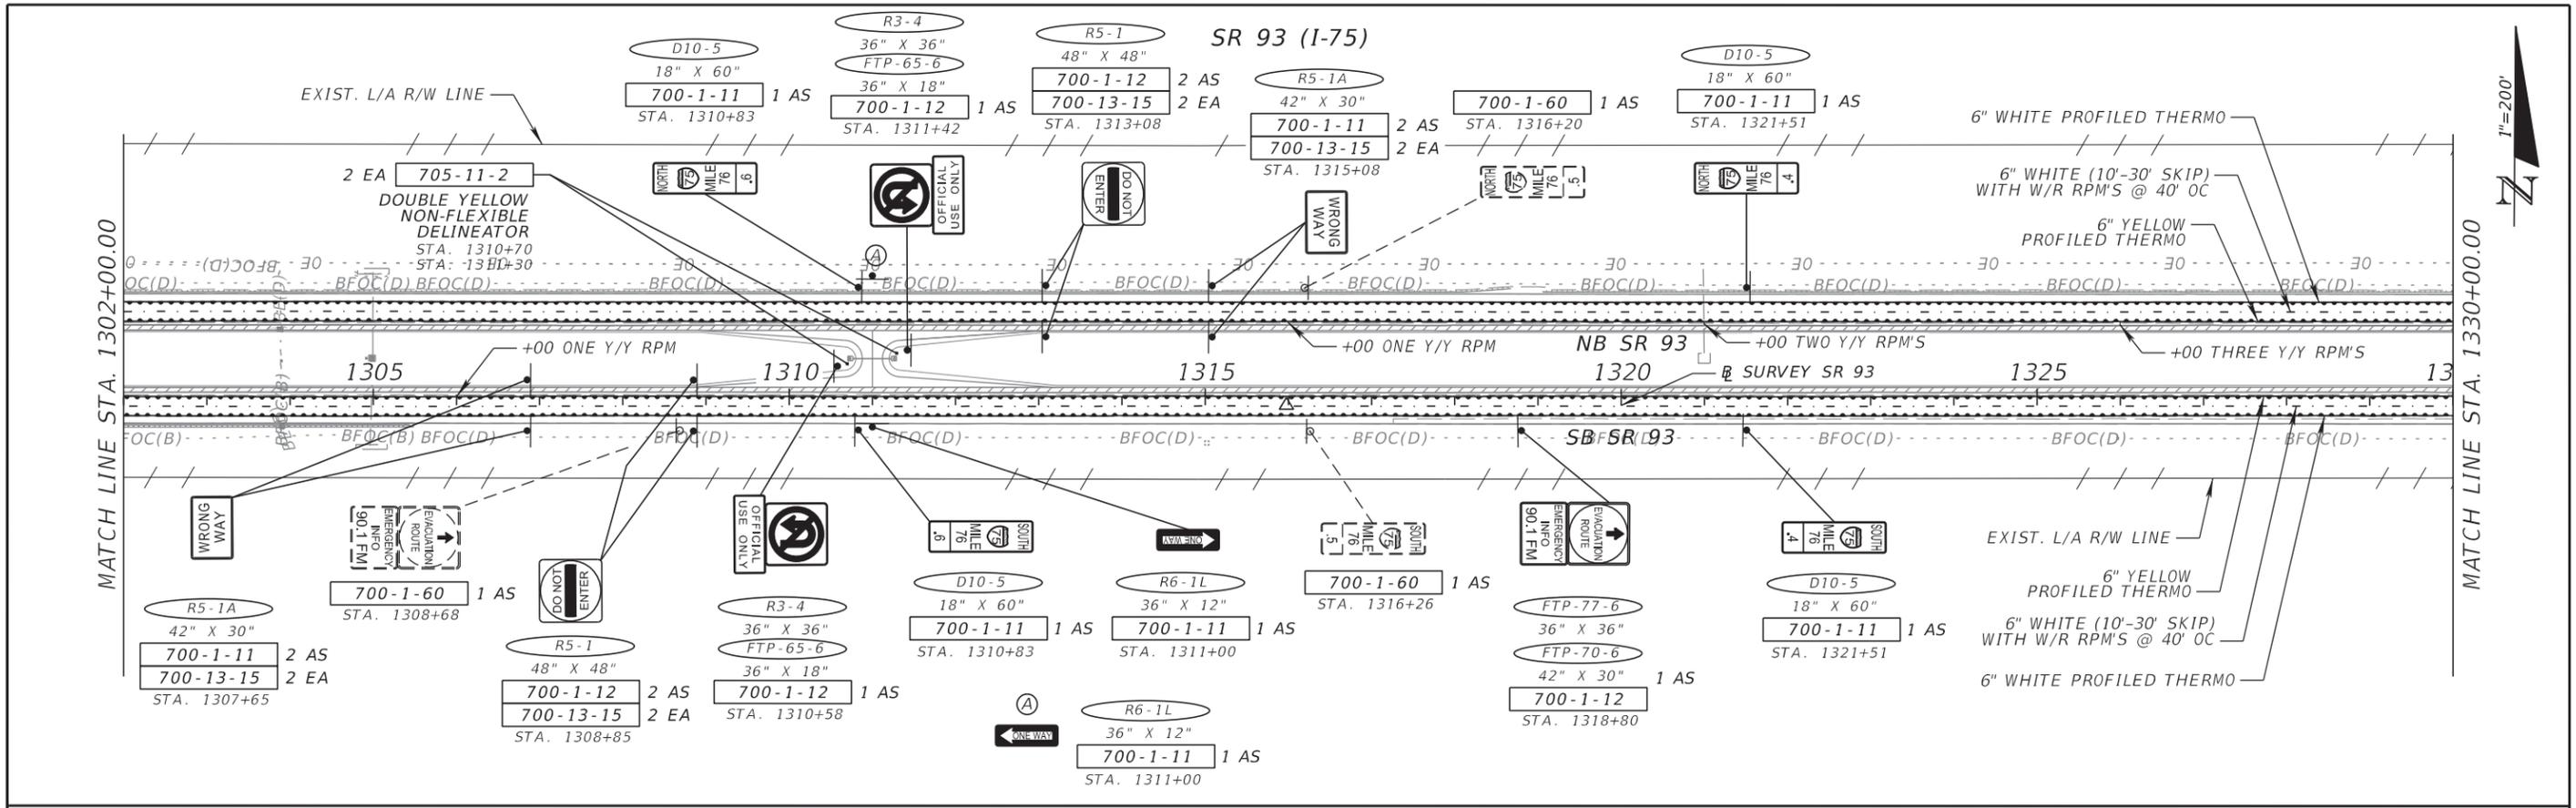

REVISIONS				PATRICIA T. CHRISTIE, P.E. P.E. NO.: 60049 FALLER, DAVIS & ASSOCIATES, INC. 4200 W. CYPRESS ST., SUITE 500 TAMPA, FLORIDA 33607-4168	STATE OF FLORIDA DEPARTMENT OF TRANSPORTATION			SIGNING AND PAVEMENT MARKING PLAN (38)	SHEET NO.
DATE	DESCRIPTION	DATE	DESCRIPTION		ROAD NO.	COUNTY	FINANCIAL PROJECT ID		
						SR 93	COLLIER		444008-3-52-01

OFF RAMP: SOUTH I-75 TO SR 29

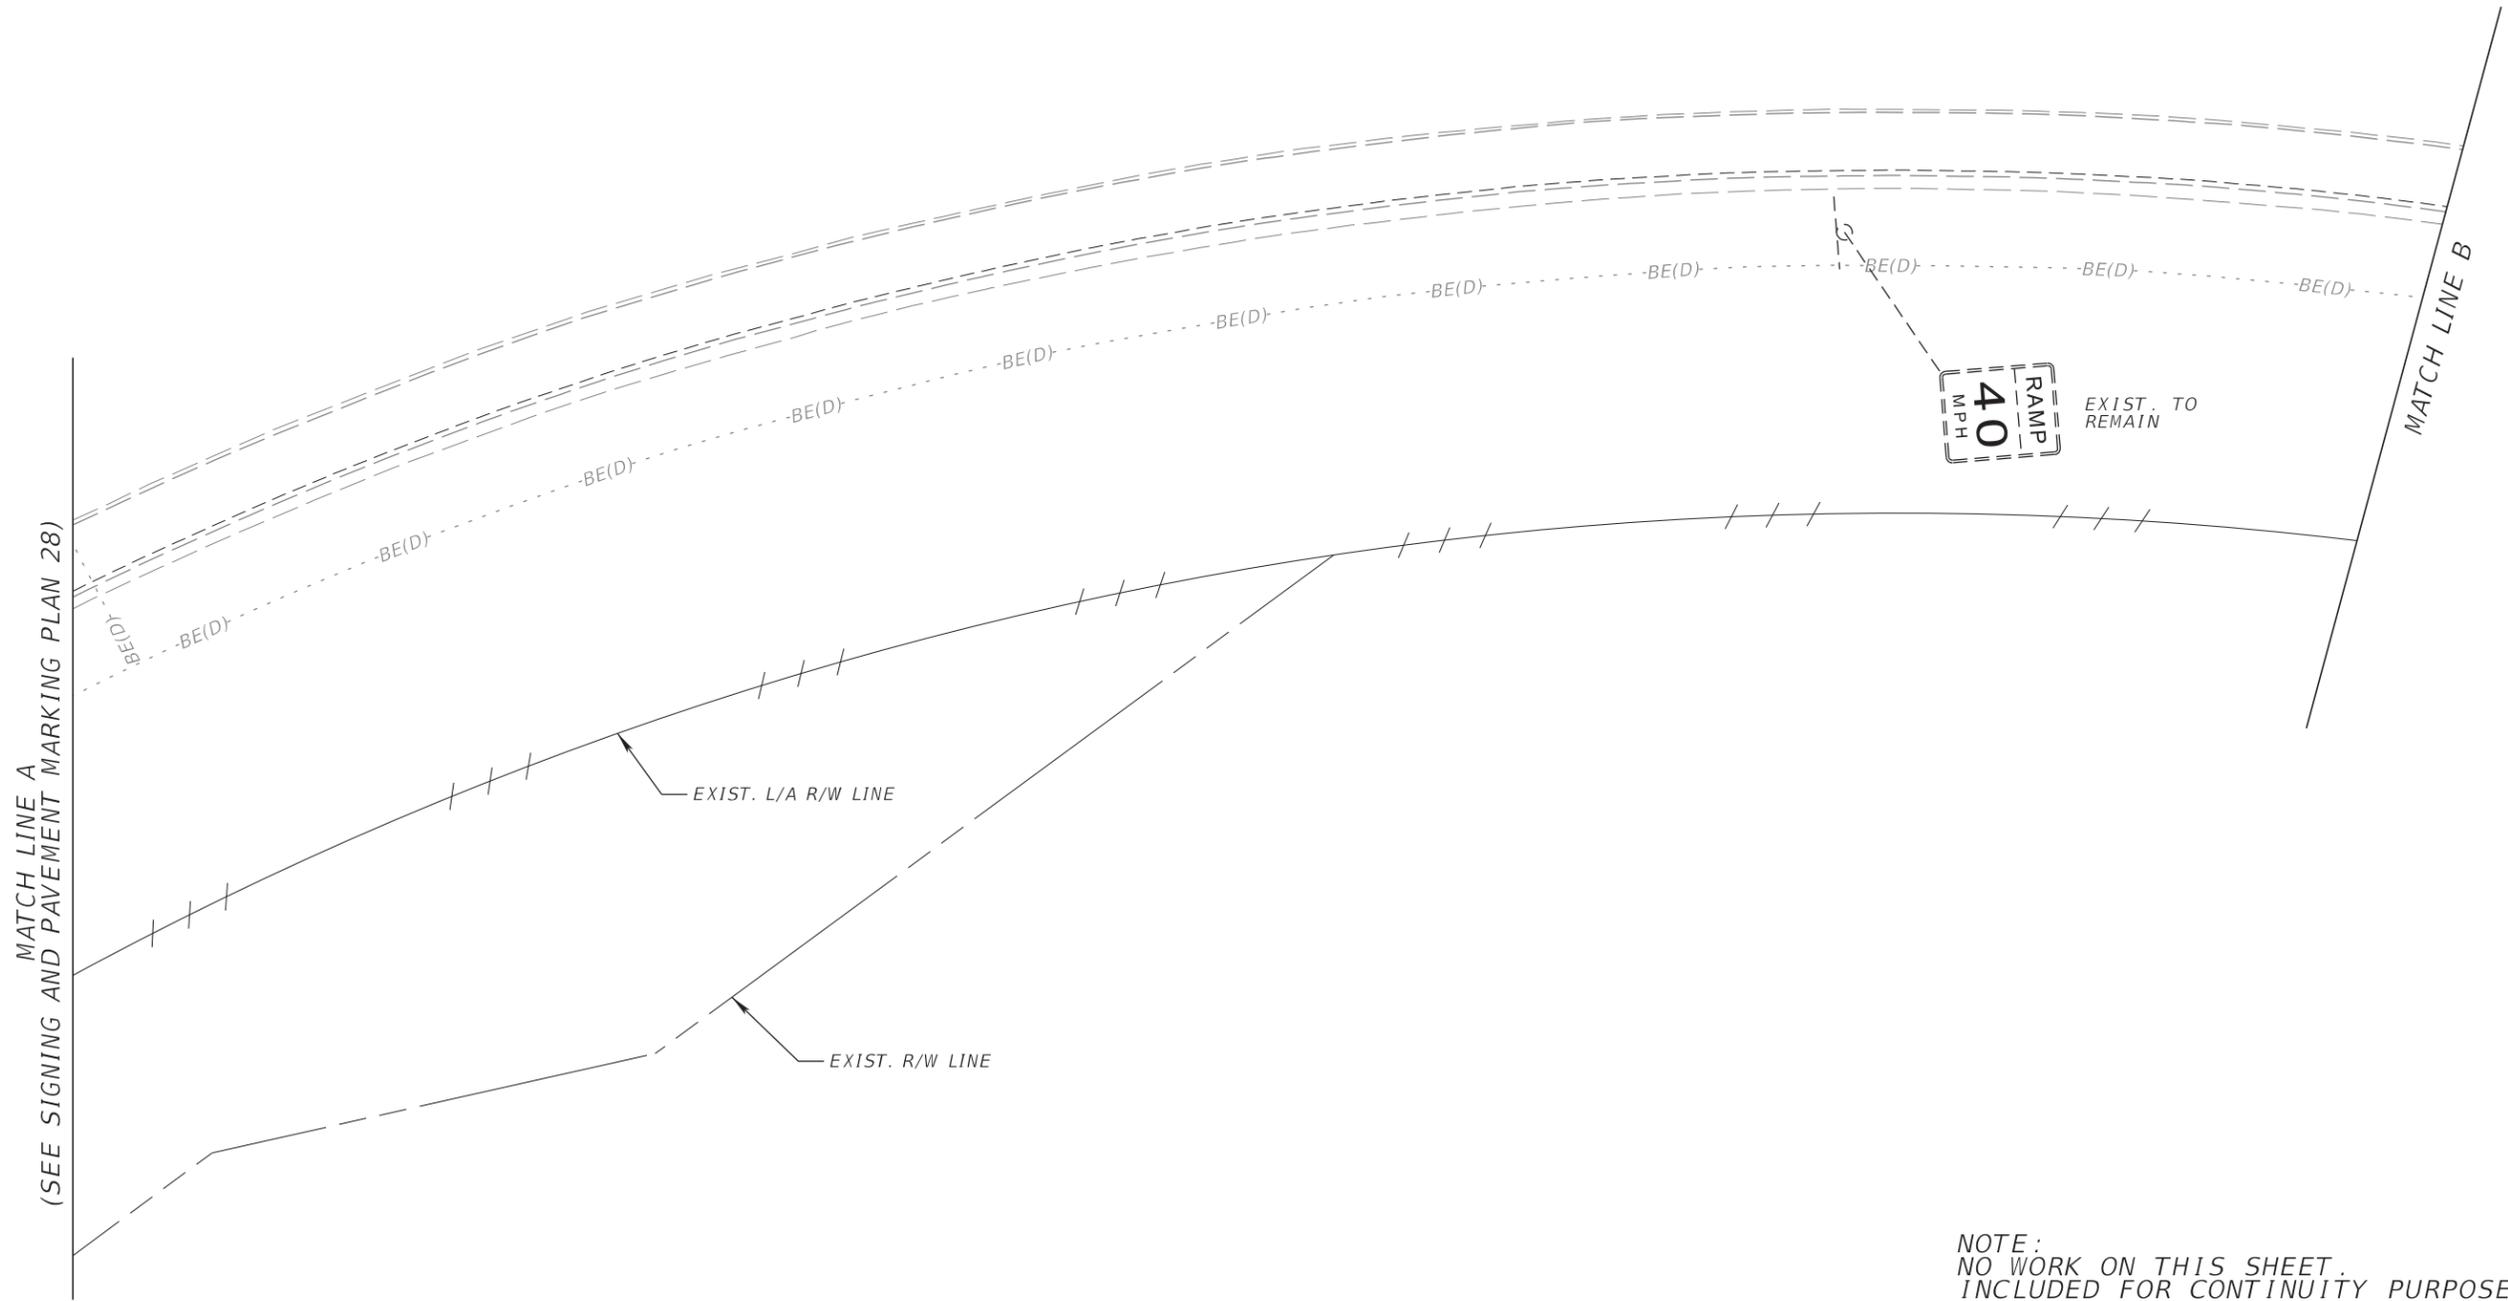


NOTE:
NO WORK ON THIS SHEET.
INCLUDED FOR CONTINUITY PURPOSES ONLY.


REVISIONS				PATRICIA T. CHRISTIE, P.E. P.E. NO.: 60049 FALLER, DAVIS & ASSOCIATES, INC. 4200 W. CYPRESS ST., SUITE 500 TAMPA, FLORIDA 33607-4168	STATE OF FLORIDA DEPARTMENT OF TRANSPORTATION			SIGNING AND PAVEMENT MARKING PLAN (39)	SHEET NO.
DATE	DESCRIPTION	DATE	DESCRIPTION		ROAD NO.	COUNTY	FINANCIAL PROJECT ID		S-48
					SR 93	COLLIER	444008-3-52-01		

THE OFFICIAL RECORD OF THIS SHEET IS THE ELECTRONIC FILE DIGITALLY SIGNED AND SEALED UNDER RULE 61G15-23.004, F.A.C.

OFF RAMP: SOUTH I-75 TO SR 29

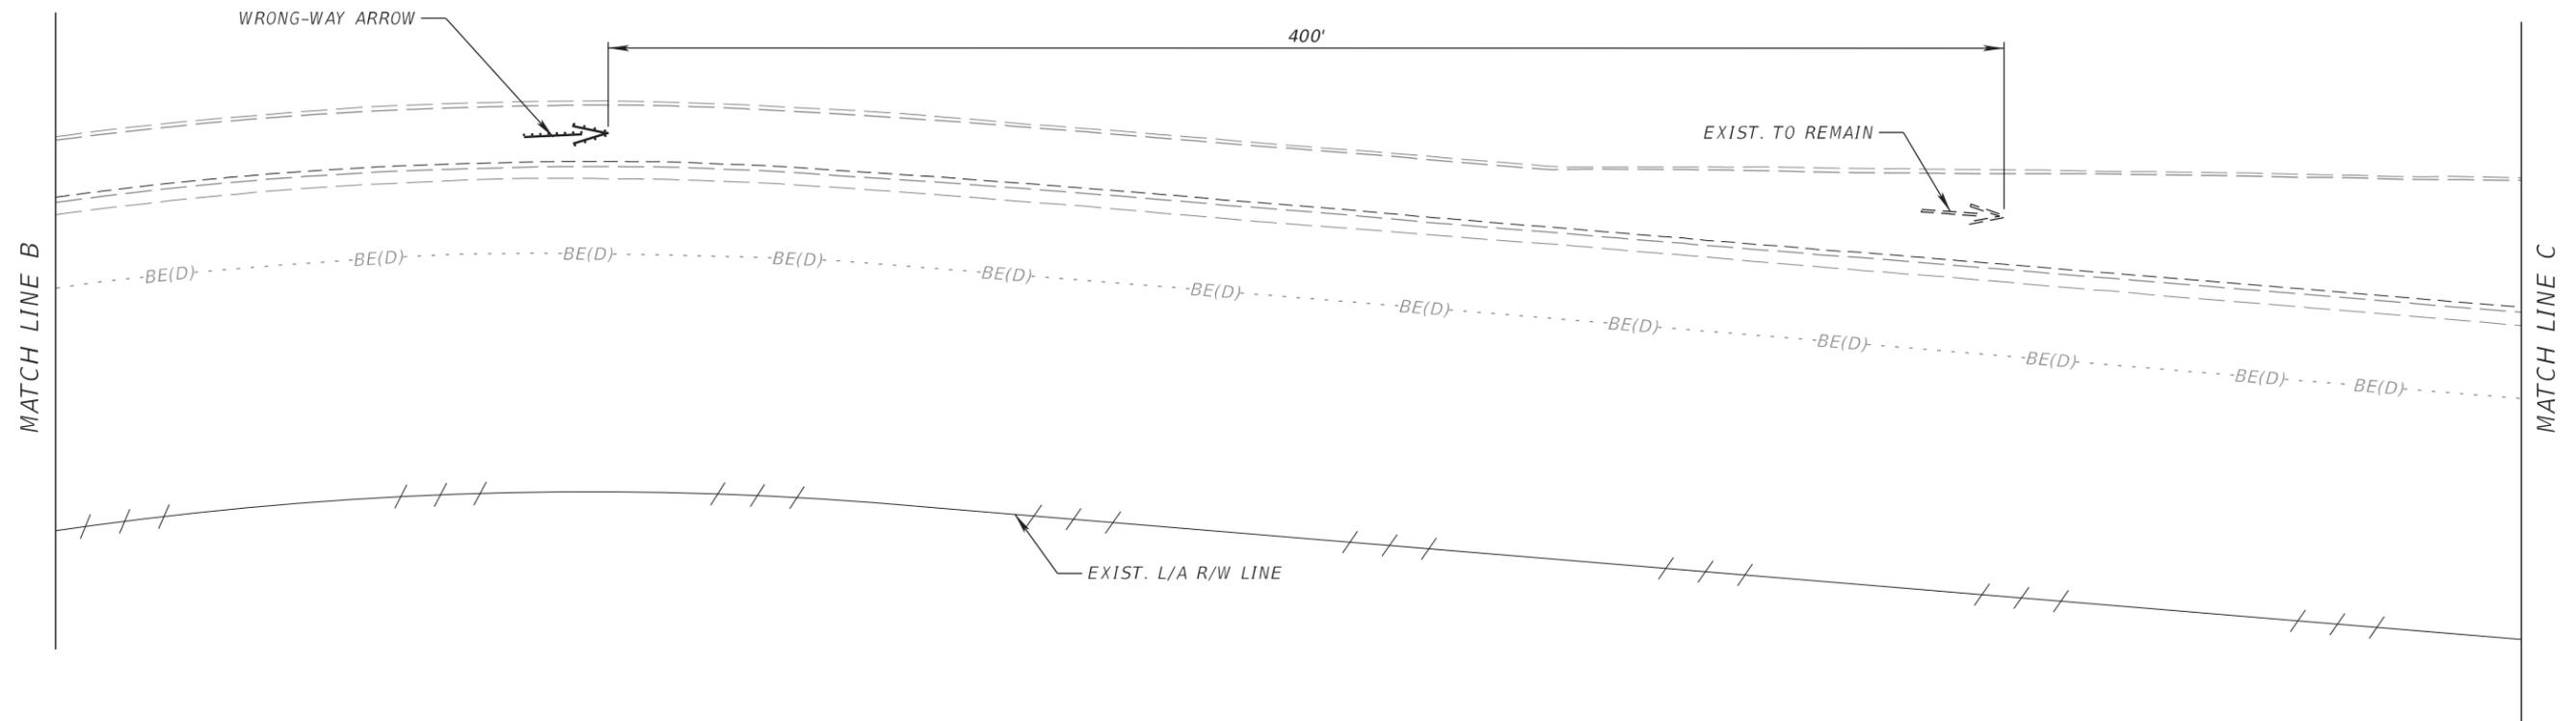


REVISIONS				PATRICIA T. CHRISTIE, P.E. P.E. NO.: 60049 FALLER, DAVIS & ASSOCIATES, INC. 4200 W. CYPRESS ST., SUITE 500 TAMPA, FLORIDA 33607-4168	STATE OF FLORIDA DEPARTMENT OF TRANSPORTATION			SIGNING AND PAVEMENT MARKING PLAN (40)	SHEET NO.
DATE	DESCRIPTION	DATE	DESCRIPTION		ROAD NO.	COUNTY	FINANCIAL PROJECT ID		
						SR 93	COLLIER		444008-3-52-01

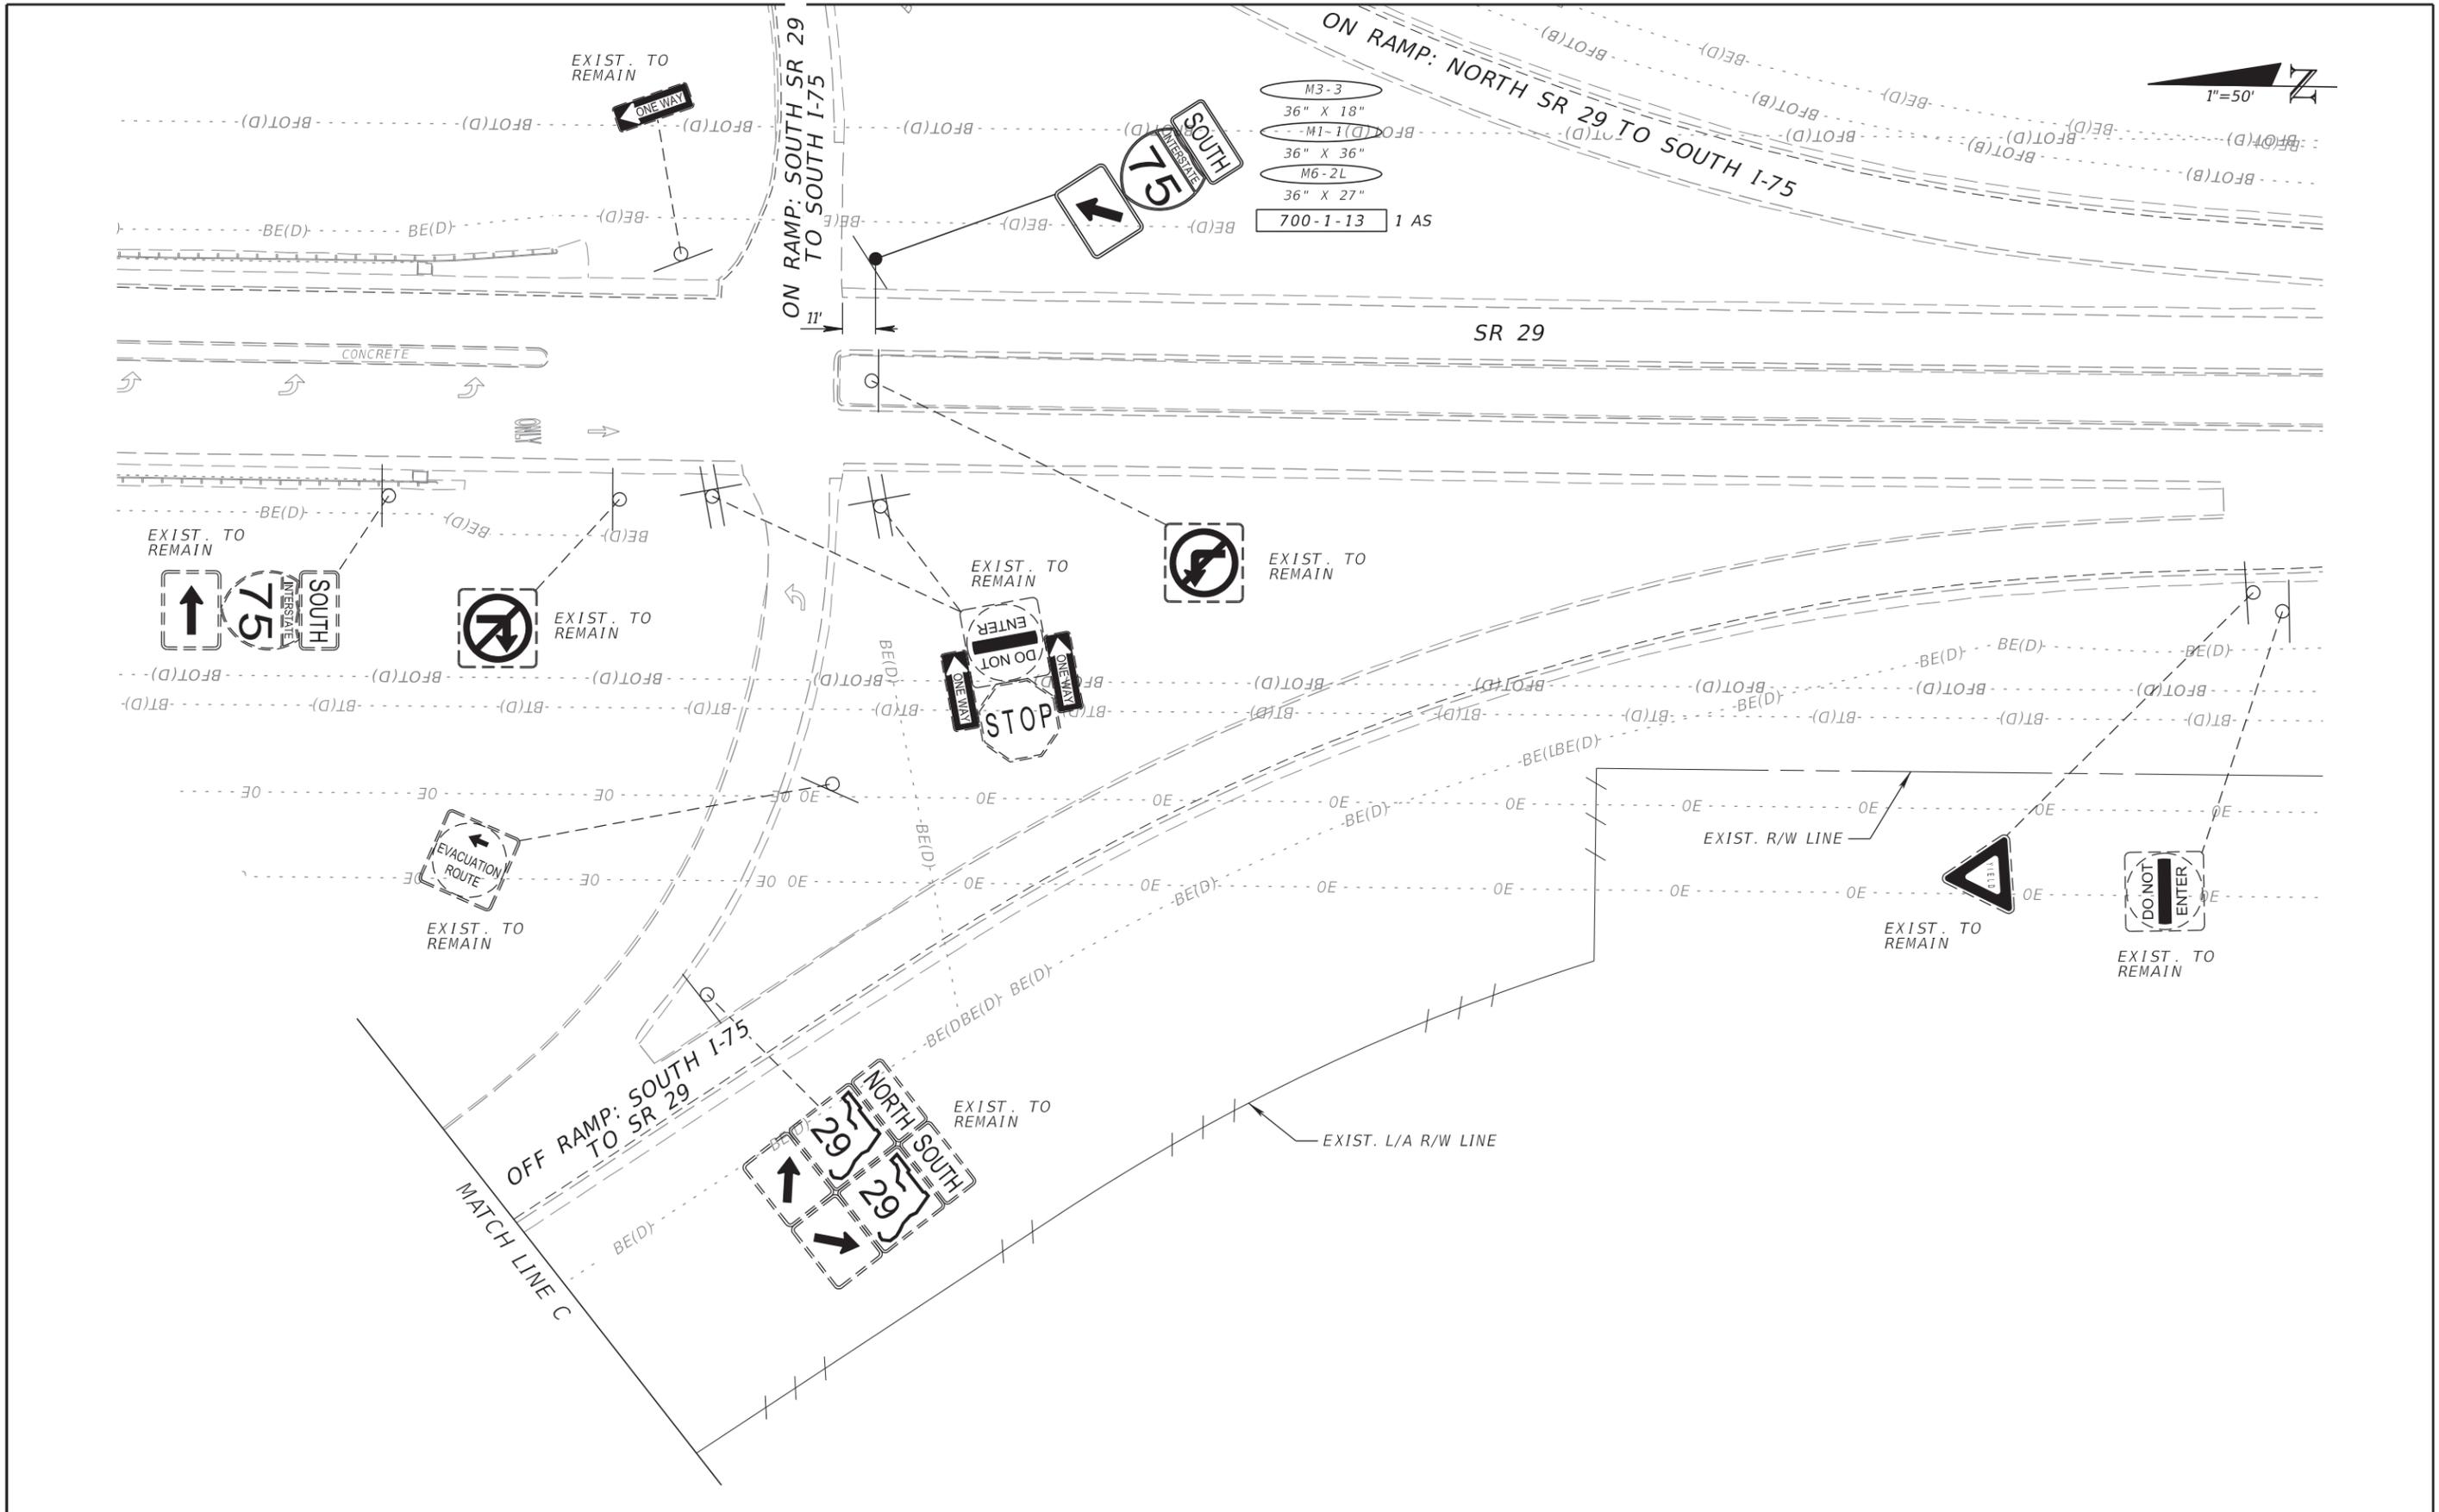

- M3-3
36" X 18"
- M1-1M
36" X 36"
- M6-2L
36" X 27"
- 700-1-13 1 AS



REVISIONS				PATRICIA T. CHRISTIE, P.E. P.E. NO.: 60049 FALLER, DAVIS & ASSOCIATES, INC. 4200 W. CYPRESS ST., SUITE 500 TAMPA, FLORIDA 33607-4168	STATE OF FLORIDA DEPARTMENT OF TRANSPORTATION			SIGNING AND PAVEMENT MARKING PLAN (41)	SHEET NO.
DATE	DESCRIPTION	DATE	DESCRIPTION		ROAD NO.	COUNTY	FINANCIAL PROJECT ID		S-50
					SR 93	COLLIER	444008-3-52-01		

THE OFFICIAL RECORD OF THIS SHEET IS THE ELECTRONIC FILE DIGITALLY SIGNED AND SEALED UNDER RULE 61G15-23.004, F.A.C.

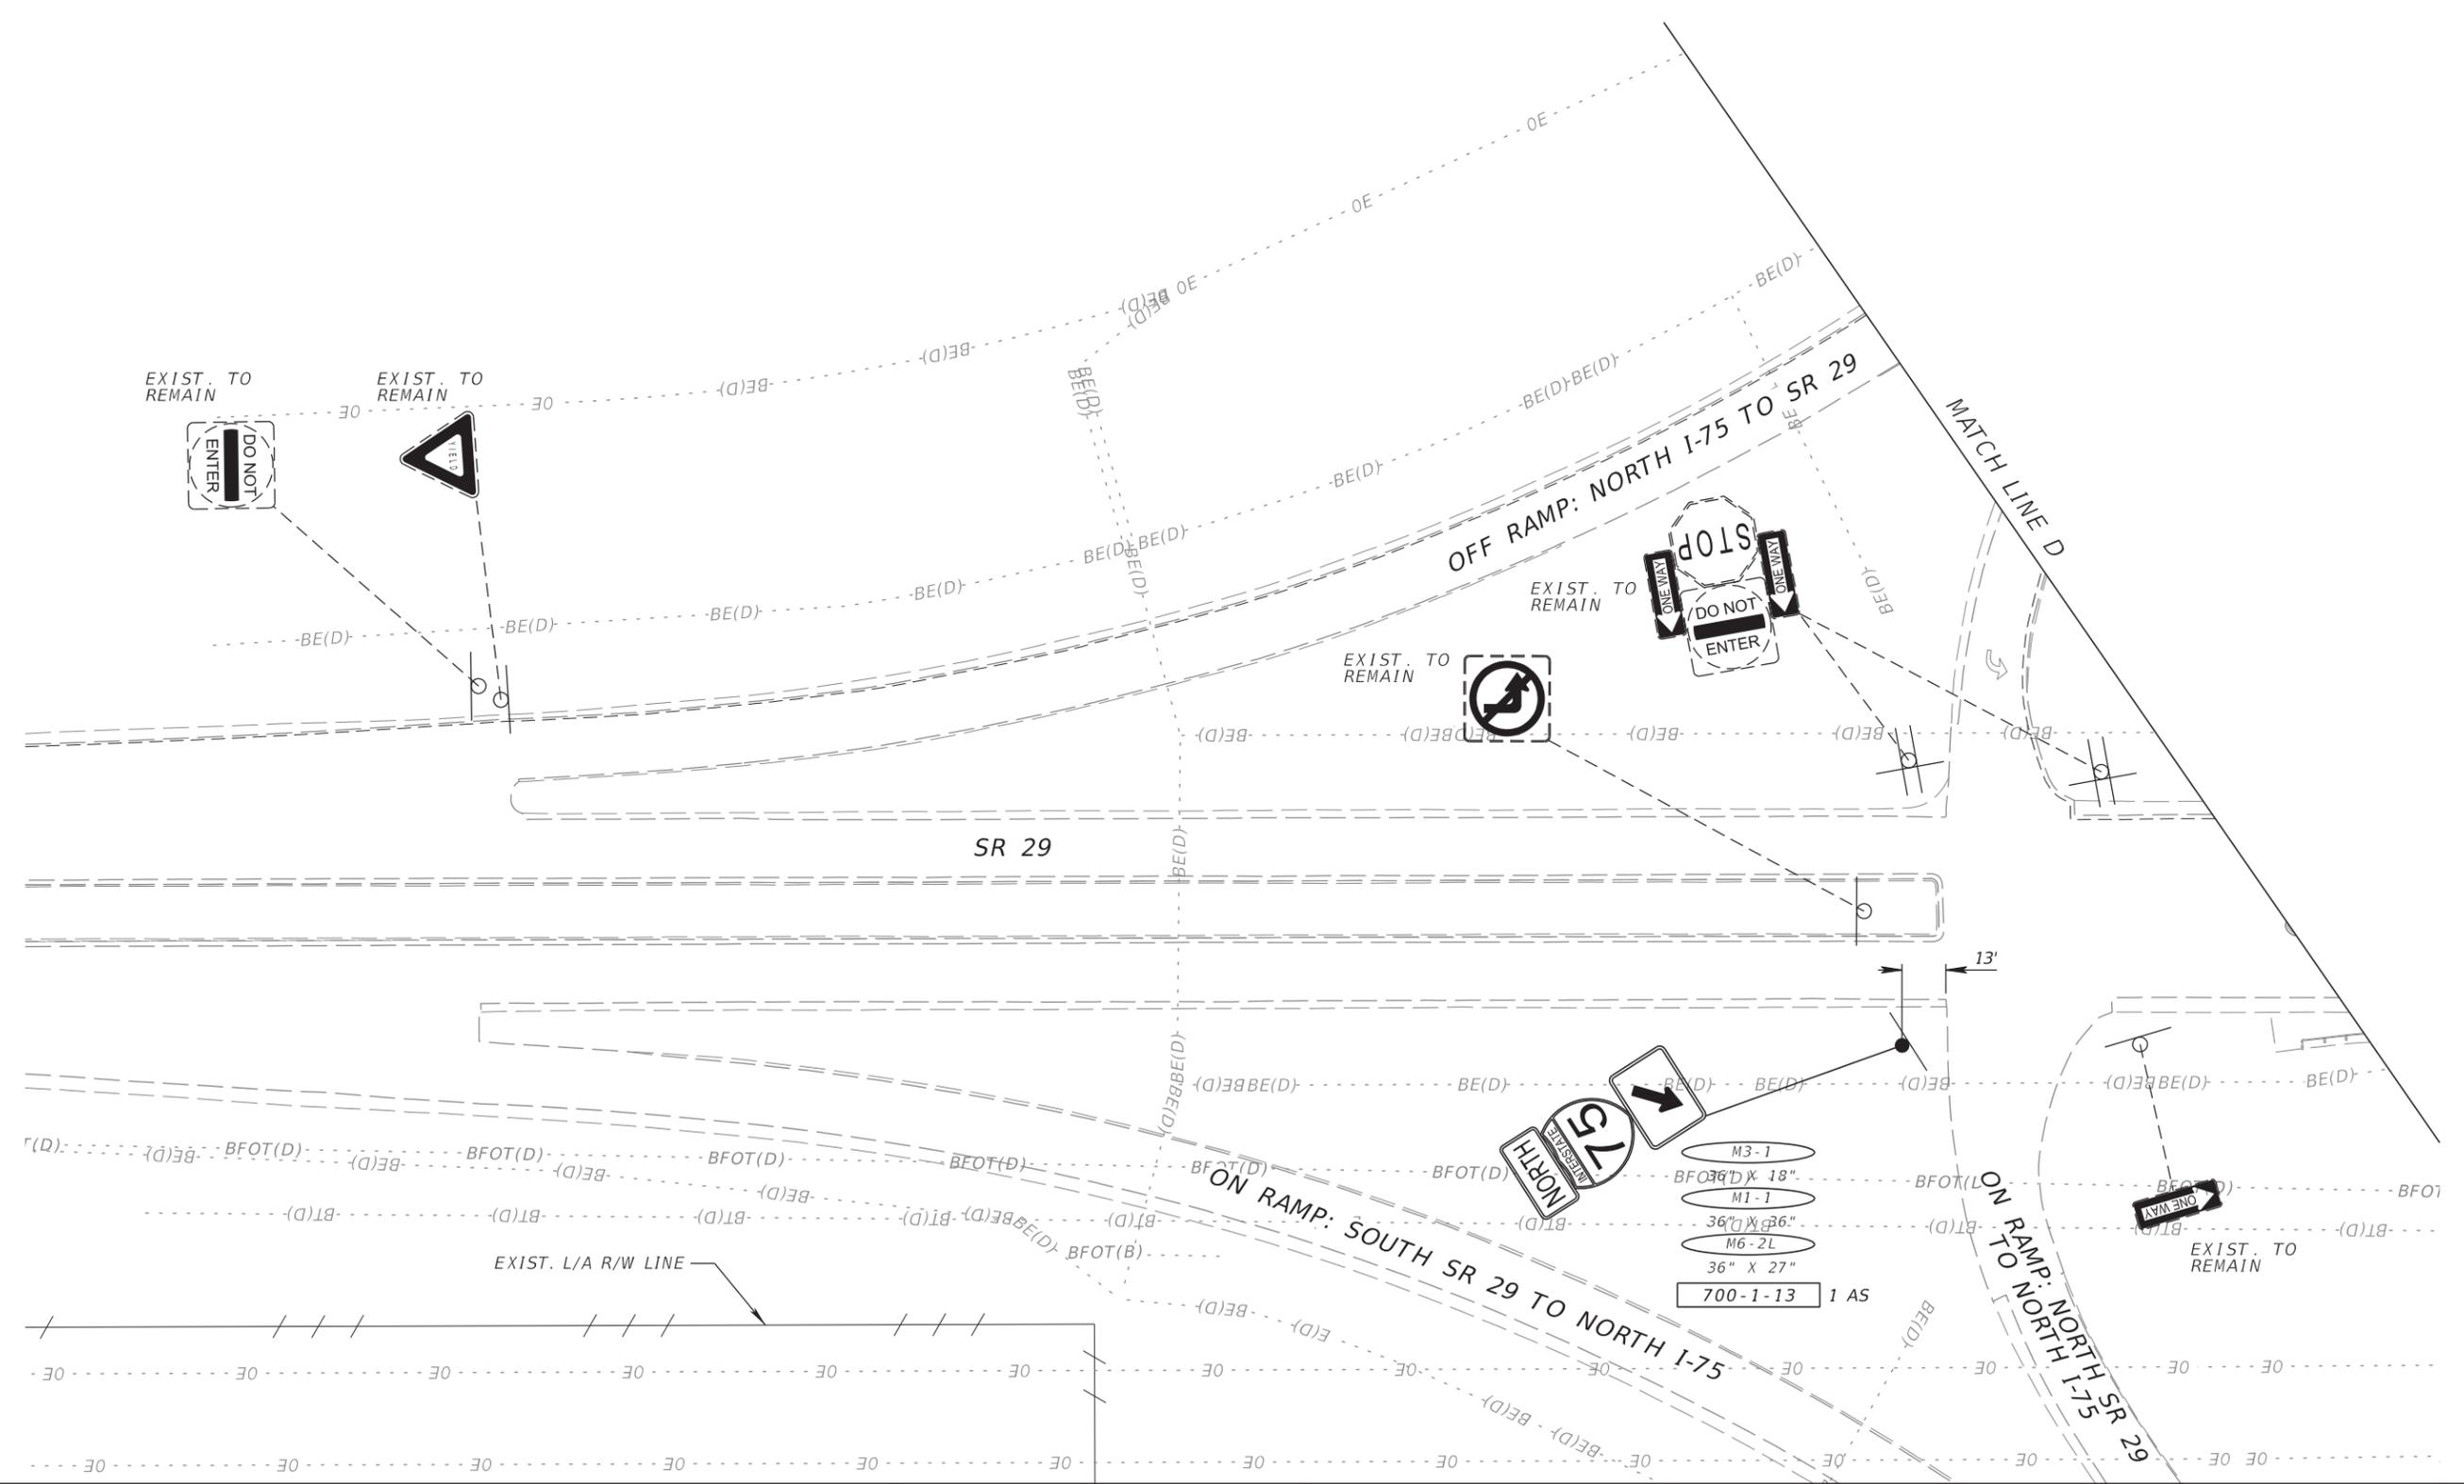

REVISIONS				PATRICIA T. CHRISTIE, P.E. P.E. NO.: 60049 FALLER, DAVIS & ASSOCIATES, INC. 4200 W. CYPRESS ST., SUITE 500 TAMPA, FLORIDA 33607-4168	STATE OF FLORIDA DEPARTMENT OF TRANSPORTATION			SIGNING AND PAVEMENT MARKING PLAN (42)	SHEET NO.
DATE	DESCRIPTION	DATE	DESCRIPTION		ROAD NO.	COUNTY	FINANCIAL PROJECT ID		S-51
					SR 93	COLLIER	444008-3-52-01		


OFF RAMP: NORTH I-75 TO SR 29

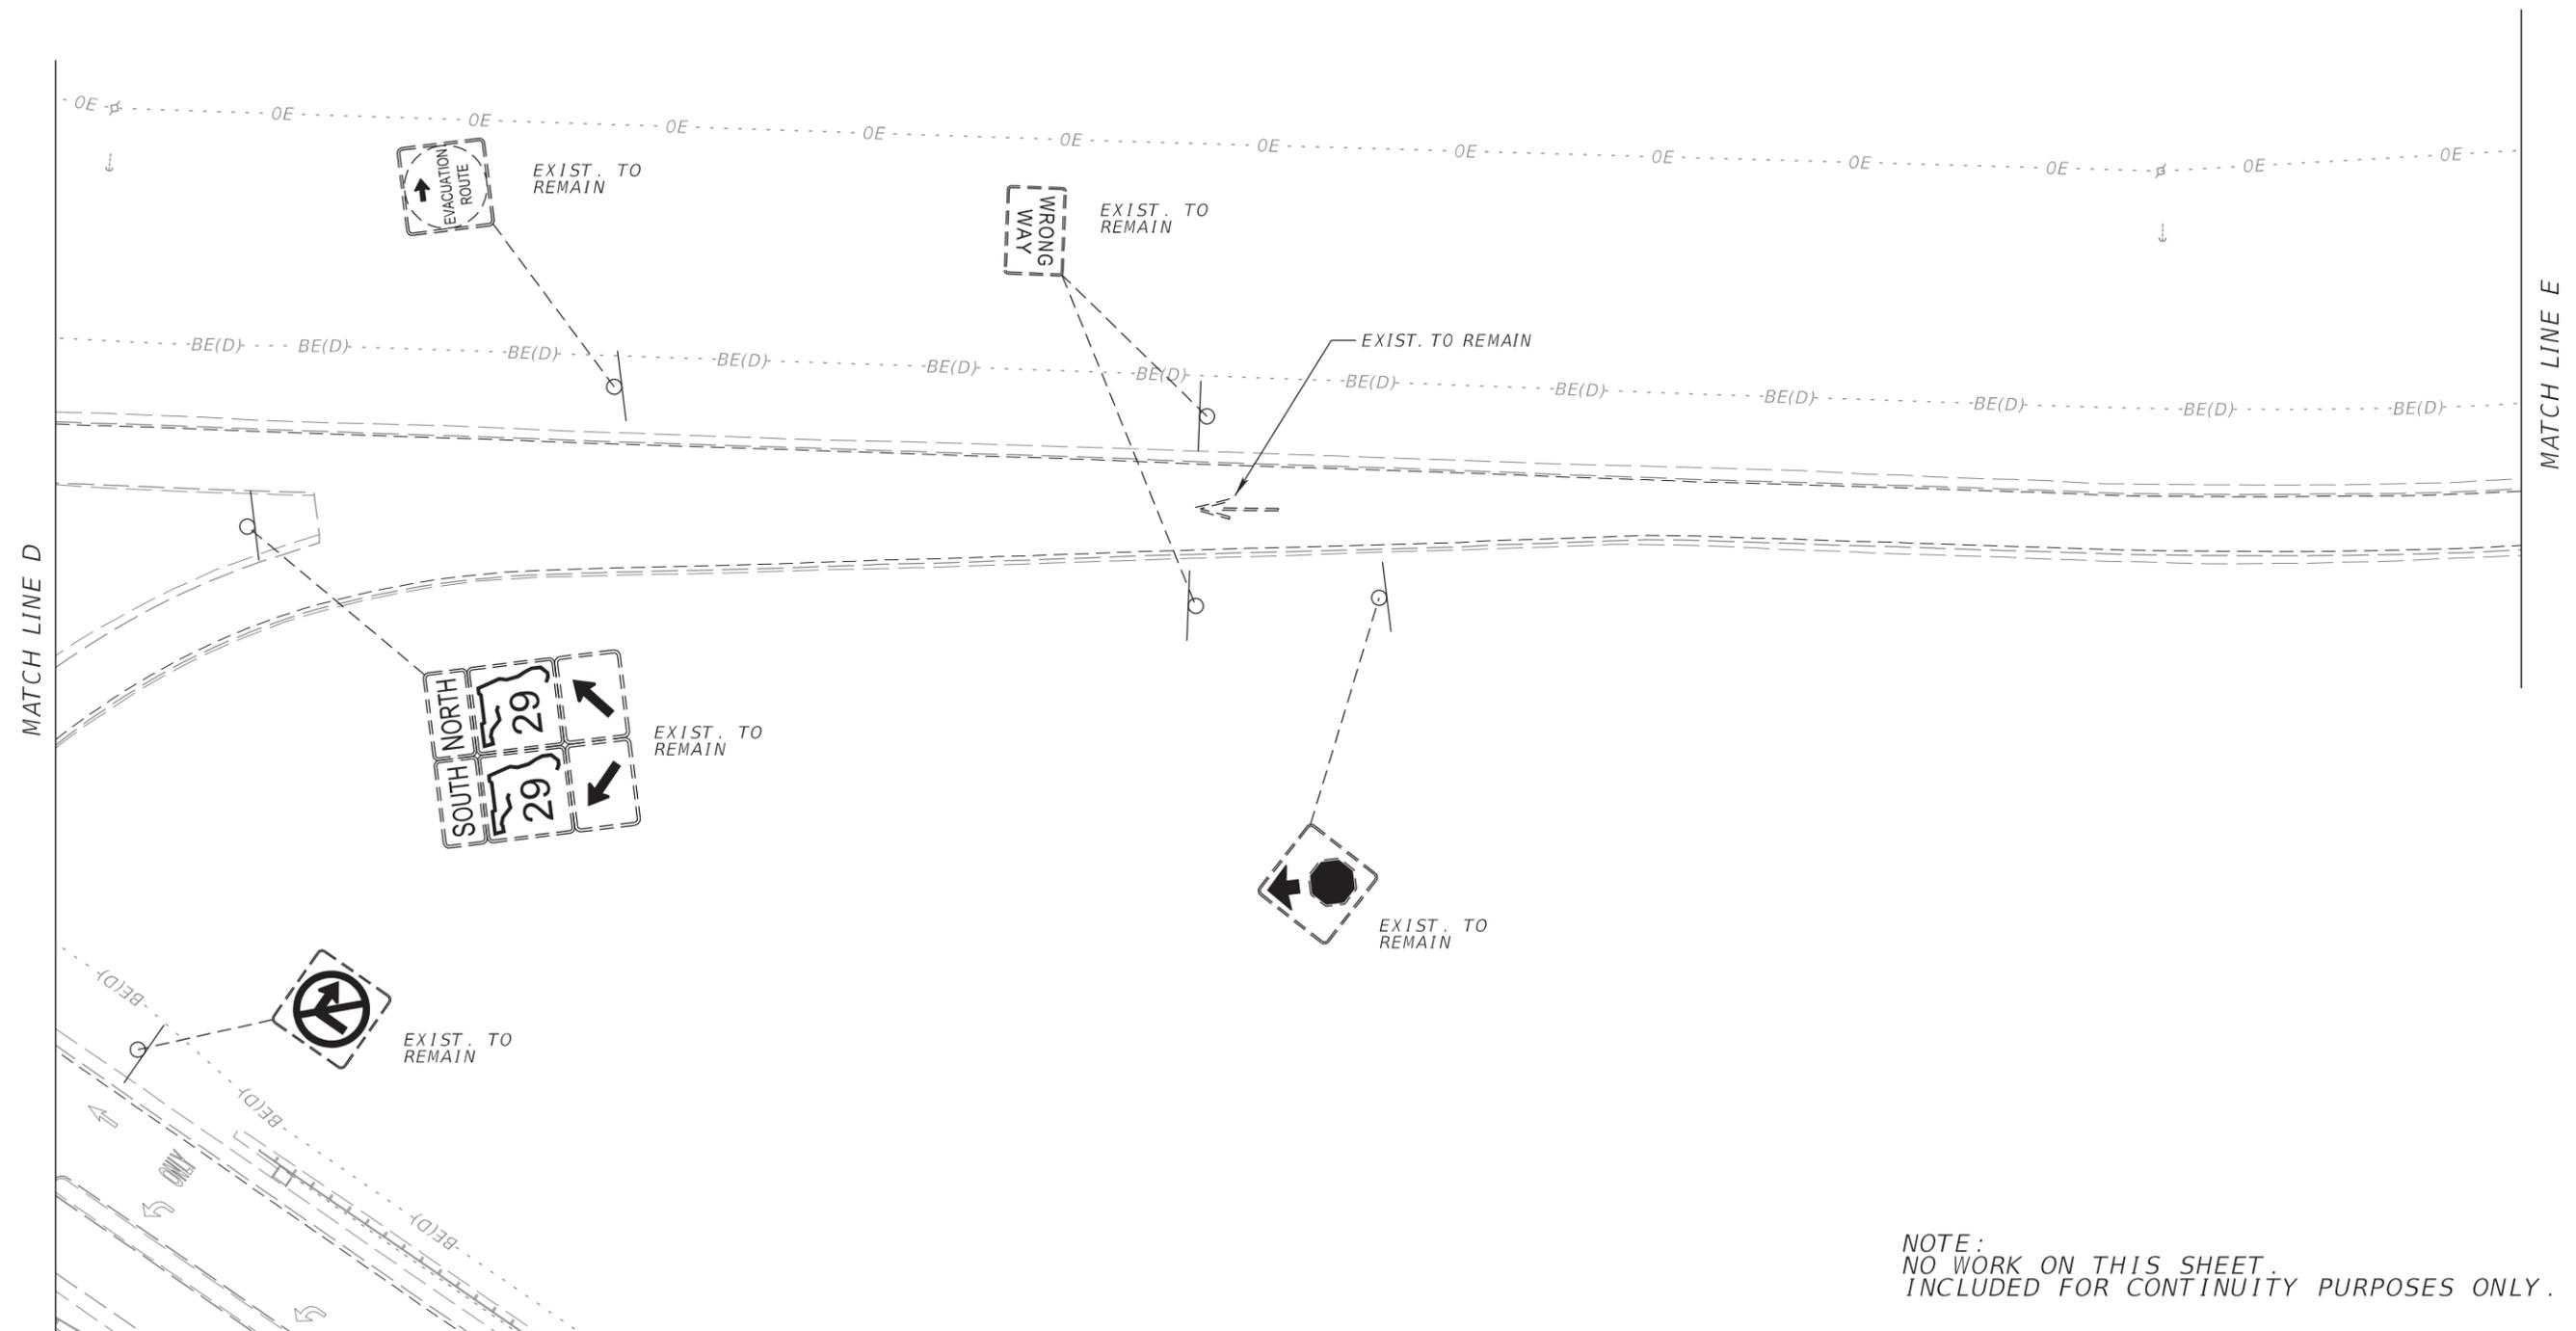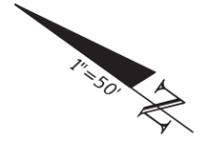

THE OFFICIAL RECORD OF THIS SHEET IS THE ELECTRONIC FILE DIGITALLY SIGNED AND SEALED UNDER RULE 61G15-23.004, F.A.C.


REVISIONS				PATRICIA T. CHRISTIE, P.E. P.E. NO.: 60049 FALLER, DAVIS & ASSOCIATES, INC. 4200 W. CYPRESS ST., SUITE 500 TAMPA, FLORIDA 33607-4168	STATE OF FLORIDA DEPARTMENT OF TRANSPORTATION			SIGNING AND PAVEMENT MARKING PLAN (43)	SHEET NO.
DATE	DESCRIPTION	DATE	DESCRIPTION		ROAD NO.	COUNTY	FINANCIAL PROJECT ID		S-52
					SR 93	COLLIER	444008-3-52-01		

OFF RAMP: NORTH I-75 TO SR 29

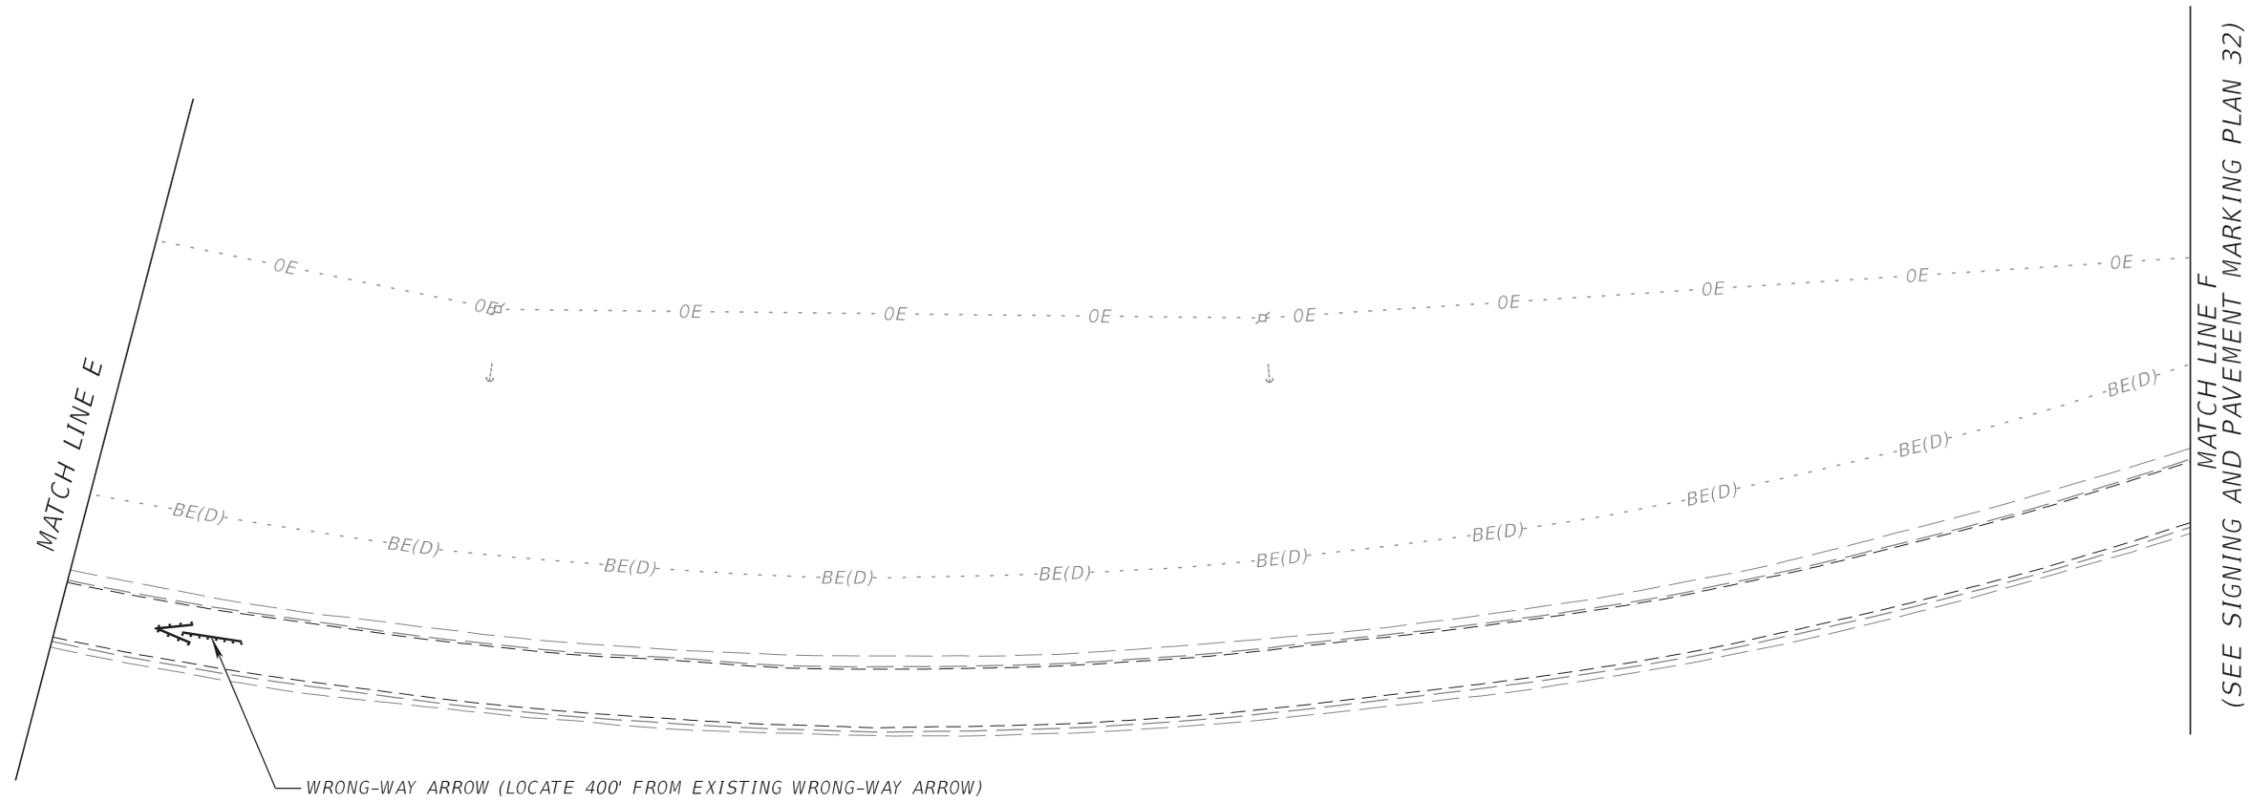

REVISIONS				PATRICIA T. CHRISTIE, P.E. P.E. NO.: 60049 FALLER, DAVIS & ASSOCIATES, INC. 4200 W. CYPRESS ST., SUITE 500 TAMPA, FLORIDA 33607-4168	STATE OF FLORIDA DEPARTMENT OF TRANSPORTATION			SIGNING AND PAVEMENT MARKING PLAN (44)	SHEET NO.
DATE	DESCRIPTION	DATE	DESCRIPTION		ROAD NO.	COUNTY	FINANCIAL PROJECT ID		
						SR 93	COLLIER		444008-3-52-01


SIGN NAME Q		QTY 2	SIGN NUMBER	STATION(S)	
PANEL	BORDER	1	1007+54 RT		
WIDTH 20'-0"	WIDTH 2"	2	1252+35 LT		
HEIGHT 13'-0"	RADII 12"				
LEGEND White	COLOR White				
COLOR Green					
SYMBOL(S)	ANGLE X	Y	WID	HT	
F28_2B	0	98.4	99.6	43.2	36
SIGN NUMBER	NUMBER OF POSTS	CLEARANCE	COLUMN SIZE	AVERAGE LENGTH	
1	2	33' EOT	W12X45	24.30'	
2	2	8' FROM FACE GR	W12X45	22.50'	

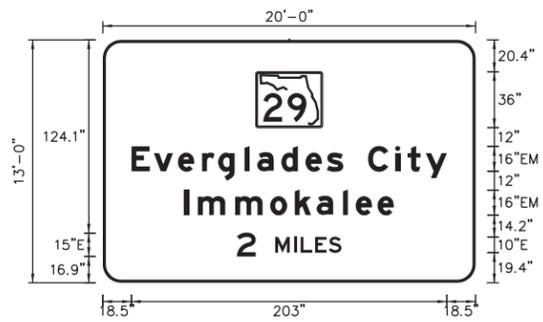

NO. OF LIGHT FIXTURES	FIXTURE SPACING	PHOTOMETRIC CURVE	WATT	VOLTAGE
-----------------------	-----------------	-------------------	------	---------

COPY	E	v	e	r	g	i	a	d	e	s	C	i	t	y	L			
SPACE	18.5	14.4	15.5	15.5	10.4	17	8.2	15.5	15.5	13.8	10.6	16	17.4	8	11.7	13.6	18.5	203
COPY		l	m	m	o	k	a	l	e	e	L							
SPACE	52.6	8.6	24	22.6	15.8	14.1	17	8.2	14.1	10.6	52.6	134.9						
COPY		2		M	l	L	E	S	L									
SPACE	86.4	12.1	12.5	12	4.4	9.2	8.9	8.1	86.4	67.2								
COPY																		
SPACE																		
COPY																		
SPACE																		
COPY																		
SPACE																		

SIGN NAME S		QTY 2	SIGN NUMBER	STATION(S)	
PANEL	BORDER	1	1086+75 RT		
WIDTH 20'-0"	WIDTH 2"	2	1173+15 LT		
HEIGHT 13'-0"	RADII 12"				
LEGEND White	COLOR White				
COLOR Green					
SYMBOL(S)	ANGLE X	Y	WID	HT	
F28_2B	0	98.4	99.9	43.2	36
SIGN NUMBER	NUMBER OF POSTS	CLEARANCE	COLUMN SIZE	AVERAGE LENGTH	
1	2	33' EOT	W12X45	22.80'	
2	2	10' FROM FACE GR	W12X45	22.52'	

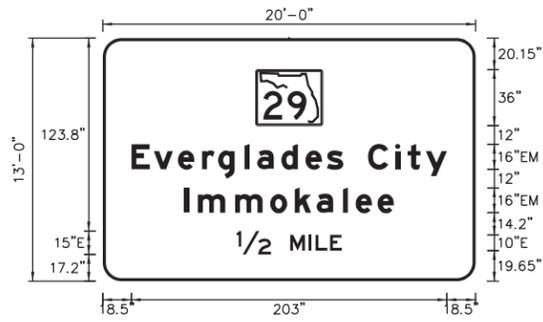

NO. OF LIGHT FIXTURES	FIXTURE SPACING	PHOTOMETRIC CURVE	WATT	VOLTAGE
-----------------------	-----------------	-------------------	------	---------

COPY	E	v	e	r	g	i	a	d	e	s	C	i	t	y	L			
SPACE	18.5	14.4	15.5	15.5	10.4	17	8.2	15.5	15.5	13.8	10.6	16	17.4	8	11.7	13.6	18.5	203
COPY		l	m	m	o	k	a	l	e	e	L							
SPACE	52.6	8.6	24	22.6	15.8	14.1	17	8.2	14.1	10.6	52.6	134.9						
COPY		1/2		M	l	L	E	L										
SPACE	86.2	22	12.5	12	4.4	9.2	7.5	86.2	67.6									
COPY																		
SPACE																		
COPY																		
SPACE																		
COPY																		
SPACE																		


REVISIONS			
DATE	DESCRIPTION	DATE	DESCRIPTION

PATRICIA T. CHRISTIE, P.E.
P.E. NO.: 60049
FALLER, DAVIS & ASSOCIATES, INC.
4200 W. CYPRESS ST., SUITE 500
TAMPA, FLORIDA 33607-4168

STATE OF FLORIDA DEPARTMENT OF TRANSPORTATION		
ROAD NO.	COUNTY	FINANCIAL PROJECT ID
SR 93	COLLIER	444008-3-52-01

GUIDE SIGN WORKSHEET (2)		SHEET NO. S-55
--------------------------	--	-------------------

THE OFFICIAL RECORD OF THIS SHEET IS THE ELECTRONIC FILE DIGITALLY SIGNED AND SEALED UNDER RULE 61G15-23.004, F.A.C.

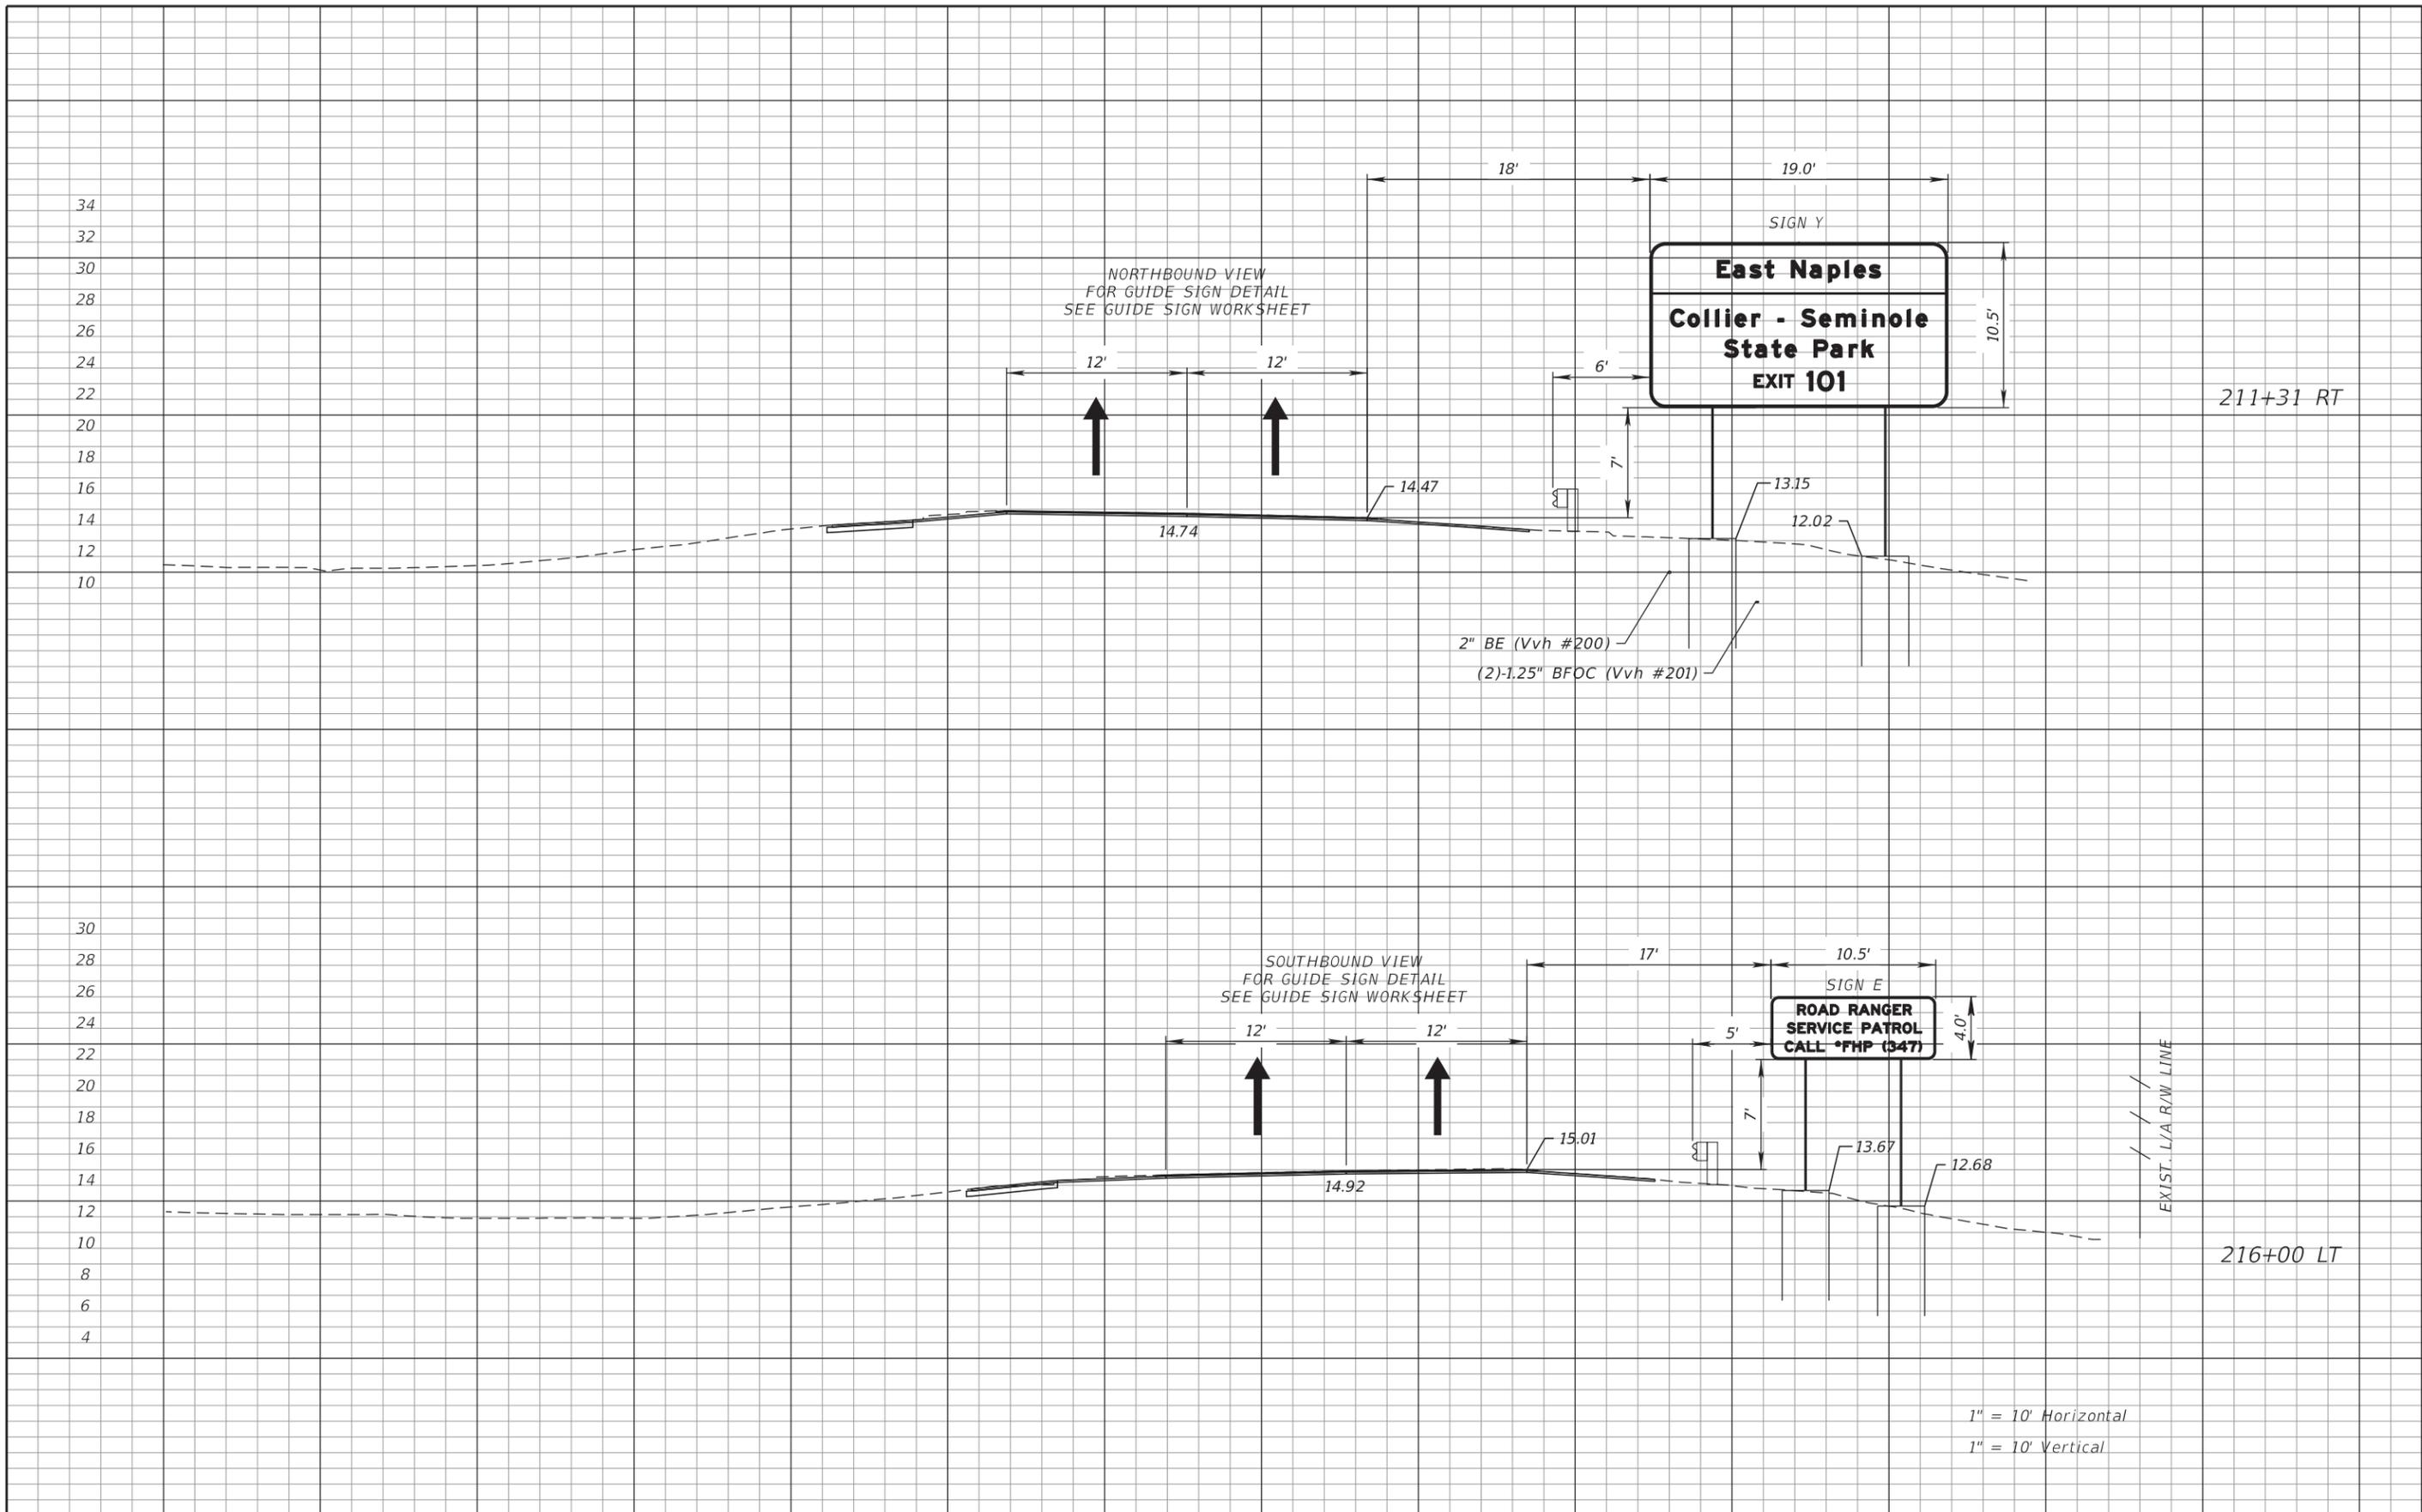

1" = 10' Horizontal
 1" = 10' Vertical


REVISIONS			
DATE	DESCRIPTION	DATE	DESCRIPTION

PATRICIA T. CHRISTIE, P.E.
 P.E. NO.: 60049
 FALLER, DAVIS & ASSOCIATES, INC.
 4200 W. CYPRESS ST., SUITE 500
 TAMPA, FLORIDA 33607-4168

STATE OF FLORIDA DEPARTMENT OF TRANSPORTATION		
ROAD NO.	COUNTY	FINANCIAL PROJECT ID
SR 93	COLLIER	444008-3-52-01


SIGN CROSS SECTION (1)

SHEET NO.
S-59

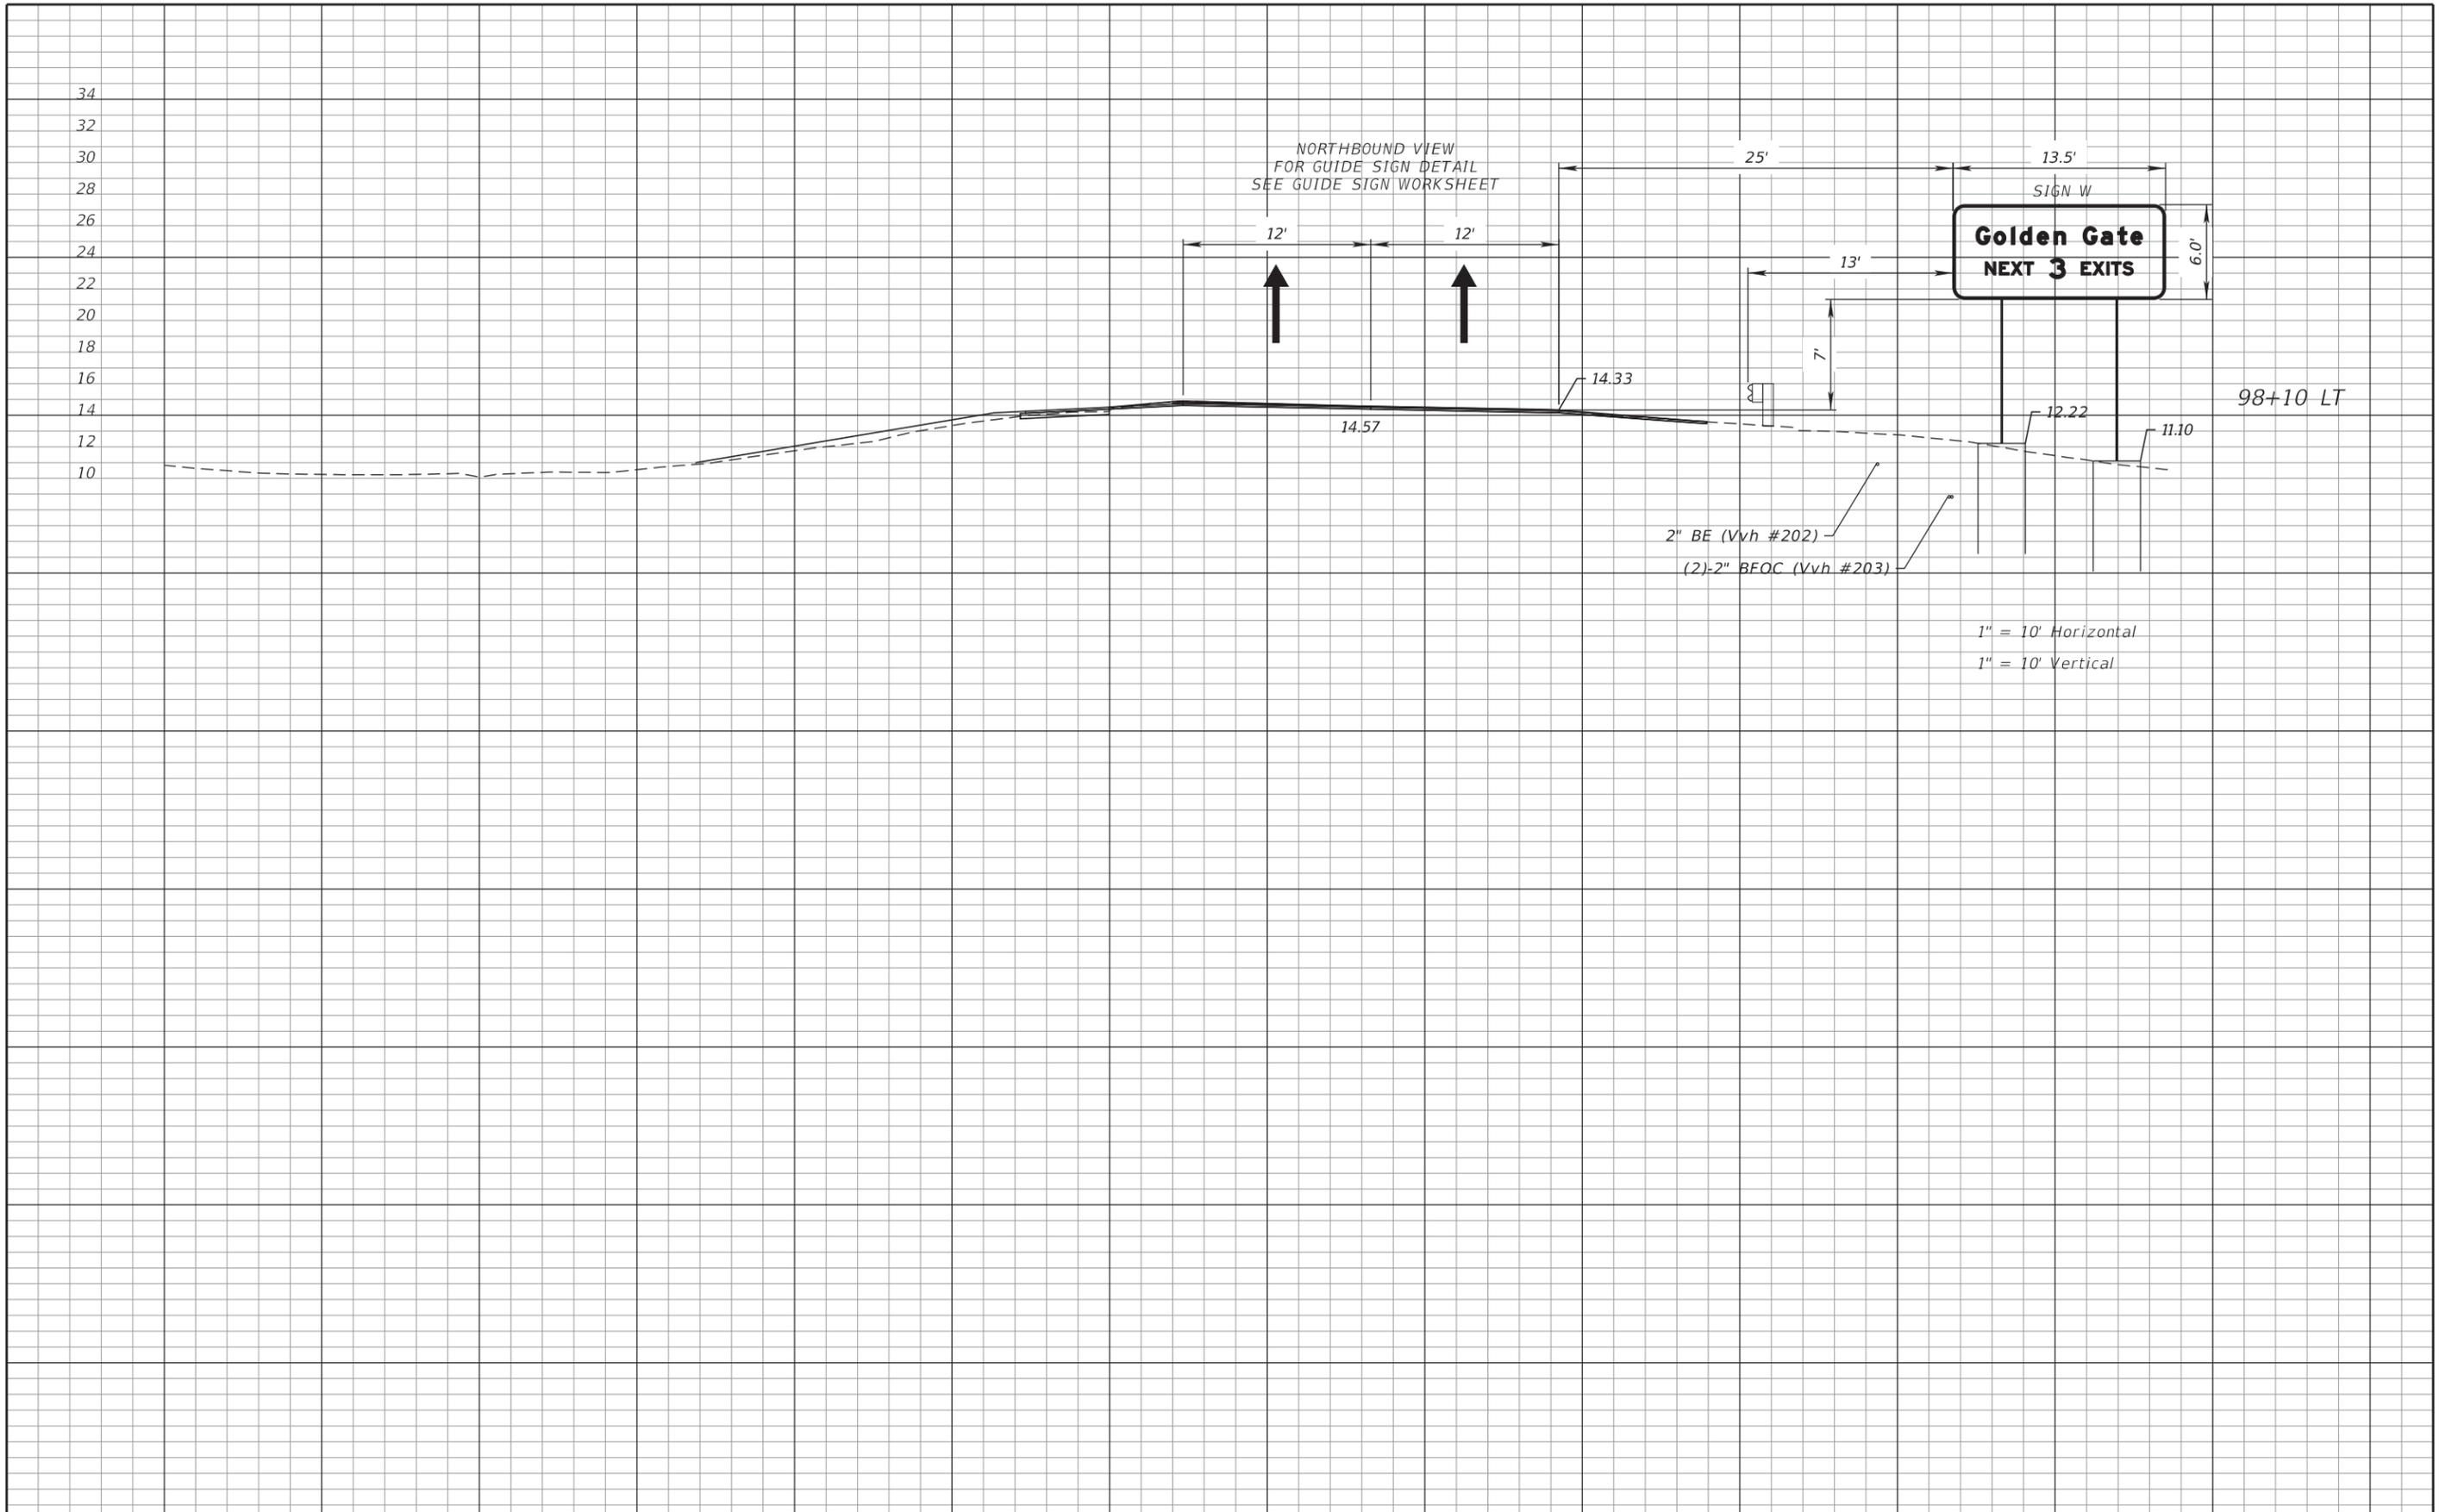


REVISIONS		DATE	DESCRIPTION	PATRICIA T. CHRISTIE, P.E. P.E. NO.: 60049 FALLER, DAVIS & ASSOCIATES, INC. 4200 W. CYPRESS ST., SUITE 500 TAMPA, FLORIDA 33607-4168	STATE OF FLORIDA DEPARTMENT OF TRANSPORTATION			SHEET NO.	
DATE	DESCRIPTION				ROAD NO.	COUNTY	FINANCIAL PROJECT ID		
					SR 93	COLLIER	444008-3-52-01	SIGN CROSS SECTION (2)	S-60

THE OFFICIAL RECORD OF THIS SHEET IS THE ELECTRONIC FILE DIGITALLY SIGNED AND SEALED UNDER RULE 61G15-23.004, F.A.C.

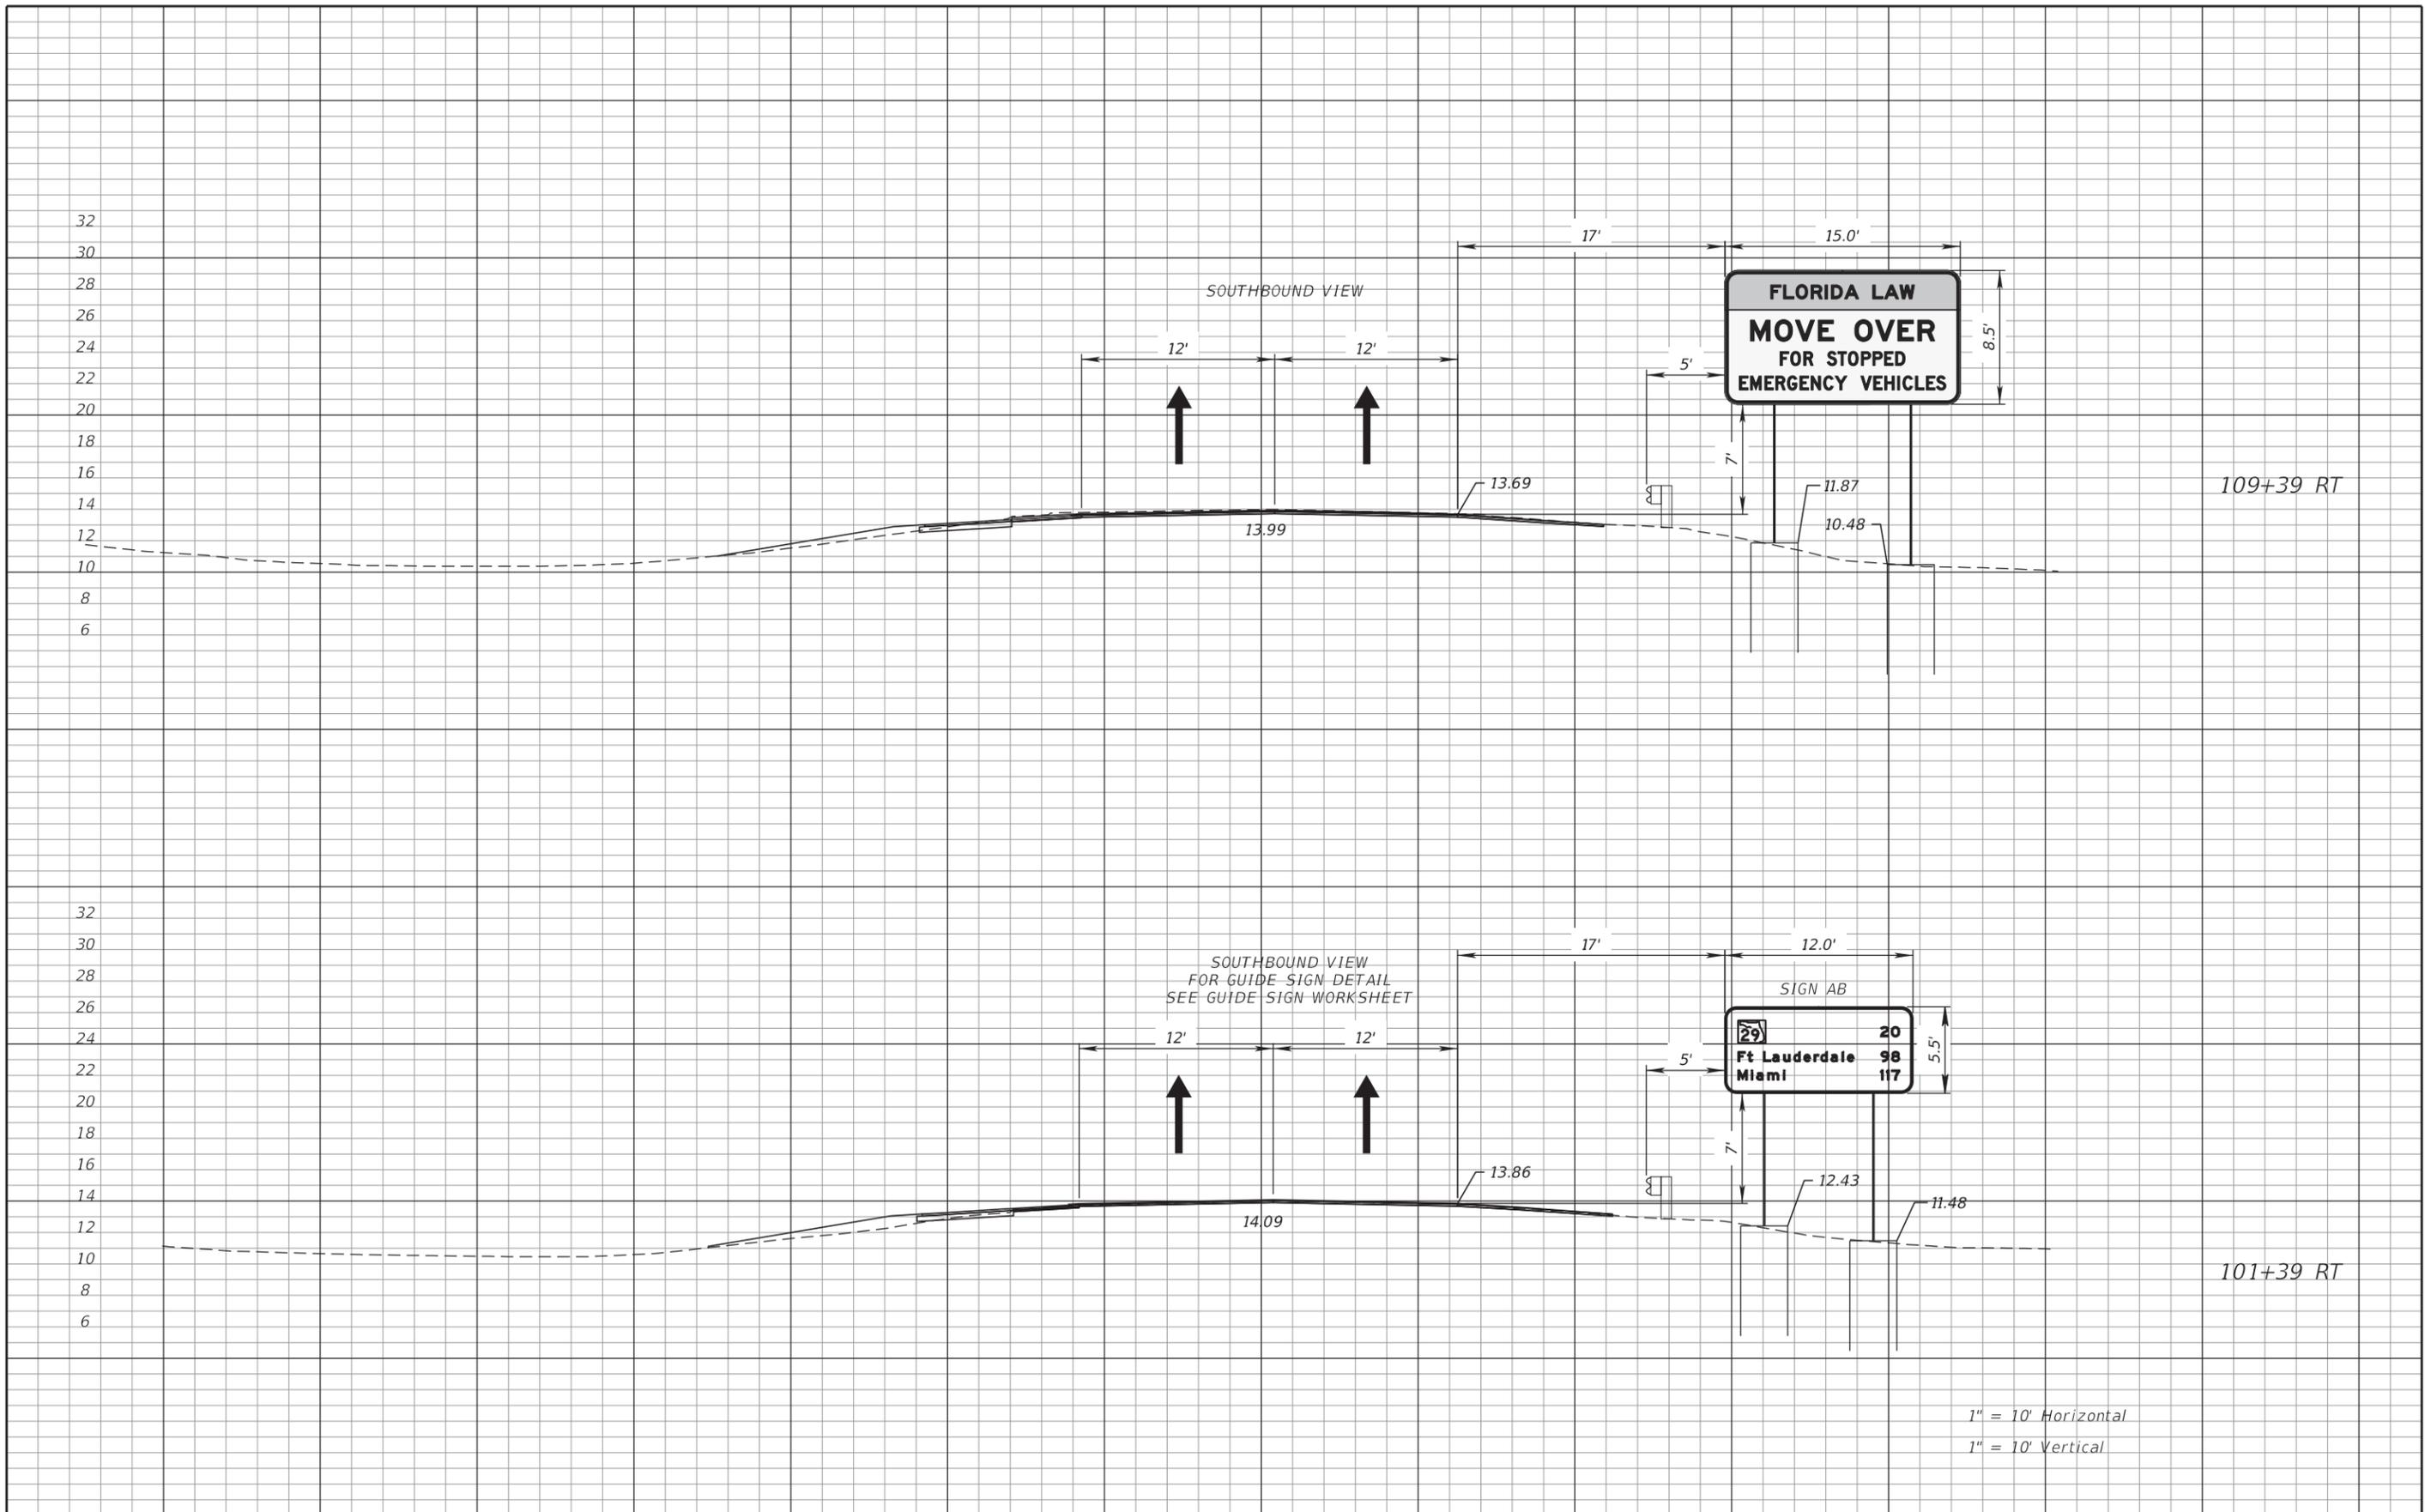


THE OFFICIAL RECORD OF THIS SHEET IS THE ELECTRONIC FILE DIGITALLY SIGNED AND SEALED UNDER RULE 61G15-23.004, F.A.C.

REVISIONS				PATRICIA T. CHRISTIE, P.E. P.E. NO.: 60049 FALLER, DAVIS & ASSOCIATES, INC. 4200 W. CYPRESS ST., SUITE 500 TAMPA, FLORIDA 33607-4168	STATE OF FLORIDA DEPARTMENT OF TRANSPORTATION			SIGN CROSS SECTION (3)	SHEET NO. S-61
DATE	DESCRIPTION	DATE	DESCRIPTION		ROAD NO.	COUNTY	FINANCIAL PROJECT ID		
					SR 93	COLLIER	444008-3-52-01		

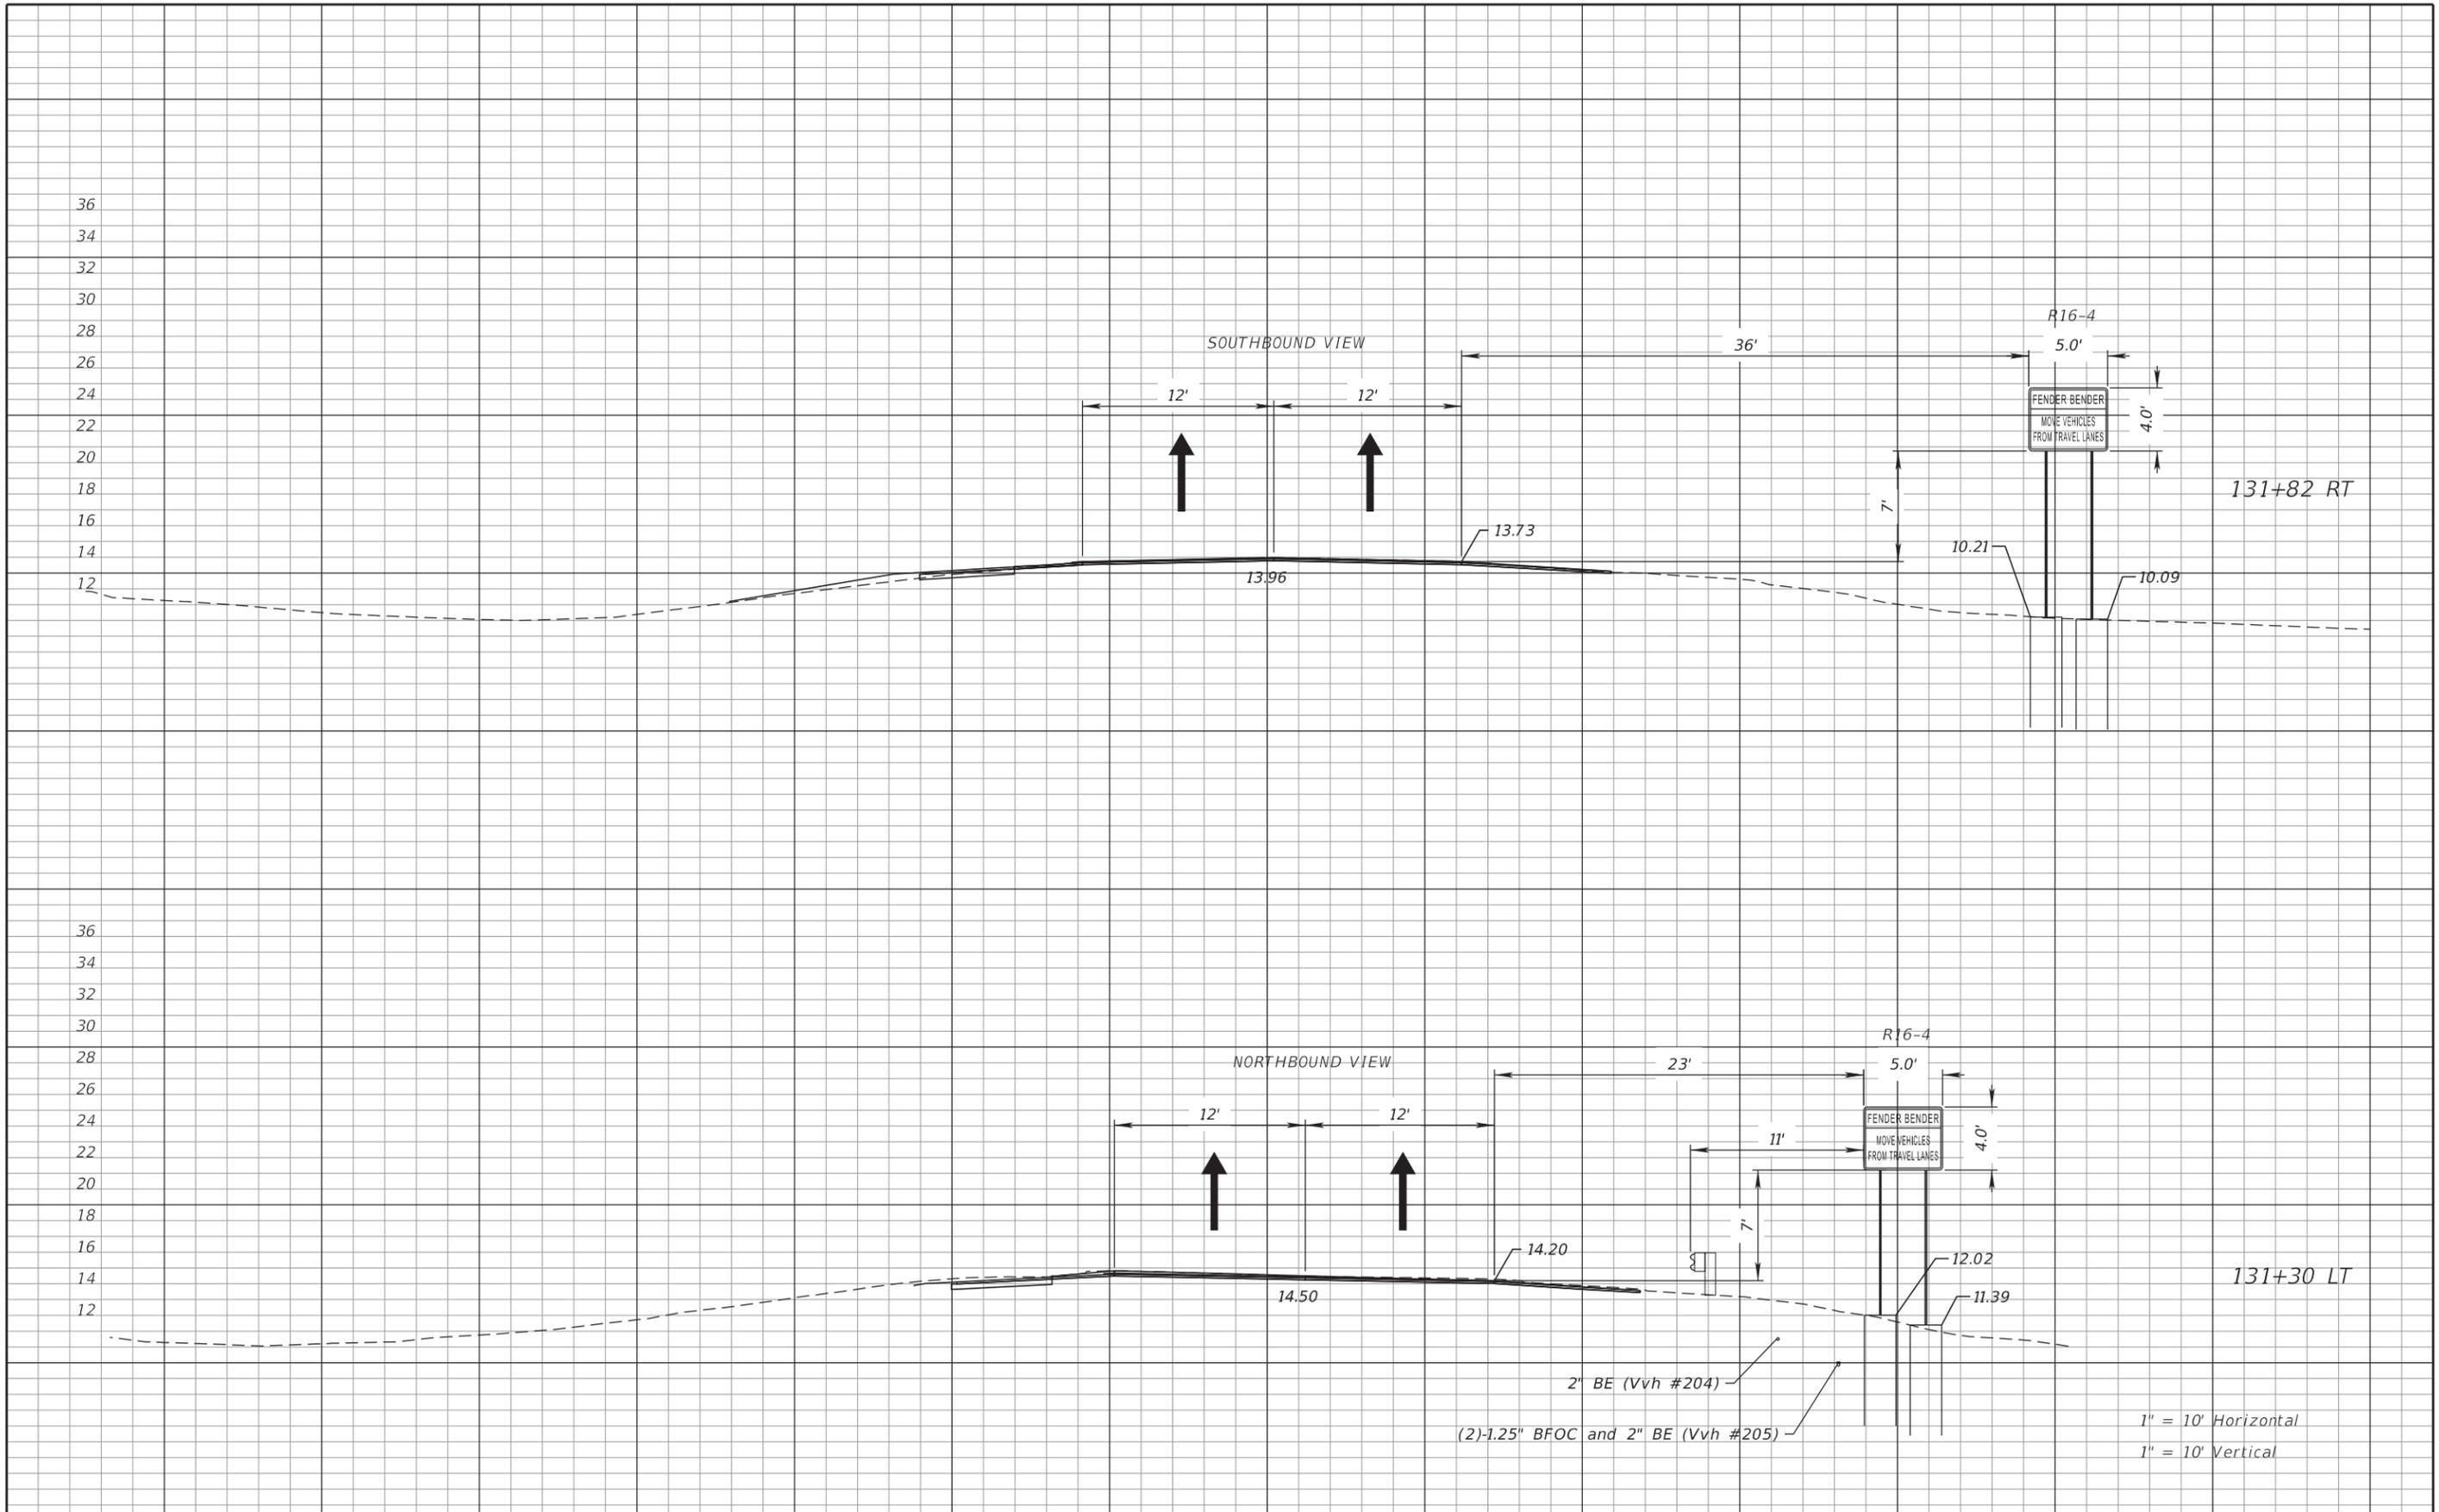


THE OFFICIAL RECORD OF THIS SHEET IS THE ELECTRONIC FILE DIGITALLY SIGNED AND SEALED UNDER RULE 61G15-23.004, F.A.C.

REVISIONS				PATRICIA T. CHRISTIE, P.E. P.E. NO.: 60049 FALLER, DAVIS & ASSOCIATES, INC. 4200 W. CYPRESS ST., SUITE 500 TAMPA, FLORIDA 33607-4168	STATE OF FLORIDA DEPARTMENT OF TRANSPORTATION			SIGN CROSS SECTION (4)	SHEET NO.
DATE	DESCRIPTION	DATE	DESCRIPTION		ROAD NO.	COUNTY	FINANCIAL PROJECT ID		5-62
					SR 93	COLLIER	444008-3-52-01		

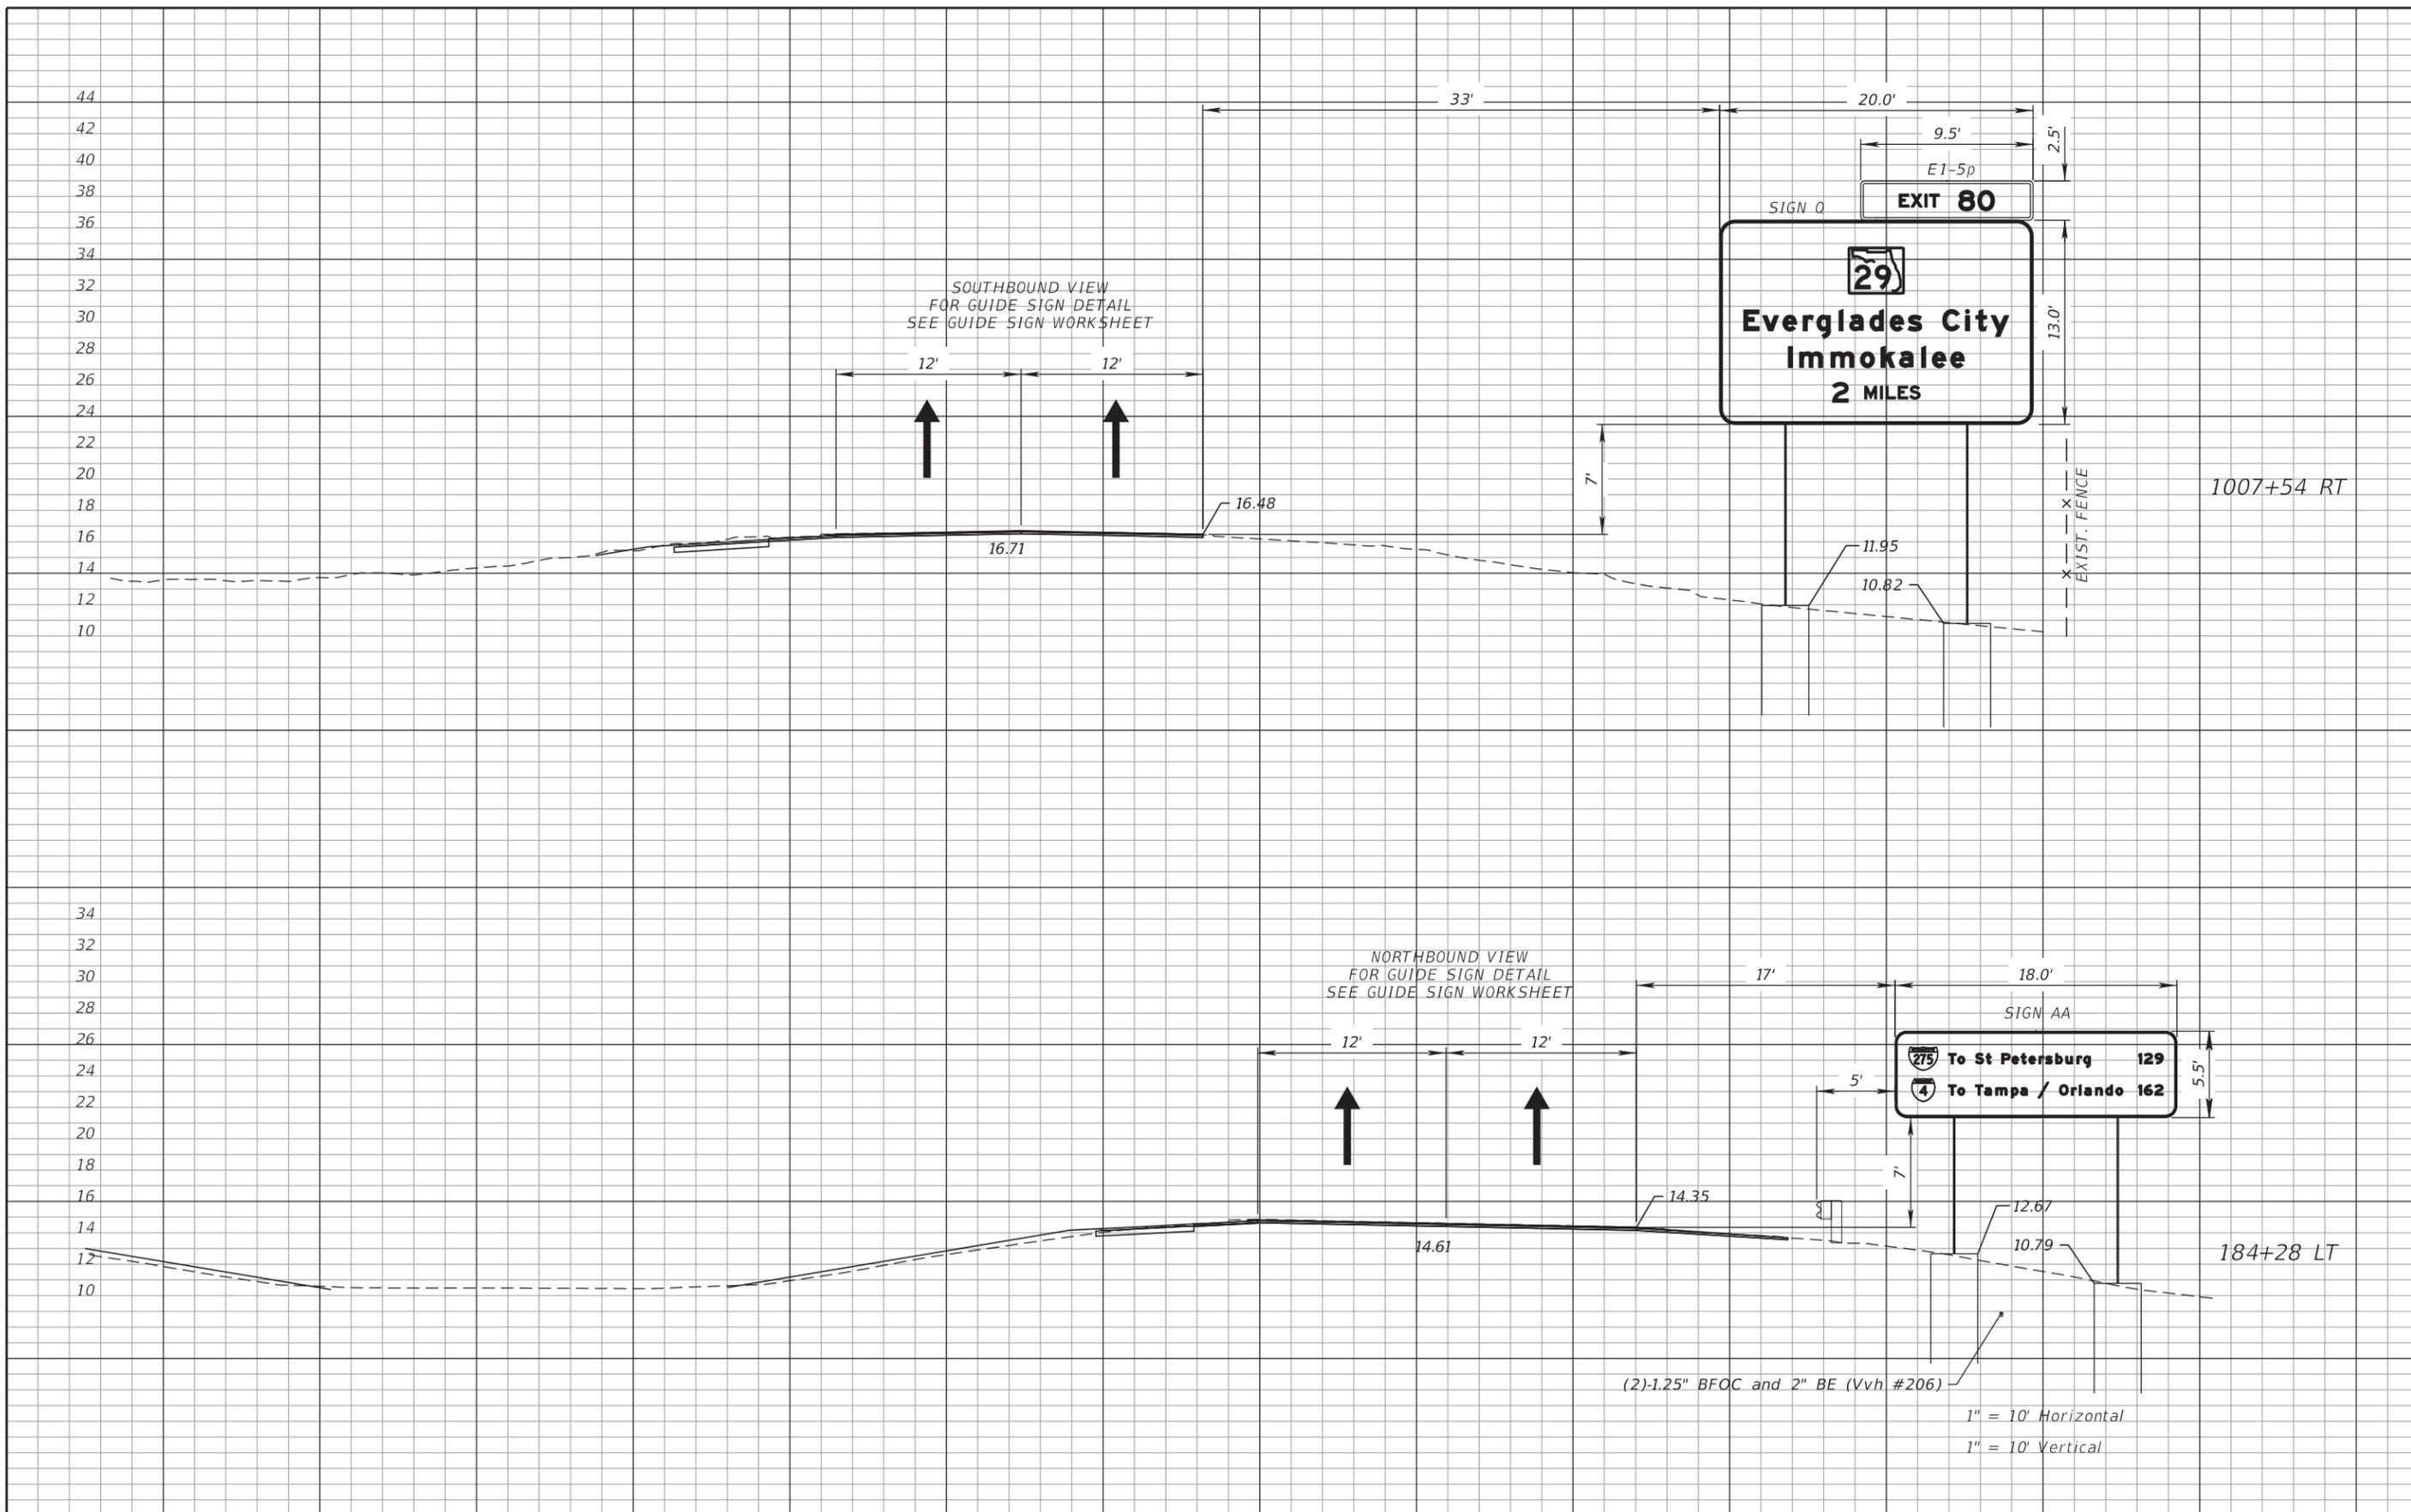


THE OFFICIAL RECORD OF THIS SHEET IS THE ELECTRONIC FILE DIGITALLY SIGNED AND SEALED UNDER RULE 61G15-23.004, F.A.C.

REVISIONS				PATRICIA T. CHRISTIE, P.E. P.E. NO.: 60049 FALLER, DAVIS & ASSOCIATES, INC. 4200 W. CYPRESS ST., SUITE 500 TAMPA, FLORIDA 33607-4168	STATE OF FLORIDA DEPARTMENT OF TRANSPORTATION			SIGN CROSS SECTION (5)	SHEET NO. S-63
DATE	DESCRIPTION	DATE	DESCRIPTION		ROAD NO.	COUNTY	FINANCIAL PROJECT ID		
					SR 93	COLLIER	444008-3-52-01		

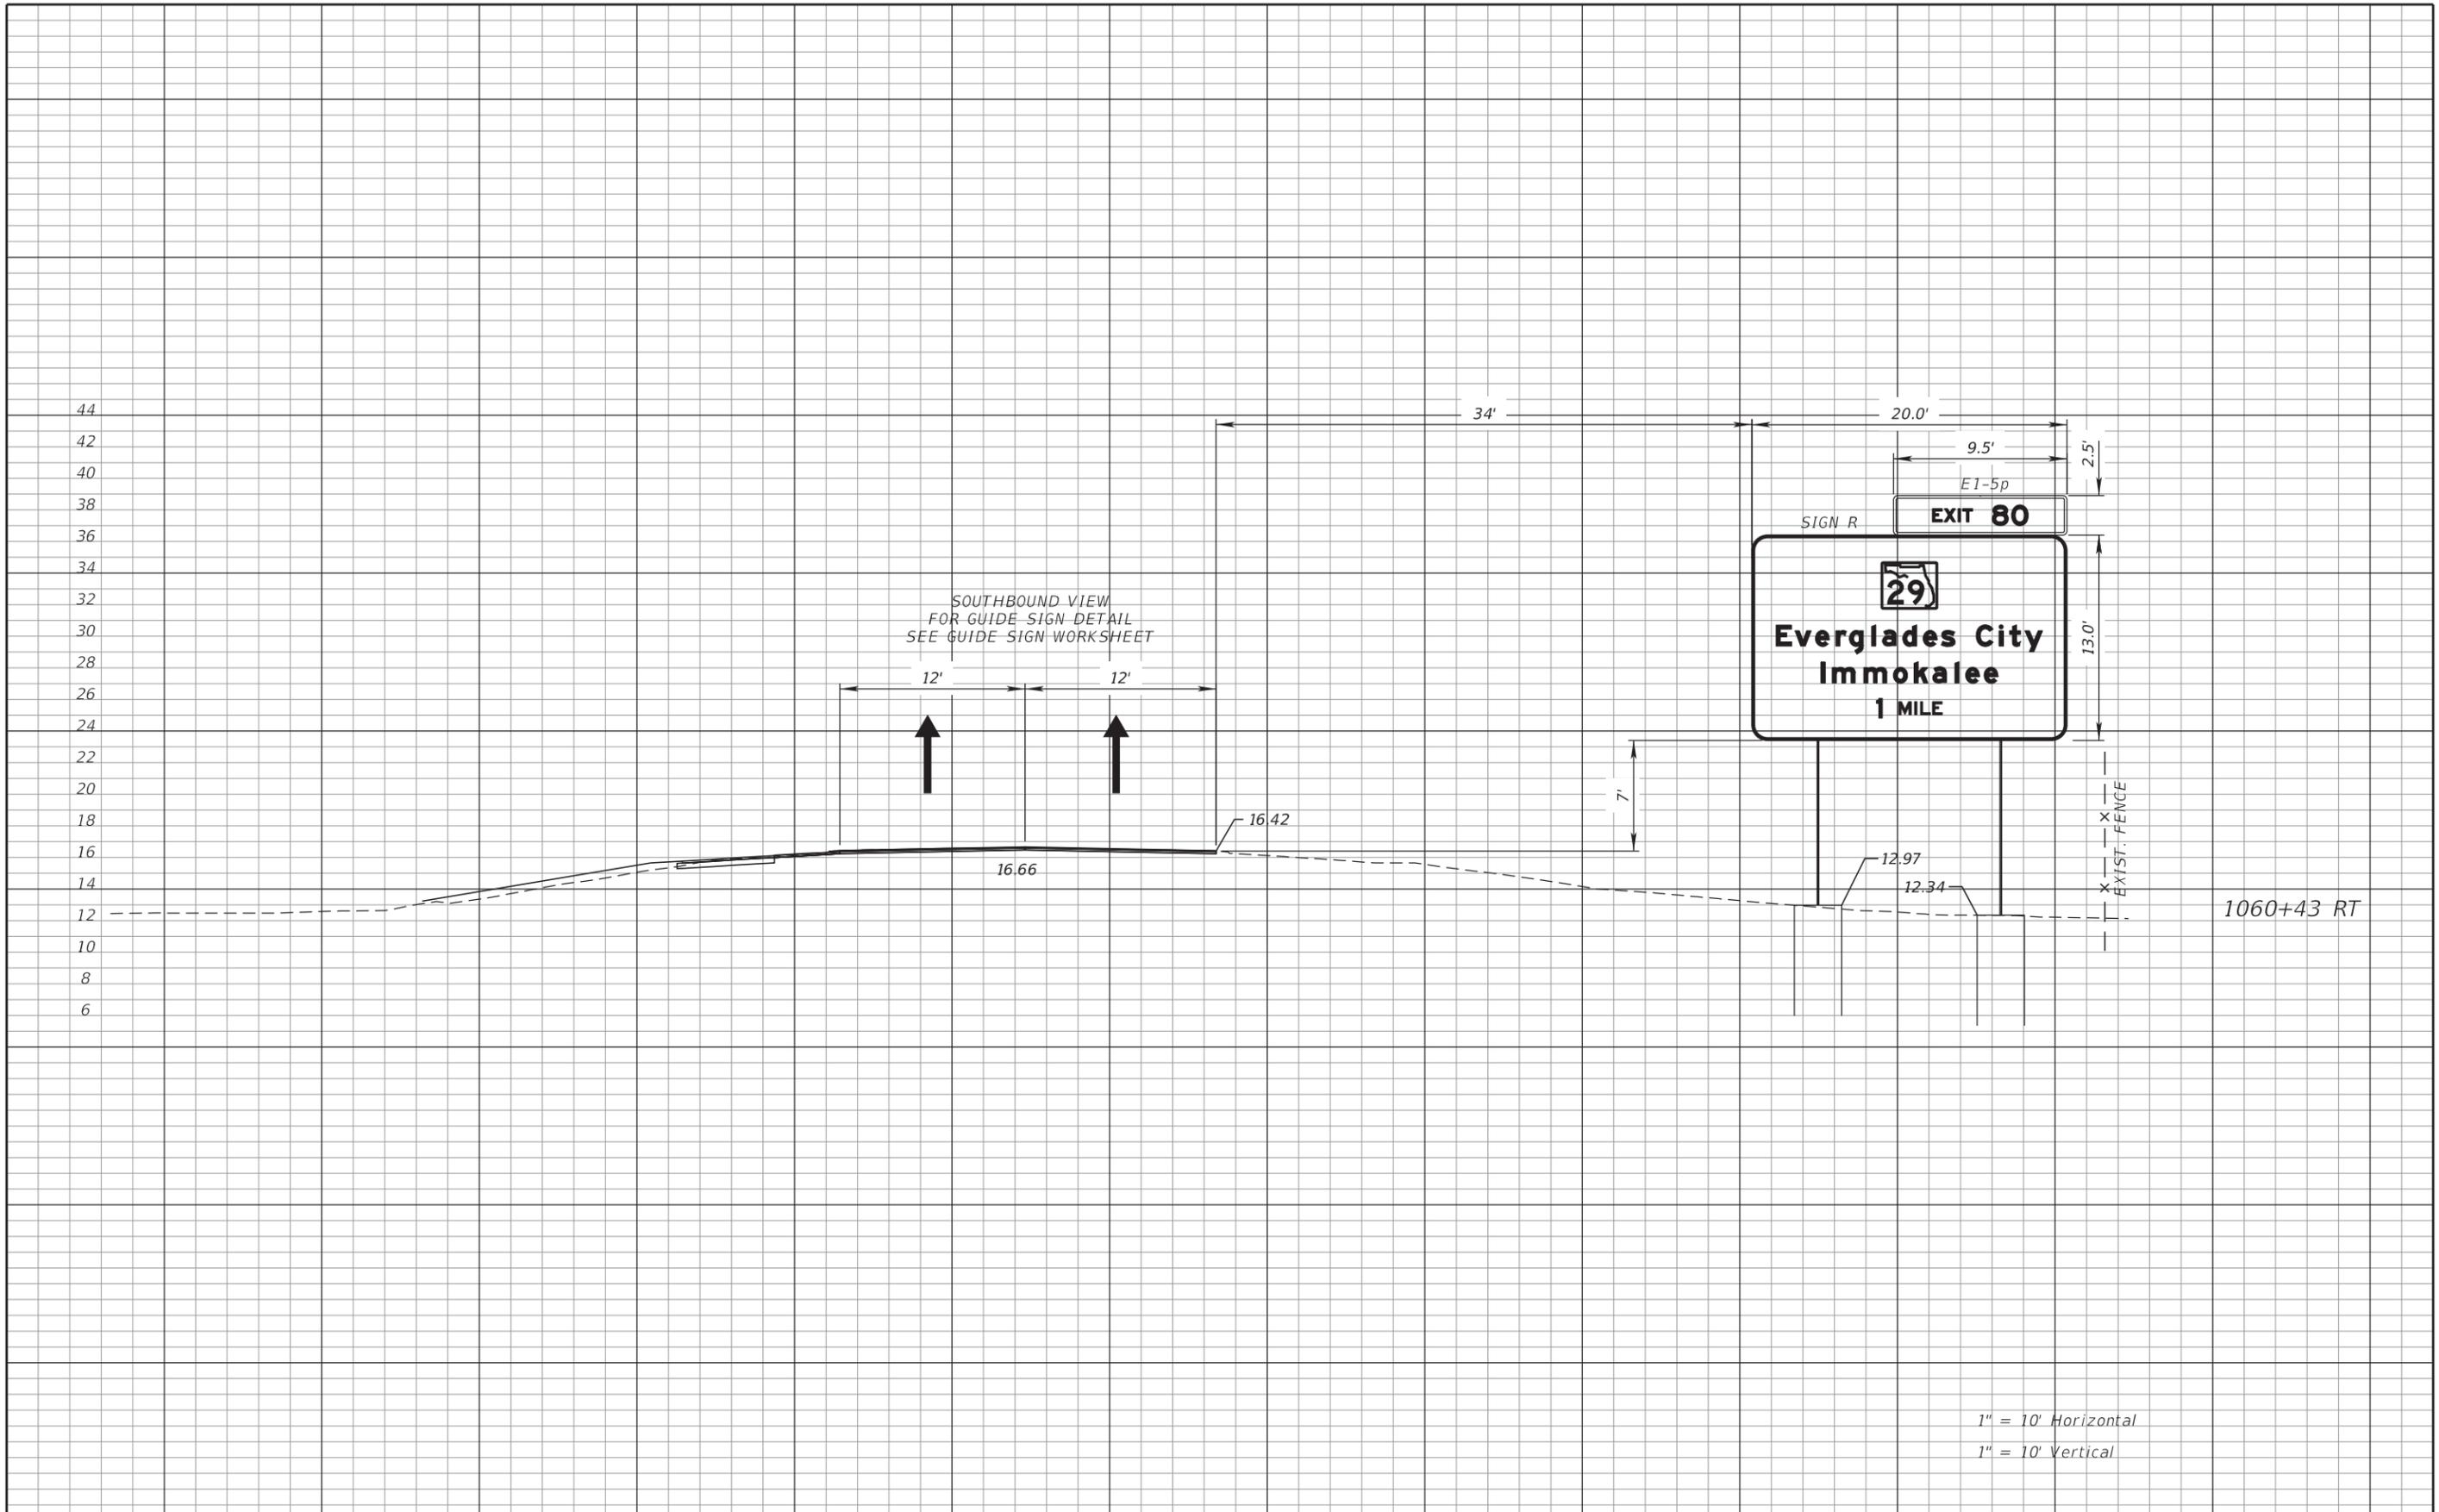

THE OFFICIAL RECORD OF THIS SHEET IS THE ELECTRONIC FILE DIGITALLY SIGNED AND SEALED UNDER RULE 61G15-23.004, F.A.C.


REVISIONS				PATRICIA T. CHRISTIE, P.E. P.E. NO.: 60049 FALLER, DAVIS & ASSOCIATES, INC. 4200 W. CYPRESS ST., SUITE 500 TAMPA, FLORIDA 33607-4168	STATE OF FLORIDA DEPARTMENT OF TRANSPORTATION			SIGN CROSS SECTION (6)	SHEET NO. S-64
DATE	DESCRIPTION	DATE	DESCRIPTION		ROAD NO.	COUNTY	FINANCIAL PROJECT ID		
					SR 93	COLLIER	444008-3-52-01		

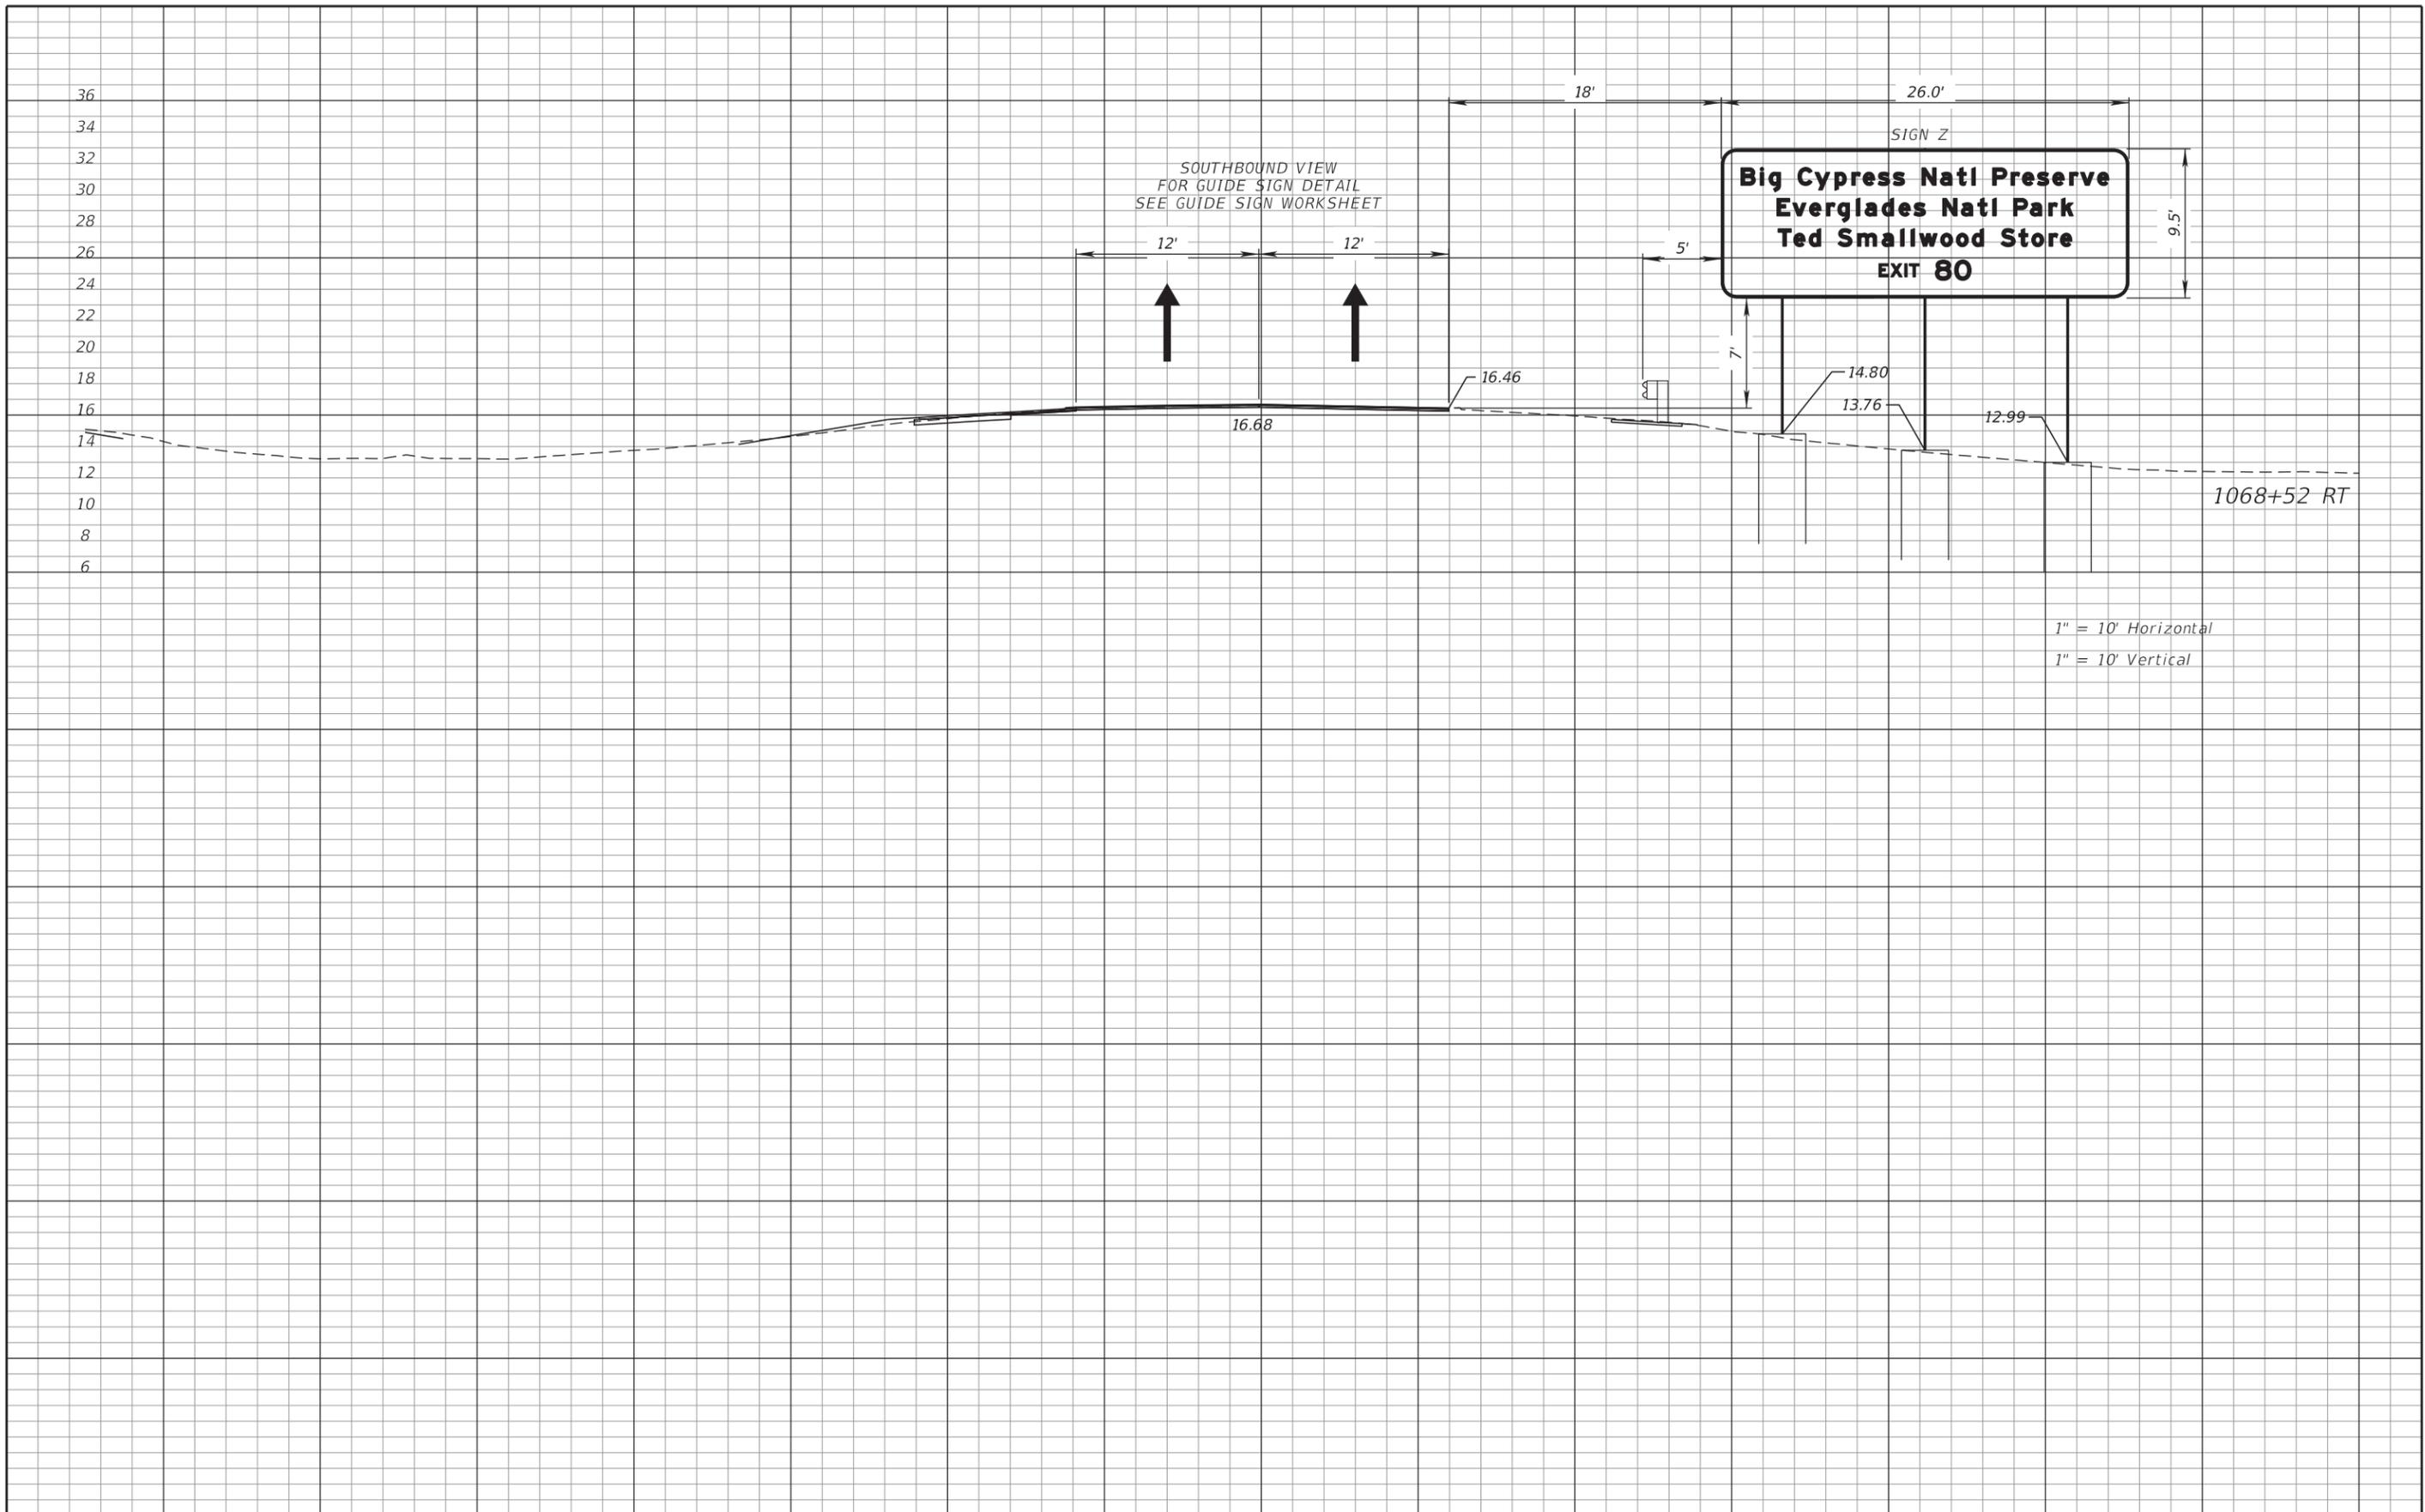

THE OFFICIAL RECORD OF THIS SHEET IS THE ELECTRONIC FILE DIGITALLY SIGNED AND SEALED UNDER RULE 61G15-23.004, F.A.C.


REVISIONS		PATRICIA T. CHRISTIE, P.E.		STATE OF FLORIDA			SHEET NO.
DATE	DESCRIPTION	DATE	DESCRIPTION	DEPARTMENT OF TRANSPORTATION			
				ROAD NO.	COUNTY	FINANCIAL PROJECT ID	
				SR 93	COLLIER	444008-3-52-01	S-65

THE OFFICIAL RECORD OF THIS SHEET IS THE ELECTRONIC FILE DIGITALLY SIGNED AND SEALED UNDER RULE 61G15-23.004, F.A.C.

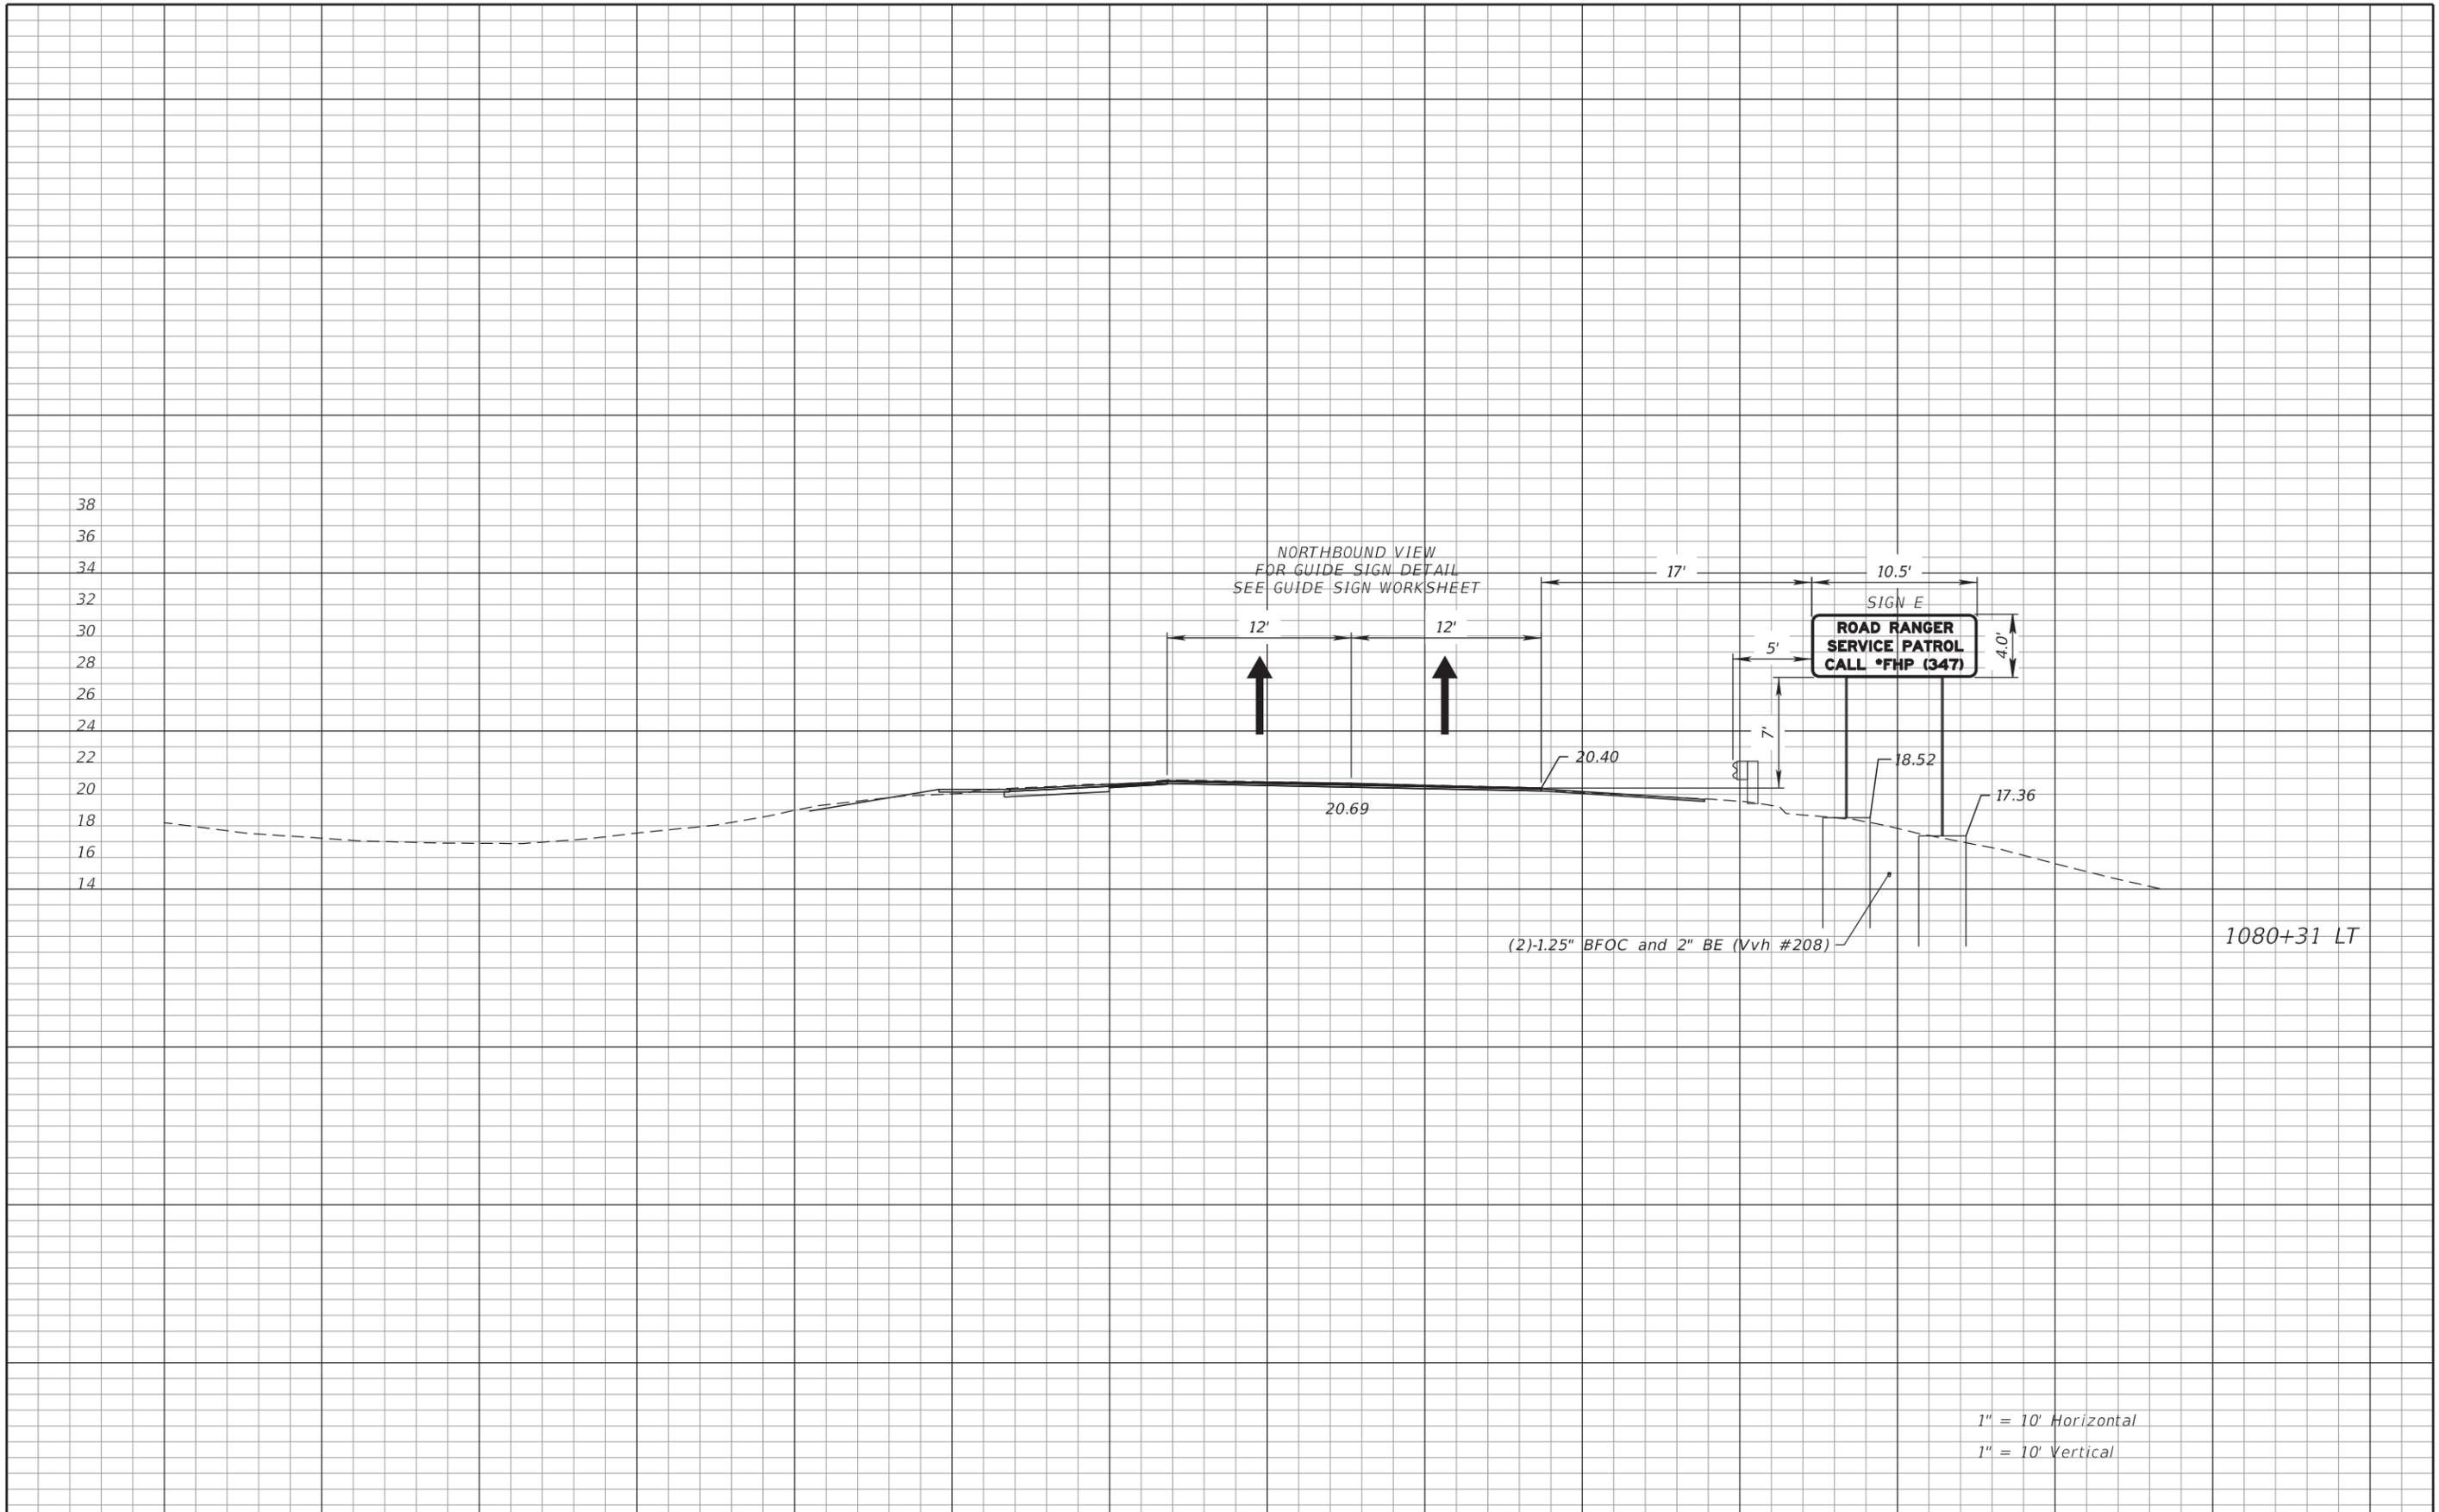


1" = 10' Horizontal
1" = 10' Vertical

DATE		DESCRIPTION		REVISIONS		PATRICIA T. CHRISTIE, P.E. P.E. NO.: 60049 FALLER, DAVIS & ASSOCIATES, INC. 4200 W. CYPRESS ST., SUITE 500 TAMPA, FLORIDA 33607-4168	STATE OF FLORIDA DEPARTMENT OF TRANSPORTATION			SHEET NO. S-66
DATE	DESCRIPTION	DATE	DESCRIPTION	ROAD NO.	COUNTY		FINANCIAL PROJECT ID			
					SR 93	COLLIER	444008-3-52-01	SIGN CROSS SECTION (8)		

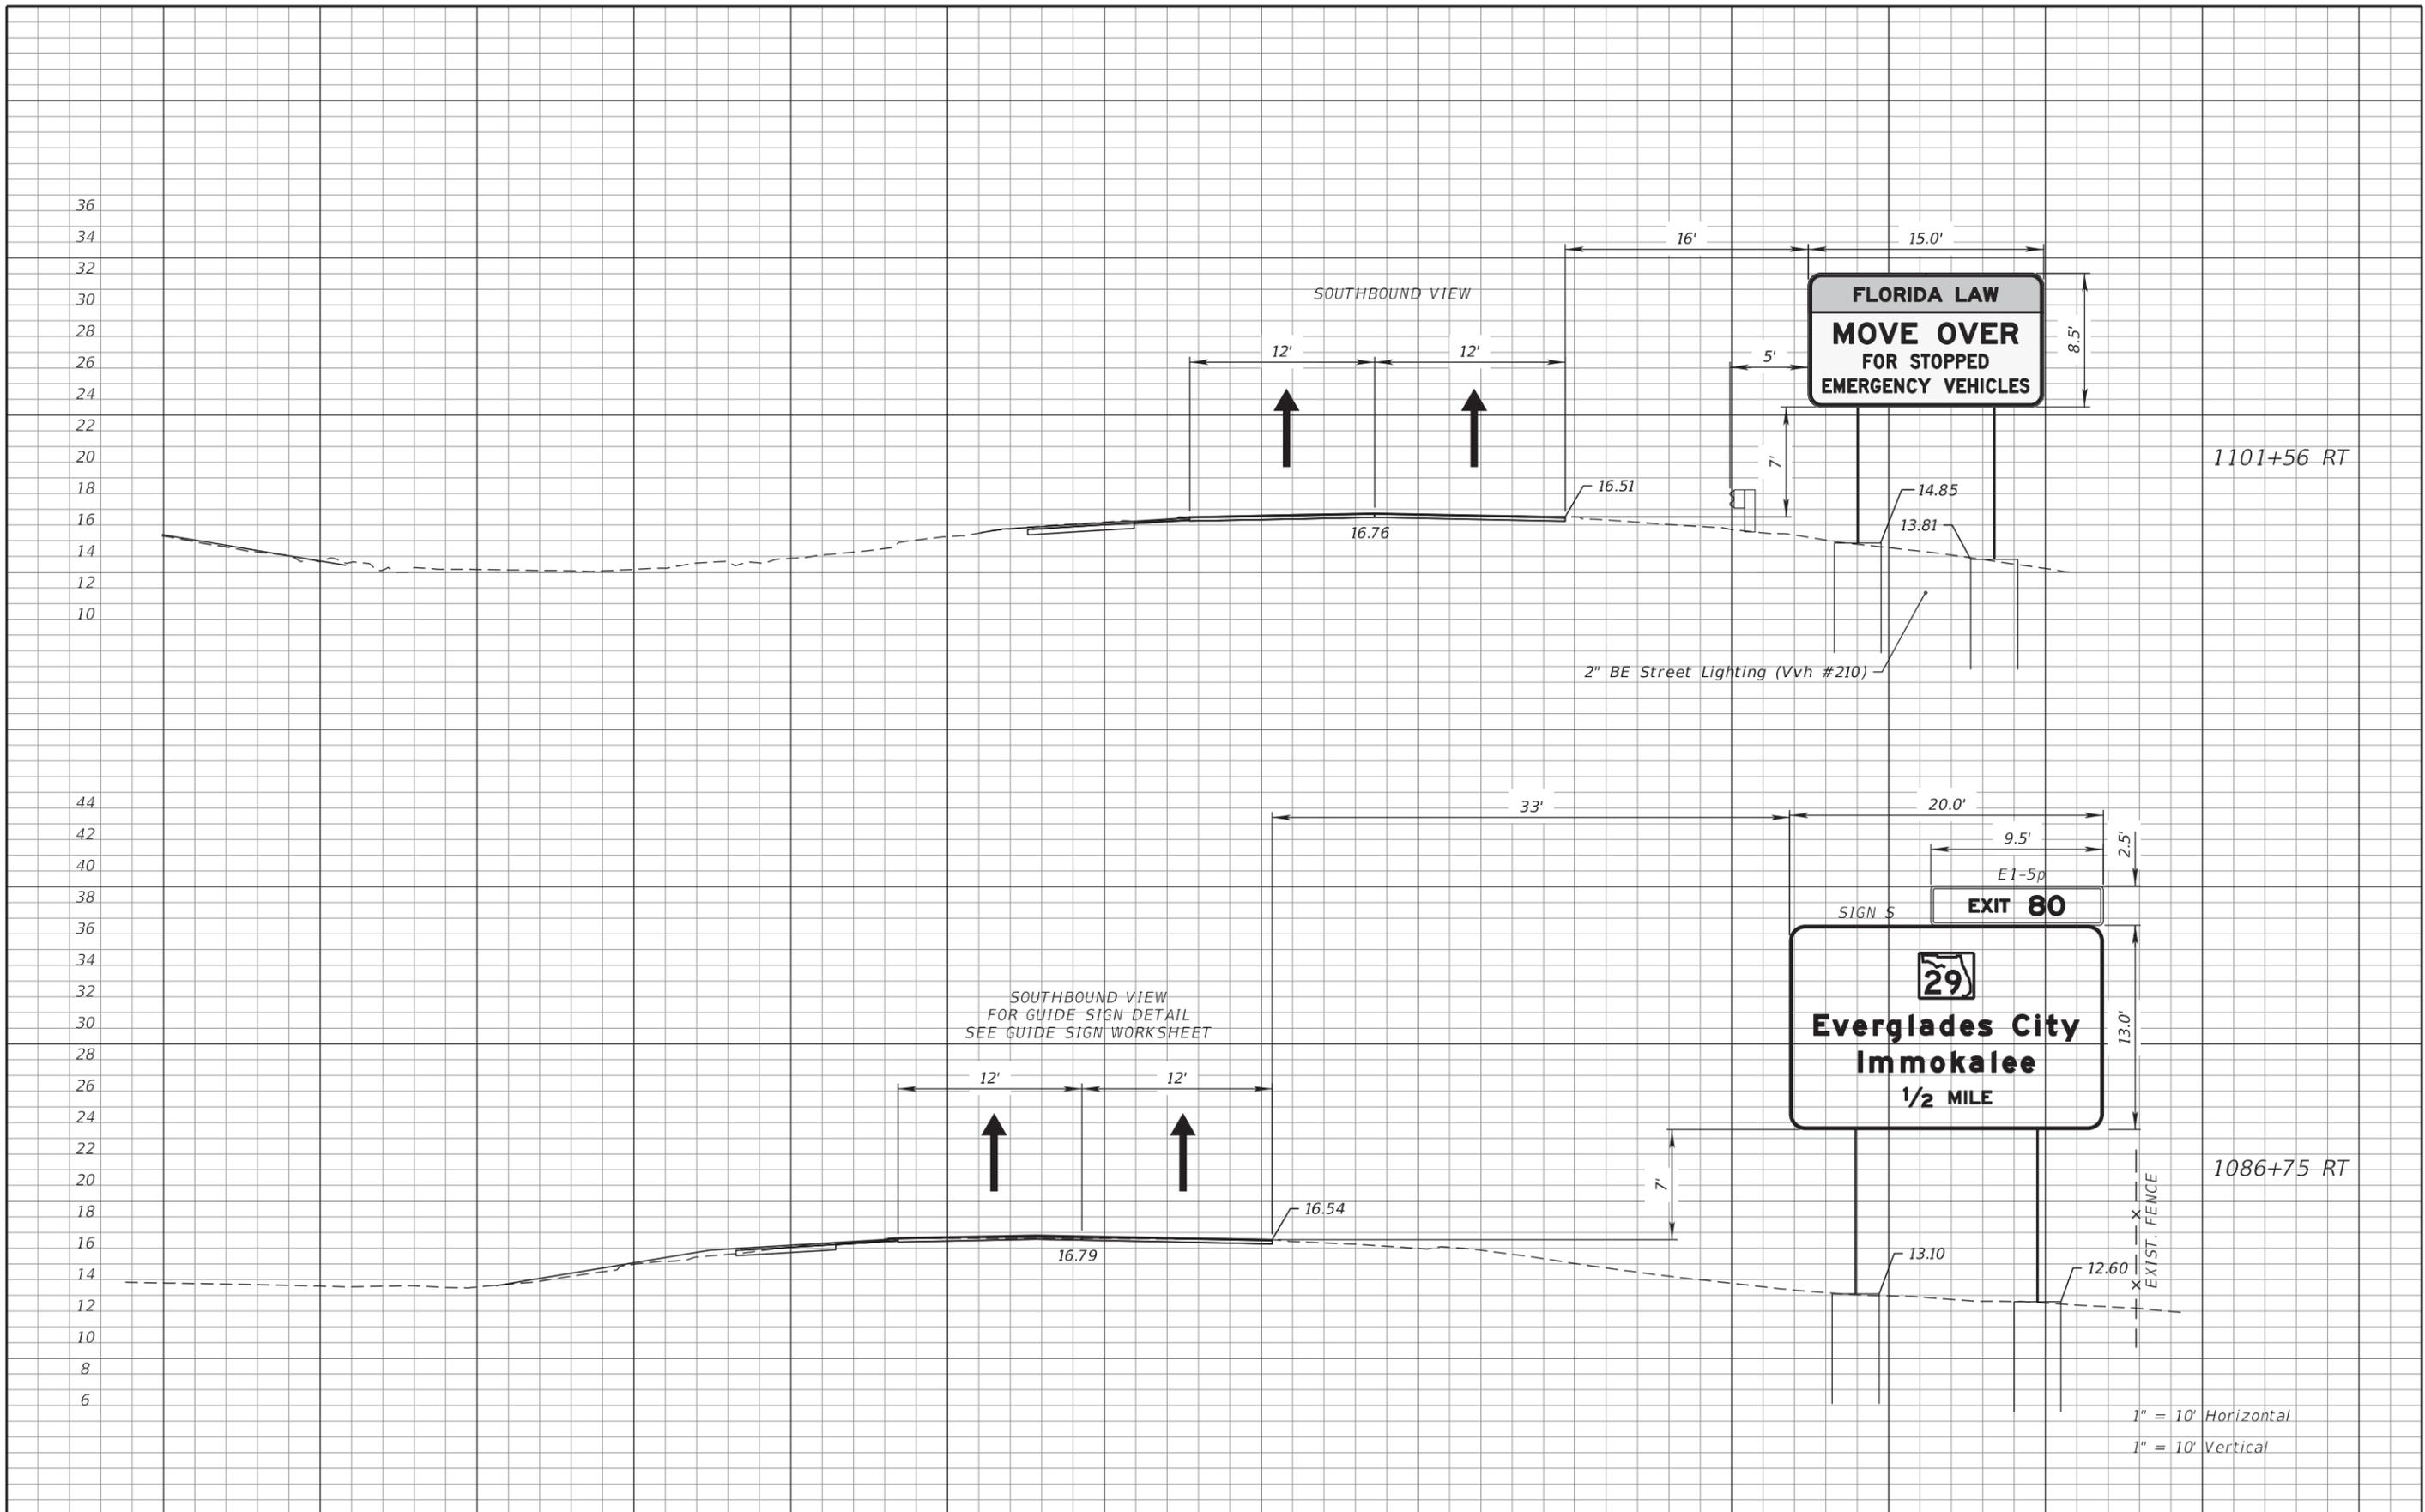


THE OFFICIAL RECORD OF THIS SHEET IS THE ELECTRONIC FILE DIGITALLY SIGNED AND SEALED UNDER RULE 61G15-23.004, F.A.C.

REVISIONS				PATRICIA T. CHRISTIE, P.E. P.E. NO.: 60049 FALLER, DAVIS & ASSOCIATES, INC. 4200 W. CYPRESS ST., SUITE 500 TAMPA, FLORIDA 33607-4168	STATE OF FLORIDA DEPARTMENT OF TRANSPORTATION			SIGN CROSS SECTION (9)	SHEET NO. S-67
DATE	DESCRIPTION	DATE	DESCRIPTION		ROAD NO.	COUNTY	FINANCIAL PROJECT ID		
					SR 93	COLLIER	444008-3-52-01		

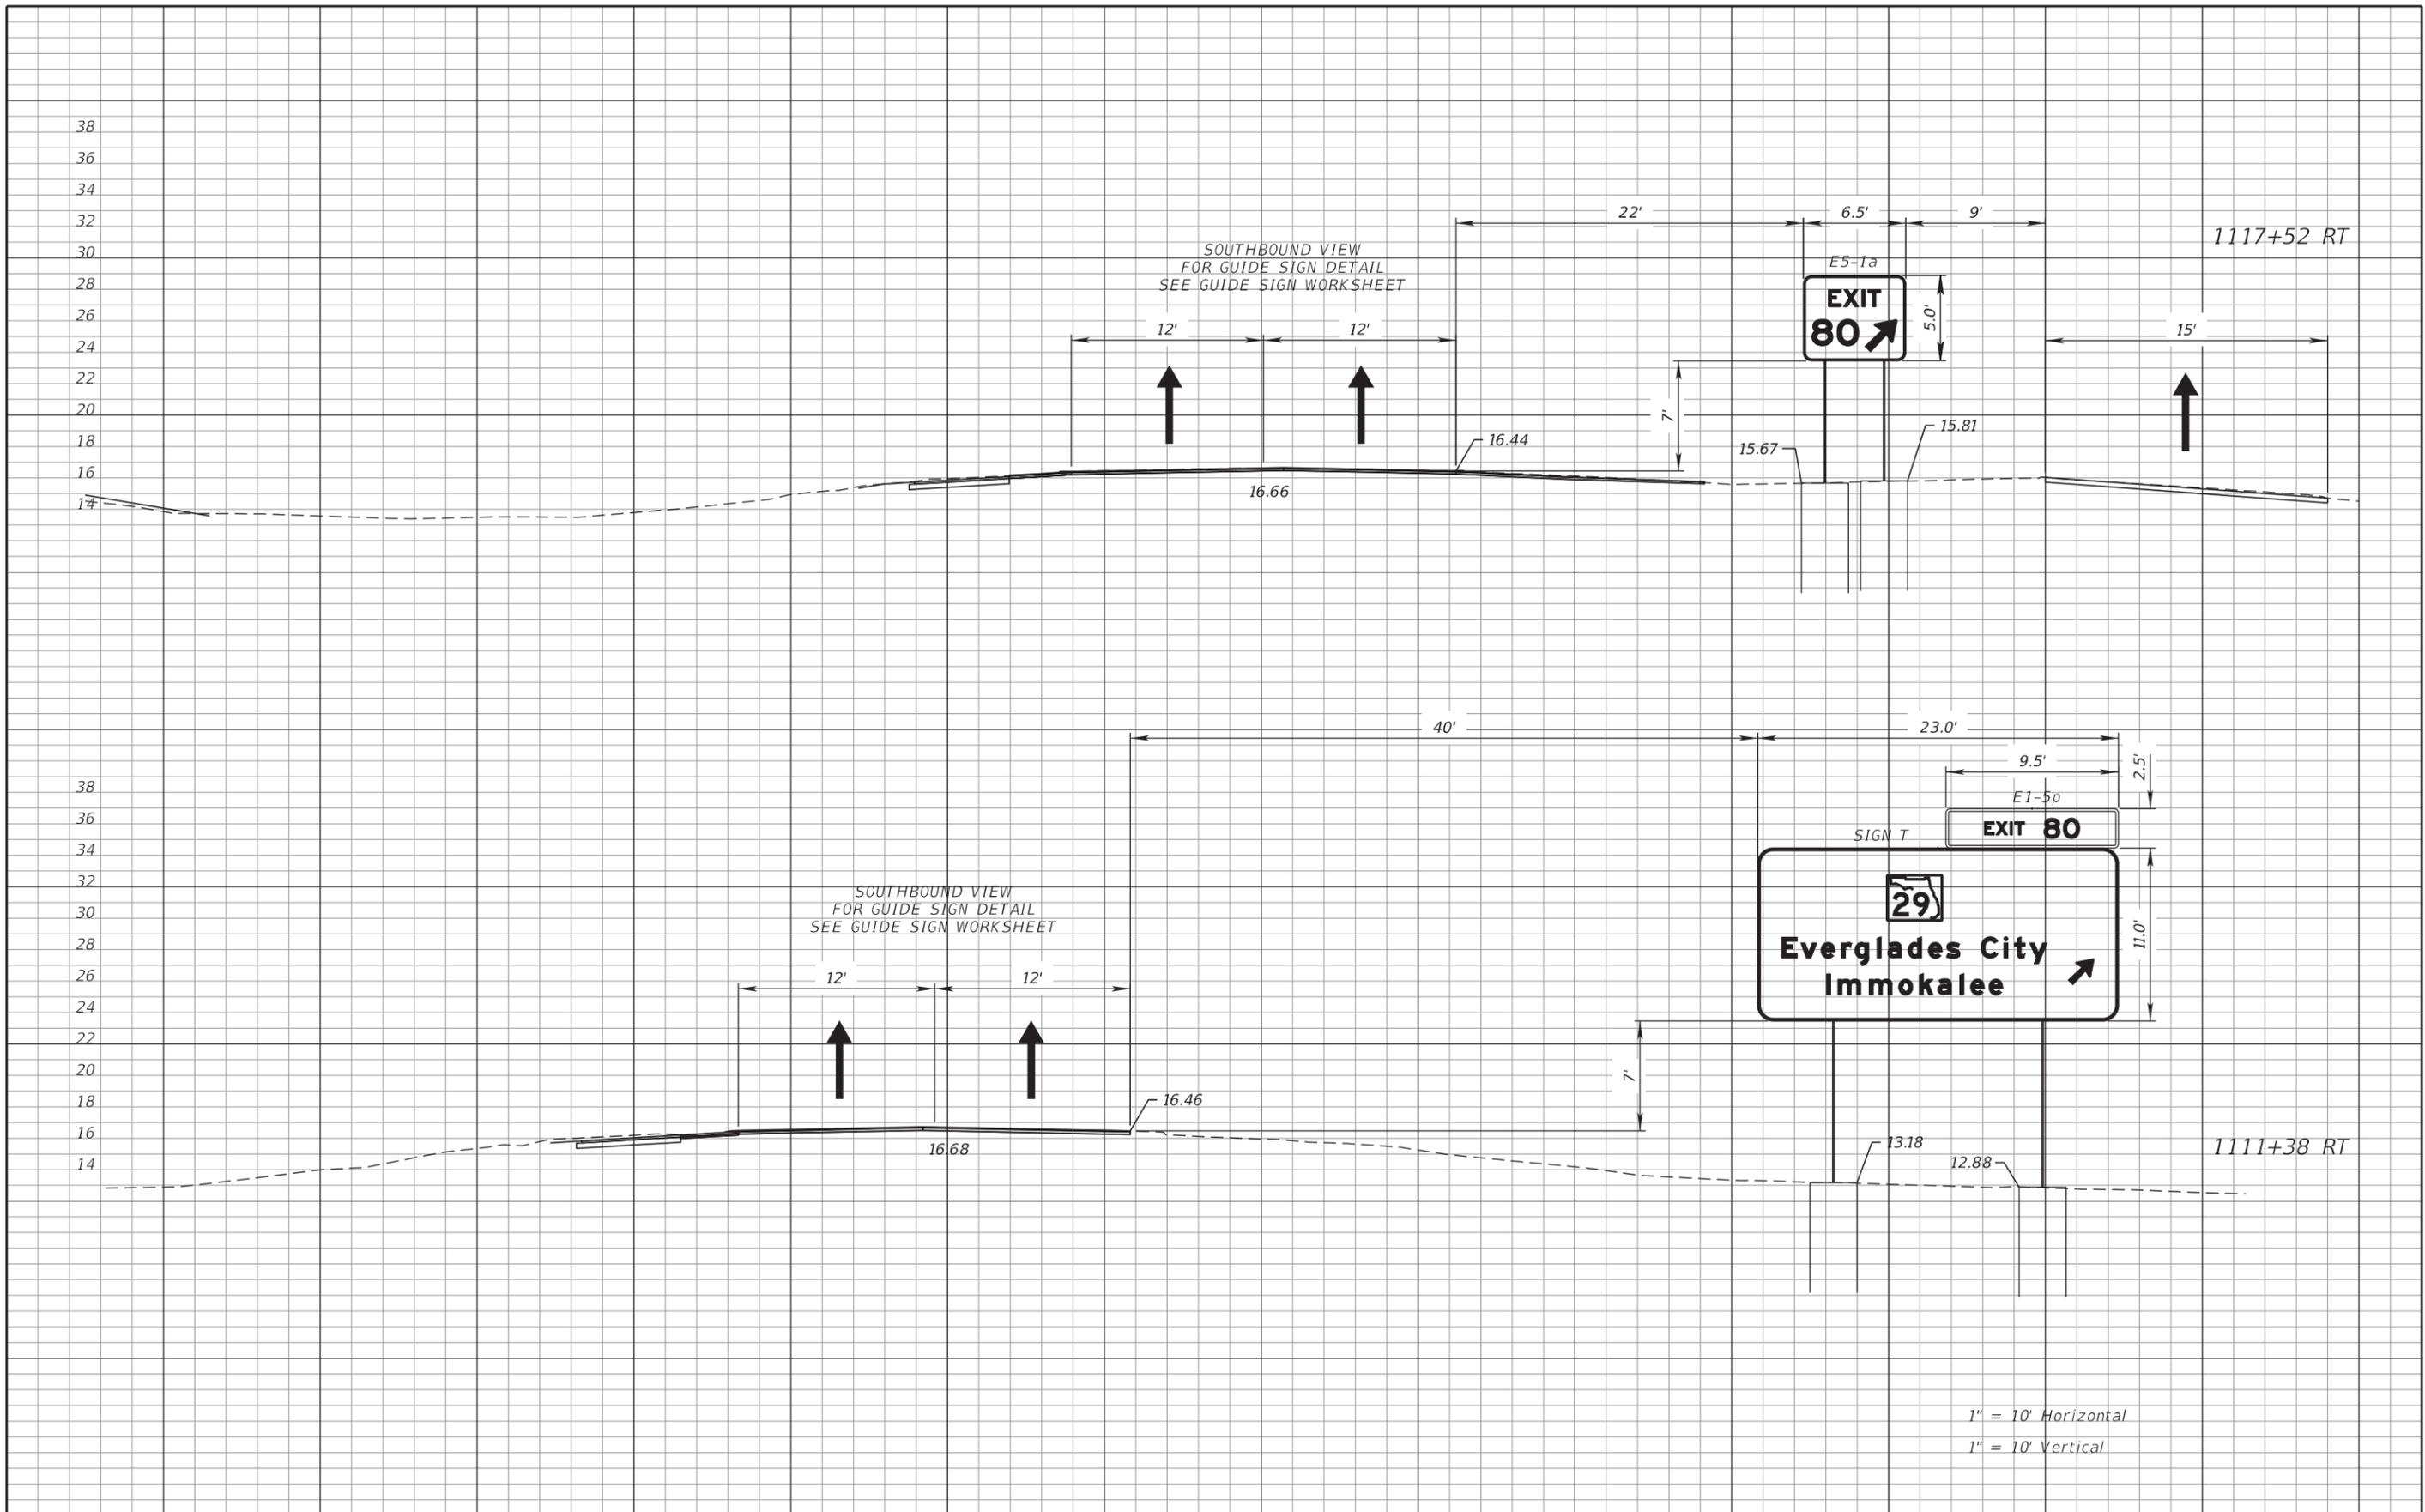


THE OFFICIAL RECORD OF THIS SHEET IS THE ELECTRONIC FILE DIGITALLY SIGNED AND SEALED UNDER RULE 61G15-23.004, F.A.C.

REVISIONS				PATRICIA T. CHRISTIE, P.E. P.E. NO.: 60049 FALLER, DAVIS & ASSOCIATES, INC. 4200 W. CYPRESS ST., SUITE 500 TAMPA, FLORIDA 33607-4168	STATE OF FLORIDA DEPARTMENT OF TRANSPORTATION			SIGN CROSS SECTION (10)	SHEET NO. S-68
DATE	DESCRIPTION	DATE	DESCRIPTION		ROAD NO.	COUNTY	FINANCIAL PROJECT ID		
					SR 93	COLLIER	444008-3-52-01		

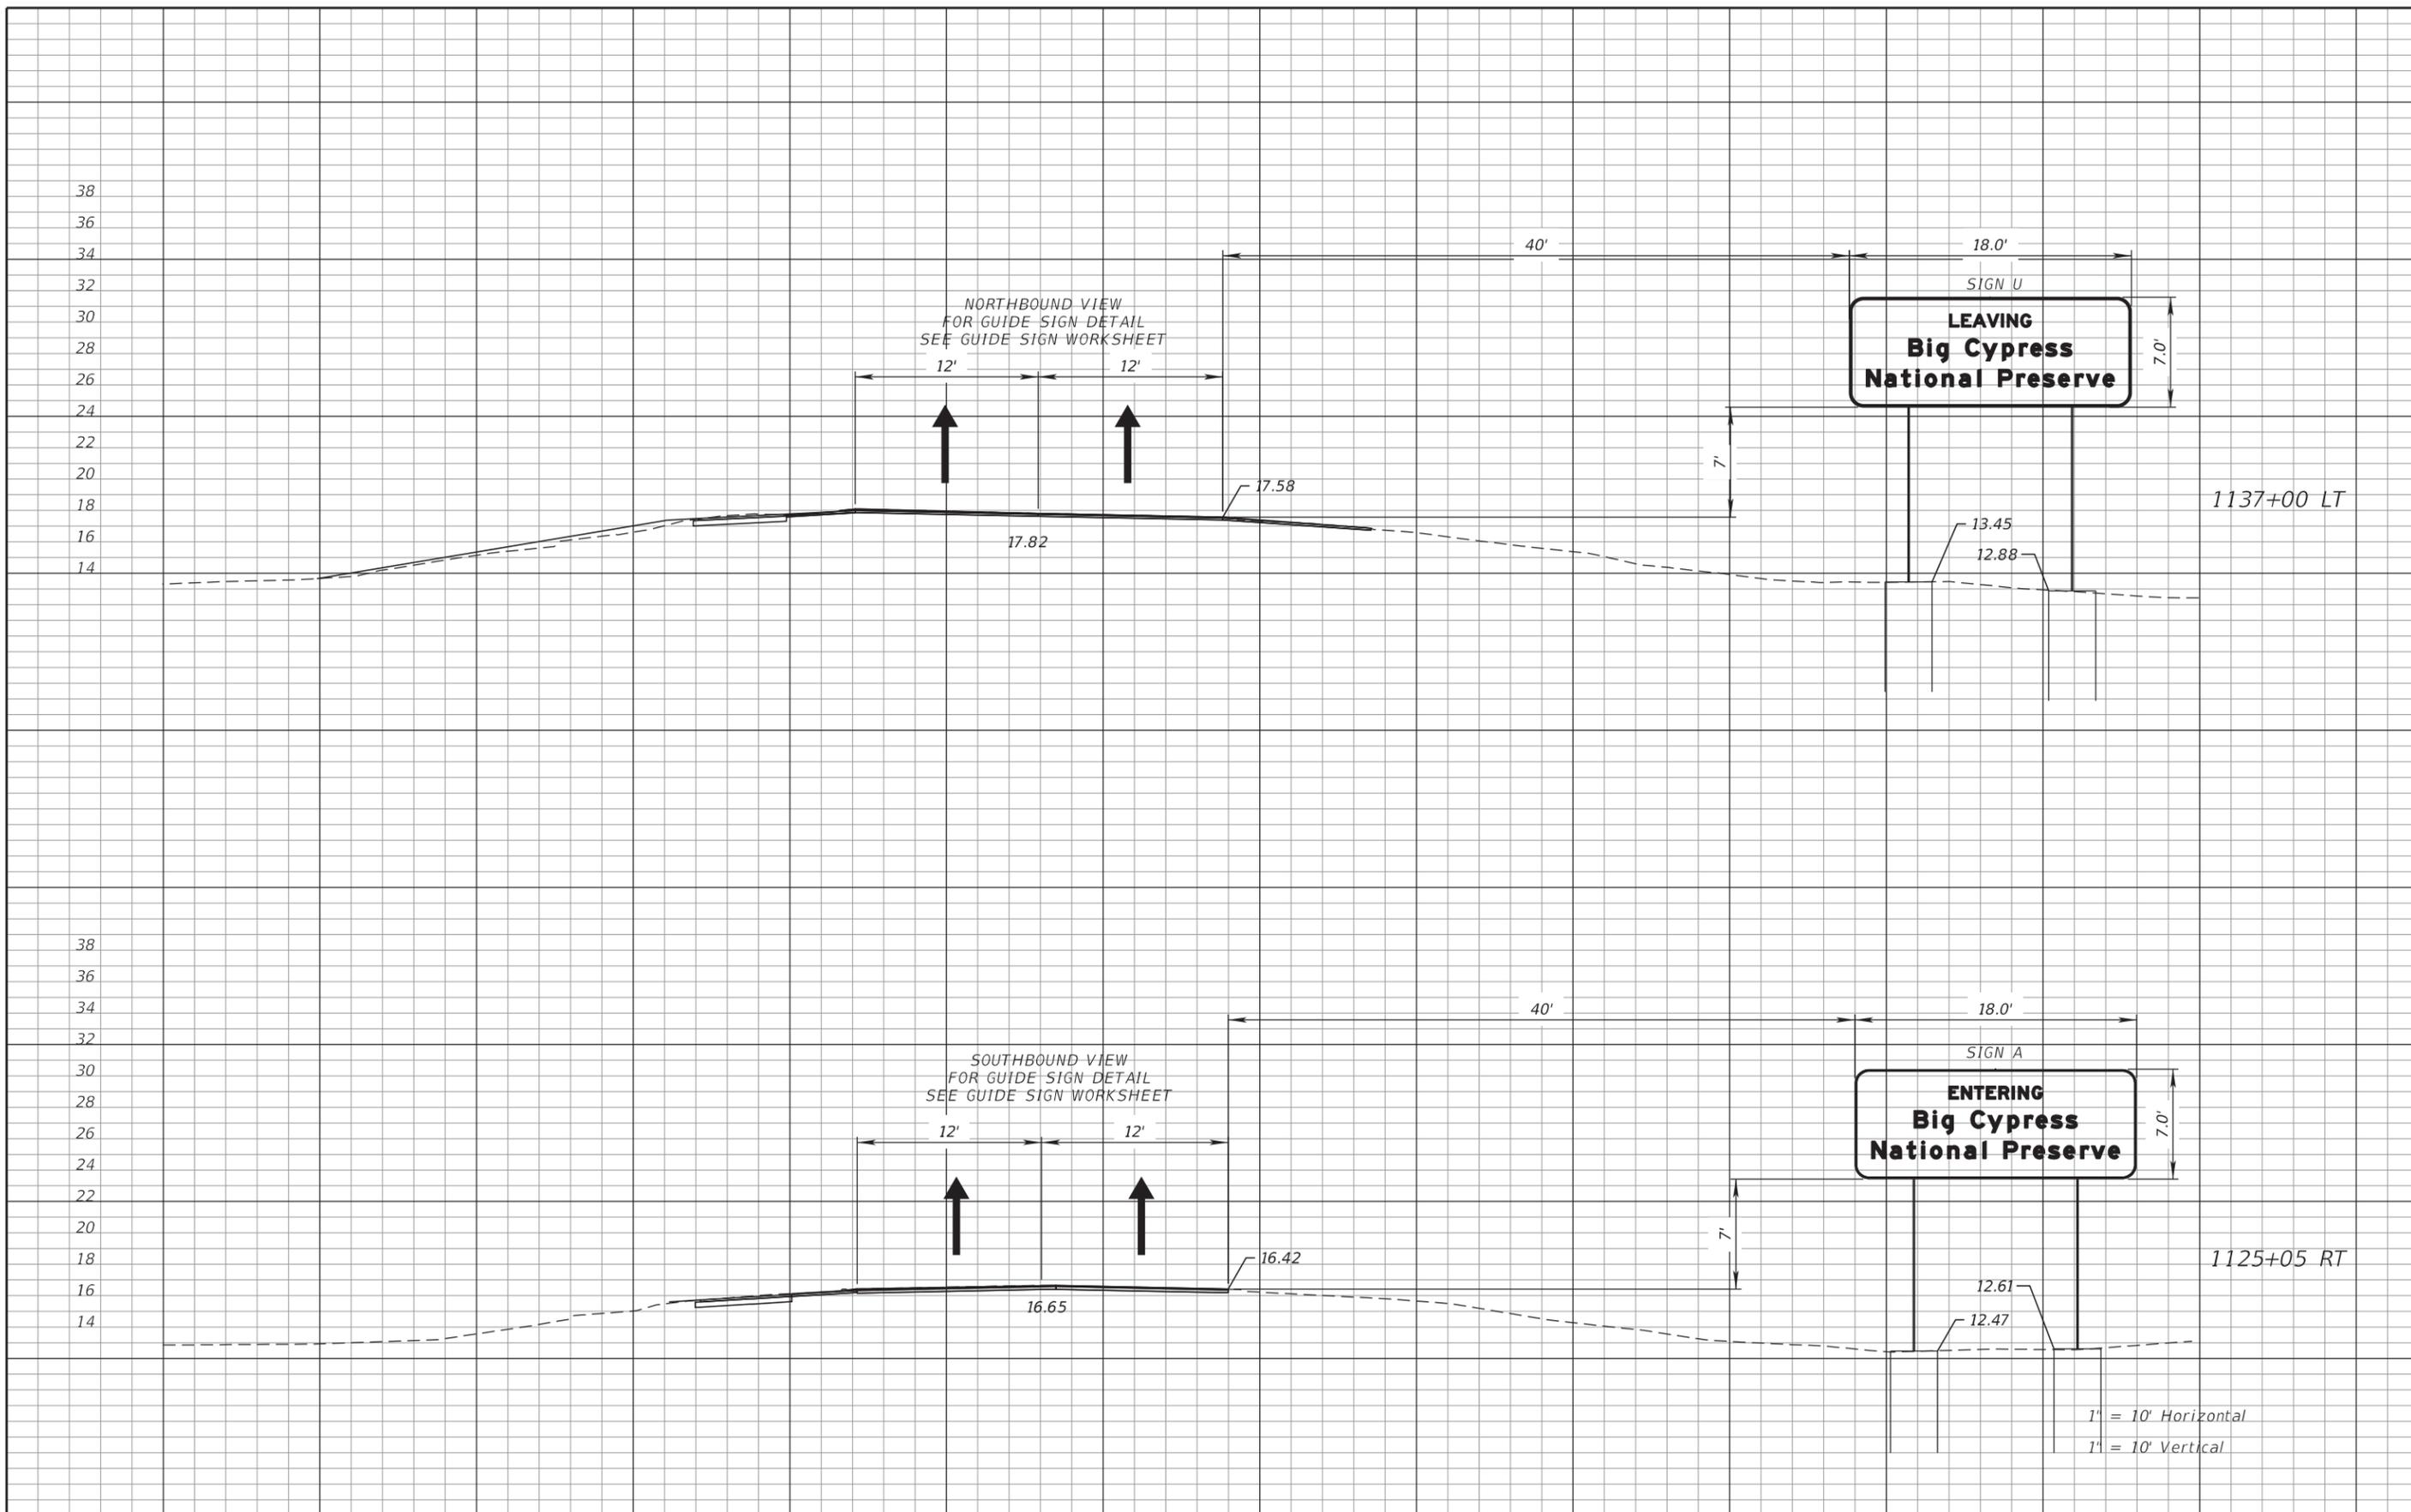


THE OFFICIAL RECORD OF THIS SHEET IS THE ELECTRONIC FILE DIGITALLY SIGNED AND SEALED UNDER RULE 61G15-23.004, F.A.C.

REVISIONS				PATRICIA T. CHRISTIE, P.E. P.E. NO.: 60049 FALLER, DAVIS & ASSOCIATES, INC. 4200 W. CYPRESS ST., SUITE 500 TAMPA, FLORIDA 33607-4168			STATE OF FLORIDA DEPARTMENT OF TRANSPORTATION			SIGN CROSS SECTION (11)	SHEET NO. S-69
DATE	DESCRIPTION	DATE	DESCRIPTION	ROAD NO.	COUNTY	FINANCIAL PROJECT ID					
				SR 93	COLLIER	444008-3-52-01					

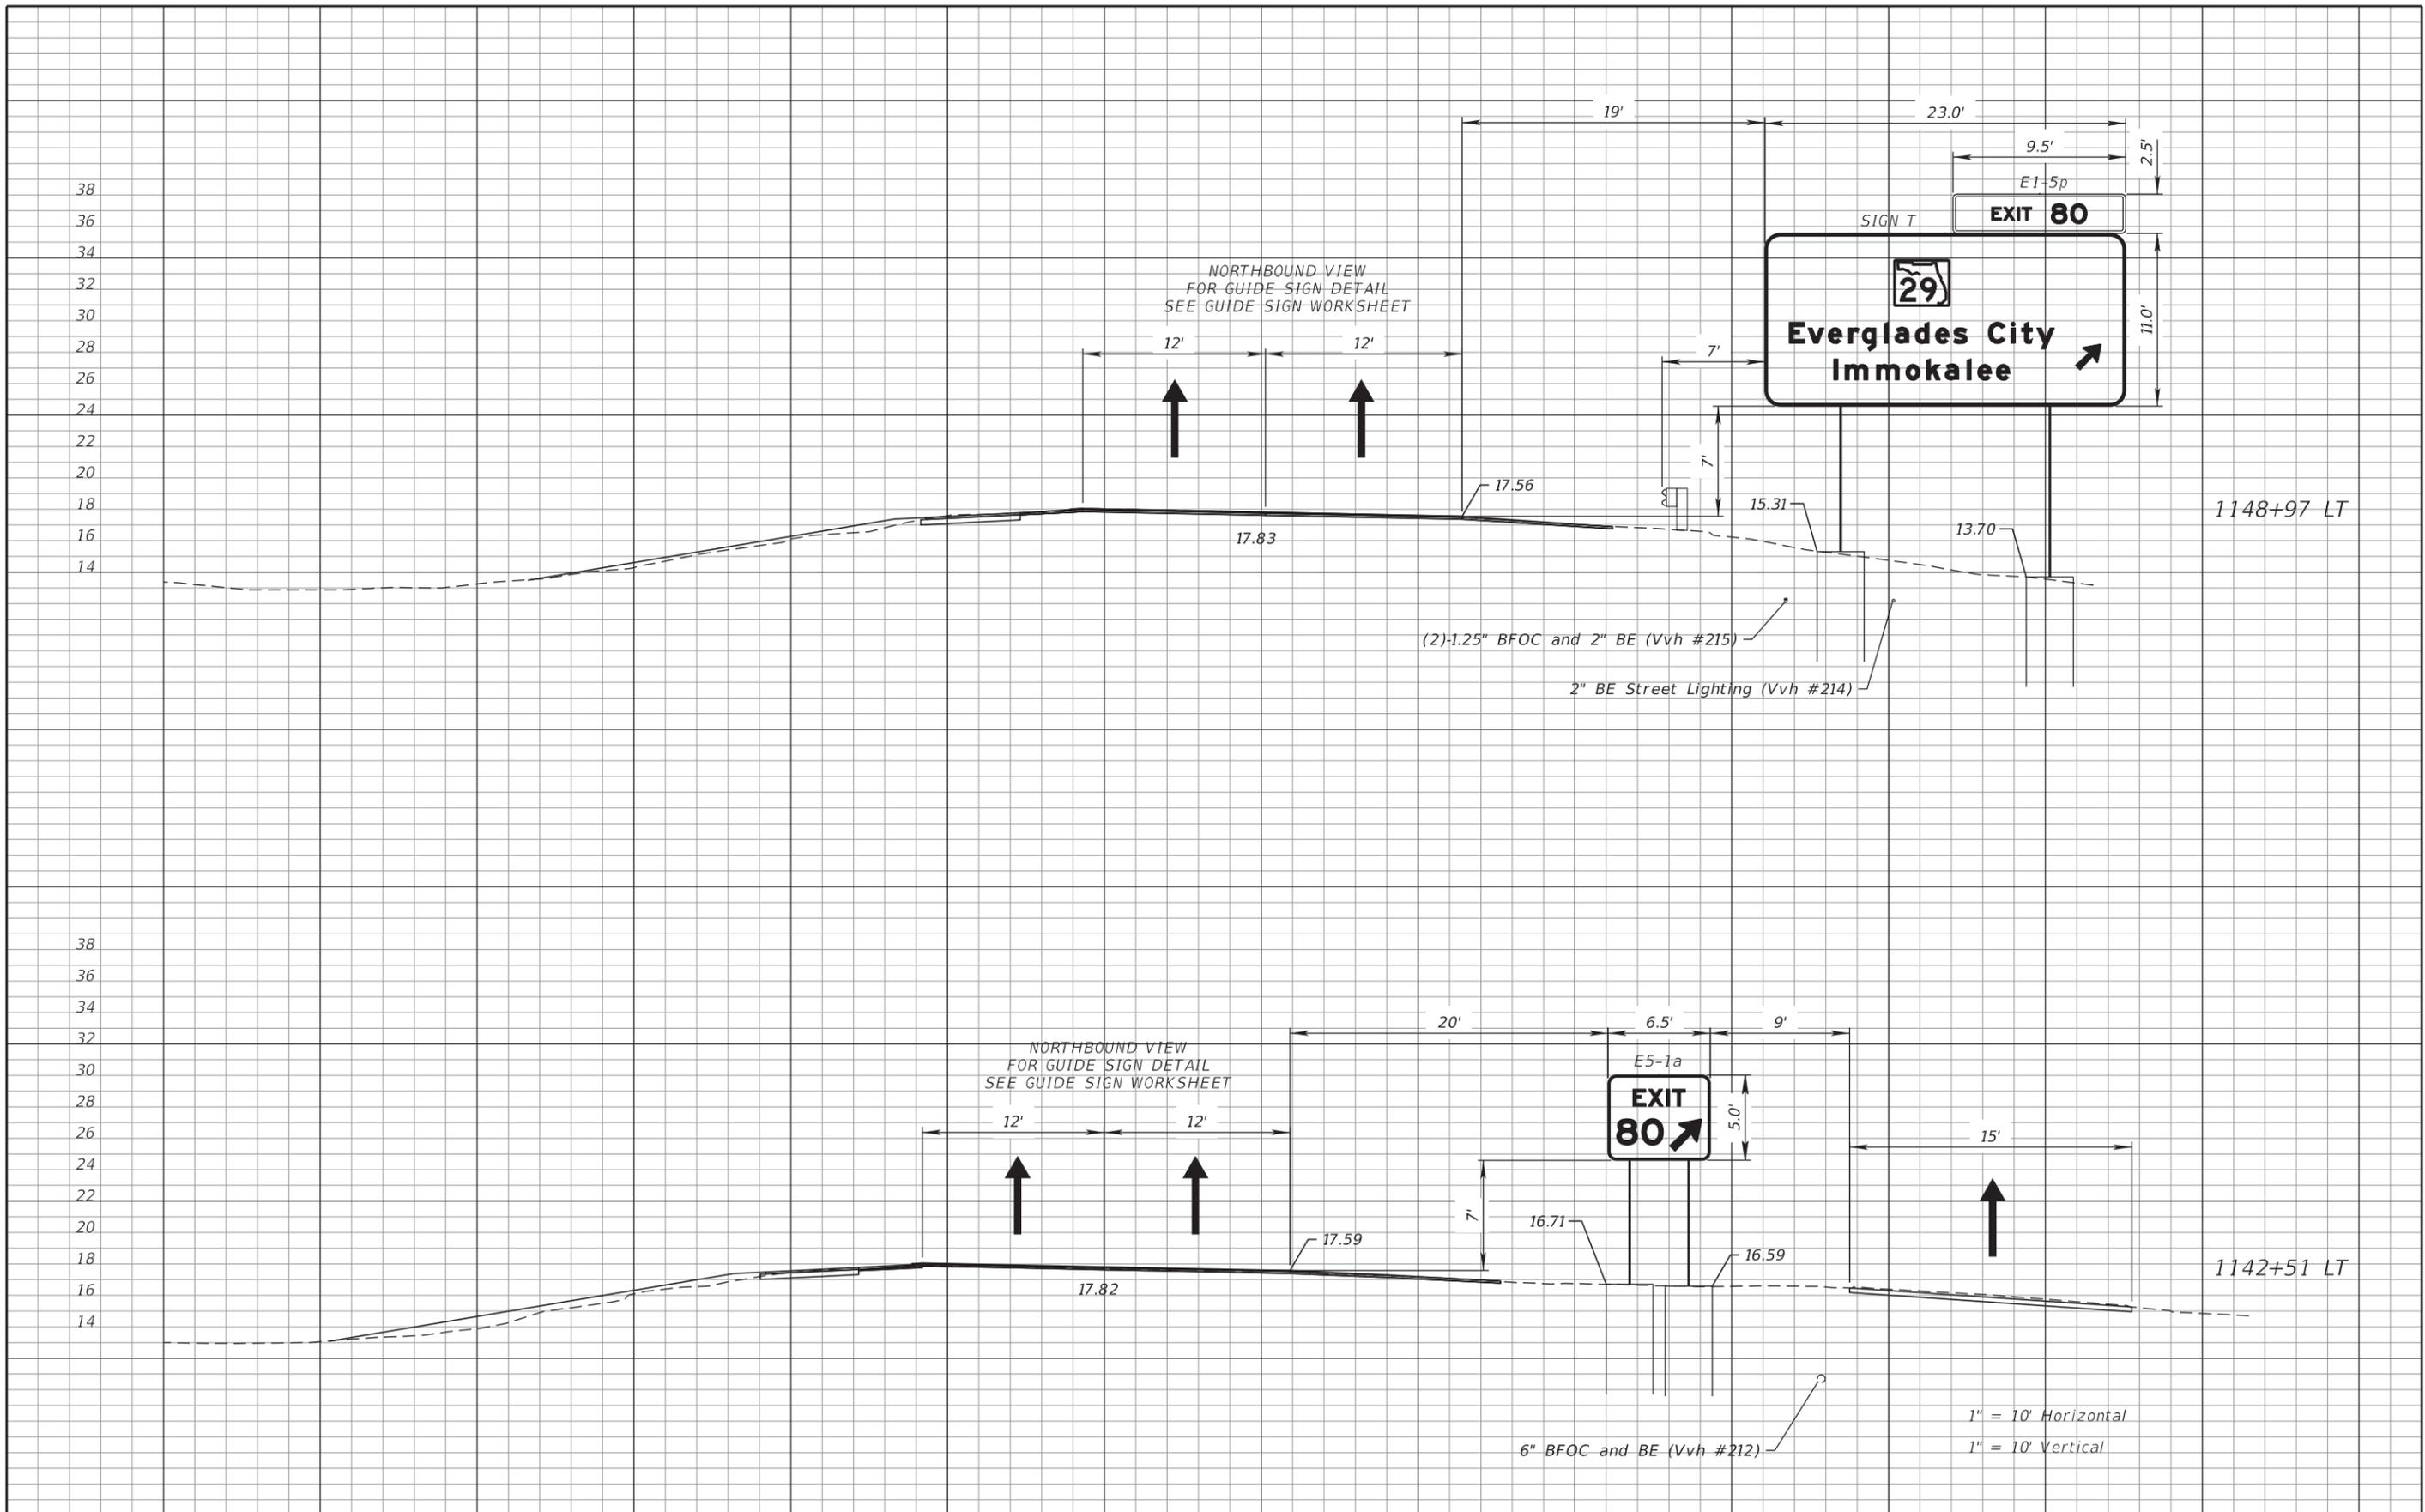


THE OFFICIAL RECORD OF THIS SHEET IS THE ELECTRONIC FILE DIGITALLY SIGNED AND SEALED UNDER RULE 61G15-23.004, F.A.C.

REVISIONS				PATRICIA T. CHRISTIE, P.E. P.E. NO.: 60049 FALLER, DAVIS & ASSOCIATES, INC. 4200 W. CYPRESS ST., SUITE 500 TAMPA, FLORIDA 33607-4168	STATE OF FLORIDA DEPARTMENT OF TRANSPORTATION			SIGN CROSS SECTION (12)	SHEET NO.
DATE	DESCRIPTION	DATE	DESCRIPTION		ROAD NO.	COUNTY	FINANCIAL PROJECT ID		S-70
					SR 93	COLLIER	444008-3-52-01		

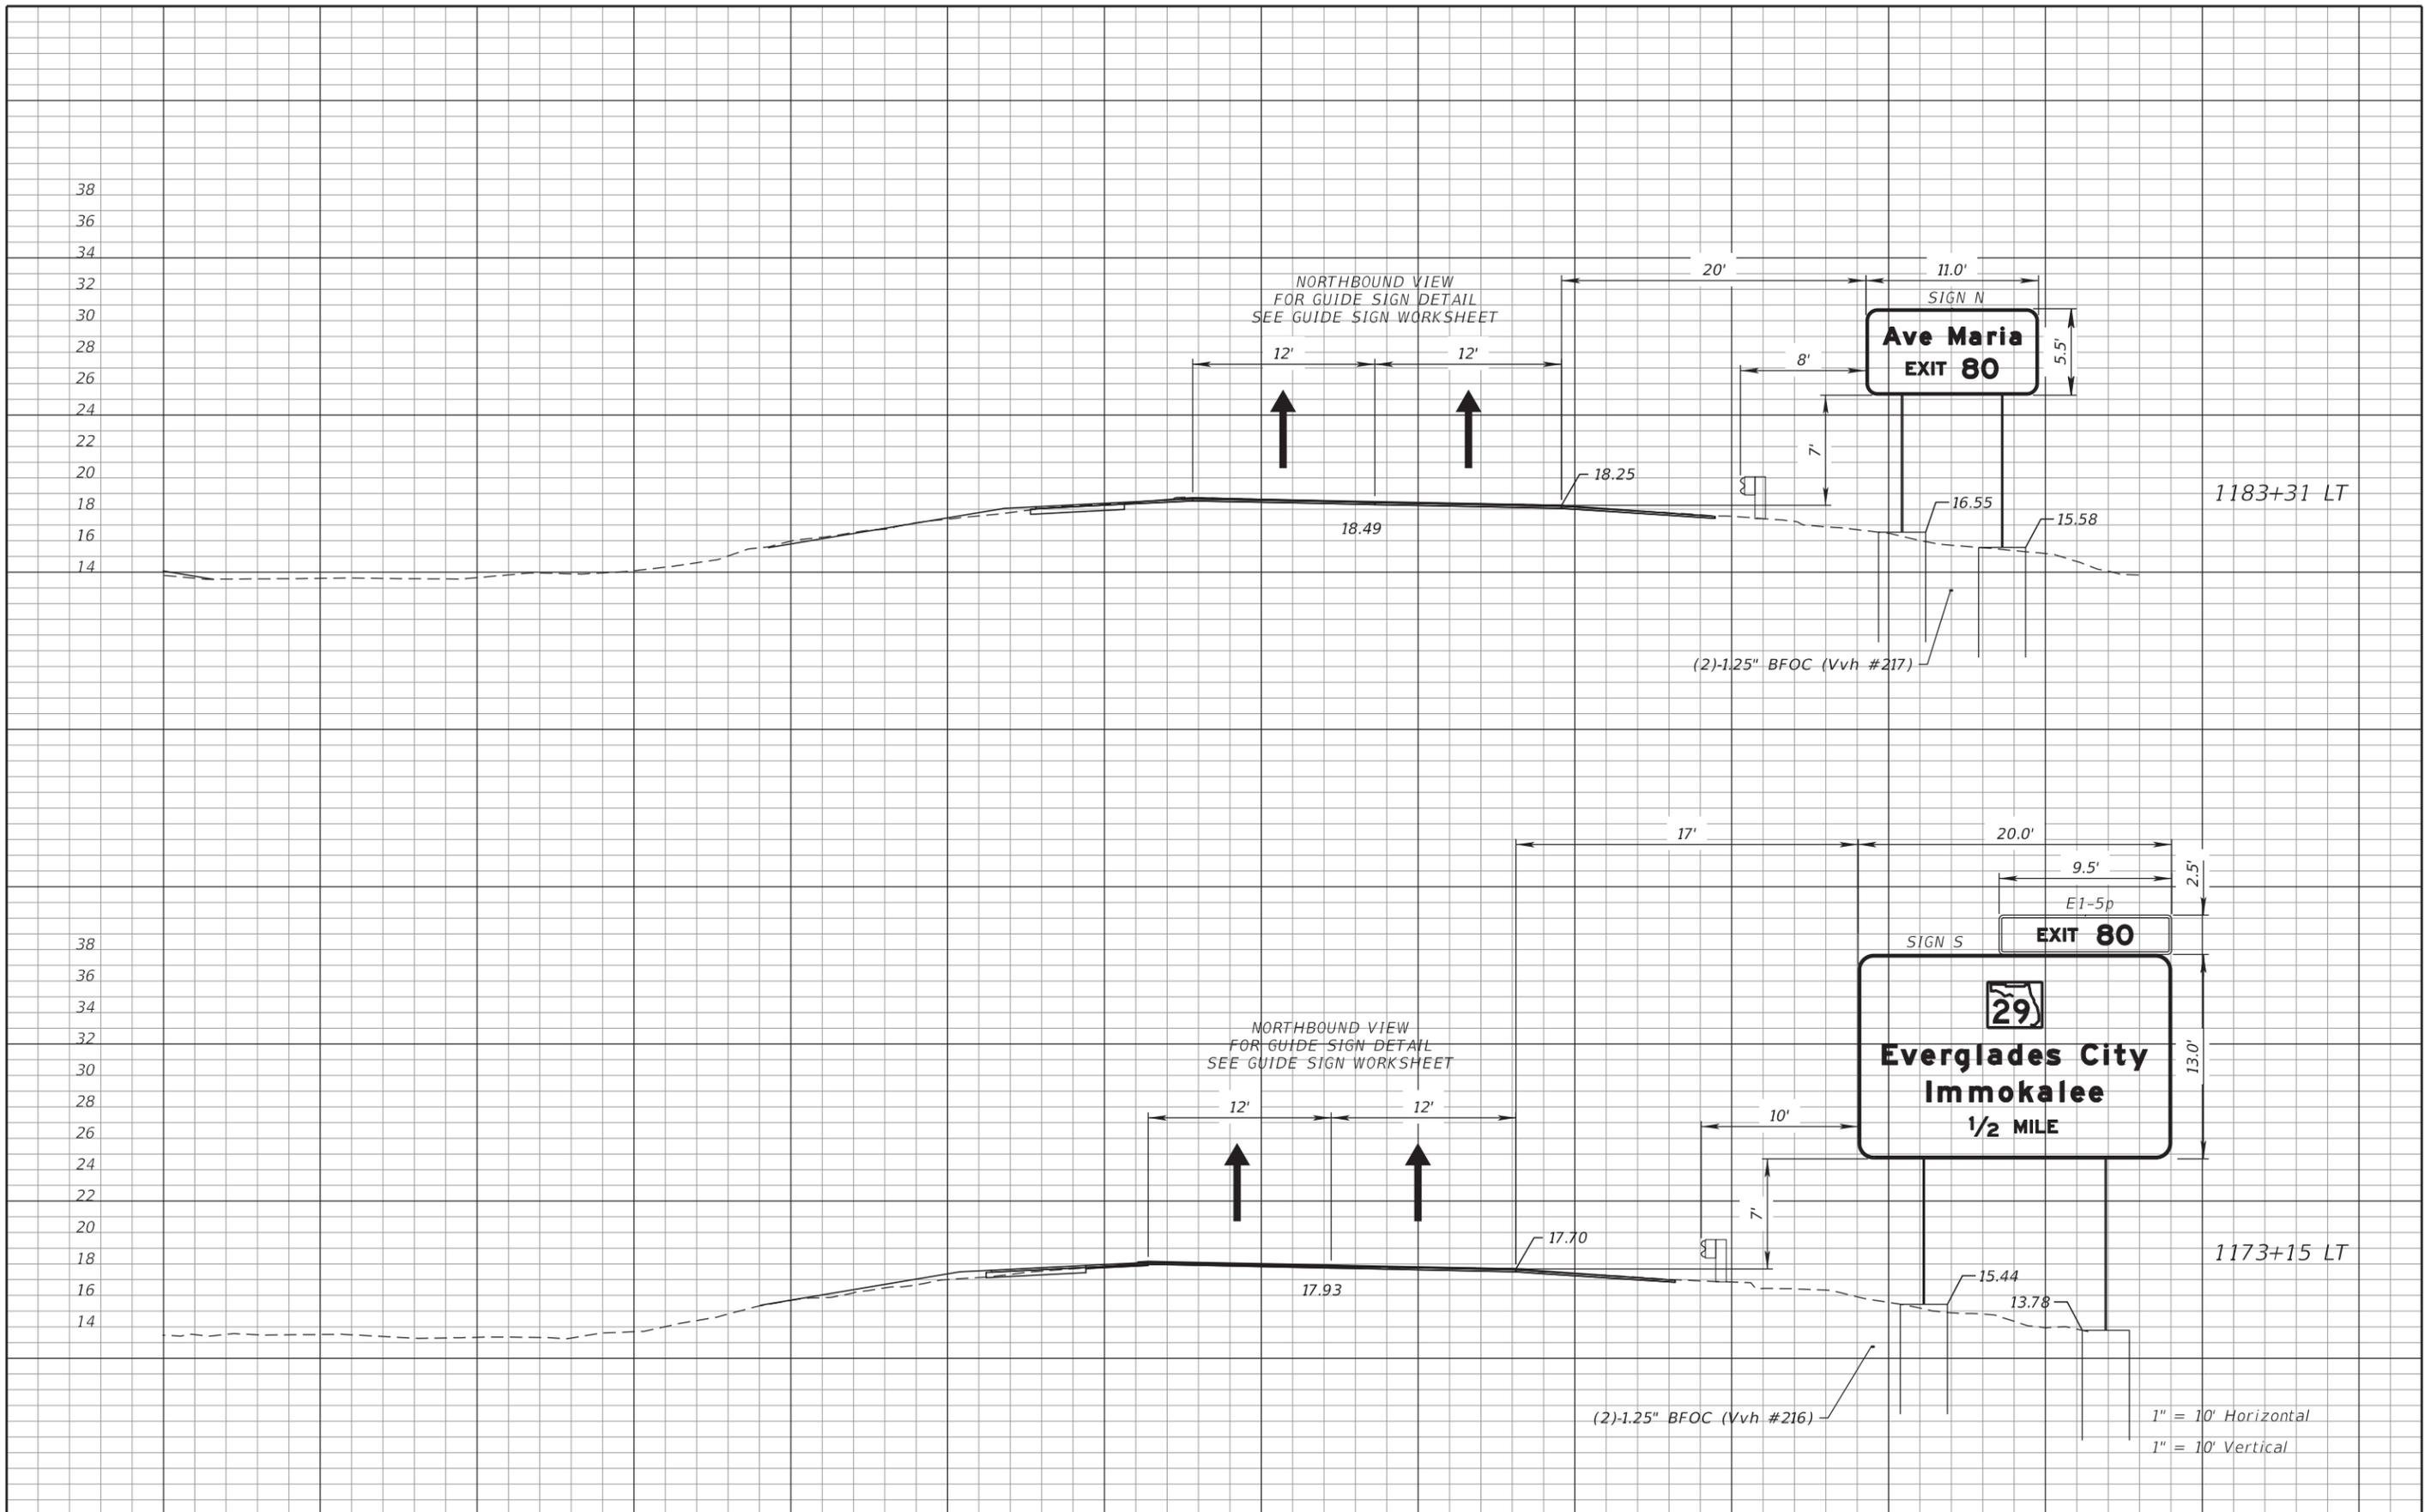


THE OFFICIAL RECORD OF THIS SHEET IS THE ELECTRONIC FILE DIGITALLY SIGNED AND SEALED UNDER RULE 61G15-23.004, F.A.C.

REVISIONS				PATRICIA T. CHRISTIE, P.E. P.E. NO.: 60049 FALLER, DAVIS & ASSOCIATES, INC. 4200 W. CYPRESS ST., SUITE 500 TAMPA, FLORIDA 33607-4168	STATE OF FLORIDA DEPARTMENT OF TRANSPORTATION			SIGN CROSS SECTION (13)	SHEET NO. S-71
DATE	DESCRIPTION	DATE	DESCRIPTION		ROAD NO.	COUNTY	FINANCIAL PROJECT ID		
					SR 93	COLLIER	444008-3-52-01		

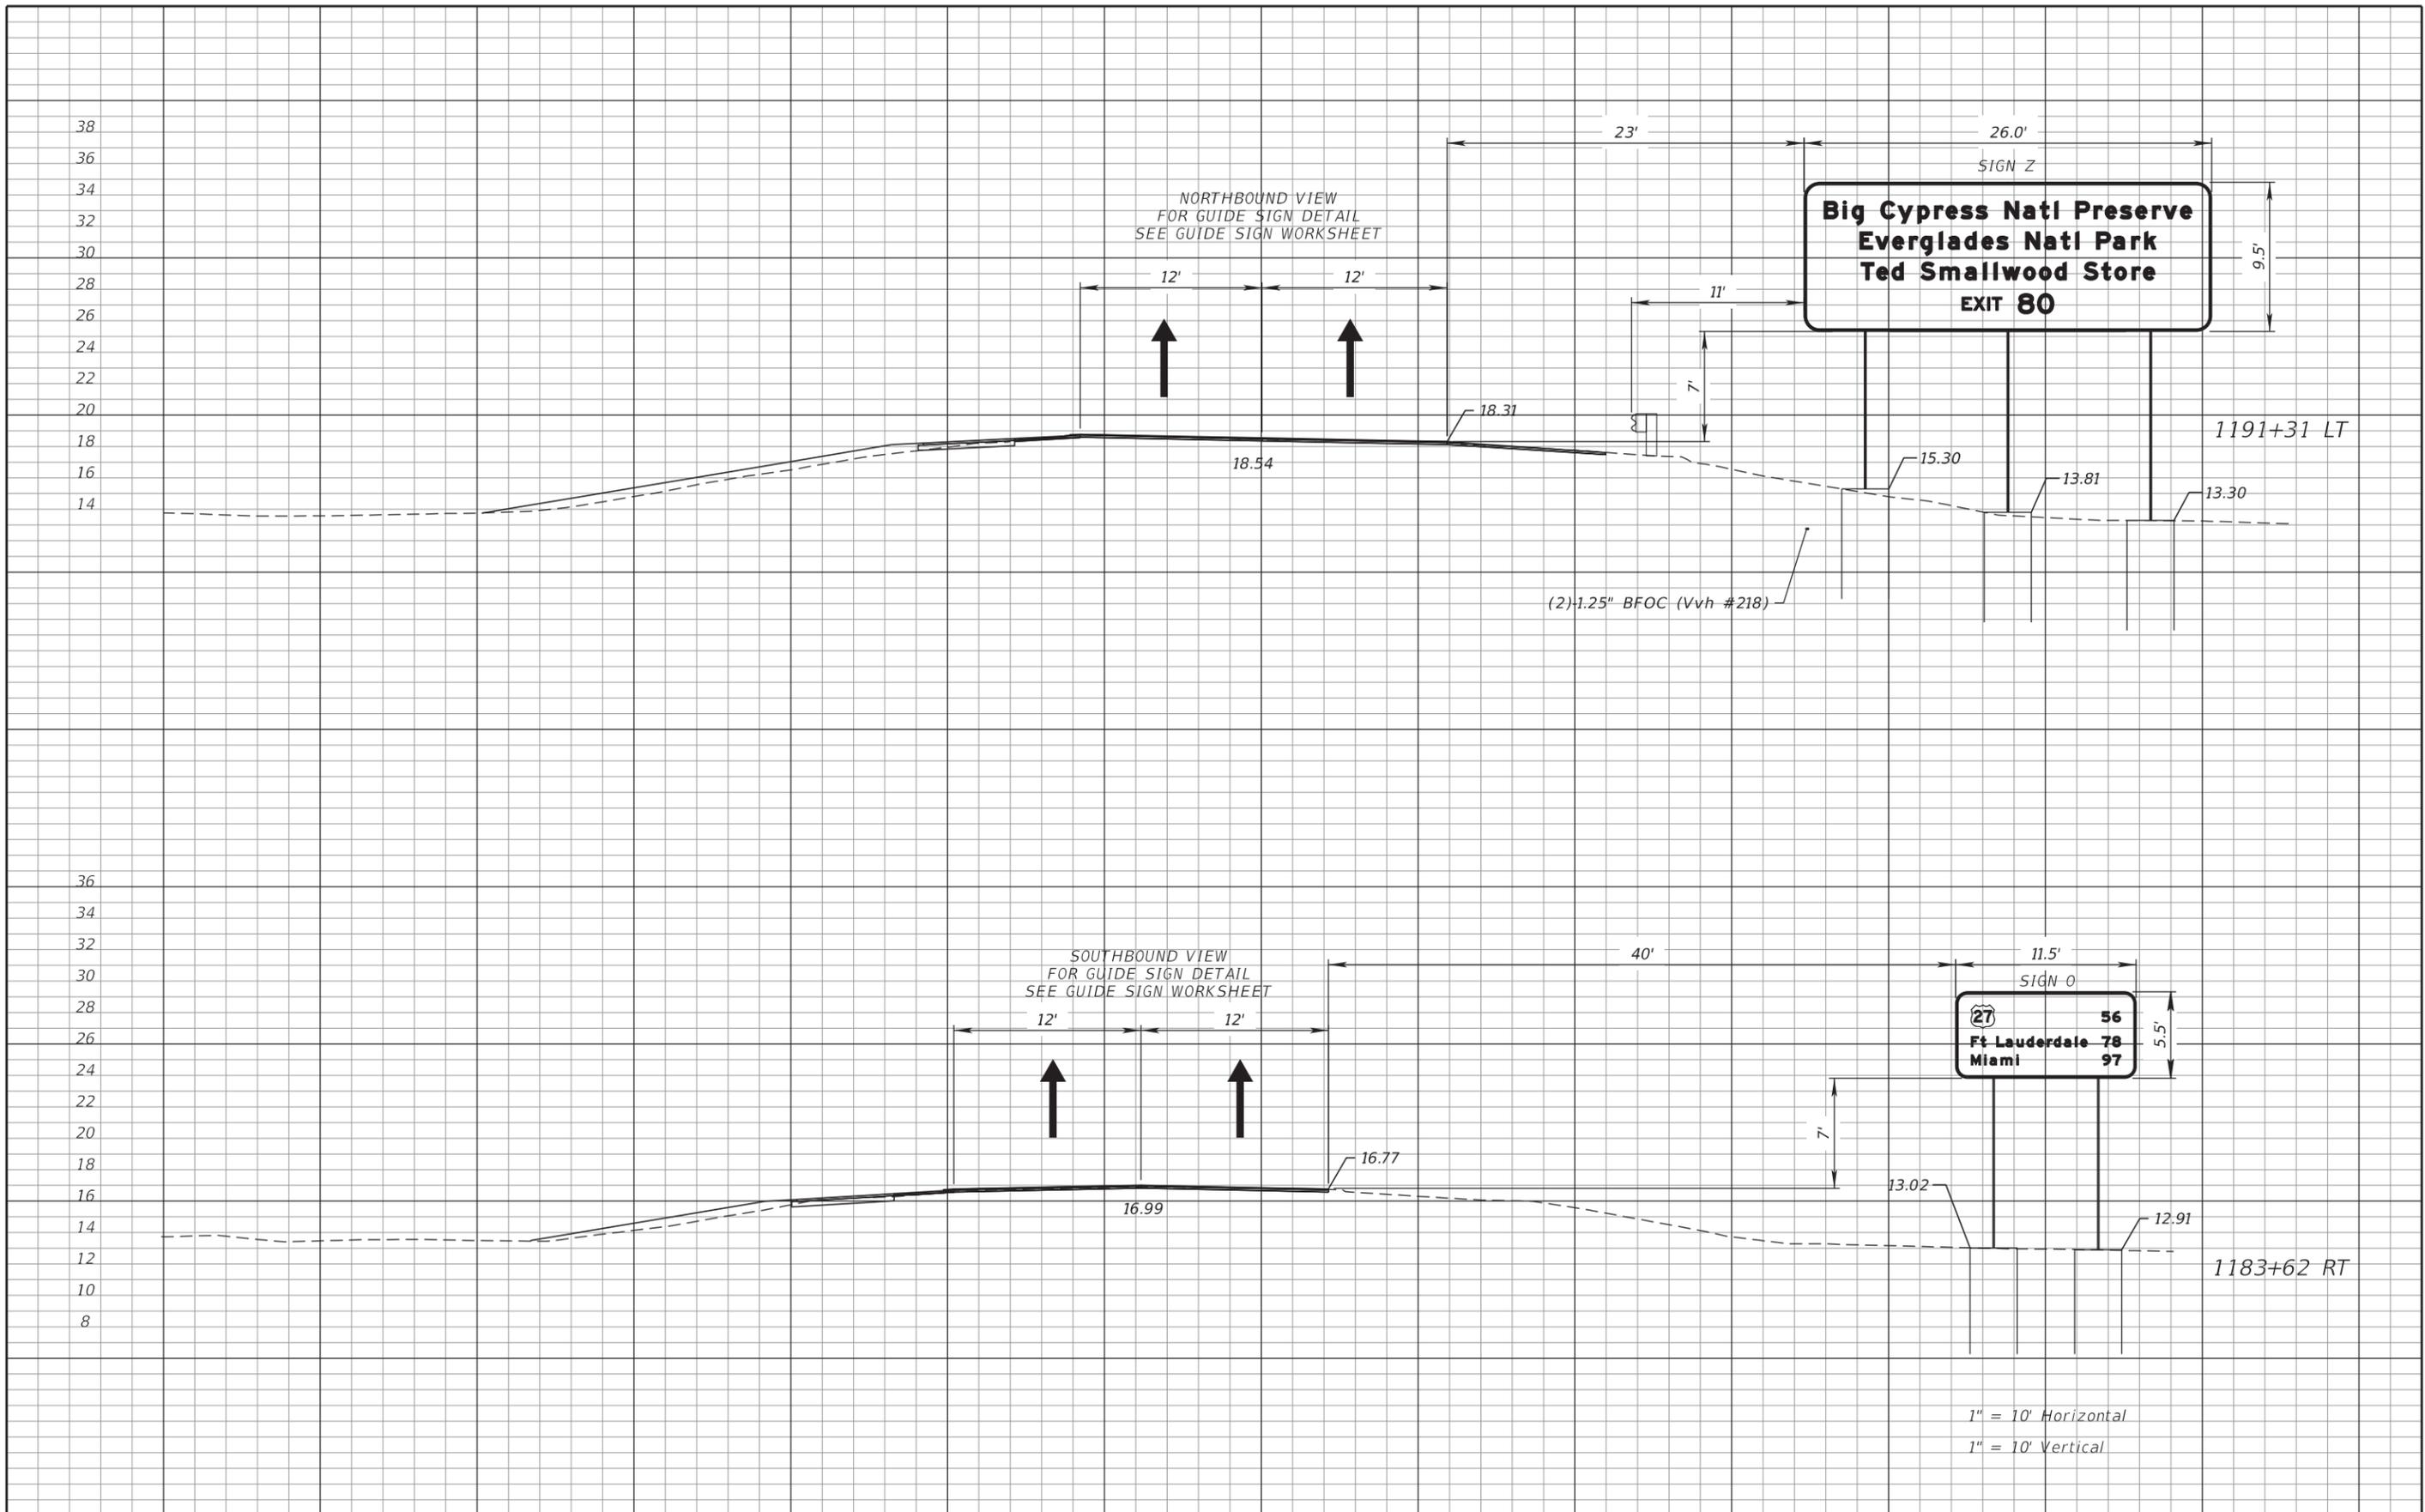

THE OFFICIAL RECORD OF THIS SHEET IS THE ELECTRONIC FILE DIGITALLY SIGNED AND SEALED UNDER RULE 61G15-23.004, F.A.C.

REVISIONS				PATRICIA T. CHRISTIE, P.E. P.E. NO.: 60049 FALLER, DAVIS & ASSOCIATES, INC. 4200 W. CYPRESS ST., SUITE 500 TAMPA, FLORIDA 33607-4168	STATE OF FLORIDA DEPARTMENT OF TRANSPORTATION			SIGN CROSS SECTION (14)	SHEET NO. S-72
DATE	DESCRIPTION	DATE	DESCRIPTION		ROAD NO.	COUNTY	FINANCIAL PROJECT ID		
					SR 93	COLLIER	444008-3-52-01		

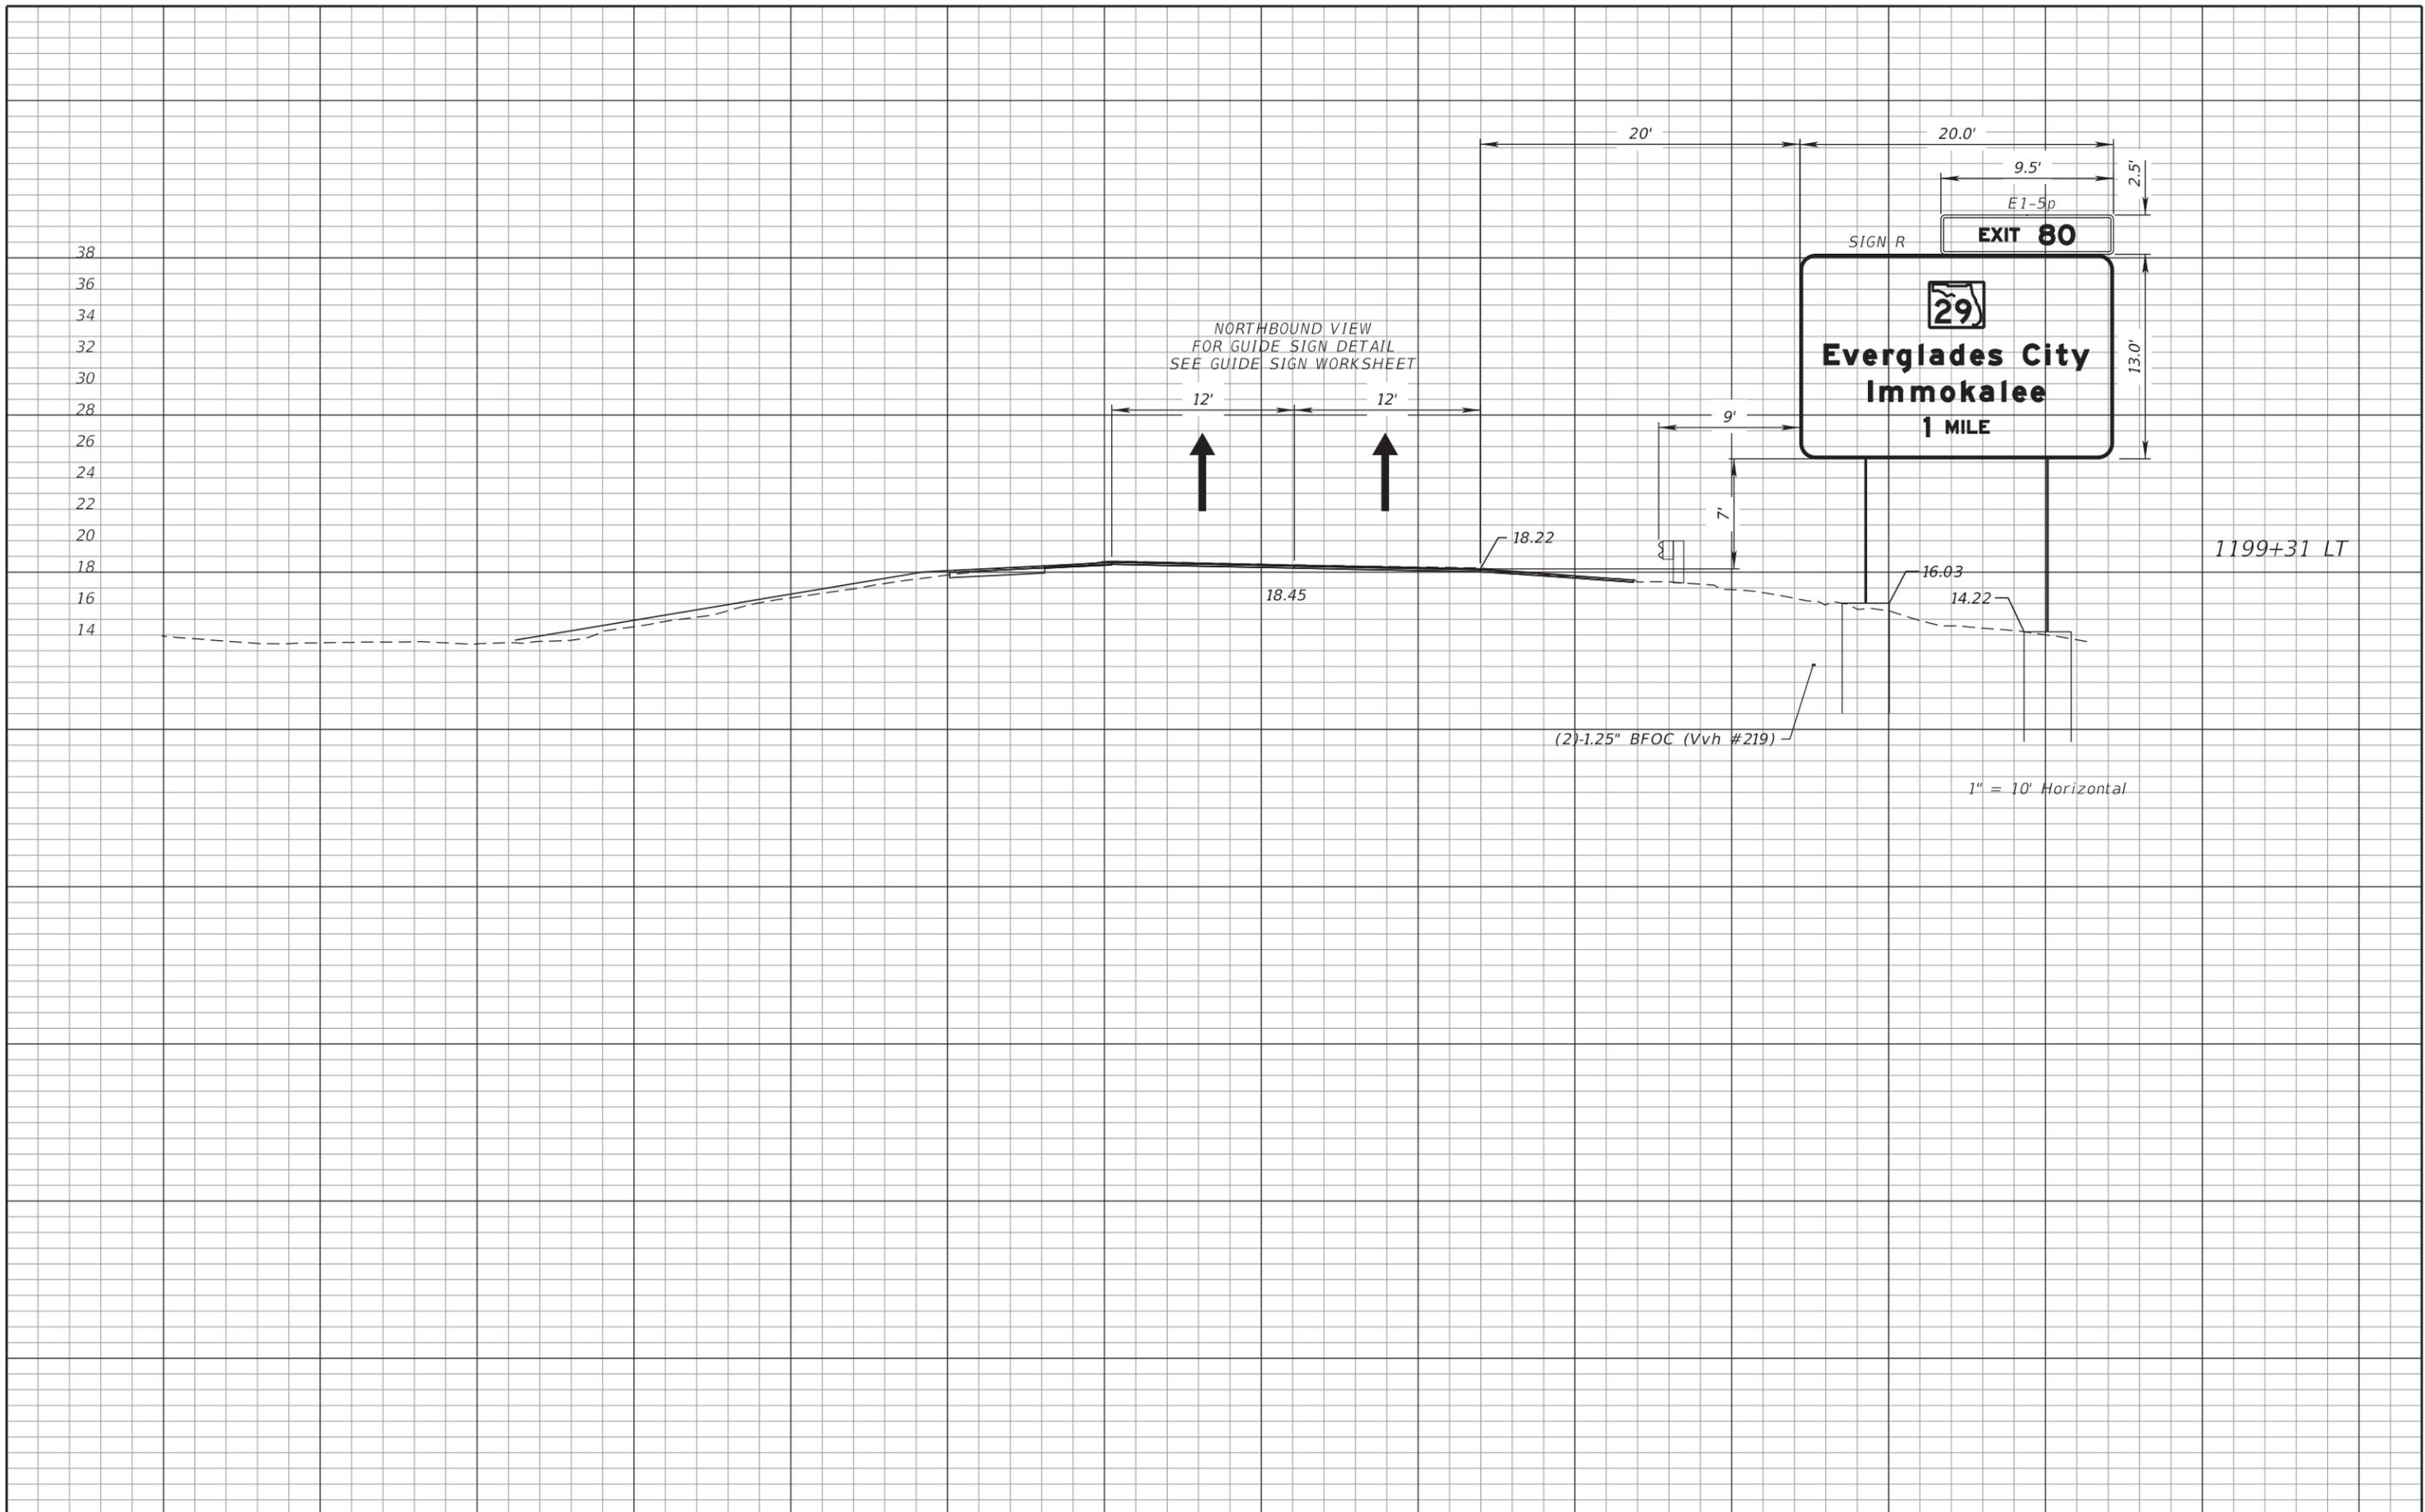


REVISIONS			
DATE	DESCRIPTION	DATE	DESCRIPTION

PATRICIA T. CHRISTIE, P.E.
P.E. NO.: 60049
FALLER, DAVIS & ASSOCIATES, INC.
4200 W. CYPRESS ST., SUITE 500
TAMPA, FLORIDA 33607-4168

STATE OF FLORIDA DEPARTMENT OF TRANSPORTATION		
ROAD NO.	COUNTY	FINANCIAL PROJECT ID
SR 93	COLLIER	444008-3-52-01

SIGN CROSS SECTION (15)

SHEET NO.
S-73

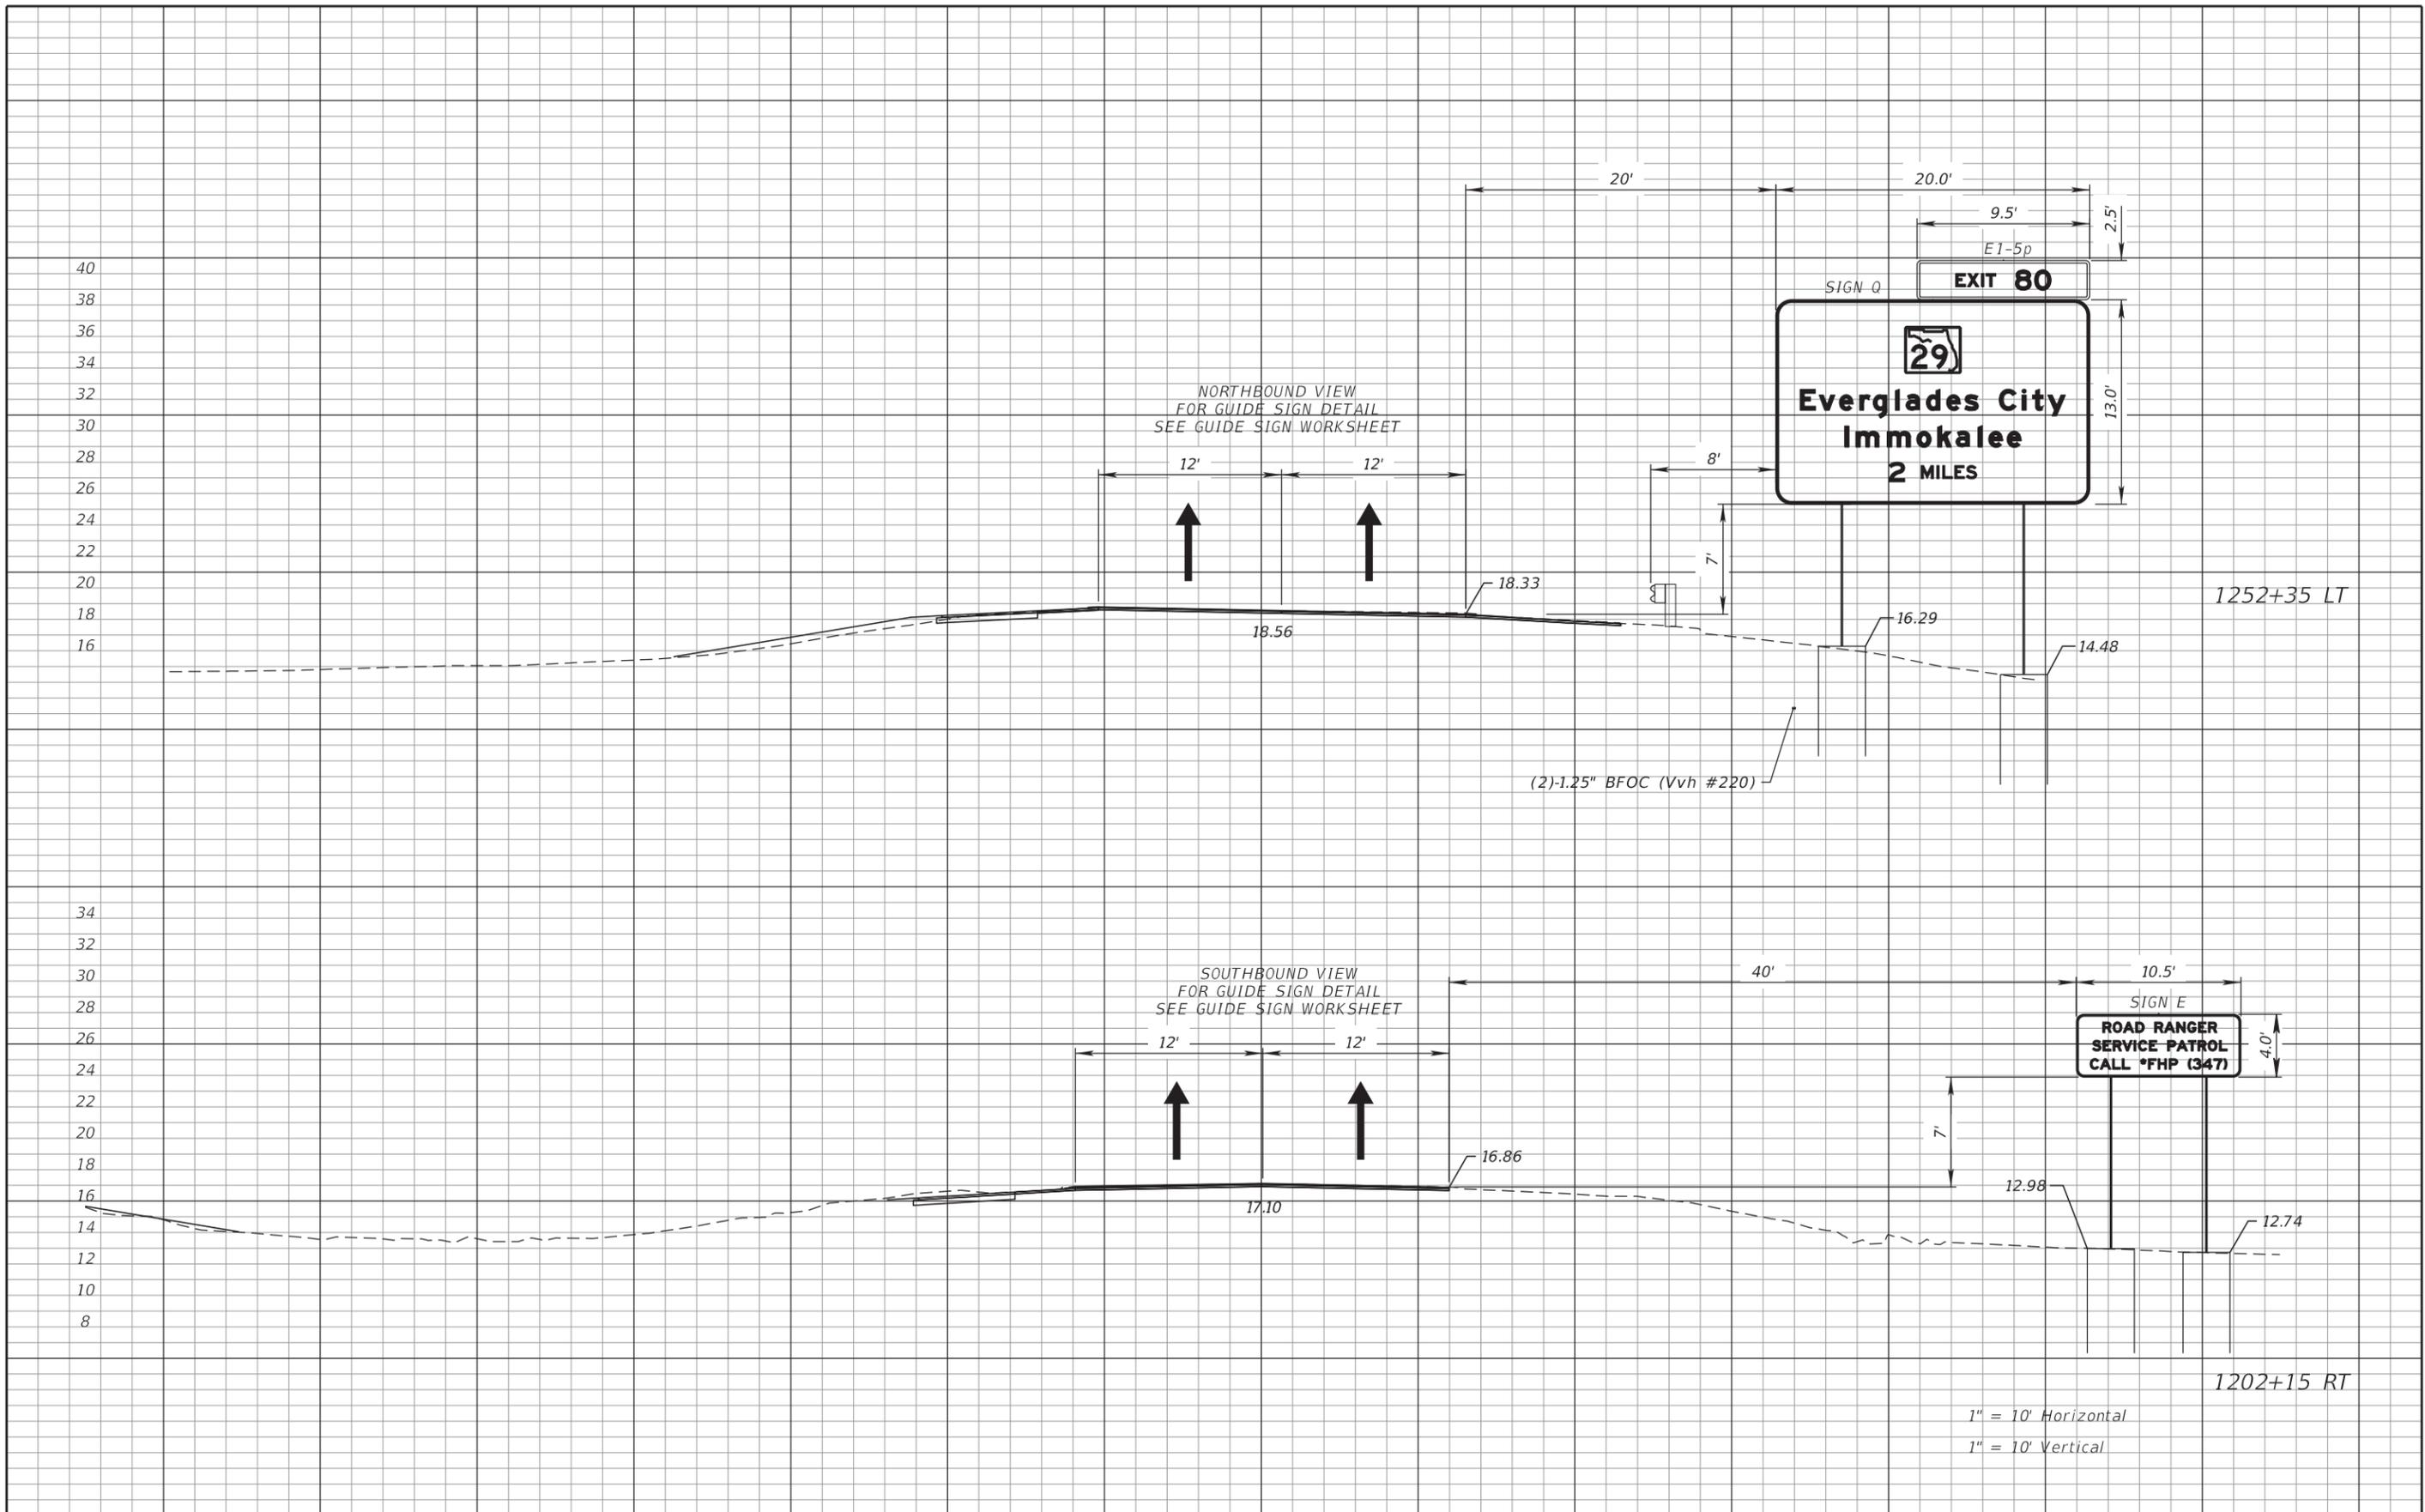

REVISIONS			
DATE	DESCRIPTION	DATE	DESCRIPTION


PATRICIA T. CHRISTIE, P.E.
P.E. NO.: 60049
FALLER, DAVIS & ASSOCIATES, INC.
4200 W. CYPRESS ST., SUITE 500
TAMPA, FLORIDA 33607-4168

STATE OF FLORIDA DEPARTMENT OF TRANSPORTATION		
ROAD NO.	COUNTY	FINANCIAL PROJECT ID
SR 93	COLLIER	444008-3-52-01

SIGN CROSS SECTION (16)

SHEET NO.
S-74

THE OFFICIAL RECORD OF THIS SHEET IS THE ELECTRONIC FILE DIGITALLY SIGNED AND SEALED UNDER RULE 61G15-23.004, F.A.C.

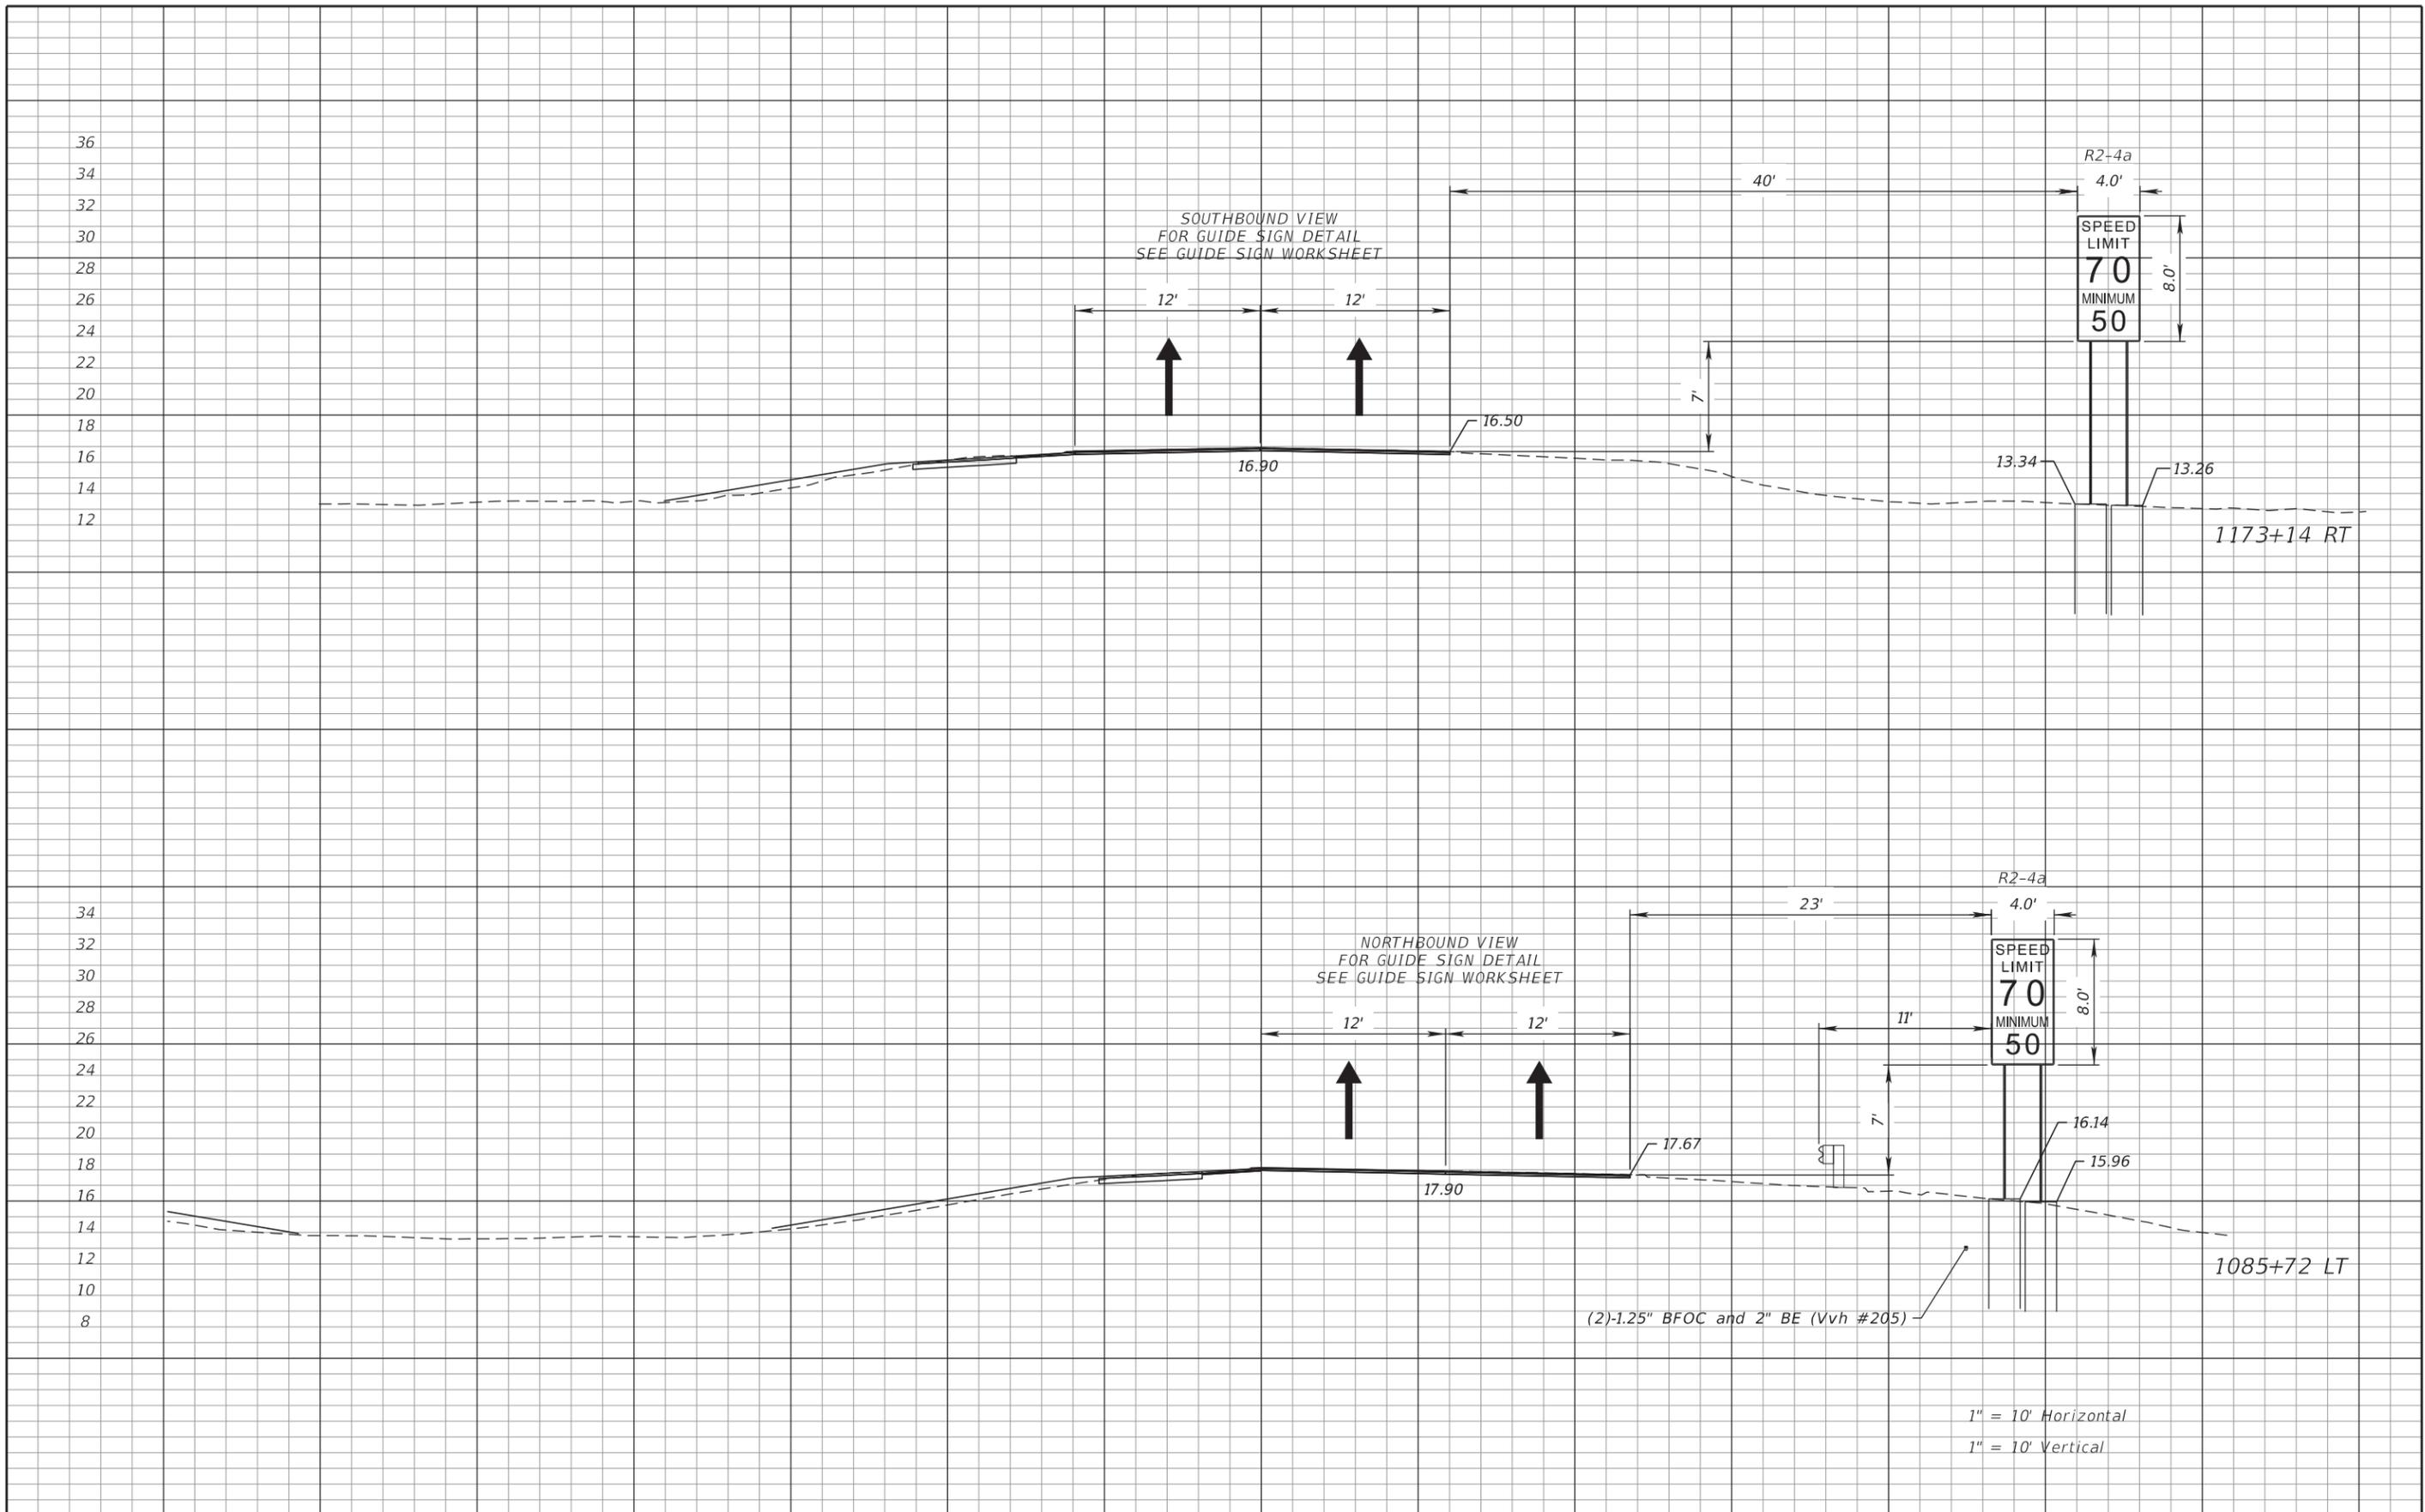

THE OFFICIAL RECORD OF THIS SHEET IS THE ELECTRONIC FILE DIGITALLY SIGNED AND SEALED UNDER RULE 61G15-23.004, F.A.C.

REVISIONS				PATRICIA T. CHRISTIE, P.E. P.E. NO.: 60049 FALLER, DAVIS & ASSOCIATES, INC. 4200 W. CYPRESS ST., SUITE 500 TAMPA, FLORIDA 33607-4168	STATE OF FLORIDA DEPARTMENT OF TRANSPORTATION			SIGN CROSS SECTION (17)	SHEET NO. S-75
DATE	DESCRIPTION	DATE	DESCRIPTION		ROAD NO.	COUNTY	FINANCIAL PROJECT ID		
					SR 93	COLLIER	444008-3-52-01		