

STATE OF FLORIDA
DEPARTMENT OF TRANSPORTATION

Final As-Built Plans
~~CONTRACT PLANS~~



FINANCIAL PROJECT ID 446320-1-52-01
(FEDERAL FUNDS)
COLLIER COUNTY (03175)
STATE ROAD NO. 93 (1-75)

INDEX OF SIGNING AND
PAVEMENT MARKING PLANS

SHEET NO.	SHEET DESCRIPTION
S-1	KEY SHEET S-1A Final As-Built Signature Sheet
S-2	SIGNATURE SHEET
S-3	GENERAL NOTES
S-4 - S-11	SIGNING AND PAVEMENT MARKING PLAN
S-12 - S-15	GUIDE SIGN WORKSHEET
S-16 - S-22	SIGN CROSS SECTION

SIGNING AND PAVEMENT MARKING PLANS

Shop Drawings:
Signs - EDMS 1404743

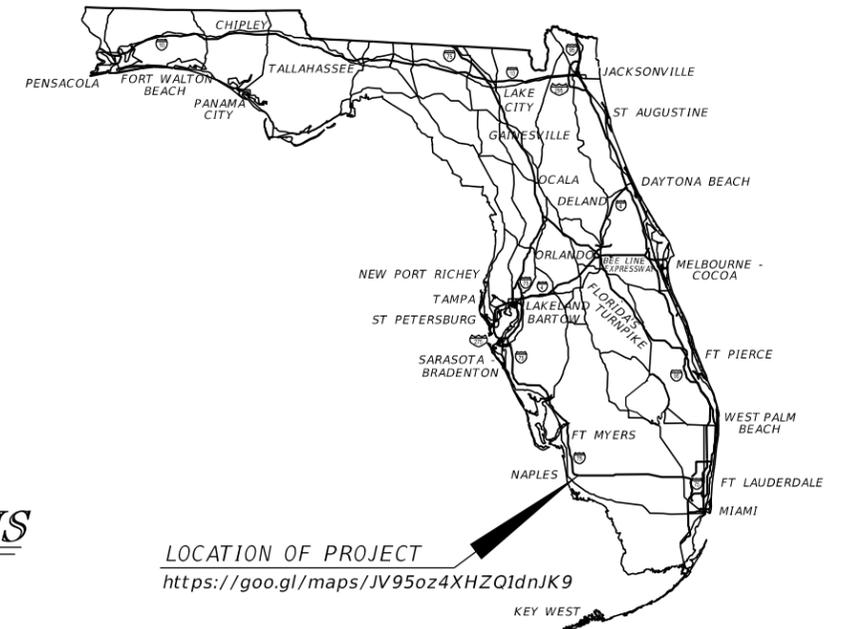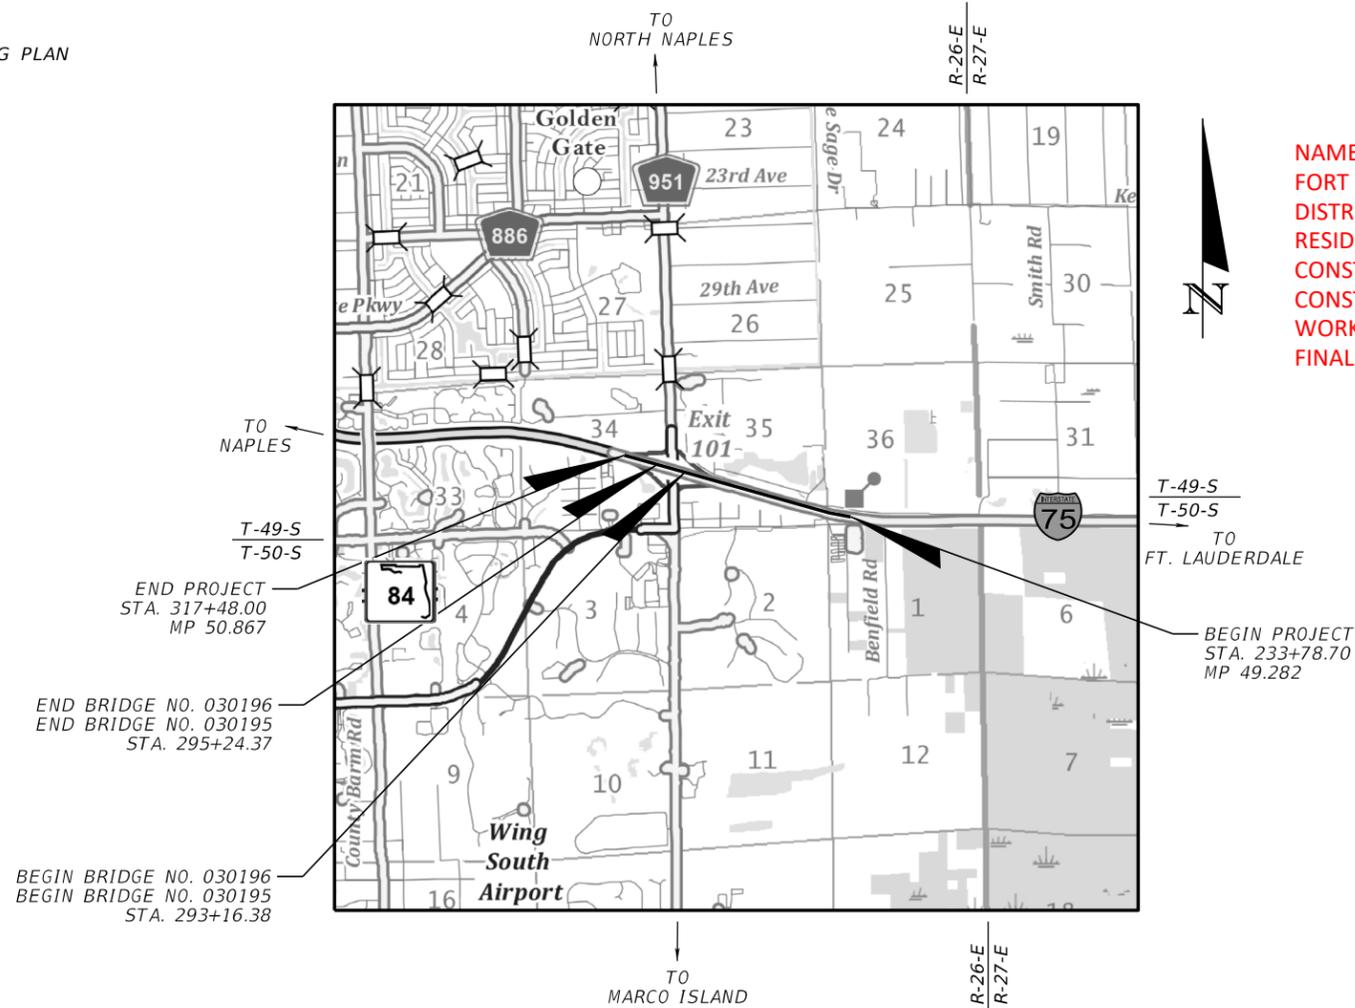

NAME OF PRIME CONTRACTOR: AJAX PAVING INDUSTRIES OF FLORIDA, LLC
FORT MYERS OPERATIONS IN-HOUSE PROJECT
DISTRICT SECRETARY: L.K. NANDAM, P.E.
RESIDENT ENGINEER: JESSICA A. WHITE, P.E.
CONSTRUCTION MANAGER: CHRIS MOLLITOR
CONSTRUCTION PROJECT MANAGER: LUELLA PIERCE
WORK STARTED: 09-24-2022
FINAL ACCEPTED: 06-22-2023

SIGNING AND
PAVEMENT MARKING PLANS
ENGINEER OF RECORD:

BHARATHI CHIGURUPATI, P.E.
P.E. LICENSE NUMBER 84860
DRMP, INC.
941 LAKE BALDWIN LANE
ORLANDO, FLORIDA 32814
(813) 321-5787
CONTRACT NO.: CAB04
VENDOR NO.: F591791174001

FDOT PROJECT MANAGER:

CHRIS SPEESE

CONSTRUCTION CONTRACT NO.	FISCAL YEAR	SHEET NO.
T1834	22	S-1


STATE OF FLORIDA, PROFESSIONAL ENGINEER, LICENSE NO.

THIS ITEM HAS BEEN DIGITALLY SIGNED AND SEALED BY
ON THE DATE INDICATED HERE

PRINTED COPIES OF THIS DOCUMENT ARE NOT CONSIDERED SIGNED AND
SEALED AND THE SIGNATURE MUST BE VERIFIED ON ANY ELECTRONIC
COPIES.

Date	Name	Position (Title)	Review Type, If Applicable
RESIDENT OFFICE			
DISTRICT OFFICE			

REVISIONS				STATE OF FLORIDA DEPARTMENT OF TRANSPORTATION	FINAL "AS-BUILT" SIGNATURE SHEET	SHEET NO.
DATE	DESCRIPTION	DATE	DESCRIPTION			

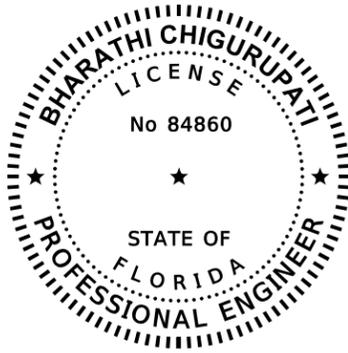

THIS ITEM HAS BEEN DIGITALLY
SIGNED AND SEALED BY

ON THE DATE ADJACENT TO THE SEAL

PRINTED COPIES OF THIS DOCUMENT ARE
NOT CONSIDERED SIGNED AND SEALED
AND THE SIGNATURE MUST BE VERIFIED
ON ANY ELECTRONIC COPIES.

DRMP, INC.
941 LAKE BALDWIN LANE
ORLANDO, FL 32814

BHARATHI CHIGURUPATI, P.E. NO. 84860

THE ABOVE NAMED PROFESSIONAL ENGINEER SHALL BE RESPONSIBLE FOR THE
FOLLOWING SHEETS IN ACCORDANCE WITH RULE 61G15-23.004, F.A.C.

SHEET NO.	SHEET DESCRIPTION
S-1	KEY SHEET
S-2	SIGNATURE SHEET
S-3	GENERAL NOTES
S-4 - S-11	SIGNING AND PAVEMENT MARKING PLAN
S-12 - S-15	GUIDE SIGN WORKSHEET
S-16 - S-22	SIGN CROSS SECTION

2/14/2022 12:22:15 PM MHammosh C:\USERS\BCHIGURUPATI\ONEEDRIVE - DRMP, INC\WORKSETS\FDOT20\44632015201\SIGNINGANDMARKING\SIGNSP01.DGN

REVISIONS				BHARATHI CHIGURUPATI, P.E. P.E. LICENSE NUMBER 84860 DRMP, INC. 941 LAKE BALDWIN LANE ORLANDO, FLORIDA 32814	STATE OF FLORIDA DEPARTMENT OF TRANSPORTATION			<i>SIGNATURE SHEET</i>	SHEET NO.
DATE	DESCRIPTION	DATE	DESCRIPTION		ROAD NO.	COUNTY	FINANCIAL PROJECT ID		S-2
					SR 93	COLLIER	446320-1-52-01		

SIGNING AND PAVEMENT MARKING NOTES


1. THE SIGN LOCATIONS SHOWN ARE APPROXIMATE AND MAY REQUIRE FIELD ADJUSTMENT AS DIRECTED BY THE ENGINEER.
2. ANY EXISTING SIGNS WITHIN THE PROJECT LIMITS SHALL REMAIN UNLESS OTHERWISE NOTED IN THE PLANS.
3. EXPOSE EXISTING UTILITIES WITHIN THE FIRST 4 FEET PRIOR TO USING MECHANIZED EQUIPMENT FOR SIGN FOUNDATIONS.
4. PATCH ATTACHMENT HARDWARE, SUCH AS COUNTERSUNK SCREWS OR RIVET HEADS, WITH RETROREFLECTIVE BUTTONS THAT MATCH THE COLOR AND SHEETING MATERIAL OF THE FINISHED SIGN PANEL INCLUDING THE BACKGROUND, LEGEND OR BORDER.
5. DOWNLOAD THE SUNPASS LOGO IN MICROSTATION FORMAT FOR USE IN SIGN FABRICATION FROM THE FLORIDA'S TURNPIKE TRAFFIC DESIGN WEBSITE: [HTTP://DESIGN.FLORIDASTURNPIKE.COM/](http://design.floridasturnpike.com/) OR OBTAIN THE LOGO BY CONTACTING THE TURNPIKE TRAFFIC DESIGN ENGINEER AT (407) 264-3418. THE LOGO SHALL NOT BE FABRICATED BY HAND CUT-OUT METHOD.
6. PAVEMENT MARKINGS MAY BE ADJUSTED SLIGHTLY AS DIRECTED BY THE ENGINEER.

2/14/2022 12:22:48 PM MHammosh P:\WORKSETS\FDOT20\44632015201\SIGNING\MARKING\GNWNTSP01.DGN

REVISIONS				BHARATHI CHIGURUPATI, P.E. P.E. LICENSE NUMBER 84860 DRMP, INC. 941 LAKE BALDWIN LANE ORLANDO, FLORIDA 32814	STATE OF FLORIDA DEPARTMENT OF TRANSPORTATION			<i>GENERAL NOTES</i>	SHEET NO.
DATE	DESCRIPTION	DATE	DESCRIPTION		ROAD NO.	COUNTY	FINANCIAL PROJECT ID		S-3
					SR 93	COLLIER	446320-1-52-01		

THE OFFICIAL RECORD OF THIS SHEET IS THE ELECTRONIC FILE DIGITALLY SIGNED AND SEALED UNDER RULE 61G15-23.004, F.A.C.

2/14/2022 12:24:25 PM MHammosh
 P:\Worksets\FDOT\2044632015201\Roadway\PLANRD01.dgn

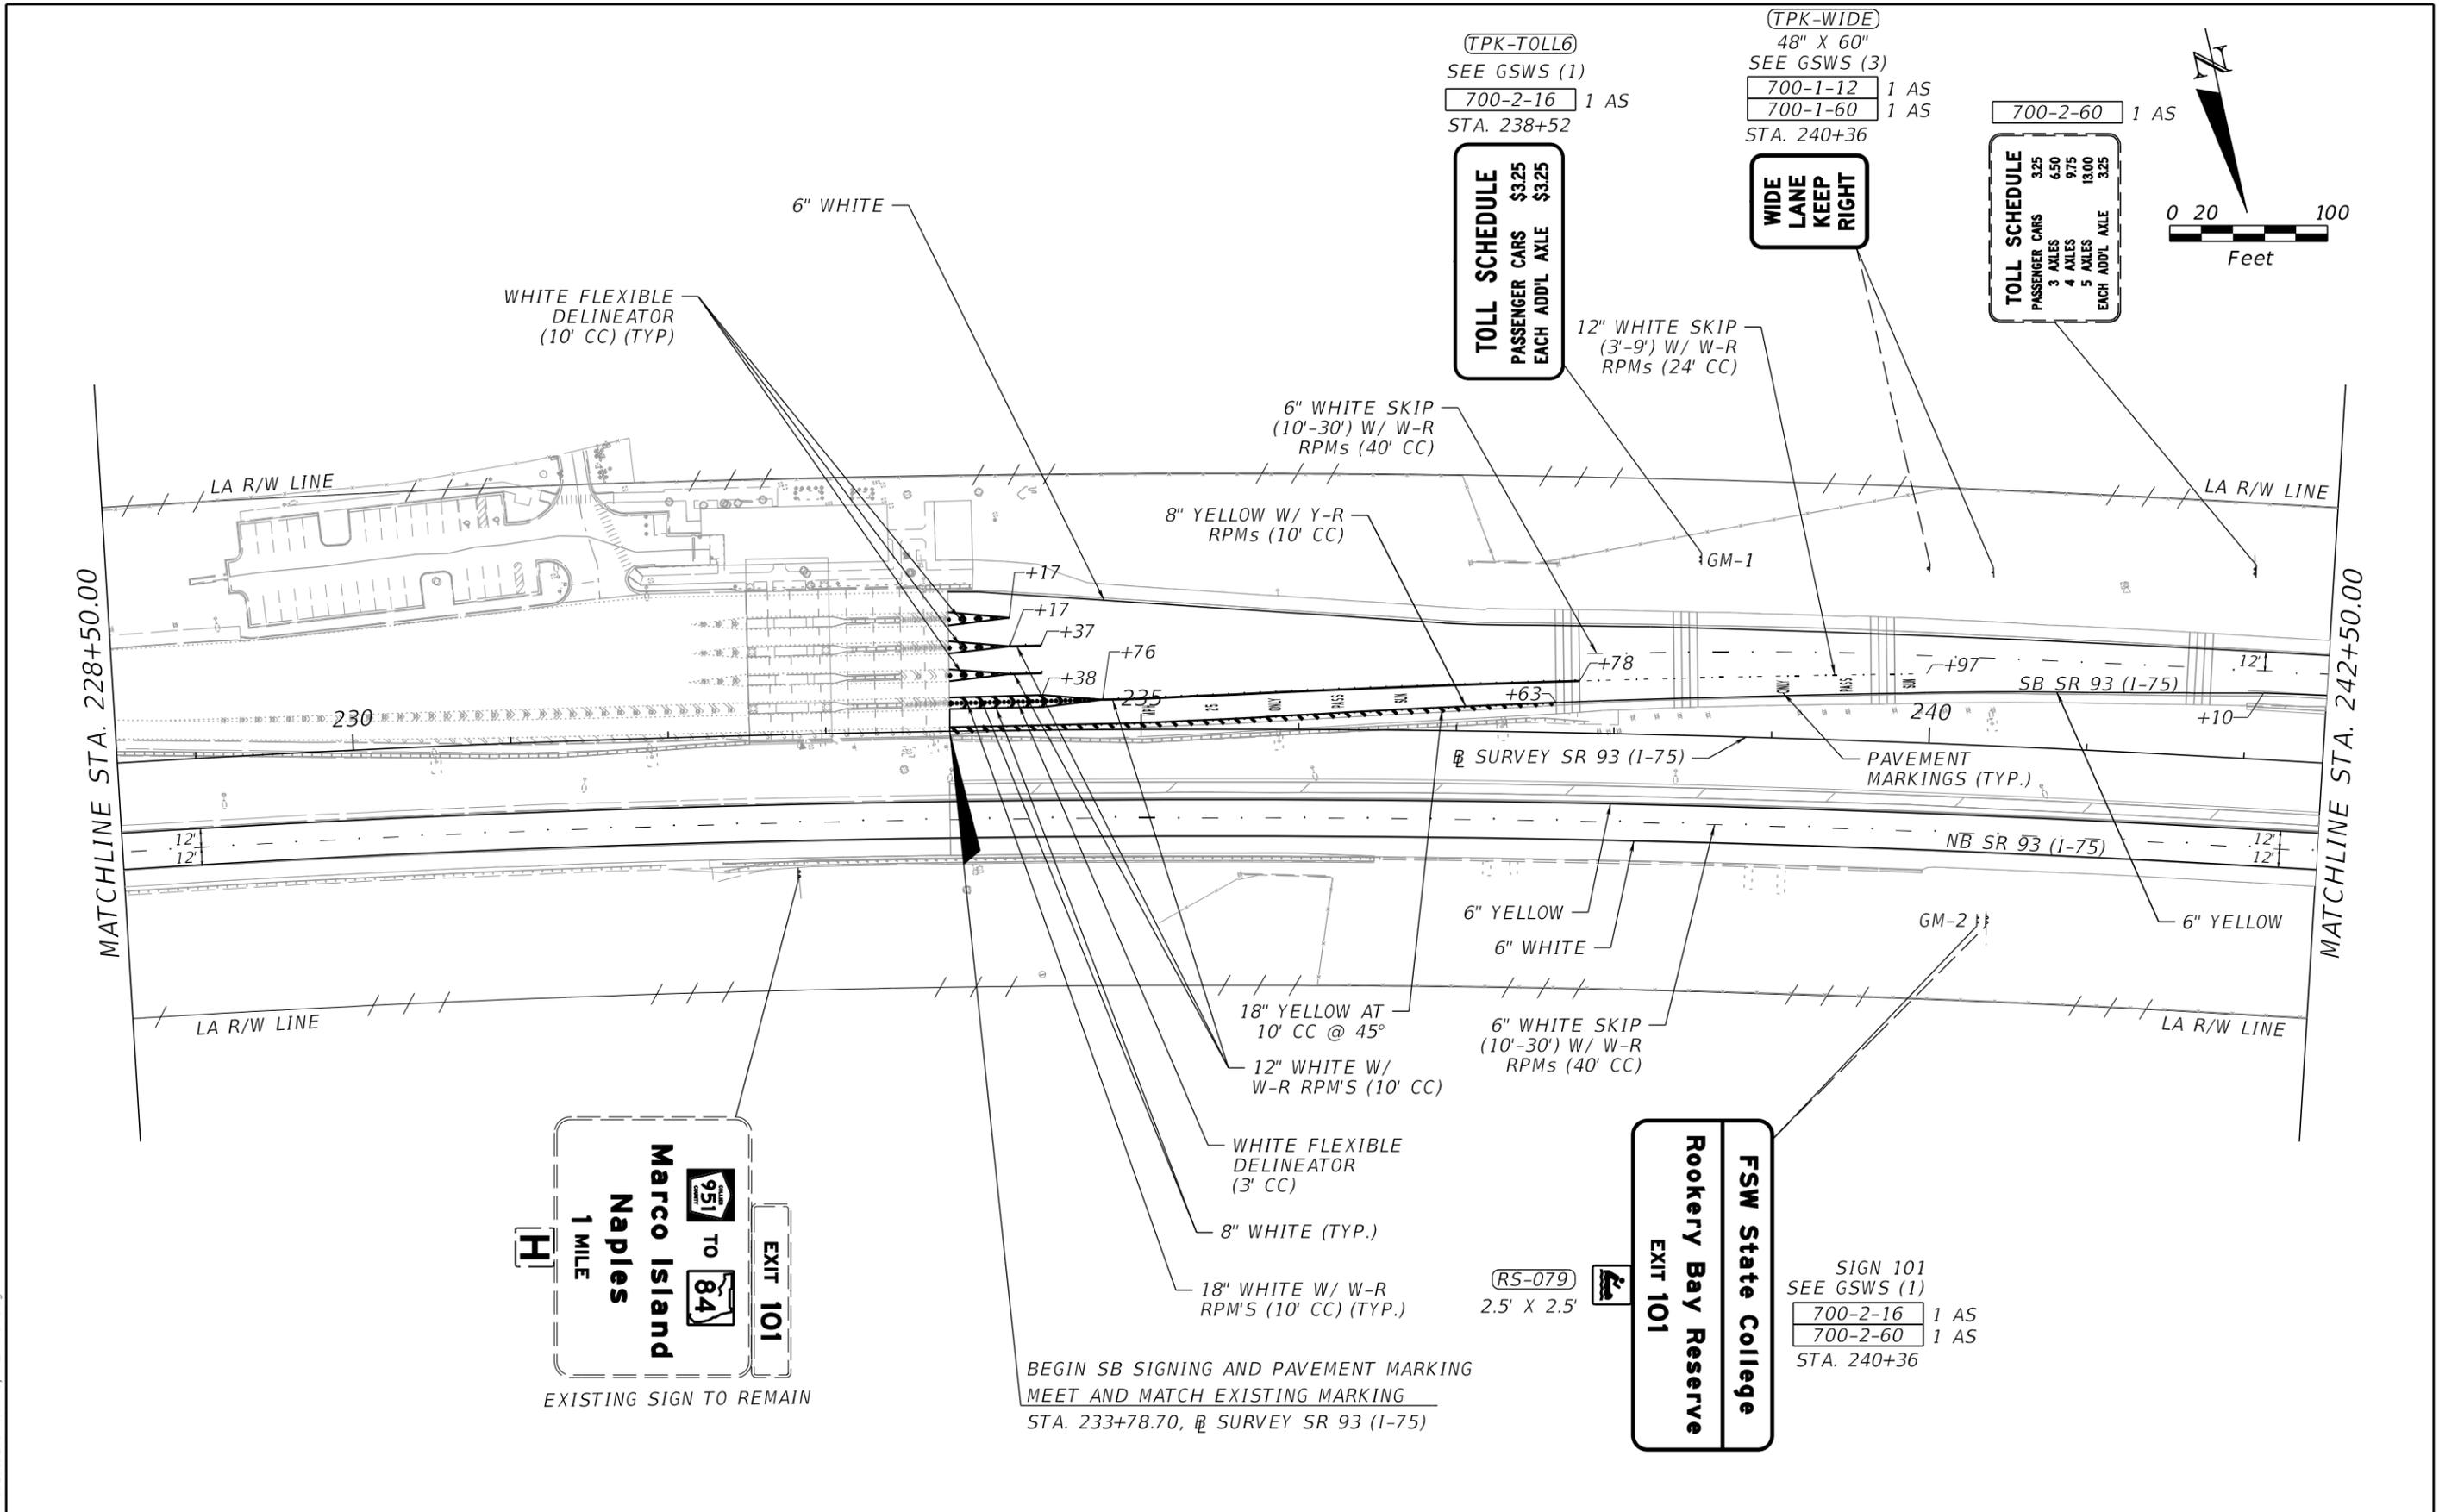


TPK-TOLL
 SEE GSWS (1)
 700-2-16 1 AS
 STA. 238+52

TPK-WIDE
 48" X 60"
 SEE GSWS (3)
 700-1-12 1 AS
 700-1-60 1 AS
 STA. 240+36

700-2-60 1 AS

TOLL SCHEDULE	
PASSENGER CARS	3.25
3 AXLES	6.50
4 AXLES	9.75
5 AXLES	13.00
EACH ADD'L AXLE	3.25

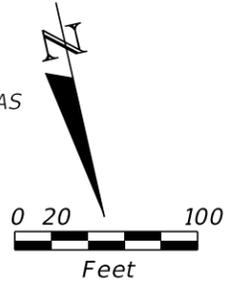

TOLL SCHEDULE
 PASSENGER CARS \$3.25
 EACH ADD'L AXLE \$3.25

WIDE LANE KEEP RIGHT

WHITE FLEXIBLE DELINEATOR (10' CC) (TYP)

6" WHITE

6" WHITE SKIP (10'-30') W/ W-R RPMs (40' CC)

8" YELLOW W/ Y-R RPMs (10' CC)

12" WHITE SKIP (3'-9") W/ W-R RPMs (24' CC)

MATCHLINE STA. 228+50.00

MATCHLINE STA. 242+50.00

EXISTING SIGN TO REMAIN

EXIT 101
 Marco Island
 Naples
 1 MILE

BEGIN SB SIGNING AND PAVEMENT MARKING
 MEET AND MATCH EXISTING MARKING
 STA. 233+78.70, @ SURVEY SR 93 (I-75)

FSW State College
Rookery Bay Reserve
 EXIT 101

SIGN 101
 SEE GSWS (1)
 700-2-16 1 AS
 700-2-60 1 AS
 STA. 240+36

REVISIONS			
DATE	DESCRIPTION	DATE	DESCRIPTION

BHARATHI CHIGURUPATI, P.E
 P.E. LICENSE NUMBER 84860
 DRMP, INC
 941 LAKE BALDWIN LANE
 ORLANDO, FL 32814


STATE OF FLORIDA DEPARTMENT OF TRANSPORTATION		
ROAD NO.	COUNTY	FINANCIAL PROJECT ID
SR 93	COLLIER	446320-1-52-01

SIGNING AND PAVEMENT MARKING PLAN

SHEET NO.
 S-5

THE OFFICIAL RECORD OF THIS SHEET IS THE ELECTRONIC FILE DIGITALLY SIGNED AND SEALED UNDER RULE 61G15-23.004, F.A.C.

2/14/2022 12:24:31 PM MHammosh
 P:\Worksets\FDOT\2044632015201\Roadway\PLAN\RD01.dgn

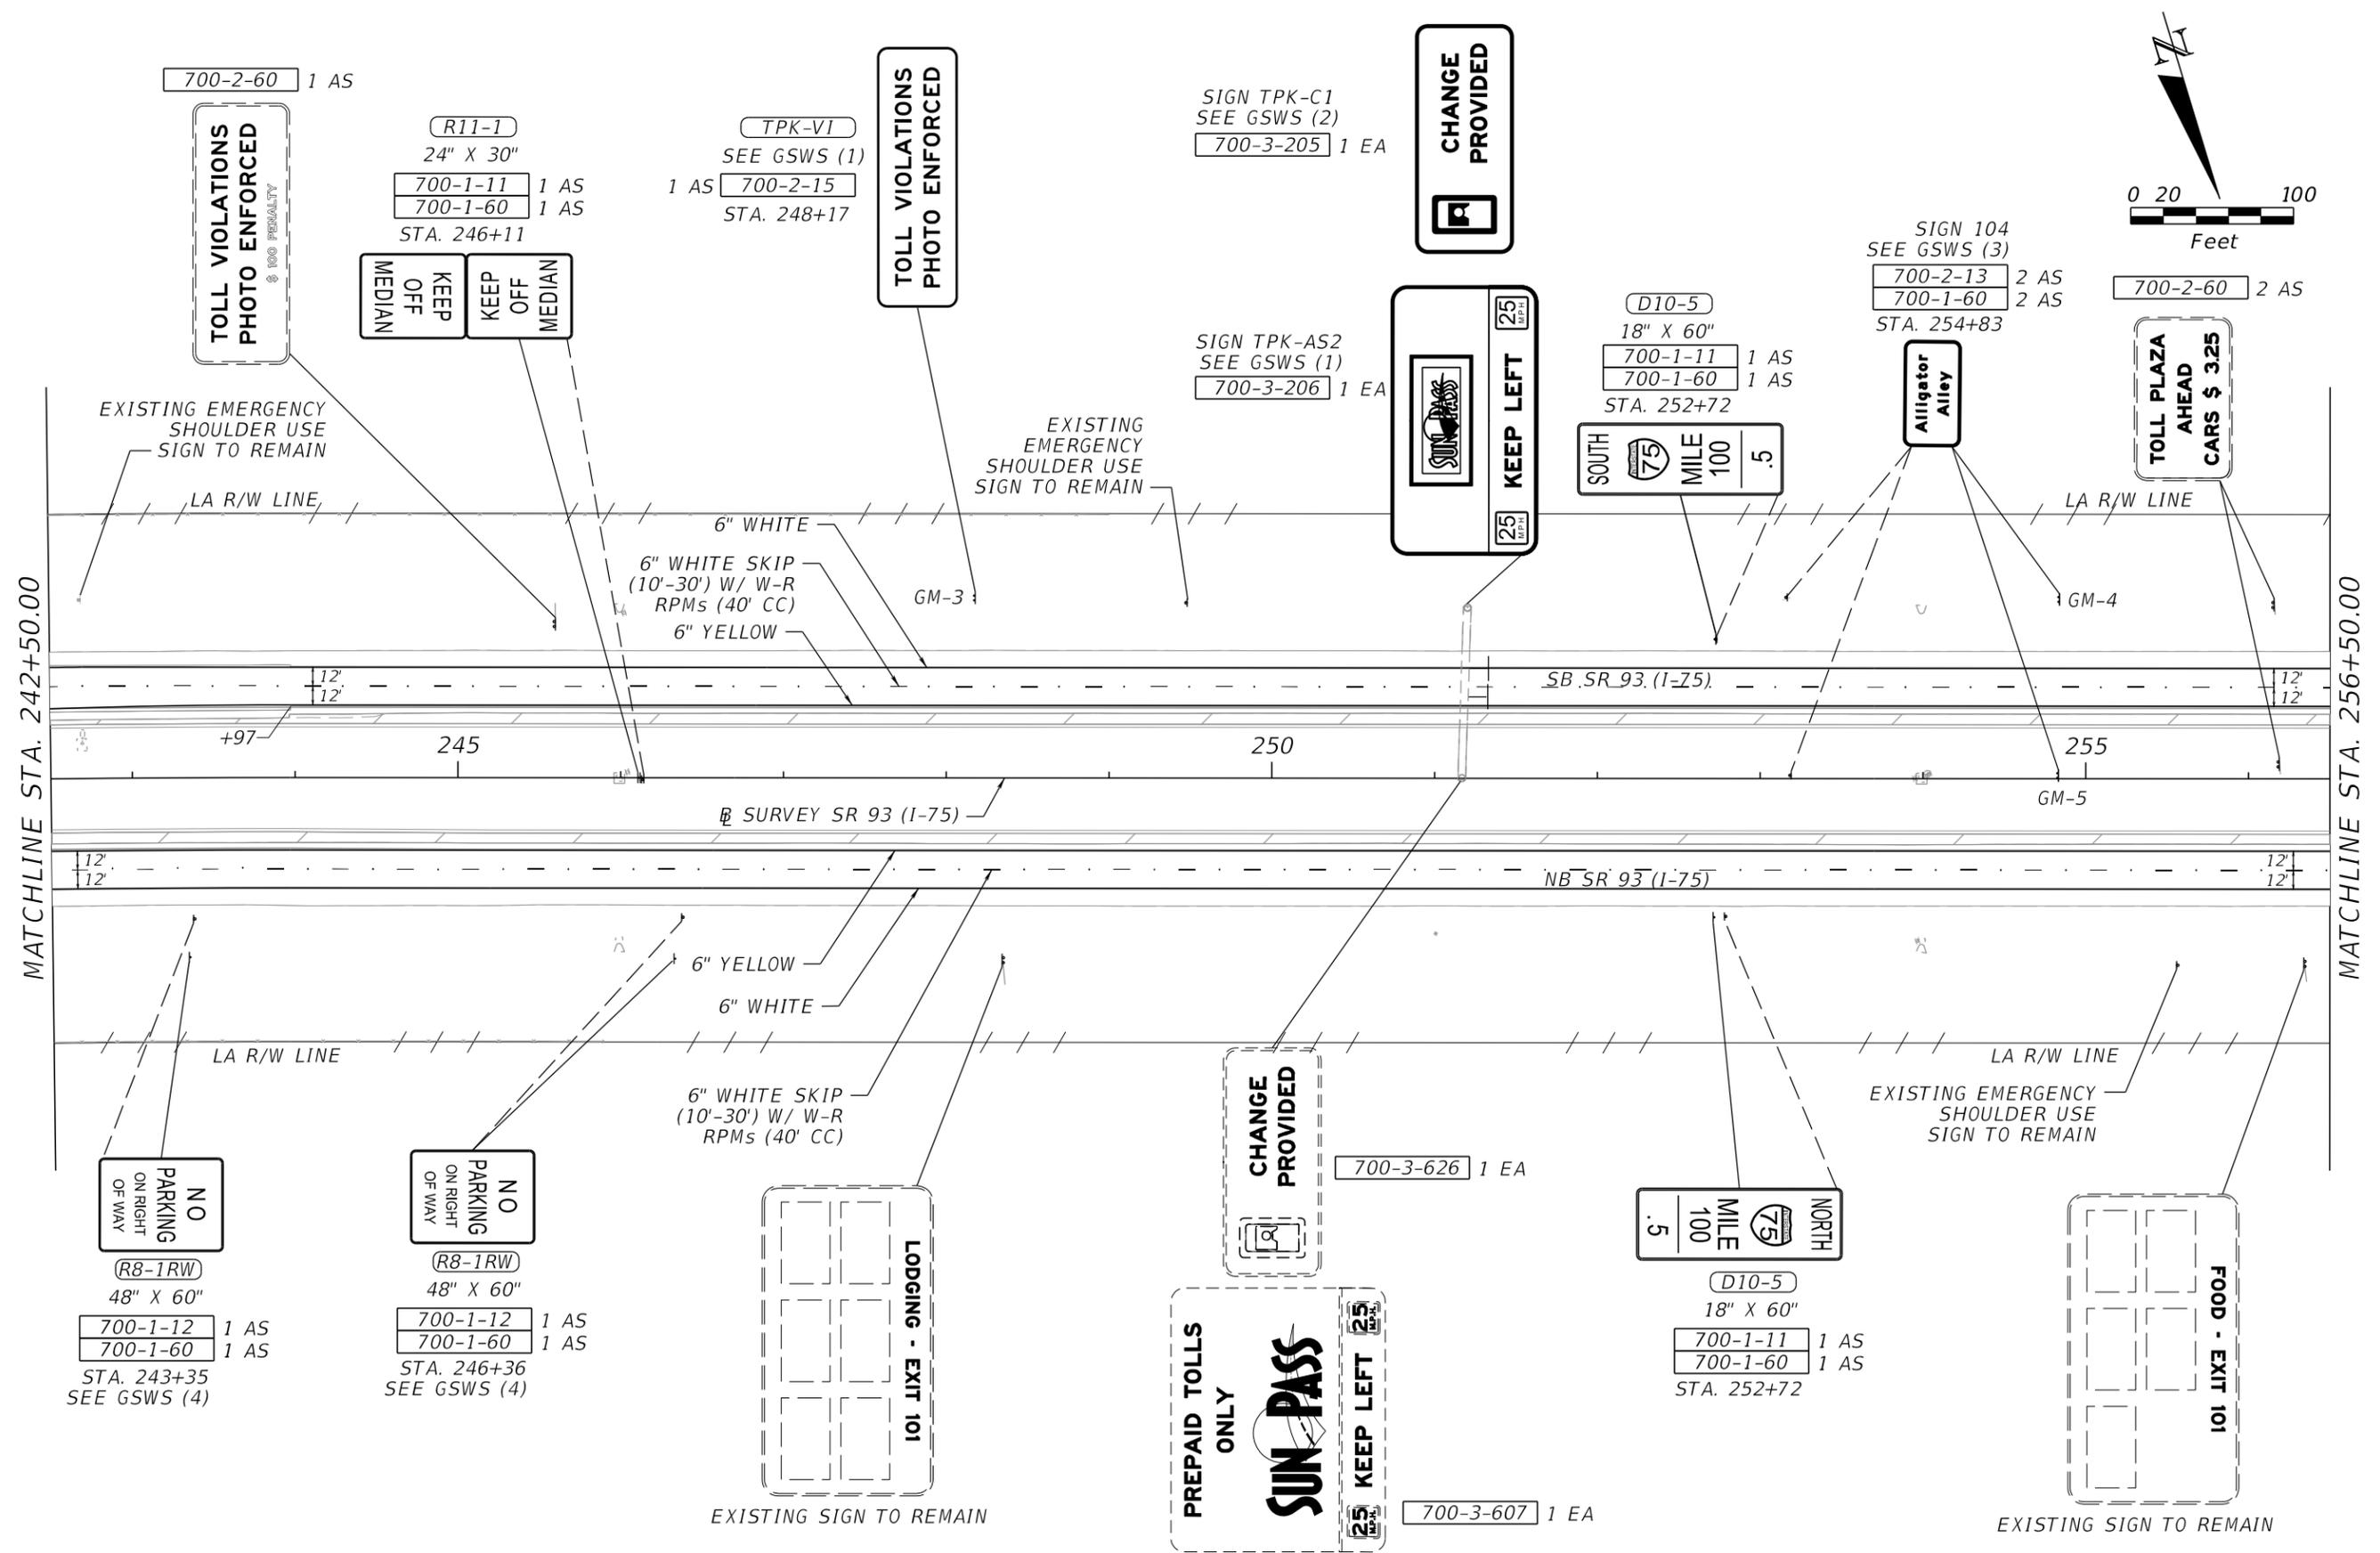

REVISIONS			
DATE	DESCRIPTION	DATE	DESCRIPTION

BHARATHI CHIGURUPATI, P.E.
 P.E. LICENSE NUMBER 84860
 DRMP, INC
 941 LAKE BALDWIN LANE
 ORLANDO, FL 32814


STATE OF FLORIDA DEPARTMENT OF TRANSPORTATION		
ROAD NO.	COUNTY	FINANCIAL PROJECT ID
SR 93	COLLIER	446320-1-52-01

SIGNING AND PAVEMENT MARKING PLAN

SHEET NO.
S-6

THE OFFICIAL RECORD OF THIS SHEET IS THE ELECTRONIC FILE DIGITALLY SIGNED AND SEALED UNDER RULE 61G15-23.004, F.A.C.

2/14/2022 12:24:38 PM MHammosh P:\Worksets\FDOT\2044632015201\Roadway\PLANRD01.dgn

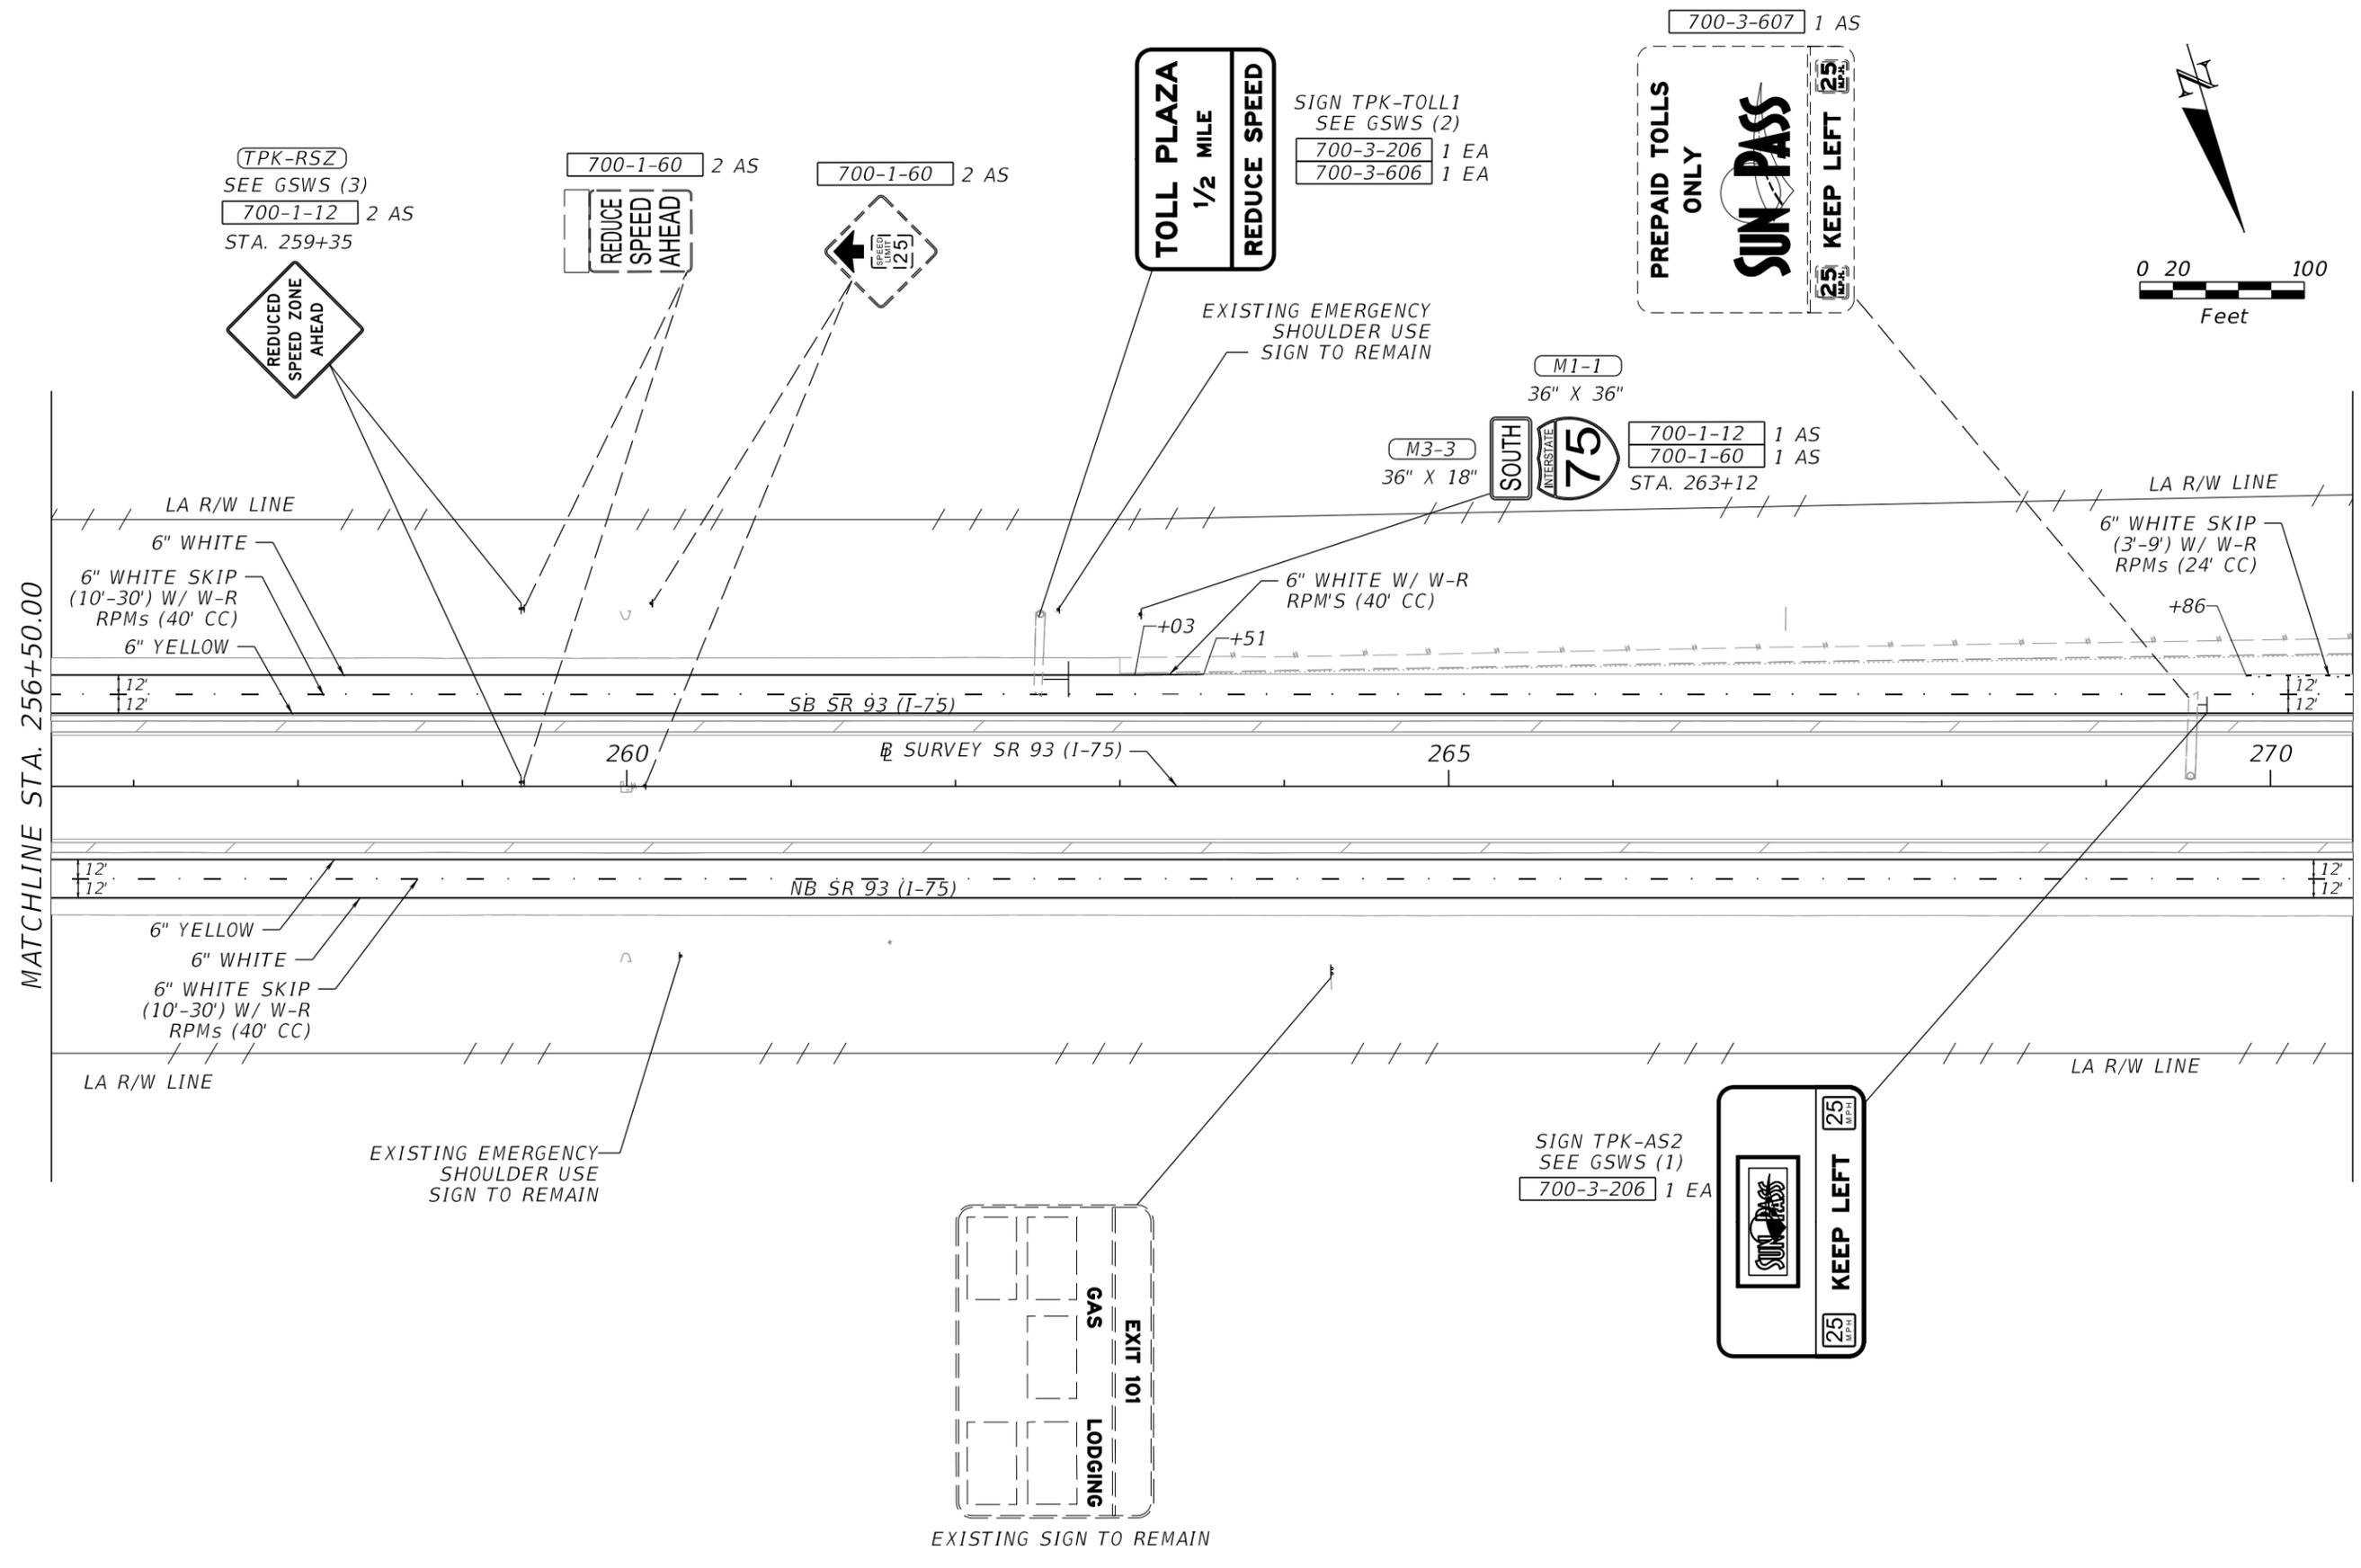

REVISIONS			
DATE	DESCRIPTION	DATE	DESCRIPTION

BHARATHI CHIGURUPATI, P.E.
 P.E. LICENSE NUMBER 84860
 DRMP, INC
 941 LAKE BALDWIN LANE
 ORLANDO, FL 32814


STATE OF FLORIDA DEPARTMENT OF TRANSPORTATION		
ROAD NO.	COUNTY	FINANCIAL PROJECT ID
SR 93	COLLIER	446320-1-52-01

SIGNING AND PAVEMENT MARKING PLAN

SHEET NO.
S-7

THE OFFICIAL RECORD OF THIS SHEET IS THE ELECTRONIC FILE DIGITALLY SIGNED AND SEALED UNDER RULE 61G15-23.004, F.A.C.

2/14/2022 12:24:46 PM MHammosh
 P:\Worksets\FDOT\2044632015201\Roadway\PLAN\RD01.dgn

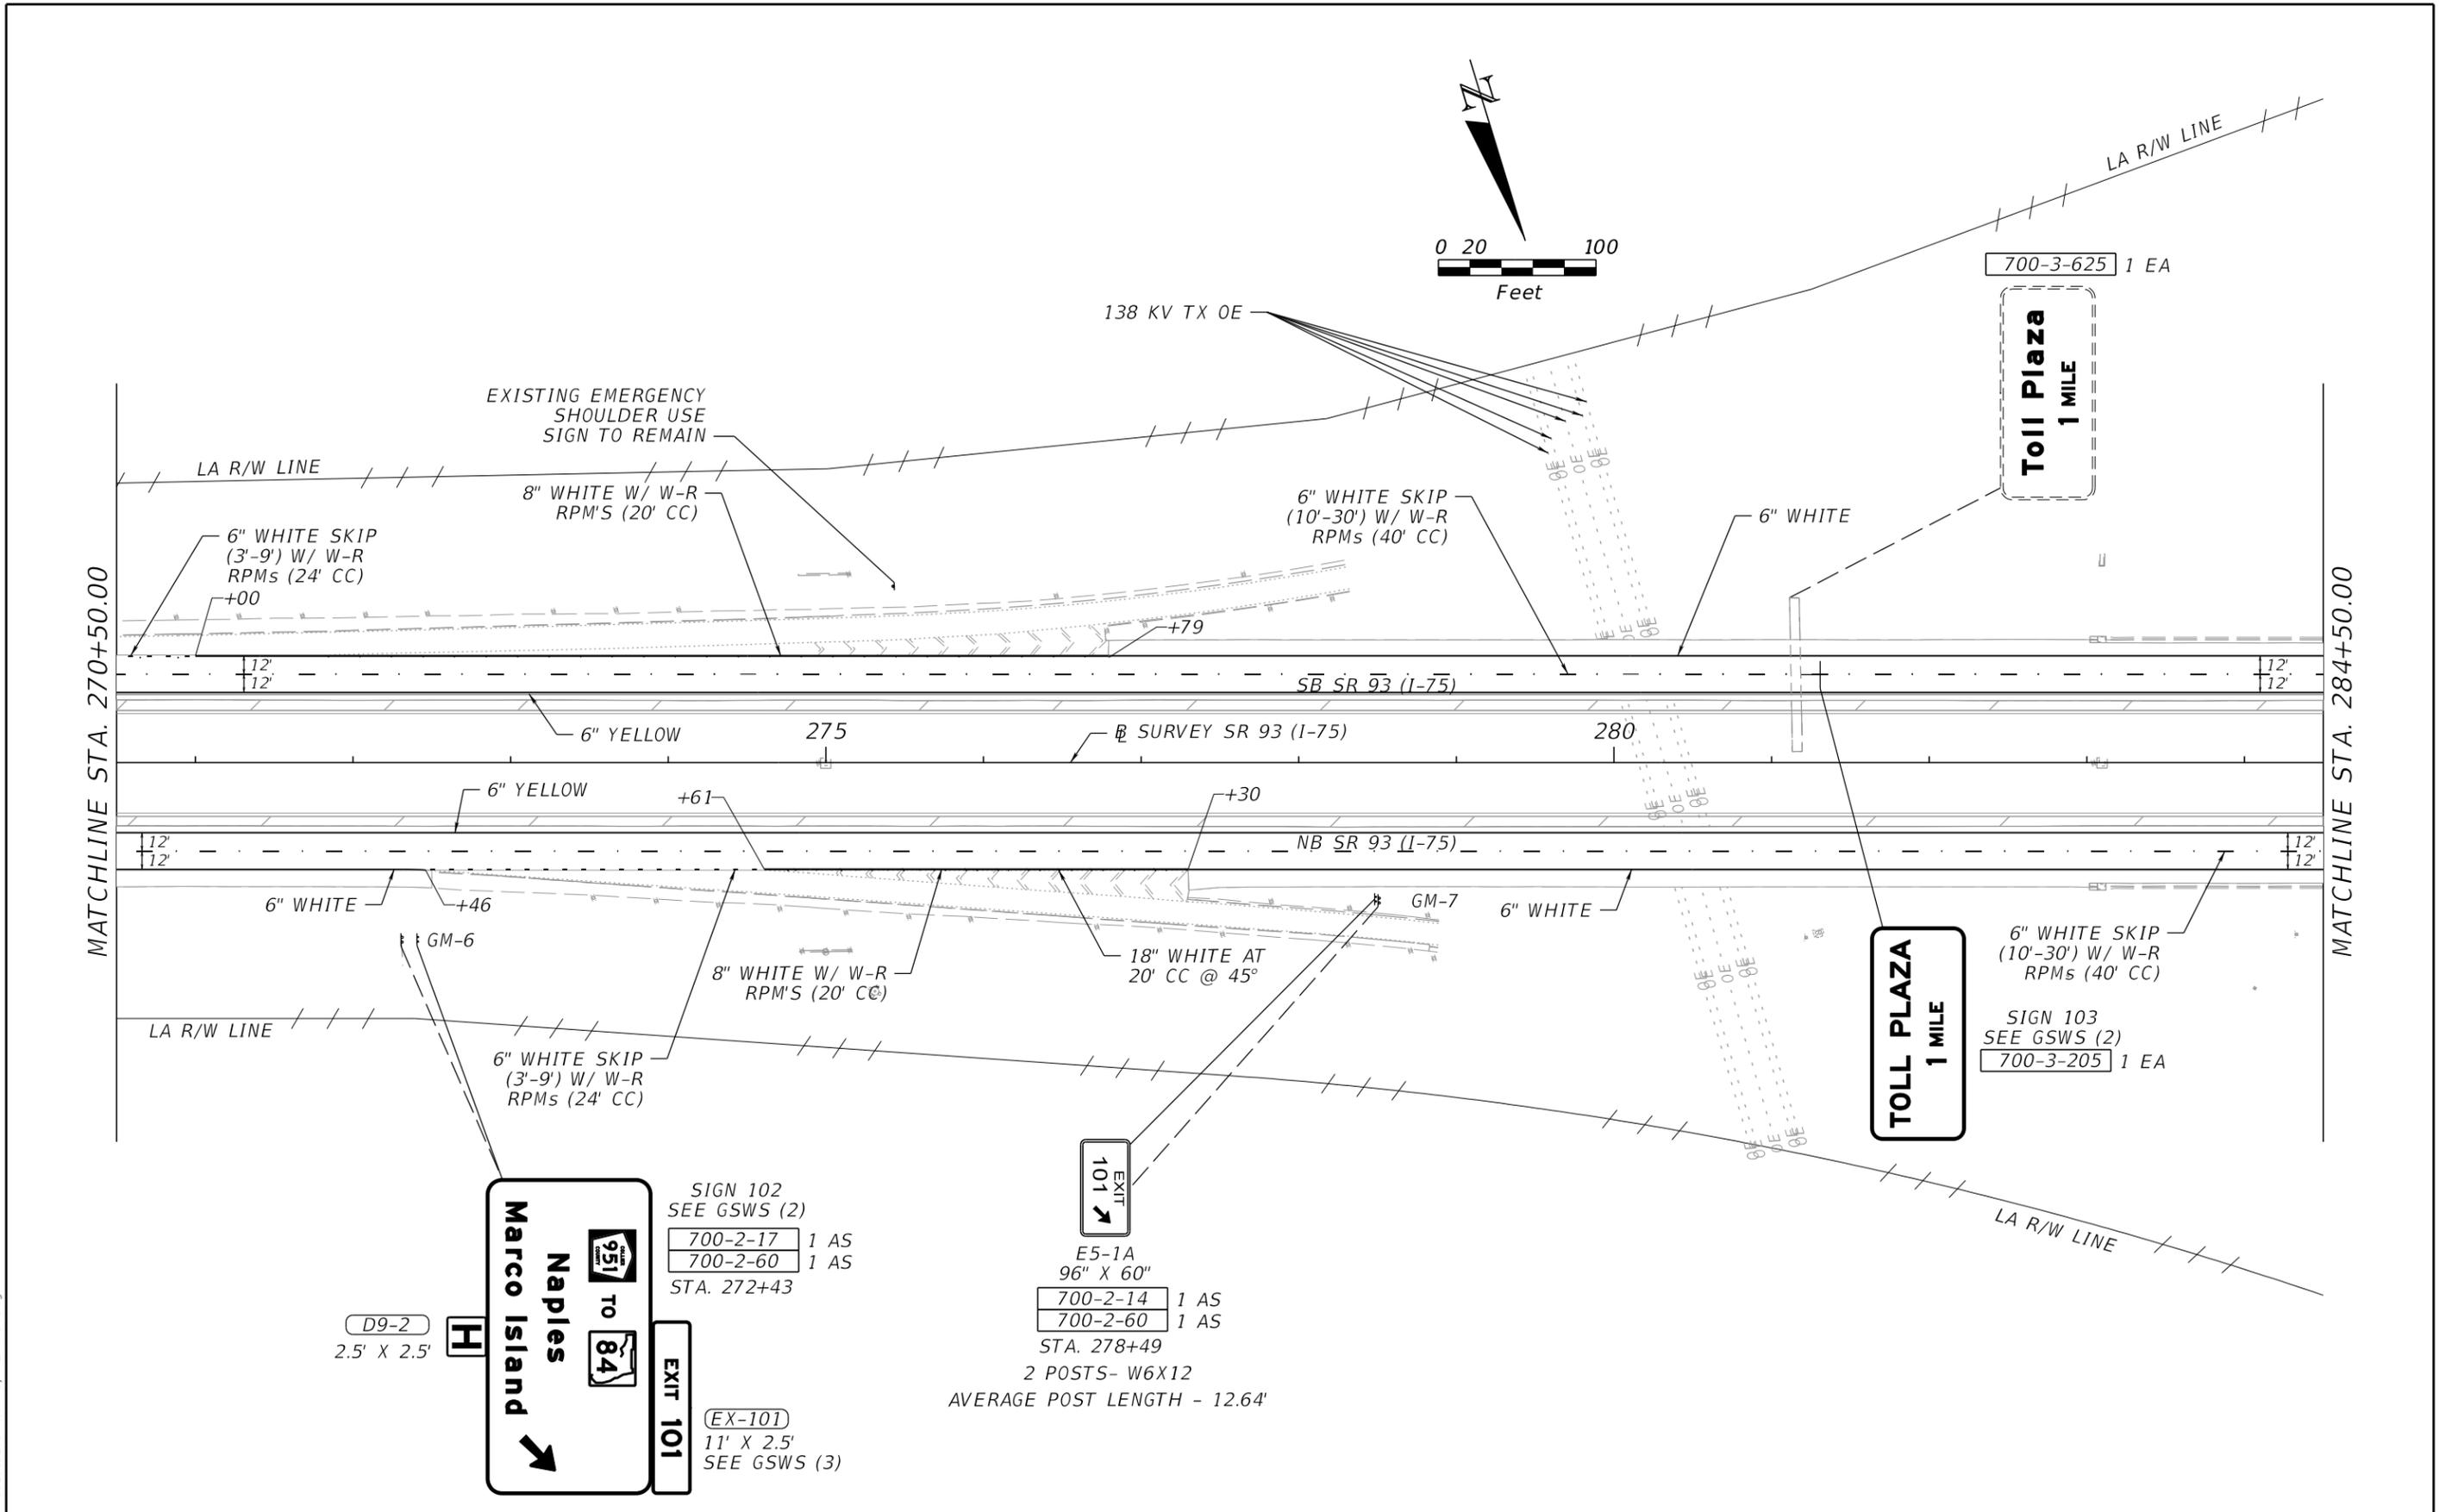

REVISIONS			
DATE	DESCRIPTION	DATE	DESCRIPTION

BHARATHI CHIGURUPATI, P.E.
 P.E. LICENSE NUMBER 84860
 DRMP, INC
 941 LAKE BALDWIN LANE
 ORLANDO, FL 32814

STATE OF FLORIDA DEPARTMENT OF TRANSPORTATION		
ROAD NO.	COUNTY	FINANCIAL PROJECT ID
SR 93	COLLIER	446320-1-52-01



**SIGNING AND PAVEMENT
MARKING PLAN**

SHEET NO.
S-8

THE OFFICIAL RECORD OF THIS SHEET IS THE ELECTRONIC FILE DIGITALLY SIGNED AND SEALED UNDER RULE 61G15-23.004, F.A.C.

NOTES: PAVEMENT MARKINGS SHALL BE PERMANENT TAPE FROM BEGIN TO END OF BRIDGE.

LA R/W LINE

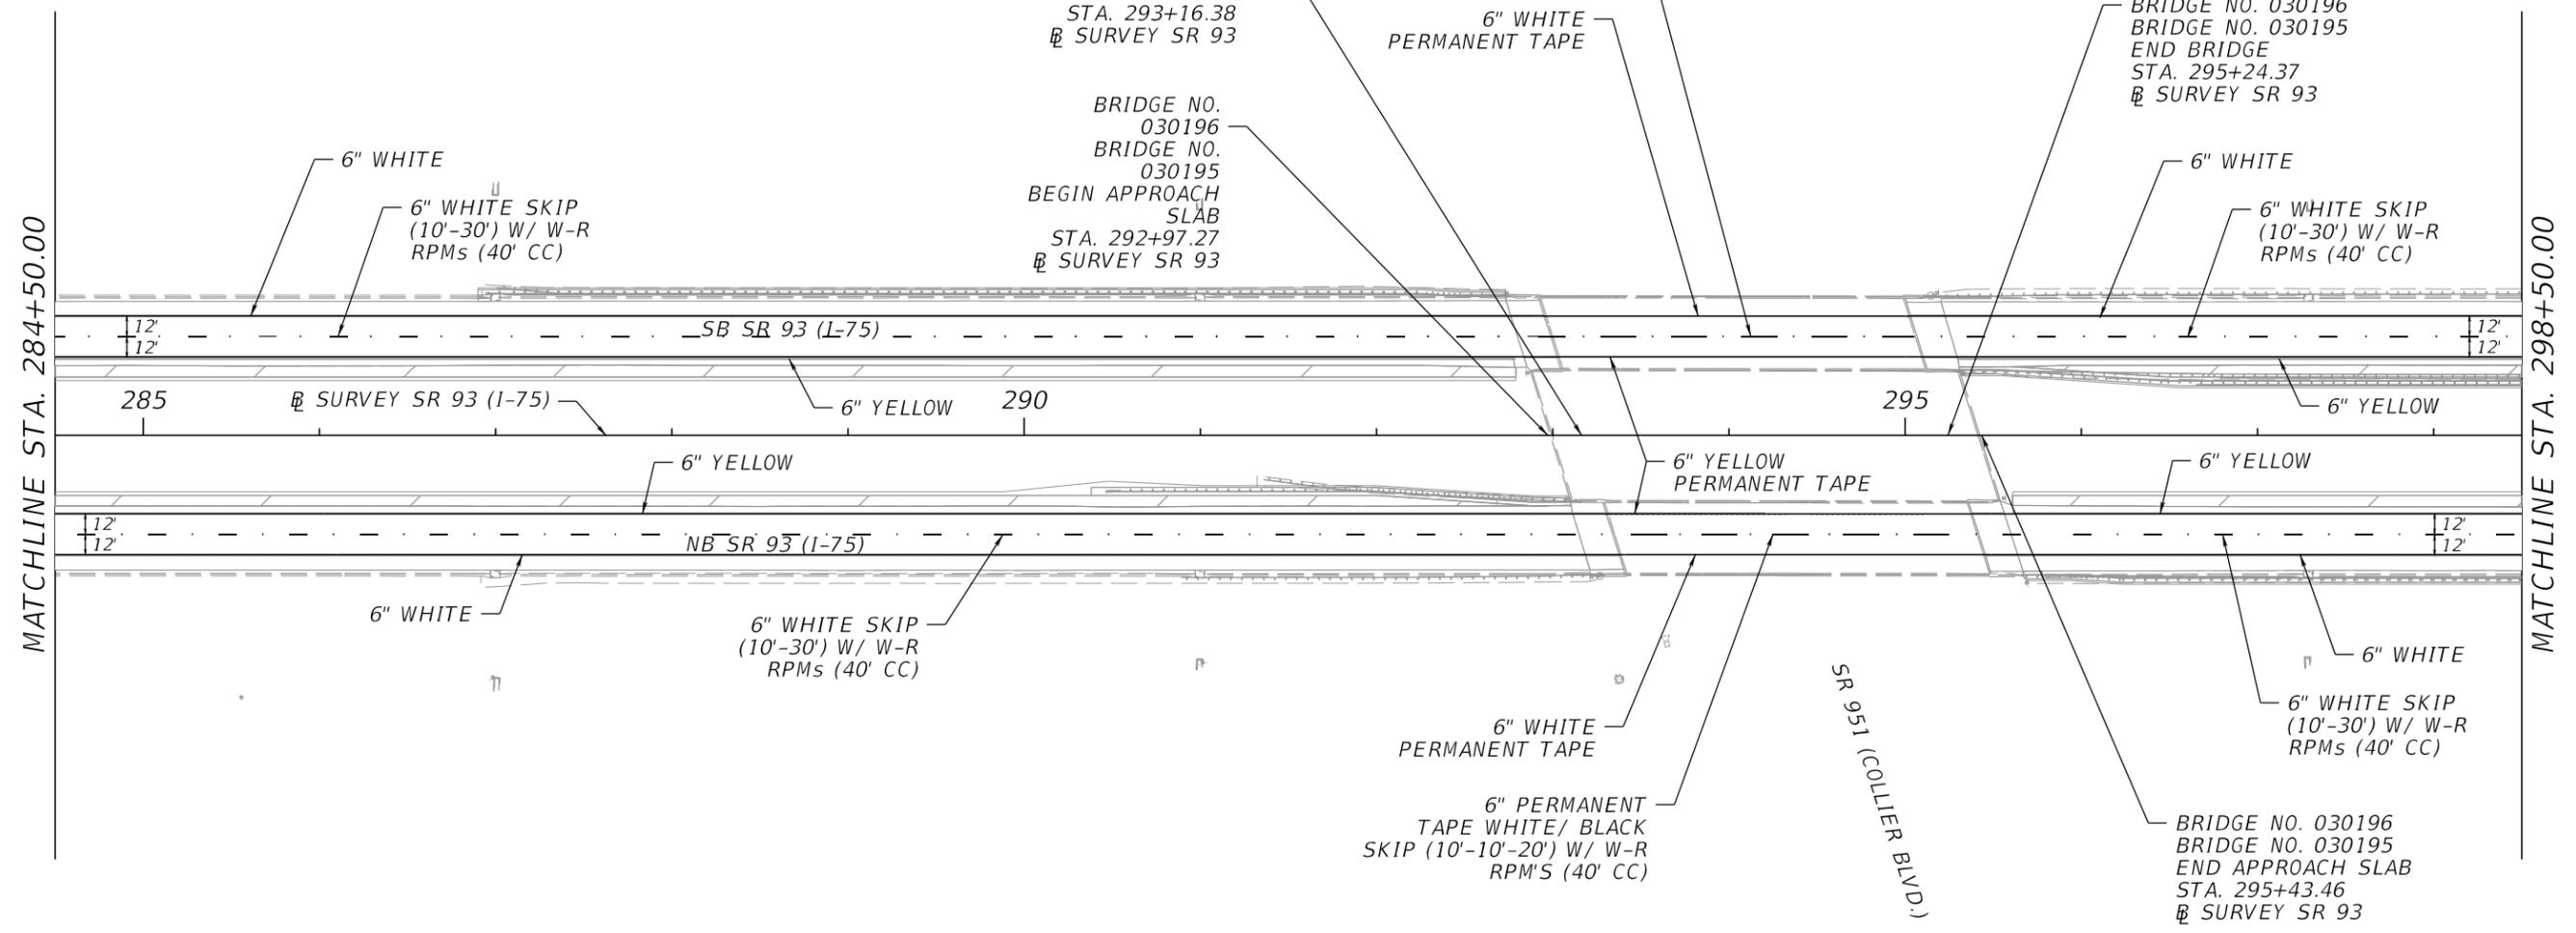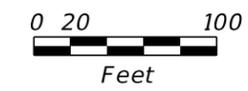

BRIDGE NO. 030196
BRIDGE NO. 030195
BEGIN BRIDGE
STA. 293+16.38
SURVEY SR 93

6" PERMANENT TAPE WHITE/ BLACK SKIP (10'-10'-20') W/ W-R RPM'S (40' CC)

6" WHITE PERMANENT TAPE

BRIDGE NO. 030196
BRIDGE NO. 030195
END BRIDGE
STA. 295+24.37
SURVEY SR 93

BRIDGE NO. 030196
BRIDGE NO. 030195
BEGIN APPROACH SLAB
STA. 292+97.27
SURVEY SR 93

6" WHITE

6" WHITE SKIP (10'-30') W/ W-R RPMs (40' CC)

6" WHITE

6" WHITE SKIP (10'-30') W/ W-R RPMs (40' CC)

MATCHLINE STA. 284+50.00

MATCHLINE STA. 298+50.00

SR 951 (COLLIER BLVD.)

6" WHITE

6" WHITE SKIP (10'-30') W/ W-R RPMs (40' CC)

6" WHITE PERMANENT TAPE

6" PERMANENT TAPE WHITE/ BLACK SKIP (10'-10'-20') W/ W-R RPM'S (40' CC)

6" WHITE

6" WHITE SKIP (10'-30') W/ W-R RPMs (40' CC)

BRIDGE NO. 030196
BRIDGE NO. 030195
END APPROACH SLAB
STA. 295+43.46
SURVEY SR 93

LA R/W LINE

2/14/2022 12:24:53 PM MHammosh P:\Worksets\FDOT\2044632015201\Roadway\PLANRD01.dgn

REVISIONS			
DATE	DESCRIPTION	DATE	DESCRIPTION

BHARATHI CHIGURUPATI, P.E
P.E. LICENSE NUMBER 84860
DRMP, INC
941 LAKE BALDWIN LANE
ORLANDO, FL 32814


STATE OF FLORIDA DEPARTMENT OF TRANSPORTATION		
ROAD NO.	COUNTY	FINANCIAL PROJECT ID
SR 93	COLLIER	446320-1-52-01

**SIGNING AND PAVEMENT
MARKING PLAN**

SHEET NO.
S-9

THE OFFICIAL RECORD OF THIS SHEET IS THE ELECTRONIC FILE DIGITALLY SIGNED AND SEALED UNDER RULE 61G15-23.004, F.A.C.

2/14/2022 12:25:00 PM MHammoth
 P:\Worksets\FDOT\2044632015201\Roadway\PLANRD01.dgn

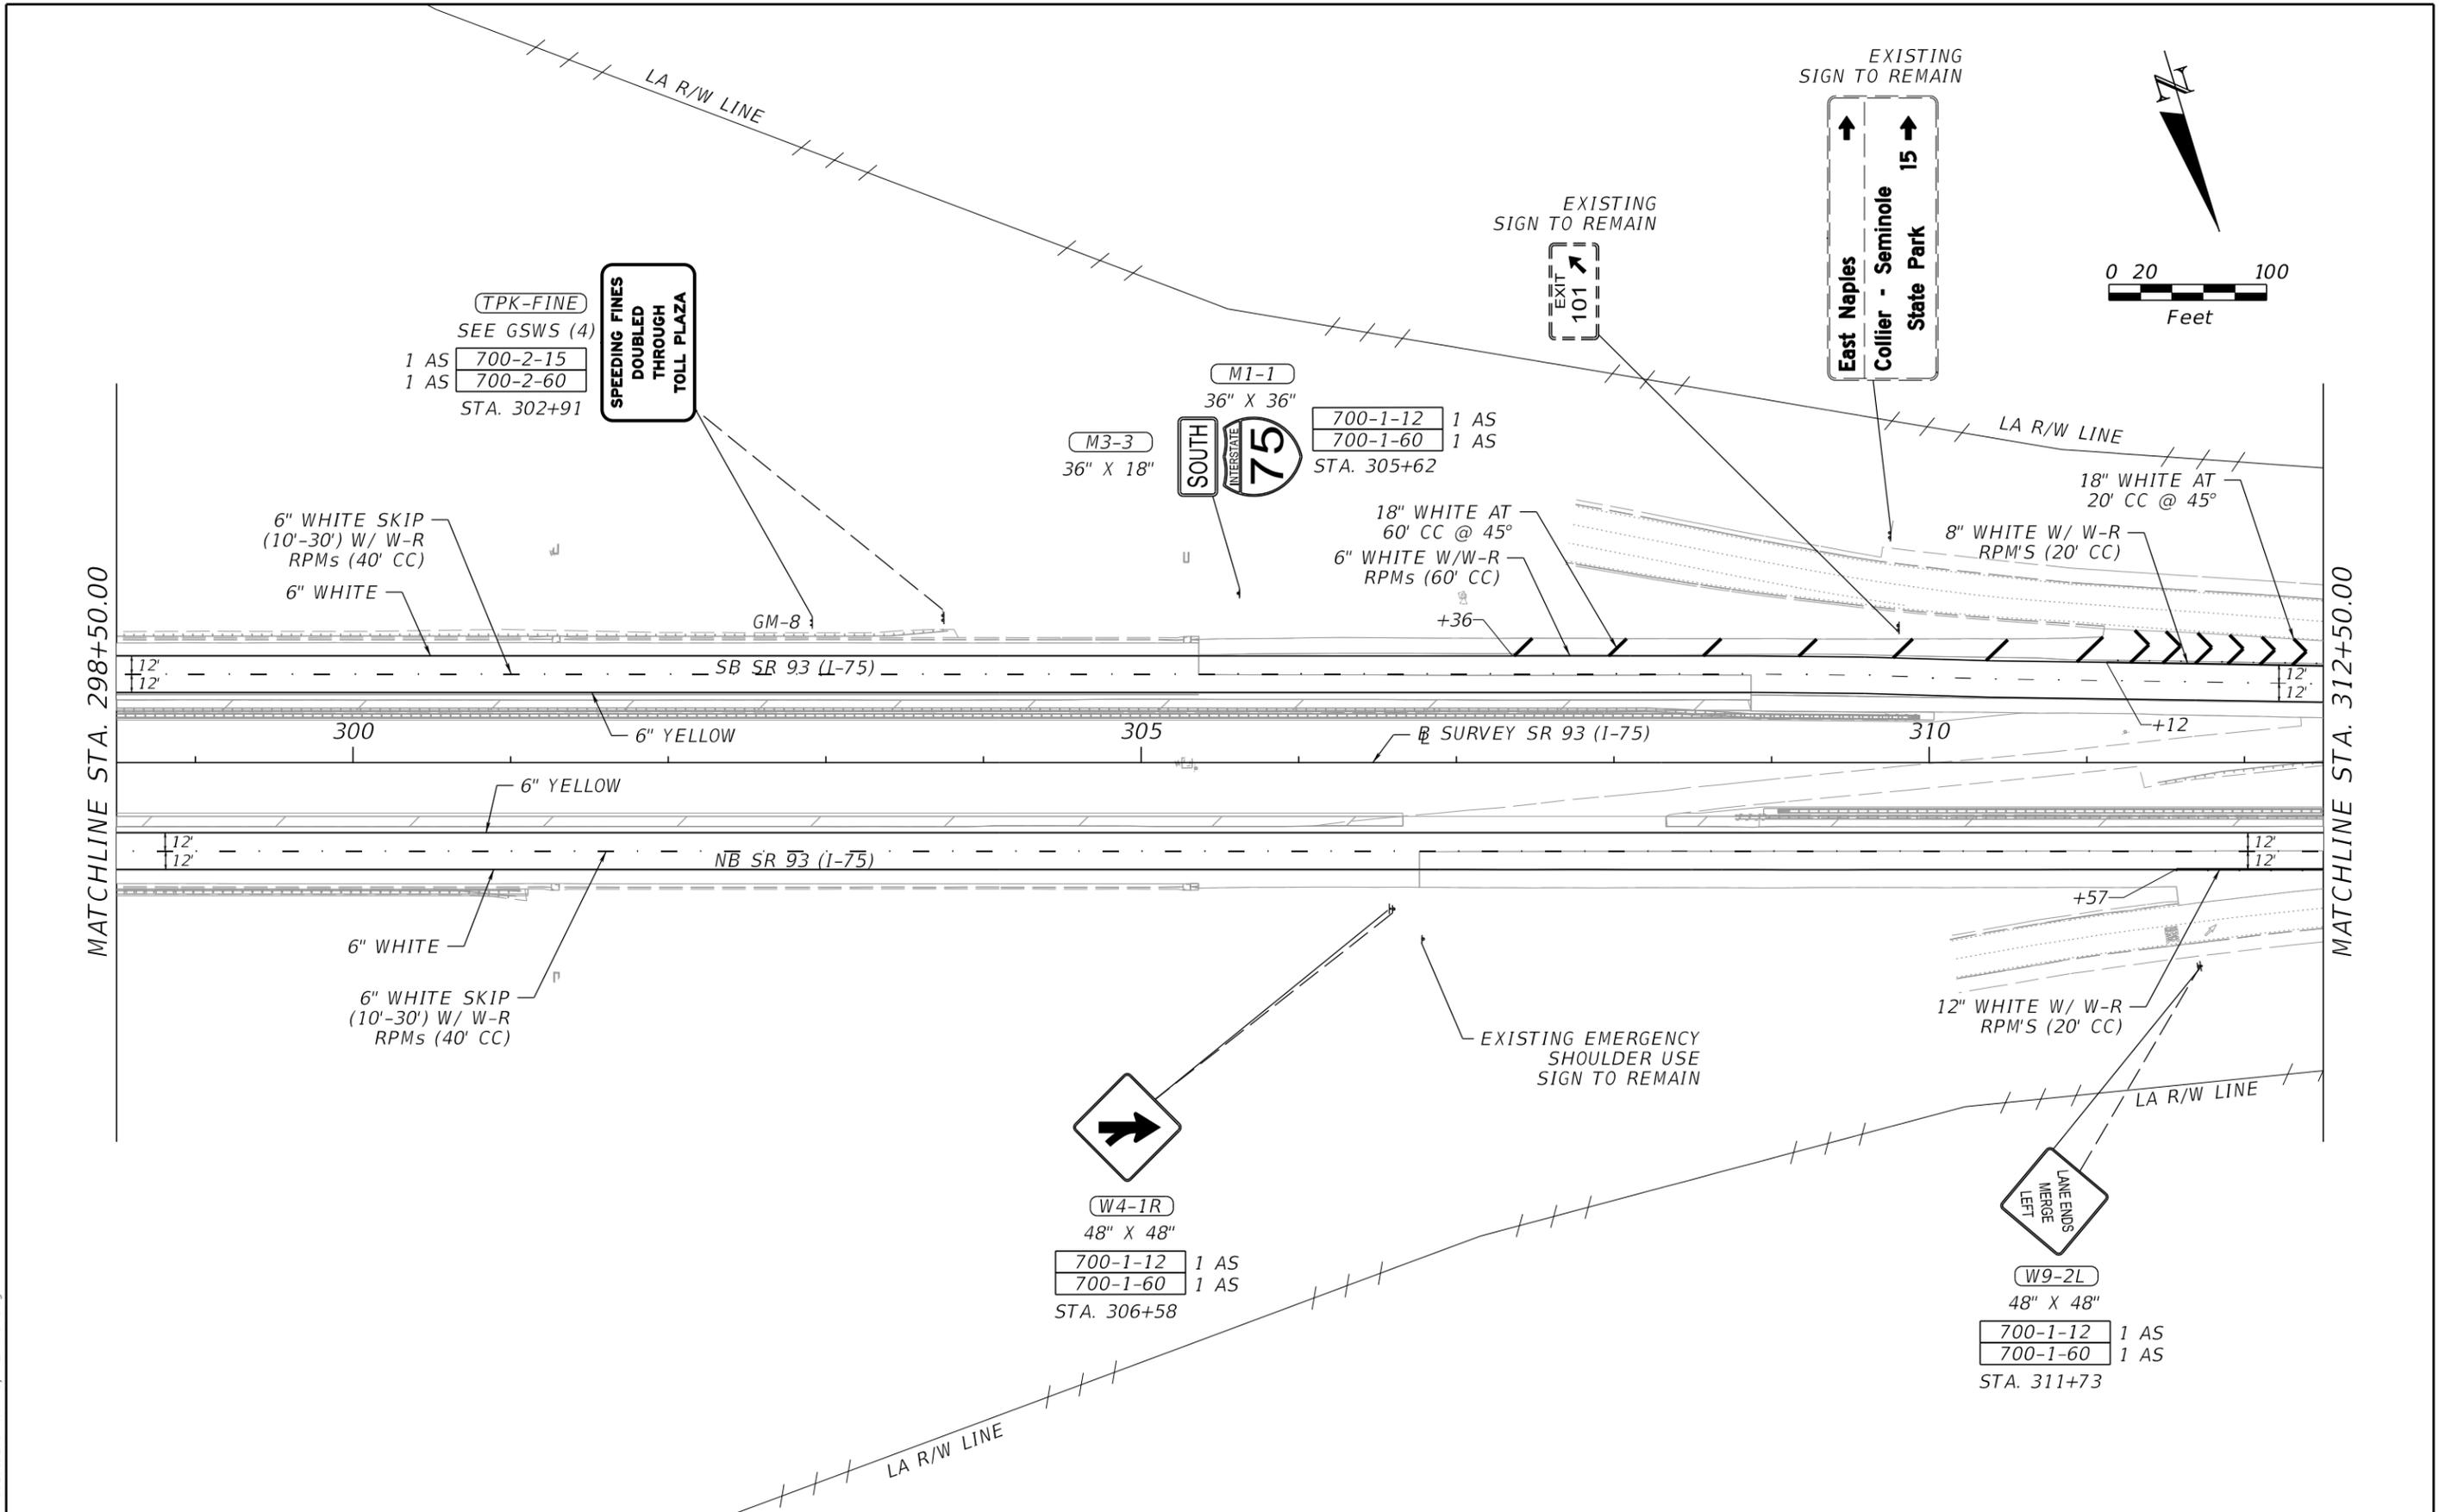

MATCHLINE STA. 298+50.00

MATCHLINE STA. 312+50.00

REVISIONS			
DATE	DESCRIPTION	DATE	DESCRIPTION



BHARATHI CHIGURUPATI, P.E.
 P.E. LICENSE NUMBER 84860
 DRMP, INC
 941 LAKE BALDWIN LANE
 ORLANDO, FL 32814

STATE OF FLORIDA DEPARTMENT OF TRANSPORTATION		
ROAD NO.	COUNTY	FINANCIAL PROJECT ID
SR 93	COLLIER	446320-1-52-01

**SIGNING AND PAVEMENT
MARKING PLAN**

SHEET NO.
S-10

THE OFFICIAL RECORD OF THIS SHEET IS THE ELECTRONIC FILE DIGITALLY SIGNED AND SEALED UNDER RULE 61G15-23.004, F.A.C.

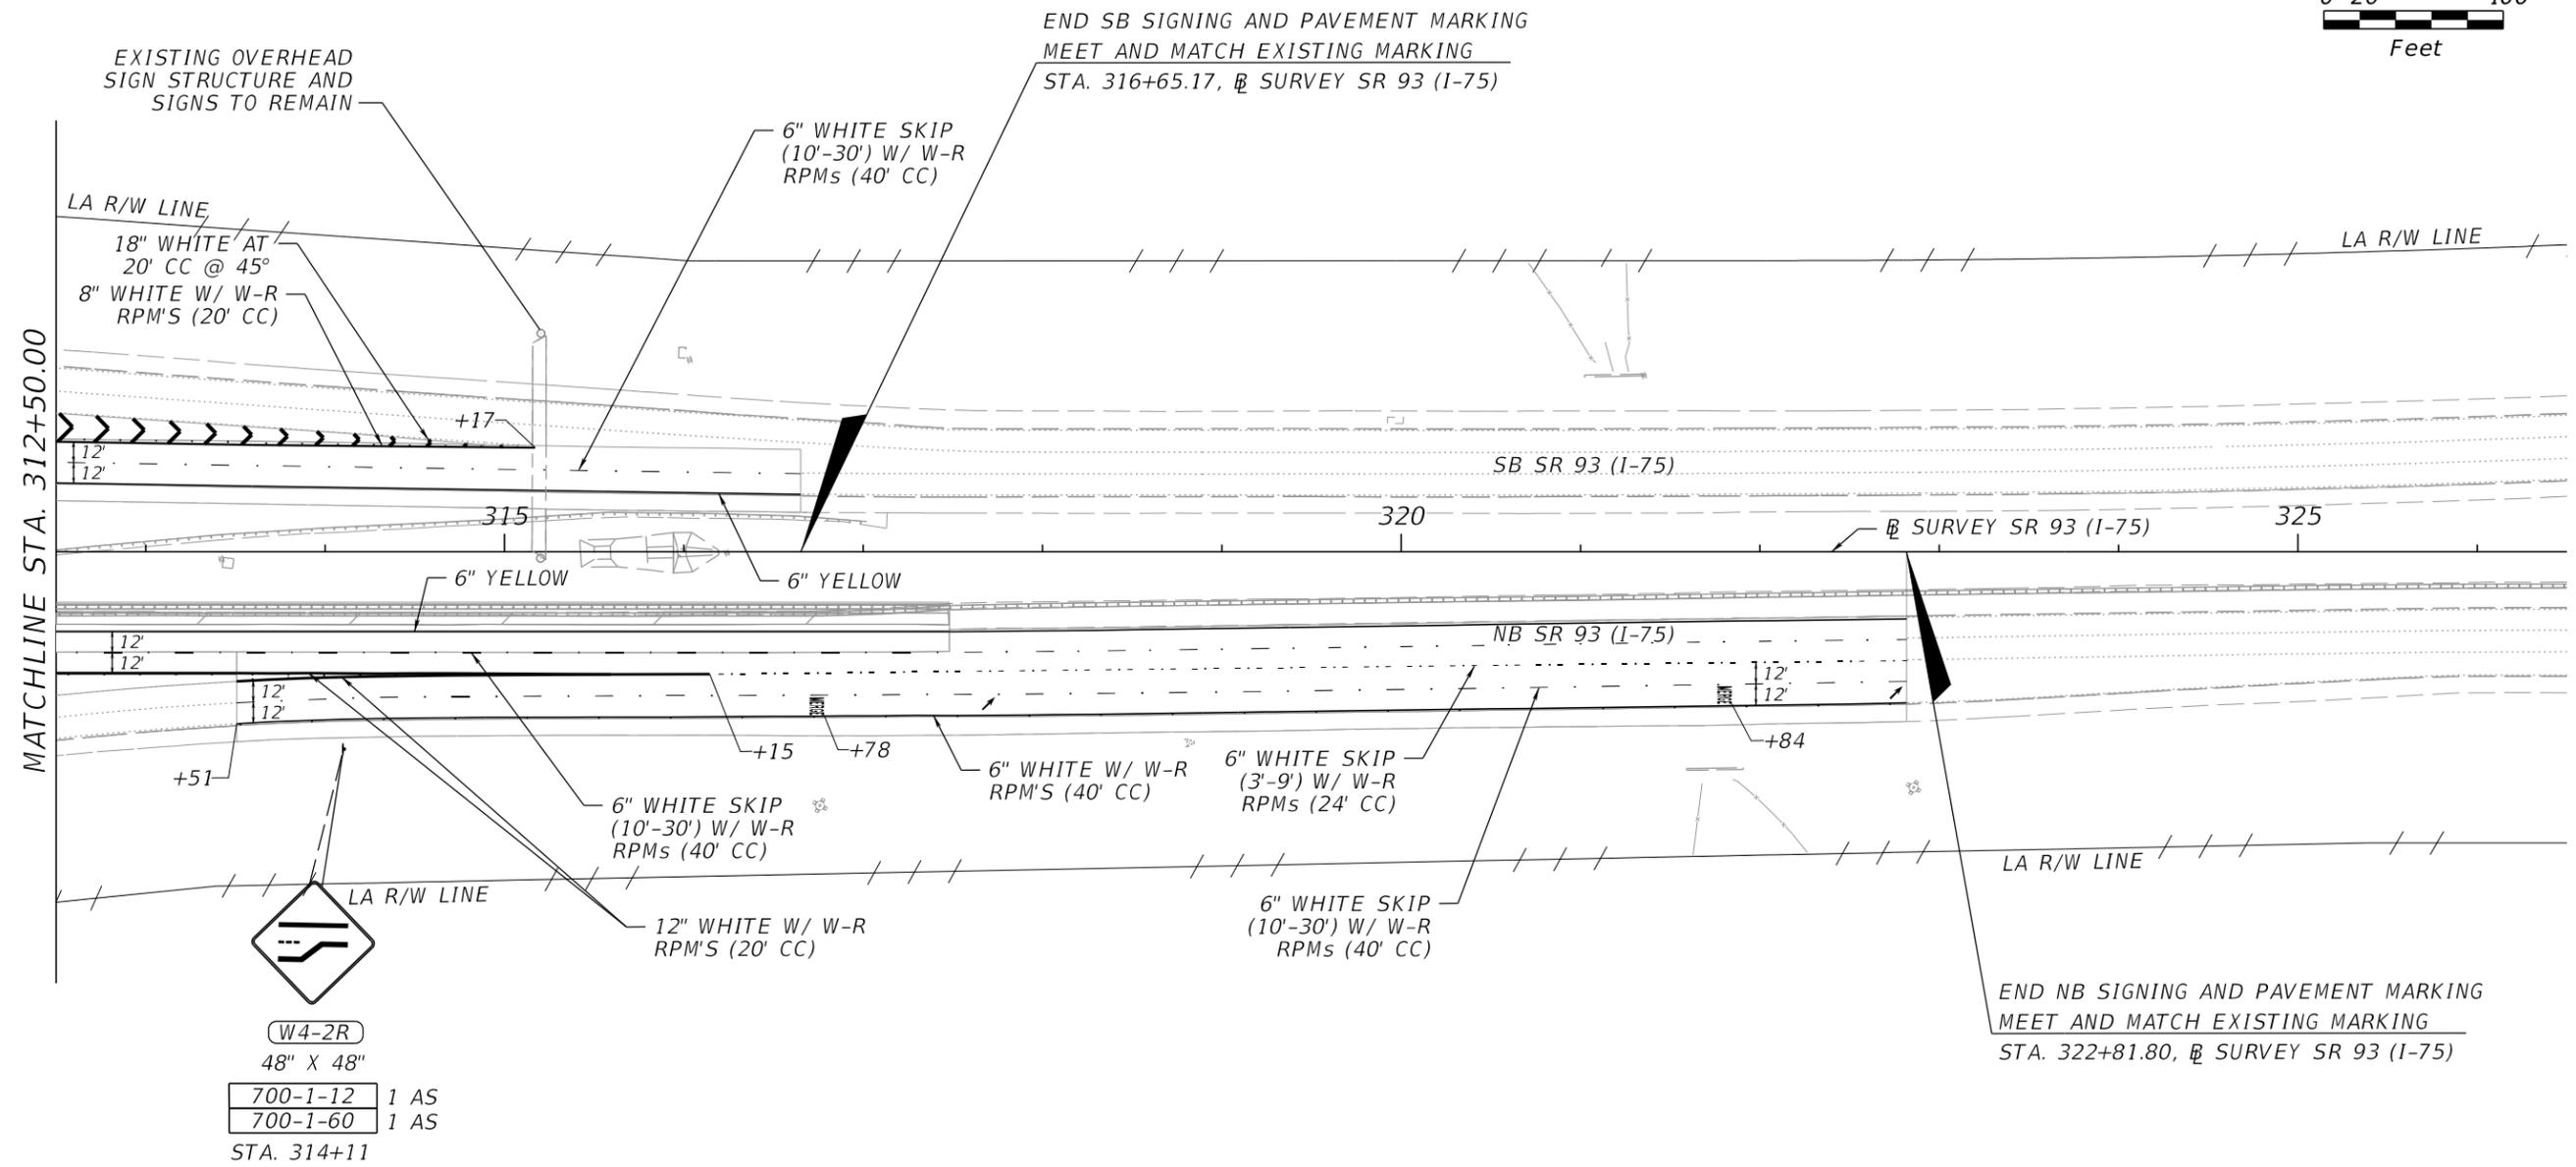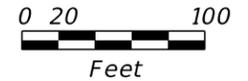

W4-2R	
48" X 48"	
700-1-12	1 AS
700-1-60	1 AS
STA. 314+11	

END NB SIGNING AND PAVEMENT MARKING
MEET AND MATCH EXISTING MARKING
STA. 322+81.80, @ SURVEY SR 93 (I-75)


2/14/2022 12:25:07 PM MHammosh P:\Worksets\FDOT\2044632015201\Roadway\PLANRD01.dgn

THE OFFICIAL RECORD OF THIS SHEET IS THE ELECTRONIC FILE DIGITALLY SIGNED AND SEALED UNDER RULE 61G15-23.004, F.A.C.

REVISIONS				BHARATHI CHIGURUPATI, P.E. P.E. LICENSE NUMBER 84860 DRMP, INC 941 LAKE BALDWIN LANE ORLANDO, FL 32814	STATE OF FLORIDA DEPARTMENT OF TRANSPORTATION			SHEET NO. S-11
DATE	DESCRIPTION	DATE	DESCRIPTION		ROAD NO.	COUNTY	FINANCIAL PROJECT ID	
					SR 93	COLLIER	446320-1-52-01	

SIGNING AND PAVEMENT MARKING PLAN


SIGN NAME	TPK-TOLL6	QTY	1	SIGN NUMBER	238+52
PANEL	BORDER				
WIDTH	15'-0"	WIDTH	2"		
HEIGHT	7'-0"	RADII	11"		
LEGEND	Black	COLOR	Black		
COLOR	White				
SYMBOL(S)	ANGLE	X	Y	WID	HT
SIGN NUMBER	NUMBER OF POSTS	CLEARANCE Edge of Lane	COLUMN SIZE	AVERAGE LENGTH	
GM-1	2	40' EOTL	W8X18	18.67'	

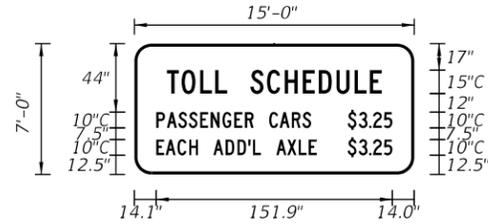

NO. OF LIGHT FIXTURES	FIXTURE SPACING	PHOTOMETRIC CURVE	WATT	VOLTAGE

COPY	T	O	L	L	S	C	H	E	D	U	L	E	L											
SPACE	20.8	9.5	11.9	9.8	7.7	15	10.7	11.4	11.7	10.2	11.4	11.7	9.8	7.7	20.7	138.5								
COPY	P	A	S	S	E	N	G	E	R	C	A	R	S	S	3	2	5			L				
SPACE	14.1	6.8	7.3	6.8	7.3	6.8	7.6	7.6	6.8	5.6	10	6.8	7.8	6.8	5.6	23.6	7.1	6.6	2.6	6.8	5.6	14.0	151.9	
COPY	E	A	C	H	A	D	D	L	A	X	L	E	S	3	2	5								
SPACE	14.1	6	7.6	7.6	5.6	10	7.8	7.6	6.9	3.1	5.1	10	7	7.3	6.5	5.1	20	7.1	6.6	2.6	6.8	5.6	14.0	
COPY																								L
SPACE																								151.9
COPY																								
SPACE																								
COPY																								
SPACE																								

SIGN NAME	TPK-VI	QTY	1	SIGN NUMBER	248+17
PANEL	BORDER				
WIDTH	16'-0"	WIDTH	2"		
HEIGHT	5'-0"	RADII	8"		
LEGEND	Black	COLOR	Black		
COLOR	White				
SYMBOL(S)	ANGLE	X	Y	WID	HT
SIGN NUMBER	NUMBER OF POSTS	CLEARANCE Edge of Lane	COLUMN SIZE	AVERAGE LENGTH	
GM-3	2	40' EOTL	W8X18	16.47'	

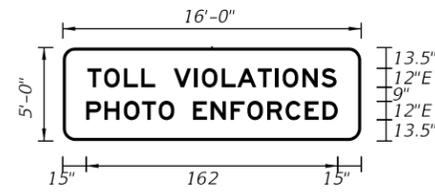


NO. OF LIGHT FIXTURES	FIXTURE SPACING	PHOTOMETRIC CURVE	WATT	VOLTAGE

COPY	T	O	L	L	V	I	O	L	A	T	I	O	N	S	L									
SPACE	16	10.7	12.8	11	9	12	13.1	4.9	12.8	10	13.2	11	4.9	12.8	12.1	9.7	16	160						
COPY	P	H	O	T	O	E	N	F	O	R	C	E	D	L										
SPACE	15	11.8	12.5	11.8	10.7	10.1	12	11.4	12.8	10.7	12.8	11.8	12.5	11.4	9.7	15	162							
COPY																								
SPACE																								
COPY																								
SPACE																								
COPY																								
SPACE																								

REVISIONS			
DATE	DESCRIPTION	DATE	DESCRIPTION

BHARATHI CHIGURUPATI, P.E.
P.E. LICENSE NUMBER 84860
DRMP, INC.
941 LAKE BALDWIN LANE
ORLANDO, FLORIDA 32814


SIGN NAME	101	QTY	1	SIGN NUMBER	STATION(S)
PANEL	BORDER				STA. 240+36
WIDTH	21'-0"	WIDTH	2"		
HEIGHT	9'-0"	RADII	12"		
LEGEND	White	COLOR	White		
COLOR	Green/ Brown				
SYMBOL(S)	ANGLE	X	Y	WID	HT
SIGN NUMBER	NUMBER OF POSTS	CLEARANCE Edge of Lane	COLUMN SIZE	AVERAGE LENGTH	
GM-2	2	40' EOTL	W10X33	20.98'	

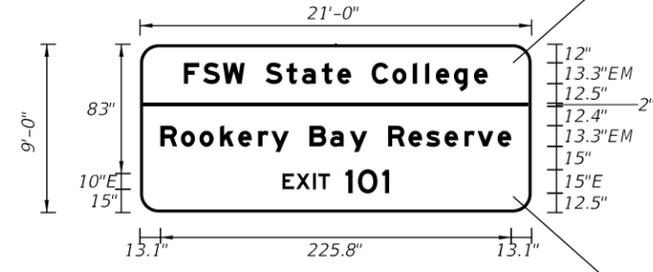

NO. OF LIGHT FIXTURES	FIXTURE SPACING	PHOTOMETRIC CURVE	WATT	VOLTAGE

COPY	F	S	W	S	t	a	t	e	C	o	l	i	e	g	e	L								
SPACE	28.2	12.2	12.8	14.1	13.3	13.6	10	12.8	10	8.8	13.3	13.3	13.2	8	6.8	11.7	12.9	8.8	28.2	195.6				
COPY	R	o	o	k	e	r	y	B	a	y	R	e	s	e	r	v	e	L						
SPACE	13.1	13.2	12	13.2	11.7	12.9	8.4	11.3	13.3	13.3	12.6	11.3	13.3	13.2	11.4	11.7	12.9	8.4	12.9	8.8	13.1	225.8		
COPY	E	X	I	T	I	O	I	L																
SPACE	91.7	8.9	10.7	3.5	7.5	10	7.9	15.6	4.5	91.7	68.6													
COPY																								
SPACE																								
COPY																								
SPACE																								

SIGN NAME	TPK-A52	QTY	2	SIGN NUMBER	STATION(S)
PANEL	BORDER				Existing Truss
WIDTH	16'-6"	WIDTH	2"		Existing Cantilever
HEIGHT	9'-0"	RADII	12"		
LEGEND	Black	COLOR	White/Black		
COLOR	Green/ Yellow				
SYMBOL(S)	ANGLE	X	Y	WID	HT
SunPassLarge	0	60	57	78	28
LogoPanelLarge	0	51	48	96	46
W13-1	0	7.9	7.1	24	24
W13-1	0	166.1	7.1	24	24
SIGN NUMBER	NUMBER OF POSTS	CLEARANCE Edge of Lane	COLUMN SIZE	AVERAGE LENGTH	

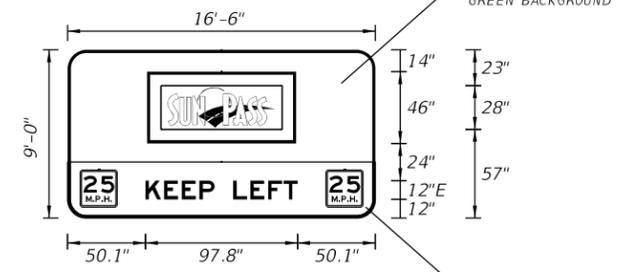

NO. OF LIGHT FIXTURES	FIXTURE SPACING	PHOTOMETRIC CURVE	WATT	VOLTAGE

COPY	K	E	E	P	L	E	F	T	L										
SPACE	50.1	11.9	11.4	11.4	9.7	12	11	11.4	10	9	50.1	97.8							
COPY																			
SPACE																			
COPY																			
SPACE																			
COPY																			
SPACE																			
COPY																			
SPACE																			

REVISIONS			
DATE	DESCRIPTION	DATE	DESCRIPTION

STATE OF FLORIDA
DEPARTMENT OF TRANSPORTATION

ROAD NO.	COUNTY	FINANCIAL PROJECT ID
SR 93	COLLIER	446320-1-52-01

GUIDE SIGN WORKSHEET (1)


SHEET NO.
S-12

2/14/2022 12:25:32 PM MHammosh C:\Users\mhammosh\OneDrive - DRMP, Inc.\Projects\Worksets\FDOT\20-446320-1-5201\Signing\Marking\GSWKSPO1.dgn

THE OFFICIAL RECORD OF THIS SHEET IS THE ELECTRONIC FILE DIGITALLY SIGNED AND SEALED UNDER RULE 61G15-23.004, F.A.C.

2/14/2022 12:25:46 PM MHammosh C:\Users\mhammosh\OneDrive - DRMP, Inc.\Projects\Worksets\FDOT\20-4463201-5201\SigningAndMarking\G5WKSPO1.dgn

SIGN NAME	TPK-FINE	QTY	1	SIGN NUMBER		STATION(S)	
PANEL	BORDER					302+91	
WIDTH	10'-0"	WIDTH	1.5"				
HEIGHT	6'-0"	RADII	9"				
LEGEND	Black	COLOR	Black				
COLOR	White						
SYMBOL(S)	ANGLE	X	Y	WID	HT		
SIGN NUMBER	NUMBER OF POSTS	CLEARANCE Edge Of Lane	COLUMN SIZE	AVERAGE LENGTH			
GM-8	2	5' FOGR	W6X12	15.29'			

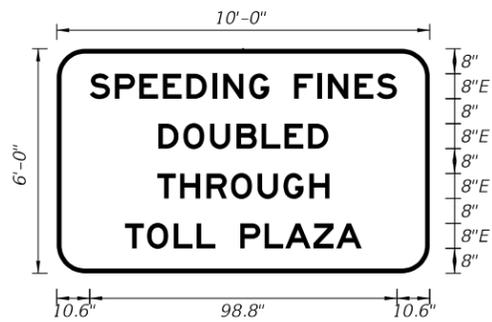

NO. OF LIGHT FIXTURES	FIXTURE SPACING	PHOTOMETRIC CURVE	WATT	VOLTAGE

COPY		S	P	E	E	D	I	N	G	F	I	N	E	S	L		
SPACE	10.6	8.1	7.8	7.6	7.6	8.3	3.5	8.3	6.5	8	7.4	3.5	8.6	7.1	6.5	10.6	98.8
COPY		D	O	U	B	L	E	D	L								
SPACE	32.6	8.1	8.6	8.6	8.1	7.4	7.6	6.5	32.5	54.9							
COPY		T	H	R	O	U	G	H	L								
SPACE	32.3	7.4	8.6	7.8	8.6	8.3	8.3	6.5	32.2	55.5							
COPY		T	O	L	L	P	L	A	Z	A	L						
SPACE	22	7.1	8.6	7.4	6	8	7.8	6.6	9	7.4	8.2	21.9	76.1				
COPY																	
SPACE																	
COPY																	
SPACE																	

SIGN NAME		QTY		SIGN NUMBER		STATION(S)	
PANEL	BORDER						
WIDTH	WIDTH						
HEIGHT	RADII						
LEGEND	COLOR						
COLOR							
SYMBOL(S)	ANGLE	X	Y	WID	HT		
SIGN NUMBER	NUMBER OF POSTS	CLEARANCE Edge Of Lane	COLUMN SIZE	AVERAGE LENGTH			

NOT USED

NO. OF LIGHT FIXTURES	FIXTURE SPACING	PHOTOMETRIC CURVE	WATT	VOLTAGE

COPY																	
SPACE																	
COPY																	
SPACE																	
REVISIONS			
-----------	--	--	--

DATE	DESCRIPTION	DATE	DESCRIPTION

BHARATHI CHIGURUPATI, P.E.
P.E. LICENSE NUMBER 84860
DRMP, INC.
941 LAKE BALDWIN LANE
ORLANDO, FLORIDA 32814

SIGN NAME	RB-1RW	QTY	2	SIGN NUMBER		STATION(S)	
PANEL	BORDER					243+35	
WIDTH	4'-0"	WIDTH	1.25"			246+36	
HEIGHT	5'-0"	RADII	3"				
LEGEND	Red	COLOR	Red				
COLOR	White						
SYMBOL(S)	ANGLE	X	Y	WID	HT		
SIGN NUMBER	NUMBER OF POSTS	CLEARANCE Edge Of Lane	COLUMN SIZE	AVERAGE LENGTH			



NO. OF LIGHT FIXTURES	FIXTURE SPACING	PHOTOMETRIC CURVE	WATT	VOLTAGE

COPY		N	O	L													
SPACE	16.8	8.1	6.4	16.7	14.5												
COPY		P	A	R	K	I	N	G	L								
SPACE	3.4	6.1	7	6.6	6.6	3.2	6.8	5	3.3	41.3							
COPY		O	N	R	I	G	H	T	L								
SPACE	8.5	4.7	3.4	5	4.3	1.9	4.5	4.2	3.1	8.4	31.1						
COPY		O	F	W	A	Y	L										
SPACE	10.9	4.6	3.1	5	4.8	4.5	4.3	10.8	26.3								
COPY																	
SPACE																	
COPY																	
SPACE																	

SIGN NAME		QTY		SIGN NUMBER		STATION(S)	
PANEL	BORDER						
WIDTH	WIDTH						
HEIGHT	RADII						
LEGEND	COLOR						
COLOR							
SYMBOL(S)	ANGLE	X	Y	WID	HT		
SIGN NUMBER	NUMBER OF POSTS	CLEARANCE Edge Of Lane	COLUMN SIZE	AVERAGE LENGTH			

NOT USED

NO. OF LIGHT FIXTURES	FIXTURE SPACING	PHOTOMETRIC CURVE	WATT	VOLTAGE

COPY																	
SPACE																	
COPY																	
SPACE																	
REVISIONS			
-----------	--	--	--


STATE OF FLORIDA DEPARTMENT OF TRANSPORTATION		
ROAD NO.	COUNTY	FINANCIAL PROJECT ID
SR 93	COLLIER	446320-1-52-01

GUIDE SIGN WORKSHEET (4)

SHEET NO. S-15

THE OFFICIAL RECORD OF THIS SHEET IS THE ELECTRONIC FILE DIGITALLY SIGNED AND SEALED UNDER RULE 61G15-23.004, F.A.C.

2/14/2022 12:27:09 PM C:\USERS\HAMMOSH\ONE DRIVE - DRMP, INC\PROJECTS\WORKSETS\FDOT\20\44632015201\SIGNING\MARKING\RDYSSP01.DGN

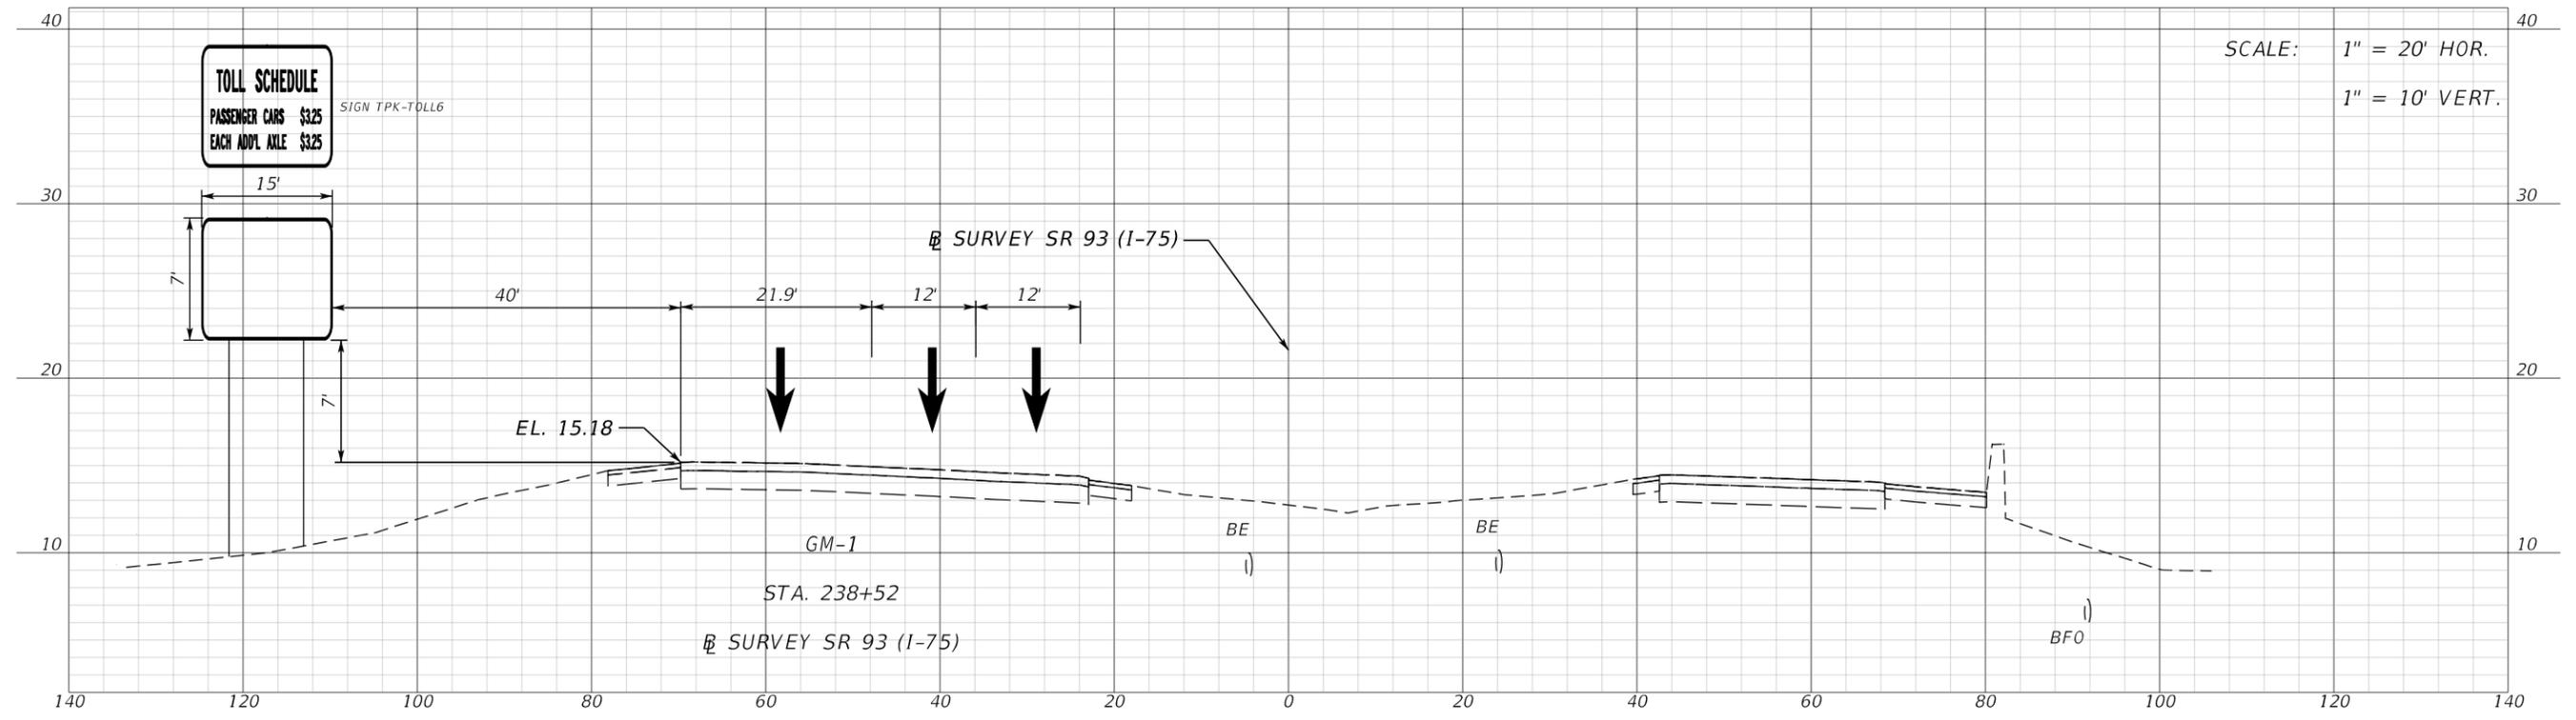


SCALE: 1" = 20' HOR.
1" = 10' VERT.

REVISIONS				BHARATHI CHIGURUPATI, P.E. P.E. LICENSE NUMBER 84860 DRMP, INC. 941 LAKE BALDWIN LANE ORLANDO, FLORIDA 32814	STATE OF FLORIDA DEPARTMENT OF TRANSPORTATION			SIGN CROSS SECTION	SHEET NO.
DATE	DESCRIPTION	DATE	DESCRIPTION		ROAD NO.	COUNTY	FINANCIAL PROJECT ID		S-16
					SR 93	COLLIER	446320-1-52-01		

THE OFFICIAL RECORD OF THIS SHEET IS THE ELECTRONIC FILE DIGITALLY SIGNED AND SEALED UNDER RULE 61G15-23.004, F.A.C.

2/14/2022 12:27:17 PM C:\USERS\HAMMOSH\ONE DRIVE - DRMP, INC\PROJECTS\WORKSETS\FDOT\20\44632015201\SIGNING\MARKING\RDYSSP01.DGN

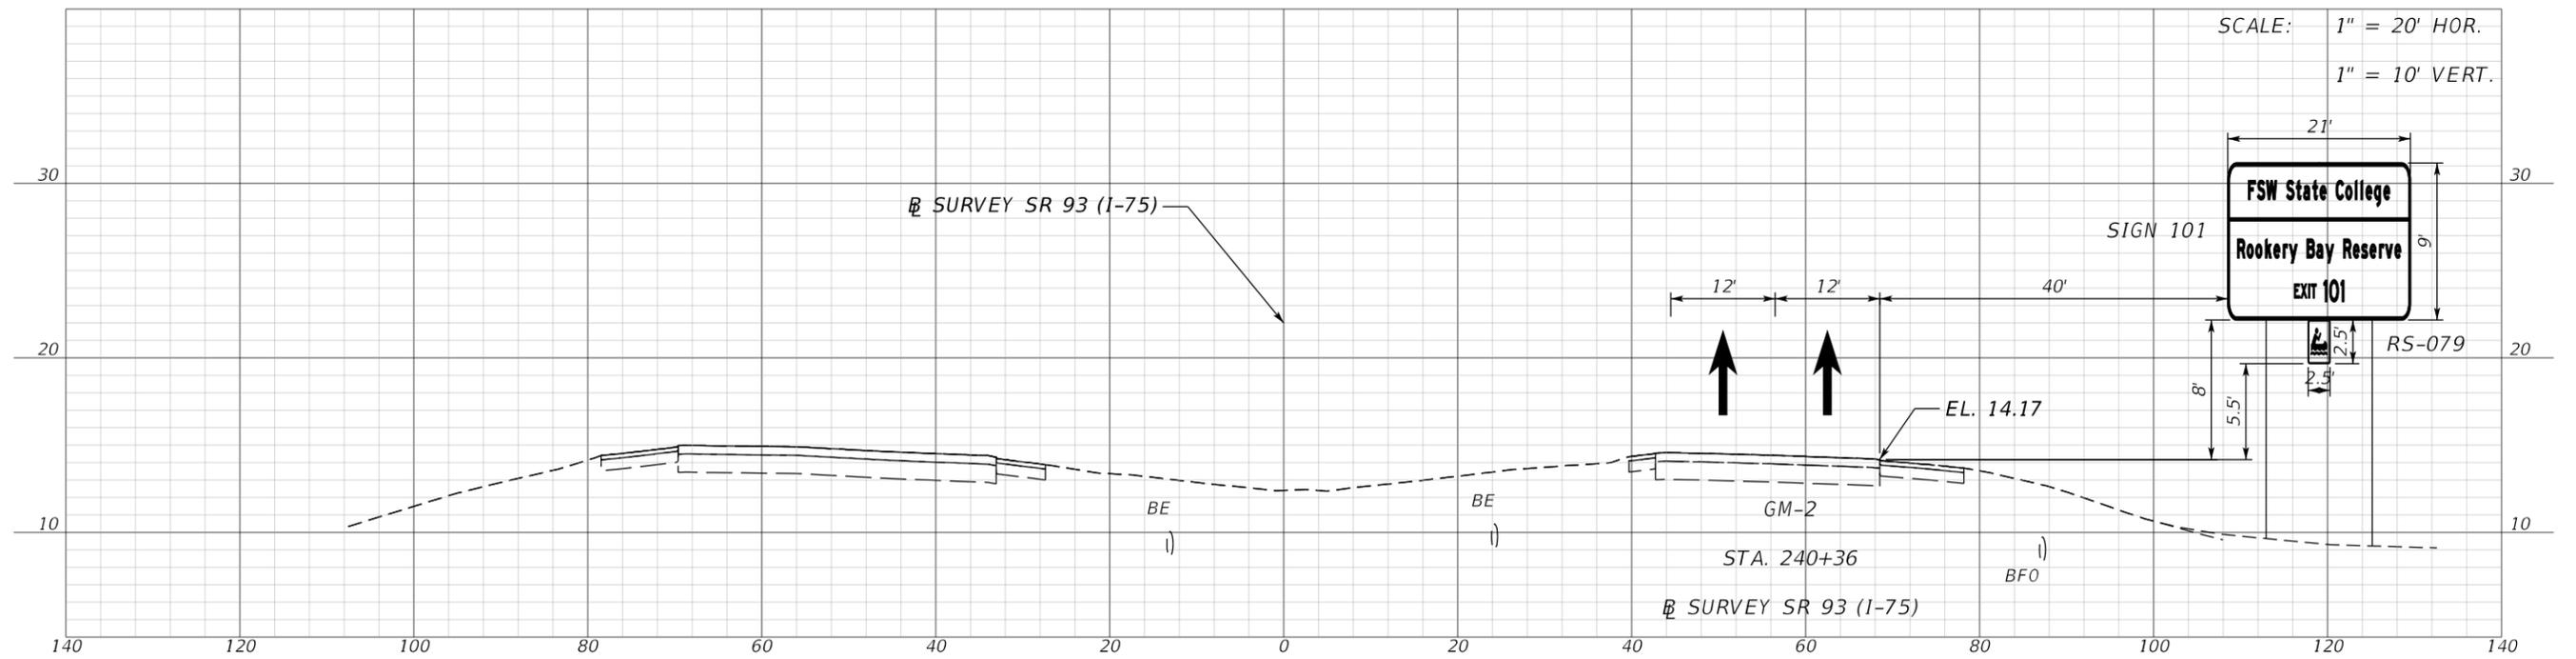

REVISIONS			
DATE	DESCRIPTION	DATE	DESCRIPTION

BHARATHI CHIGURUPATI, P.E.
P.E. LICENSE NUMBER 84860
DRMP, INC.
941 LAKE BALDWIN LANE
ORLANDO, FLORIDA 32814


STATE OF FLORIDA DEPARTMENT OF TRANSPORTATION		
ROAD NO.	COUNTY	FINANCIAL PROJECT ID
SR 93	COLLIER	446320-1-52-01

SIGN CROSS SECTION

SHEET NO.
S-17

THE OFFICIAL RECORD OF THIS SHEET IS THE ELECTRONIC FILE DIGITALLY SIGNED AND SEALED UNDER RULE 61G15-23.004, F.A.C.

2/14/2022 12:27:21 PM P:\WORKSETS\FDOT20-44632015201\SIGNING\MARKING\RD\XSSP01.DGN

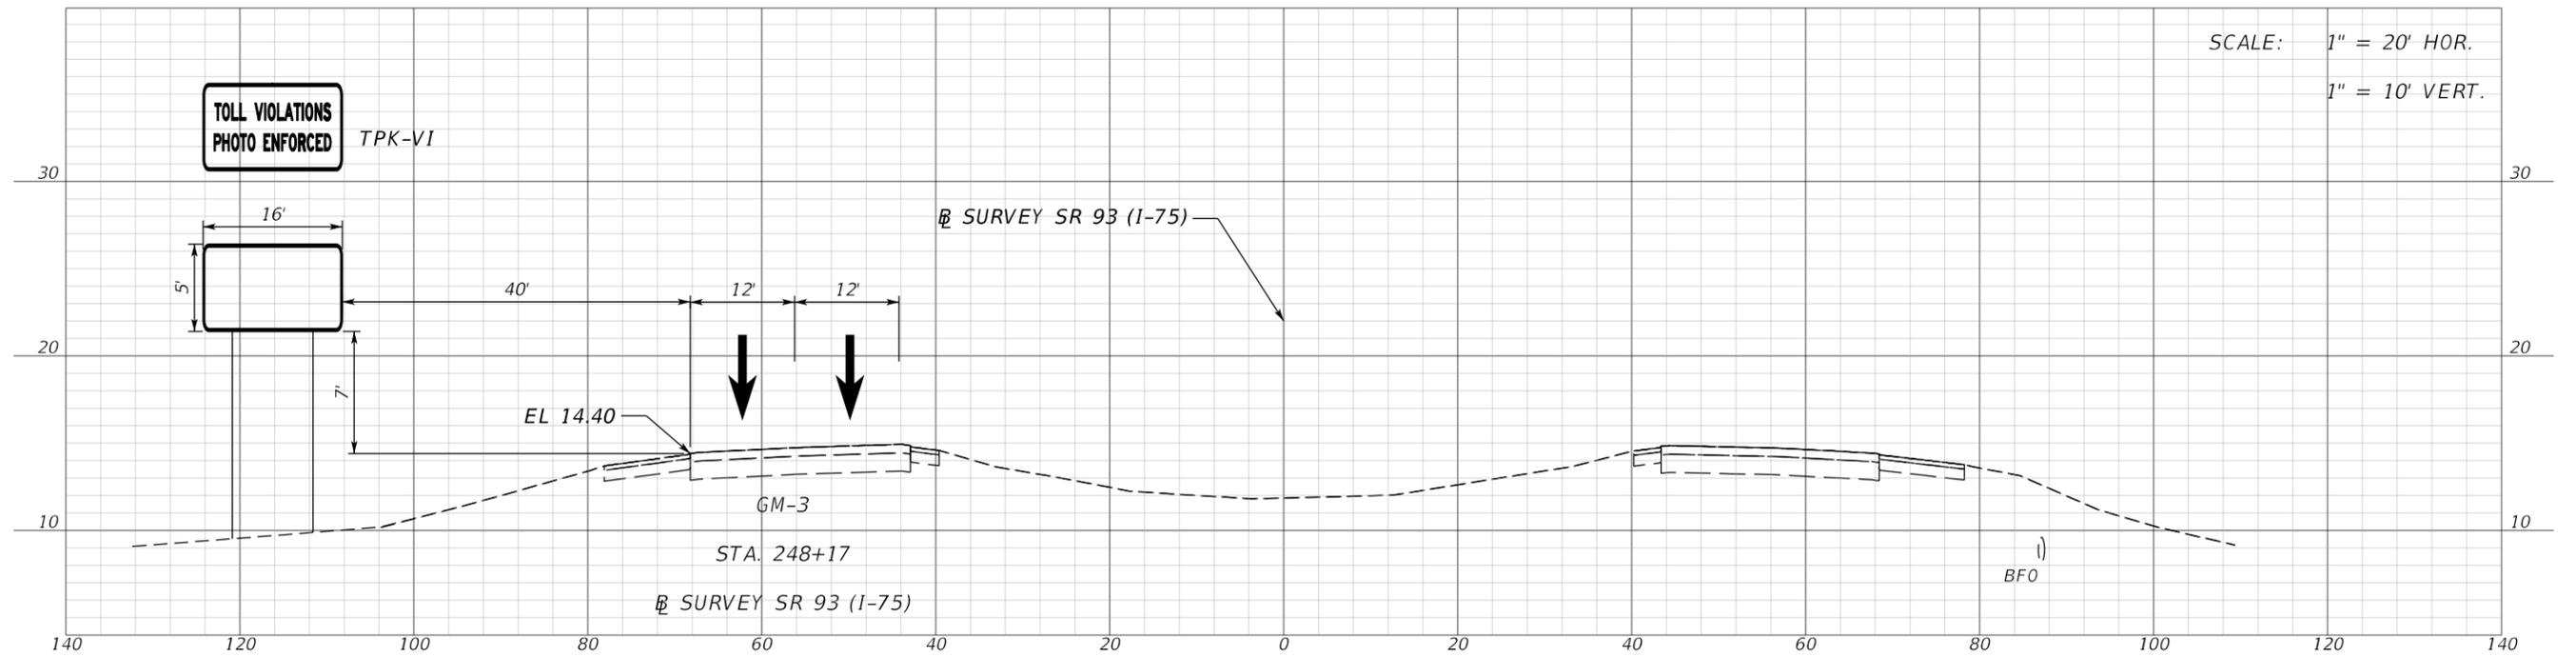

REVISIONS			
DATE	DESCRIPTION	DATE	DESCRIPTION

BHARATHI CHIGURUPATI, P.E.
P.E. LICENSE NUMBER 84860
DRMP, INC.
941 LAKE BALDWIN LANE
ORLANDO, FLORIDA 32814


STATE OF FLORIDA DEPARTMENT OF TRANSPORTATION		
ROAD NO.	COUNTY	FINANCIAL PROJECT ID
SR 93	COLLIER	446320-1-52-01

SIGN CROSS SECTION

SHEET NO.
S-18

THE OFFICIAL RECORD OF THIS SHEET IS THE ELECTRONIC FILE DIGITALLY SIGNED AND SEALED UNDER RULE 61G15-23.004, F.A.C.

2/14/2022 12:27:29 PM C:\USERS\BCHIGURUPATI\ONE DRIVE - DRMP, INC\WORKSETS\FDOT\2044632015201\SIGNING\ANDMARKING\RD\X5SP01.DGN

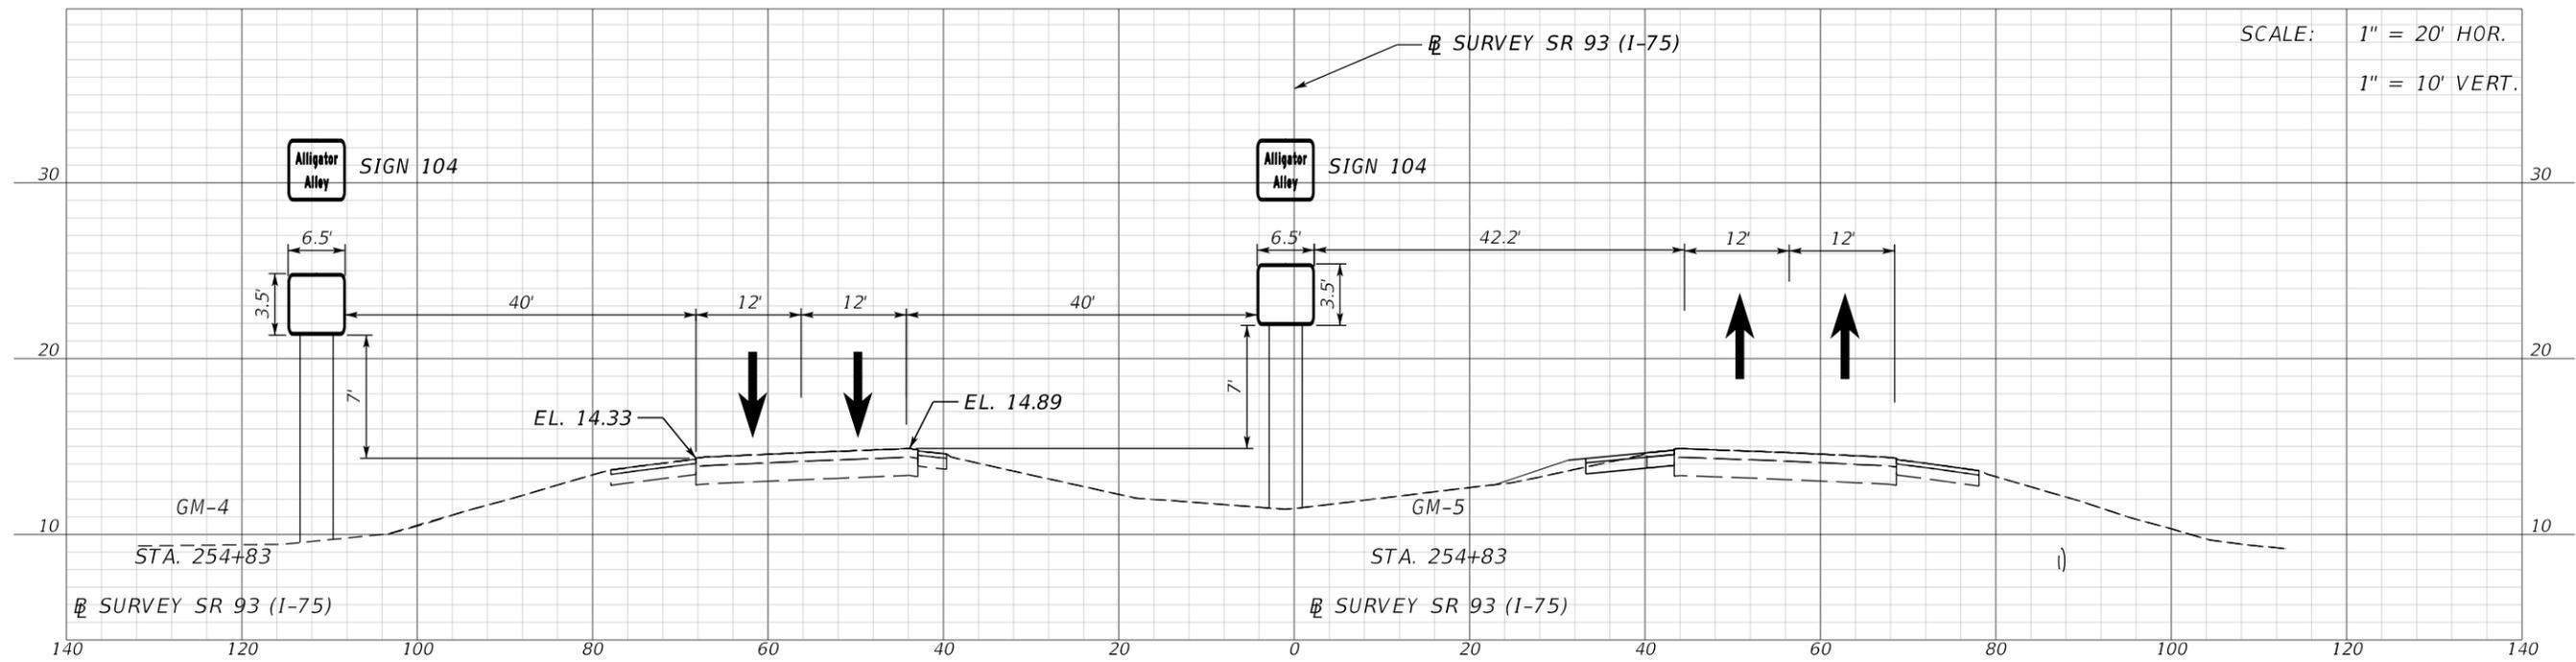

REVISIONS			
DATE	DESCRIPTION	DATE	DESCRIPTION

BHARATHI CHIGURUPATI, P.E.
 P.E. LICENSE NUMBER 84860
 DRMP, INC.
 941 LAKE BALDWIN LANE
 ORLANDO, FLORIDA 32814


STATE OF FLORIDA DEPARTMENT OF TRANSPORTATION		
ROAD NO.	COUNTY	FINANCIAL PROJECT ID
SR 93	COLLIER	446320-1-52-01

SIGN CROSS SECTION

SHEET NO.
 S-19

THE OFFICIAL RECORD OF THIS SHEET IS THE ELECTRONIC FILE DIGITALLY SIGNED AND SEALED UNDER RULE 61G15-23.004, F.A.C.

2/14/2022 12:27:37 PM C:\USERS\HAMMOSH\ONE DRIVE - DRMP, INC\PROJECTS\WORKSETS\FDOT\20\44632015201\SIGNING\MARKING\RDY\SSP01.DGN

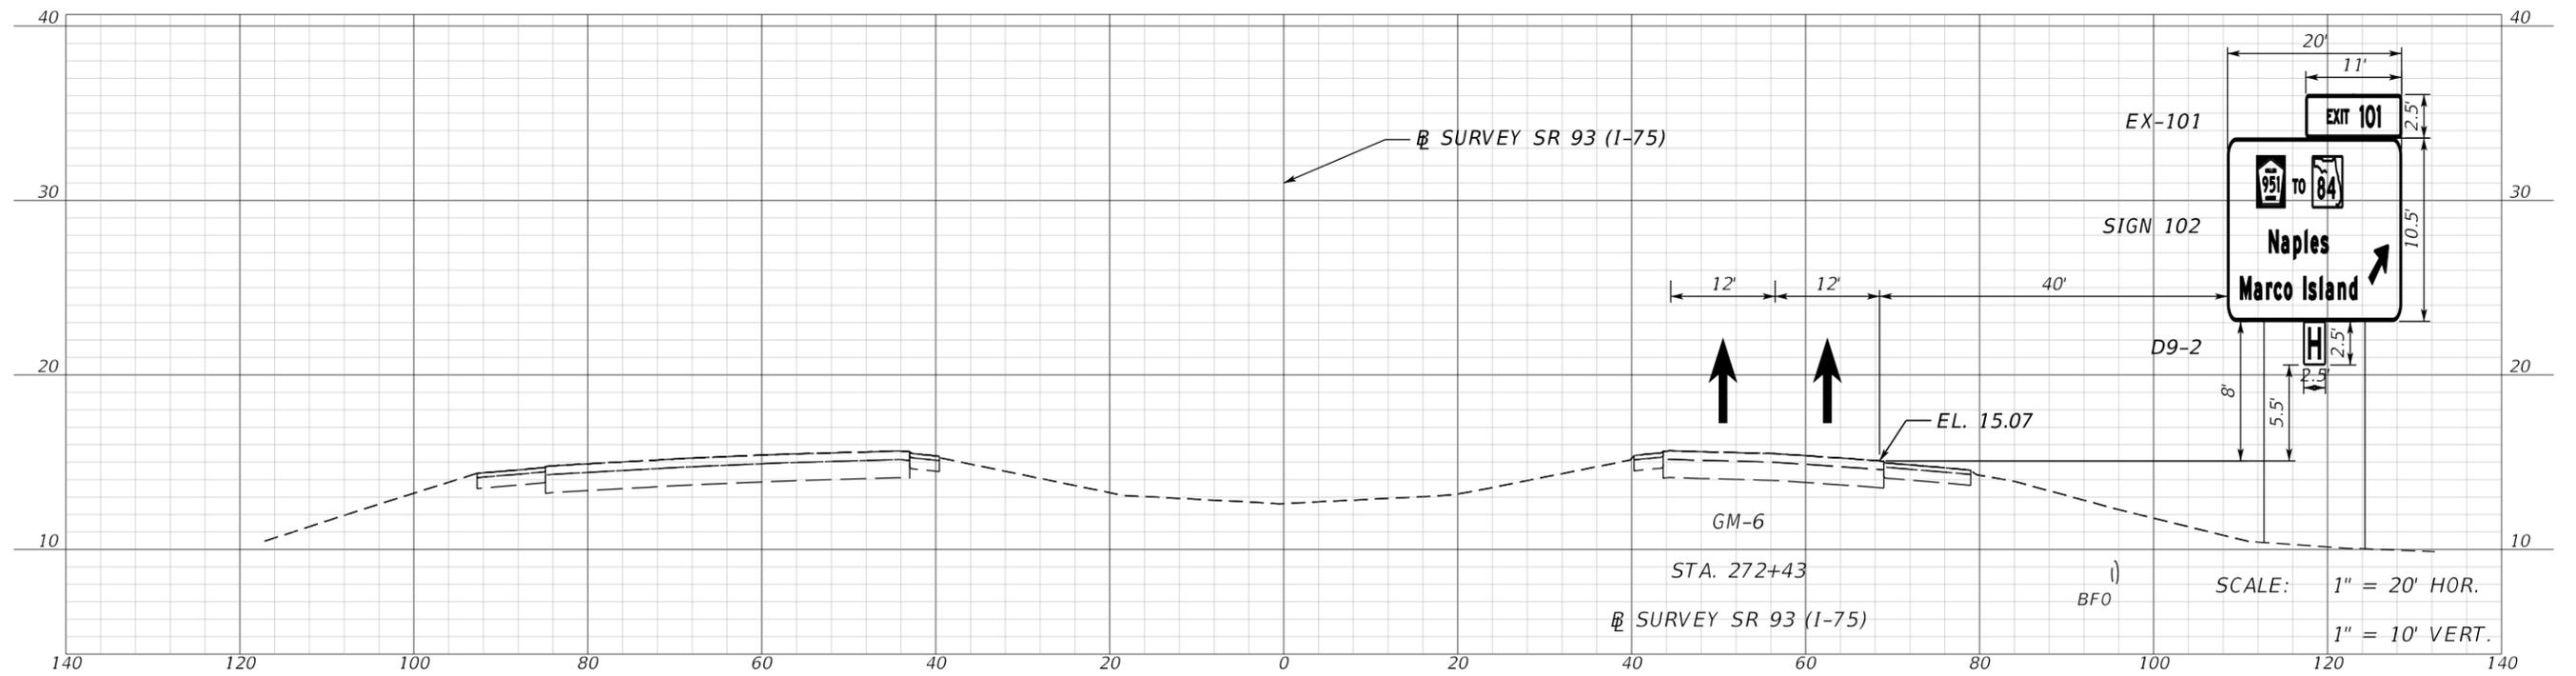

REVISIONS			
DATE	DESCRIPTION	DATE	DESCRIPTION


BHARATHI CHIGURUPATI, P.E.
 P.E. LICENSE NUMBER 84860
 DRMP, INC.
 941 LAKE BALDWIN LANE
 ORLANDO, FLORIDA 32814

STATE OF FLORIDA DEPARTMENT OF TRANSPORTATION		
ROAD NO.	COUNTY	FINANCIAL PROJECT ID
SR 93	COLLIER	446320-1-52-01

SIGN CROSS SECTION

SHEET NO.
S-20

2/14/2022 12:27:45 PM C:\USERS\BCHIGURUPATI\ONE DRIVE - DRMP, INC\WORKSETS\FDOT\2044632015201\SIGNING\MARKING\RD\XSSP01.DGN

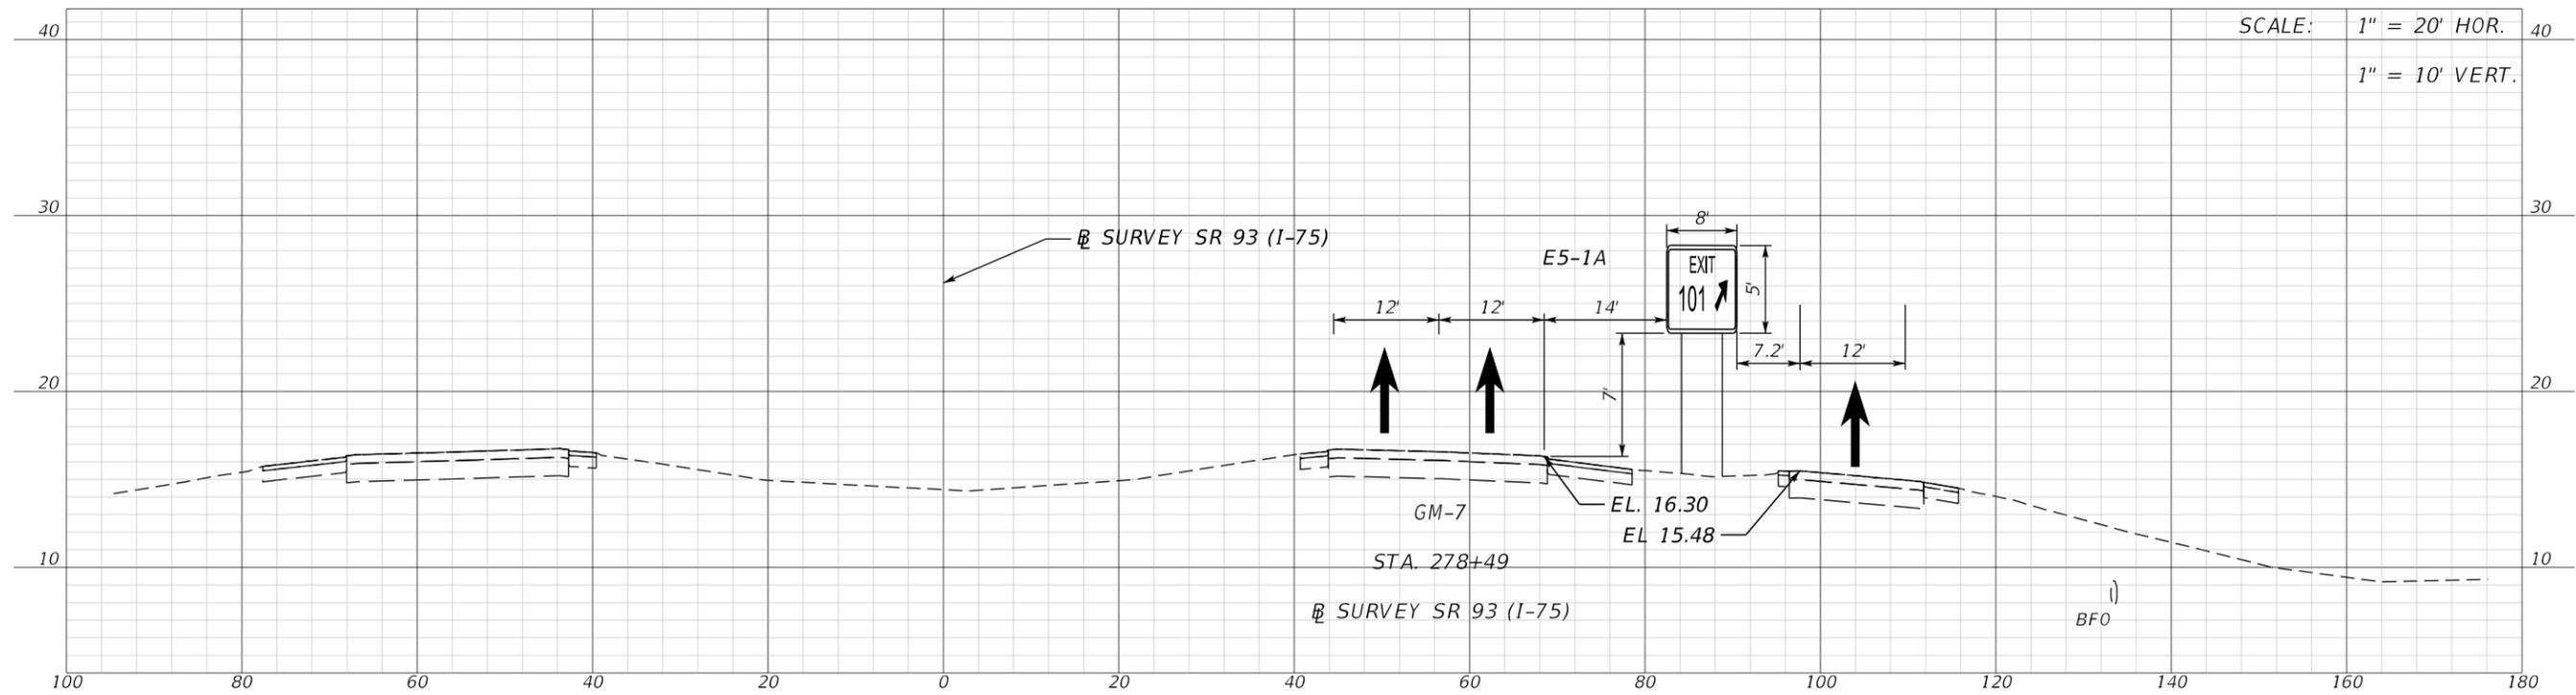

SCALE: 1" = 20' HOR.
1" = 10' VERT.

REVISIONS			
DATE	DESCRIPTION	DATE	DESCRIPTION

BHARATHI CHIGURUPATI, P.E.
 P.E. LICENSE NUMBER 84860
 DRMP, INC.
 941 LAKE BALDWIN LANE
 ORLANDO, FLORIDA 32814


STATE OF FLORIDA DEPARTMENT OF TRANSPORTATION		
ROAD NO.	COUNTY	FINANCIAL PROJECT ID
SR 93	COLLIER	446320-1-52-01

SIGN CROSS SECTION

SHEET NO.
S-21

THE OFFICIAL RECORD OF THIS SHEET IS THE ELECTRONIC FILE DIGITALLY SIGNED AND SEALED UNDER RULE 61G15-23.004, F.A.C.

2/14/2022 12:27:53 PM C:\USERS\BCHIGURUPATI\ONE DRIVE - DRMP, INC\WORKSETS\FDOT\204463201\5201\SIGNING\MARKING\RD\XSSP01.DGN

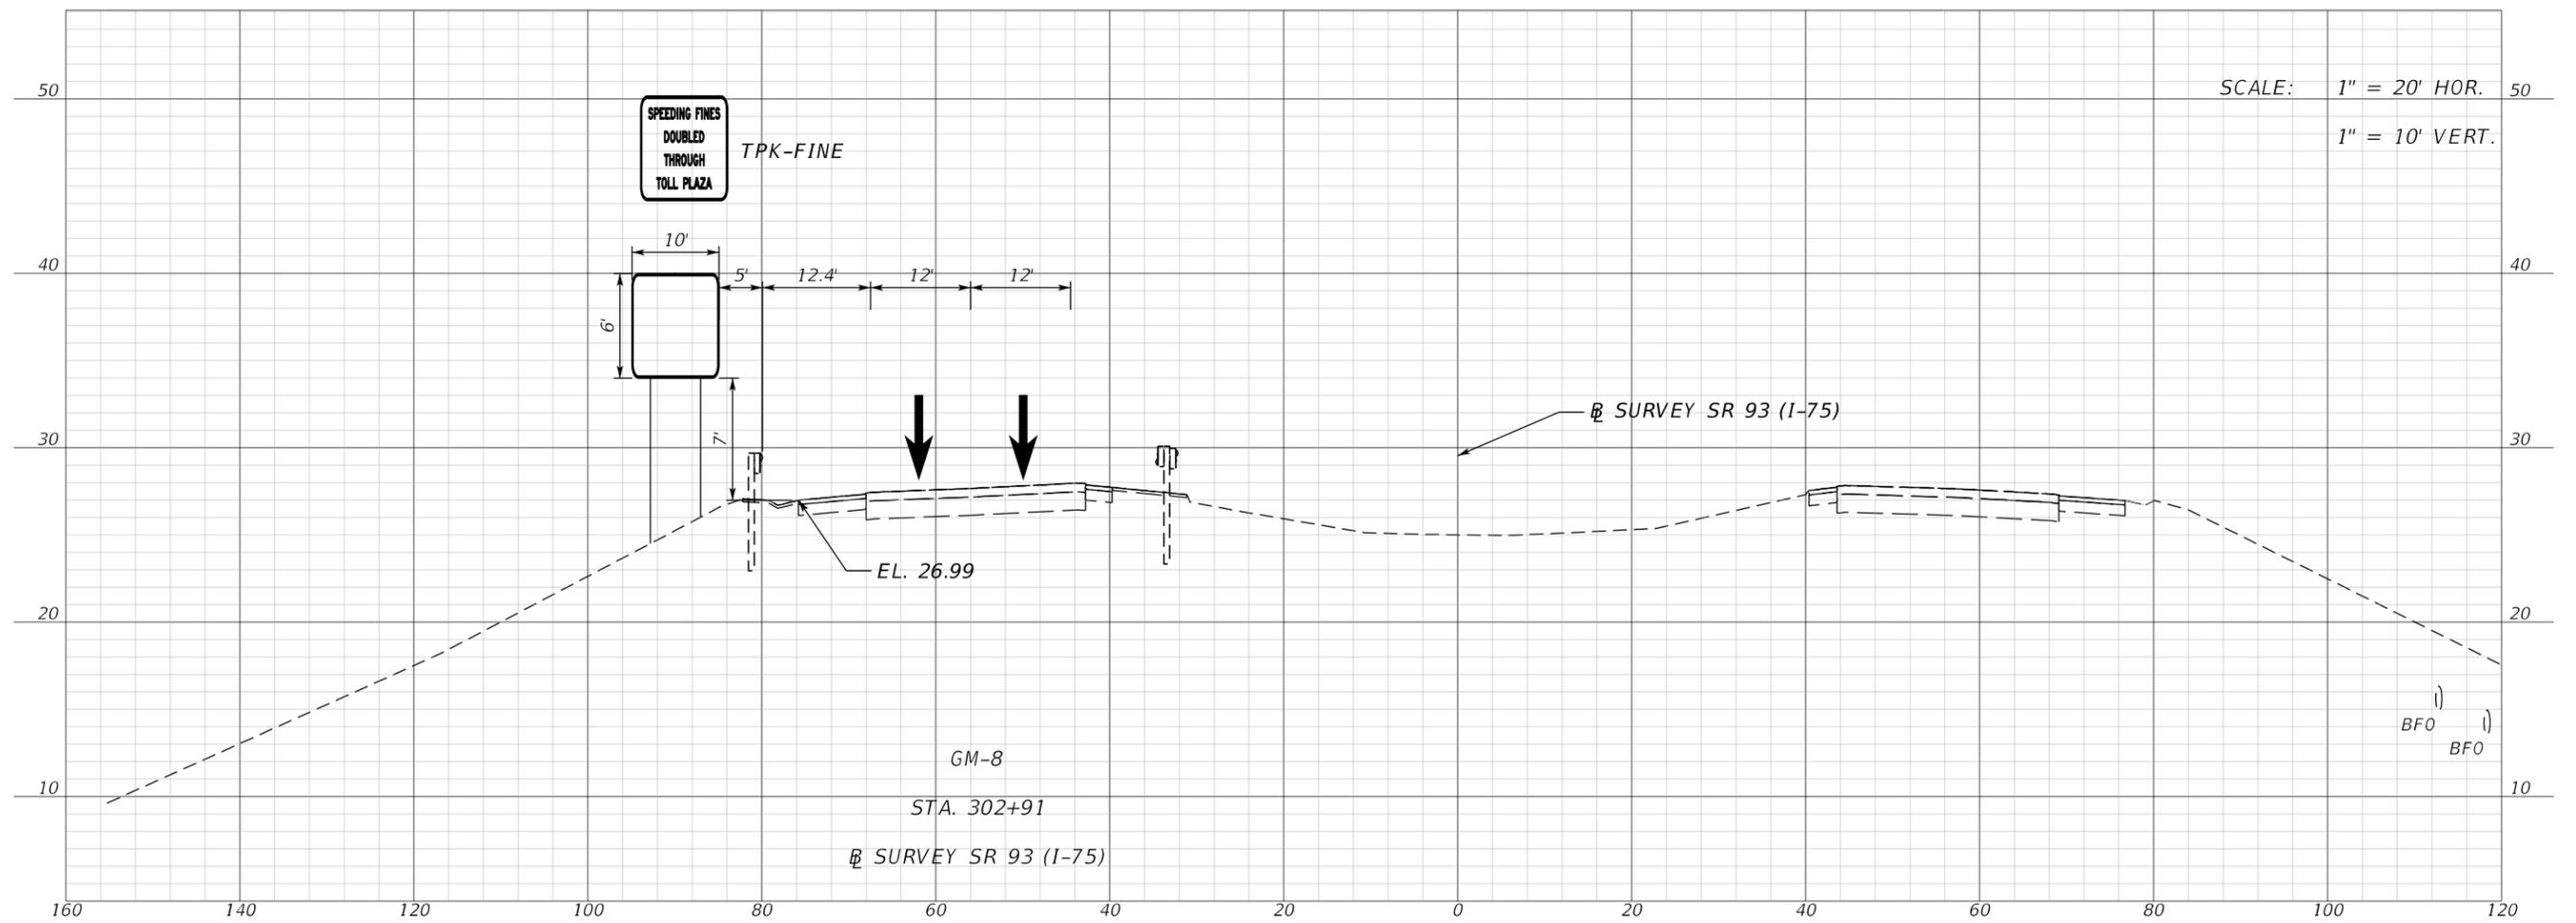

SCALE: 1" = 20' HOR.
1" = 10' VERT.

REVISIONS				BHARATHI CHIGURUPATI, P.E. P.E. LICENSE NUMBER 84860 DRMP, INC. 941 LAKE BALDWIN LANE ORLANDO, FLORIDA 32814	STATE OF FLORIDA DEPARTMENT OF TRANSPORTATION			SIGN CROSS SECTION	SHEET NO.
DATE	DESCRIPTION	DATE	DESCRIPTION		ROAD NO.	COUNTY	FINANCIAL PROJECT ID		S-22
					SR 93	COLLIER	446320-1-52-01		

THE OFFICIAL RECORD OF THIS SHEET IS THE ELECTRONIC FILE DIGITALLY SIGNED AND SEALED UNDER RULE 61G15-23.004, F.A.C.