
Index 11860 Single Column Ground Sign

ORIGINATION

Date: 07/05/17

Name: Gevin McDaniel

Phone: 850-414-4284

Email: gevin.mcdaniel@dot.state.fl.us

COMMENTARY

Sheet 1: Changed Notes 3 and 4.

Sheet 3: Updated the COLUMN (POST) and FOUNDATION TABLE. Sheet 4: Changed Note 3.D.

Sheet 5: Deleted the CONCRETE/STUB DETAIL; Added DETIAL 'B' Optional Slotted Holes; Changed the Soil Plate Dimension in the ALUMINUM SOIL PLATE DETAIL; Changed the hole diameter to 8" and soil plate width to 7" for DRIVEN POST DETAIL; Added Plan View to the DRIVEN POST DETAIL.

COMMENTS AND RESPONSES

BLACK = Industry Review Comments **RED** = Standard Plans Response

Name: Christian Cummings and John Simms

Date: Monday, September 18, 2017 10:59 AM


COMMENT:

The dimensions of the soil plate on sheet 5 of 9 have been changed to 7" wide, but the diameter of the hole in concrete remains unchanged at 1'6". Is there a reason that the diameter of the hole is still 1'6"? Would the Department consider changing it to 12" now that the smaller soil plate is used?

RESPONSE:


Date 9/18/17

The dimension will be changed to accommodate a range from 8" minimum to 1'-6" maximum.

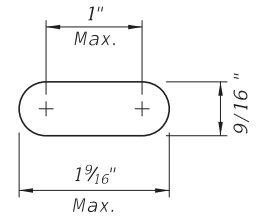


Optional Slotted Holes

DETAIL "B"

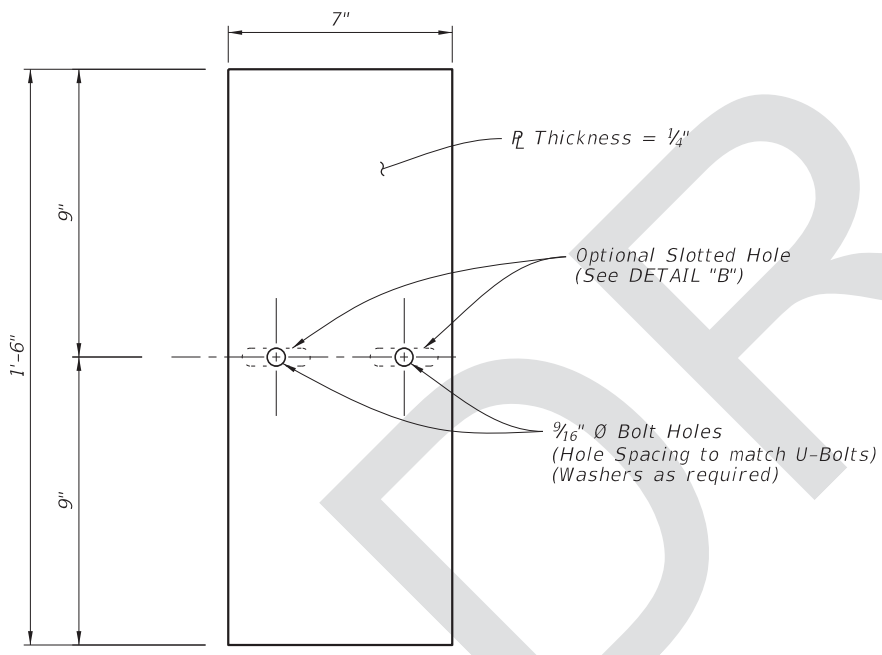


ALUMINUM SOIL PLATE DETAIL

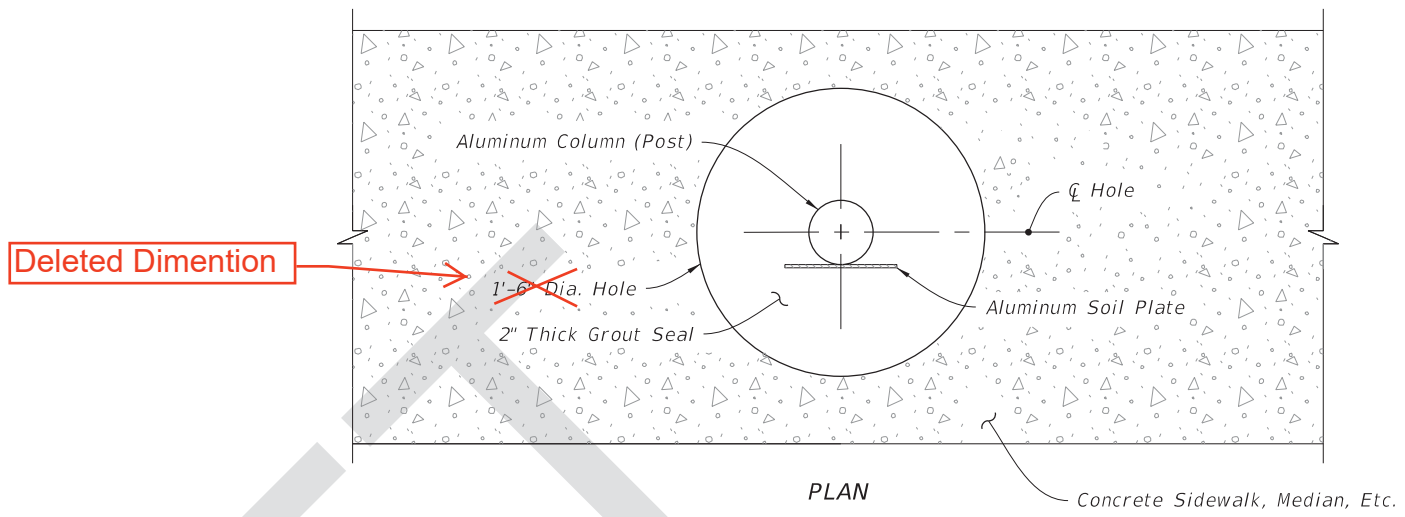

PLAN

Deleted Dimension

Changed to 8" Min., 1'-6" Max.

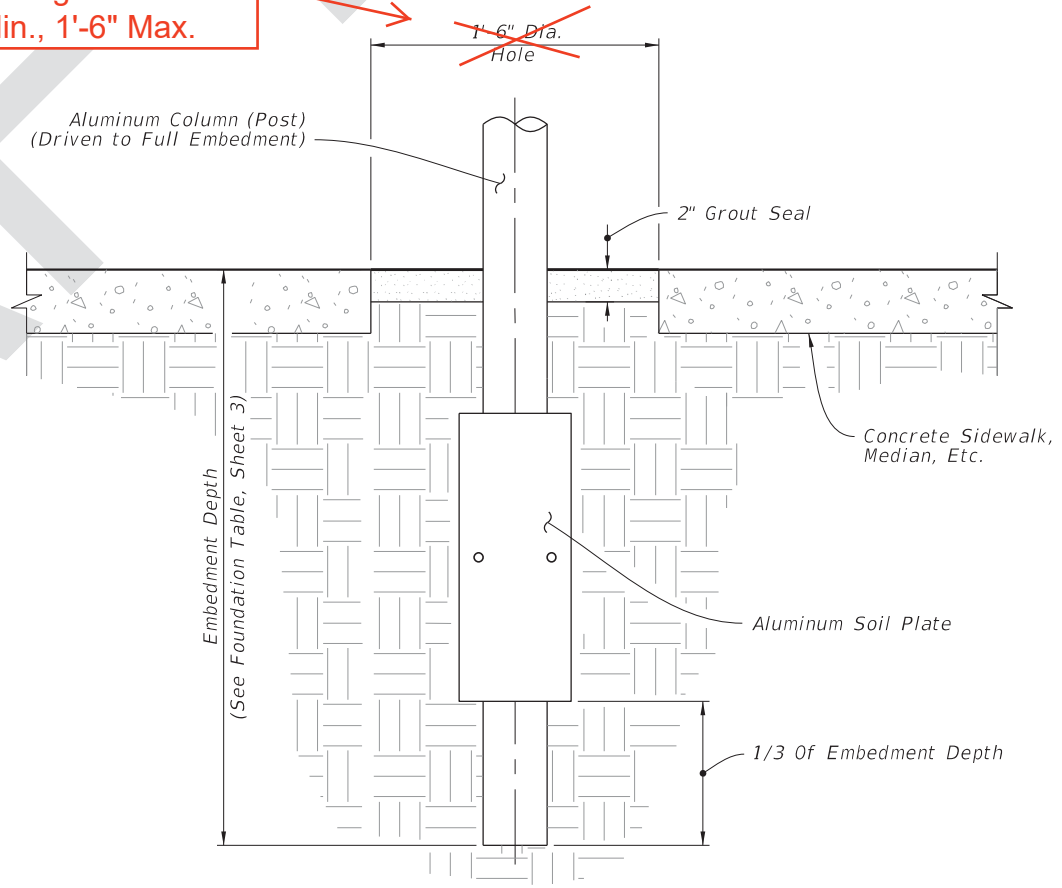

ELEVATION


DRIVEN POST DETAIL

(Frangible Post In Crossovers, Medians & Sidewalks)

DRIVEN POST AND SOIL PLATE DETAIL


8/29/2017 3:37:34 PM

LAST REVISION 11/01/17	REVISION	DESCRIPTION:		FY 2018-19 STANDARD PLANS	SINGLE COLUMN GROUND SIGNS	INDEX 700-010	SHEET 5 of 9
---------------------------	----------	--------------	--	------------------------------	----------------------------	------------------	-----------------

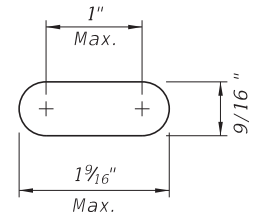


Optional Slotted Holes


DETAIL "B"

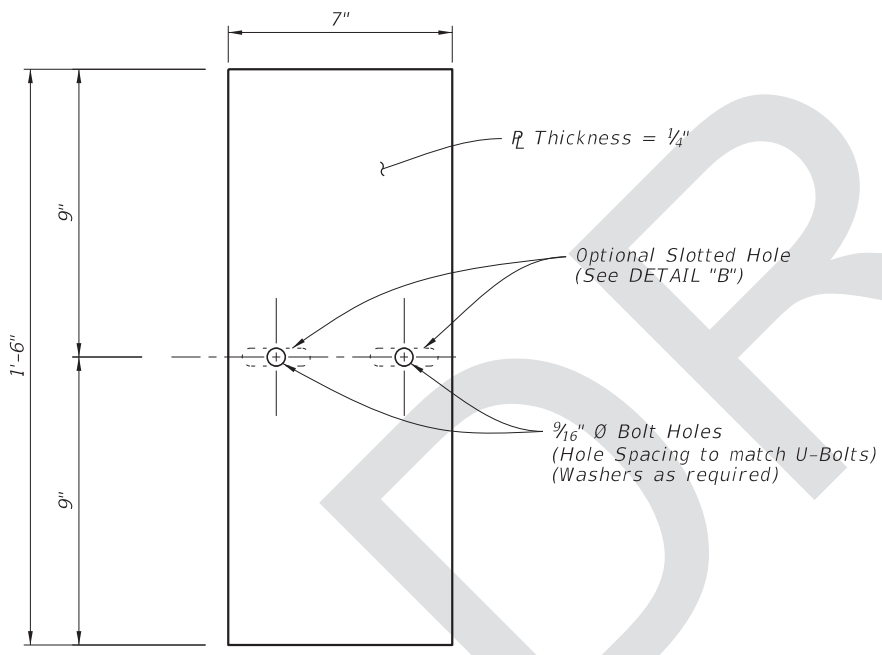

ALUMINUM SOIL PLATE DETAIL

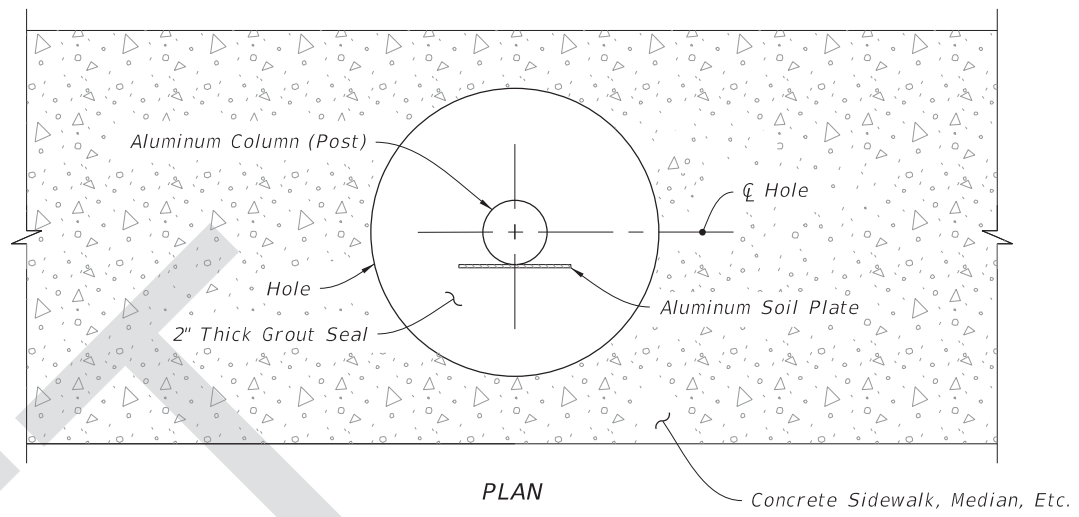

PLAN

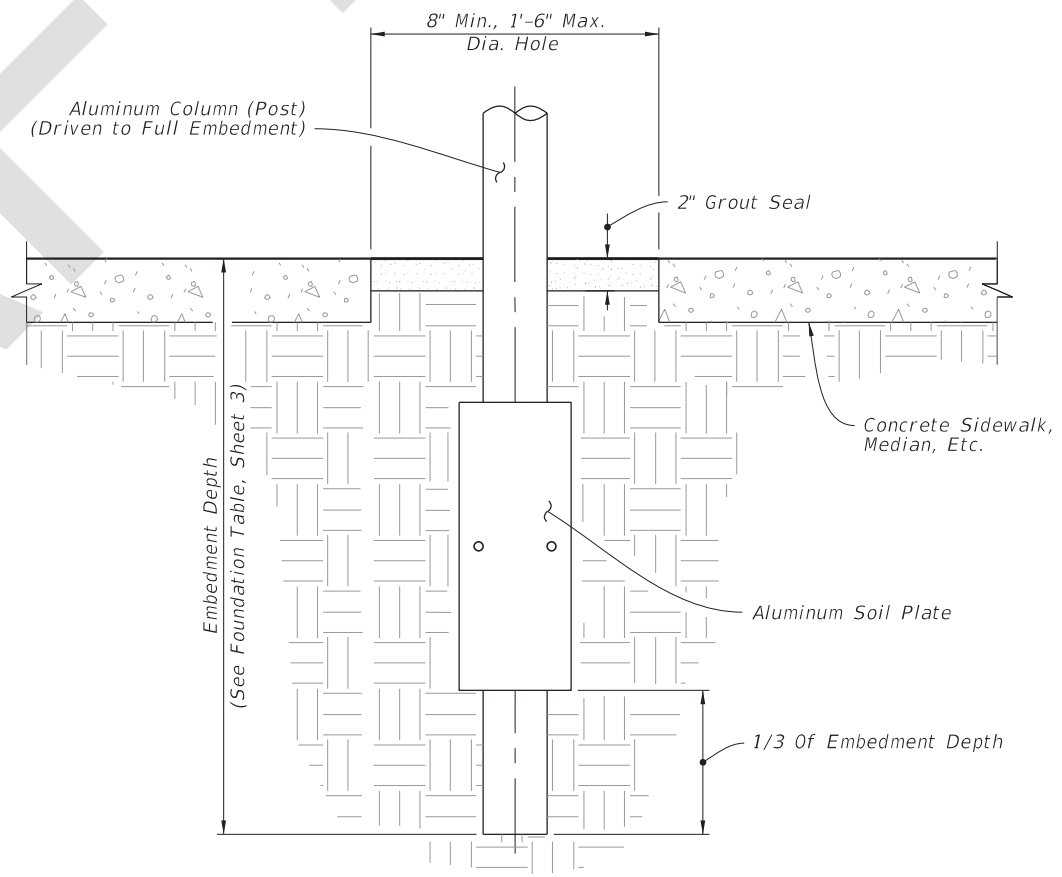

ELEVATION

DRIVEN POST DETAIL

(Frangible Post In Crossovers, Medians & Sidewalks)

DRIVEN POST AND SOIL PLATE DETAIL

9/19/2017 10:35:26 AM

LAST REVISION 11/01/17	REVISION	DESCRIPTION:		FY 2018-19 STANDARD PLANS	SINGLE COLUMN GROUND SIGNS	INDEX 700-010	SHEET 5 of 9
---------------------------	----------	--------------	--	------------------------------	----------------------------	------------------	-----------------