

# ORIGINATION FORM

Proposed Revisions to a Design Standards Index  
(Please provide all information – Incomplete forms will be returned)

## Contact Information:

Date: March 1, 2017  
Originator: **Ed Cashman and Gevin McDaniel**  
Phone: (850) 414-4314  
Email: edward.cashman@dot.state.fl.us

## Design Standards:

Index Number: **17355**  
Sheet Number (s): ALL SHEETS  
Index Title: SPECIAL SIGN DETAILS

## Summary of the changes:

ALL Sheets: Reorganized  
Sheet 2: Added two new sign details.  
Sheet 3: Updated the Notes and Table for M1-6 COUNTY ROUTE MARKER DETAIL.  
Sheet 8: Deleted duplicate sign.  
Sheet 10: Changed MOT-12-06 to a R & L.

## Commentary / Background:

Traffic Operations requested two additional Turnpike signs be added to the Standard Plans. The current sign is still relevant, but additional sizes are needed for overhead roles.

## Other Affected Offices / Documents: (Provide name of responsible personnel)

- | Yes                      | No                                  |                             |
|--------------------------|-------------------------------------|-----------------------------|
| <input type="checkbox"/> | <input checked="" type="checkbox"/> | Other Design Standards –    |
| <input type="checkbox"/> | <input checked="" type="checkbox"/> | Plans Preparation Manual –  |
| <input type="checkbox"/> | <input checked="" type="checkbox"/> | Basis of Estimates Manual – |
| <input type="checkbox"/> | <input checked="" type="checkbox"/> | Standard Specifications –   |
| <input type="checkbox"/> | <input checked="" type="checkbox"/> | Approved Product List –     |
| <input type="checkbox"/> | <input checked="" type="checkbox"/> | Construction –              |
| <input type="checkbox"/> | <input checked="" type="checkbox"/> | Maintenance –               |













## Origination Package Includes: (Email or hand deliver package to Derwood Sheppard)

- | Yes                                 | N/A                      |                         |
|-------------------------------------|--------------------------|-------------------------|
| <input checked="" type="checkbox"/> | <input type="checkbox"/> | Redline Mark-ups        |
| <input type="checkbox"/>            | <input type="checkbox"/> | Proposed IDS            |
| <input type="checkbox"/>            | <input type="checkbox"/> | Revised IDS             |
| <input type="checkbox"/>            | <input type="checkbox"/> | Other Support Documents |

## Implementation:

- Design Bulletin (DSR)    DCE Memo    Program Mgmt. Bulletin    Design Standards e-Booklet (Next Release)

Contact the Roadway Design Office for assistance in completing this form

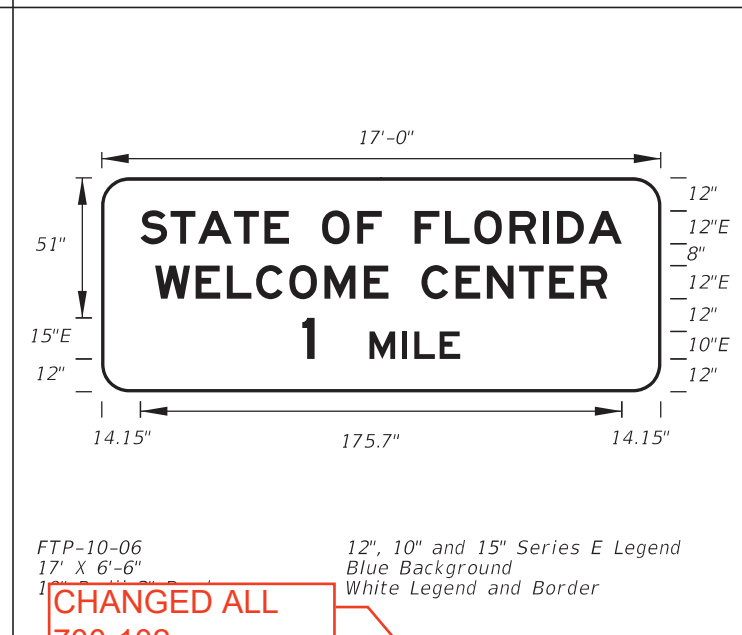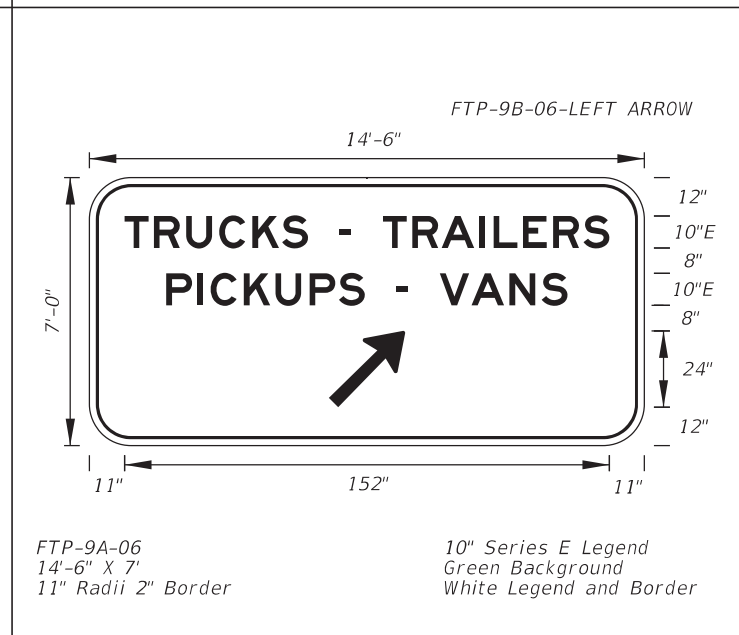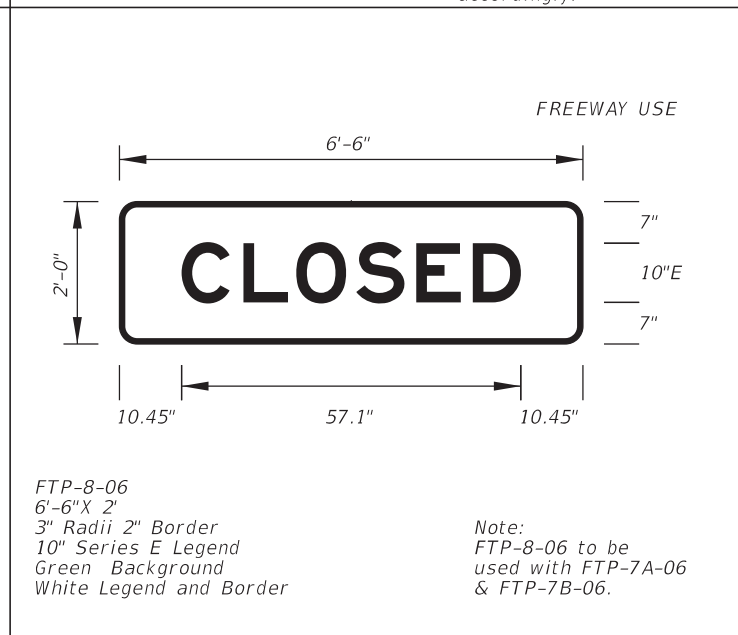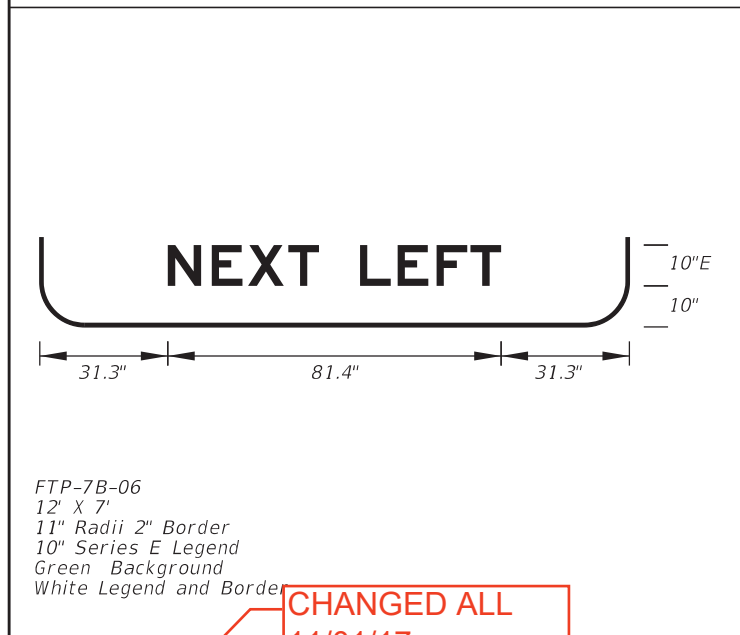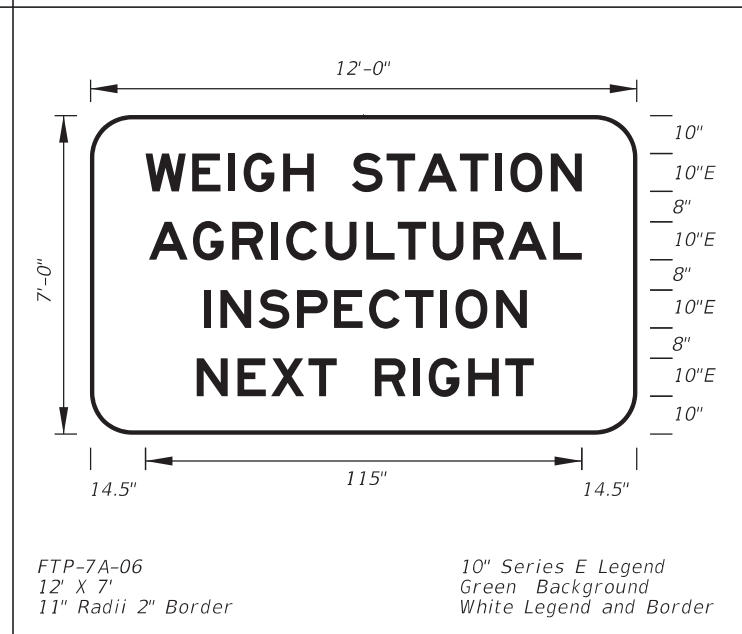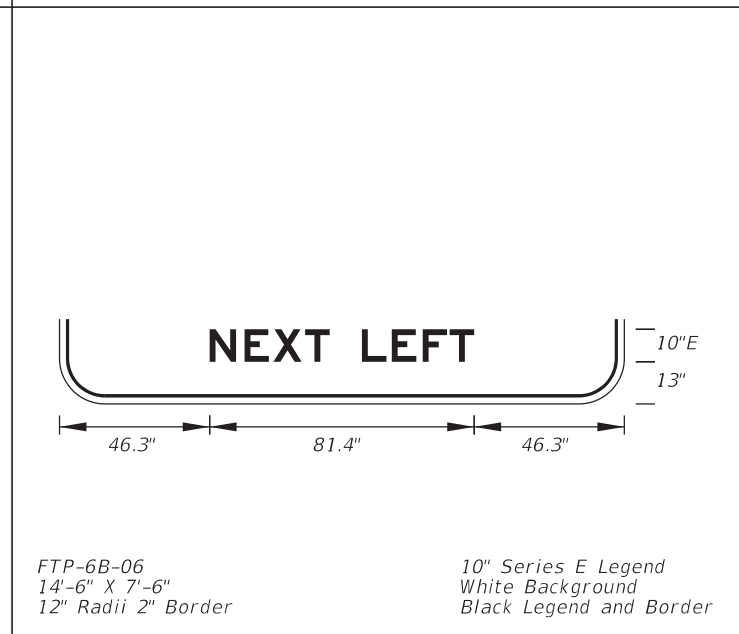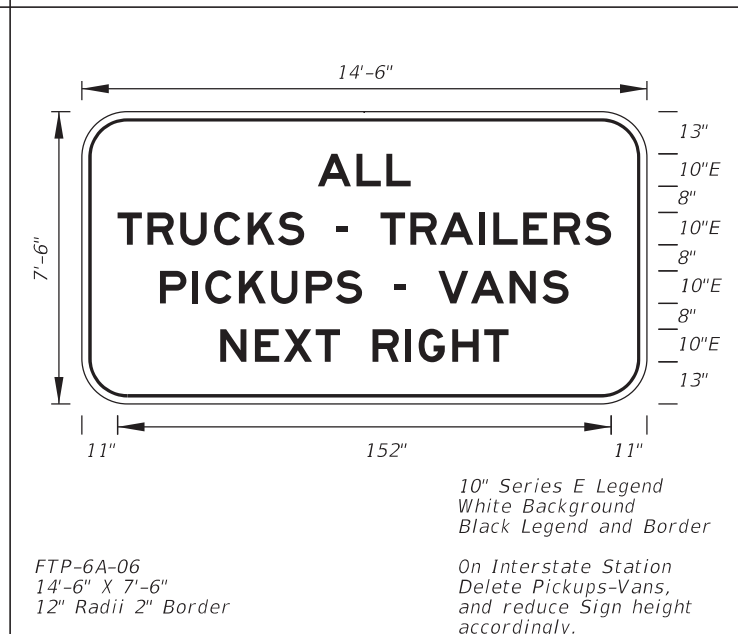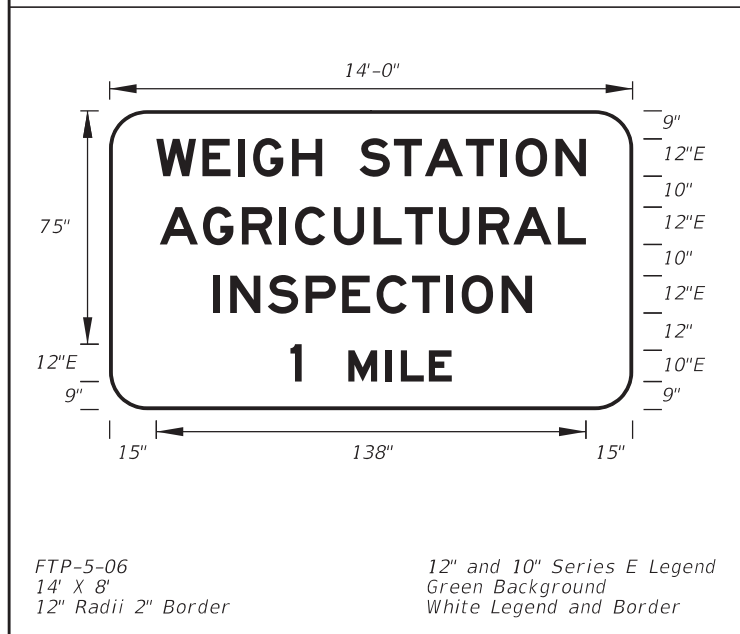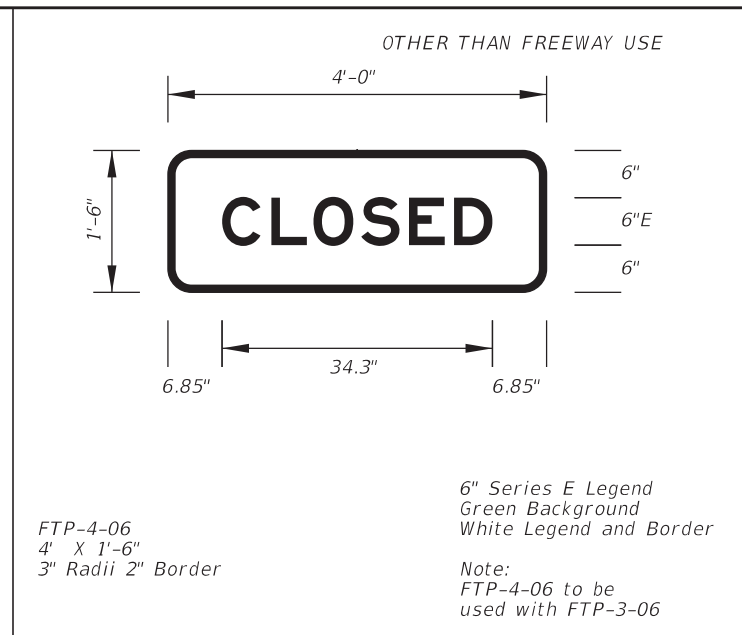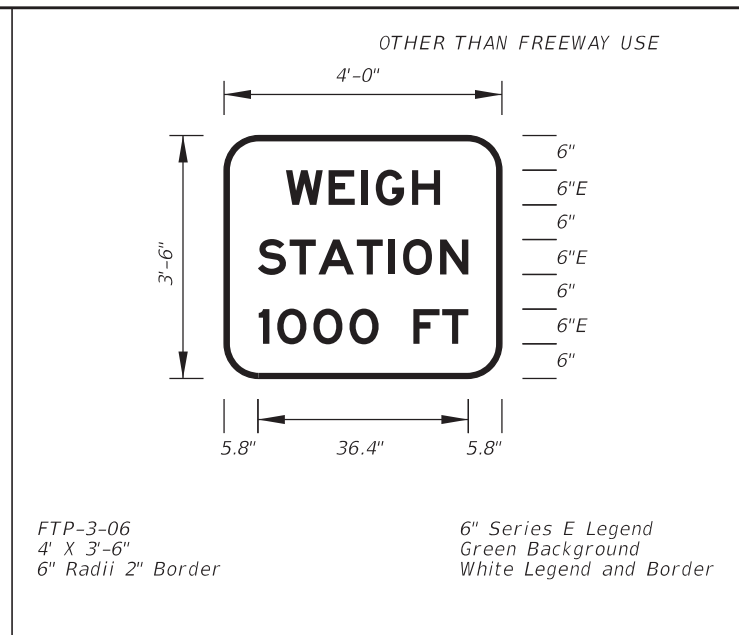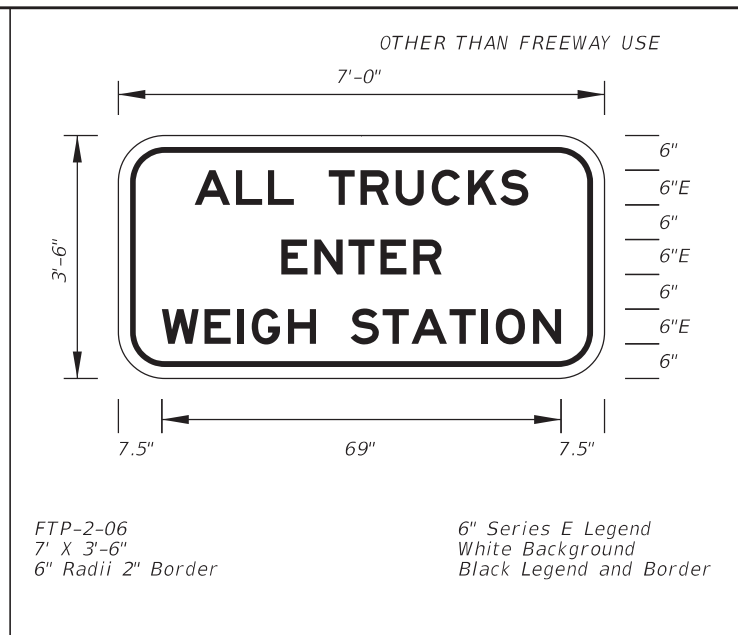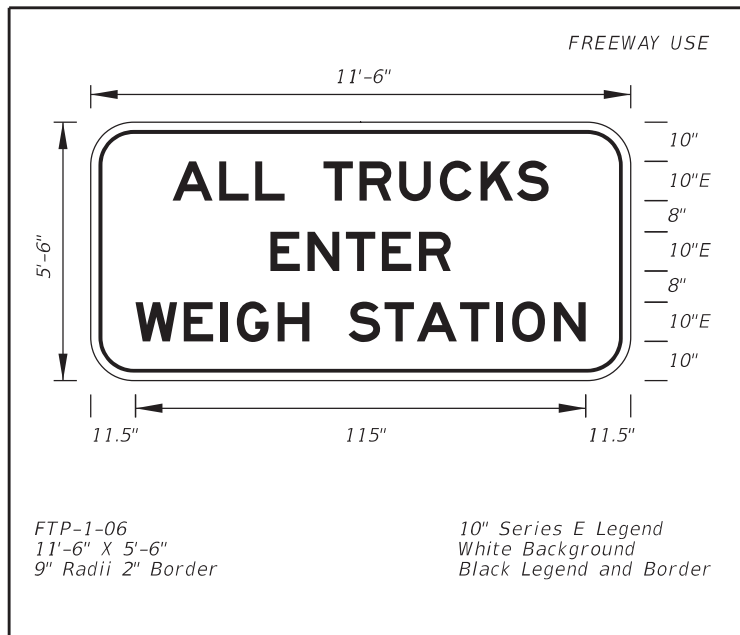


10/14/2016 8:43:14 AM


CHANGED ALL 11/01/17

CHANGED ALL 700-102


LAST REVISION	DESCRIPTION
07/01/14	

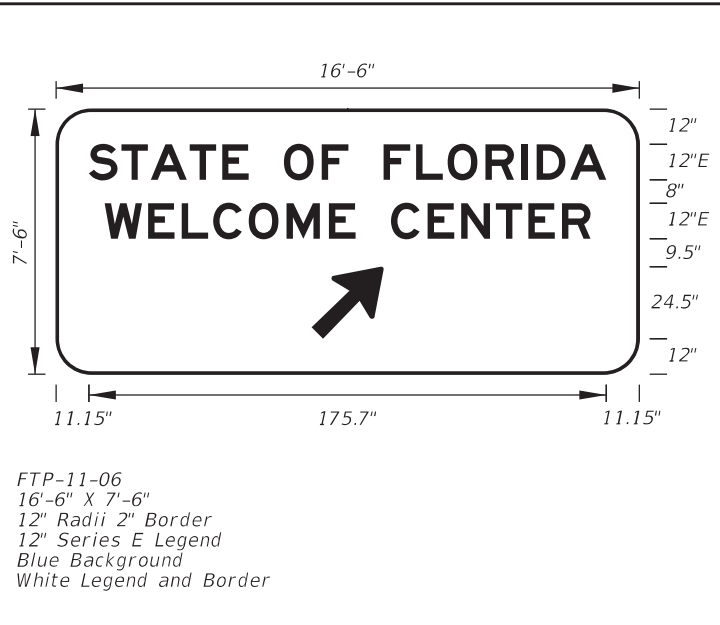


FTP-11-06  
16'-6" X 7'-6"  
12" Radii 2" Border  
12" Series E Legend  
Blue Background  
White Legend and Border

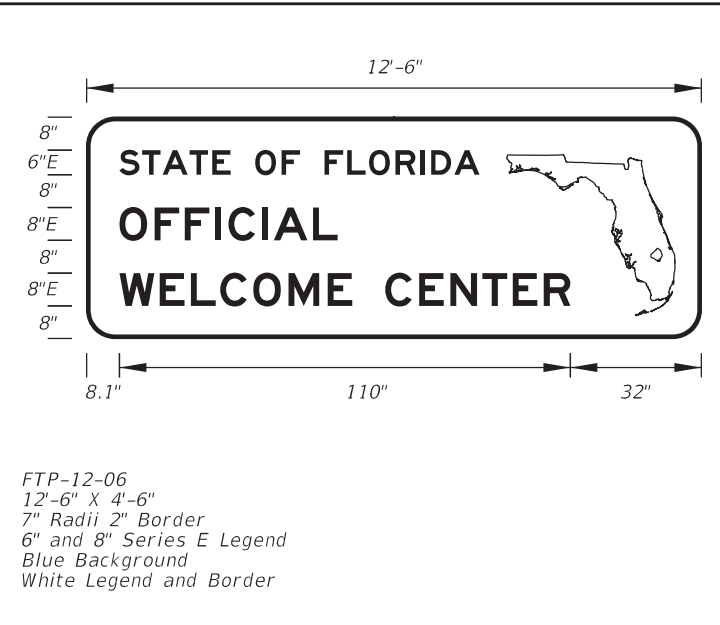


FTP-12-06  
12'-6" X 4'-6"  
7" Radii 2" Border  
6" and 8" Series E Legend  
Blue Background  
White Legend and Border

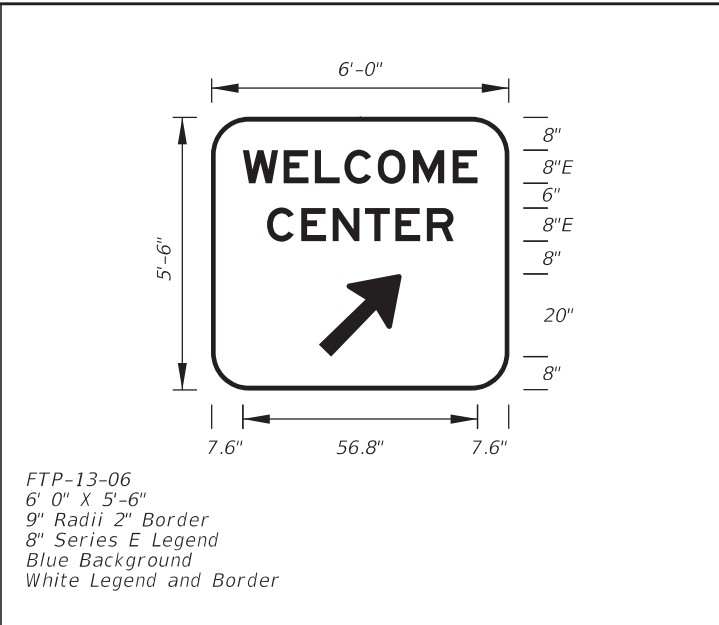


FTP-13-06  
6' 0" X 5'-6"  
9" Radii 2" Border  
8" Series E Legend  
Blue Background  
White Legend and Border

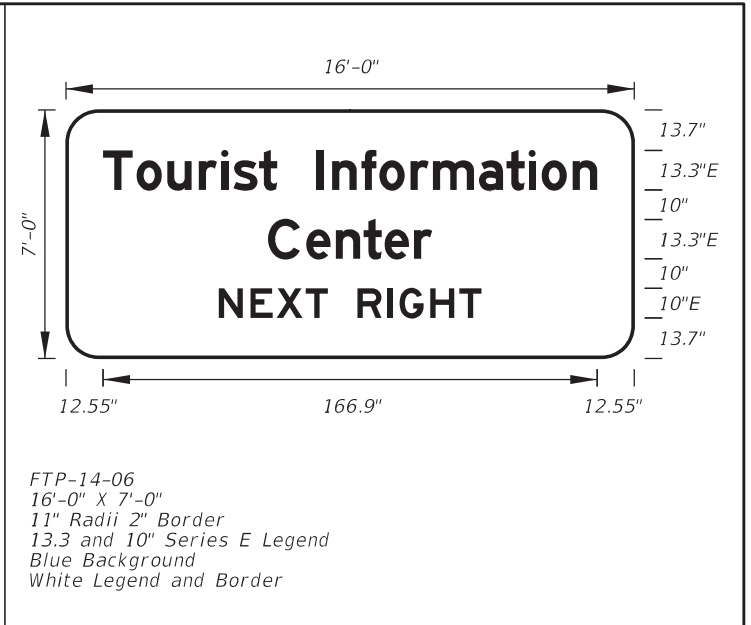


FTP-14-06  
16'-0" X 7'-0"  
11" Radii 2" Border  
13.3 and 10" Series E Legend  
Blue Background  
White Legend and Border

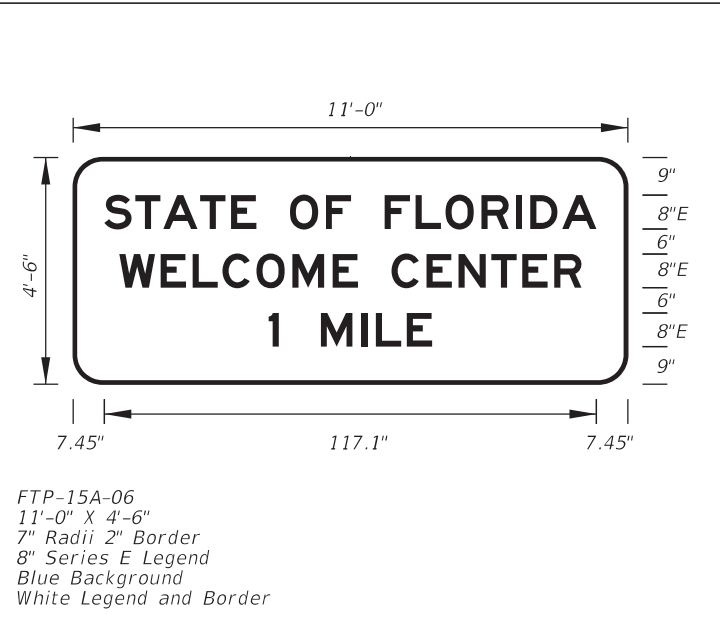

FTP-15A-06  
11'-0" X 4'-6"  
7" Radii 2" Border  
8" Series E Legend  
Blue Background  
White Legend and Border

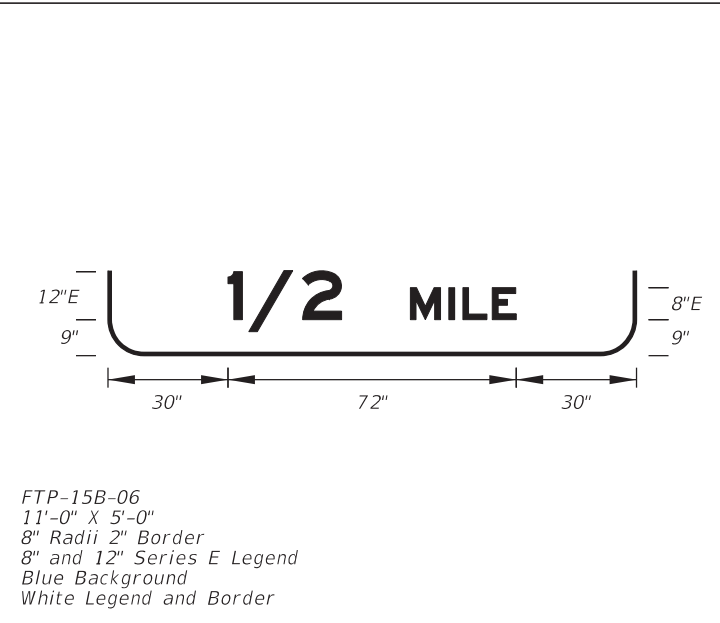


FTP-15B-06  
11'-0" X 5'-0"  
8" Radii 2" Border  
8" and 12" Series E Legend  
Blue Background  
White Legend and Border

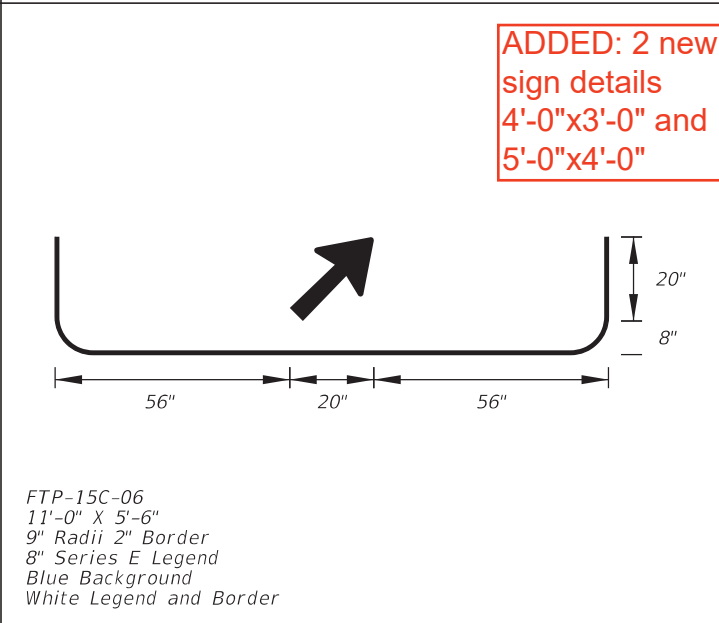


FTP-15C-06  
11'-0" X 5'-6"  
9" Radii 2" Border  
8" Series E Legend  
Blue Background  
White Legend and Border


ADDED: 2 new sign details  
4'-0"x3'-0" and  
5'-0"x4'-0"

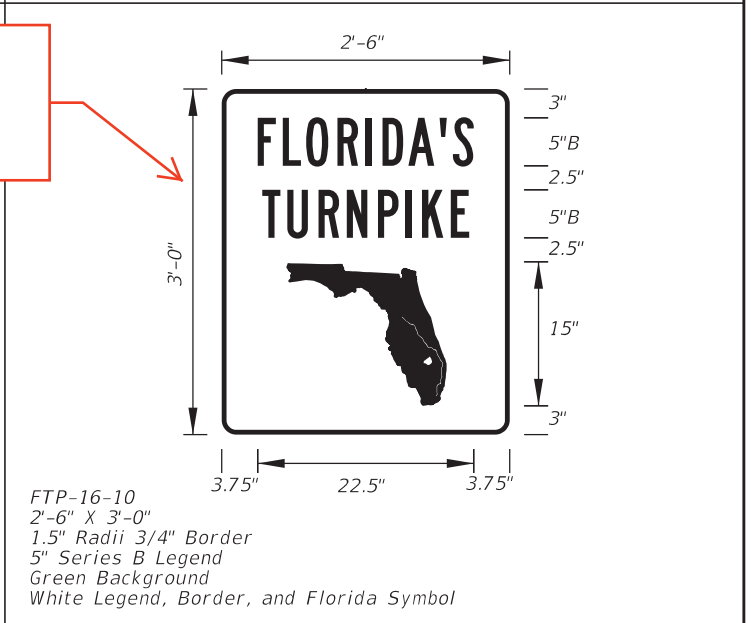

FTP-16-10  
2'-6" X 3'-0"  
1.5" Radii 3/4" Border  
5" Series B Legend  
Green Background  
White Legend, Border, and Florida Symbol

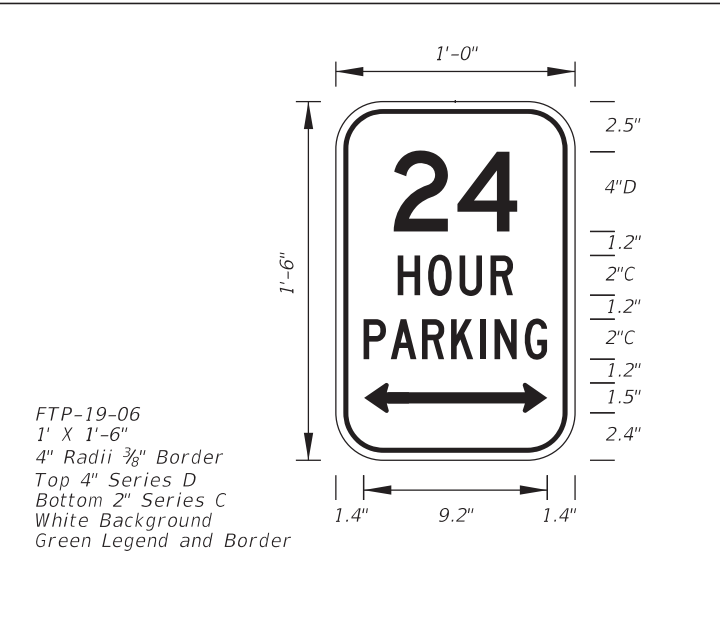


FTP-19-06  
1' X 1'-6"  
4" Radii 3/8" Border  
Top 4" Series D  
Bottom 2" Series C  
White Background  
Green Legend and Border

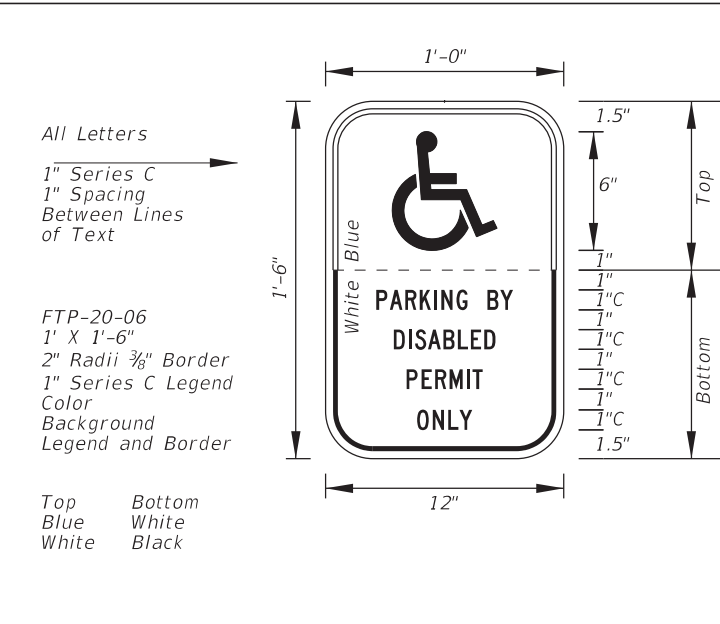


FTP-20-06  
1' X 1'-6"  
2" Radii 3/8" Border  
1" Series C Legend  
Color Background  
Legend and Border

Top Bottom  
Blue White  
White Black

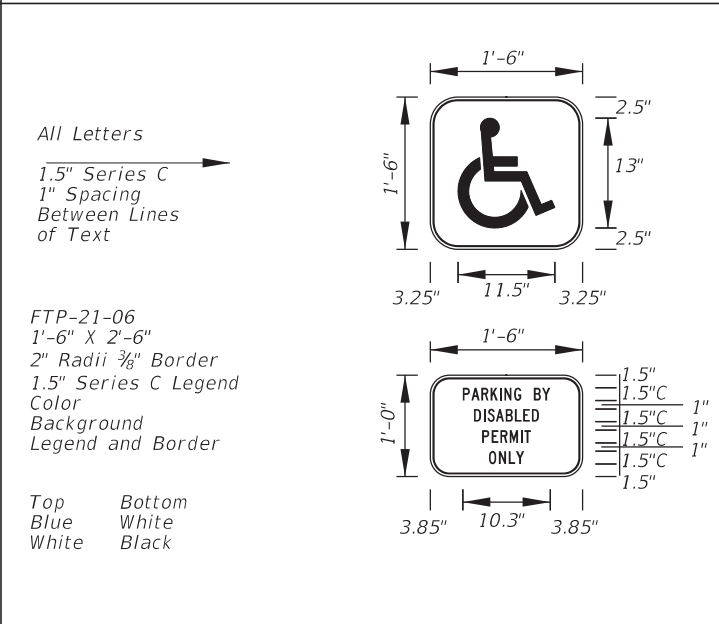

FTP-21-06  
1'-6" X 2'-6"  
2" Radii 3/8" Border  
1.5" Series C Legend  
Color Background  
Legend and Border


Top Bottom  
Blue White  
White Black

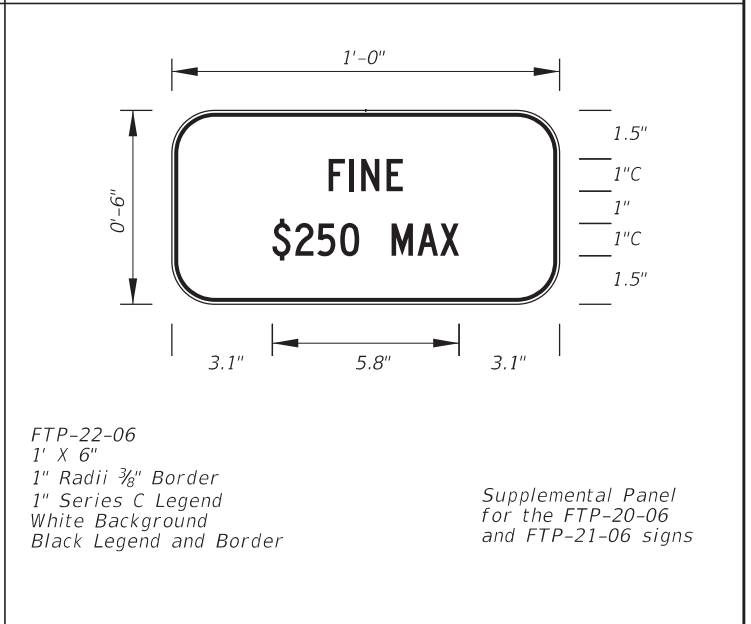

FTP-22-06  
1' X 6"  
1" Radii 3/8" Border  
1" Series C Legend  
White Background  
Black Legend and Border

Supplemental Panel  
for the FTP-20-06  
and FTP-21-06 signs

10/14/2016 8:43:17 AM

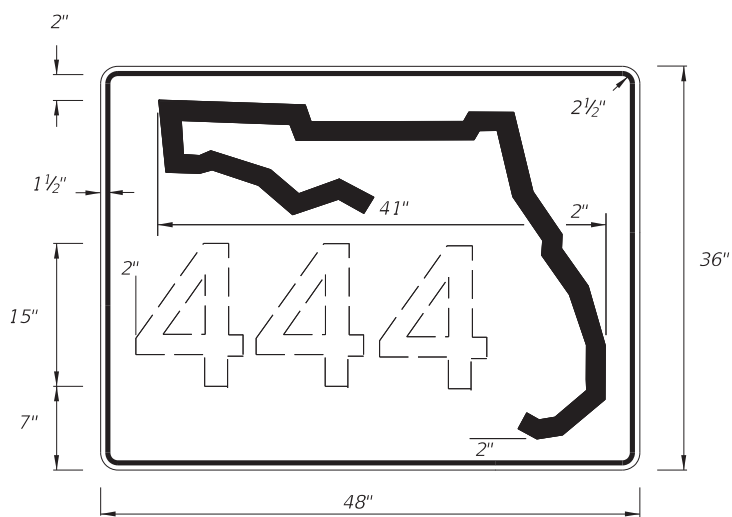


INDEPENDENT USE FOR FREEWAY


DIGITS	NUMERAL SIZE	SERIES	PANEL SIZE
1-2	10"	D	24" x 24"
3	8"	D	24" x 24"
3	8"	D	30" x 24"
4	8"	C	30" x 24"
1-3	15"	C	48" x 36"
4	12"	C	48" x 36"

Note:

1. The 24" X 24" panel shall only be used for a 3 digit route when the panel is to be used on a sign cluster with other 24" X 24" panels.
2. Florida Route Marker shall have Black Legend with White Background.
3. Stroke width of State Outline shall be 1".
4. 2" Radii, 5/8" Border.

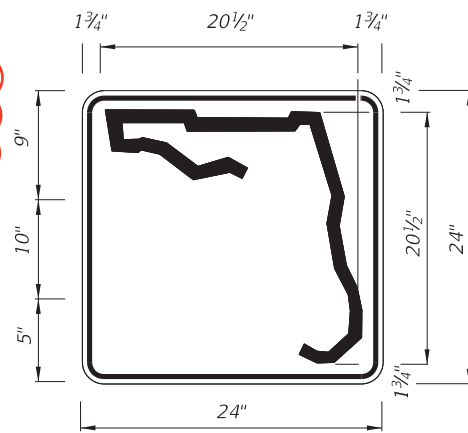


1 or 2 DIGITS

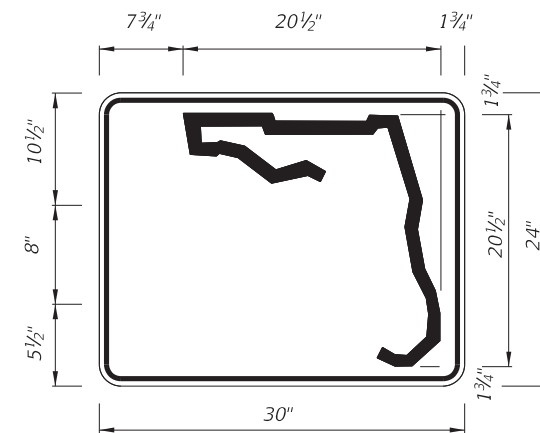


3 or 4 DIGITS

INDEPENDENT USE OTHER THAN FREEWAY

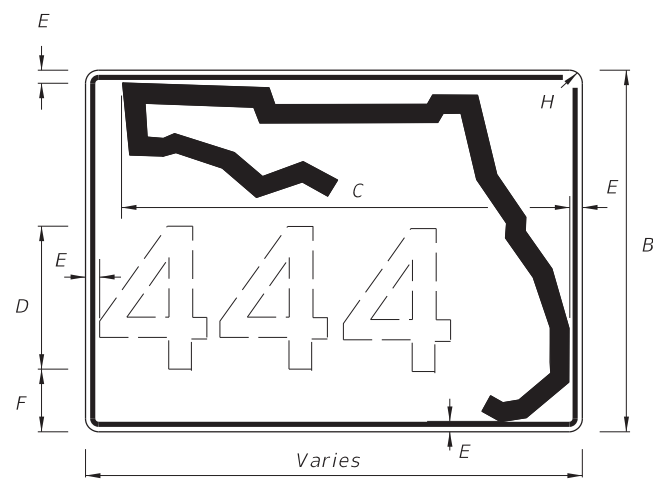


3 OR MORE DIGITS

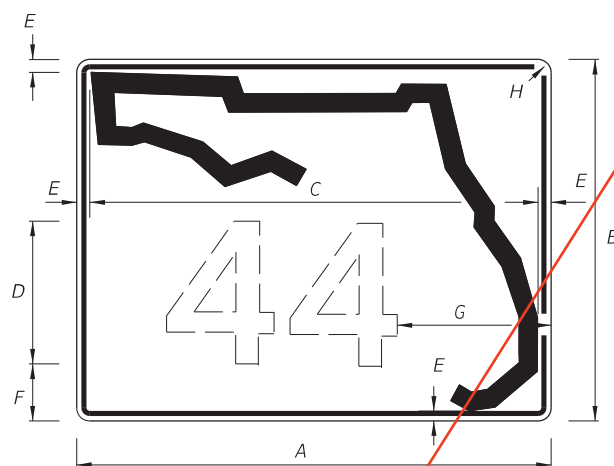

1 OR 2 DIGITS

UPDATED NOTES AND TABLES

CHANGED NOTE 3

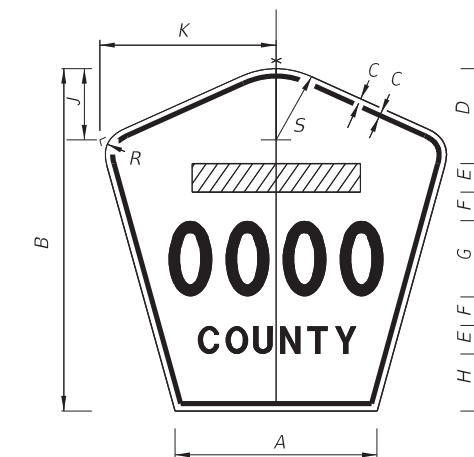

UPDATED: Rectangular Yellow Background Dimensions (See Note 3)

- Notes:
1. All Legend Series "D".
  2. Color: Yellow Legend and Border on Blue Background.
  3. When used on a guide sign, marker must be overlaid on a rectangular Yellow Background as shown in chart.

A	B	C	D	E	F	G	H
30"	24"	26"	12"	1 1/4"	2 3/4"	8 1/4"	1 1/4"
36"	30"	32"	15"	1 1/4"	3 1/4"	8 3/4"	1 1/4"
42"	36"	38"	15"	1 1/4"	6 1/4"	11"	1 1/4"

GUIDE SIGN USE

- Notes:
1. Florida marker shall have Black Legend with White Background.
  2. Stroke width of State outline to be 1 1/4" for Guide Sign.
  3. Numbers are series D.

FLORIDA ROUTE MARKER  
FTP-17-06

SIGN	DIMENSIONS											***	
	A	B	C	D	E	F	G	H	J	K	R		S
4 DIGIT POST MOUNTED	25 1/8"	42"	3/4"	10"	4"	4"	8"	8"	8 3/8"	22"	5"	8 3/4"	
2 DIGIT OVERHEAD	21 1/2"	36"	1/2"	7 1/2"	3"	3"	12"	4 1/2"	7 1/8"	18 7/8"	4 1/4"	7 1/2"	42" x 42"
3 DIGIT OVERHEAD	25 1/8"	42"	3/4"	8"	4"	4"	12"	6"	8 3/8"	22"	5"	8 3/4"	48" x 48"
4 DIGIT OVERHEAD	29 7/8"	48"	3/4"	8"	5"	5"	12"	8"	9 3/4"	25 5/8"	5 3/4"	10 1/4"	52" x 52"

M-1-6 COUNTY ROUTE MARKER DETAIL  
FTP-18-06

10/14/2016 8:43:19 AM

LAST REVISION  
07/01/14


REVISION DESCRIPTION:

FDOT  
FY 2017-18  
DESIGN STANDARDS

SPECIAL SIGN DETAILS


INDEX NO.  
17355

SHEET NO.  
3 of 11

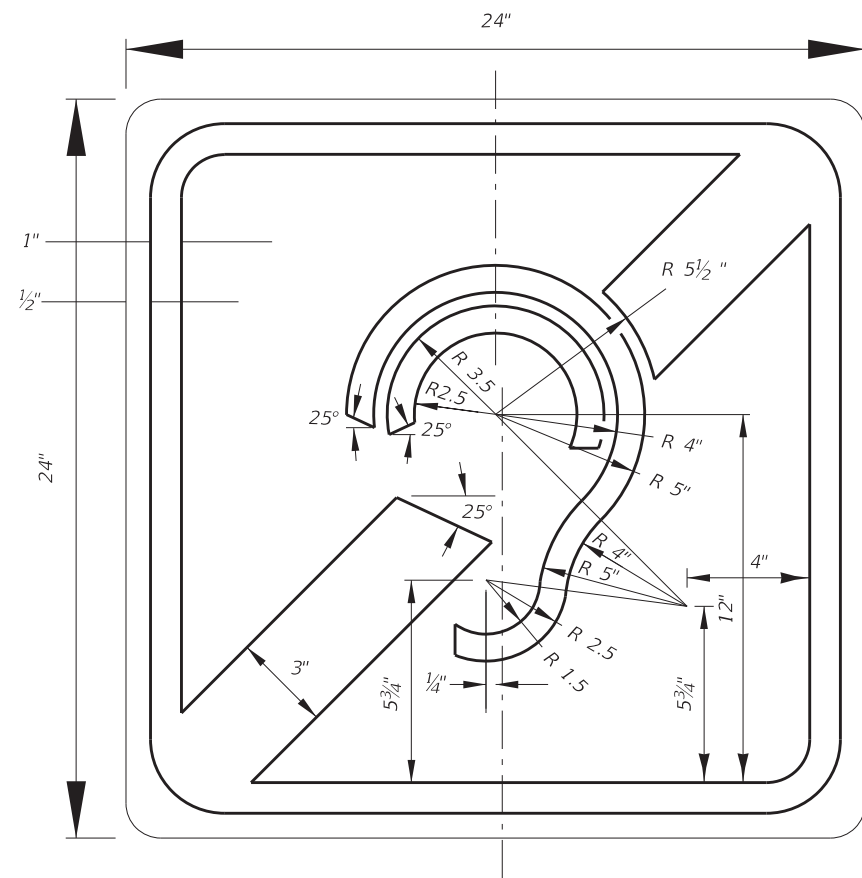


FTP-23-06  
2' X 2'  
1.5" Radii  $\frac{5}{8}$ " Border  
Blue Background  
White Legend and Border


INTERNATIONAL SYMBOL OF  
ACCESS FOR HEARING LOSS

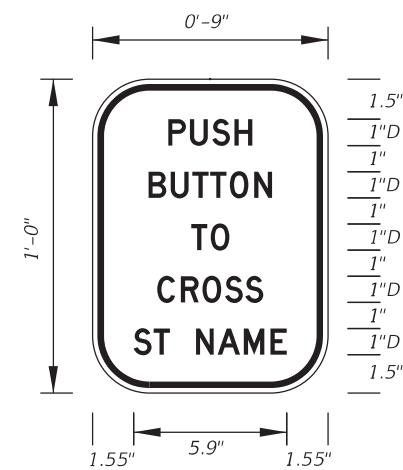

FTP-25-06  
9" X 1'-0"  
2" Radii  $\frac{3}{8}$ " Border  
1" Series D Legend  
White Background  
Black Legend and Border

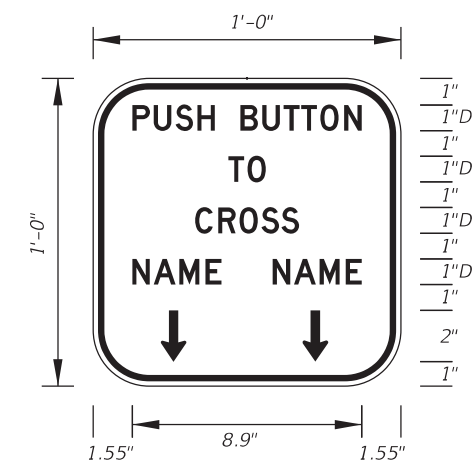


FTP-26-06  
1' X 1'  
2" Radii  $\frac{3}{8}$ " Border  
1" Series D Legend  
White Background  
Black Legend and Border

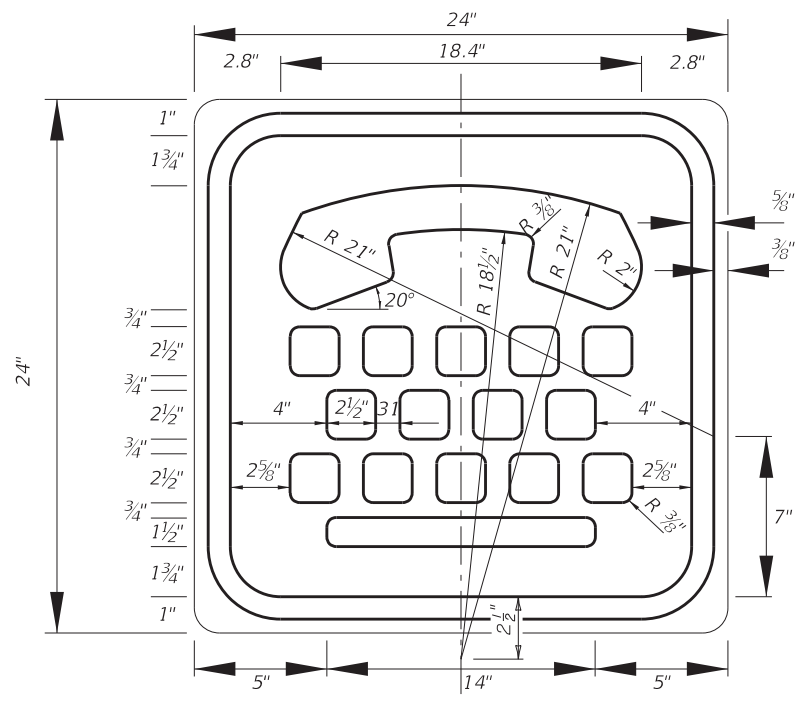


FTP-24-06  
2' X 2'  
1.5" Radii  $\frac{5}{8}$ " Border  
Blue Background  
White Legend and Border

INTERNATIONAL TDD SYMBOL

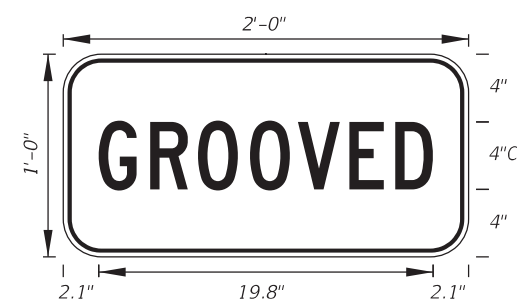

FTP-29-06  
2'-0" X 1'-0"  
2" Radii  $\frac{5}{8}$ " Border  
4" Series C Legend  
Yellow Background  
Black Legend and Border

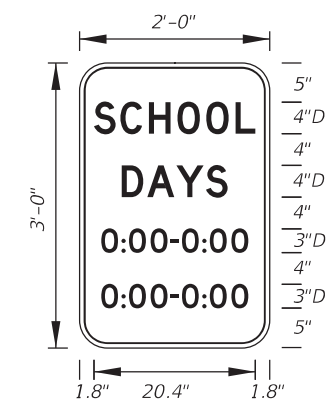

FTP-30-06  
2'-0" X 3'-0"  
3" Radii  $\frac{5}{8}$ " Border  
White Background  
Black Legend and Border

10/14/2016 8:43:21 AM

LAST  
REVISION  
07/01/14

REVISION DESCRIPTION:




FY 2017-18  
DESIGN STANDARDS


SPECIAL SIGN DETAILS

INDEX  
NO.  
17355


SHEET  
NO.  
4 of 11

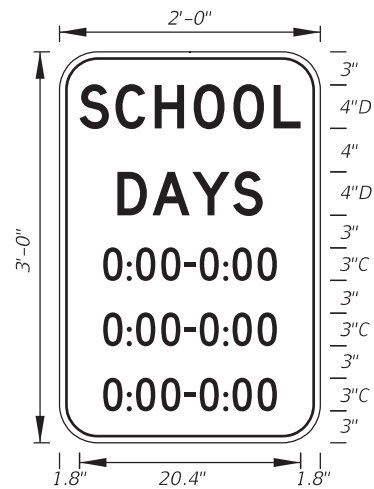


FTP-30A-06  
2' X 3'  
3" Radii 5/8" Border  
Top 4" Series D Legend  
Bottom 3" Series C Legend  
White Background  
Black Legend and Border

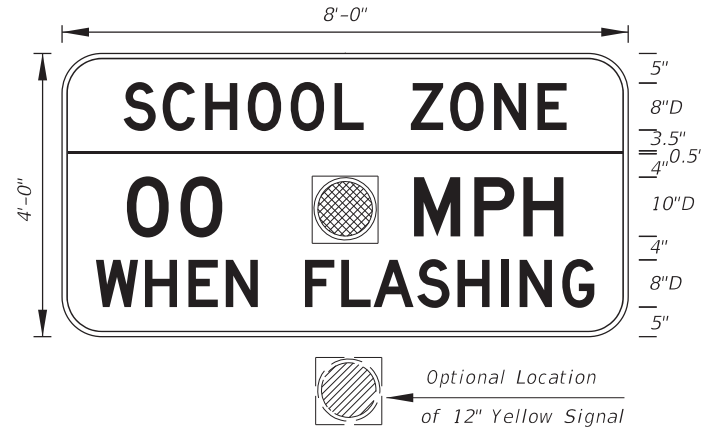


FTP-31-06  
8' X 4'  
6" Radii 3/4" Border  
Series D Legend  
Yellow Background Top  
White Background Bottom  
Black Legend and Border

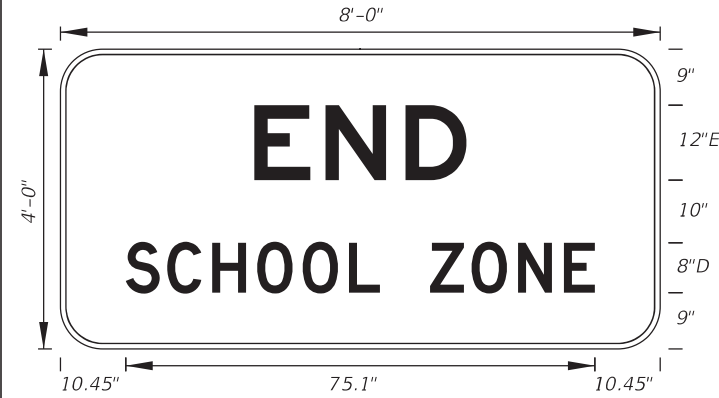


FTP-32-06  
8' X 4'  
6" Radii 3/4" Border  
12" Series E and 8" Series D Legend  
White Background  
Black Legend and Border

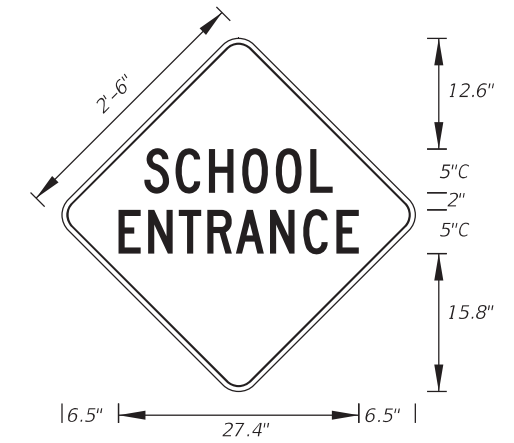


FTP-33-06  
2'-6" X 2'-6"  
2" Radii 3/4" Border  
5" Series C Legend  
Yellow Background  
Black Legend and Border

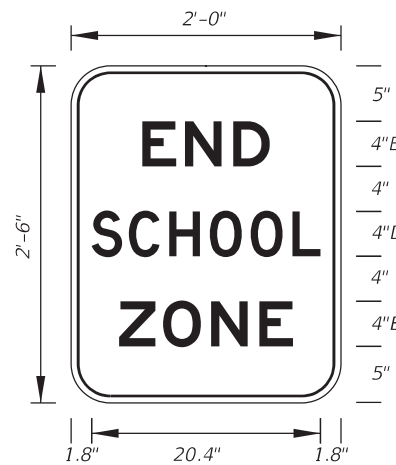


FTP-34-06  
2' X 2'-6"  
3" Radii 5/8" Border  
4" Series D and E Legend  
White Background  
Black Legend and Border

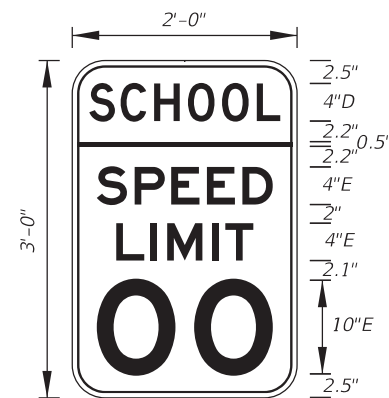


FTP-35-06  
2' X 3'  
3" Radii 5/8" Border  
Top 4" Series D Legend  
Bottom 4" and 10" Series E Legend  
Yellow Background Top  
White Background Bottom  
Black Legend and Border

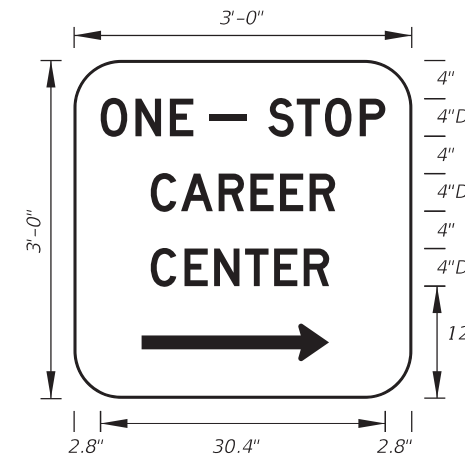


FTP-36-06  
3' X 3'  
5" Radii  
4" Series D Legend  
Green Background  
White Legend and Border

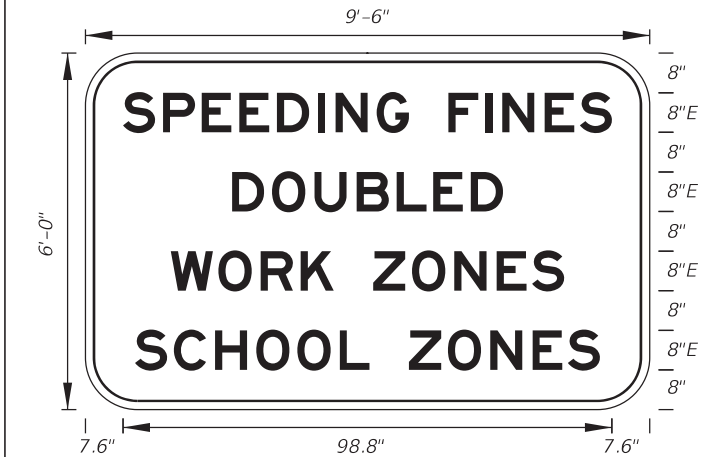


FTP-37-06  
9'-6" X 6'  
9" Radii 2" Border  
8" Series E Legend  
White Background  
Black Legend and Border  
State Line Sign

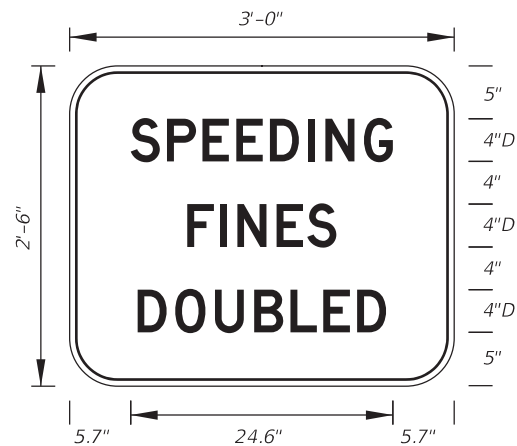

FTP-38-06  
3' X 2'-6"  
4" Radii 3/4" Border  
4" Series D Legend  
White Background  
Black Legend and Border

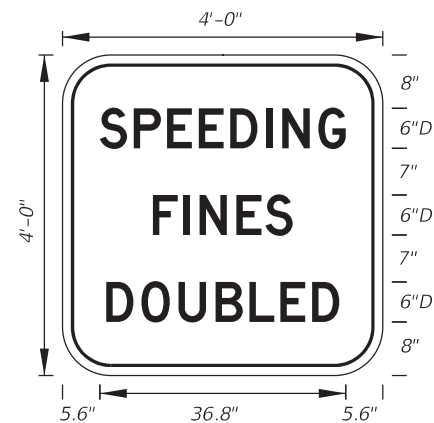

FTP-39-06  
4' X 4'  
6" Radii 3/4" Border  
6" Series D Legend  
White Background  
Black Legend and Border  
Freeway Sign

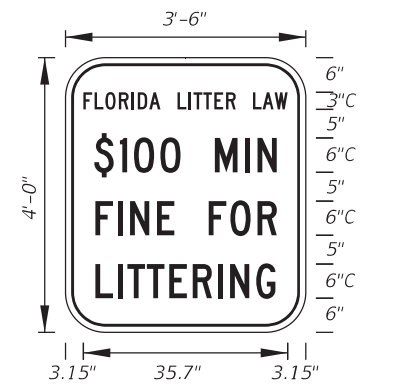

FTP-40-06  
3'-6" X 4'  
6" Radii 3/4" Border  
3" and 6" Series C Legend  
White Background  
Black Legend and Border




FTP-41-06  
2'-6" X 3'  
4" Radii 3/4" Border  
2" and 4" Series C Legend  
White Background  
Black Legend and Border

10/14/2016 8:43:23 AM




FTP-42-06  
4' X 2'-6"  
3" Radii  
Top 4" Series C Legend  
Bottom 2" Series EM Legend  
White Background  
Blue Legend and Border

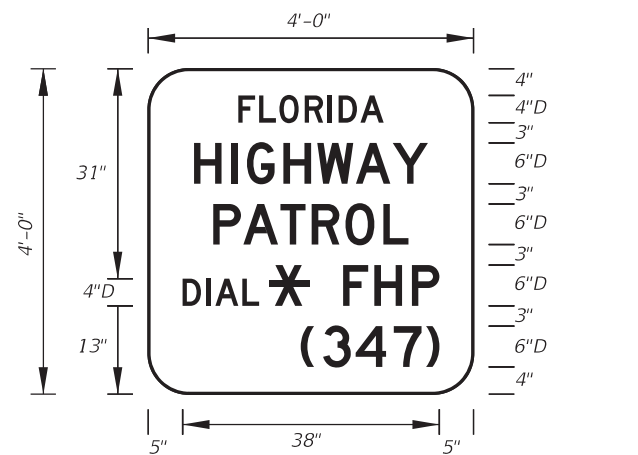


FTP-43-06  
4' X 4'  
6" Radii 1" Border  
Top 4" Series D Legend  
Bottom 6" Series D Legend  
Blue Background  
White Legend and Border




FTP-44-06  
9' X 6'  
9" Radii 3/4" Border  
8" Series D Legend  
White Background  
Black Legend and Border

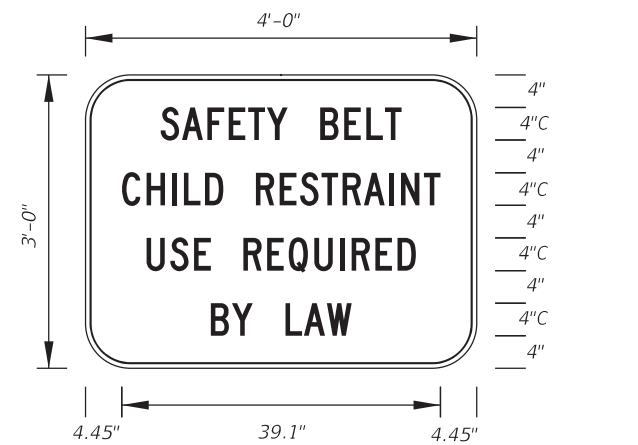


FTP-45-06  
4' X 3'  
5" Radii 3/4" Border  
4" Series C Legend  
White Background  
Black Legend and Border

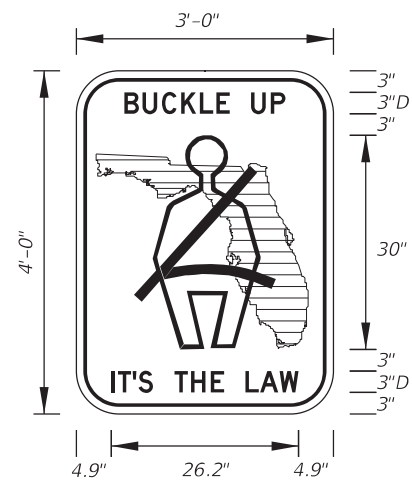


FTP-46-06  
3' X 4'  
5" Radii 3/4" Border  
3" Series D Legend  
White Background  
Green Florida Symbol  
Black Legend, Border and Man Belt Symbol

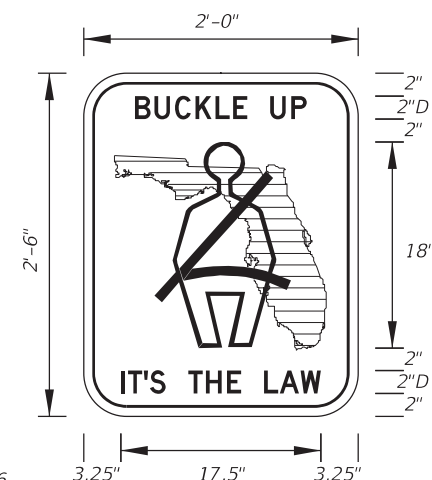


FTP-47-06  
2' X 2'-6"  
3" Radii 5/8" Border  
2" Series D Legend  
White Background  
Green Florida Symbol  
Black Legend, Border and Man Belt Symbol

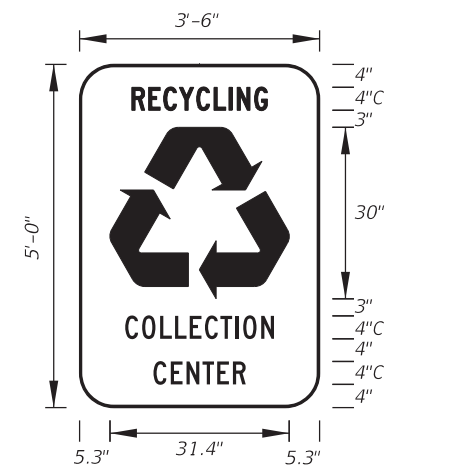


FTP-48-06  
3'-6" X 5'  
6" Radii  
4" Series C Legend  
Green Background  
White Legend, Border and Symbol

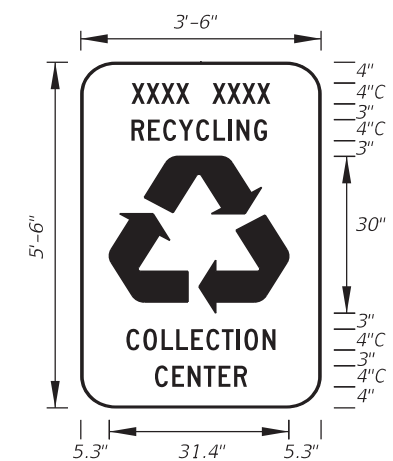


FTP-49-06  
3'-6" X 5'-6"  
6" Radii  
4" Series C Legend  
Green Background  
Municipality Name Optional  
White Legend, Border and Symbol

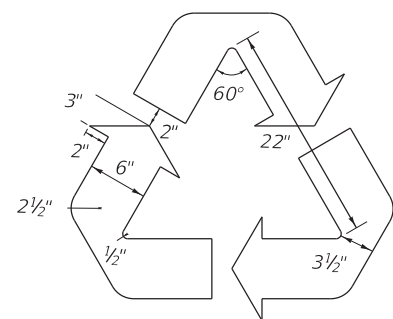


Detail for FTP-48-06 and FTP-49-06

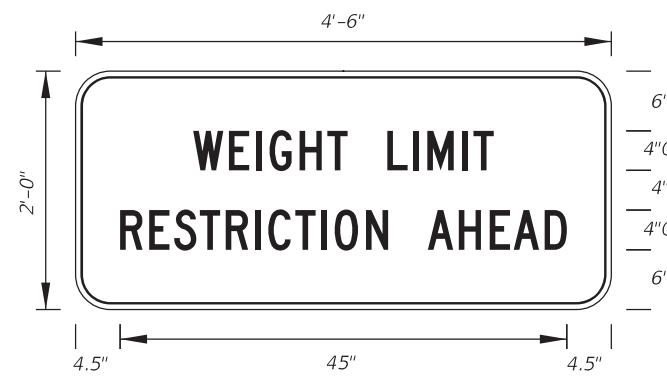

FTP-50-06  
4'-6" X 2'  
3" Radii 3/4" Border  
4" Series C Legend  
Yellow Background  
Black Legend and Border

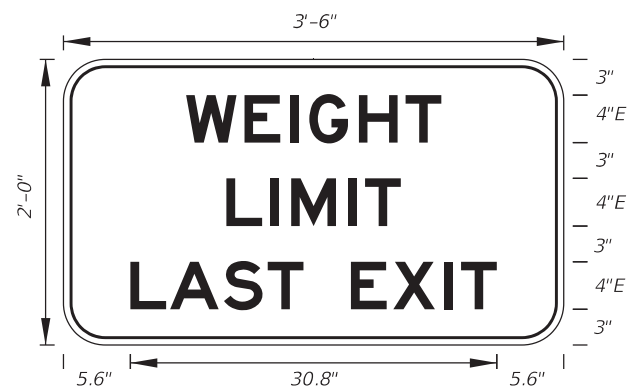


FTP-51-06  
3' X 2'  
3" Radii 3/4" Border  
4" Series E Legend  
White Background  
Black Legend and Border

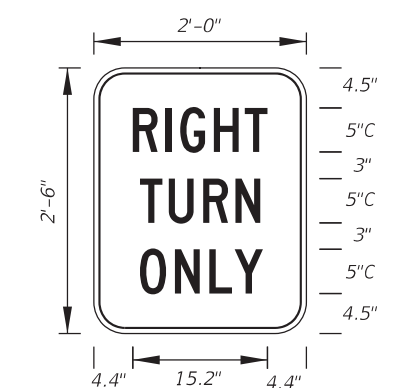


FTP-52-06  
2' X 2'-6"  
3" Radii 5/8" Border  
5" Series C Legend  
White Background  
Black Legend and Border

10/14/2016 8:43:26 AM

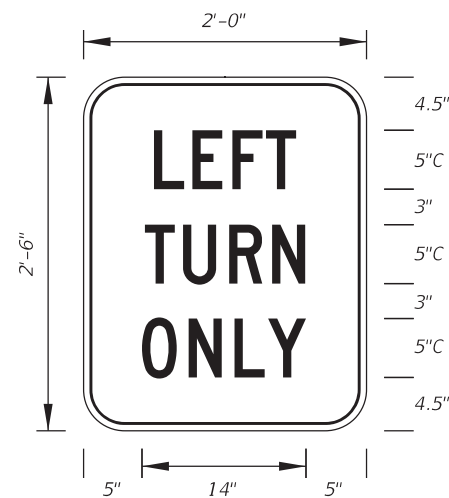


FTP-53-06  
2' X 2'-6"  
3" Radii 5/8" Border  
5" Series C Legend  
White Background  
Black Legend and Border

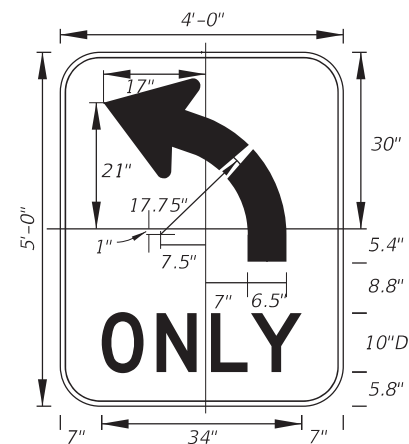

FTP-54L-06  
4' X 5'  
6" Radii 3/4" Border  
10" Series D Legend  
White Background  
Black Legend and Border

FTP-54R-06 for  
(Right Turn Arrow)

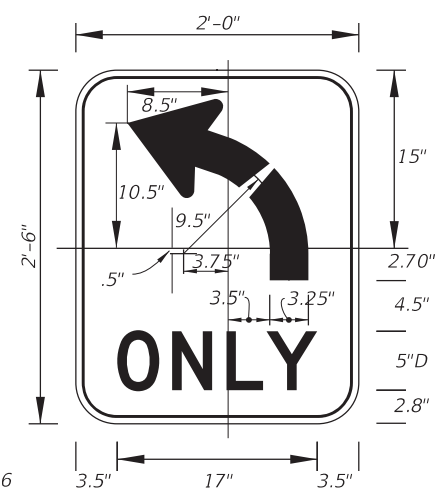


FTP-55L-06  
2' X 2'-6"  
3" Radii 3/8" Border  
5" Series D Legend  
White Background  
Black Legend and Border

FTP-55R-06 for  
(Right Turn Arrow)



FTP-56-06  
6'-6" X 4'  
6" Radii 3/4" Border  
8" and 6" Series D Legend  
Blue Background  
White Legend and Border

Design Project Manager  
or Transit Administrator  
will supply correct 1-8XX  
number.

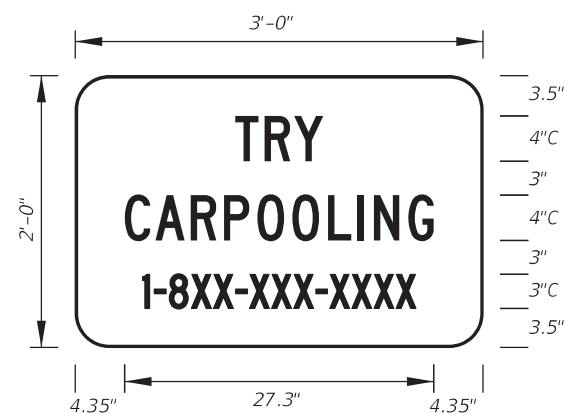


FTP-56A-06  
3' X 2'  
3" Radii  
4" and 3" Series C Legend  
Blue Background  
White Legend and Border

Design Project Manager  
or Transit Administrator  
will supply correct 1-8XX  
number.




FTP-57-06  
6'-6" X 4'  
6" Radii  
8" and 6" Series D Legend  
Blue Background  
White Legend and Border

Design Project Manager  
or Transit Administrator  
will supply correct 1-8XX  
number.

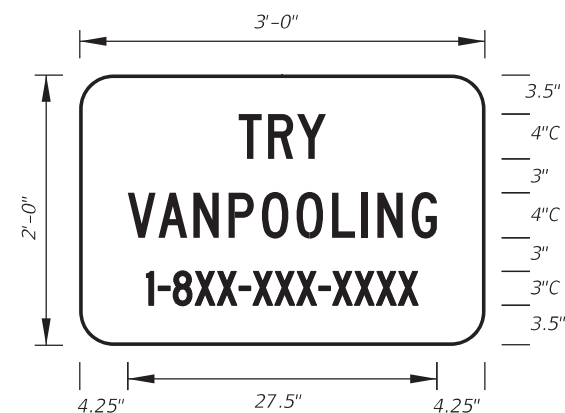


FTP-58-06  
3' X 2'  
3" Radii  
4" and 3" Series C Legend  
Blue Background  
White Legend and Border

Design Project Manager  
or Transit Administrator  
will supply correct 1-8XX  
number.

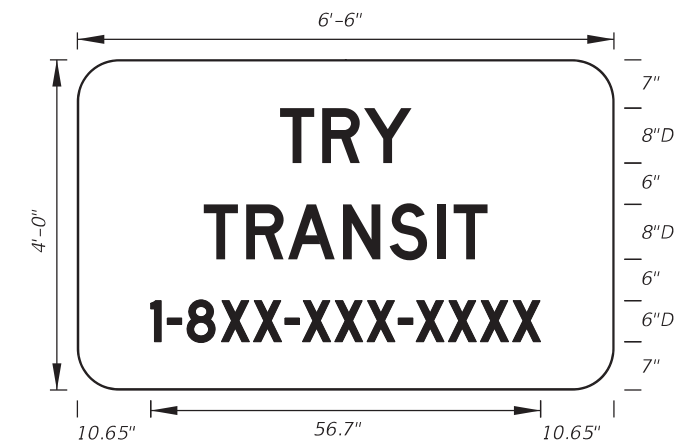

FTP-59-06  
6'-6" X 4'  
6" Radii  
8" and 6" Series D Legend  
Blue Background  
White Legend and Border

Design Project Manager  
or Transit Administrator  
will supply correct 1-8XX  
number.

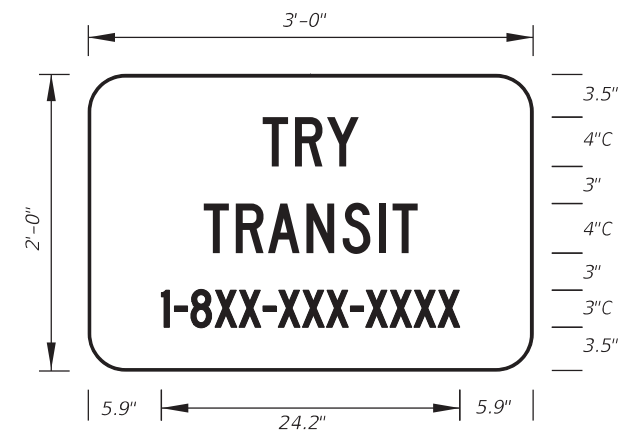

FTP-60-06  
3' X 2'  
3" Radii  
4" and 3" Series C Legend  
Blue Background  
White Legend and Border


Design Project Manager  
or Transit Administrator  
will supply correct 1-8XX  
number.



FTP-61-06  
3' X 2'  
3" Radii 3/4" Border  
4" and 3" Series C Legend  
Yellow Background  
Black Legend and Border




FTP-62-06  
3' X 3'  
2" Radii 3/4" Border 4" and 5" Series C Legend  
Yellow Background Black Legend and Border

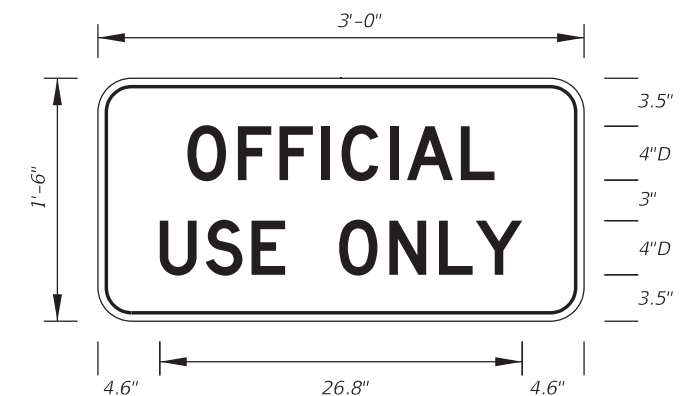

FTP-65-06  
3' X 1'-6"  
2" Radii 3/4" Border  
4" Series D Legend  
White Background  
Black Legend and Border

10/14/2016 8:43:28 AM



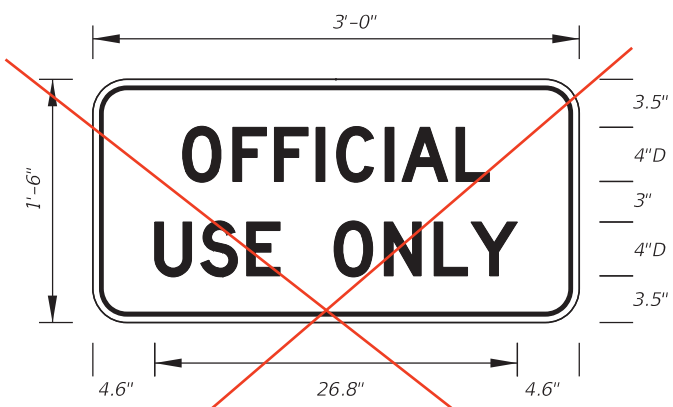

FTP-65-06  
3' X 1'-6"  
2" Radii 3/4" Border  
4" Series D Legend  
White Background  
Black Legend and Border

DELETED DUPLICATE



FTP-66-06  
4' X 5'  
2" Radii 3/4" Border  
7" Series D Legend  
Blue Background  
White Legend and Border




FTP-67-06  
3' X 4'  
2" Radii 3/4" Border  
5" Series D Legend  
Blue Background  
White Legend and Border



DETAIL for FTP-66 AND FTP-67


Sign Mounting Holes Can Be Punched Or Field Drilled With No Obstruction To Text Or Symbols From Holes Or Bolts.

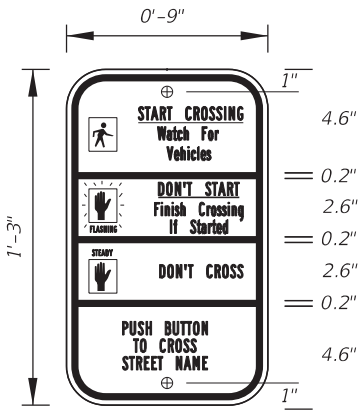

FTP-68A-06  
9" X 1'-3"  
1.5" Radii 3/4" Border  
Series B Legend  
White Background  
Black Legend and Border


See Standard Highway Signs Manual, Sign R10-3b For Letter Size Spacing And Symbol Sizes.

Sign Mounting Holes Can Be Punched Or Field Drilled With No Obstruction To Text Or Symbols From Holes Or Bolts.

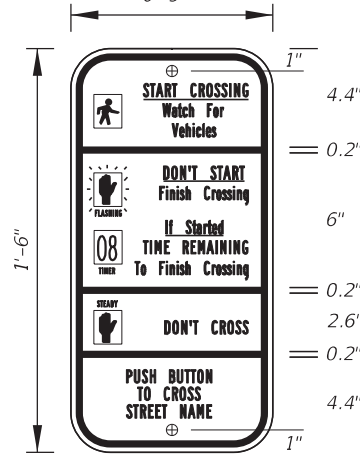


FTP-68B-06  
9" X 1'-6"  
1.5" Radii 3/4" Border  
Series B Legend  
White Background  
Black Legend and Border

See Standard Highway Signs Manual, Sign R10-3b For Letter Size Spacing And Symbol Sizes.

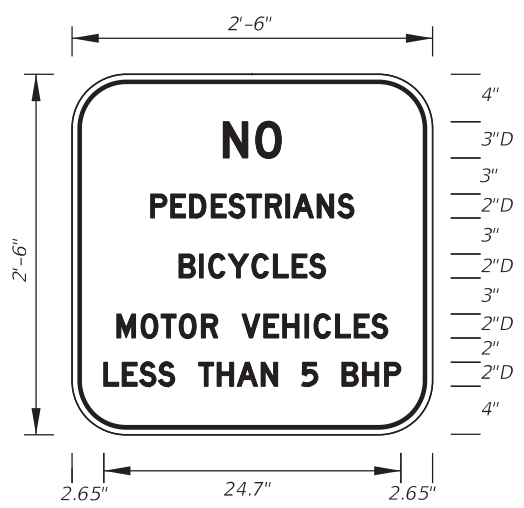


FTP-69-06  
2'-6" X 2'-6"  
4" Radii 3/4" Border

2" and 3" Series D Legend  
White Background  
Black Legend and Border

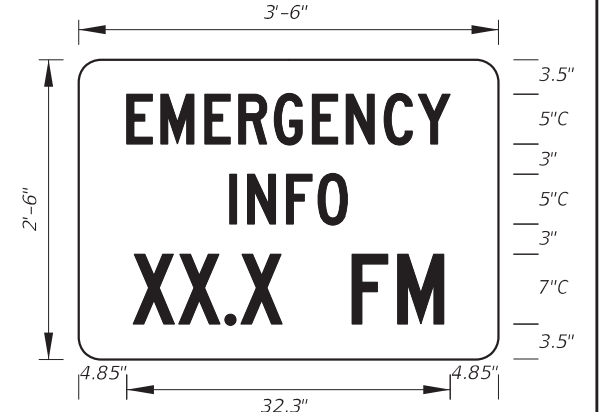

FTP-70-06  
3'-6" X 2'-6"  
2.25" Radii 3/4" Border  
5" Series C and 7" Series C Legend  
Blue Background  
White Legend and Border

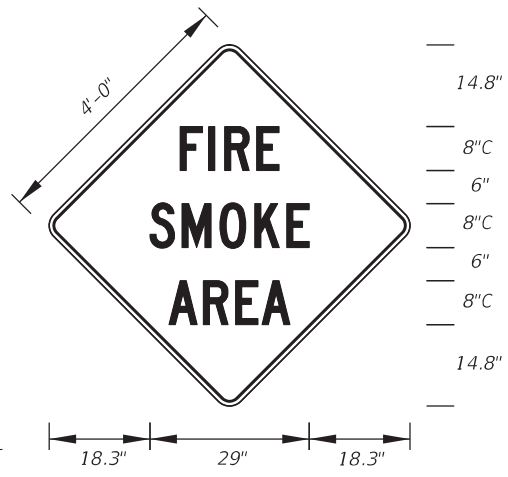


FTP-71-06  
4' X 4'  
2" Radii 3/4" Border  
8" Series C Legend  
Yellow Background  
Black Legend and Border



FTP-72-06  
3' X 3'  
2" Radii 3/4" Border

6" Series C Legend  
Yellow Background  
Black Legend and Border

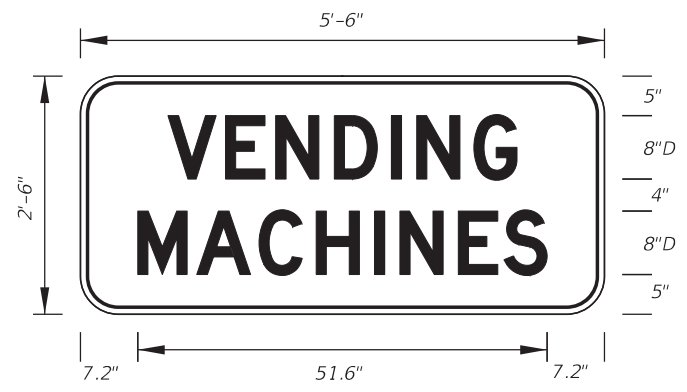


FTP-73-06  
5'-6" X 2'-6"  
4" Radii 3/4" Border

8" Series D Legend  
Blue Background  
White Legend and Border




FTP-74-06  
5'-6" X 2'-6"  
4" Radii 3/4" Border  
6" Series D Legend  
Blue Background  
White Legend and Border


10/14/2016 8:43:30 AM

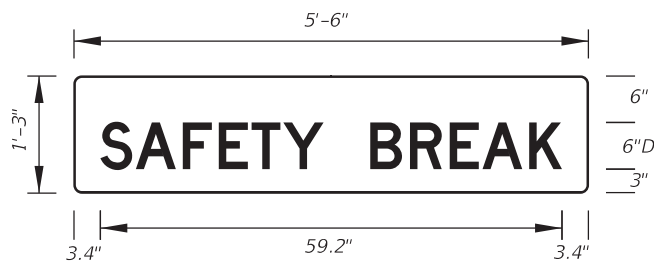


FTP-75-06  
5'-6" X 1'-3"  
1" Radii  
6" Series D Legend  
Blue Background  
White Legend

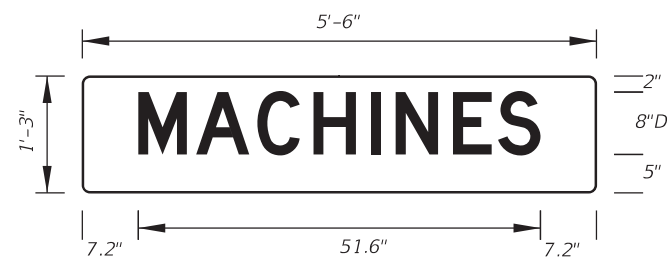


FTP-76-06  
5'-6" X 1'-3"  
1" Radii  
8" Series D Legend  
Blue Background  
White Legend

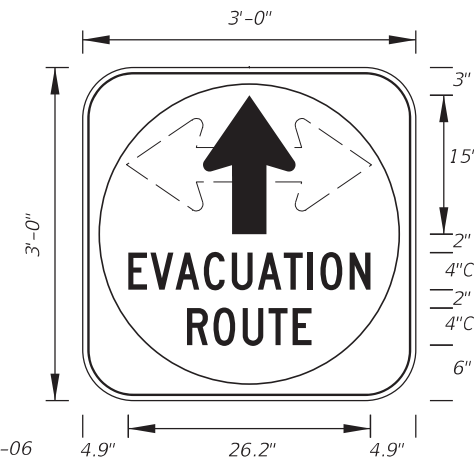


FTP-77-06  
3' X 3'  
5" Radii 3/4" Border  
4" Series C Legend  
White Background with Blue Circle Background  
White Legend and Black Border

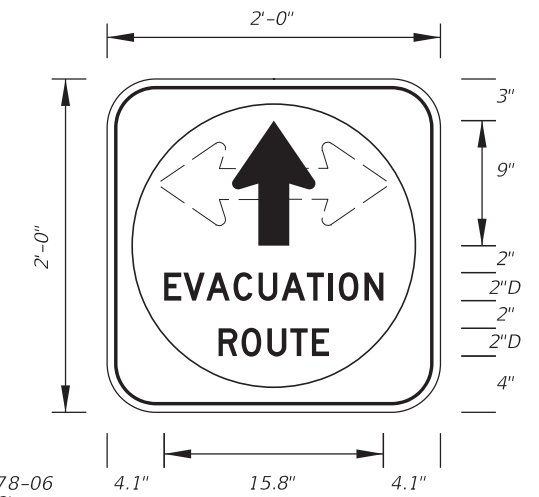


FTP-78-06  
2' X 2'  
3" Radii 3/4" Border  
2" Series D Legend  
White Background with Blue Circle Background  
White Legend and Black Border

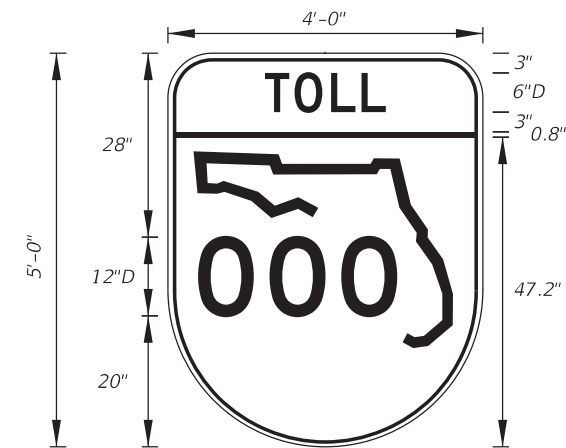


FTP-79-06  
4' X 5'  
6" Radii 3/4" Border  
6" and 12" Series D Legend  
Top Yellow Background with Black Legend and Black Border  
Bottom White Background with Black Legend and Border

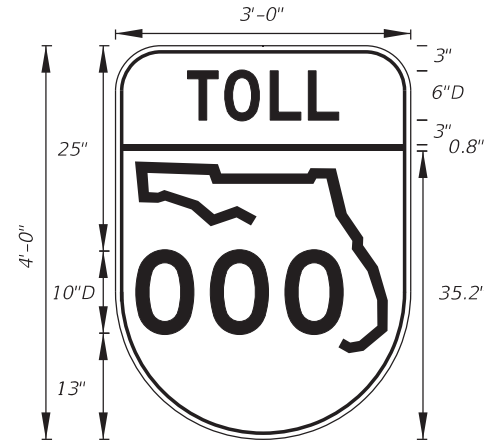


FTP-80-06  
3' X 4'  
5" Radii 3/4" Border  
6" and 10" Series D Legend  
Top Yellow Background with Black Legend and Black Border  
Bottom White Background with Black Legend and Border

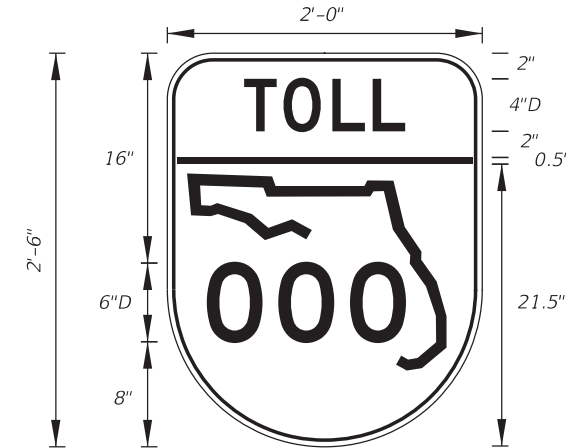

FTP-81-06  
2' X 2'-6"  
3" Radii 3/4" Border  
4" and 6" Series D Legend  
Top Yellow Background with Black Legend and Black Border  
Bottom White Background with Black Legend and Border

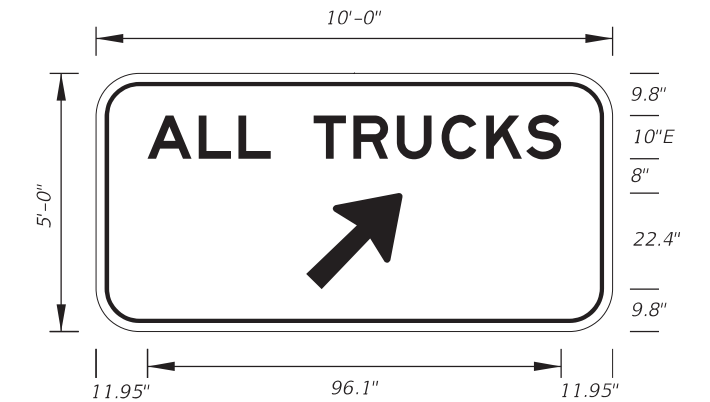


FTP-83-08  
10'-0" X 5'-0"  
8" Radii  
10" Series E Legend  
Green Background  
White Legend

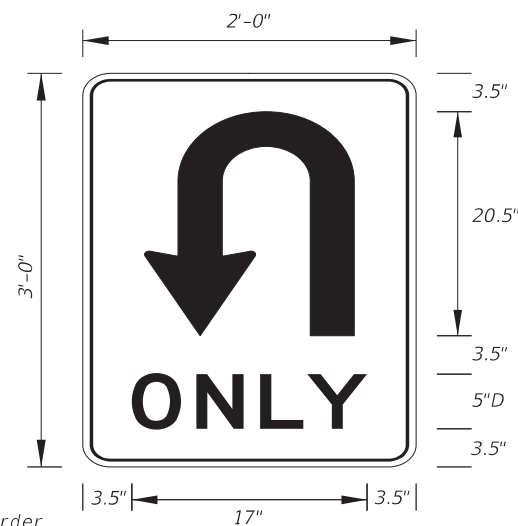

FTP-82-08  
2' X 3'  
1.5" Radii  
5" Series D Legend  
White Background  
Black Legend and Border


ARROW HEAD

A	3.125
B	3.625
C	6.375
D	.5
E	.625

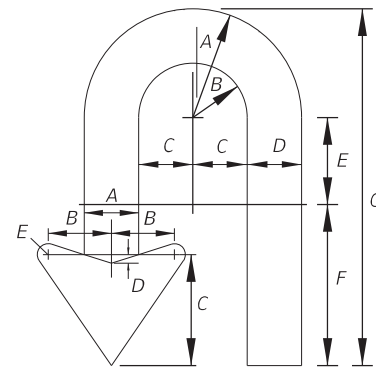


ARROW BODY

A	B	C	D	E	F	G
6.25	3.125	3.125	3.125	5	9.25	20.5

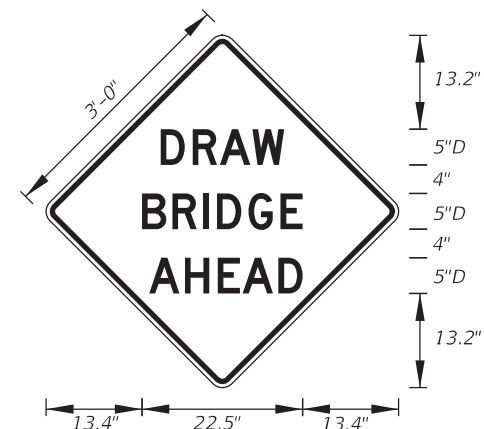


FTP-84-09  
3' X 3'  
1.5" Radii  
5" Series D Legend  
Yellow Background  
Black Legend

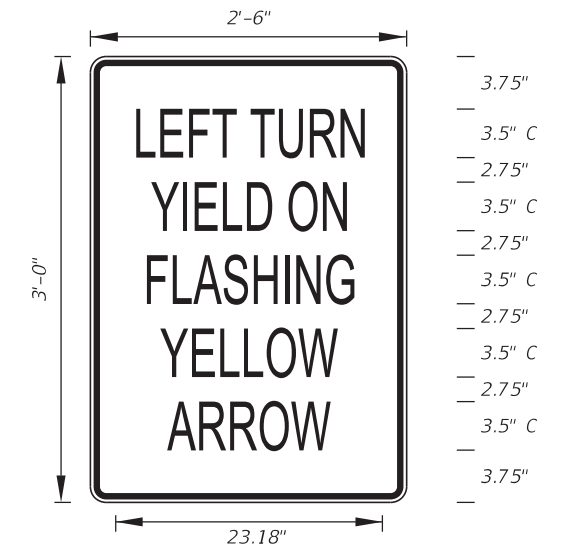


FTP-85-13  
3' X 2'-6"  
1.875" Radii 3/4" Border  
3.5" Series C Legend  
White Background  
Black Legend and Border

10/14/2016 8:43:36 AM


LAST REVISION	DESCRIPTION:
<del>07/01/14</del>	

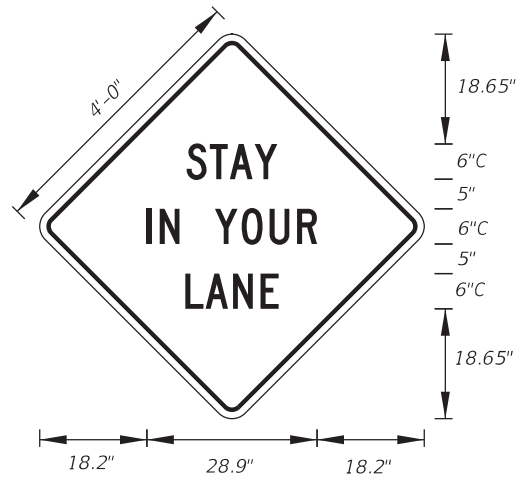


MOT-1-06  
4' X 4'  
2" Radii 3/4" Border  
6" Series C Legend  
Orange Background  
Black Legend and Border

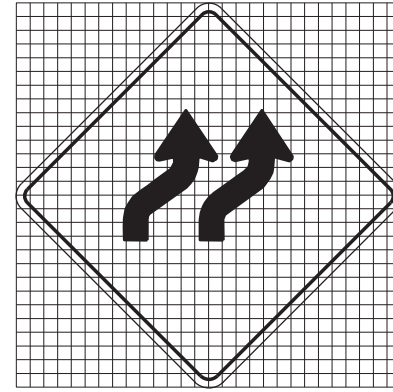


MOT-2-06  
4' X 4'  
2" Radii 3/4" Border  
Orange Background  
Black Arrows and Border

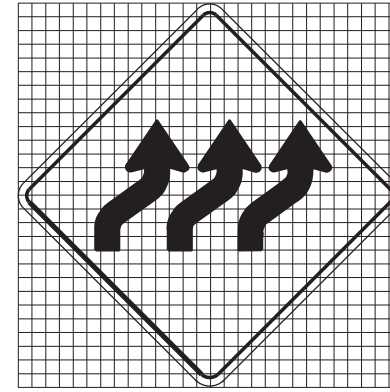


MOT-3-06  
4' X 4'  
2" Radii 3/4" Border  
Orange Background  
Black Arrows and Border

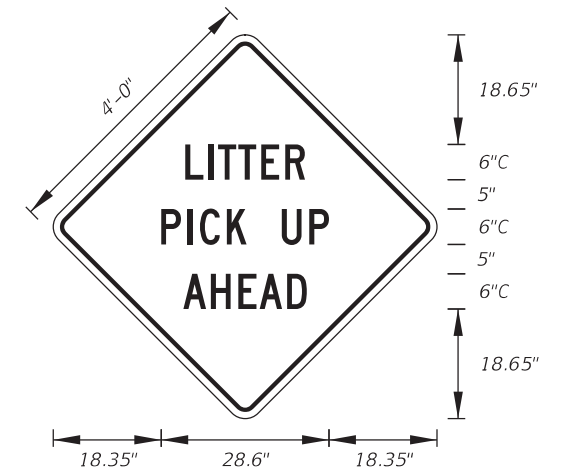


MOT-4-06  
4' X 4'  
2" Radii 3/4" Border  
6" Series C Legend  
Orange Background  
Black Legend and Border

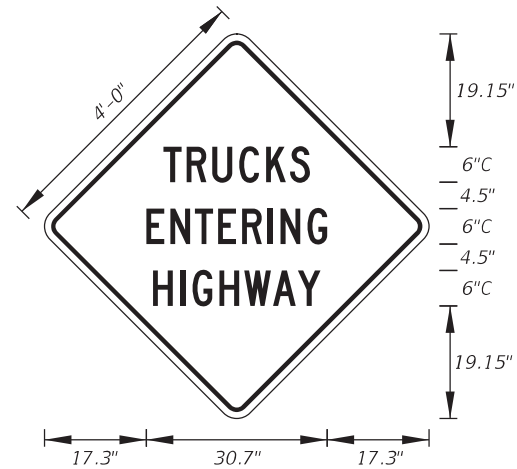


MOT-5-06  
4' X 4'  
2" Radii 3/4" Border  
6" Series C Legend  
Orange Background  
Black Legend and Border

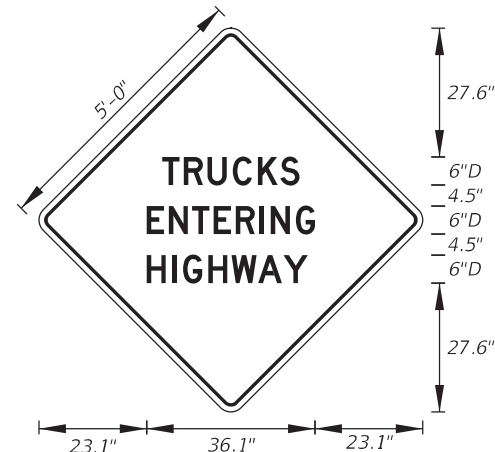


MOT-6-06  
5' X 5'  
2" Radii 3/4" Border  
6" Series D Legend  
Orange Background  
Black Legend and Border

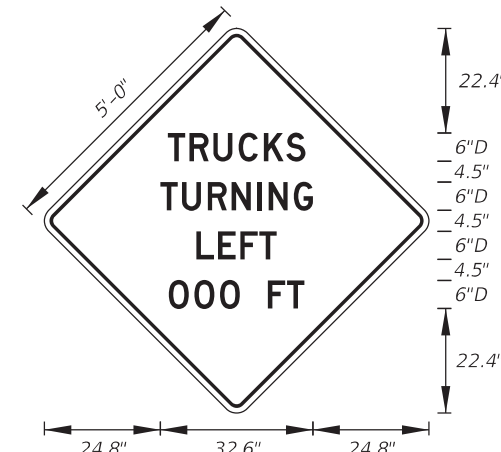


MOT-7-06  
5' X 5'  
2" Radii 3/4" Border  
6" Series D Legend  
Orange Background  
Black Legend and Border

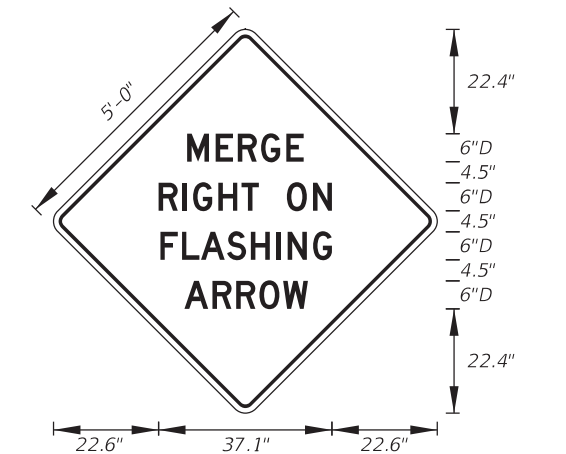


MOT-8-06  
5' X 5'  
2" Radii 3/4" Border  
6" Series D Legend  
Orange Background  
Black Legend and Border

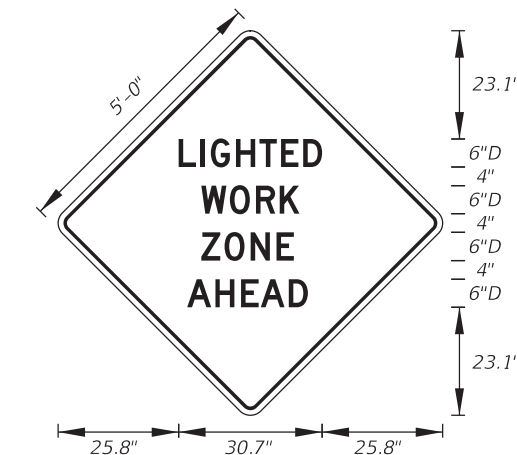


MOT-9-06  
5' X 5'  
2" Radii 3/4" Border  
6" Series D Legend  
Orange Background  
Black Legend and Border

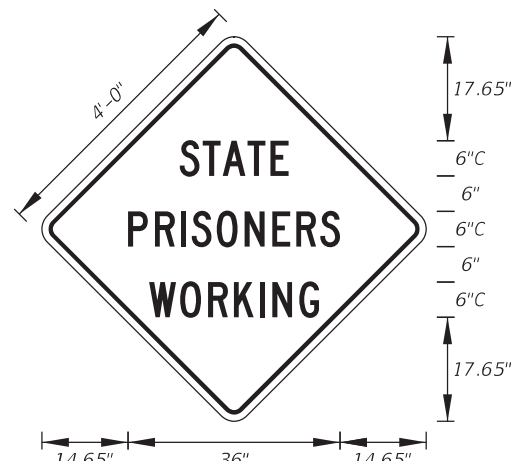

MOT-10-06  
4' X 4'  
2" Radii 3/4" Border  
6" Series C Legend  
Orange Background  
Black Legend and Border

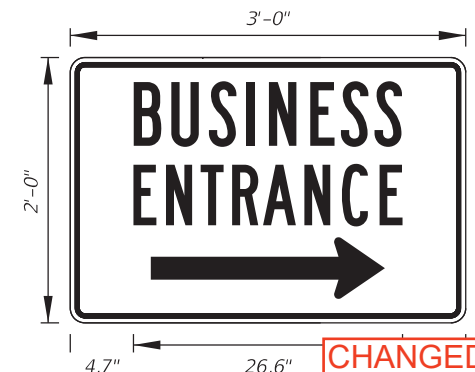


MOT-11-06  
3' X 2'  
2" Radii 3/4" Border  
6" Series B Legend  
Blue Background  
White Legend and Border

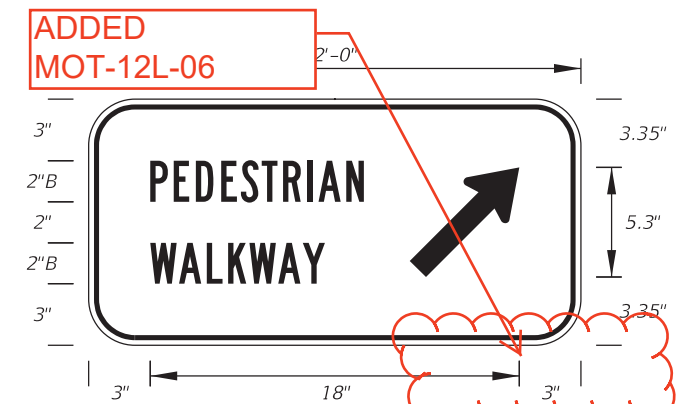


MOT-12-06  
2' X 1'  
2" Radii 3/4" Border  
2" Series B Legend  
White Background  
Black Legend and Border


10/14/2016 8:43:38 AM

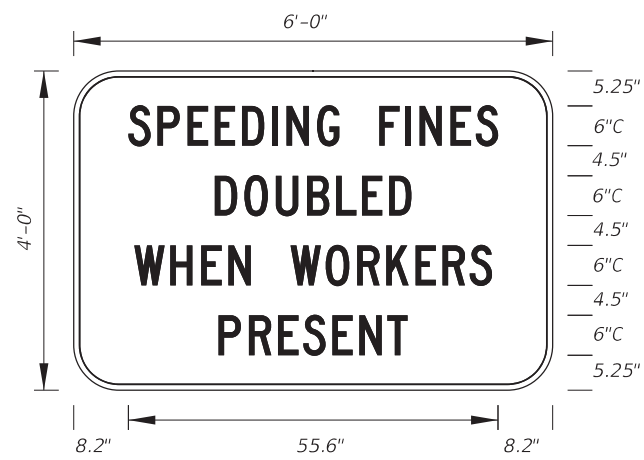


MOT-13-06 Freeway Sign  
6' X 4'  
6" Radii 3/4" Border  
6" Series C Legend  
White Background  
Black Legend and Border

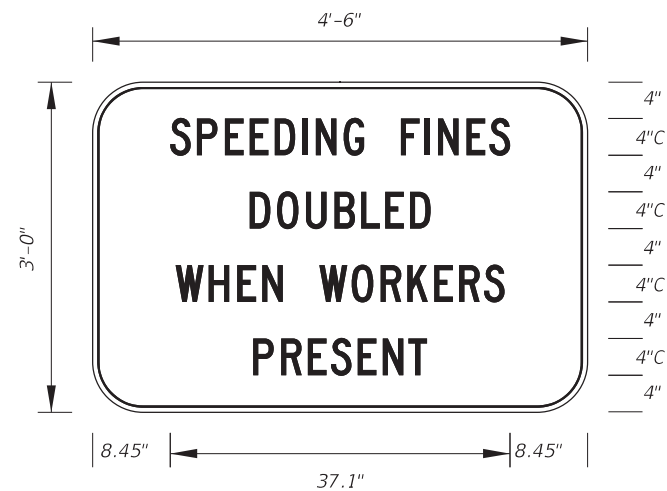


MOT-14-06 Arterial Sign  
4'-6" X 3'  
5" Radii 3/4" Border  
4" Series C Legend  
White Background  
Black Legend and Border

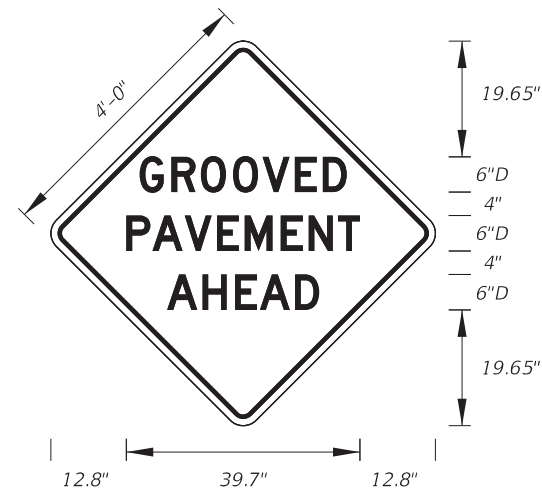


MOT-15-06  
4' X 4'  
2" Radii 3/4" Border  
6" Series D Legend  
Orange Background  
Black Legend and Border

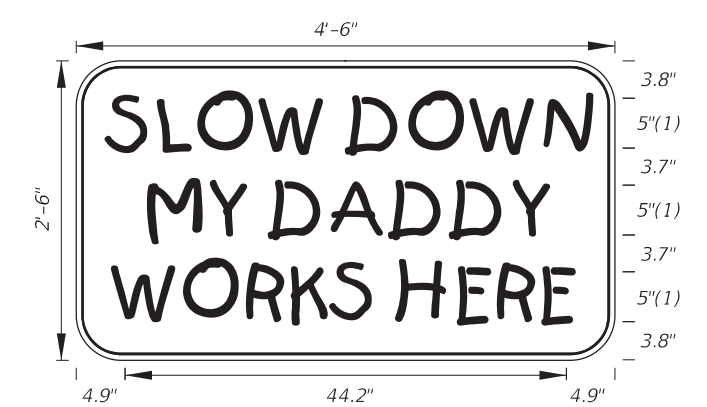


MOT-16-06  
4'-6" X 2'-6"  
4" Radii 3/4" Border  
5" Kids Series Legend  
Orange Background  
Black Legend and Border

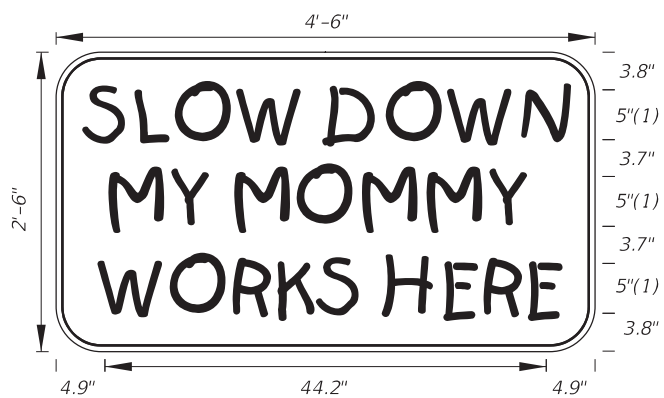


MOT-17-06  
4'-6" X 2'-6"  
4" Radii 3/4" Border  
5" Kids Series Legend  
Orange Background  
Black Legend and Border

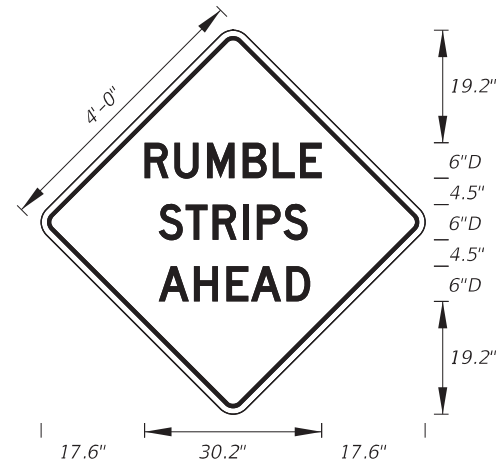


MOT-18-10  
4' X 4'  
2" Radii 3/4" Border  
6" Series D Legend  
Orange Background  
Black Legend and Border

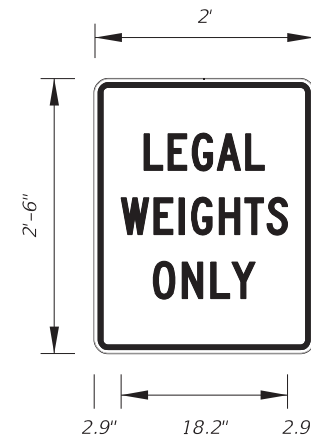

MOT-19-11  
2' X 2'-6"  
1.13" Radii 3/4" Border  
4" Series C Legend  
White Background  
Red Legend and Border

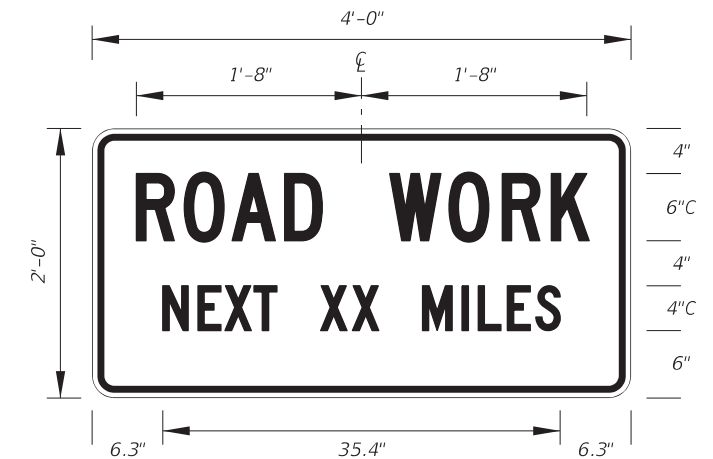

G20-1  
2' X 4'  
1.5" Radii 3/4" Border  
Orange Background  
Black Legend and Border

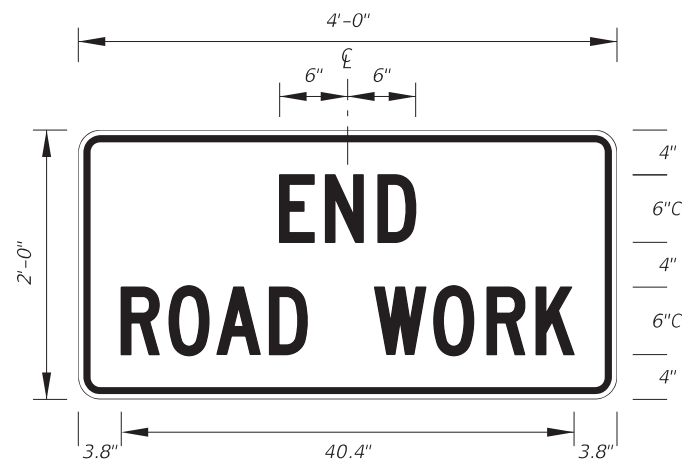

G20-2  
2' X 4'  
1.5" Radii 3/4" Border  
Orange Background  
Black Legend and Border

8:43:41 AM  
10/14/2016

LAST REVISION  
~~07/01/14~~

REVISION

DESCRIPTION:




FY 2017-18  
DESIGN STANDARDS

SPECIAL SIGN DETAILS


INDEX NO.  
~~17355~~

SHEET NO.  
11 of 11

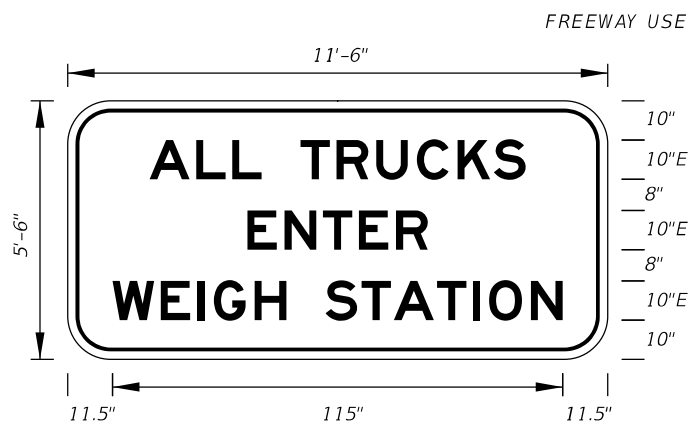


**FTP-1-06**  
11'-6" X 5'-6"  
9" Radii 2" Border

10" Series E Legend  
White Background  
Black Legend and Border

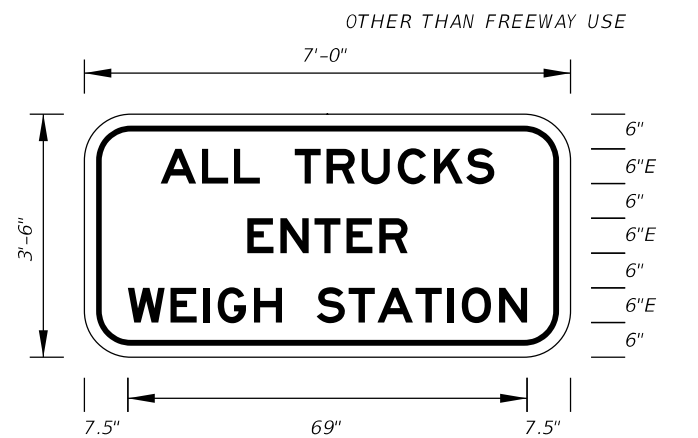


**FTP-2-06**  
7' X 3'-6"  
6" Radii 2" Border

6" Series E Legend  
White Background  
Black Legend and Border

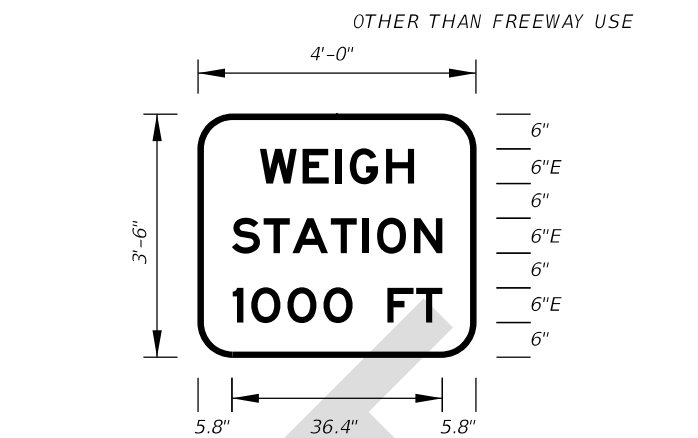

**FTP-3-06**  
4' X 3'-6"  
6" Radii 2" Border


6" Series E Legend  
Green Background  
White Legend and Border

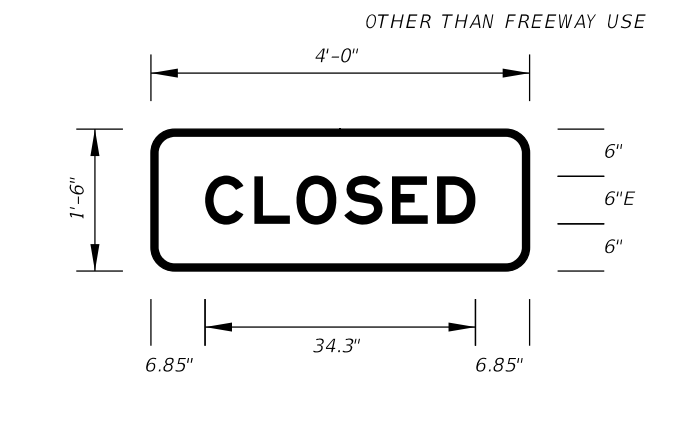

**FTP-4-06**  
4' X 1'-6"  
3" Radii 2" Border


6" Series E Legend  
Green Background  
White Legend and Border

Note:  
FTP-4-06 to be  
used with FTP-3-06

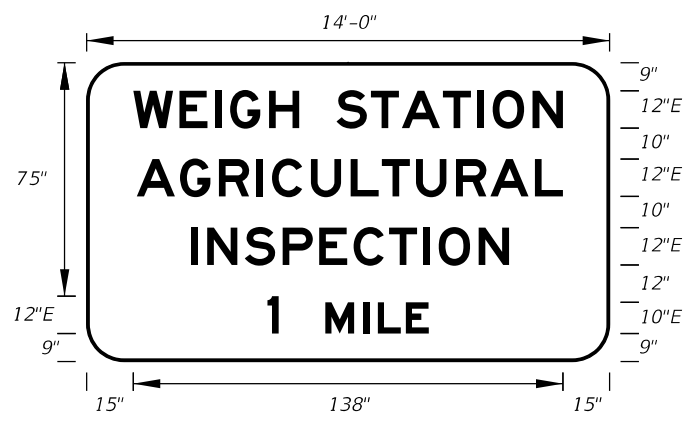

**FTP-5-06**  
14' X 8'  
12" Radii 2" Border


12" and 10" Series E Legend  
Green Background  
White Legend and Border

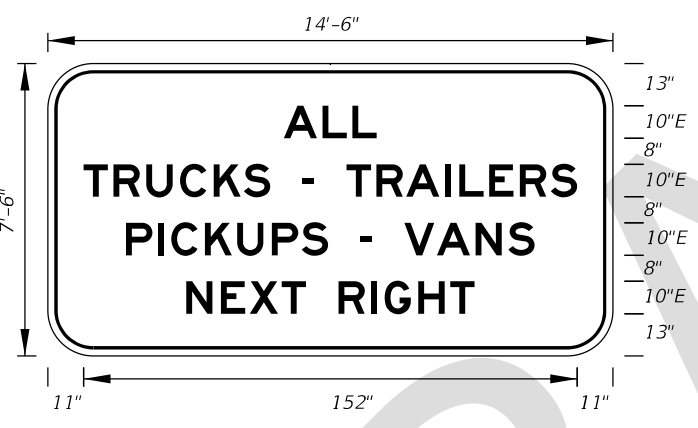

**FTP-6A-06**  
14'-6" X 7'-6"  
12" Radii 2" Border

10" Series E Legend  
White Background  
Black Legend and Border

On Interstate Station  
Delete Pickups-Vans,  
and reduce Sign height  
accordingly.

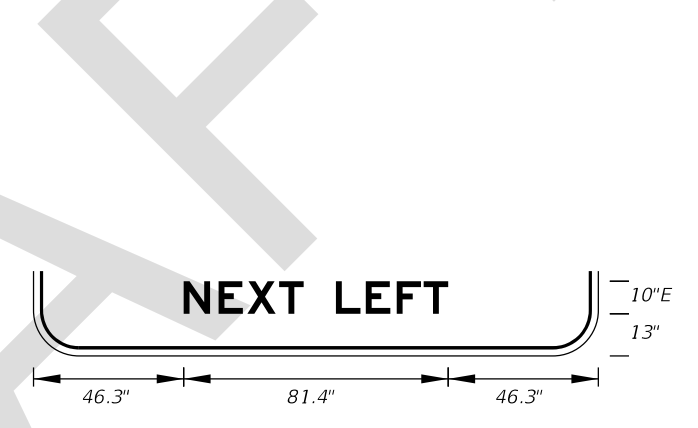


**FTP-6B-06**  
14'-6" X 7'-6"  
12" Radii 2" Border

10" Series E Legend  
White Background  
Black Legend and Border




**FTP-7A-06**  
12' X 7'  
11" Radii 2" Border

10" Series E Legend  
Green Background  
White Legend and Border

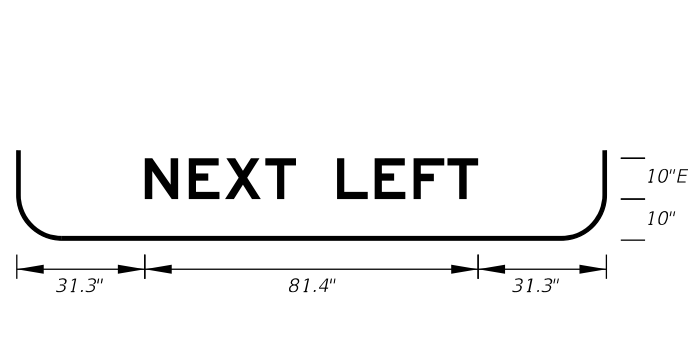

**FTP-7B-06**  
12' X 7'  
11" Radii 2" Border


10" Series E Legend  
Green Background  
White Legend and Border

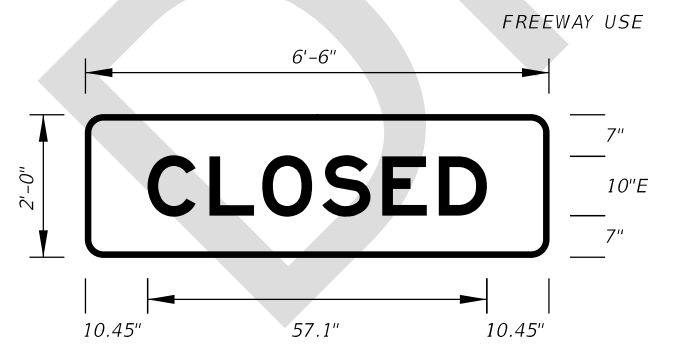

**FTP-8-06**  
6'-6" X 2'  
3" Radii 2" Border


10" Series E Legend  
Green Background  
White Legend and Border

Note:  
FTP-8-06 to be  
used with FTP-7A-06  
& FTP-7B-06.

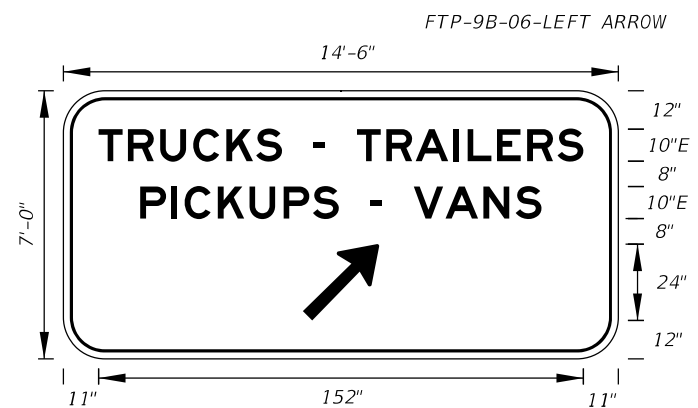

**FTP-9A-06**  
14'-6" X 7'  
11" Radii 2" Border


10" Series E Legend  
Green Background  
White Legend and Border

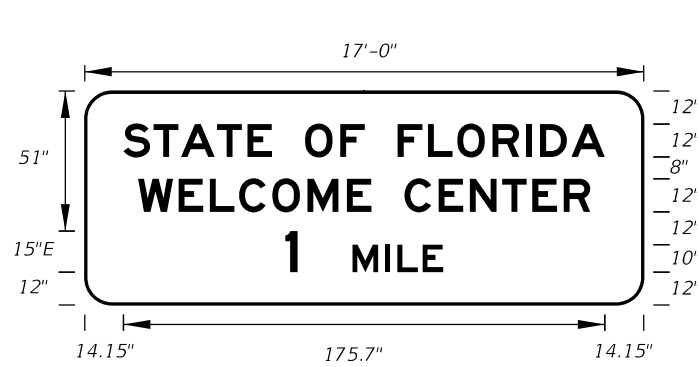


**FTP-10-06**  
17' X 6'-6"  
10" Radii 2" Border

12", 10" and 15" Series E Legend  
Blue Background  
White Legend and Border


8/30/2017 7:57:19 AM

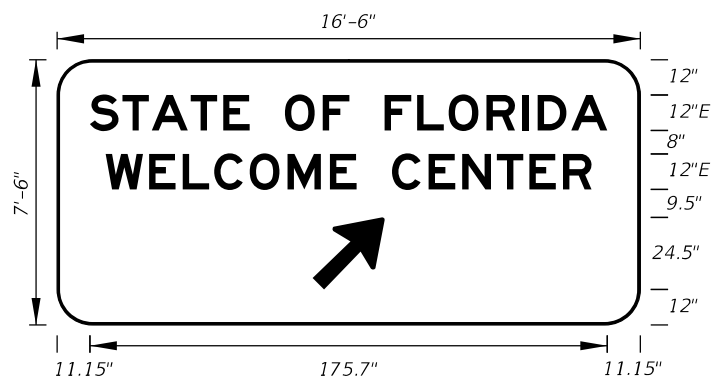


**FTP-11-06**  
 16'-6" X 7'-6"  
 12" Radii 2" Border  
 12" Series E Legend  
 Blue Background  
 White Legend and Border

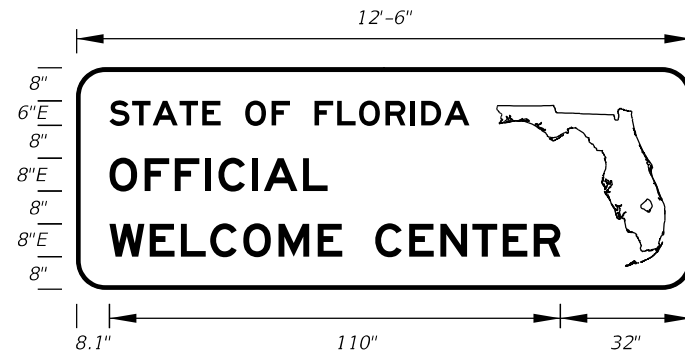


**FTP-12-06**  
 12'-6" X 4'-6"  
 7" Radii 2" Border  
 6" and 8" Series E Legend  
 Blue Background  
 White Legend and Border

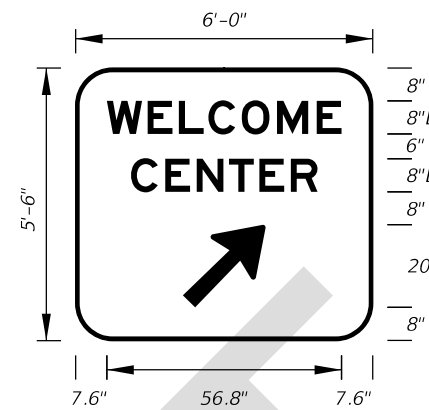


**FTP-13-06**  
 6' 0" X 5'-6"  
 9" Radii 2" Border  
 8" Series E Legend  
 Blue Background  
 White Legend and Border

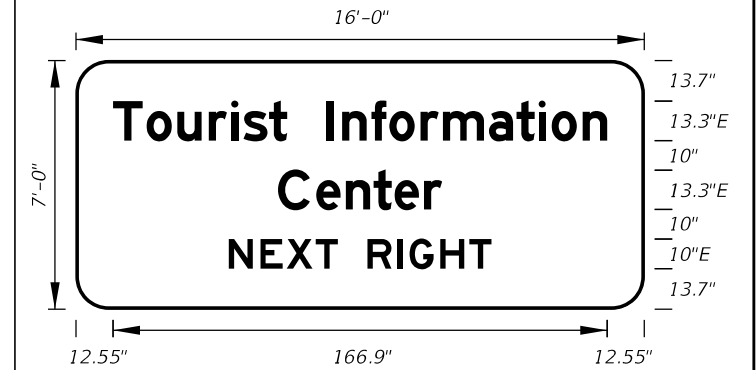


**FTP-14-06**  
 16'-0" X 7'-0"  
 11" Radii 2" Border  
 13.3 and 10" Series E Legend  
 Blue Background  
 White Legend and Border

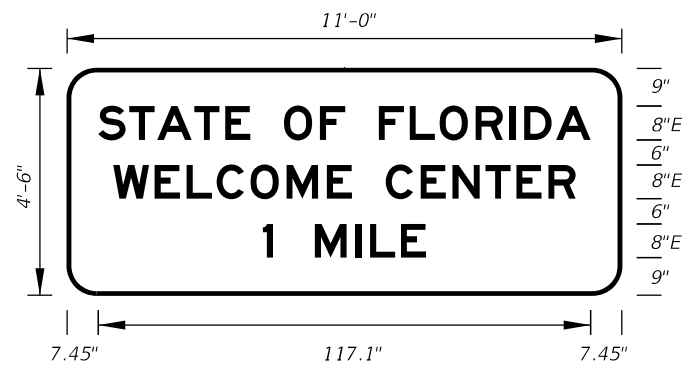

**FTP-15A-06**  
 11'-0" X 4'-6"  
 7" Radii 2" Border  
 8" Series E Legend  
 Blue Background  
 White Legend and Border

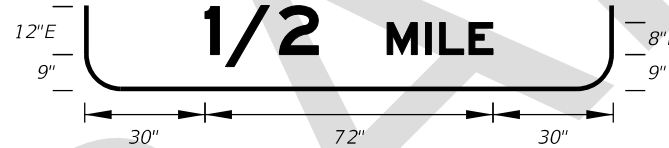

**FTP-15B-06**  
 11'-0" X 5'-0"  
 8" Radii 2" Border  
 8" and 12" Series E Legend  
 Blue Background  
 White Legend and Border

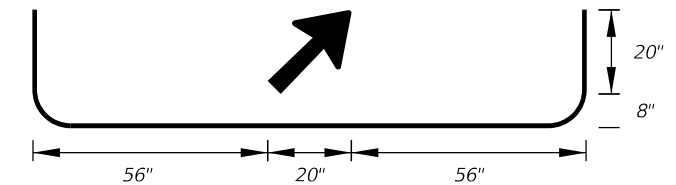

**FTP-15C-06**  
 11'-0" X 5'-6"  
 9" Radii 2" Border  
 8" Series E Legend  
 Blue Background  
 White Legend and Border



**FTP-16-10**  
 2'-6" X 3'-0"  
 1.5" Radii 3/4" Border  
 5" Series B Legend  
 Green Background  
 White Legend, Border,  
 and Florida Symbol



**FTP-17-10**  
 3'-0" X 4'-0"  
 1.5" Radii 3/4" Border  
 7" Series B Legend  
 Green Background  
 White Legend, Border,  
 and Florida Symbol



**FTP-18-10**  
 4'-0" X 5'-0"  
 3" Radii 1 1/4" Border  
 8" Series B Legend  
 Green Background  
 White Legend, Border,  
 and Florida Symbol

8/30/2017 7:57:19 AM

LAST REVISION	DESCRIPTION:
11/01/17	




FY 2018-19  
 STANDARD PLANS

SPECIAL SIGN DETAILS

INDEX  
 700-102

SHEET  
 2 of 11

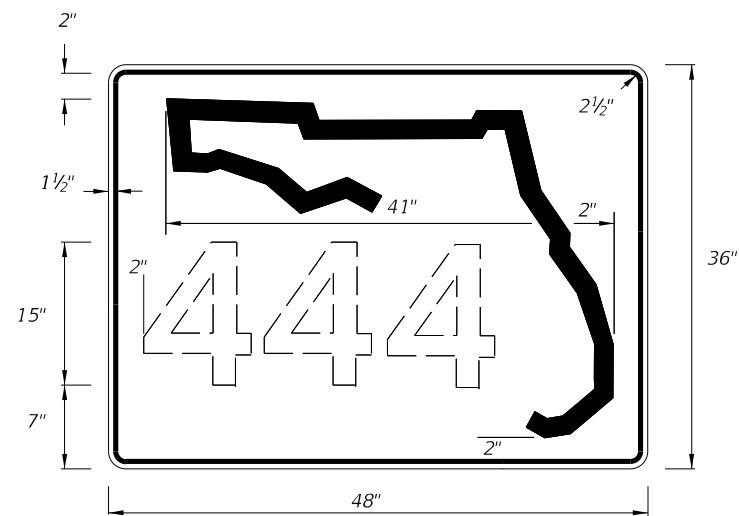


DIGITS	NUMERAL SIZE	SERIES LEGEND	PANEL SIZE
1-3	15"	C	48" x 36"
4	12"	C	48" x 36"


**NOTES:**

- Stroke width of State Outline shall be 1".
- 2 1/2" Radii

INDEPENDENT USE FOR FREEWAY

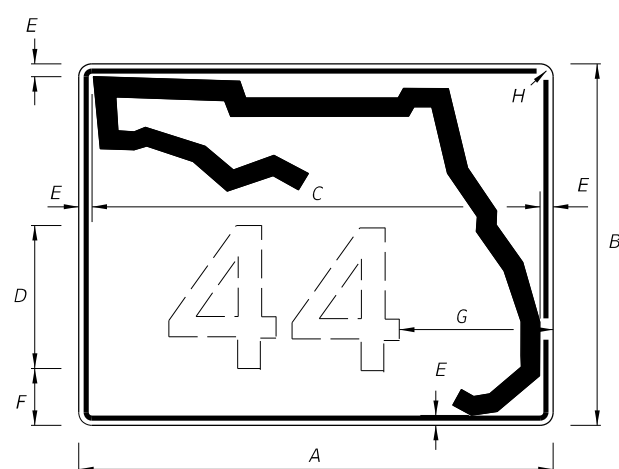

1 OR 2 DIGITS

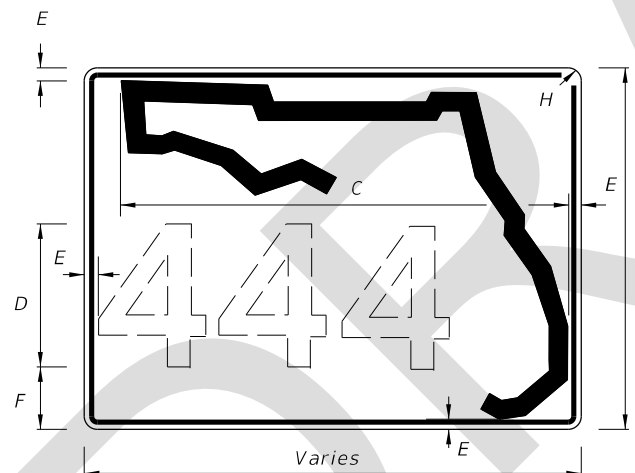

3 OR MORE DIGITS


**NOTES:**

- Florida marker shall have Black Legend with White Background.
- Stroke width of State outline shall be 1 3/4" for Guide Sign.
- Series D Legend.
- 5/8" Border

A	B	C	D	E	F	G	H
30"	24"	26"	12"	1 1/4"	2 3/4"	8 1/4"	1 1/4"
36"	30"	32"	15"	1 1/4"	3 1/4"	8 3/4"	1 1/4"
42"	36"	38"	15"	1 1/4"	6 1/4"	11"	1 1/4"


GUIDE SIGN USE

FTP-17-06 - FLORIDA ROUTE MARKER

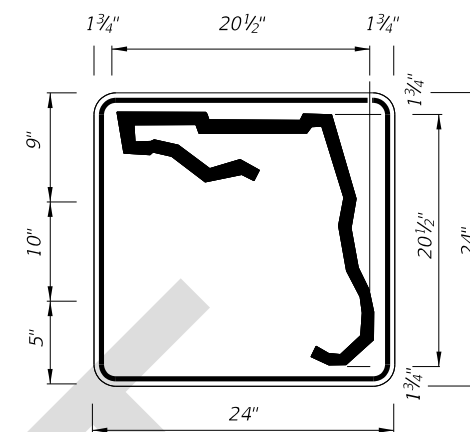

1 or 2 DIGITS

DIGITS	NUMERAL SIZE	SERIES LEGEND	PANEL SIZE
1-2	10"	D	24" x 24"

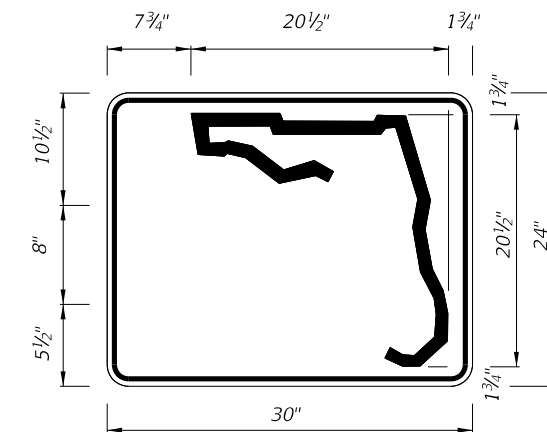

3 or 4 DIGITS

DIGITS	NUMERAL SIZE	SERIES LEGEND	PANEL SIZE
3	8"	D	30" x 24"
4	8"	C	30" x 24"


**NOTES:**

- Stroke width of State Outline shall be 1".
- The 24" X 24" panel shall only be used for a 3 digit route when the panel is to be used on a sign cluster with other 24" X 24" panels.
- 1 1/2" Radii

INDEPENDENT USE OTHER THAN FREEWAY

**NOTES:**

- Series D Legend.
- Color: Yellow Legend and Border on Blue Background.
- When used on a guide sign, marker must be overlaid on a rectangular Yellow Background as shown in chart.

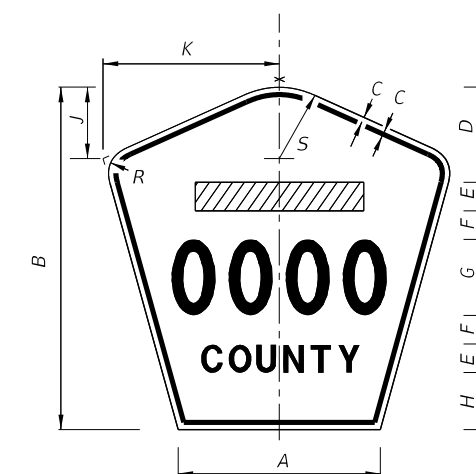


SIGN	DIMENSIONS													Rectangular Yellow Background Dimensions (See Note 3)
	A	B	C	D	E	F	G	H	J	K	R	S		
4 DIGIT POST MOUNTED	25 1/8"	42"	3/4"	10"	4"	4"	8"	8"	8 3/8"	22"	5"	8 3/4"		
2 DIGIT OVERHEAD	21 1/2"	36"	1/2"	7 1/2"	3"	3"	12"	4 1/2"	7 1/8"	18 1/8"	4 1/4"	7 1/2"	42" x 42"	
3 DIGIT OVERHEAD	25 1/8"	42"	3/4"	8"	4"	4"	12"	6"	8 3/8"	22"	5"	8 3/4"	48" x 48"	
4 DIGIT OVERHEAD	29 7/8"	48"	3/4"	8"	5"	5"	12"	8"	9 3/4"	25 5/8"	5 3/4"	10 1/4"	52" x 52"	

FTP-18-06 - COUNTY ROUTE MARKER (M1-6)

8/30/2017 7:57:20 AM




**FTP-19-06**  
 1' X 1'-6"  
 4" Radii 3/8" Border  
 Top 4" Series D  
 Bottom 2" Series C  
 White Background  
 Green Legend and Border

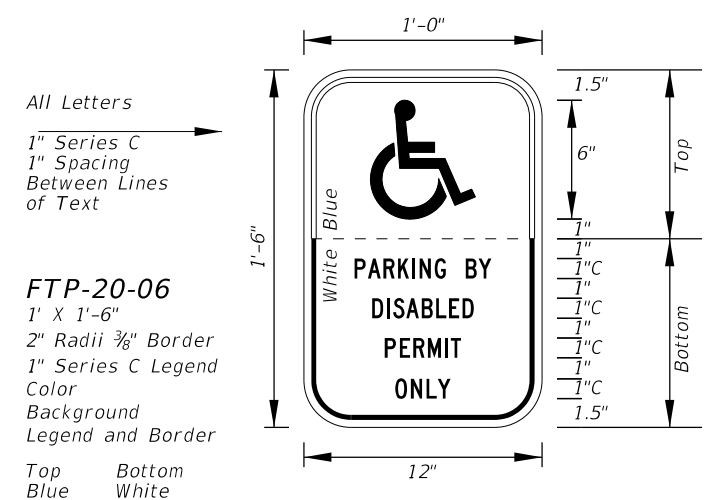


**FTP-20-06**  
 1' X 1'-6"  
 2" Radii 3/8" Border  
 1" Series C Legend  
 Color  
 Background  
 Legend and Border

Top Blue  
 Bottom White  
 White Black

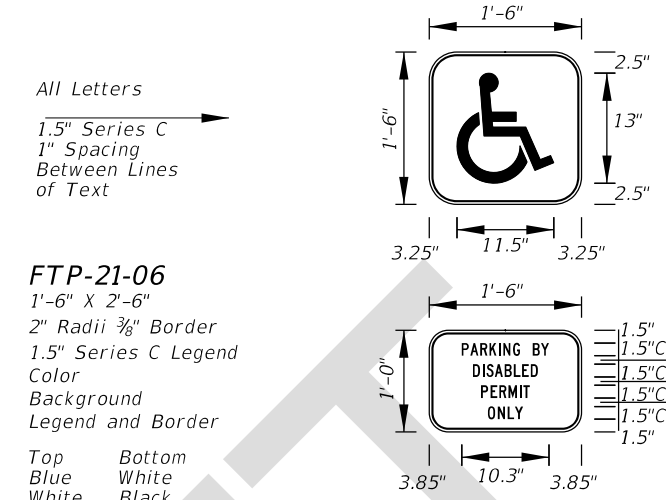


**FTP-21-06**  
 1'-6" X 2'-6"  
 2" Radii 3/8" Border  
 1.5" Series C Legend  
 Color  
 Background  
 Legend and Border

Top Blue  
 Bottom White  
 White Black

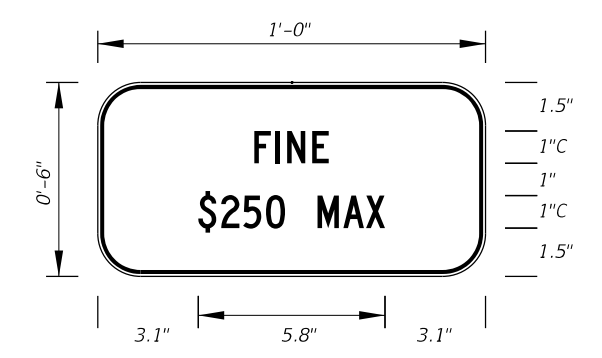


**FTP-22-06**  
 1' X 6"  
 1" Radii 3/8" Border  
 1" Series C Legend  
 White Background  
 Black Legend and Border

Supplemental Panel  
 for the FTP-20-06  
 and FTP-21-06 signs

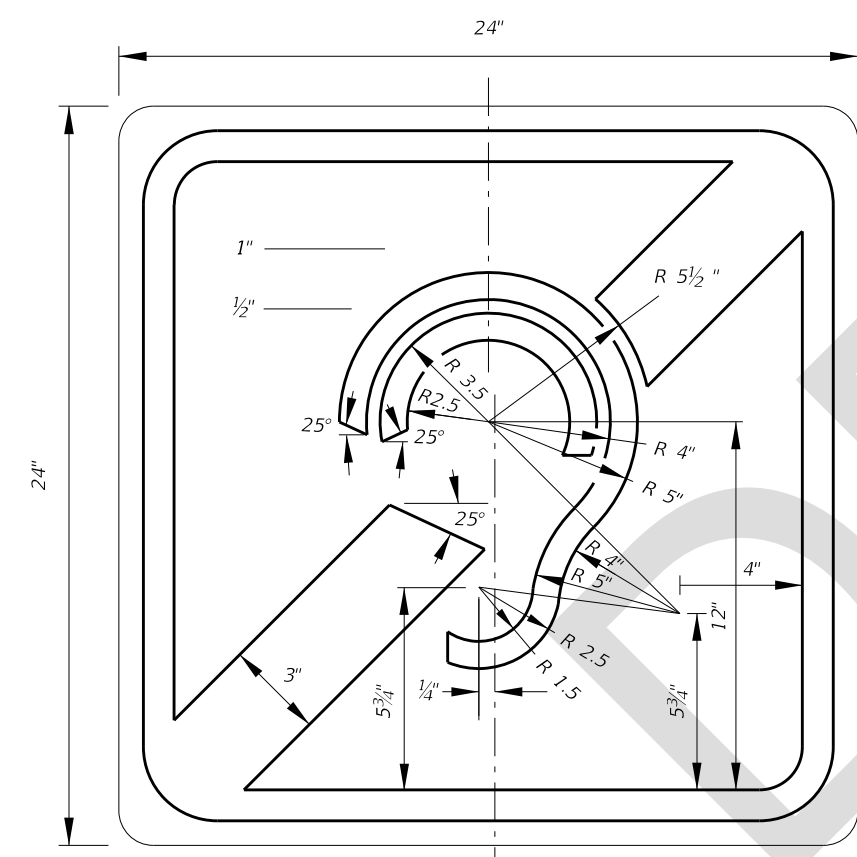

**FTP-23-06**  
 2' X 2'  
 1.5" Radii 5/8" Border  
 Blue Background  
 White Legend and Border

INTERNATIONAL SYMBOL OF  
 ACCESS FOR HEARING LOSS

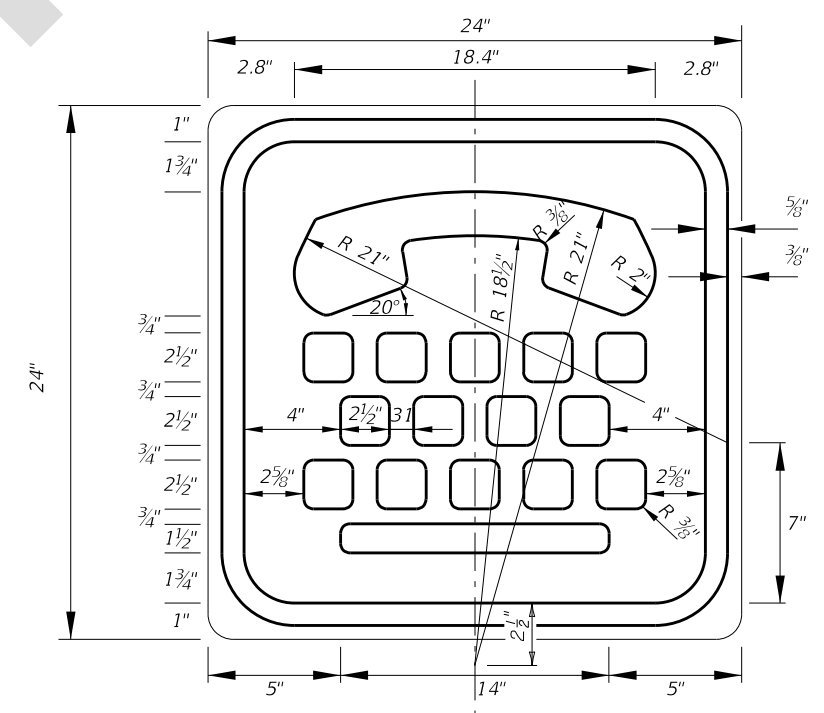


**FTP-24-06**  
 2' X 2'  
 1.5" Radii 5/8" Border  
 Blue Background  
 White Legend and Border


INTERNATIONAL TDD SYMBOL

8/30/2017 7:57:20 AM




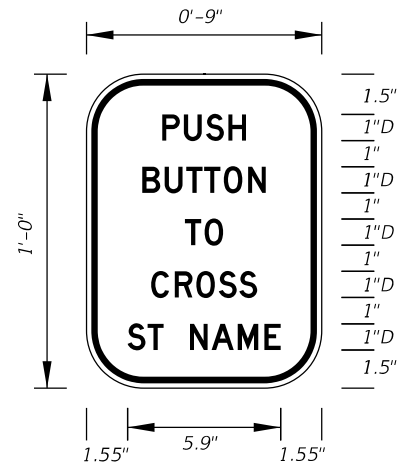


**FTP-25-06**  
 9" X 1'-0"  
 2" Radii 3/8" Border  
 1" Series D Legend  
 White Background  
 Black Legend and Border

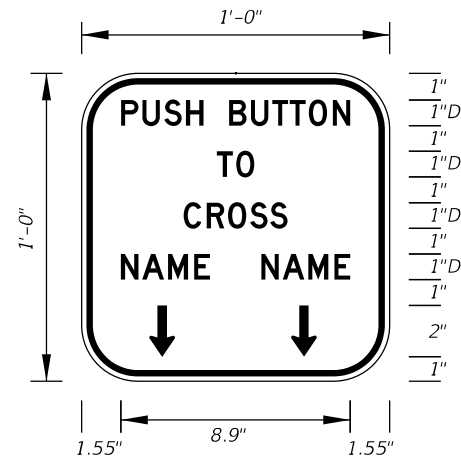


**FTP-26-06**  
 1' X 1'  
 2" Radii 3/8" Border  
 1" Series D Legend  
 White Background  
 Black Legend and Border

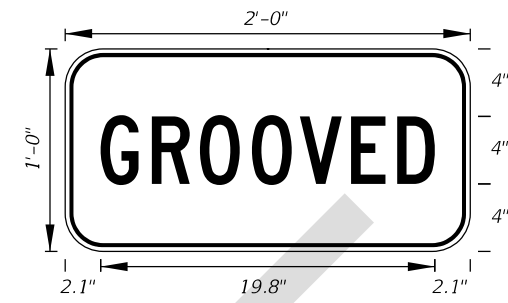


**FTP-29-06**  
 2'-0" X 1'-0"  
 2" Radii 5/8" Border  
 4" Series C Legend  
 Yellow Background  
 Black Legend and Border

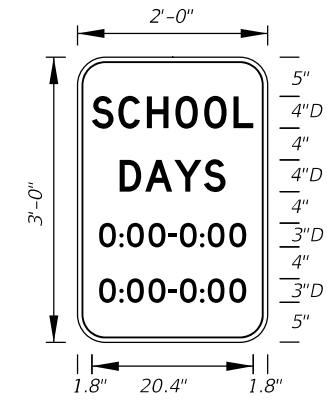


**FTP-30-06**  
 2'-0" X 3'-0"  
 3" Radii 5/8" Border  
 White Background  
 Black Legend and Border

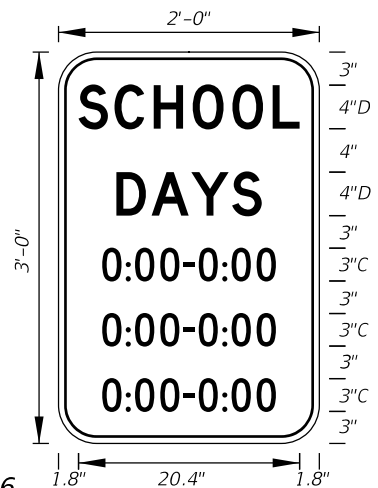


**FTP-30A-06**  
 2' X 3'  
 3" Radii 5/8" Border  
 Top 4" Series D Legend  
 Bottom 3" Series C Legend  
 White Background  
 Black Legend and Border

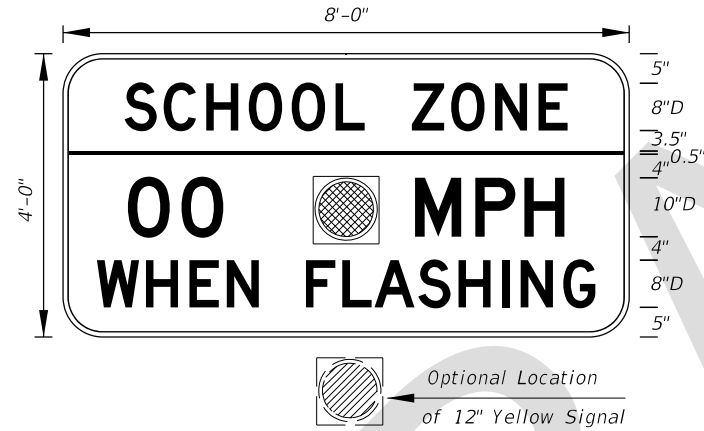


**FTP-31-06**  
 8' X 4'  
 6" Radii 3/4" Border  
 Series D Legend  
 Yellow Background Top  
 White Background Bottom  
 Black Legend and Border

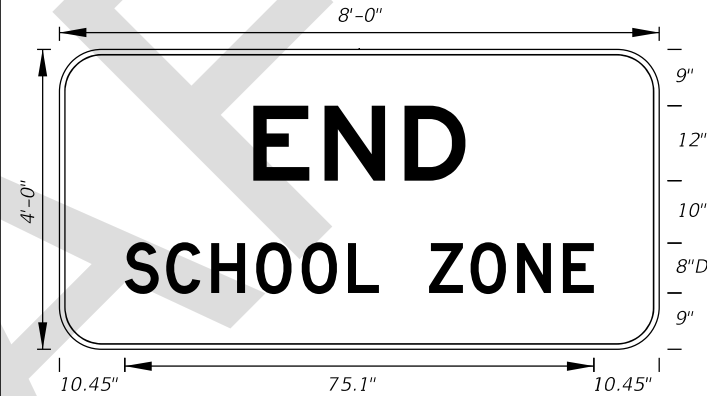


**FTP-32-06**  
 8' X 4'  
 6" Radii 3/4" Border  
 12" Series E and 8" Series D Legend  
 White Background  
 Black Legend and Border

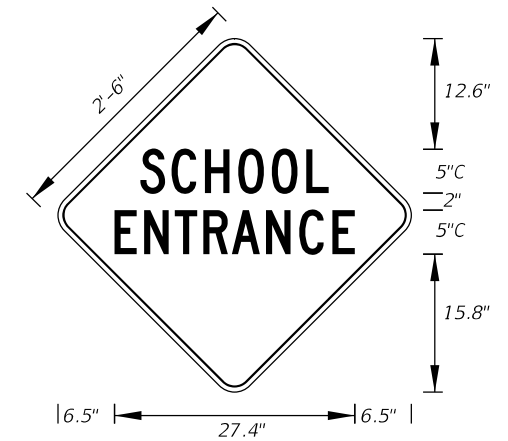


**FTP-33-06**  
 2'-6" X 2'-6"  
 2" Radii 3/4" Border  
 5" Series C Legend  
 Yellow Background  
 Black Legend and Border

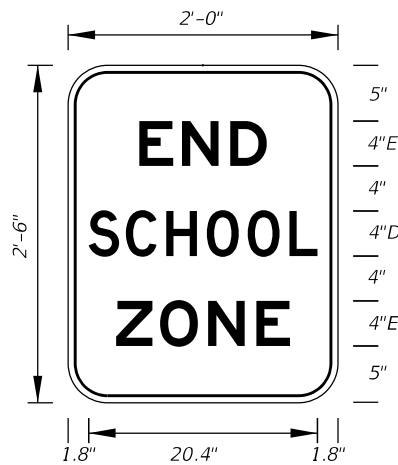


**FTP-34-06**  
 2' X 2'-6"  
 3" Radii 5/8" Border  
 4" Series D and E Legend  
 White Background  
 Black Legend and Border

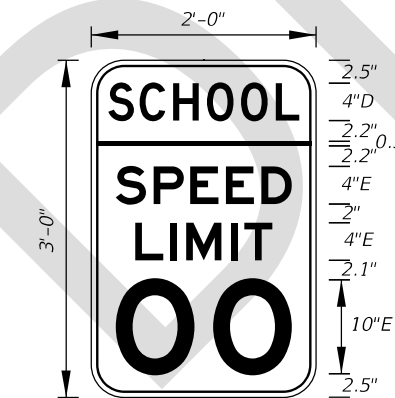

**FTP-35-06**  
 2' X 3'  
 3" Radii 5/8" Border  
 Top 4" Series D Legend  
 Bottom 4" and 10" Series E Legend  
 Yellow Background Top  
 White Background Bottom  
 Black Legend and Border

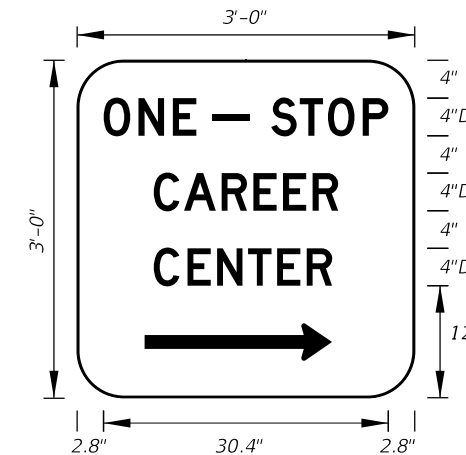


**FTP-36-06**  
 3' X 3'  
 5" Radii  
 4" Series D Legend  
 Green Background  
 White Legend and Border

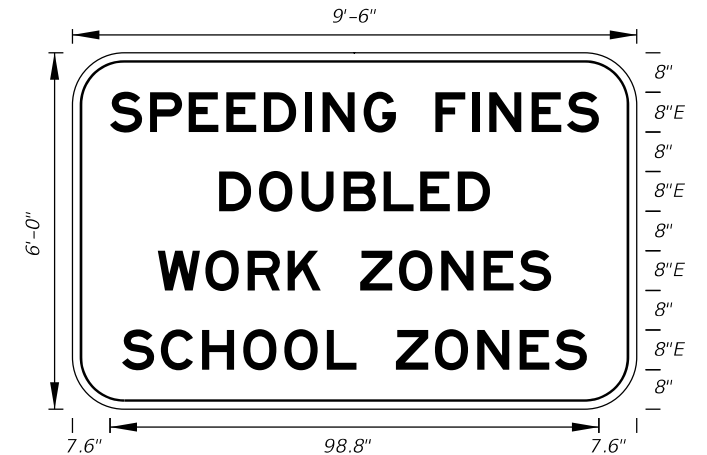


**FTP-37-06**  
 9'-6" X 6'  
 9" Radii 2" Border  
 8" Series E Legend  
 White Background  
 Black Legend and Border  
 State Line Sign

8/30/2017 7:57:21 AM

LAST REVISION	DESCRIPTION:
11/01/17	

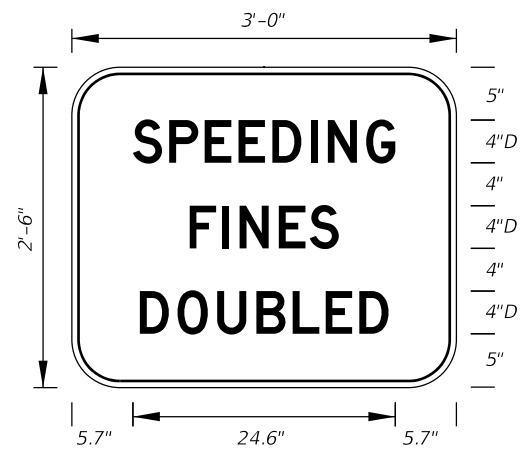


**FTP-38-06**  
 3' X 2'-6"  
 4" Radii 3/4" Border  
 4" Series D Legend  
 White Background  
 Black Legend and Border

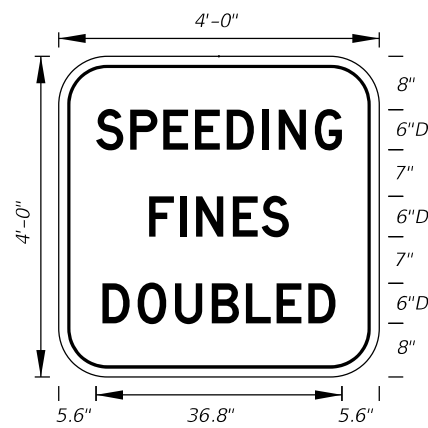

**FTP-39-06**  
 4' X 4'  
 6" Radii 3/4" Border  
 6" Series D Legend  
 White Background  
 Black Legend and Border  
 Freeway Sign




**FTP-40-06**  
 3'-6" X 4'  
 6" Radii 3/4" Border  
 3" and 6" Series C Legend  
 White Background  
 Black Legend and Border

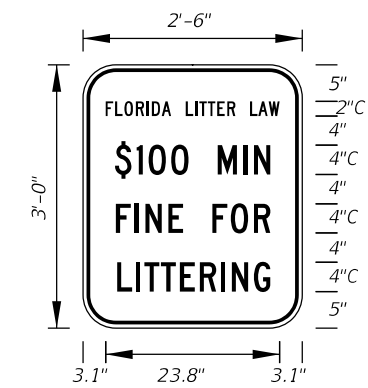

**FTP-41-06**  
 2'-6" X 3'  
 4" Radii 3/4" Border  
 2" and 4" Series C Legend  
 White Background  
 Black Legend and Border



**FTP-42-06**  
 4' X 2'-6"  
 3" Radii  
 Top 4" Series C Legend  
 Bottom 2" Series EM Legend  
 White Background  
 Blue Legend and Border

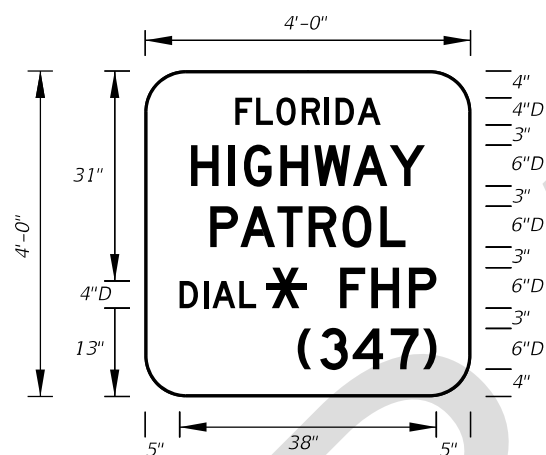


**FTP-43-06**  
 4' X 4'  
 6" Radii 1" Border  
 Top 4" Series D Legend  
 Bottom 6" Series D Legend  
 Blue Background  
 White Legend and Border




**FTP-44-06**  
 9' X 6'  
 9" Radii 3/4" Border  
 8" Series D Legend  
 White Background  
 Black Legend and Border




**FTP-45-06**  
 4' X 3'  
 5" Radii 3/4" Border  
 4" Series C Legend  
 White Background  
 Black Legend and Border

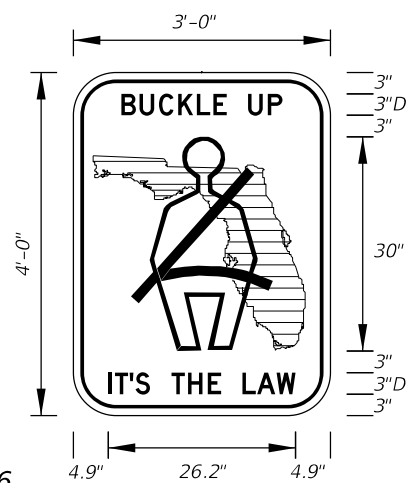


**FTP-46-06**  
 3' X 4'  
 5" Radii 3/4" Border  
 3" Series D Legend  
 White Background  
 Black Legend, Border and Man Belt Symbol  
 Green Florida Symbol

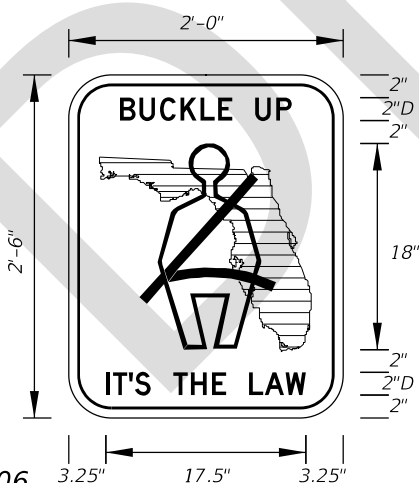

**FTP-47-06**  
 2' X 2'-6"  
 3" Radii 5/8" Border  
 2" Series D Legend  
 White Background  
 Black Legend, Border and Man Belt Symbol  
 Green Florida Symbol

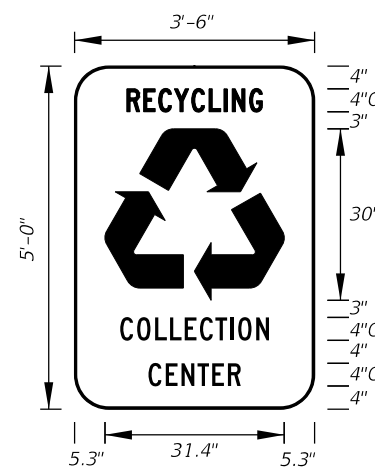


**FTP-48-06**  
 3'-6" X 5'  
 6" Radii  
 4" Series C Legend  
 Green Background  
 White Legend, Border and Symbol

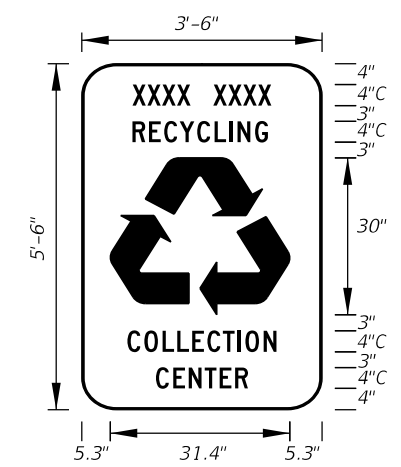


**FTP-49-06**  
 3'-6" X 5'-6"  
 6" Radii  
 4" Series C Legend  
 Green Background  
 White Legend, Border and Symbol  
 Municipality Name Optional

8/30/2017 7:57:21 AM


LAST REVISION	DESCRIPTION:
11/01/17	

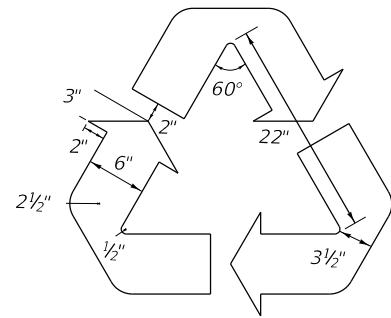


Detail for FTP-48-06 and FTP-49-06

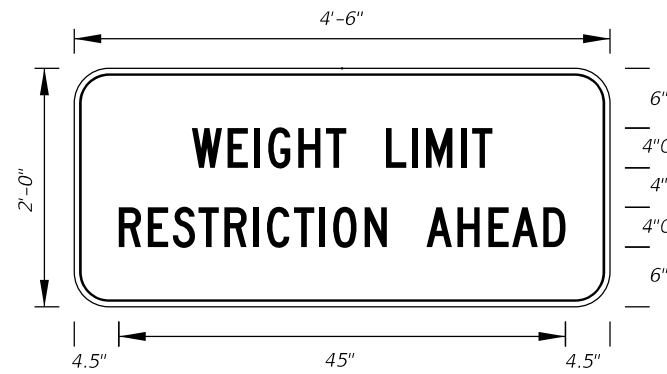


**FTP-50-06**  
4'-6" X 2'  
3" Radii 3/4" Border  
4" Series C Legend  
Yellow Background  
Black Legend and Border

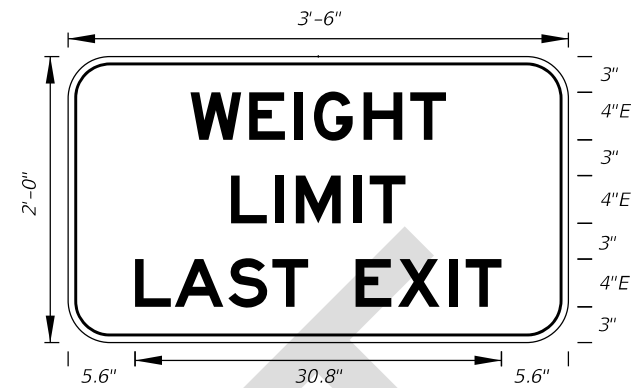


**FTP-51-06**  
3' X 2'  
3" Radii 3/4" Border  
4" Series E Legend  
White Background  
Black Legend and Border

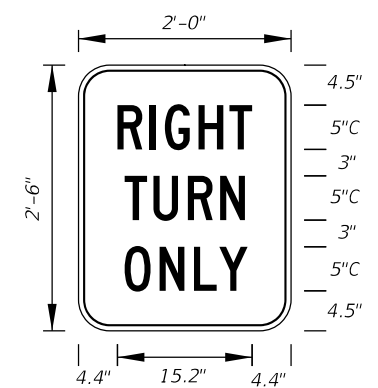

**FTP-52-06**  
2' X 2'-6"  
3" Radii 5/8" Border  
5" Series C Legend  
White Background  
Black Legend and Border

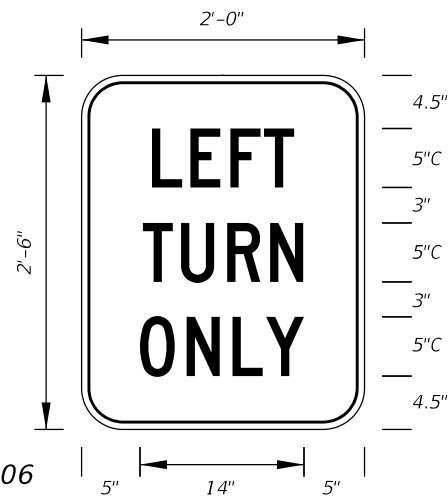


**FTP-53-06**  
2' X 2'-6"  
3" Radii 5/8" Border  
5" Series C Legend  
White Background  
Black Legend and Border

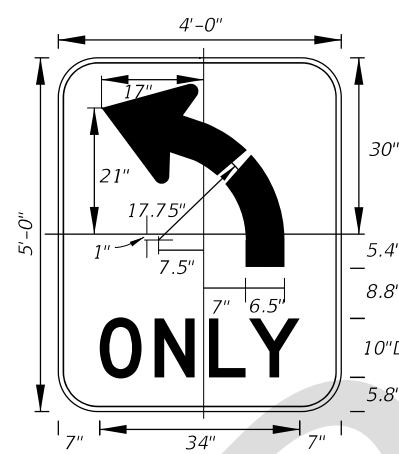


**FTP-54L-06**  
4' X 5'  
6" Radii 3/4" Border  
10" Series D Legend  
White Background  
Black Legend and Border

FTP-54R-06 for  
(Right Turn Arrow)

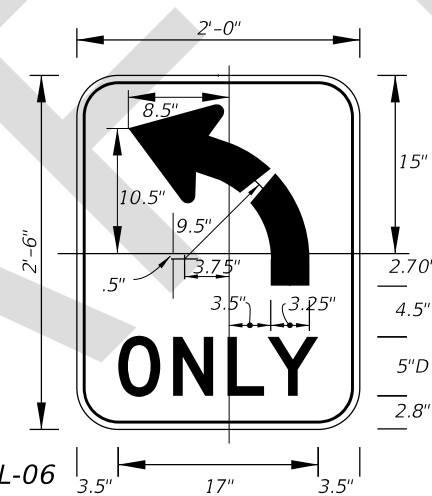


**FTP-55L-06**  
2' X 2'-6"  
3" Radii 5/8" Border  
5" Series D Legend  
White Background  
Black Legend and Border

FTP-55R-06 for  
(Right Turn Arrow)

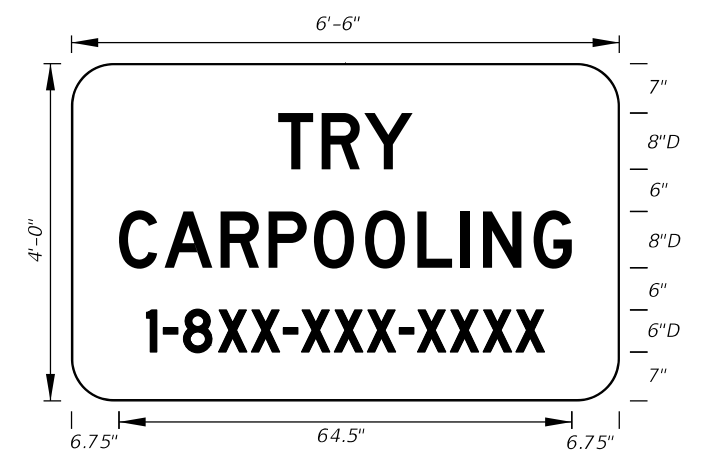


**FTP-56-06**  
6'-6" X 4'  
6" Radii 3/4" Border  
8" and 6" Series D Legend  
Blue Background  
White Legend and Border

Design Project Manager  
or Transit Administrator  
will supply correct 1-8XX  
number.

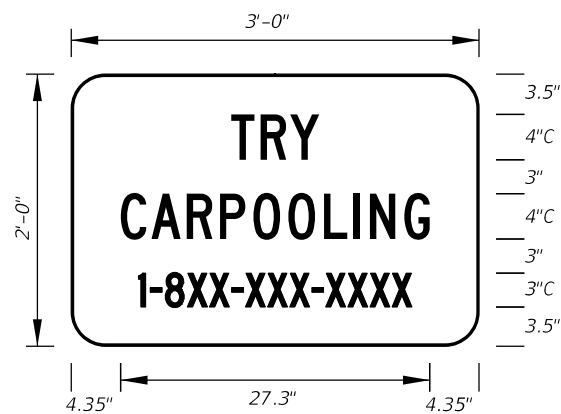


**FTP-56A-06**  
3' X 2'  
3" Radii  
4" and 3" Series C Legend  
Blue Background  
White Legend and Border

Design Project Manager  
or Transit Administrator  
will supply correct 1-8XX  
number.

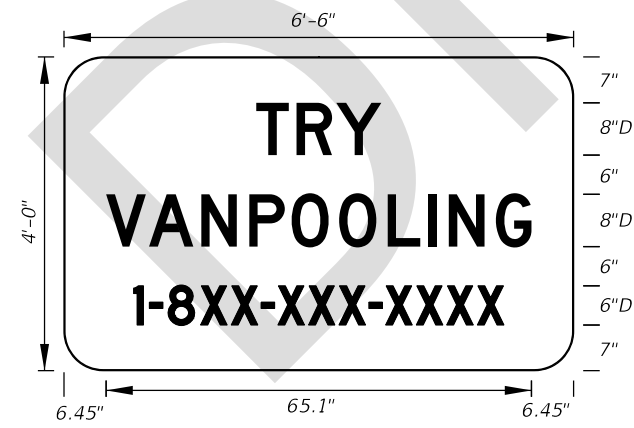


**FTP-57-06**  
6'-6" X 4'  
6" Radii  
8" and 6" Series D Legend  
Blue Background  
White Legend and Border

Design Project Manager  
or Transit Administrator  
will supply correct 1-8XX  
number.

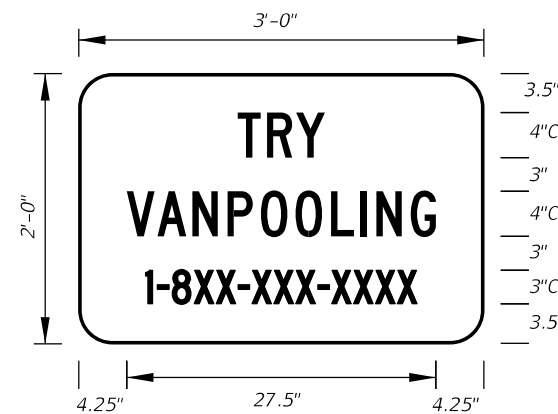

**FTP-58-06**  
3' X 2'  
3" Radii  
4" and 3" Series C Legend  
Blue Background  
White Legend and Border


Design Project Manager  
or Transit Administrator  
will supply correct 1-8XX  
number.

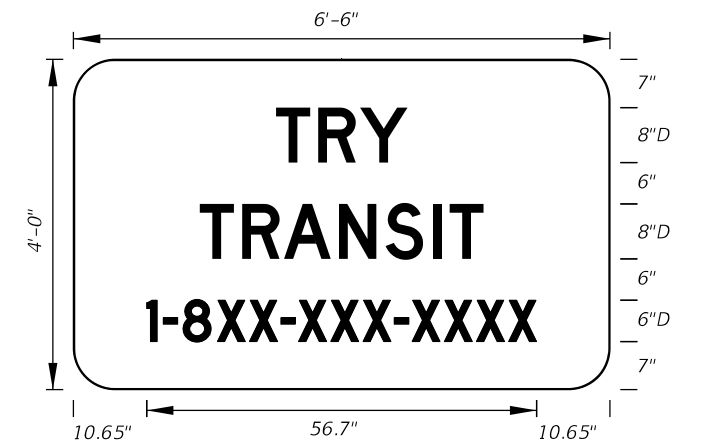


**FTP-59-06**  
6'-6" X 4'  
6" Radii  
8" and 6" Series D Legend  
Blue Background  
White Legend and Border

Design Project Manager  
or Transit Administrator  
will supply correct 1-8XX  
number.

8/30/2017 7:57:22 AM

LAST REVISION 11/01/17	DESCRIPTION:	 FY 2018-19 STANDARD PLANS	SPECIAL SIGN DETAILS	INDEX 700-102	SHEET 7 of 11
---------------------------	--------------	----------------------------------------------------------------------------------------------------------------------	----------------------	------------------	------------------

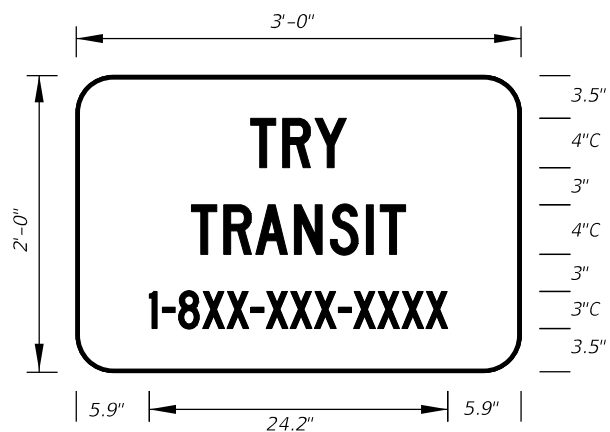

**FTP-60-06**  
 3' X 2'  
 3" Radii  
 4" and 3" Series C Legend  
 Blue Background  
 White Legend and Border


*Design Project Manager or Transit Administrator will supply correct 1-8XX number.*



**FTP-61-06**  
 3' X 2'  
 3" Radii 3/4" Border  
 4" and 3" Series C Legend  
 Yellow Background  
 Black Legend and Border



**FTP-62-06**  
 3' X 3'  
 2" Radii 3/4" Border 4" and 5" Series C Legend  
 Yellow Background Black Legend and Border

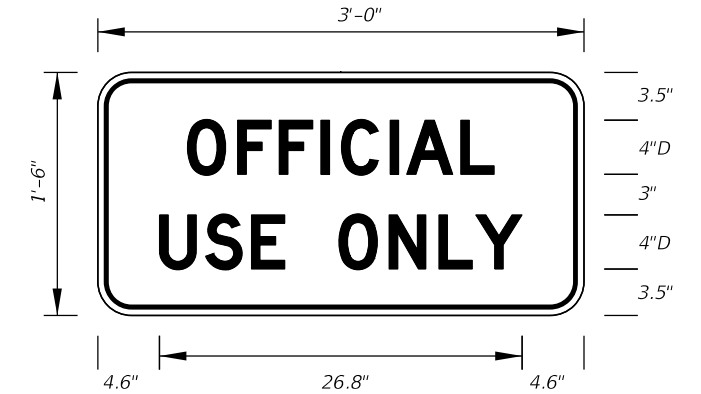

**FTP-65-06**  
 3' X 1'-6"  
 2" Radii 3/4" Border  
 4" Series D Legend  
 White Background  
 Black Legend and Border



**FTP-66-06**  
 4' X 5'  
 2" Radii 3/4" Border  
 7" Series D Legend  
 Blue Background  
 White Legend and Border




**FTP-67-06**  
 3' X 4'  
 2" Radii 3/4" Border  
 5" Series D Legend  
 Blue Background  
 White Legend and Border



DETAIL for FTP-66 AND FTP-67


Sign Mounting Holes Can Be Punched Or Field Drilled With No Obstruction To Text Or Symbols From Holes Or Bolts.

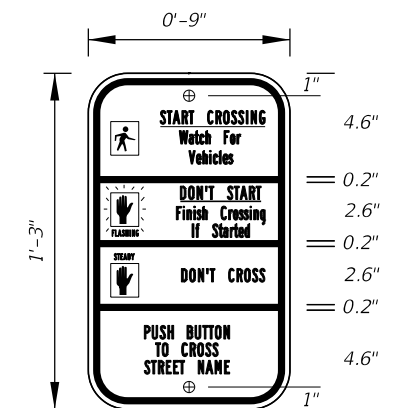

**FTP-68A-06**  
 9" X 1'-3"  
 1.5" Radii 3/4" Border  
 Series B Legend  
 White Background  
 Black Legend and Border


*See Standard Highway Signs Manual, Sign R10-3b For Letter Size Spacing And Symbol Sizes.*

Sign Mounting Holes Can Be Punched Or Field Drilled With No Obstruction To Text Or Symbols From Holes Or Bolts.

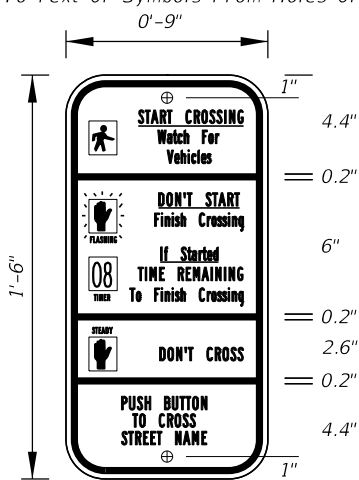

**FTP-68B-06**  
 9" X 1'-6"  
 1.5" Radii 3/4" Border  
 Series B Legend  
 White Background


*See Standard Highway Signs Manual, Sign R10-3b For Letter Size Spacing And Symbol Sizes.*

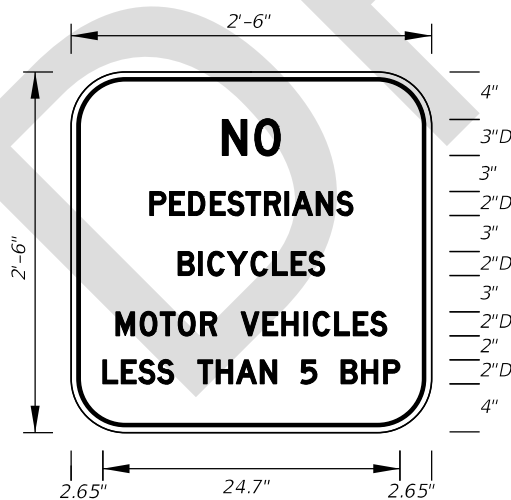

**FTP-69-06**  
 2'-6" X 2'-6"  
 4" Radii 3/4" Border  
 2" and 3" Series D Legend  
 White Background  
 Black Legend and Border



**FTP-70-06**  
 3'-6" X 2'-6"  
 2.25" Radii 3/4" Border  
 5" Series C and 7" Series C Legend  
 Blue Background  
 White Legend and Border

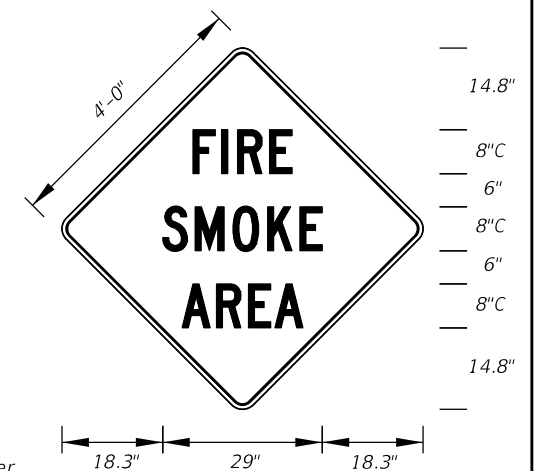

**FTP-71-06**  
 4' X 4'  
 2" Radii 3/4" Border  
 8" Series C Legend  
 Yellow Background  
 Black Legend and Border

8/30/2017 7:57:22 AM

LAST REVISION	DESCRIPTION:
11/01/17	



FY 2018-19  
 STANDARD PLANS

SPECIAL SIGN DETAILS


INDEX  
 700-102

SHEET  
 8 of 11



**FTP-72-06**  
3' X 3'  
2" Radii 3/4" Border

6" Series C Legend  
Yellow Background  
Black Legend and Border

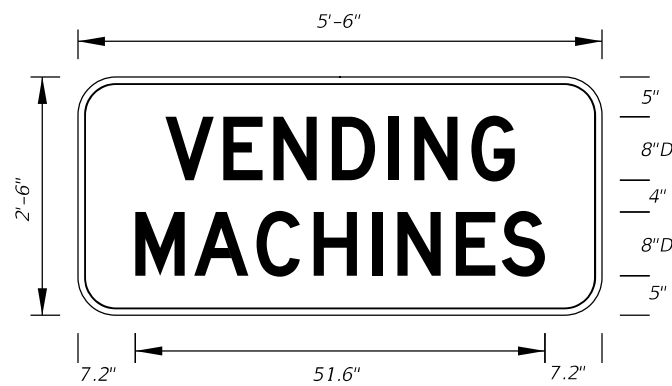


**FTP-73-06**  
5'-6" X 2'-6"  
4" Radii 3/4" Border


8" Series D Legend  
Blue Background  
White Legend and Border




**FTP-74-06**  
5'-6" X 2'-6"  
4" Radii 3/4" Border  
6" Series D Legend  
Blue Background  
White Legend and Border

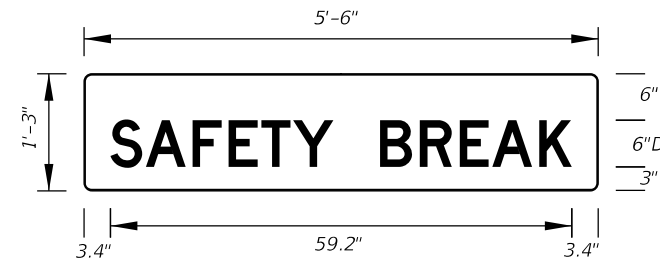


**FTP-75-06**  
5'-6" X 1'-3"  
1" Radii  
6" Series D Legend  
Blue Background  
White Legend

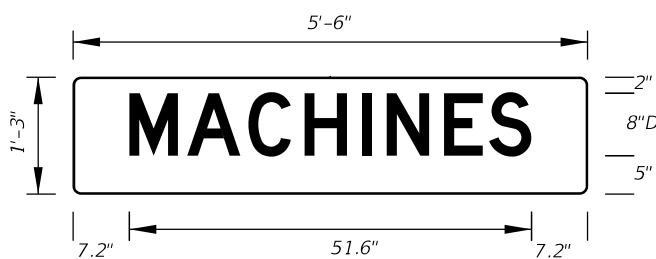


**FTP-76-06**  
5'-6" X 1'-3"  
1" Radii  
8" Series D Legend  
Blue Background  
White Legend

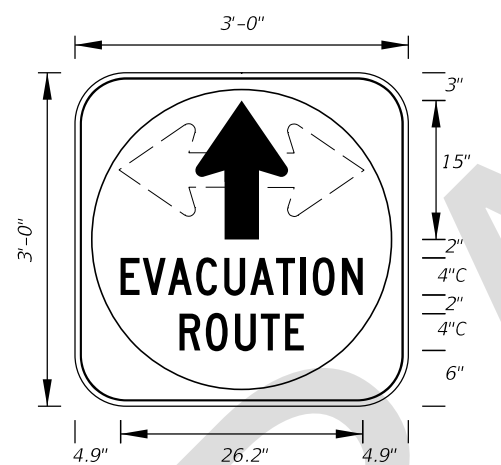


**FTP-77-06**  
3' X 3'  
5" Radii 3/4" Border  
4" Series C Legend  
White Background with Blue Circle Background  
White Legend and Black Border

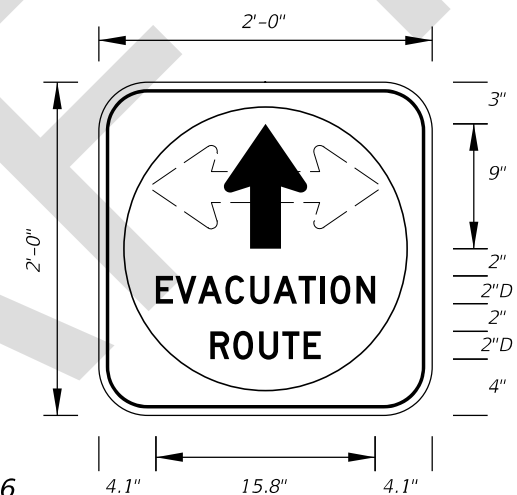


**FTP-78-06**  
2' X 2'  
3" Radii 3/4" Border  
2" Series D Legend  
White Background with Blue Circle Background  
White Legend and Black Border

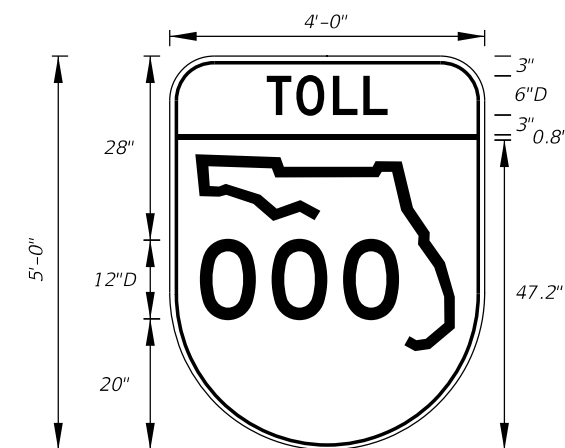


**FTP-79-06**  
4' X 5'  
6" Radii 3/4" Border  
6" and 12" Series D Legend  
Top Yellow Background with Black Legend and Black Border  
Bottom White Background with Black Legend and Border

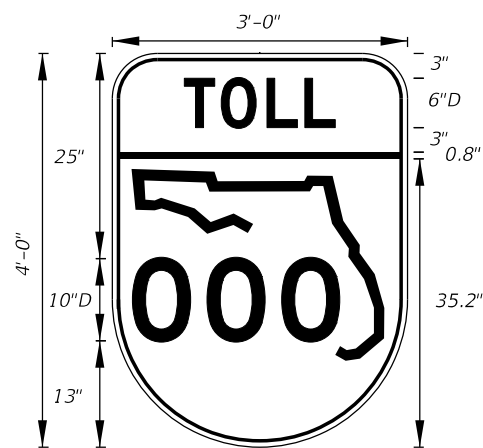


**FTP-80-06**  
3' X 4'  
5" Radii 3/4" Border  
6" and 10" Series D Legend  
Top Yellow Background with Black Legend and Black Border  
Bottom White Background with Black Legend and Border

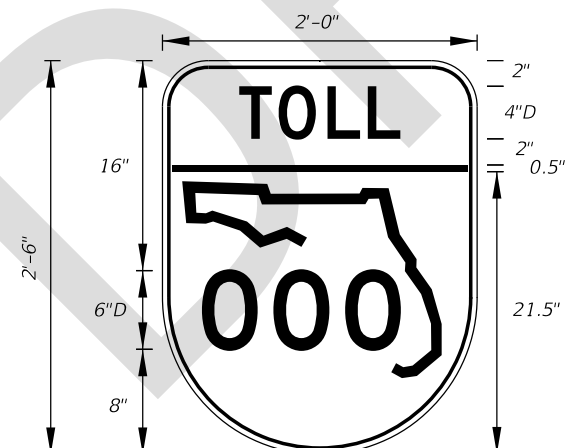

**FTP-81-06**  
2' X 2'-6"  
3" Radii 3/4" Border  
4" and 6" Series D Legend  
Top Yellow Background with Black Legend and Black Border  
Bottom White Background with Black Legend and Border

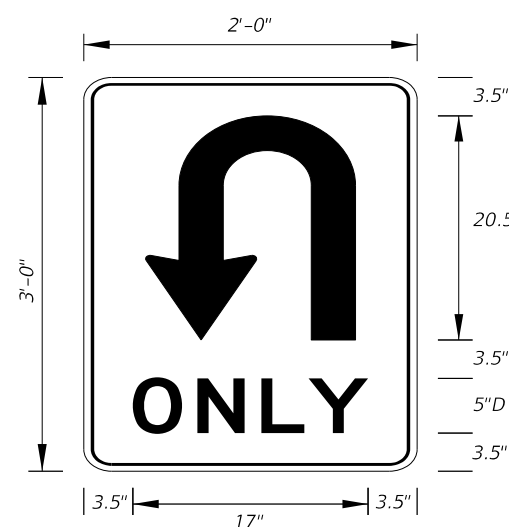

**FTP-82-08**  
2' X 3'  
1.5" Radii  
5" Series D Legend  
White Background  
Black Legend and Border

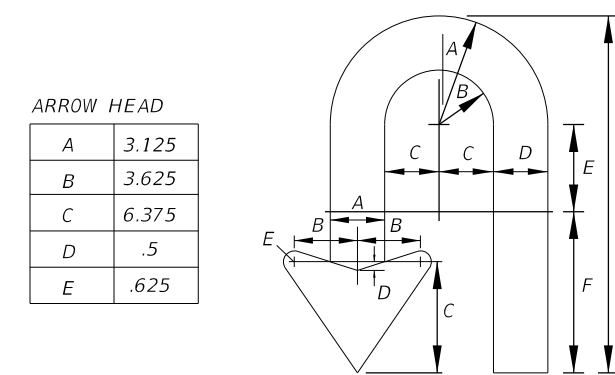

ARROW HEAD	
A	3.125
B	3.625
C	6.375
D	.5
E	.625

ARROW BODY						
A	B	C	D	E	F	G
6.25	3.125	3.125	3.125	5	9.25	20.5

8/30/2017 7:57:24 AM

LAST REVISION	DESCRIPTION:
11/01/17	




FY 2018-19  
STANDARD PLANS


SPECIAL SIGN DETAILS

INDEX  
700-102


SHEET  
9 of 11

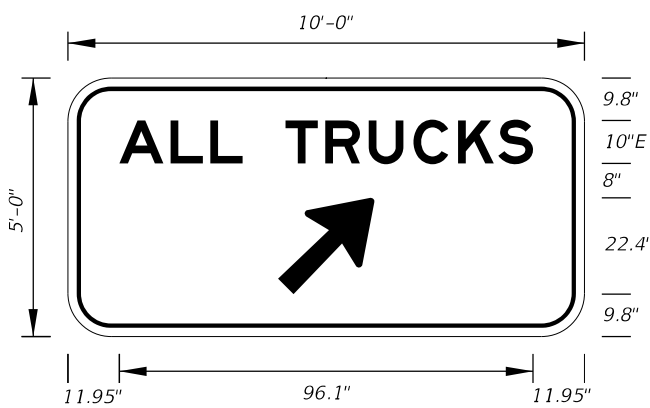


**FTP-83-08**  
10'-0" X 5'-0"  
8" Radii  
10" Series E Legend  
Green Background  
White Legend

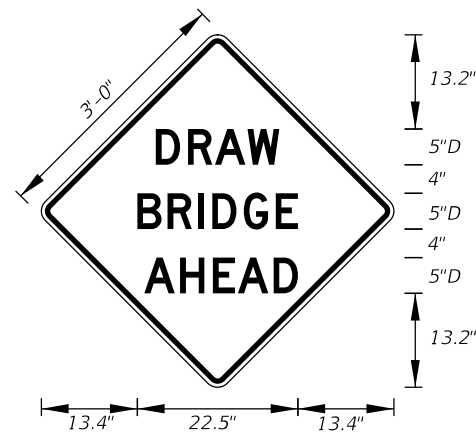


**FTP-84-09**  
3' X 3'  
1.5" Radii  
5" Series D Legend  
Yellow Background  
Black Legend

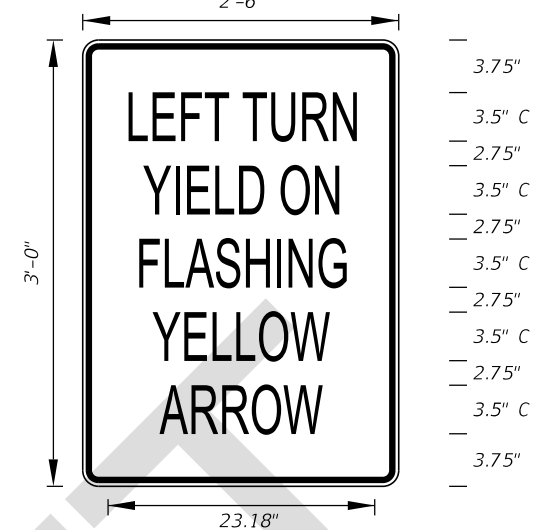


**FTP-85-13**  
3' X 2'-6"  
1.875" Radii 3/4" Border  
3.5" Series C Legend  
White Background  
Black Legend and Border

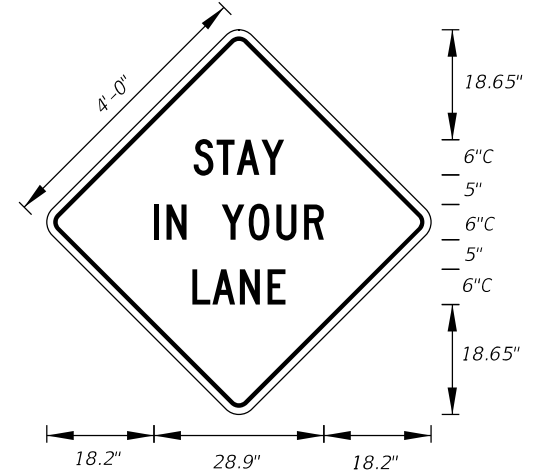


**MOT-1-06**  
4' X 4'  
2" Radii 3/4" Border  
6" Series C Legend  
Orange Background  
Black Legend and Border

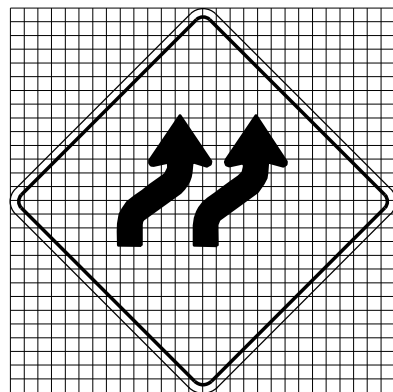


**MOT-2-06**  
4' X 4'  
2" Radii 3/4" Border  
Orange Background  
Black Arrows and Border

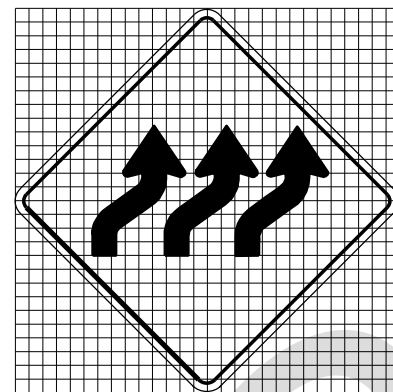


**MOT-3-06**  
4' X 4'  
2" Radii 3/4" Border  
Orange Background  
Black Arrows and Border

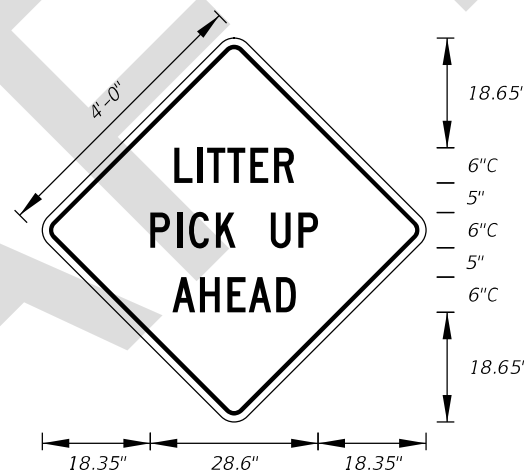


**MOT-4-06**  
4' X 4'  
2" Radii 3/4" Border  
6" Series C Legend  
Orange Background  
Black Legend and Border

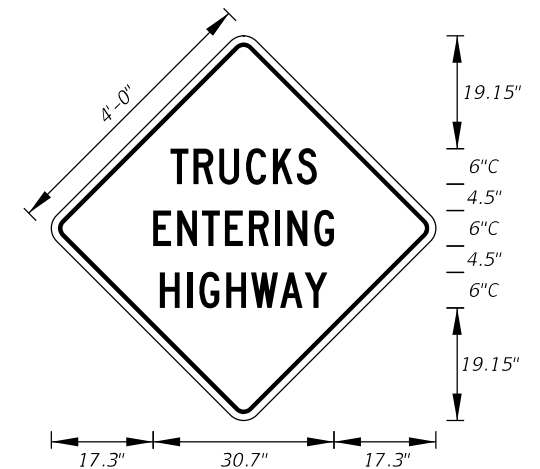


**MOT-5-06**  
4' X 4'  
2" Radii 3/4" Border  
6" Series C Legend  
Orange Background  
Black Legend and Border

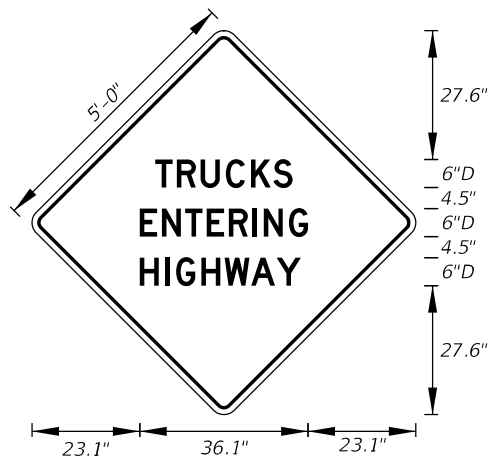


**MOT-6-06**  
5' X 5'  
2" Radii 3/4" Border  
6" Series D Legend  
Orange Background  
Black Legend and Border

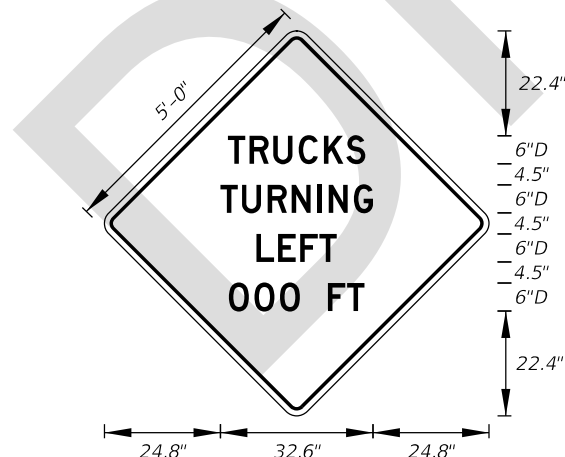

**MOT-7-06**  
5' X 5'  
2" Radii 3/4" Border  
6" Series D Legend  
Orange Background  
Black Legend and Border

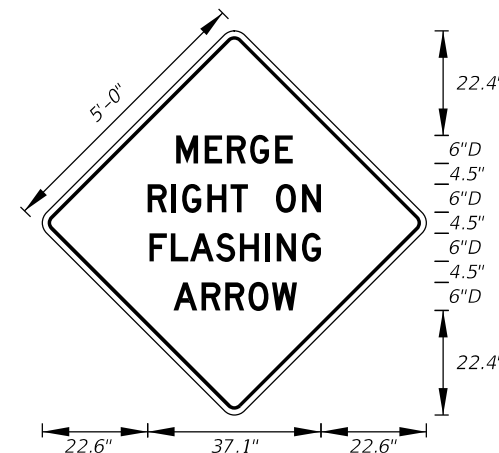

**MOT-8-06**  
5' X 5'  
2" Radii 3/4" Border  
6" Series D Legend  
Orange Background  
Black Legend and Border

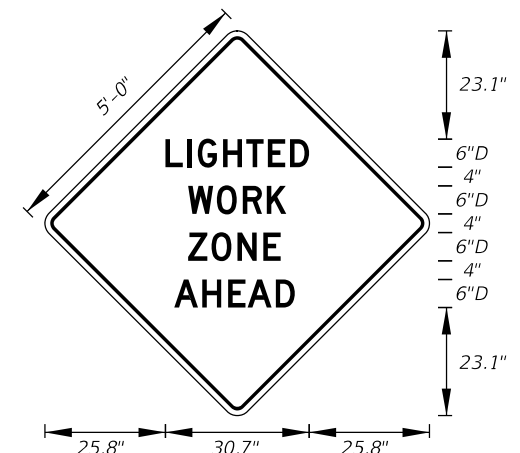

**MOT-9-06**  
5' X 5'  
2" Radii 3/4" Border  
6" Series D Legend  
Orange Background  
Black Legend and Border

8/30/2017 7:57:24 AM

LAST REVISION	DESCRIPTION:
11/01/17	




FY 2018-19  
STANDARD PLANS


SPECIAL SIGN DETAILS

INDEX  
700-102


SHEET  
10 of 11

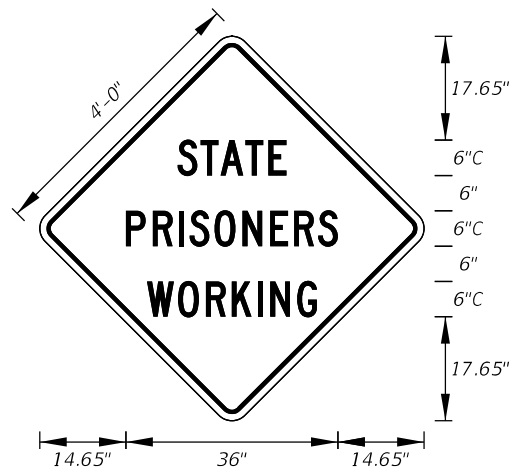


**MOT-10-06**  
4' X 4'  
2" Radii 3/4" Border  
6" Series C Legend  
Orange Background  
Black Legend and Border

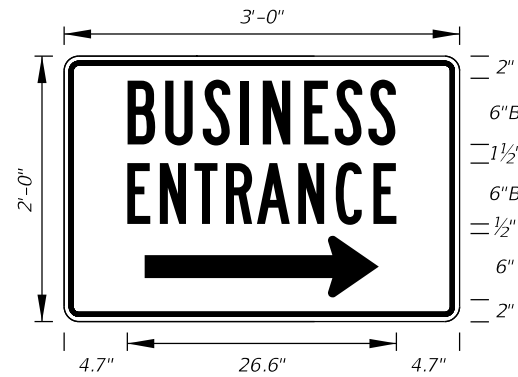


**MOT-11-06**  
3' X 2'  
2" Radii 3/4" Border  
6" Series B Legend  
Blue Background  
White Legend and Border

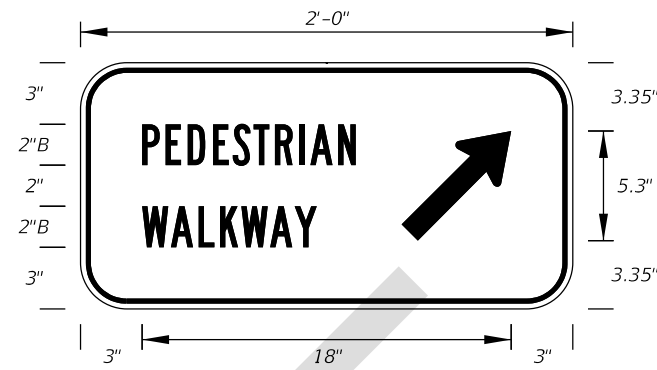


**MOT-12R-06**  
2' X 1'  
2" Radii 3/4" Border  
2" Series B Legend  
White Background  
Black Legend and Border  
**MOT-12L-06**  
For Diversion  
to the left

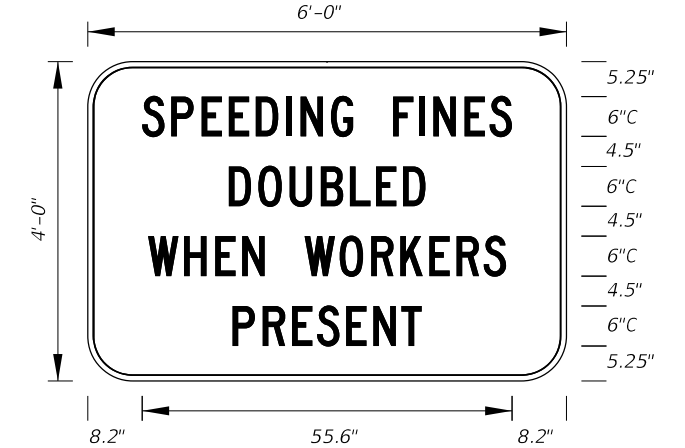


**MOT-13-06**  
Freeway Sign  
6' X 4'  
6" Radii 3/4" Border  
6" Series C Legend  
White Background  
Black Legend and Border

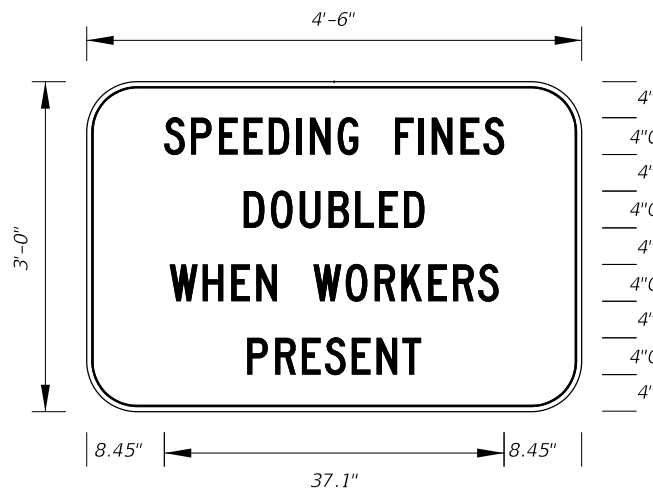


**MOT-14-06**  
Arterial Sign  
4'-6" X 3'  
5" Radii 3/4" Border  
4" Series C Legend  
White Background  
Black Legend and Border

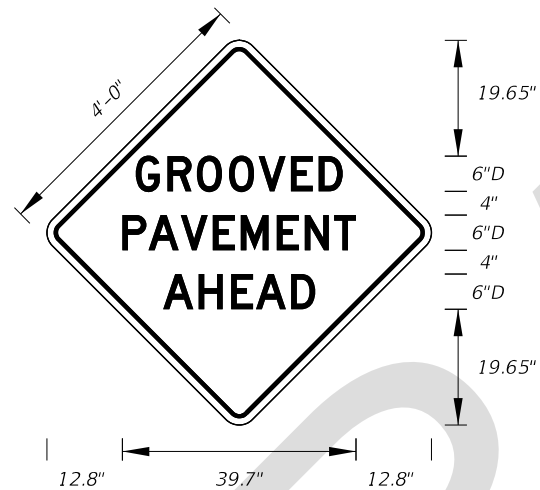


**MOT-15-06**  
4' X 4'  
2" Radii 3/4" Border  
6" Series D Legend  
Orange Background  
Black Legend and Border

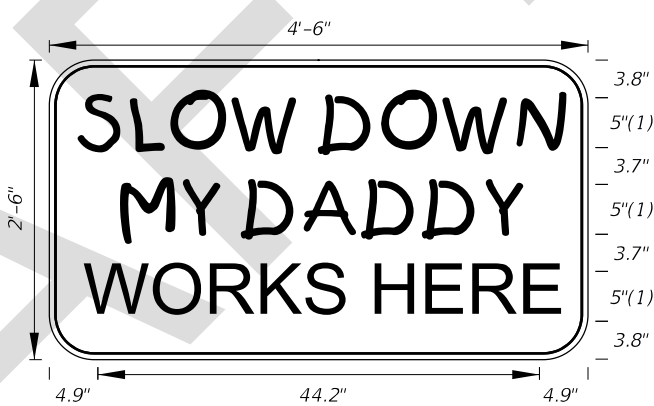


**MOT-16-06**  
4'-6" X 2'-6"  
4" Radii 3/4" Border  
5" Kids Series Legend  
Orange Background  
Black Legend and Border

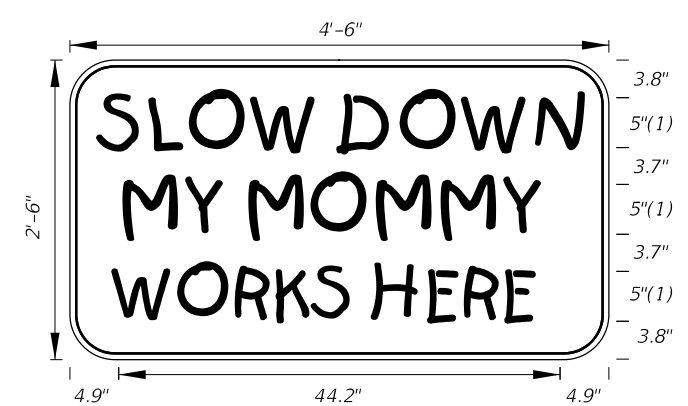


**MOT-17-06**  
4'-6" X 2'-6"  
4" Radii 3/4" Border  
5" Kids Series Legend  
Orange Background  
Black Legend and Border

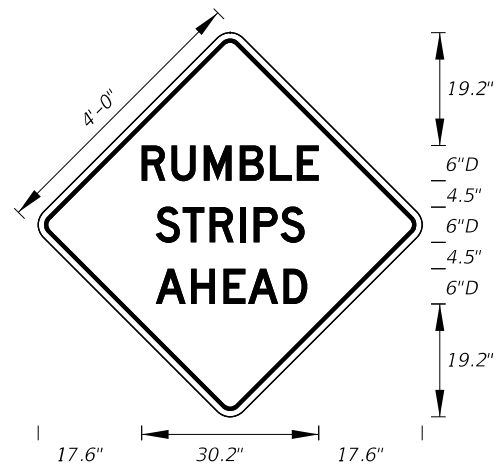


**MOT-18-10**  
4' X 4'  
2" Radii 3/4" Border  
6" Series D Legend  
Orange Background  
Black Legend and Border

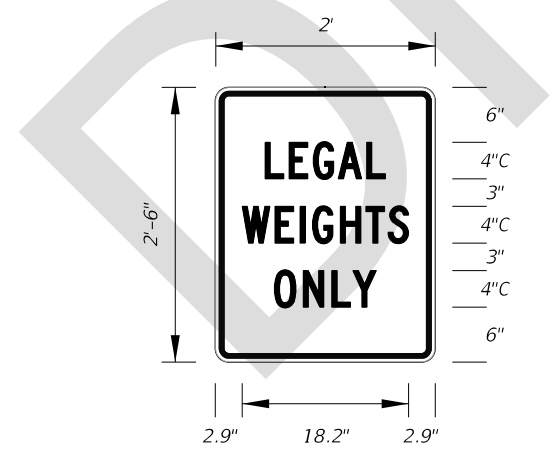

**MOT-19-11**  
2' X 2'-6"  
1.13" Radii 3/4" Border  
4" Series C Legend  
White Background  
Red Legend and Border

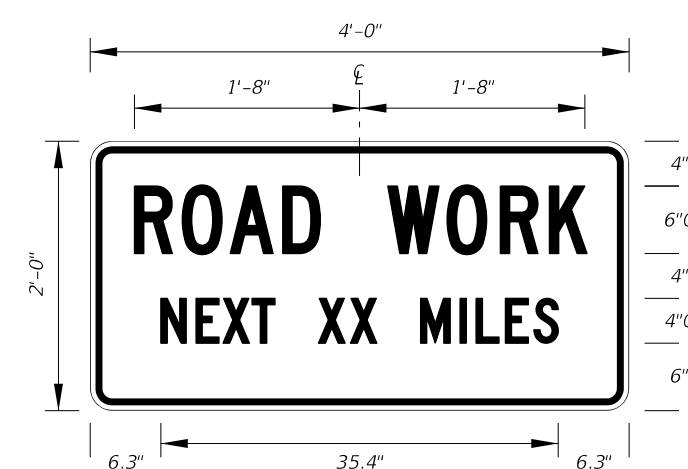


**G20-1**  
2' X 4'  
1.5" Radii 3/4" Border  
Orange Background  
Black Legend and Border

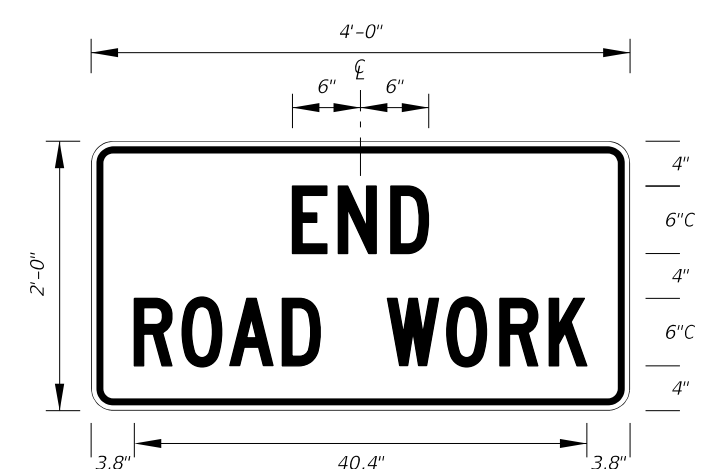

**G20-2**  
2' X 4'  
1.5" Radii 3/4" Border  
Orange Background  
Black Legend and Border

8/30/2017 7:57:25 AM

LAST REVISION 11/01/17	REVISION	DESCRIPTION:	 FY 2018-19 STANDARD PLANS	SPECIAL SIGN DETAILS	INDEX 700-102	SHEET 11 of 11
---------------------------	----------	--------------	-----------------------------------------------------------------------------------------------------------------------	----------------------	------------------	-------------------