


10/14/2016 8:37:59 AM

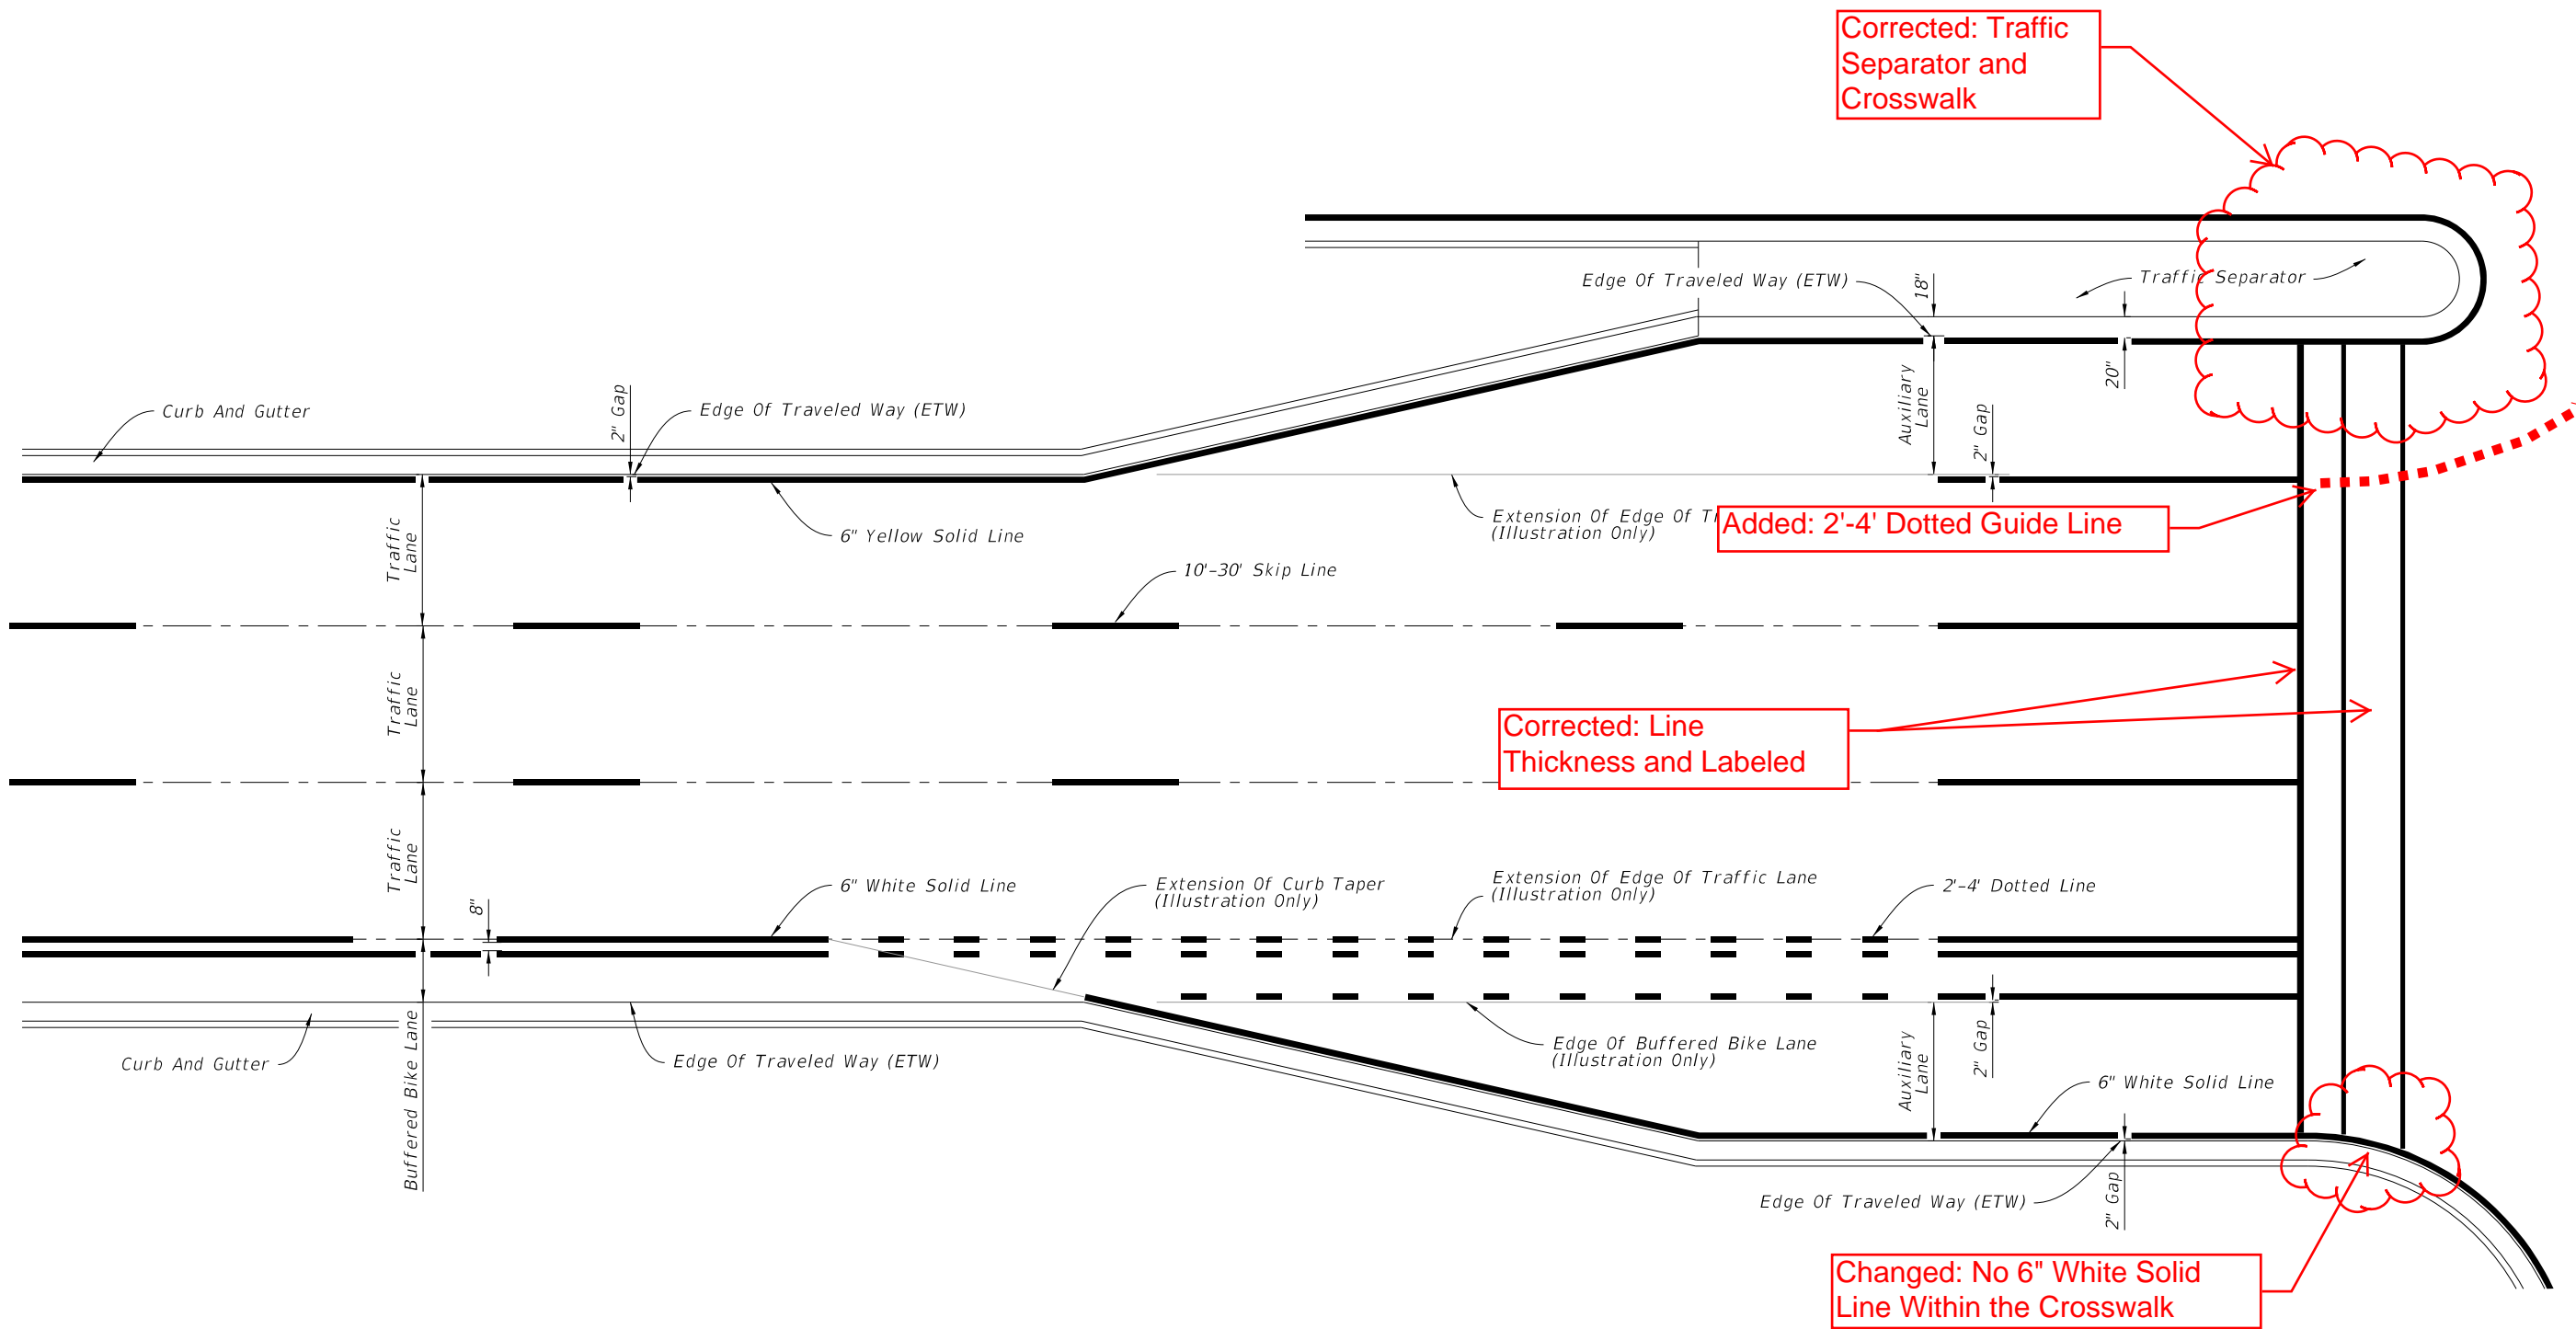

PLACEMENT OF LONGITUDINAL PAVEMENT MARKINGS

LAST REVISION	DESCRIPTION:
11/01/16	




FY 2017-18
DESIGN STANDARDS

PAVEMENT MARKINGS

INDEX NO.
17346

SHEET NO.
3 of 17

10/14/2016 8:38:01 AM

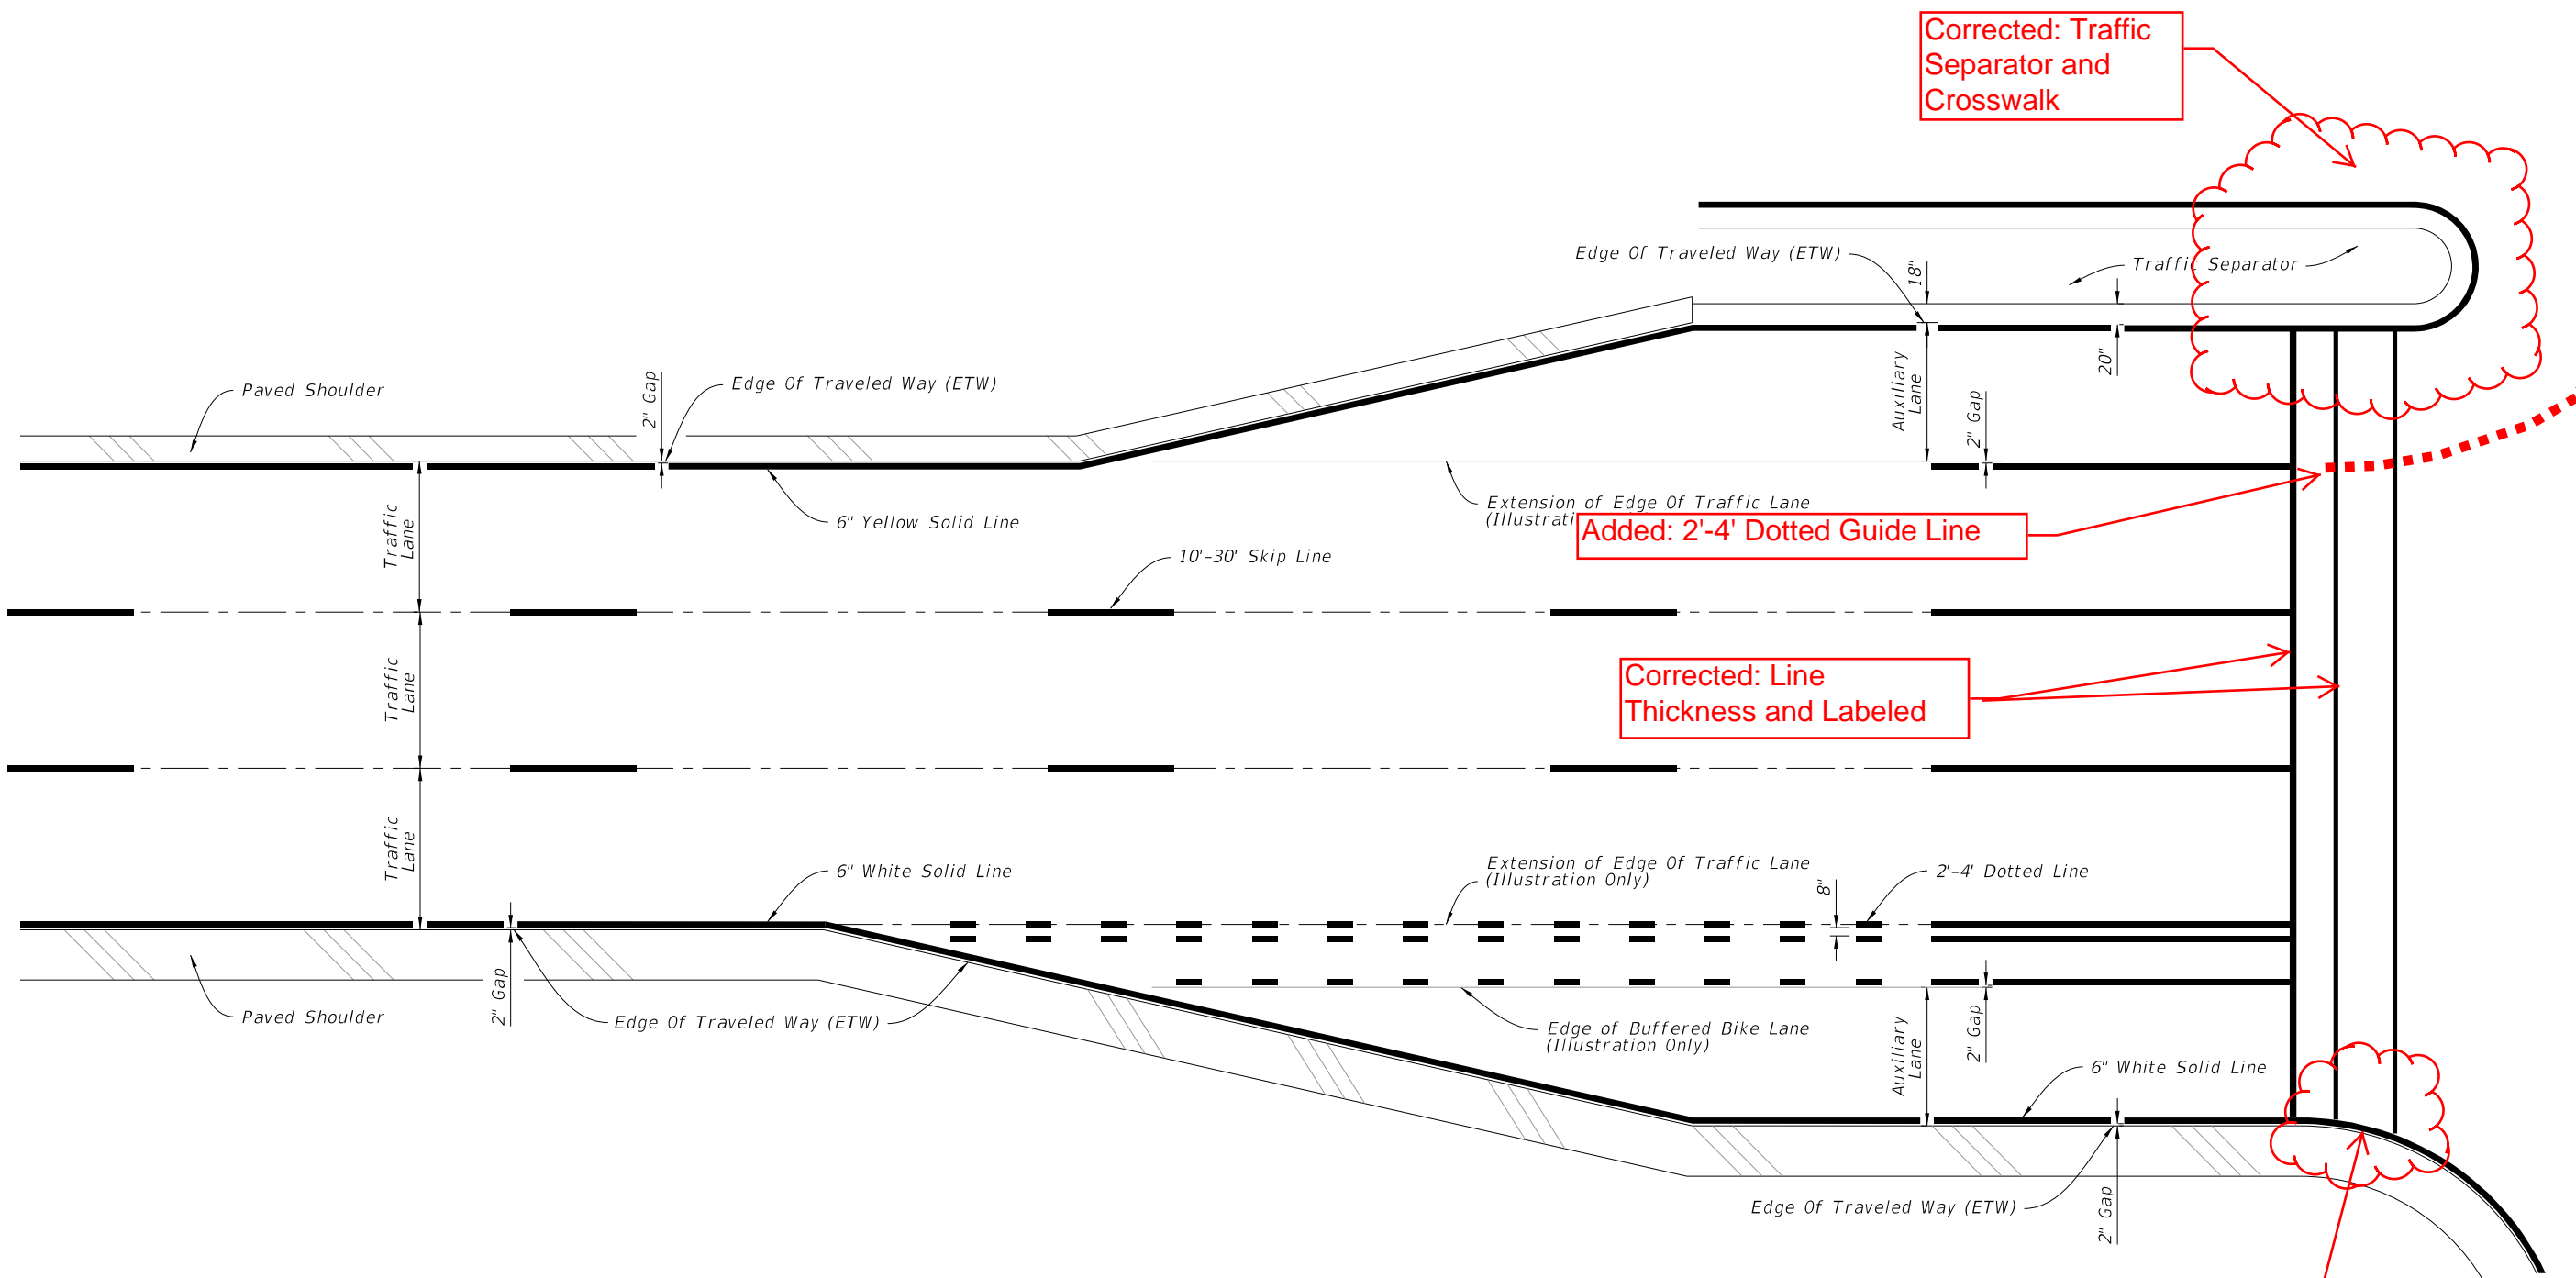

PLACEMENT OF LONGITUDINAL PAVEMENT MARKINGS

LAST REVISION 11/01/16	DESCRIPTION:
---------------------------	--------------



PAVEMENT MARKINGS

INDEX NO. 17346	SHEET NO. 4 of 17
--------------------	----------------------