




BIKE LANE TYPICAL PAVEMENT MARKINGS

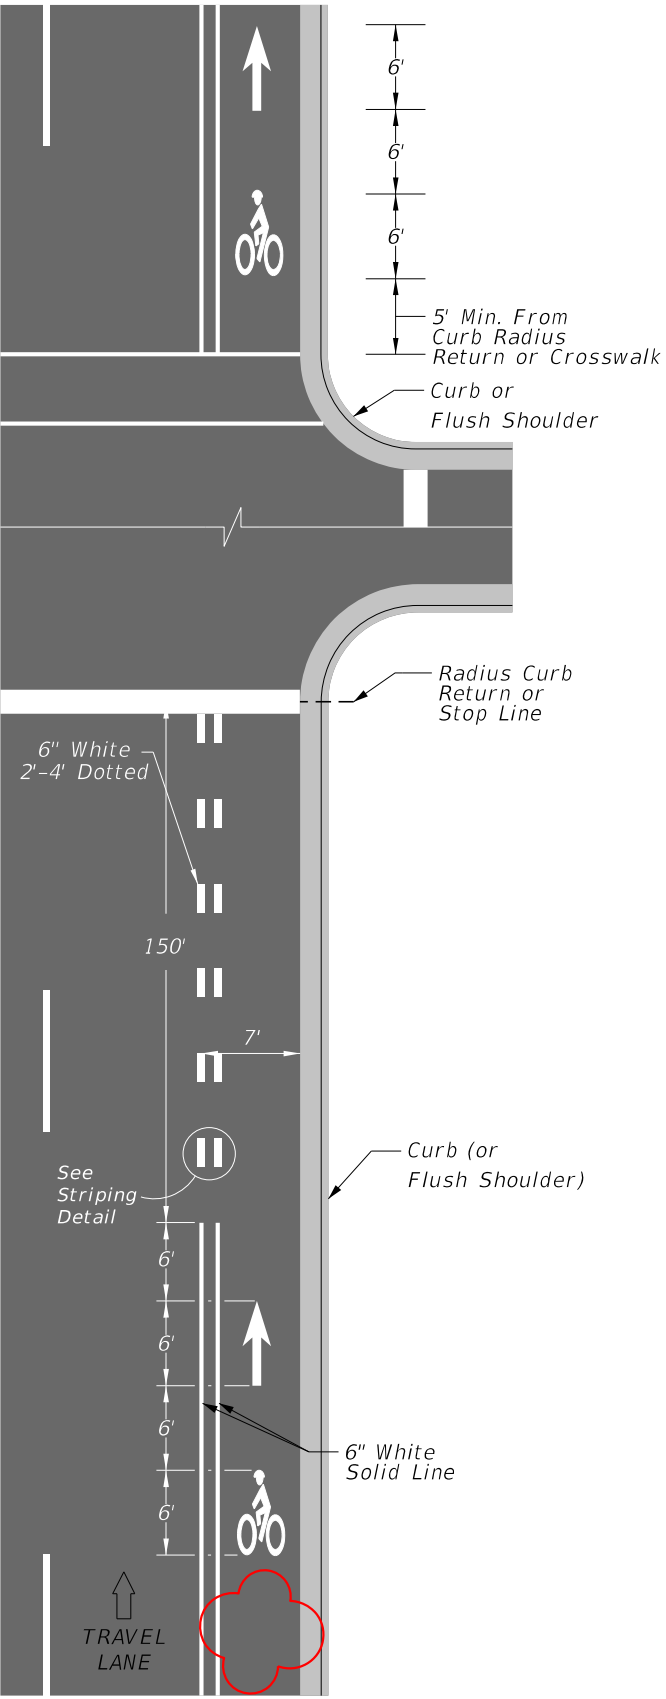

BIKE LANE INTERSECTION APPROACH DETAILS

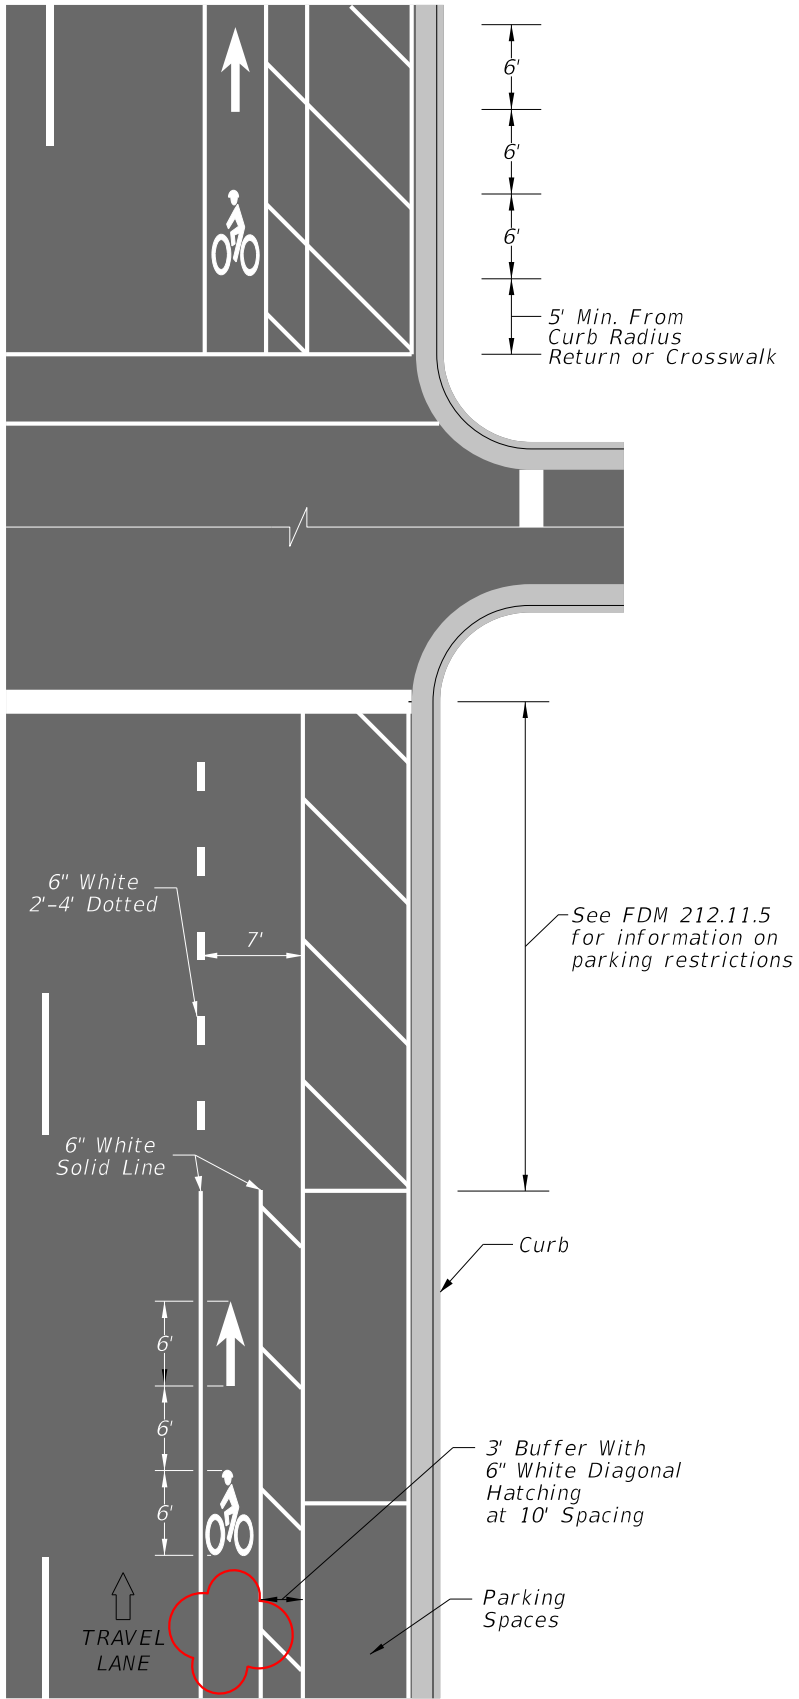

BIKE LANE ADJACENT TO ON-STREET PARKING

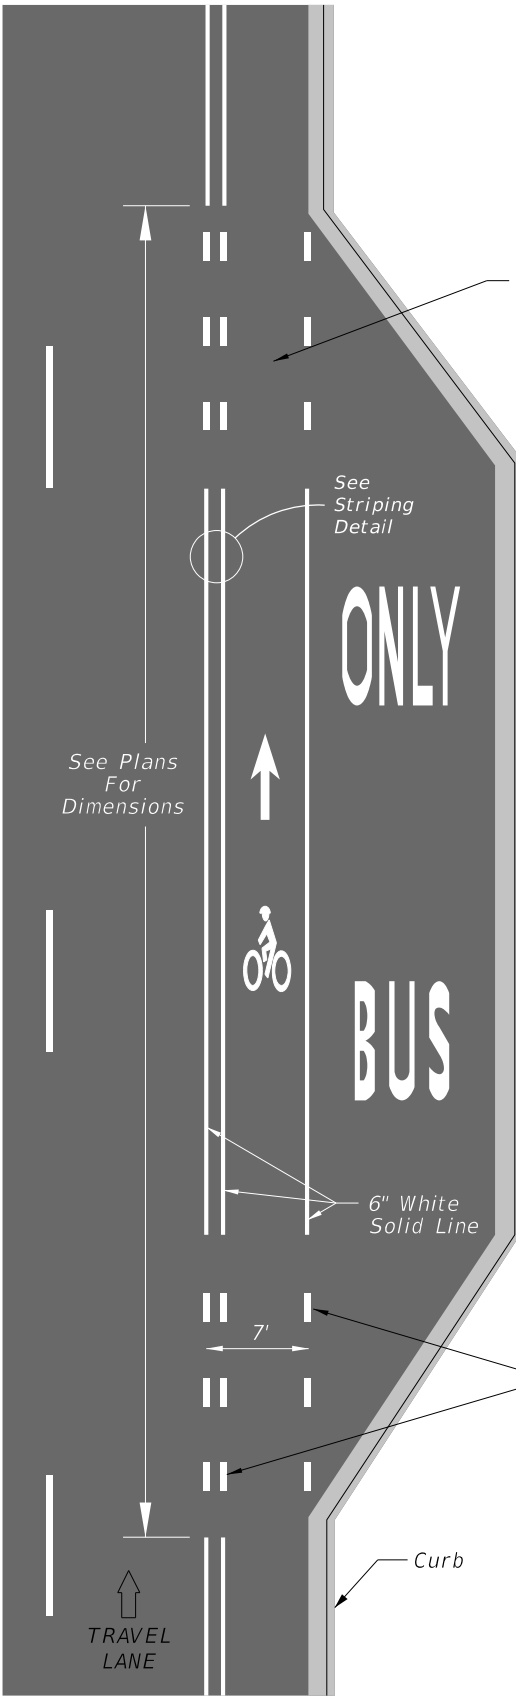

BIKE LANE ADJACENT TO BUS BAY

Buffered Bike Lane

See Striping Detail

See Plans For Dimensions

See FDM 212.11.5 for information on parking restrictions

Curb

3' Buffer With 6" White Diagonal Hatching at 10' Spacing


Parking Spaces

6" White Solid Line

6" White 2'-4' Dotted at Curb Tapers (Typ.)

Curb

Note:
See Exhibit 230-9 in FDM 230 for bike lane and midblock crossings pavement markings.

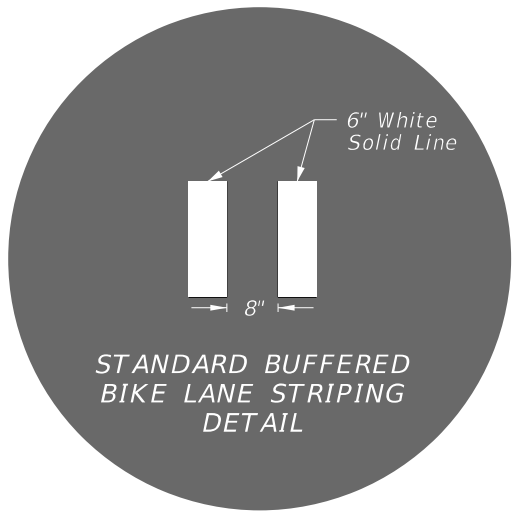

STANDARD BUFFERED BIKE LANE STRIPING DETAIL

NOT TO SCALE

EXHIBIT 223-1
01/01/2025