
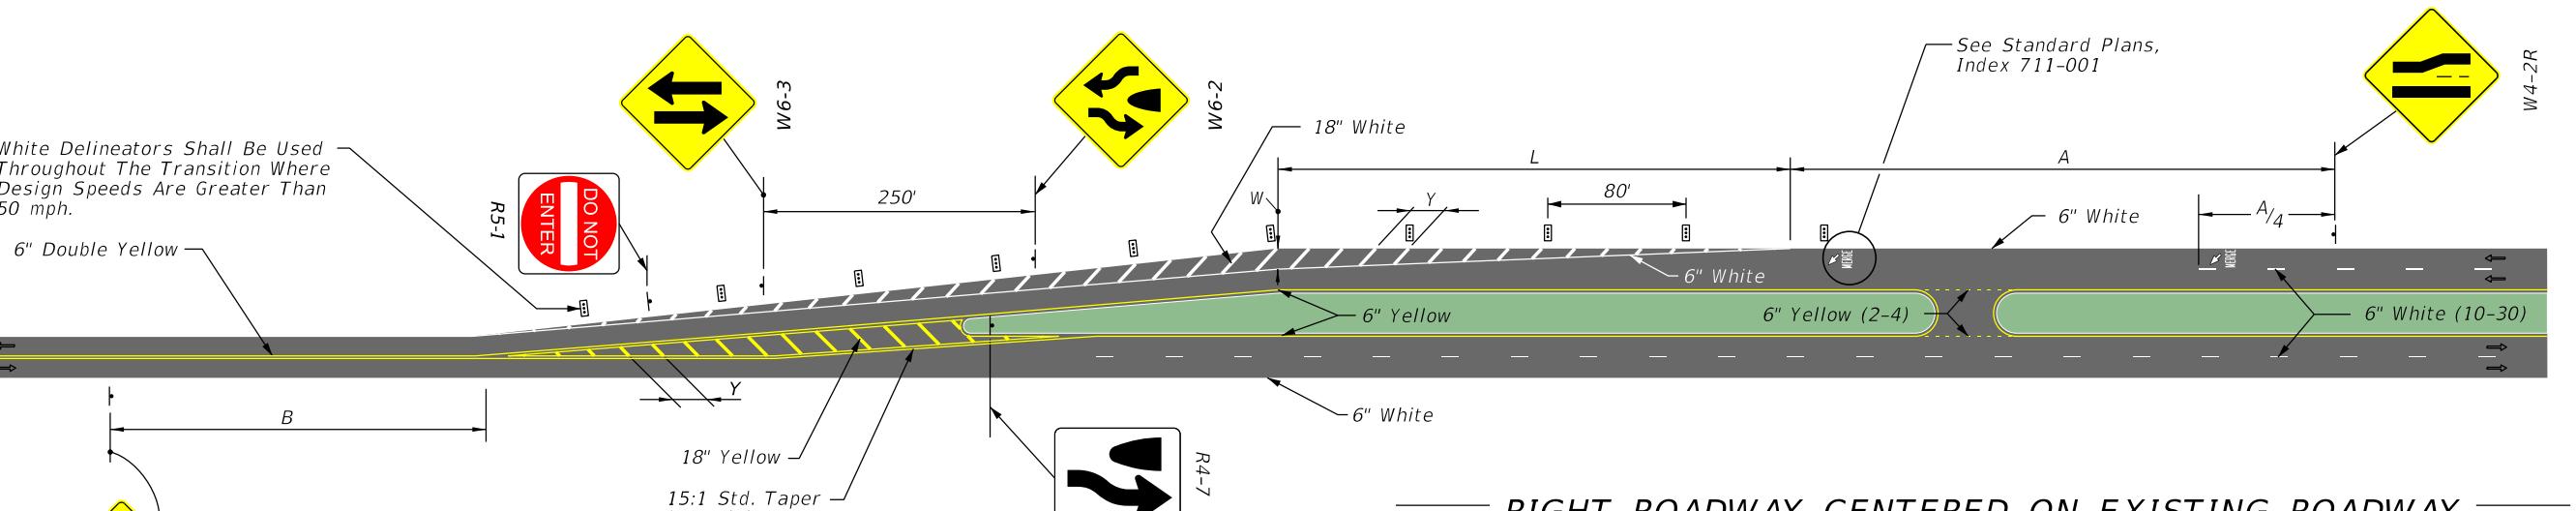


TYPICAL SIGNING AND PAVEMENT MARKINGS FOR ROADWAY TRANSITIONS

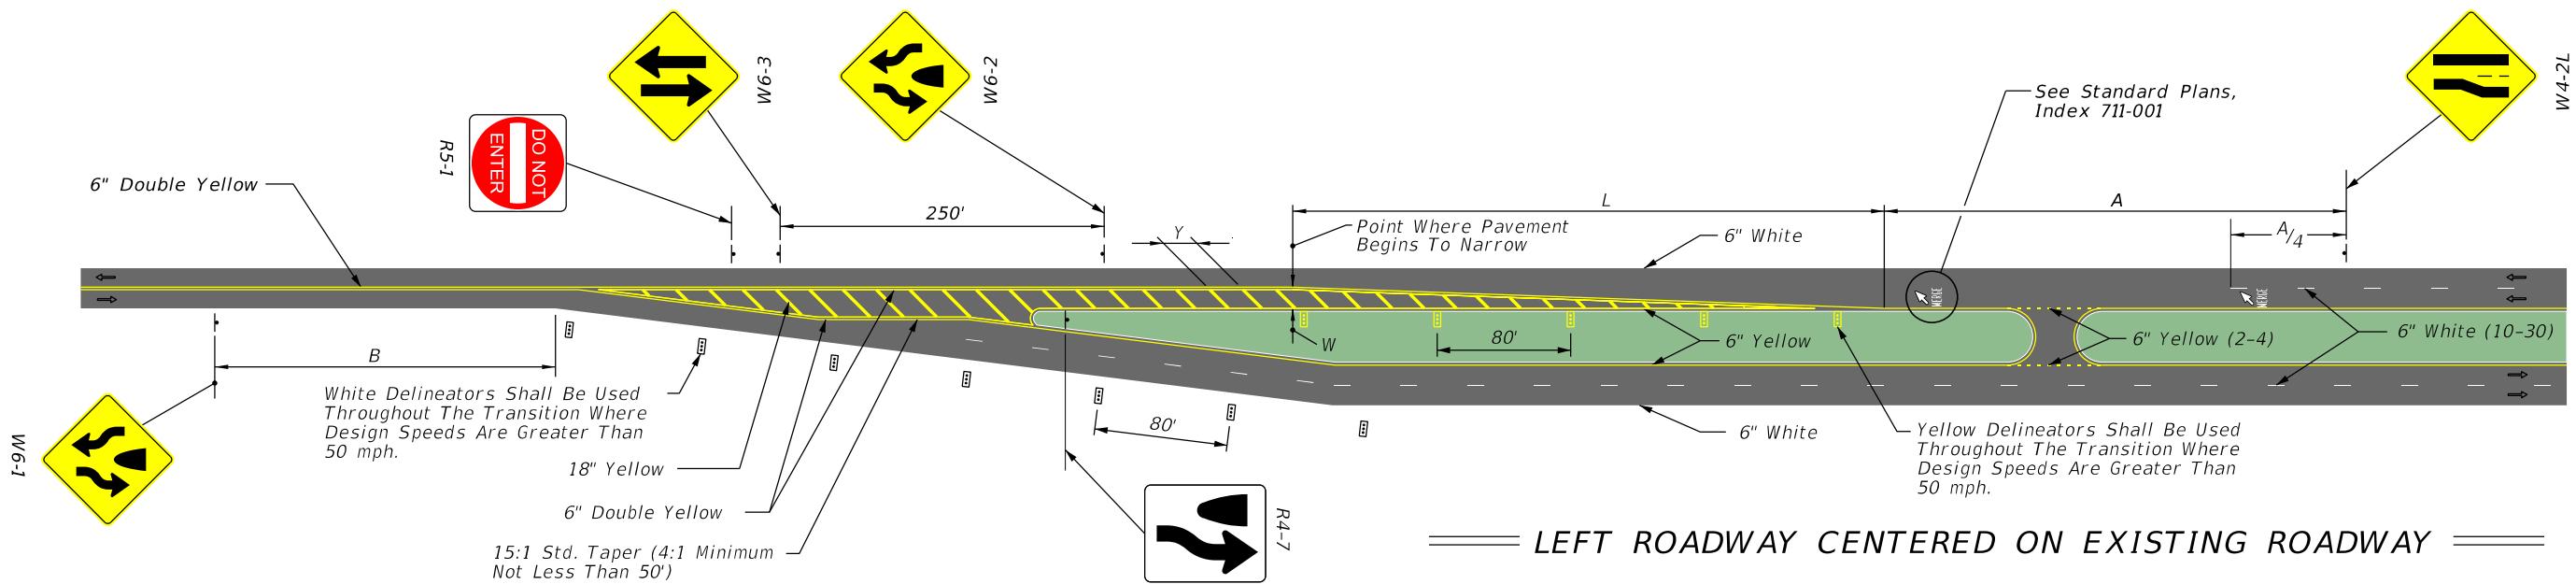


SCHEMES FOR TRANSITION - 2 LANE / 4 LANE ROADWAY

SPEED MPH	"A" (FT.)	"B" * (FT.)
60	---	640
55	950	595
50	850	550
45	750	500
40	650	455
30	450	365

* 50' Minimum

POSTED SPEED MPH	"Y" (FT.)
50 OR MORE	40
45	30
40	20
35	20
30 OR LESS	10

DESIGN SPEED 'S' (MPH)	Length 'L' (FT.)
50 OR MORE	40
40 or Less	$L = WS^2/60$
45 or Greater	$L = WS$
30 OR LESS	10

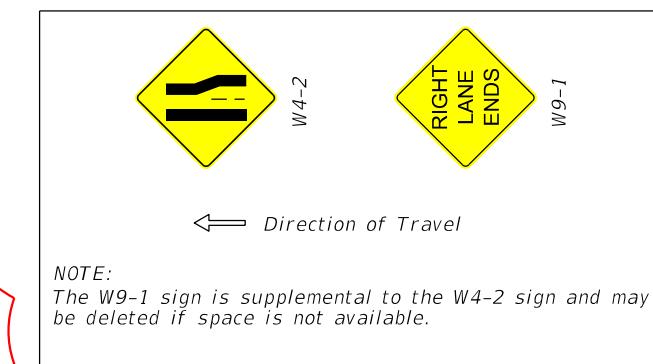

NOT TO SCALE