

BICYCLE AND PEDESTRIAN FACILITIES THROUGH INTERCHANGE TYPICAL SIGNING AND MARKING LAYOUT

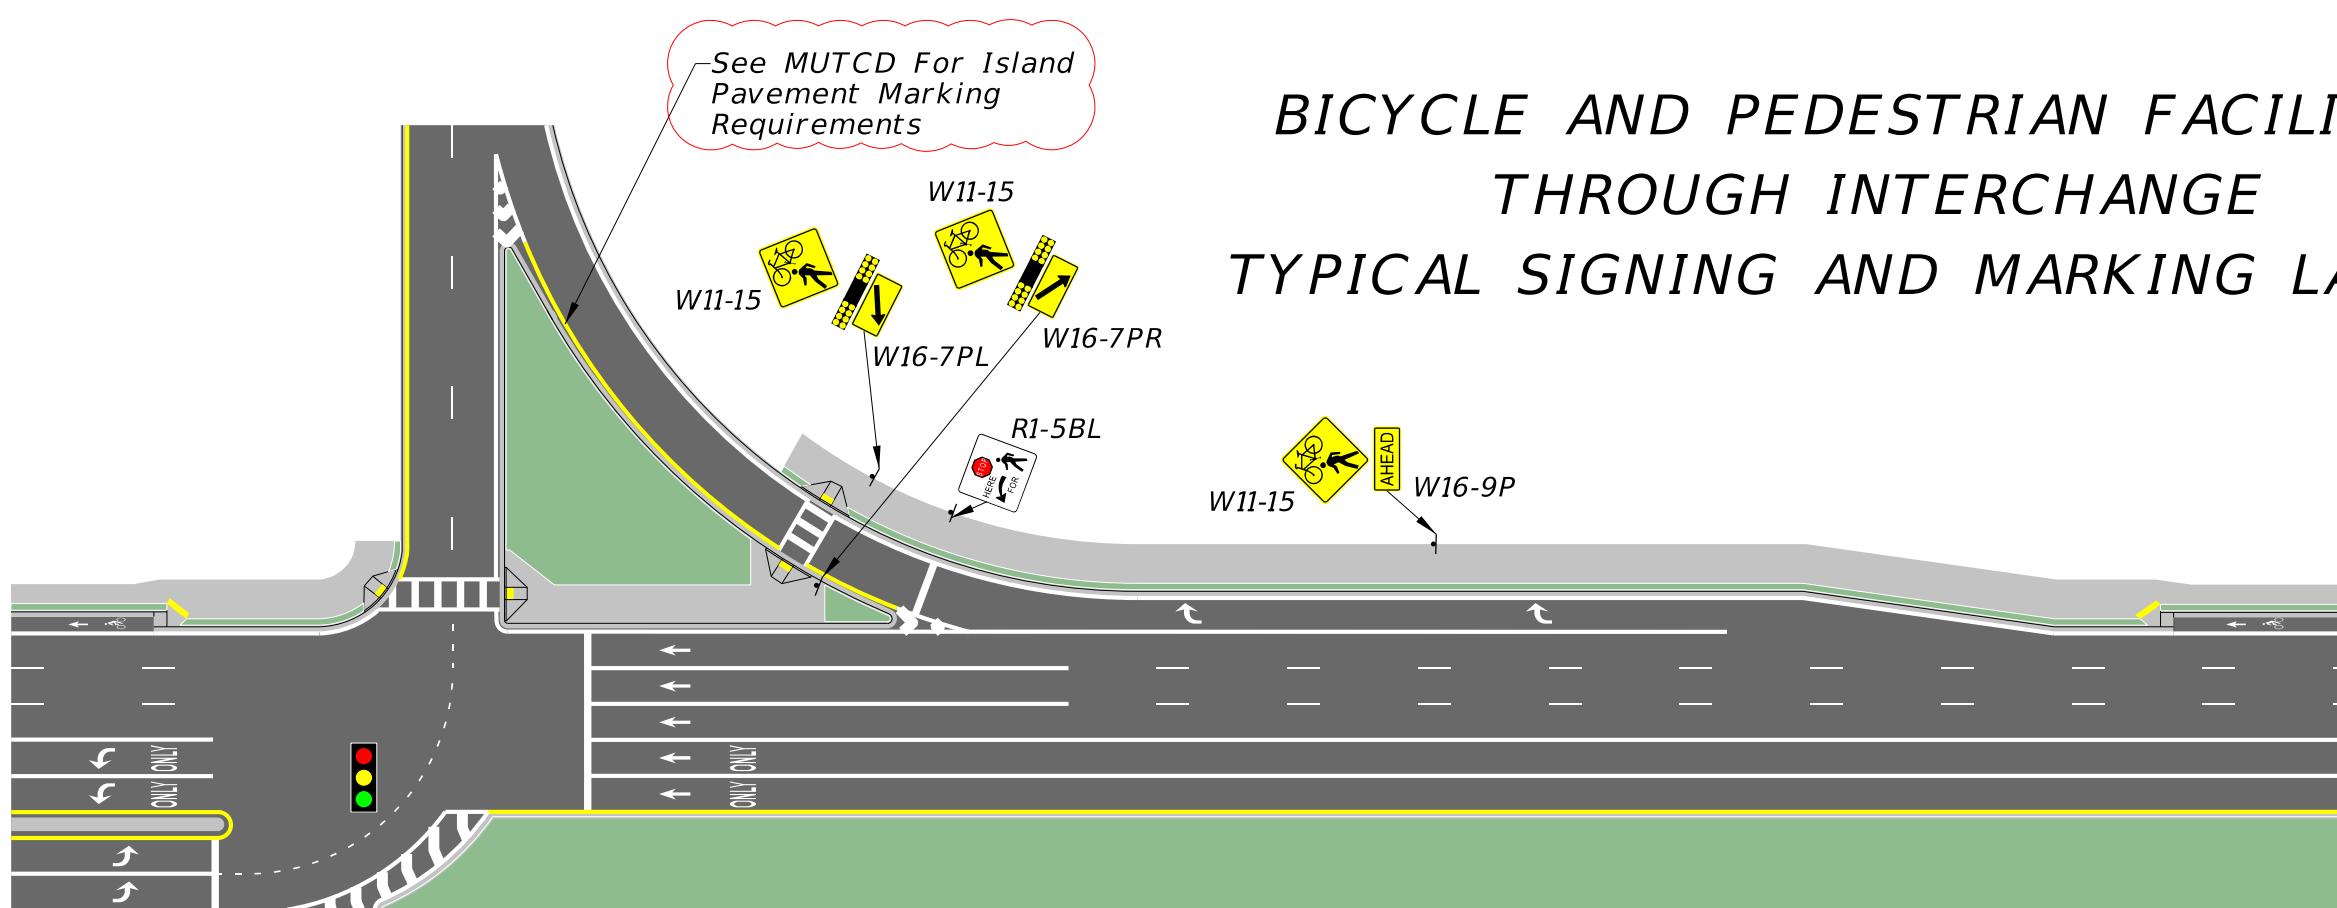


EXHIBIT 230-17a
01/01/2025

BICYCLE AND PEDESTRIAN FACILITIES AT LOW-ANGLE INTERCHANGE RAMP TYPICAL SIGNING AND MARKING LAYOUT

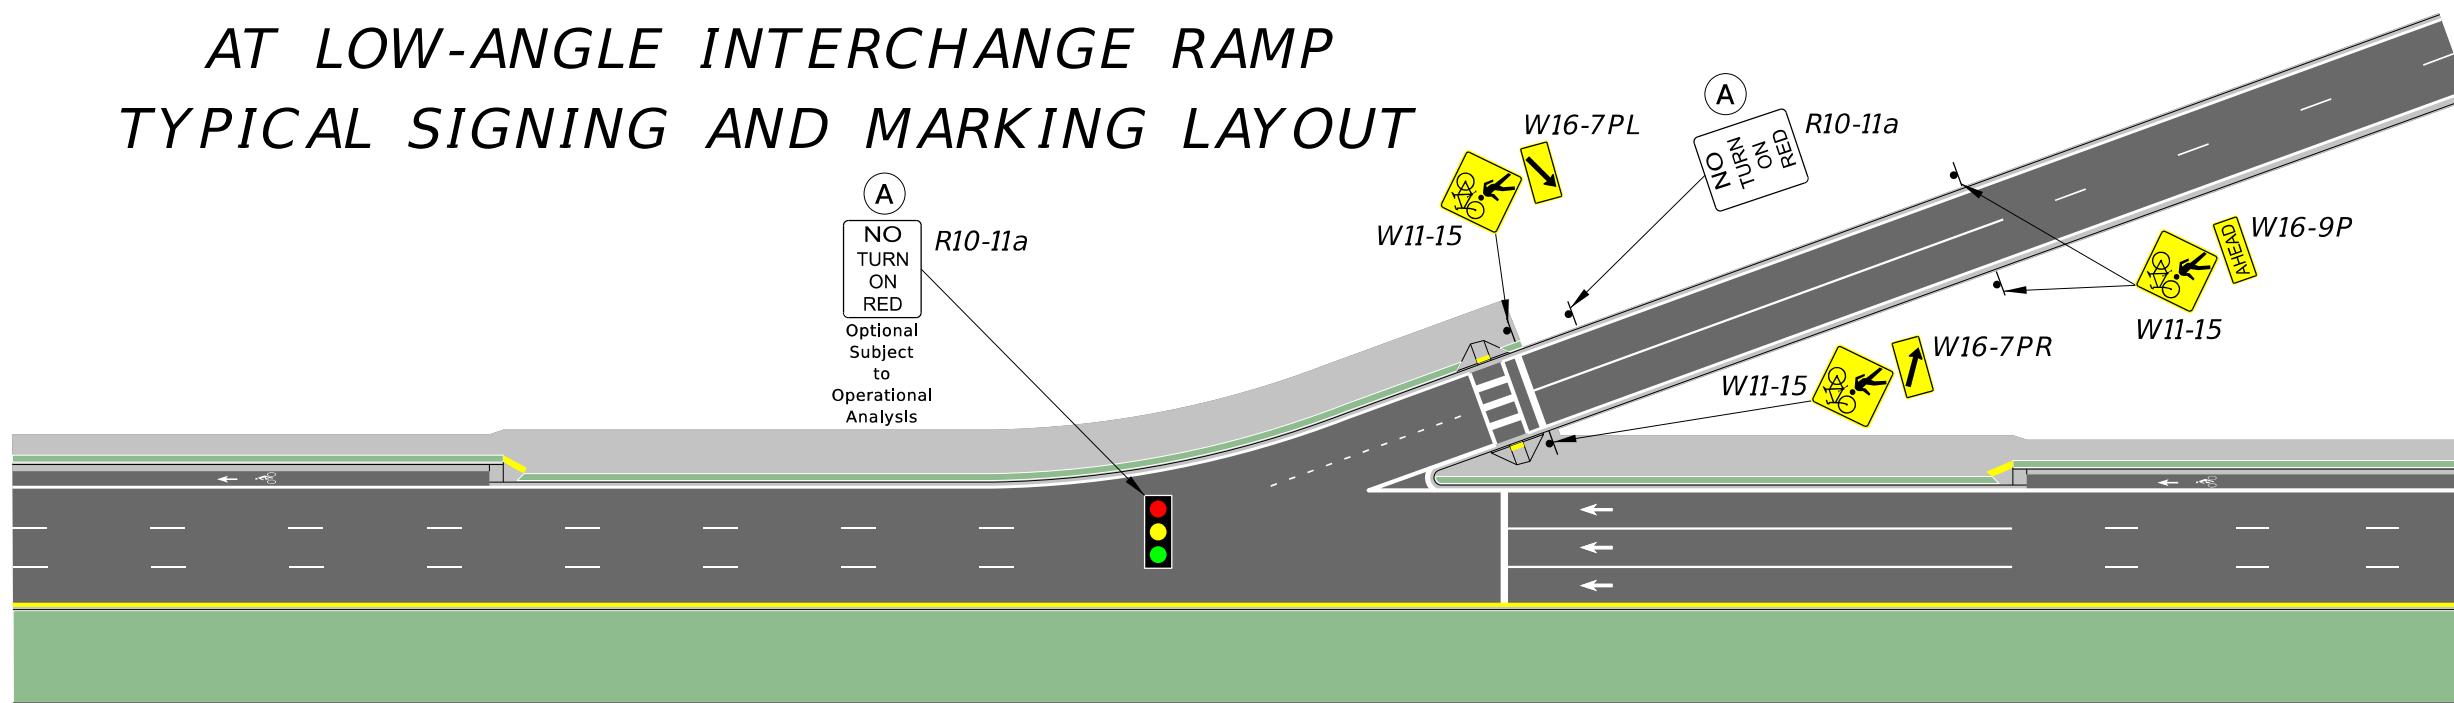


EXHIBIT 230-17b
01/01/2024