


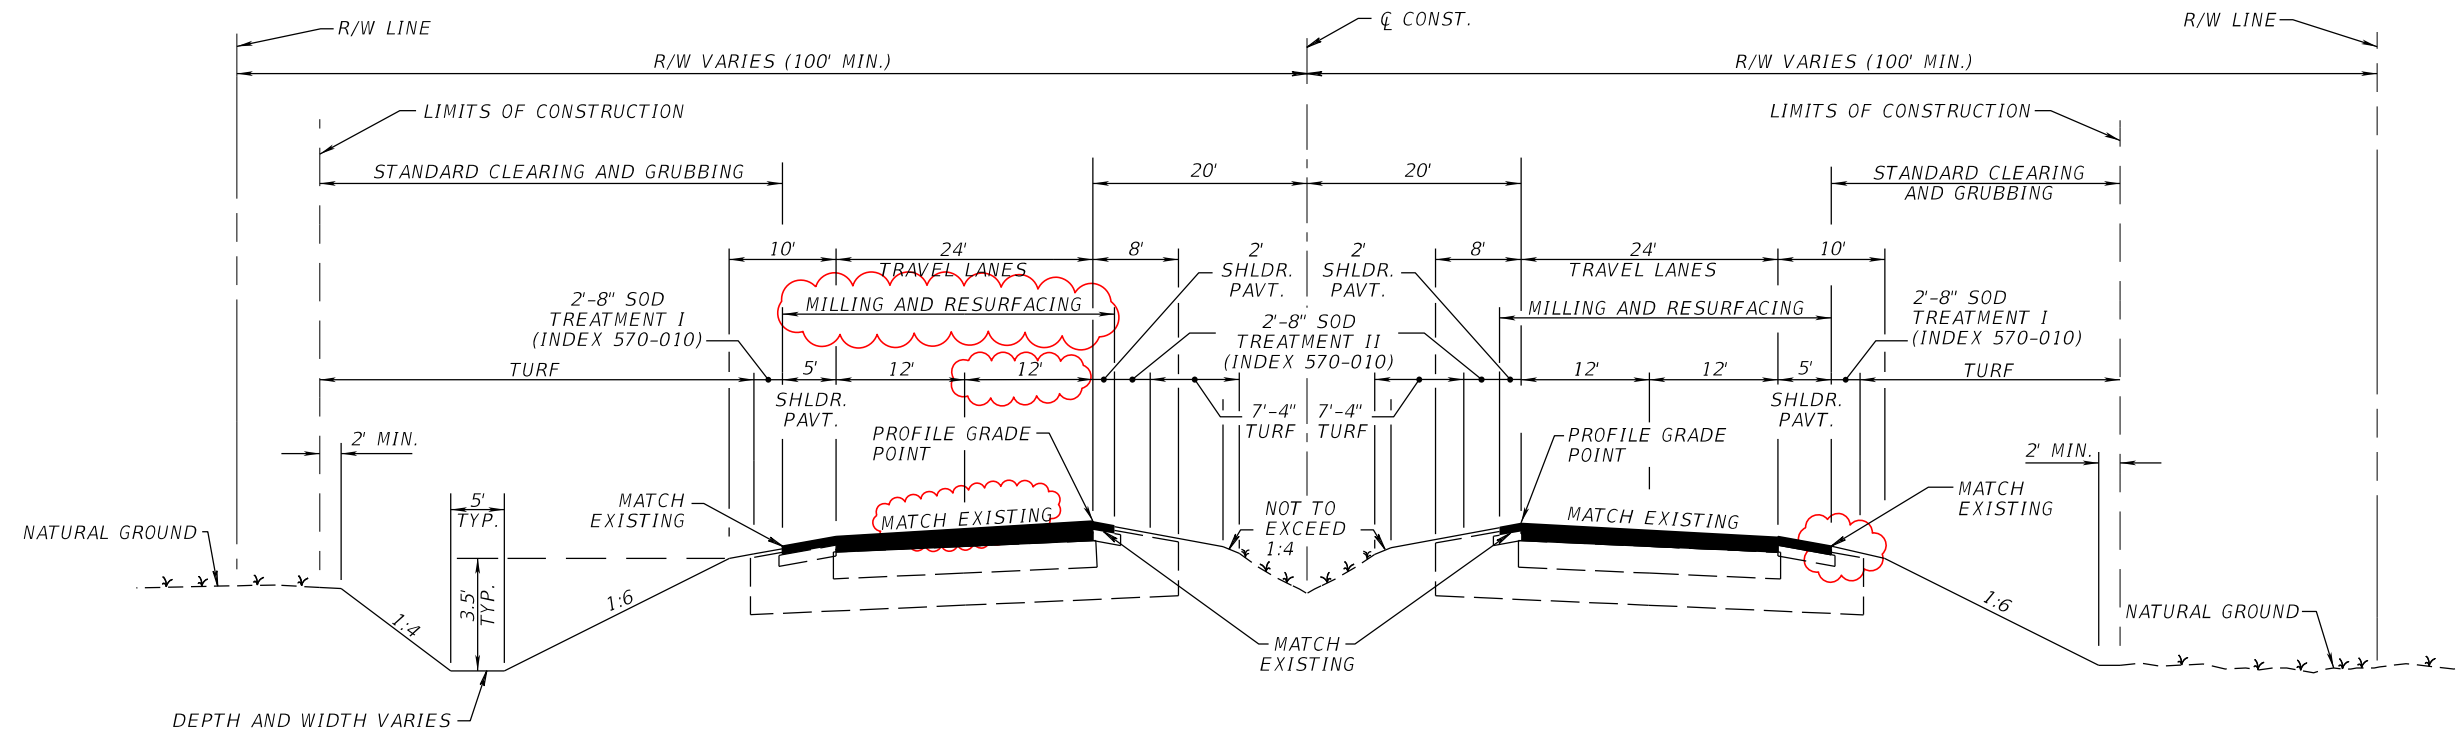

TRAFFIC DATA

CURRENT YEAR = 2018 AADT = 18100
ESTIMATED OPENING YEAR = 2020 AADT = 21000
ESTIMATED DESIGN YEAR = 2040 AADT = 38900
K = 11% D = 58% T = 22% (24 HOUR)
DESIGN HOUR T = 11%
DESIGN SPEED = 60 MPH
CONTEXT CLASSIFICATION = C2

TYPICAL SECTION
SR 22
STA. 145+00.00 TO STA. 166+00.00
SMOOTHNESS CLASS 3

EASTBOUND AND WESTBOUND TRAVEL LANES

MILL EXISTING ASPHALT PAVEMENT (2 1/4" DEPTH)
TYPE SP STRUCTURAL COURSE (TRAFFIC E) (1 1/2") (PG 76-22)
FRICTION COURSE (FC-12.5 (TRAFFIC E) (1 1/2") (PG 76-22))

SHOULDER PAVEMENT

MILL EXISTING ASPHALT PAVEMENT (2 1/4" DEPTH)
TYPE SP STRUCTURAL COURSE (TRAFFIC E) (1 1/2") (PG 76-22)
FRICTION COURSE (FC-12.5 (TRAFFIC E) (1 1/2") (PG 76-22))

Exhibit 913-3
4-Lane Flush Shoulder
Resurfacing
Date: 1/1/2025

REVISIONS				ENGINEER OF RECORD	STATE OF FLORIDA DEPARTMENT OF TRANSPORTATION			SHEET NO.
DATE	DESCRIPTION	DATE	DESCRIPTION		ROAD NO.	COUNTY	FINANCIAL PROJECT ID	
				LUKE S. WALKER LICENSE NUMBER: 99991 ROADWAY ENGINEERS, INC. 123 MAIN STREET TALLAHASSEE, FL 32301	SR 22	BAY	123456-1-52-01	6