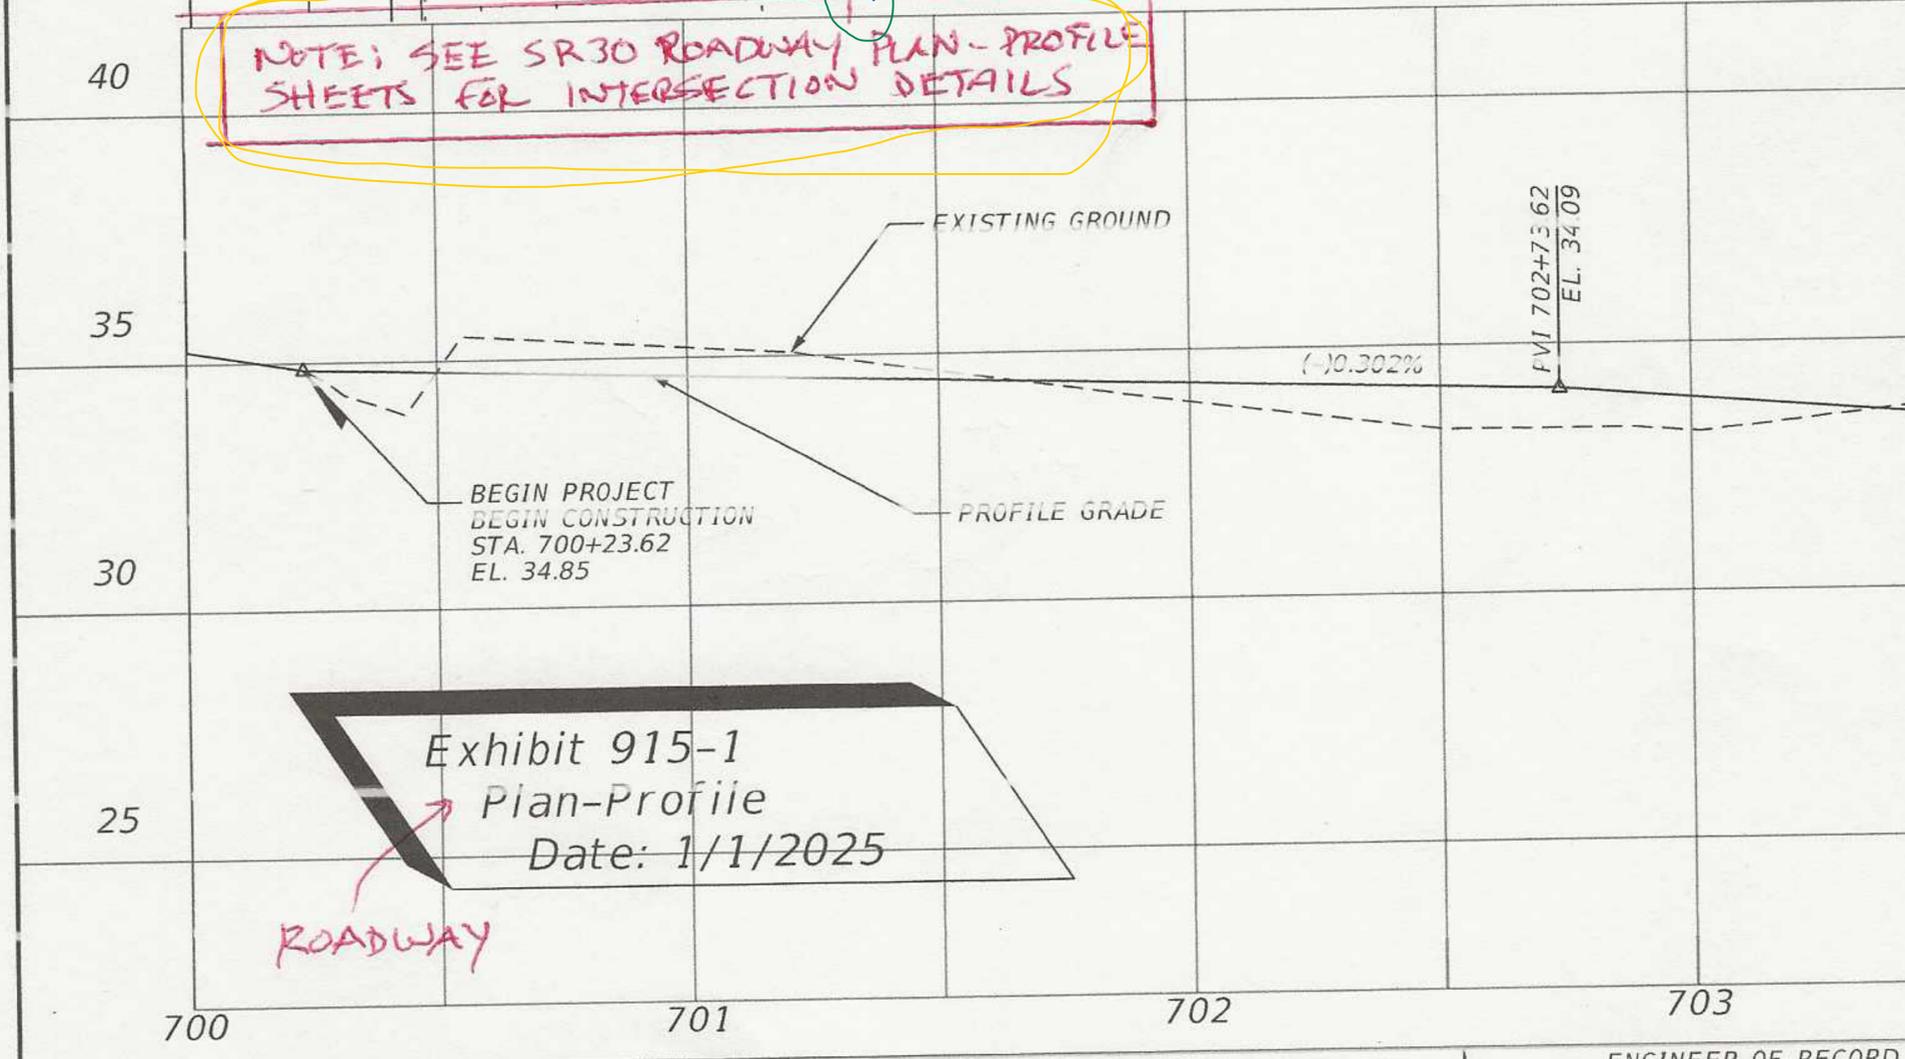


**NOTE: SEE SR30 ROADWAY PLAN-PROFILE SHEETS FOR INTERSECTION DETAILS**



**Exhibit 915-1**  
**Plan-Profile**  
**Date: 1/1/2025**

*ROADWAY*

REVISIONS				ENGINEER OF RECORD
DATE	DESCRIPTION	DATE	DESCRIPTION	
				<b>LUKE S. WALKER</b> LICENSE NUMBER: 12345 ROADWAY ENGINEERS, INC 122 MAIN ST TALLAHASSEE, FL 32301

