


MEDIAN BARRIER OPENING FOR MEDIAN
Crossovers Typical Layout

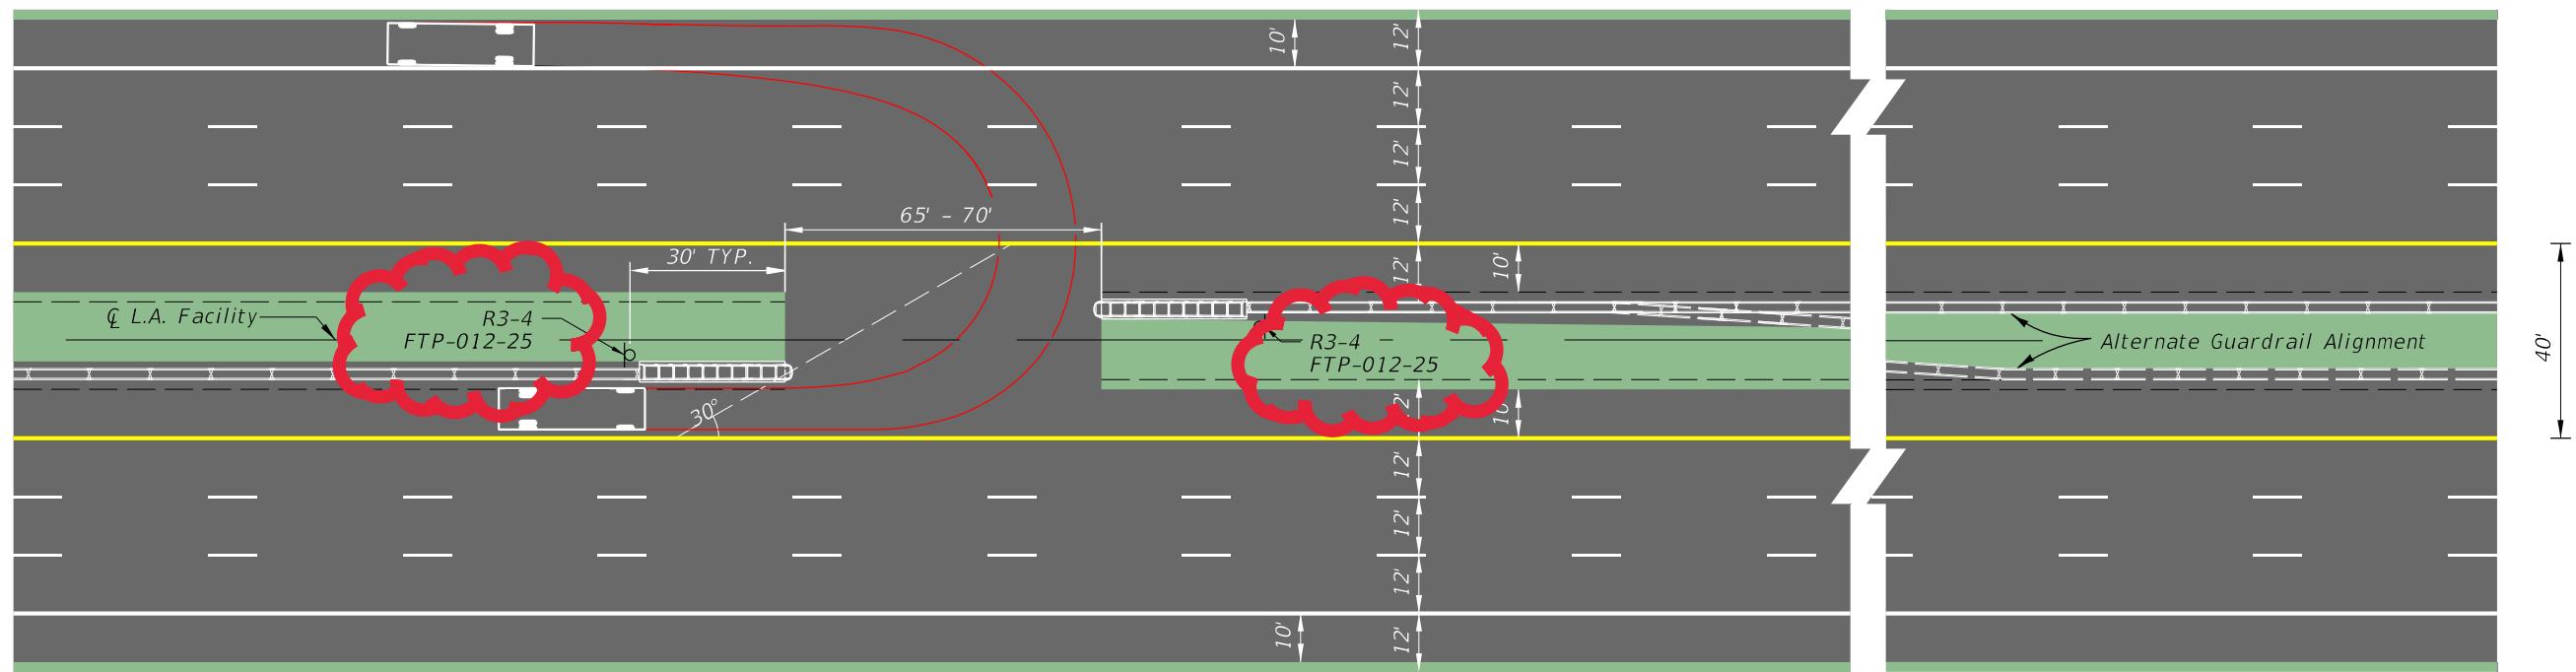

PLAN VIEW

LEGEND:



Crash Cushion



Barrier



Sign



SU Vehicle



R3-4
(36" x 36")

OFFICIAL
USE ONLY

NOTES:

1. Provide Yellow RPMs placed outside yellow edge line in advance of crossover as shown in Standard Plans, Index 706-001.
2. Minimum turning radius for SU vehicle shown, and were generated by AutoTURN.
3. For lane and median configurations other than the 6-lane, 40-foot median shown here, adjustments in turn radii or additional pavement may be required.

NOT TO SCALE

EXHIBIT 211-2
01/01/2026