


VEHICLE REFUGE AREA

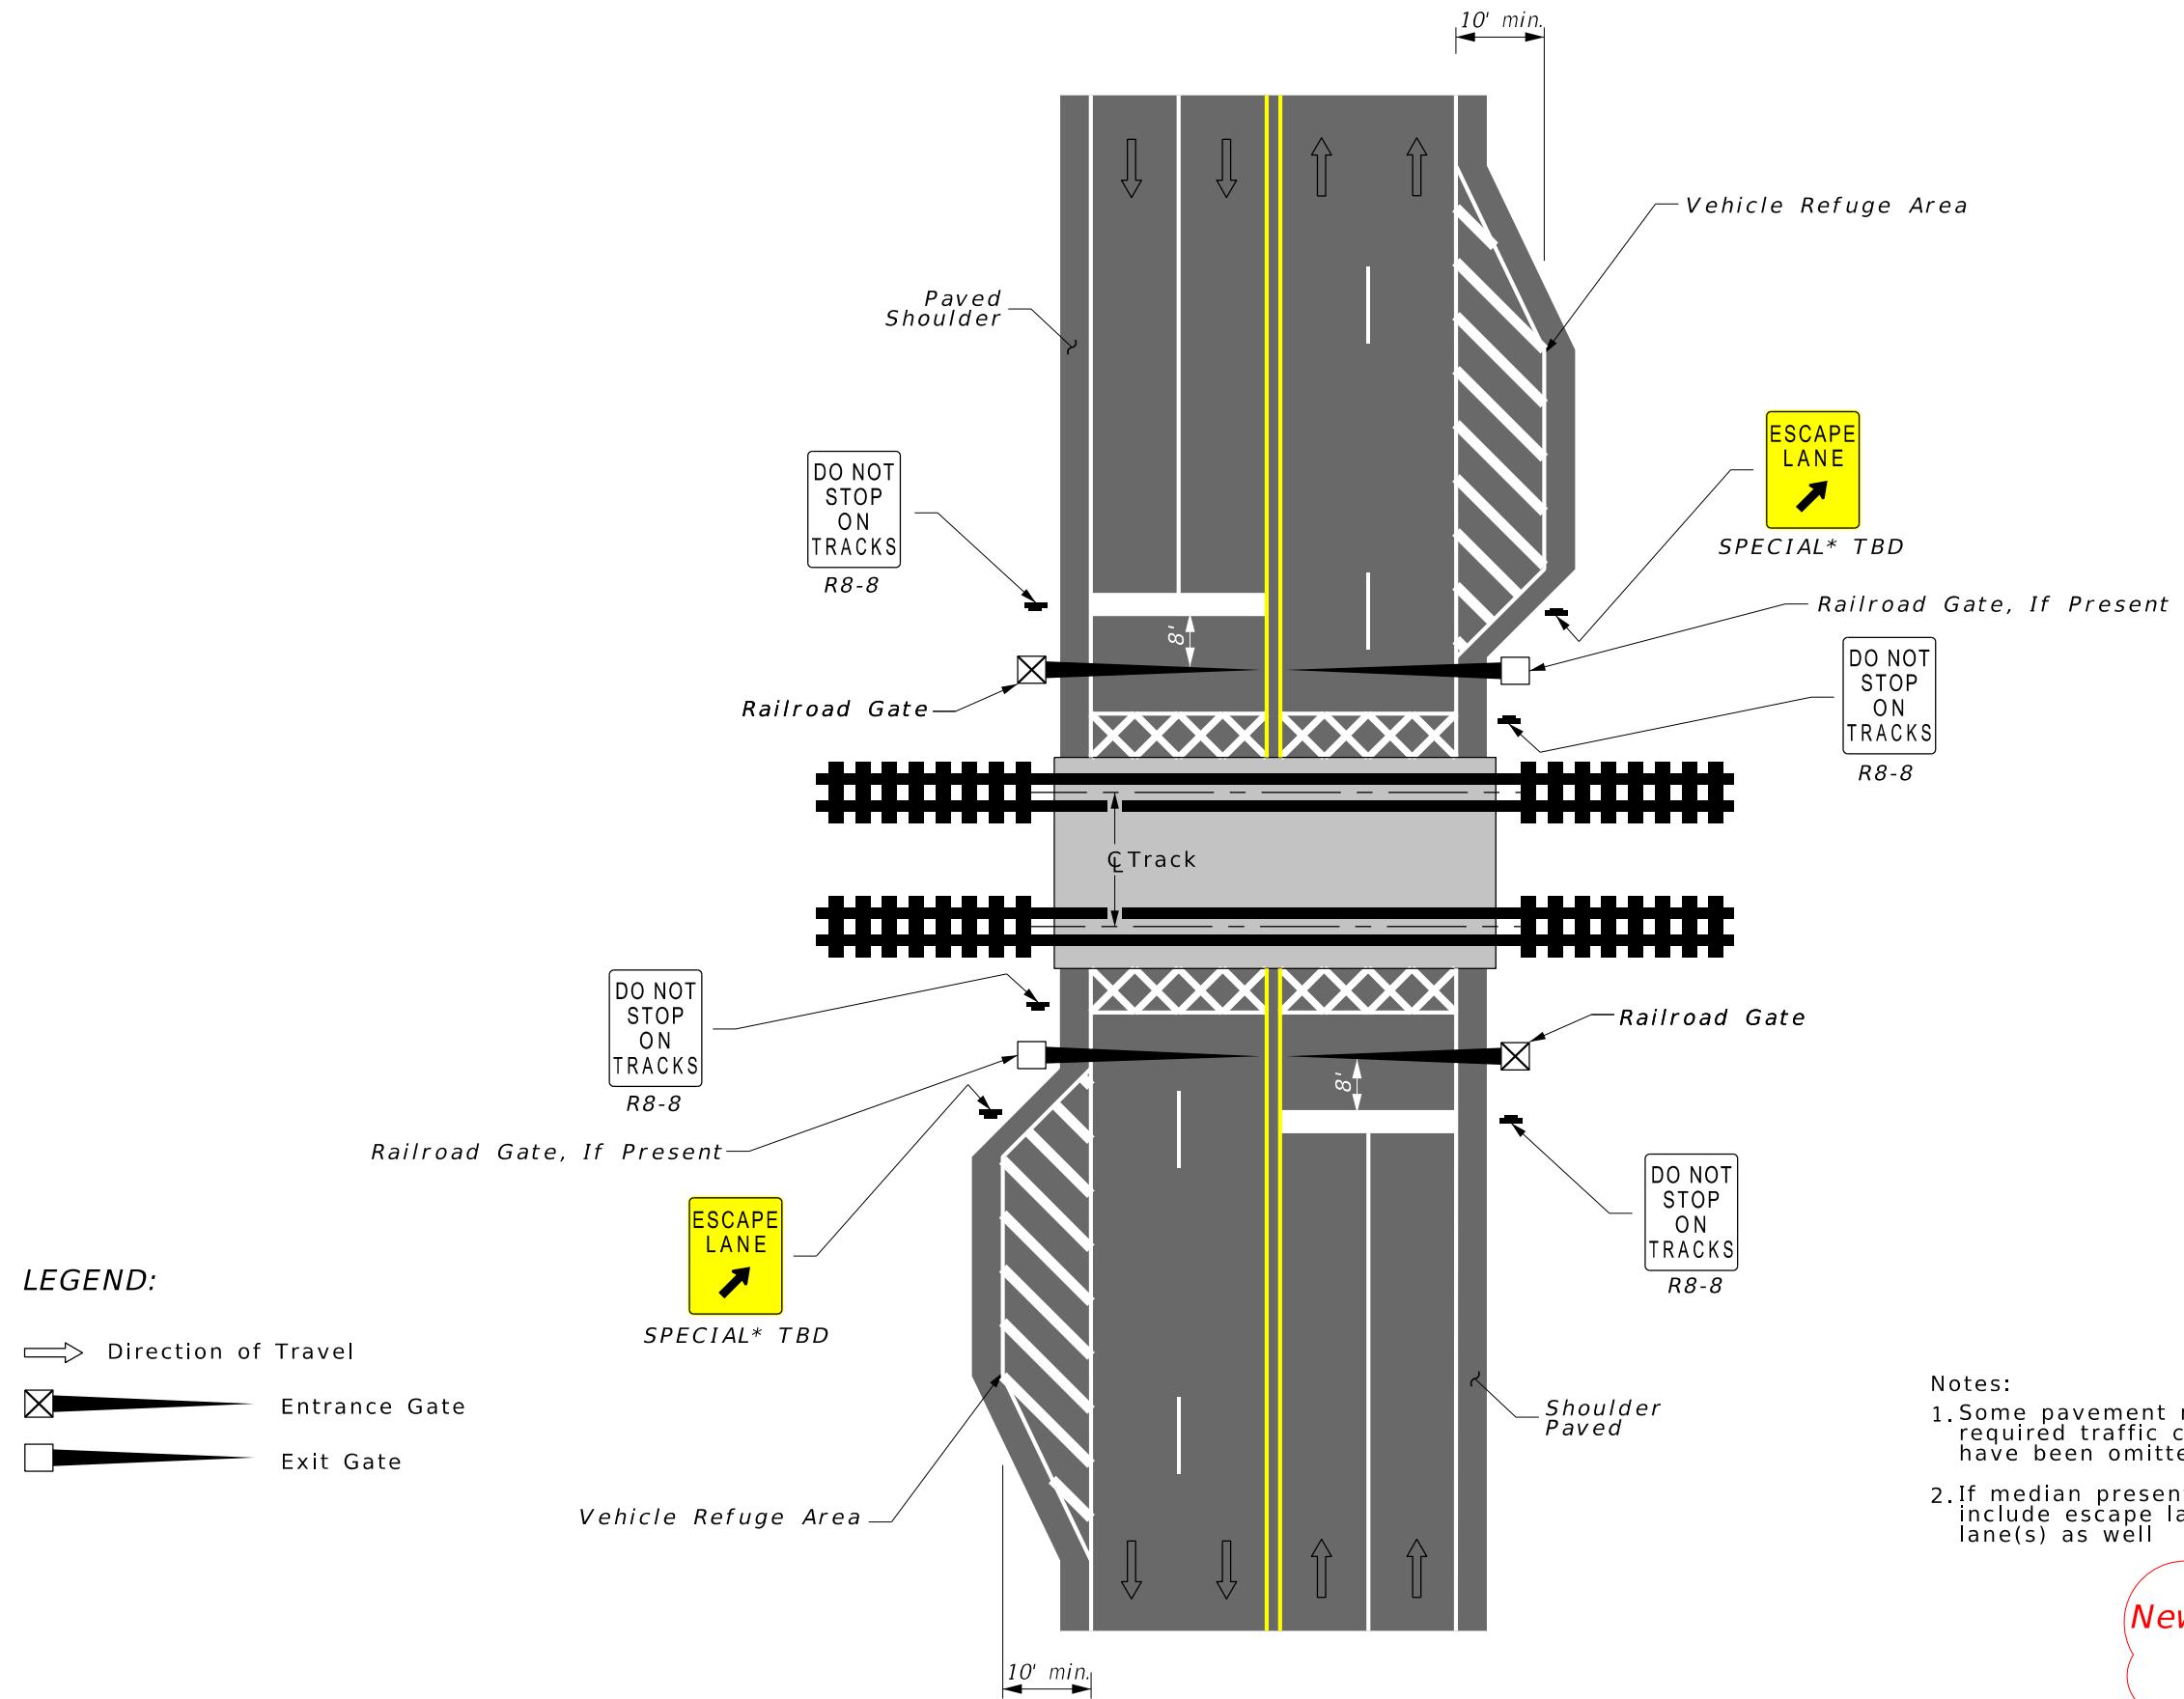

New FDM Exhibit for 2026
NOT TO SCALE

EXHIBIT 220-1

01/01/2026