


TYPICAL LAYOUT FOR ~~STANDARD~~ SIGNING AND PAVEMENT MARKING AT EXIT RAMP INTERSECTIONS

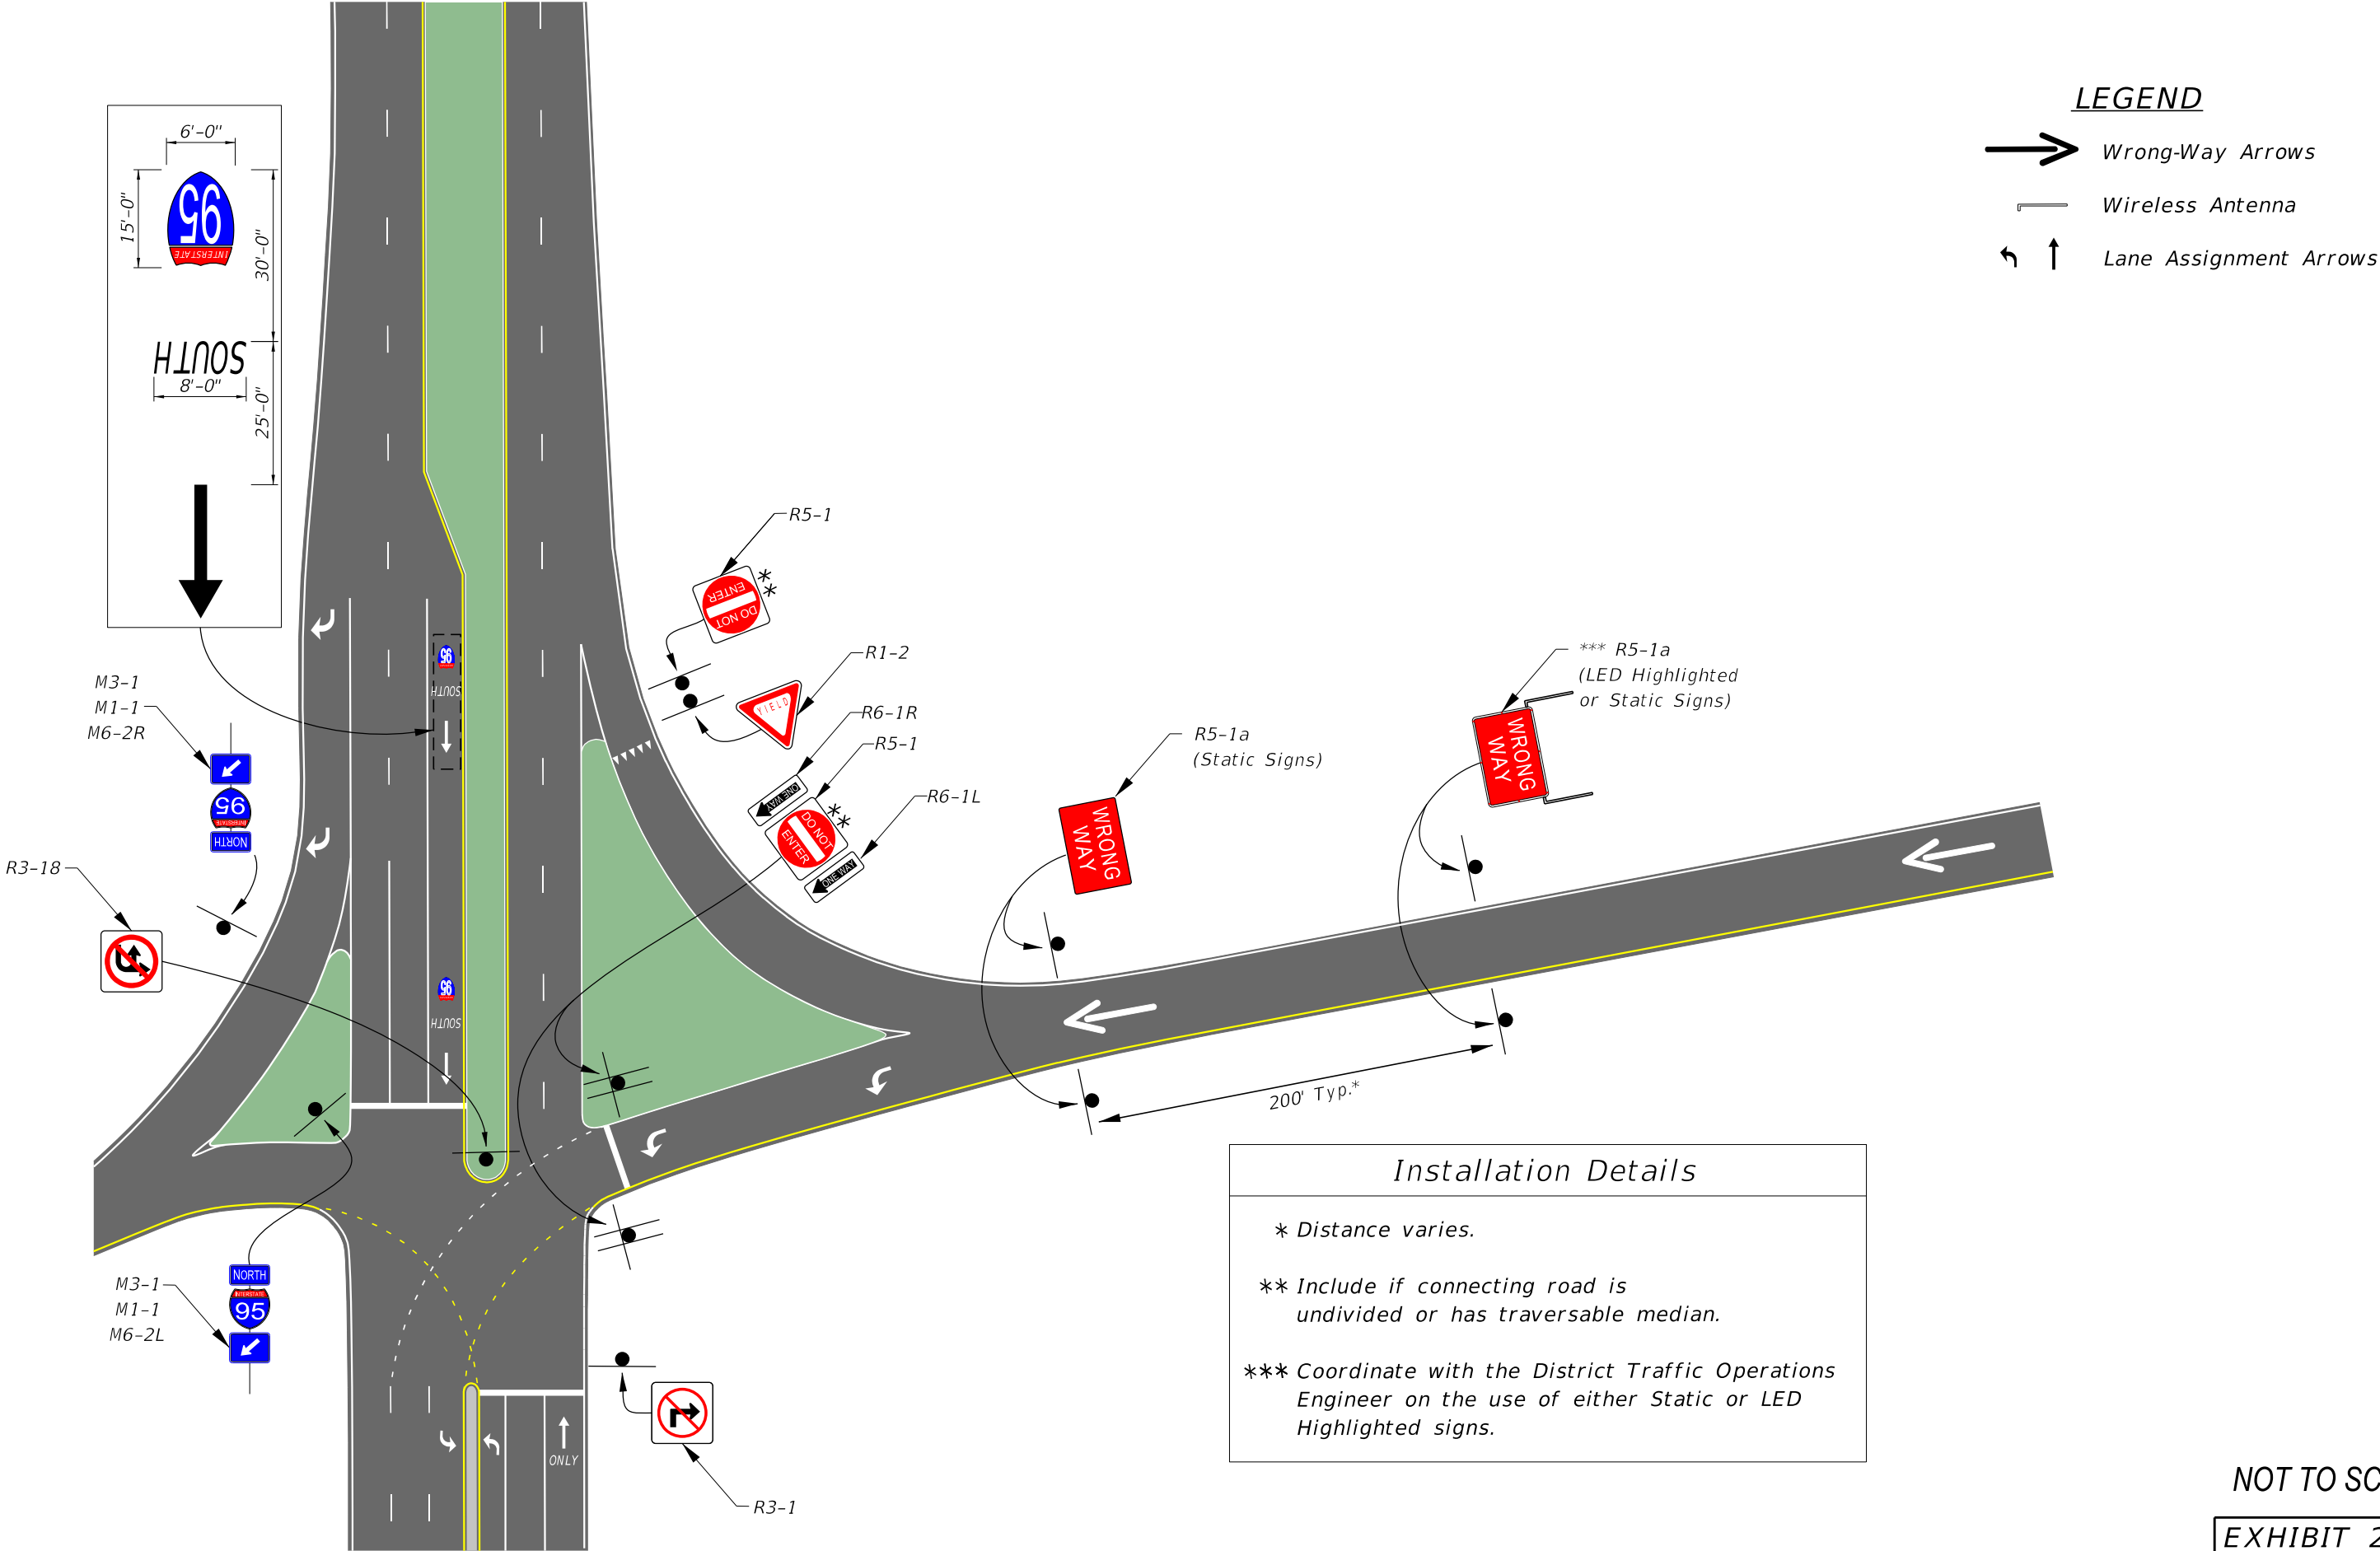

NOT TO SCALE

EXHIBIT 230-1a
01/01/2026