


TYPICAL LAYOUT FOR WRONG-WAY SIGNING AND PAVEMENT MARKING AT 4-LEG
UNSIGNALIZED INTERSECTIONS ALONG DIVIDED ARTERIALS/COLLECTORS

Installation Details

* If median nose width is <30 ft, these R5-1 and R5-1a signs are optional. See FDM 230.4.3

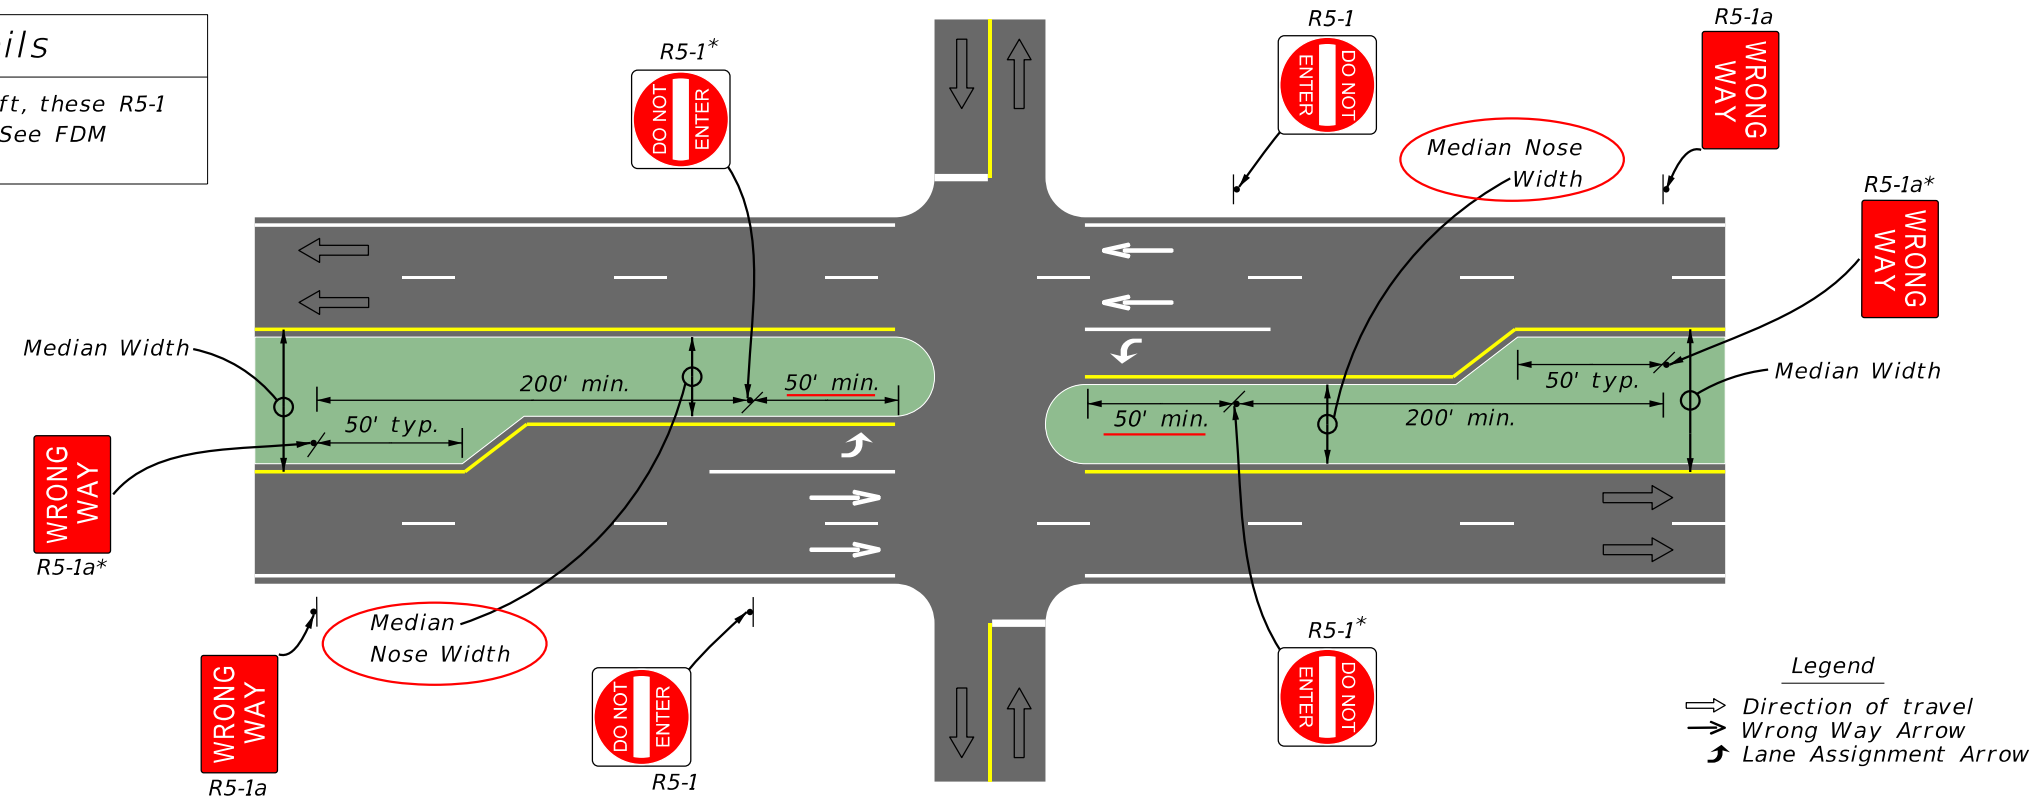

NOT TO SCALE

EXHIBIT 230-3
01/01/2026


TYPICAL LAYOUT FOR WRONG-WAY SIGNING AND PAVEMENT MARKING AT 3-LEG
UNSIGNALIZED INTERSECTIONS ALONG DIVIDED ARTERIALS/COLLECTORS

Installation Details

(1) Median Nose Width is equal to Median Width when auxiliary lanes are not present.

* If median nose width is <30 ft, these R5-1 and R5-1a signs are optional. See FDM 230.4.3.

**** Wrong Way Arrows optional when Downstream One-Way Egress is present. See Exhibit 230-5 for signing at these One-Way Egress locations.**

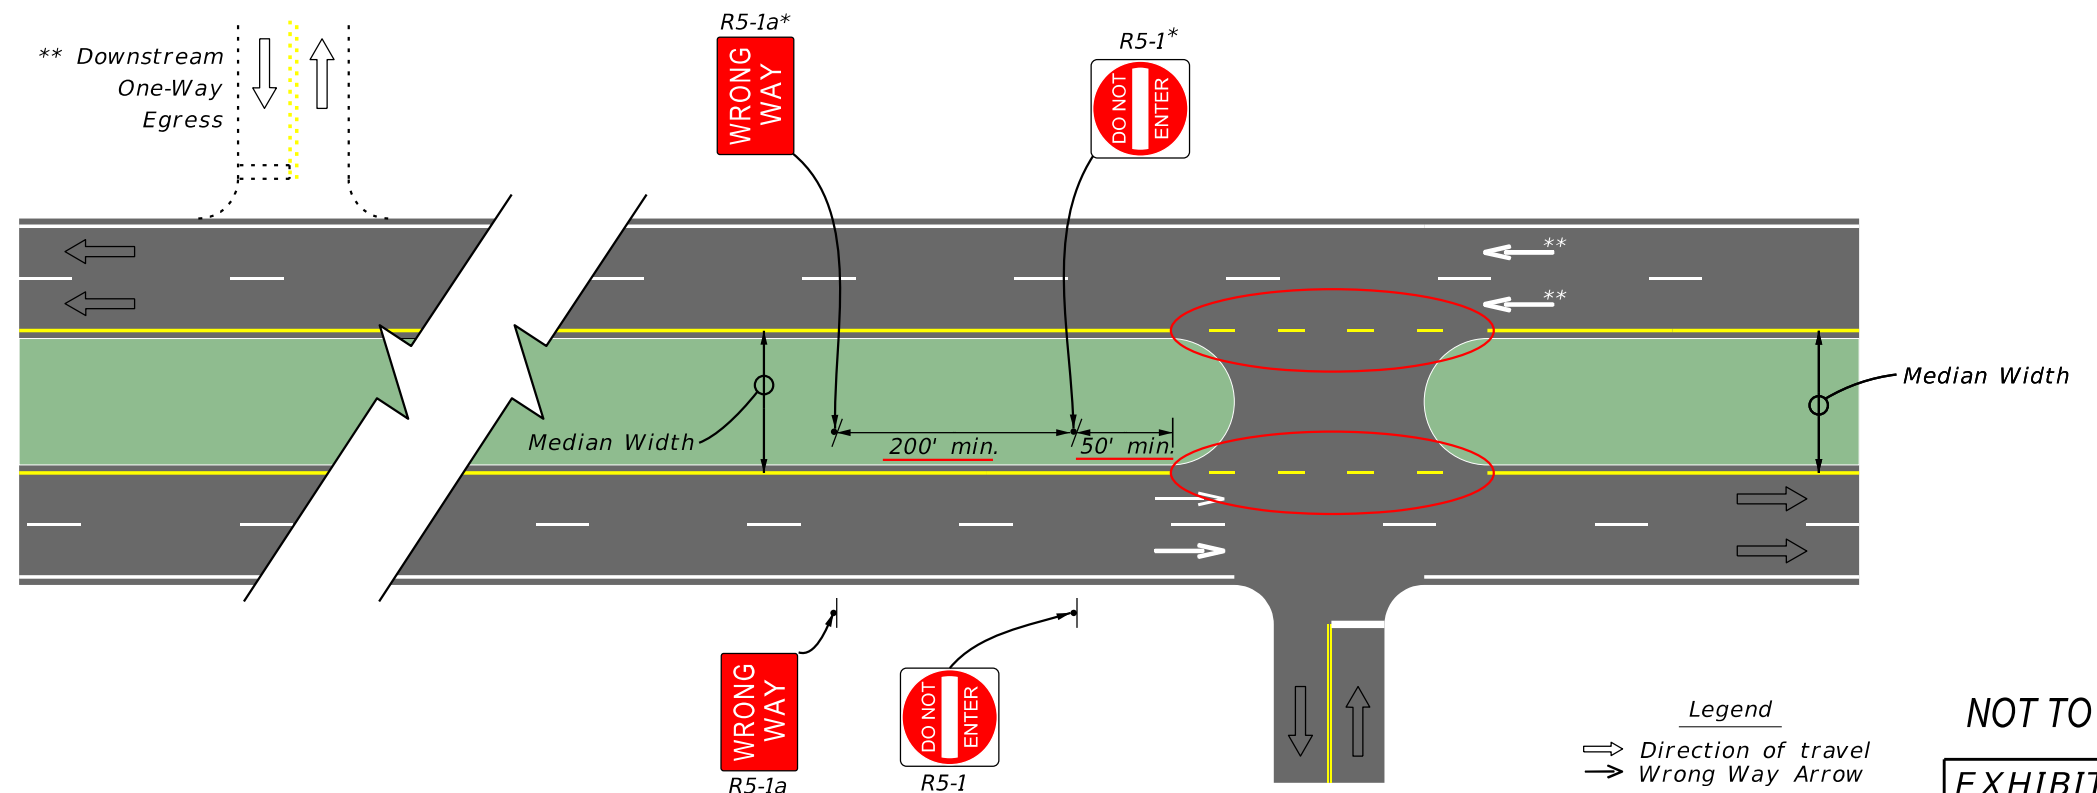

NOT TO SCALE

EXHIBIT 230-4
01/01/2026