
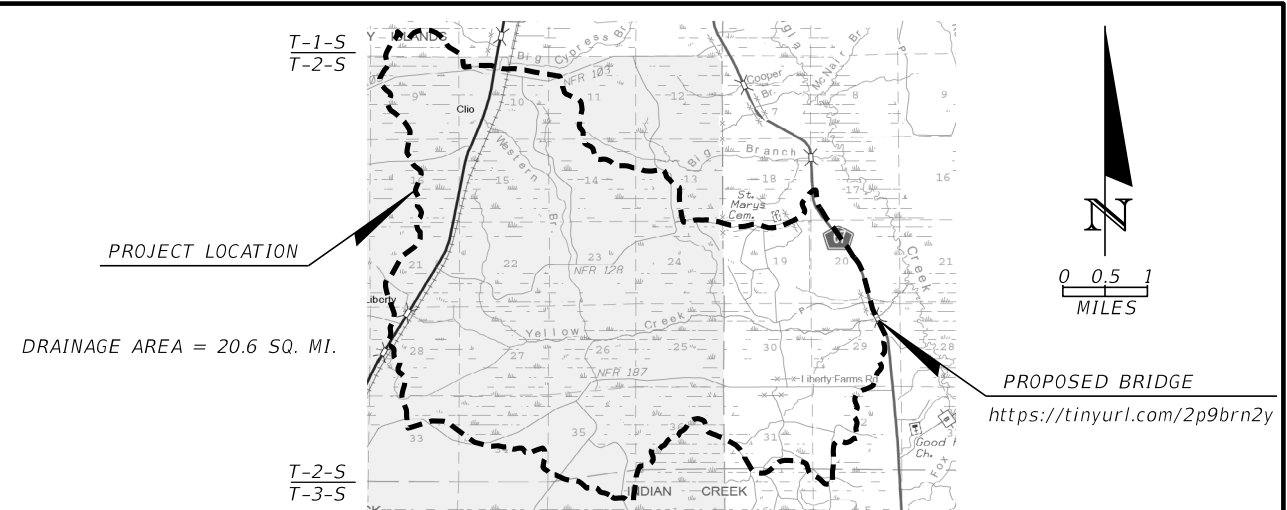


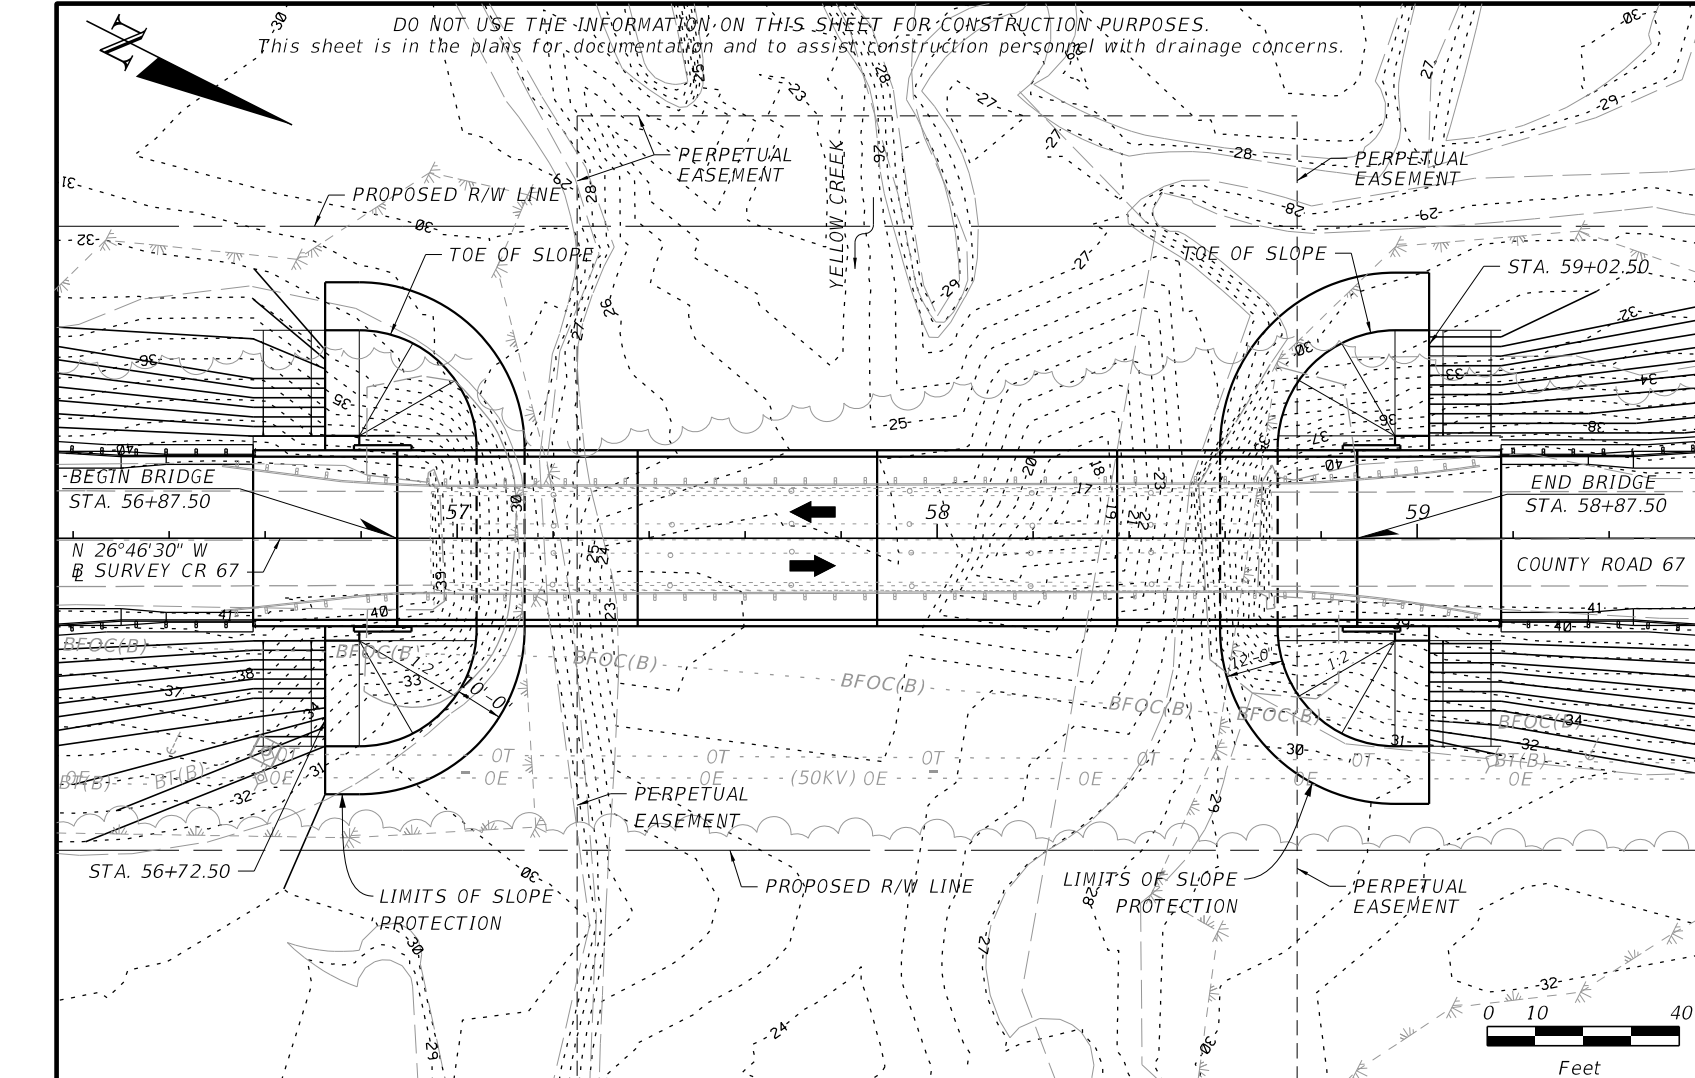


(REFERENCE)	EXISTING STRUCTURES				PROPOSED STRUCTURE
	(1)	(2)	(3)	(4)	
FOUNDATION	TIMBER PILE				24" **
OVERALL LENGTH (ft)	175'				200'
SPAN LENGTH (ft)	25'				50'
TYPE CONSTRUCTION	STEEL				CONCRETE
AREA OF OPENING @D.F. (sf)	1207.31				1343.41
BRIDGE WIDTH	20'				36'-8"
ELEV. LOW MEMBER (ft)	39.3				37.75
NOTES: Existing Structures - (1) structure being replaced or modified. (2), (3), and (4) are immediate upstream and downstream structures that affect the hydraulics of the proposed structure.					

HYDRAULIC DESIGN DATA					
WATER SURFACE ELEVATIONS:		N.H.W. (Non-Tidal)	24.6	M.H.W. (Tidal)	N/A
		CONTROL (Non-Tidal)	N/A	M.L.W. (Tidal)	N/A
FLOOD DATA:	MAX EVENT OF RECORD	DESIGN FLOOD	BASE FLOOD	OVERTOPPING	GREATEST FLOOD
STAGE ELEV. NAVD (ft)	36.36 (REM. #2)	34.57* / 31.64	35.26* / 32.00		37.24* / 32.88
DISCHARGE (cfs)	UNKNOWN	1915	2204		2964
AVERAGE VELOCITY (f/s)	UNKNOWN	1.52* / 2.64	1.59* / 2.81		1.68* / 3.18
EXCEEDANCE PROB. (%)	UNKNOWN	2%	1%		0.2%
FREQUENCY (yr.)	UNKNOWN	50	100		500
NOTES: Max. Event of Record: Maximum event recorded based on historical information (if available). Design Flood: Utilized to assure a desired level of hydraulic performance. Base Flood: Has a 1% chance of being exceeded in any given year (100 year frequency). Overtopping/Greatest Flood: Only show data for event with lower return period. Overtopping: Causes flow over the highway, watershed divide, or thru relief structures. Greatest flood: The most severe that can be predicted where overtopping is not practicable.					

SCOUR PREDICTIONS FOR PROPOSED STRUCTURE DESCRIBED ABOVE	(1) PIER INFORMATION		(2) TOTAL SCOUR ELEVATION (FT)		
	NUMBERS	SIZE AND TYPE	LONG TERM SCOUR ELEVATION	WORST CASE<100 yr FREQ. 100 YR.	WORST CASE<500 yr. FREQ. 500 YR.
	2 - 3	24" SO. PILES	N/A	20.10	19.90
	4	24" SO. PILES	N/A	14.96	14.76

HYDRAULIC RECOMMENDATIONS				
BEGIN BRIDGE STA. <u>56+87.50</u>		END BRIDGE STA. <u>58+87.50</u>		SKEW ANGLE BETWEEN BRIDGE AND ROADWAY <u>0°</u>
CLEARANCE PROVIDED (ft):	NAV: HORIZ.	<u>50</u>	NAV. VERT.	<u>13.2</u>
	DRIFT: HORIZ.	<u>50</u>	DRIFT: VERT.	<u>3.2</u>
MINIMUM CLEARANCE (ft):	NAV: HORIZ.	<u>10</u>	NAV. VERT.	<u>6</u>
	DRIFT: HORIZ.	<u>10</u>	DRIFT: VERT.	<u>2</u>
ABUTMENTS :	BEGIN BRIDGE		END BRIDGE	
	RUBBLE GRADE:	BANK AND SHORE PROTECTION		BANK AND SHORE PROTECTION
	SLOPE:	1V:2H		1V:2H
	BURIED OR NON-BURIED HORIZ. TOE:	NON-BURIED		NON-BURIED
	TOE HORIZ. DISTANCE (ft):	10'		12'
	LIMIT OF PROTECTION (ft):	53.33 LT & RT		LT & RT
	DECK DRAINAGE:		SPREAD CONTAINED IN SHOULDER, DRAINED VIA 4" SCUPPERS.	

REMARKS	
1. VALUE INCLUDES BACKWATER EFFECTS FROM PEAK STAGES OF TELOGIA CREEK	
2. AS REPORTED BY J.T. HATHAWAY, LIBERTY COUNTY ROAD SUPERINTENDENT.	

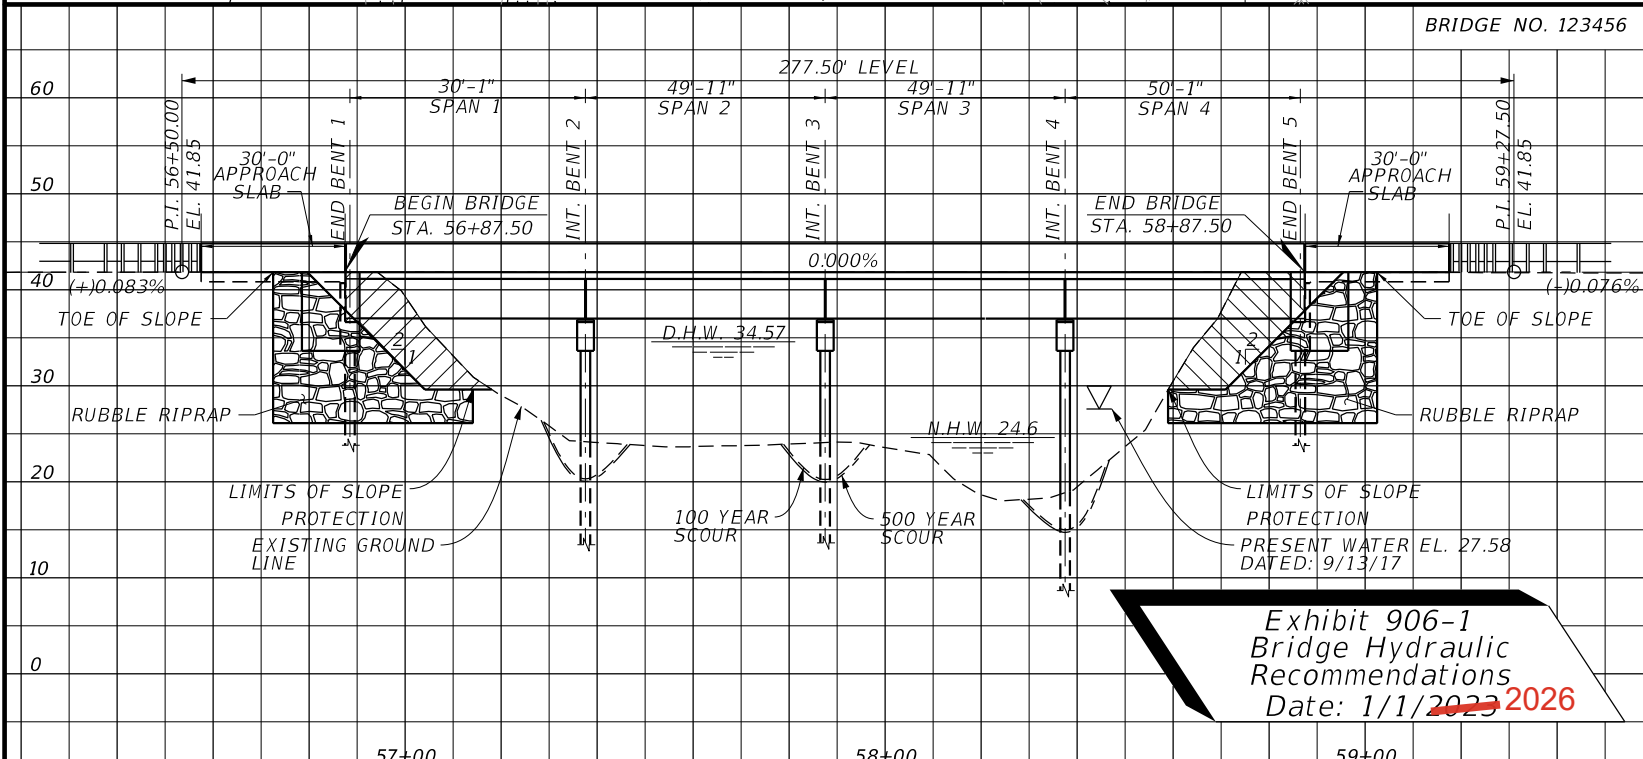

REVISIONS				LUKE S. WALKER, P.E. LICENSE NUMBER: 12345 ROADWAY ENGINEERS, INC. 123 MAIN STREET TALLAHASSEE, FL 32301			
DATE	BY	DESCRIPTION	DATE	BY	DESCRIPTION	DATE	BY

22	STATE OF FLORIDA			SHEET TITLE:	REF. DWG. NO.
22	DEPARTMENT OF TRANSPORTATION				
22	ROAD NO.	COUNTY	FINANCIAL PROJECT ID	PROJECT NAME:	SHEET NO.
22	CR 67	LIBERTY	123456-1-52-01		
22				BRIDGE OVER YELLOW CREEK	