

INDEX OF RFP CONCEPT PLANS

SHEET NO.	SHEET DESCRIPTION
1	KEY SHEET
2	TYPICAL SECTION DETAILS
3	MODEL MANAGEMENT
4 - 5	PROJECT CONTROL
6	ROADWAY PLAN-PROFILE
7 - 9	STORMWATER FACILITIES
10	DRAINAGE MAP
11	SOIL SURVEY
12 - 14	REPORT OF CORE BORINGS
15 - 16	SELECTIVE CLEARING AND GRUBBING
17	MITIGATION PLAN
18	TRAFFIC PLAN (S&PM, SIGNALIZATION, ITS, LIGHTING)
19 - 26	LANDSCAPING PLAN
27 - 32	ARCHITECTURAL PLAN
33 - 36	STRUCTURES PLAN
37 - 40	UTILITY WORK BY HIGHWAY CONTRACTOR

STATE OF FLORIDA
DEPARTMENT OF TRANSPORTATION

RFP CONCEPT PLANS


FINANCIAL PROJECT ID 123456-1-52-01

(FEDERAL FUNDS)

BAY COUNTY (46080)

STATE ROAD NO. 22 (WEWA HWY)

ADD LANES AND RECONSTRUCT FROM CRIM BLVD. TO KURT ST.

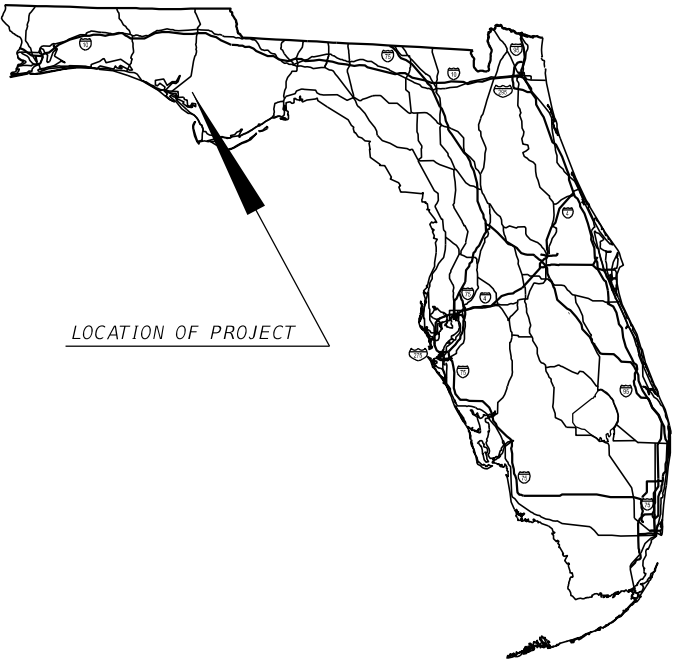

LOCATION OF PROJECT

PROJECT LOCATION URL: <https://tinyurl.com/367v2589>
PROJECT LIMITS: BEGIN MP 1.560 – END MP 7.560
EXCEPTIONS: NONE
BRIDGE LIMITS: BR#469998 MP 3.422 – MP 3.471
RAILROAD CROSSING: NONE

Replace URL box with old-style Project Location Map

Exhibit 907-1
RFP Concept Plans
Date: ~~1/30/2023~~

1/1/2026

RFP CONCEPT PLANS
DEVELOPED BY:

LUKE S. WALKER, P.E.
P.E. LICENSE NUMBER ~~9999~~12345
ROADWAY ENGINEERS, INC.
123 MAIN STREET
TALLAHASSEE, FL 32301
CONTRACT NO.: C0000
VENDOR NO.: 99-999999

FDOT PROJECT MANAGER:

BEN K. UWAIBI, P.E.

FISCAL YEAR	SHEET NO.
23	1