


CONTRACT PLANS COMPONENTS

- ROADWAY
- SIGNING AND PAVEMENT MARKING
- SIGNALIZATION
- INTELLIGENT TRANSPORTATION SYSTEMS
- LIGHTING
- LANDSCAPE
- ARCHITECTURAL
- STRUCTURES
- TOLL FACILITIES
- UTILITY WORK BY HIGHWAY CONTRACTOR PLANS

STATE OF FLORIDA
DEPARTMENT OF TRANSPORTATION
ROADWAY PLANS

FINANCIAL PROJECT ID 123456-1-52-01
(FEDERAL FUNDS)
BAY COUNTY (46080)
STATE ROAD NO. 22 (WEWA HWY)

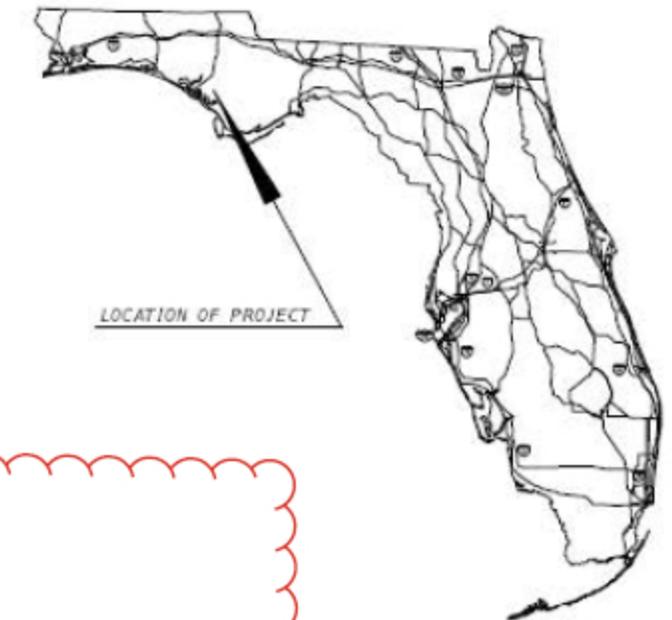

INDEX OF ROADWAY PLANS

SHEET NO.	SHEET DESCRIPTION
1	KEY SHEET
2	SIGNATURE SHEET
3	DRAINAGE MAP
4 - 5	TYPICAL SECTIONS
6	TYPICAL SECTION DETAILS
7 - 9	MODEL MANAGEMENT
10	PROJECT CONTROL
11	GENERAL NOTES
12 - 14	ROADWAY PLAN-PROFILE
15 - 16	TRAFFIC MONITORING SITE
17	SPECIAL DETAILS
18 - 19	DRAINAGE NETWORK PLAN
20 - 21	DRAINAGE NETWORK PROFILE
22	DRAINAGE NETWORK CROSS SECTIONS
23	OPTIONAL MATERIALS TABULATION
24	DRAINAGE SPECIAL DETAILS
25 - 34	ROADWAY CROSS SECTIONS
35 - 38	VERIFIED UTILITY LOCATE
39 - 46	TEMPORARY TRAFFIC CONTROL PLAN
47 - 52	UTILITY ADJUSTMENTS
53 - 56	SELECTIVE CLEARING AND GRUBBING
57	MISCELLANEOUS STRUCTURES
GR-1*	SOIL SURVEY
GR-2*	REPORT OF CORE BORINGS

ADD LANES AND RECONSTRUCT FROM CRIM BLVD. TO KURT ST.

~~PROJECT LOCATION URL: <https://tinyurl.com/367v2589>~~

~~PROJECT LIMITS: BEGIN MP 1.560 - END MP 7.560~~

~~EXCEPTIONS: NONE~~

~~BRIDGE LIMITS: BR#46508 MP 3.422 - MP 3.471~~

~~RAILROAD CROSSING: NONE~~

Replace this URL Box
with a Project Location Map
(use the Project Location Map
from 2022 FDM Exhibit 302-1)

* These sheets are included in the Index of Roadway Plans only to indicate that they are part of the Roadway Plans. These sheets are contained in a separate digitally signed and sealed document.

DEVELOPMENTAL STANDARD PLANS (DSPs):
D591-001 LANDSCAPE IRRIGATION SLEEVES

GOVERNING STANDARD PLANS:

Florida Department of Transportation, FY2023-24 Standard Plans for Road and Bridge Construction and applicable Interim Revisions (IRs).

Standard Plans for Road Construction and associated IRs are available at the following website: <http://www.fdot.gov/design/standardplans>

APPLICABLE IRs: IR536-001-01, IR521-001-01

Standard Plans for Bridge Construction are included in the Structures Plans Component

GOVERNING STANDARD SPECIFICATIONS:

Florida Department of Transportation, FY 2023-24 Standard Specifications for Road and Bridge Construction at the following website: <http://www.fdot.gov/programmanagement/Implemented/SpecBooks>

Exhibit 910-1
Lead Key Sheet
Date: 1/1/~~2025~~

2026

**ROADWAY PLANS
ENGINEER OF RECORD:**

LUKE S. WALKER, P.E.
P.E. LICENSE NUMBER 99991
ROADWAY ENGINEERS, INC.
123 MAIN STREET
TALLAHASSEE, FL 32301
(850) 671-1313
CONTRACT NO.: C0000
VENDOR NO.: 99-999999

FDOT PROJECT MANAGER:

BEN K. UWAIBI, P.E.


CONSTRUCTION CONTRACT NO.	FISCAL YEAR	SHEET NO.
T0000	22	1

CONTRACT PLANS COMPONENTS

- ROADWAY
- SIGNING AND PAVEMENT MARKING
- SIGNALIZATION
- INTELLIGENT TRANSPORTATION SYSTEMS
- LIGHTING
- LANDSCAPE
- ARCHITECTURAL
- STRUCTURES
- TOLL FACILITIES
- UTILITY WORK BY HIGHWAY CONTRACTOR PLANS

STATE OF FLORIDA
DEPARTMENT OF TRANSPORTATION
ROADWAY PLANS

FINANCIAL PROJECT ID 123456-1-52-01
(FEDERAL FUNDS)
BAY COUNTY (46080)
STATE ROAD NO. 22 (WEWA HWY)

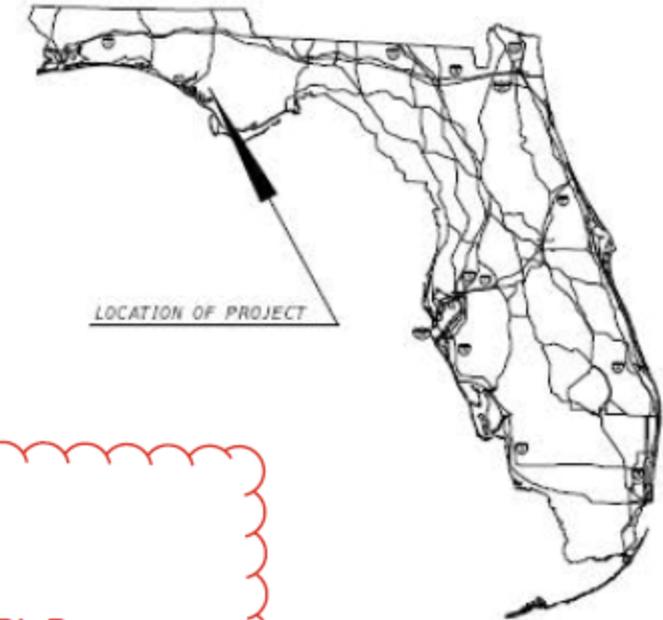

LOCATION OF PROJECT

INDEX OF ROADWAY PLANS

SHEET NO.	SHEET DESCRIPTION
1	KEY SHEET
2 - 2A	SIGNATURE SHEET
3	DRAINAGE MAP
4 - 5	TYPICAL SECTIONS
6	TYPICAL SECTION DETAILS
7 - 9	MODEL MANAGEMENT
10	PROJECT CONTROL
11	GENERAL NOTES
12 - 14	ROADWAY PLAN-PROFILE
15 - 16	TRAFFIC MONITORING SITE
17	SPECIAL DETAILS
18 - 19	DRAINAGE NETWORK PLAN
20 - 21	DRAINAGE NETWORK PROFILE
22	DRAINAGE NETWORK CROSS SECTIONS
23	OPTIONAL MATERIALS TABULATION
24	DRAINAGE SPECIAL DETAILS
25 - 34	ROADWAY CROSS SECTIONS
35 - 38	VERIFIED UTILITY LOCATE
39 - 46	TEMPORARY TRAFFIC CONTROL PLAN
47 - 52	UTILITY ADJUSTMENTS
53 - 56	SELECTIVE CLEARING AND GRUBBING
57	MISCELLANEOUS STRUCTURES
GR-1*	SOIL SURVEY
GR-2*	REPORT OF CORE BORINGS

ADD LANES AND RECONSTRUCT FROM CRIM BLVD. TO KURT ST.

~~PROJECT LOCATION URL: <https://tinyurl.com/367v2589>~~

~~PROJECT LIMITS: BEGIN MP 1.560 - END MP 7.560~~

~~EXCEPTIONS: NONE~~

~~BRIDGE LIMITS: BR#469008 MP 3.422 - MP 3.471~~

~~RAILROAD CROSSING: NONE~~

Replace this URL Box with a Project Location Map (use the Project Location Map from 2022 FDM Exhibit 302-1)

Exhibit 910-2
Revised Lead Key Sheet
Date: 1/1/2025

2026

* These sheets are included in the Index of Roadway Plans only to indicate that they are part of the Roadway Plans. These sheets are contained in a separate digitally signed and sealed document.

DEVELOPMENTAL STANDARD PLANS (DSPs):
D591-001 LANDSCAPE IRRIGATION SLEEVES

GOVERNING STANDARD PLANS:
Florida Department of Transportation, FY2023-24 Standard Plans for Road and Bridge Construction and applicable Interim Revisions (IRs).

Standard Plans for Road Construction and associated IRs are available at the following website: <http://www.fdot.gov/design/standardplans>

APPLICABLE IRs: IR536-001-01, IR521-001-01

Standard Plans for Bridge Construction are included in the Structures Plans Component

GOVERNING STANDARD SPECIFICATIONS:
Florida Department of Transportation, FY 2023-24 Standard Specifications for Road and Bridge Construction at the following website: <http://www.fdot.gov/programmanagement/Implemented/SpecBooks>

REVISIONS:
FINANCIAL PROJECT ID 123456-1-52-01
Roadway Sheets 1, 2A, 5, & 19 (Revised 04-20-22)

KEY SHEET REVISIONS	
DATE	DESCRIPTION
04-20-22	Added Sheet Number 2A to the Index and Revised Sheet Numbers 5 & 19.

ROADWAY PLANS ENGINEER OF RECORD:

LUKE S. WALKER, P.E.
P.E. LICENSE NUMBER 99991
ROADWAY ENGINEERS, INC.
123 MAIN STREET
TALLAHASSEE, FL 32301
(850) 671-1313
CONTRACT NO.: C0000
VENDOR NO.: 99-999999

FDOT PROJECT MANAGER:

BEN K. UWAIBI, P.E.

CONSTRUCTION CONTRACT NO.	FISCAL YEAR	SHEET NO.
T0000	22	1