

CONTRACT PLANS COMPONENTS

ROADWAY  
SIGNING AND PAVEMENT MARKING  
SIGNALIZATION  
INTELLIGENT TRANSPORTATION SYSTEMS  
LIGHTING  
LANDSCAPE  
ARCHITECTURAL  
STRUCTURES  
TOLL FACILITIES  
UTILITY WORK BY HIGHWAY CONTRACTOR PLANS

INDEX OF ROADWAY PLANS

SHEET NO.	SHEET DESCRIPTION
1	KEY SHEET
2 - 2A	SIGNATURE SHEET
3	DRAINAGE MAP
4 - 5	TYPICAL SECTIONS
6	TYPICAL SECTION DETAILS
7 - 9	MODEL MANAGEMENT
10	PROJECT CONTROL
11	GENERAL NOTES
12 - 14	ROADWAY PLAN-PROFILE
15 - 16	TRAFFIC MONITORING SITE
17	SPECIAL DETAILS
18 - 19	DRAINAGE NETWORK PLAN
20 - 21	DRAINAGE NETWORK PROFILE
22	DRAINAGE NETWORK CROSS SECTIONS
23	OPTIONAL MATERIALS TABULATION
24	DRAINAGE SPECIAL DETAILS
25 - 34	ROADWAY CROSS SECTIONS
35 - 38	VERIFIED UTILITY LOCATE
39 - 46	TEMPORARY TRAFFIC CONTROL PLAN
47 - 52	UTILITY ADJUSTMENTS
53 - 56	SELECTIVE CLEARING AND GRUBBING
57	MISCELLANEOUS STRUCTURES

GR-1*	SOIL SURVEY
GR-2*	REPORT OF CORE BORINGS

\* These sheets are included in the Index of Roadway Plans only to indicate that they are part of the Roadway Plans. These sheets are contained in a separate digitally signed and sealed document.

DEVELOPMENTAL STANDARD PLANS (DSPs):

D591-001 LANDSCAPE IRRIGATION SLEEVES

GOVERNING STANDARD PLANS:

Florida Department of Transportation, FY2023-24 Standard Plans for Road and Bridge Construction and applicable Interim Revisions (IRs).

Standard Plans for Road Construction and associated IRs are available at the following website: <http://www.fdot.gov/design/standardplans>

APPLICABLE IRs: IR536-001-01, IR521-001-01

Standard Plans for Bridge Construction are included in the Structures Plans Component

GOVERNING STANDARD SPECIFICATIONS:

Florida Department of Transportation, FY 2023-24 Standard Specifications for Road and Bridge Construction at the following website: <http://www.fdot.gov/programmanagement/Implemented/SpecBooks>

STATE OF FLORIDA  
DEPARTMENT OF TRANSPORTATION

ROADWAY PLANS

FINANCIAL PROJECT ID 123456-1-52-01

(FEDERAL FUNDS)

BAY COUNTY (46080)

STATE ROAD NO. 22 (WEWA HWY)

ADD LANES AND RECONSTRUCT FROM CRIM BLVD. TO KURT ST.

PROJECT LOCATION URL: <https://tinyurl.com/367v2589>

PROJECT LIMITS: BEGIN MP 1.560 – END MP 7.560

EXCEPTIONS: NONE

BRIDGE LIMITS: BR#465998 MP 3.422 – MP 3.471

RAILROAD CROSSING: NONE

Replace URL box with old-style Project Location Map

Exhibit 910-2  
Revised Lead Key Sheet  
Date: 1/1/2025


2026

REVISIONS:

FINANCIAL PROJECT ID 123456-1-52-01  
Roadway Sheets 1, 2A, 5, & 19 (Revised 04-20-22)

KEY SHEET REVISIONS	
DATE	DESCRIPTION
04-20-22	Added Sheet Number 2A to the Index and Revised Sheet Numbers 5 & 19.

THIS PROJECT TO BE LET TO CONTRACT  
WITH FINANCIAL PROJECT ID(S):  
123456-1-56-01, 123457-1-52-01, 123457-1-56-01

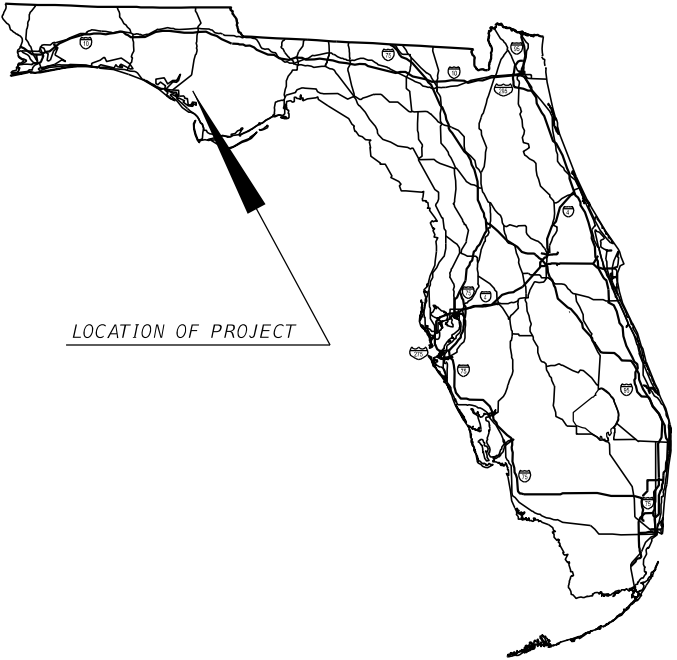

LOCATION OF PROJECT

ROADWAY PLANS  
ENGINEER OF RECORD:

LUKE S. WALKER, P.E.  
P.E. LICENSE NUMBER 00001  
ROADWAY ENGINEERS, INC.  
123 MAIN STREET  
TALLAHASSEE, FL 32301  
(850) 671-1313  
CONTRACT NO.: C0000  
VENDOR NO.: 99-999999

FDOT PROJECT MANAGER:

BEN K. UWAIBI, P.E.

CONSTRUCTION CONTRACT NO.	FISCAL YEAR	SHEET NO.
T0000	22	1