



THIS ITEM HAS BEEN DIGITALLY SIGNED AND SEALED BY:

Luke S. Walker
2022.07.14 16:52:48 - 4'00'
ON THE DATE ADJACENT TO THE SEAL
SIGNATURE MUST BE VERIFIED ON ANY ELECTRONIC COPIES.
ROADWAY ENGINEERS, INC.
123 MAIN STREET
TALLAHASSEE, FL 32301
LUKE S. WALKER, P.E. NO. 99991
12345

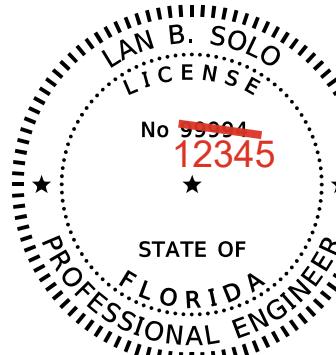

THIS ITEM HAS BEEN DIGITALLY SIGNED AND SEALED BY:

Lan B. Solo
2022.07.14 16:42:28 - 4'00'
ON THE DATE ADJACENT TO THE SEAL
SIGNATURE MUST BE VERIFIED ON ANY ELECTRONIC COPIES.
ROADWAY ENGINEERS, INC.
123 MAIN STREET
TALLAHASSEE, FL 32301
LAN B. SOLO, P.E. NO. 99994
12345

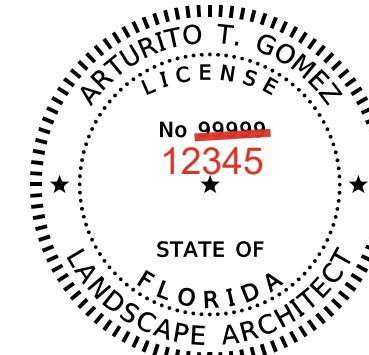

THIS ITEM HAS BEEN DIGITALLY SIGNED AND SEALED BY:

Arturito T. Gomez
2022.07.14 15:35:15 - 8'00'
ON THE DATE ADJACENT TO THE SEAL
SIGNATURE MUST BE VERIFIED ON ANY ELECTRONIC COPIES.
LAND DESIGN, LLC.
345 IVY LANE
ORLANDO, FL 32801
ARTURITO T. GOMEZ, L.A. NO. 99990
12345

THE ABOVE NAMED PROFESSIONAL ENGINEER SHALL BE RESPONSIBLE FOR THE FOLLOWING SHEETS IN ACCORDANCE WITH RULE 61G15-23.004, F.A.C.

SHEET NO.	SHEET DESCRIPTION
1	KEYSHEET
2	SIGNATURE SHEET
3	DRAINAGE MAP
4 - 5	TYPICAL SECTIONS
6	TYPICAL SECTION DETAILS
7 - 9	MODEL MANAGEMENT
10	PROJECT CONTROL
11	GENERAL NOTES
12 - 14	ROADWAY PLAN-PROFILE
18 - 19	DRAINAGE STRUCTURES
32 - 37	UTILITY ADJUSTMENTS

THE ABOVE NAMED PROFESSIONAL ENGINEER SHALL BE RESPONSIBLE FOR THE FOLLOWING SHEETS IN ACCORDANCE WITH RULE 61G15-23.004, F.A.C.

SHEET NO.	SHEET DESCRIPTION
2	SIGNATURE SHEET 32 - 37 UTILITY ADJUSTMENTS

SHEET NO.	SHEET DESCRIPTION
2	SIGNATURE SHEET 38 - 41 SELECTIVE CLEARING AND GRUBBING

THE ABOVE NAMED PROFESSIONAL IS RESPONSIBLE FOR THE FOLLOWING BIM FILES IN ACCORDANCE WITH RULE 61G15-23.004, F.A.C.

BIM FILES IDENTIFIED AS PLANS TO SUPPORT EARTHWORK		
FILE NAME	FILE DESCRIPTION	SHA256 Encryption Code
12345615201\3DDeliverables\AMG-2DSGNRD01.dgn	AMG file for 3D-Deliverables	8300BBC34652B4CFA33508126A9CA83D4AE283AE44691047C4E73BCDD2A2AD8E
12345615201\3DDeliverables\AMG-MODLRD01.i.dgn		BC738EA02F35571B8B04F32EF04AE12D0192CDC9F2531249CC207944092A12E9
12345615201\3DDeliverables\AMG-ALGNSR61.xml		BA08AC3CFBB7489B6AC129DD064CA81DD0B8B9ABD5A33691357B0AE768D50E4D
12345615201\3DDeliverables\AMG-ALGNBL98.xml		D8A843AA08EC77069804AD774D0EBA984F1BBB4713F66474589DF70745CF6B62
12345615201\3DDeliverables\AMG-3SURFACEPRO1.xml		56AECC56379686F8F0CB91C97B41739AAE76DB6B5D0C90F58486B32D0AB1B098
12345615201\3DDeliverables\AMG-3SURFACEEX01.xml		58793EFDD20A3452E7B521C101E5FACB081B57FADE42401E3AB58AE2ABEA121
12345615201\3DDeliverables\AMG-3SURFACEEW01.xml		15D9BCA09E81EA498C070705C2FAF7E34232B25ED9F380507FADE7712C0B929A
12345615201\3DDeliverables\AMG-3DSGNRDEW01.dwg	AMG file for 3D-Deliverables	7ADF218242F4EFA85BB7AEF36425C628AA5AF0BAA1B4E9CBC7A16691704B2EC9
12345615201\3DDeliverables\AMG-3DSGNRDEW01.dgn	AMG file for 3D-Deliverables	52C623395FFF3A8F3B96DAC21D9F8973A2112E9A8E94E03539A27A0D3044519
12345615201\3DDeliverables\AMG-3DSGNRD01.dwg	AMG file for 3D-Deliverables	7F25DF5C0D3F3799E3A457B93CD1AA97255E1B3C1C40361925A3B7294F140745
12345615201\3DDeliverables\AMG-3DSGNRD01.dgn	AMG file for 3D-Deliverables	9E41F7E20C9EA63B4FF41E9FD59085C18B79D7487E865BC2E9B00DE4663EF47B

https://emn178.github.io/online-tools/sha256_checksum.html

Exhibit 910-4
Signature Sheet ~~2026~~
Date: 1/1/2025

REVISIONS		ENGINEER OF RECORD		STATE OF FLORIDA DEPARTMENT OF TRANSPORTATION			SIGNATURE SHEET	SHEET NO.
DATE	DESCRIPTION	DATE	DESCRIPTION	ROAD NO.	COUNTY	FINANCIAL PROJECT ID		
				LUKE S. WALKER, P.E. LICENSE NUMBER: 99991-12345 ROADWAY ENGINEERS, INC. 123 MAIN STREET TALLAHASSEE, FL 32301	SR 22	BAY	123456-1-52-01	2