

### TYPICAL SECTION

SR 22

STA. 10+00.00 TO STA. 98+40.00  
SMOOTHNESS CLASS 3

### TRAFFIC DATA


CURRENT YEAR = 2018 AADT = 6800  
ESTIMATED OPENING YEAR = 2020 AADT = 7600  
ESTIMATED DESIGN YEAR = 2040 AADT = 12000  
K = 6% D = 55% T = 2% (24 HOUR)  
DESIGN HOUR T = 1%  
DESIGN SPEED = 55 MPH  
CONTEXT CLASSIFICATION = C2

### TRAVEL LANES

OPTIONAL BASE GROUP 8  
TYPE SP STRUCTURAL COURSE (TRAFFIC C) (2")  
FRICTION COURSE FC-12.5 (TRAFFIC C) (1 1/2") (PG 76-22)

### SHOULDER PAVEMENT

OPTIONAL BASE GROUP 1  
FRICTION COURSE FC-12.5 (TRAFFIC C) (1 1/2") (PG 76-22)

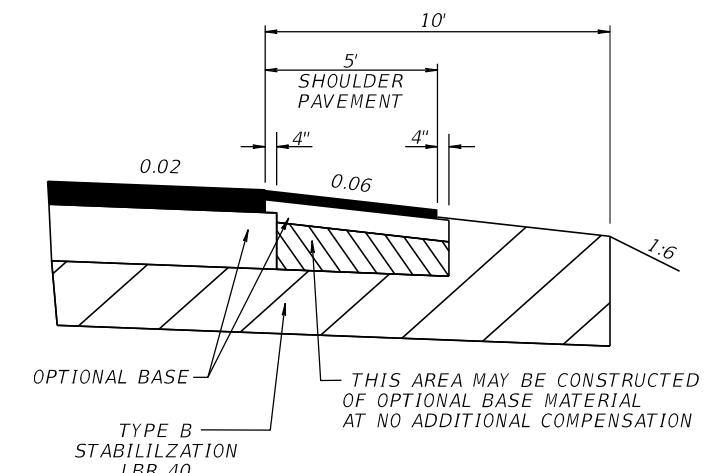

### SHOULDER PAVEMENT DETAIL

Exhibit 913-1  
2-Lane Flush Shoulder  
Date: 1/1/2025

REVISIONS				ENGINEER OF RECORD	STATE OF FLORIDA DEPARTMENT OF TRANSPORTATION			TYPICAL SECTION	SHEET NO. 4
DATE	DESCRIPTION	DATE	DESCRIPTION	LUKE S. WALKER, P.E. LICENSE NUMBER: 12345 ROADWAY ENGINEERS, INC. 123 MAIN ST TALLAHASSEE, FL 32301	ROAD NO.	COUNTY	FINANCIAL PROJECT ID		
					SR 22	LEON	123456-1-52-01		