


9/9/2024 1:44:05 PM K:\ASDMS C:\Worksets\FDOT\12345678901\Roadway\FDM_900_Exhibit_Master.dgn

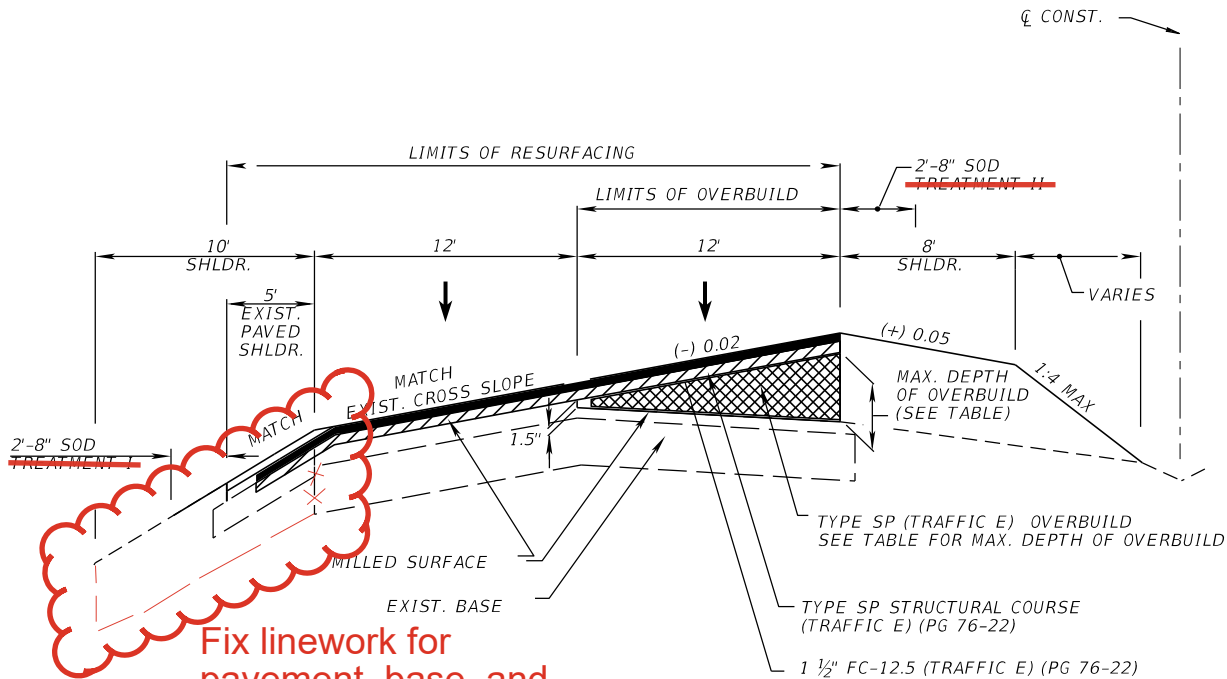

Fix linework for
pavement, base, and
stabilized subgrade

OVERBUILD
AND RESURFACING DETAIL
NTS
STA. 145+00.00 TO STA. 166+00.00

SR 22 WESTBOUND LANES

OVERBUILD DETAILS							
LOCATION		EXIST. SLOPE (%)	PROPOSED SLOPE (%)	MAX. DEPTH OF OVERBUILD (IN.)	WIDTH OF OVERBUILD (FT.)	AREA OF OVERBUILD (SQ. FT.)	AMOUNT OF OVERBUILD (TON)
STATION	LANE						
145+00	WESTBOUND INSIDE	(+) 1.6	EXISTING	1.5	12.0	1.5	---
146+00	WESTBOUND INSIDE	(+) 1.0	(-) 2.0	5.8	12.0	3.6	18.7
147+00	WESTBOUND INSIDE	(+) 1.6	(-) 2.0	6.7	12.0	4.1	28.2
148+00	WESTBOUND INSIDE	(+) 0.9	(-) 2.0	5.7	12.0	3.6	28.2
149+00	WESTBOUND INSIDE	(+) 0.4	(-) 2.0	4.9	12.0	3.2	24.9
150+00	WESTBOUND INSIDE	(+) 0.9	(-) 2.0	5.7	12.0	3.6	24.9
151+00	WESTBOUND INSIDE	(+) 0.4	(-) 2.0	4.9	12.0	3.2	24.9
152+00	WESTBOUND INSIDE	(+) 0.3	(-) 2.0	4.8	12.0	3.2	23.5
153+00	WESTBOUND INSIDE	(+) 0.0	(-) 2.0	4.4	12.0	3.0	22.7
154+00	WESTBOUND INSIDE	(+) 0.6	(-) 2.0	5.2	12.0	3.4	23.5
155+00	WESTBOUND INSIDE	(+) 1.2	(-) 2.0	6.1	12.0	3.8	26.4
156+00	WESTBOUND INSIDE	(+) 1.4	(-) 2.0	6.4	12.0	4.0	28.6
157+00	WESTBOUND INSIDE	(+) 0.8	(-) 2.0	5.5	12.0	3.5	27.5
158+00	WESTBOUND INSIDE	(+) 1.1	(-) 2.0	6.0	12.0	3.8	26.8
159+00	WESTBOUND INSIDE	(+) 1.0	(-) 2.0	5.8	12.0	3.6	27.1
160+00	WESTBOUND INSIDE	(+) 1.2	(-) 2.0	6.1	12.0	3.8	27.1
161+00	WESTBOUND INSIDE	(+) 2.2	(-) 2.0	7.5	12.0	4.5	30.4
162+00	WESTBOUND INSIDE	(+) 2.2	(-) 2.0	7.5	12.0	4.5	33.0
163+00	WESTBOUND INSIDE	(+) 1.2	(-) 2.0	6.1	12.0	3.8	30.4
164+00	WESTBOUND INSIDE	(+) 0.8	(-) 2.0	5.5	12.0	3.5	26.8
165+00	WESTBOUND INSIDE	(+) 0.6	(-) 2.0	5.2	12.0	3.4	25.3
166+00	WESTBOUND INSIDE	(+) 1.5	EXISTING	1.5	12.0	1.5	18.0
TOTAL OVERBUILD							546.9 TONS

Exhibit 913-13
Overbuild Details
Date: 1/1/~~2025~~2026

REVISIONS				ENGINEER OF RECORD			STATE OF FLORIDA DEPARTMENT OF TRANSPORTATION			SHEET NO.
DATE	DESCRIPTION	DATE	DESCRIPTION	LUKE S. WALKER, P.E. LICENSE NUMBER: 95331 12345 ROADWAY ENGINEERS, INC. 123 MAIN STREET TALLAHASSEE, FL 32301			ROAD NO.	COUNTY	FINANCIAL PROJECT ID	
							SR 22	BAY	123456-1-52-01	

TYPICAL SECTION

THE OFFICIAL RECORD OF THIS SHEET IS THE ELECTRONIC FILE DIGITALLY SIGNED AND SEALED UNDER RULE 61G15-23.004, F.A.C.