


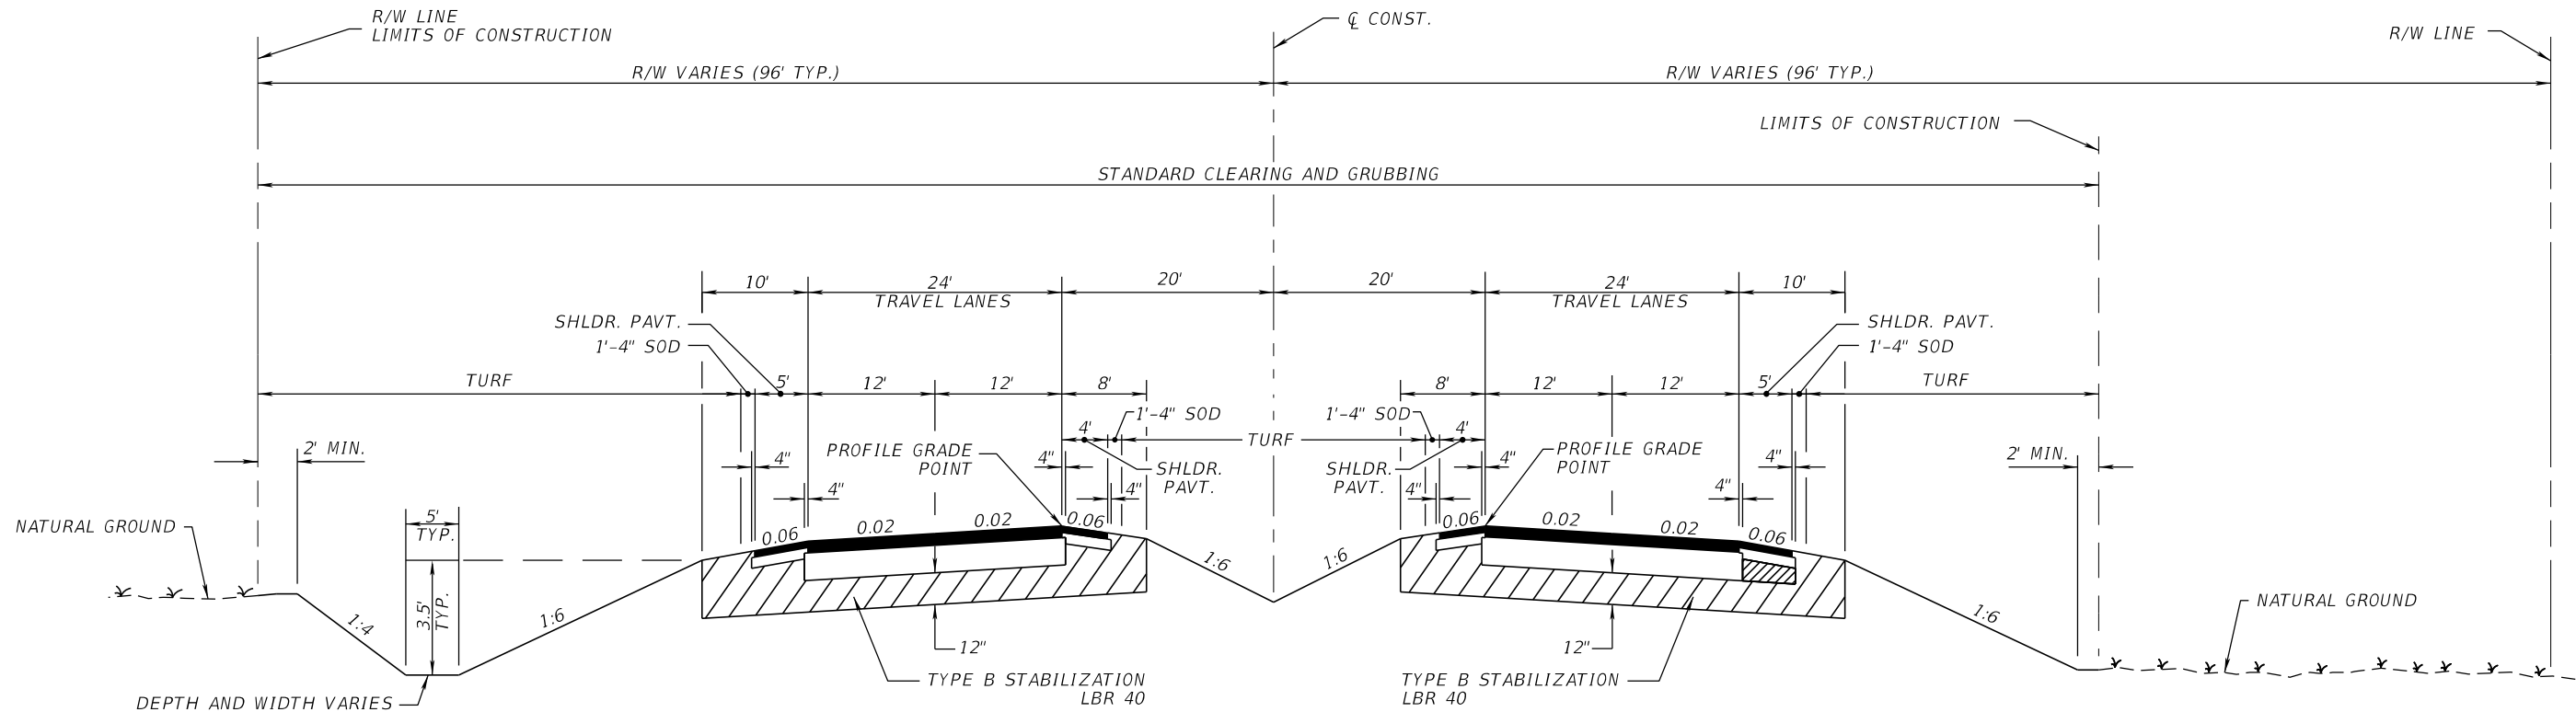

TRAFFIC DATA

CURRENT YEAR = 2018 AADT = 22300
 ESTIMATED OPENING YEAR = 2020 AADT = 23300
 ESTIMATED DESIGN YEAR = 2040 AADT = 51500
 K = 9% D = 56% T = 10% (24 HOUR)
 DESIGN HOUR T = 5%
 DESIGN SPEED = 55 MPH
 CONTEXT CLASSIFICATION = C1 STA. 63+65.42 TO STA. 108+35.00
 C2 STA. 108+35.00 TO STA. 328+65.14


TYPICAL SECTION SR 22 STA. 63+65.42 TO STA. 328+65.14 SMOOTHNESS CLASS 3

TRAVEL LANES


OPTIONAL BASE GROUP 9
 TYPE SP STRUCTURAL COURSE (TRAFFIC E) (2")
 TYPE SP STRUCTURAL COURSE (TRAFFIC E) (1 1/2") (PG 76-22)
 FRICTION COURSE ~~FC 12.5 (TRAFFIC E) (1 1/2") (PG 76-22)~~
FC-7 (3/4") (PG 76-22)

SHOULDER PAVEMENT

OPTIONAL BASE GROUP 1
 TYPE SP STRUCTURAL COURSE (TRAFFIC E) (1 1/2") (PG 76-22)
 FRICTION COURSE ~~FC 12.5 (TRAFFIC E) (1 1/2") (PG 76-22)~~
FC-7 (3/4") (PG 76-22)

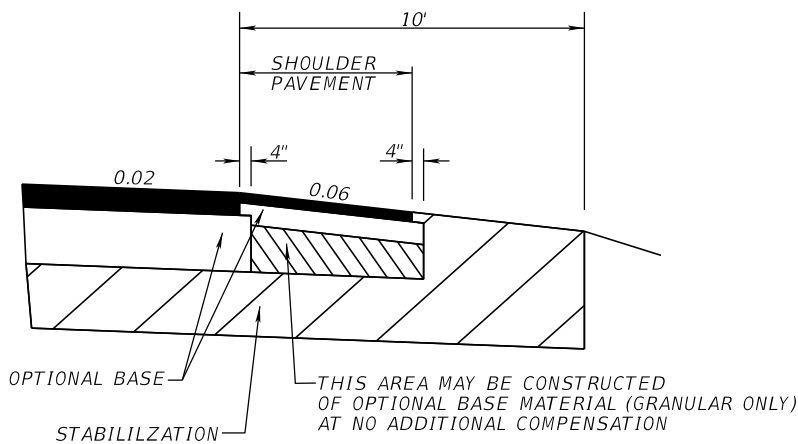

SHOULDER PAVEMENT DETAIL

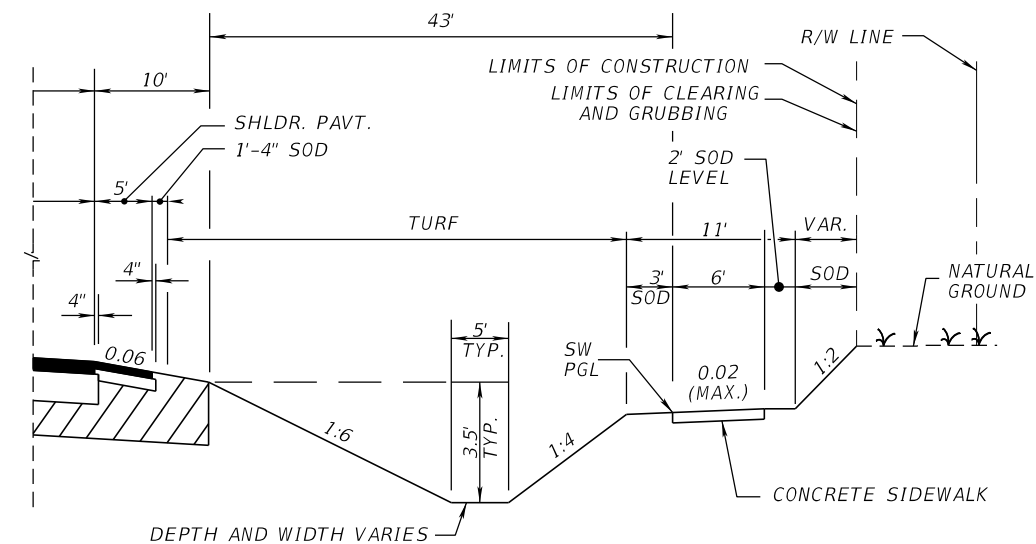

TYPICAL SECTION DETAIL STA. 157+75.40 TO STA. 215+45.22

Exhibit 913-2
 4-Lane Flush Shoulder
 Date: 1/1/~~2025~~ 2026

REVISIONS				ENGINEER OF RECORD		STATE OF FLORIDA DEPARTMENT OF TRANSPORTATION			SHEET NO.
DATE	DESCRIPTION	DATE	DESCRIPTION	LUKE S. WALKER, P.E. LICENSE NUMBER: 0000 12345 ROADWAY ENGINEERS, INC. 123 MAIN STREET TALLAHASSEE, FL 32301		ROAD NO.	COUNTY	FINANCIAL PROJECT ID	
						SR 22	BAY	123456-1-52-01	5

TYPICAL SECTION