

**TYPICAL SECTION  
RAMP "C"  
STA. 623+28.64 TO STA. 629+13.78**

**TRAFFIC DATA**


CURRENT YEAR = 2018 AADT = 8,000  
 ESTIMATED OPENING YEAR = 2020 AADT = 8,800  
 ESTIMATED DESIGN YEAR = 2040 AADT = 12,000  
 K = 10% D = 100% T = 8% (24 HOUR)  
 DESIGN SPEED = 30 MPH  
 CONTEXT CLASSIFICATION = N/A

**TRAVEL LANES**

OPTIONAL BASE GROUP 9  
 TYPE SP STRUCTURAL COURSE (TRAFFIC B) (1 1/2")  
 FRICTION COURSE FC-12.5 (TRAFFIC B) (1 1/2") (PG 76-22)

**SHOULDER PAVEMENT**

OPTIONAL BASE GROUP 1  
 FRICTION COURSE FC-12.5 (TRAFFIC B) (1 1/2") (PG 76-22)

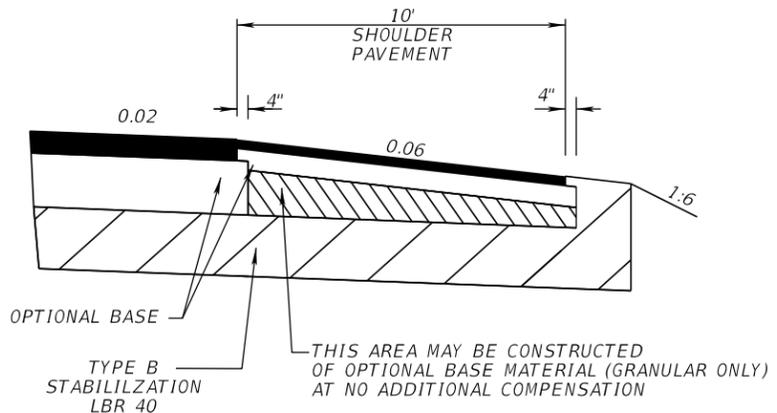

**SHOULDER PAVEMENT DETAIL**

**Exhibit 913-8  
Ramp  
Date: 1/1/2023 ~~2023~~ 2026**

9/14/2022 3:17:37 PM ps972bw C:\Worksets\FDOT\12345615201\Roadway\TYPSRD01.dgn

REVISIONS				ENGINEER OF RECORD		STATE OF FLORIDA DEPARTMENT OF TRANSPORTATION			SHEET NO.
DATE	DESCRIPTION	DATE	DESCRIPTION	LUKE S. WALKER, P.E. LICENSE NUMBER: <del>0000</del> 12345		ROAD NO.	COUNTY	FINANCIAL PROJECT ID	
				ROADWAY ENGINEERS, INC. 123 MAIN STREET TALLAHASSEE, FL 32301		SR 93	BAY	123456-1-52-01	
<b>TYPICAL SECTION</b>									

THE OFFICIAL RECORD OF THIS SHEET IS THE ELECTRONIC FILE DIGITALLY SIGNED AND SEALED UNDER RULE 61G15-23.004, F.A.C.