


TYPICAL SECTION
 SR 22 (WILLOW BEND WAY)
 STA. 122+00.000 TO STA. 210+65.000

SHARED USE PATH
 OPTIONAL BASE GROUP 1
 TYPE SP STRUCTURAL COURSE (TRAFFIC B) (1 1/2")

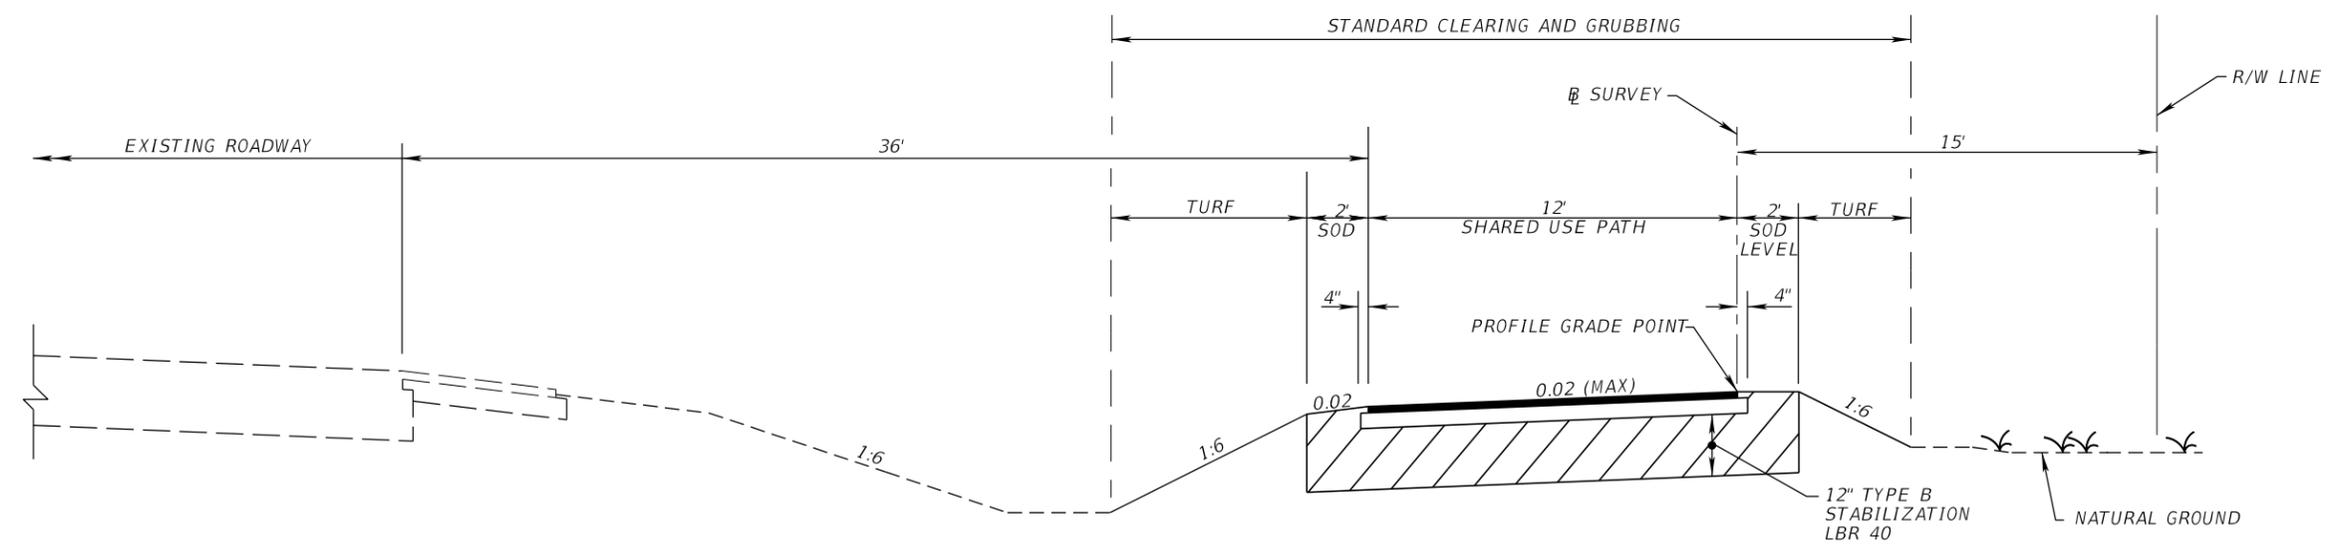

TYPICAL SECTION
 SR 22 (WILLOW BEND WAY)
 STA. 210+65.000 TO STA. 305+15.000

SHARED USE PATH
 OPTIONAL BASE GROUP 1
 TYPE SP STRUCTURAL COURSE (TRAFFIC B) (1 1/2")

Exhibit 913-9
 Shared Use Path
 Date: 1/1/~~2023~~ 2026

10/26/2022 4:53:34 PM PS972BW C:\worksets\FDOT\12345615201\Roadway\TYPSRD01.dgn

REVISIONS				ENGINEER OF RECORD		STATE OF FLORIDA DEPARTMENT OF TRANSPORTATION			SHEET NO.
DATE	DESCRIPTION	DATE	DESCRIPTION	LUKE S. WALKER, P.E. LICENSE NUMBER: 9999 12345		ROAD NO.	COUNTY	FINANCIAL PROJECT ID	
				ROADWAY ENGINEERS, INC. 123 MAIN STREET TALLAHASSEE, FL 32301		SR 22	BAY	123456-1-52-01	
TYPICAL SECTION									

THE OFFICIAL RECORD OF THIS SHEET IS THE ELECTRONIC FILE DIGITALLY SIGNED AND SEALED UNDER RULE 61G15-23.004, F.A.C.