

STATE OF FLORIDA
DEPARTMENT OF TRANSPORTATION

TYPICAL SECTION PACKAGE

FINANCIAL PROJECT ID 123456-1-52-01
(FEDERAL FUNDS)

BAY COUNTY (46080)

STATE ROAD NO. 22 (WEWA HWY)

ADD LANES AND RECONSTRUCT FROM CRIM BLVD. TO KURT ST.

FDOT DISTRICT DESIGN ENGINEER

Lan B. Solo
2017.10.11 08:12:33 - 4'00'

CONCURRING WITH:
TYPICAL SECTION ELEMENTS
TARGET SPEED
DESIGN & POSTED SPEEDS

FDOT DISTRICT TRAFFIC OPERATIONS ENGINEER

Garth Paul
2017.10.10 14:10:15 - 4'00'

CONCURRING WITH:
TARGET SPEED
DESIGN & POSTED SPEEDS

FDOT DISTRICT INTERMODAL SYSTEMS DEVELOPMENT MANAGER

Rey-Rey Olay
2017.10.10 12:01:30 - 4'00'

CONCURRING WITH:
CONTEXT CLASSIFICATION
TARGET SPEED

FDOT DISTRICT STRUCTURES DESIGN ENGINEER

J.T. Hutt
2017.10.10 15:11:45 - 4'00'

CONCURRING WITH:
BRIDGE TYPICAL SECTION ELEMENTS
TARGET SPEED

FHWA TRANSPORTATION ENGINEER

CONCURRING WITH:
TYPICAL SECTION ELEMENTS

LOCAL TRANSPORTATION ENGINEER


CONCURRING WITH:
TYPICAL SECTION ELEMENTS

NOT USED

NOT USED

CONCURRING WITH:

CONCURRING WITH:

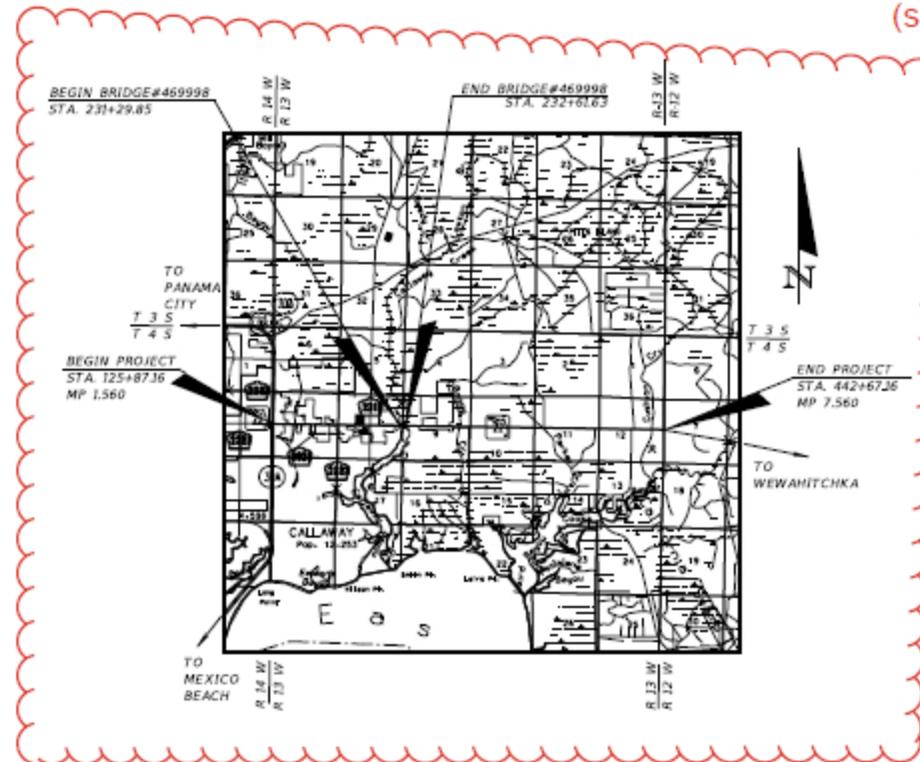


Please replace this map with the Project Location Map from 2021 FDM Exhibit 120-1 (which was dated 1/1/19).

And please enlarge the Project Location Map as much as possible while still fitting between the signatures on the left and the seal and index of sheets on the right.



APPROVED BY:

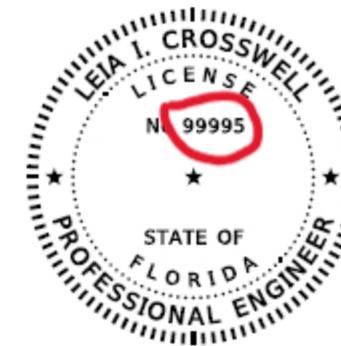

THIS ITEM HAS BEEN DIGITALLY SIGNED AND SEALED BY

Lela I. Crosswell
2017.10.09 16:40:48 - 4'00'

ON THE DATE ADJACENT TO THE SEAL

SIGNATURE MUST BE VERIFIED ON ANY ELECTRONIC COPIES.

ROADWAY ENGINEERS, INC.
123 MAIN STREET
TALLAHASSEE, FL 32301
LEIA I. CROSSWELL, P.E. N. 99995

THE ABOVE NAMED PROFESSIONAL ENGINEER SHALL BE RESPONSIBLE FOR THE FOLLOWING SHEETS IN ACCORDANCE WITH RULE 61G15-23.004, F.A.C.

INDEX OF SHEETS

SHEET NO	SHEET DESCRIPTION
1	COVER SHEET
2	TYPICAL SECTION NO. 1
3	TYPICAL SECTION NO. 2
4	TYPICAL SECTION NO. 3
5	TYPICAL SECTION NO. 4

Exhibit 120-1
Date: 1/1/26

INDEX OF RFP CONCEPT PLANS

SHEET NO.	SHEET DESCRIPTION
1	KEY SHEET
2	TYPICAL SECTION DETAILS
3	MODEL MANAGEMENT
4 - 5	PROJECT CONTROL
6	ROADWAY PLAN-PROFILE
7 - 9	STORMWATER FACILITIES
10	DRAINAGE MAP
11	SOIL SURVEY
12 - 14	REPORT OF CORE BORINGS
15 - 16	SELECTIVE CLEARING AND GRUBBING
17	MITIGATION PLAN
18	TRAFFIC PLAN (S&PM, SIGNALIZATION, ITS, LIGHTING)
19 - 26	LANDSCAPING PLAN
27 - 32	ARCHITECTURAL PLAN
33 - 36	STRUCTURES PLAN
37 - 40	UTILITY WORK BY HIGHWAY CONTRACTOR

**STATE OF FLORIDA
DEPARTMENT OF TRANSPORTATION**

RFP CONCEPT PLANS


FINANCIAL PROJECT ID 123456-1-52-01

(FEDERAL FUNDS)

BAY COUNTY (46080)

STATE ROAD NO. 22 (WEWA HWY)

ADD LANES AND RECONSTRUCT FROM CRIM BLVD. TO KURT ST.

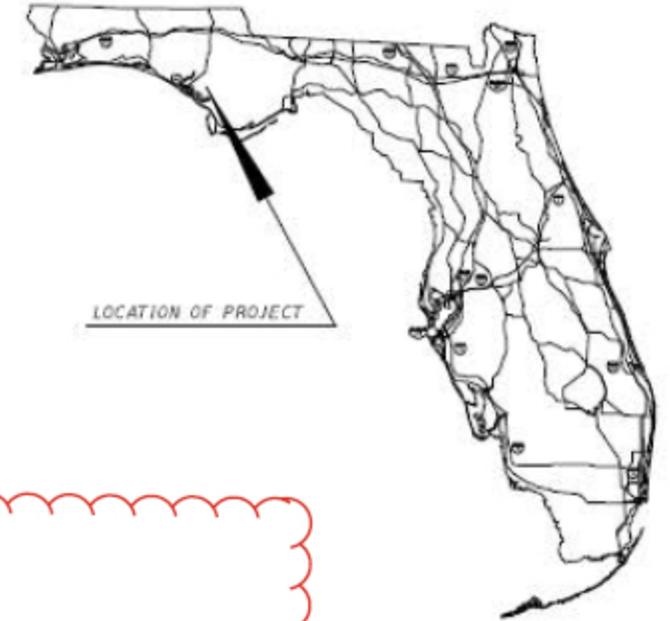

PROJECT LOCATION URL:	https://tinyurl.com/367v2589
PROJECT LIMITS:	BEGIN MP 1.560 - END MP 7.560
EXCEPTIONS:	NONE
BRIDGE LIMITS:	BR# 40098 MP 3.422 - MP 3.471
RAILROAD CROSSING:	NONE

Replace this URL Box with a Project Location Map (use the Project Location Map from 2022 FDM Exhibit 302-1)

Exhibit 907-1
RFP Concept Plans
Date: ~~1/30/2023~~

1/1/26

**RFP CONCEPT PLANS
DEVELOPED BY:**

LUKE S. WALKER, P.E.
P.E. LICENSE NUMBER 99991
ROADWAY ENGINEERS, INC.
123 MAIN STREET
TALLAHASSEE, FL 32301
CONTRACT NO.: C0000
VENDOR NO.: 99-999999

FDOT PROJECT MANAGER:

BEN K. UWAIBI, P.E.

FISCAL YEAR	SHEET NO.
23	1


3/13/2023 12:04:11 PM P:\587288 C:\Users\jv\Documents\123456\123456\123456\123456.dgn

CONTRACT PLANS COMPONENTS

- ROADWAY
- SIGNING AND PAVEMENT MARKING
- SIGNALIZATION
- INTELLIGENT TRANSPORTATION SYSTEMS
- LIGHTING
- LANDSCAPE
- ARCHITECTURAL
- STRUCTURES
- TOLL FACILITIES
- UTILITY WORK BY HIGHWAY CONTRACTOR PLANS

STATE OF FLORIDA
DEPARTMENT OF TRANSPORTATION
ROADWAY PLANS

FINANCIAL PROJECT ID 123456-1-52-01
(FEDERAL FUNDS)
BAY COUNTY (46080)
STATE ROAD NO. 22 (WEWA HWY)

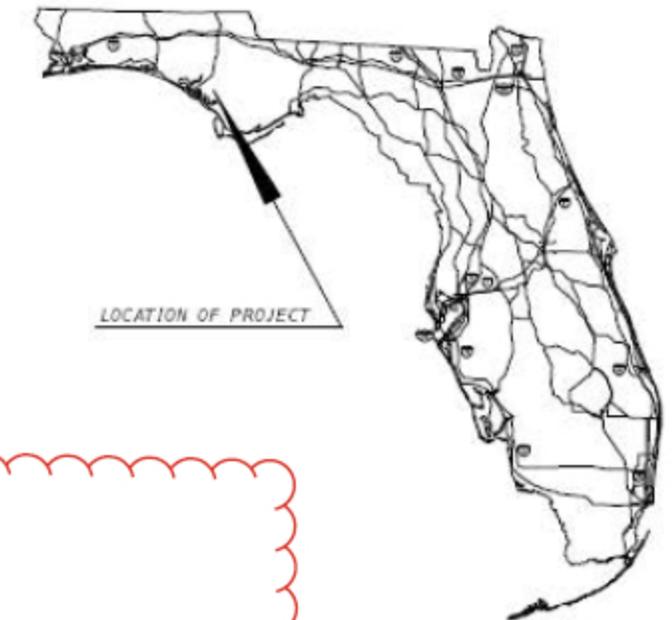

INDEX OF ROADWAY PLANS

SHEET NO.	SHEET DESCRIPTION
1	KEY SHEET
2	SIGNATURE SHEET
3	DRAINAGE MAP
4 - 5	TYPICAL SECTIONS
6	TYPICAL SECTION DETAILS
7 - 9	MODEL MANAGEMENT
10	PROJECT CONTROL
11	GENERAL NOTES
12 - 14	ROADWAY PLAN-PROFILE
15 - 16	TRAFFIC MONITORING SITE
17	SPECIAL DETAILS
18 - 19	DRAINAGE NETWORK PLAN
20 - 21	DRAINAGE NETWORK PROFILE
22	DRAINAGE NETWORK CROSS SECTIONS
23	OPTIONAL MATERIALS TABULATION
24	DRAINAGE SPECIAL DETAILS
25 - 34	ROADWAY CROSS SECTIONS
35 - 38	VERIFIED UTILITY LOCATE
39 - 46	TEMPORARY TRAFFIC CONTROL PLAN
47 - 52	UTILITY ADJUSTMENTS
53 - 56	SELECTIVE CLEARING AND GRUBBING
57	MISCELLANEOUS STRUCTURES
GR-1*	SOIL SURVEY
GR-2*	REPORT OF CORE BORINGS

ADD LANES AND RECONSTRUCT FROM CRIM BLVD. TO KURT ST.

X

PROJECT LOCATION URL:	https://tinyurl.com/367v2589
PROJECT LIMITS:	BEGIN MP 1.560 - END MP 7.560
EXCEPTIONS:	NONE
BRIDGE LIMITS:	BR#46508 MP 3.422 - MP 3.471
RAILROAD CROSSING:	NONE

Replace this URL Box
with a Project Location Map
(use the Project Location Map
from 2022 FDM Exhibit 302-1)

* These sheets are included in the Index of Roadway Plans only to indicate that they are part of the Roadway Plans. These sheets are contained in a separate digitally signed and sealed document.

DEVELOPMENTAL STANDARD PLANS (DSPs):
D591-001 LANDSCAPE IRRIGATION SLEEVES

GOVERNING STANDARD PLANS:

Florida Department of Transportation, FY2023-24 Standard Plans for Road and Bridge Construction and applicable Interim Revisions (IRs).

Standard Plans for Road Construction and associated IRs are available at the following website: <http://www.fl.dot.gov/design/standardplans>

APPLICABLE IRs: IR536-001-01, IR521-001-01

Standard Plans for Bridge Construction are included in the Structures Plans Component

GOVERNING STANDARD SPECIFICATIONS:

Florida Department of Transportation, FY 2023-24 Standard Specifications for Road and Bridge Construction at the following website: <http://www.fl.dot.gov/programmanagement/Implemented/SpecBooks>

Exhibit 910-1
Lead Key Sheet
Date: 1/1/~~2025~~
2026

**ROADWAY PLANS
ENGINEER OF RECORD:**

LUKE S. WALKER, P.E.
P.E. LICENSE NUMBER 99991
ROADWAY ENGINEERS, INC.
123 MAIN STREET
TALLAHASSEE, FL 32301
(850) 671-1313
CONTRACT NO.: C0000
VENDOR NO.: 99-999999

FDOT PROJECT MANAGER:

BEN K. UWAIBI, P.E.


CONSTRUCTION CONTRACT NO.	FISCAL YEAR	SHEET NO.
T0000	22	1

CONTRACT PLANS COMPONENTS

- ROADWAY
- SIGNING AND PAVEMENT MARKING
- SIGNALIZATION
- INTELLIGENT TRANSPORTATION SYSTEMS
- LIGHTING
- LANDSCAPE
- ARCHITECTURAL
- STRUCTURES
- TOLL FACILITIES
- UTILITY WORK BY HIGHWAY CONTRACTOR PLANS

STATE OF FLORIDA
DEPARTMENT OF TRANSPORTATION
ROADWAY PLANS

FINANCIAL PROJECT ID 123456-1-52-01
(FEDERAL FUNDS)
BAY COUNTY (46080)
STATE ROAD NO. 22 (WEWA HWY)

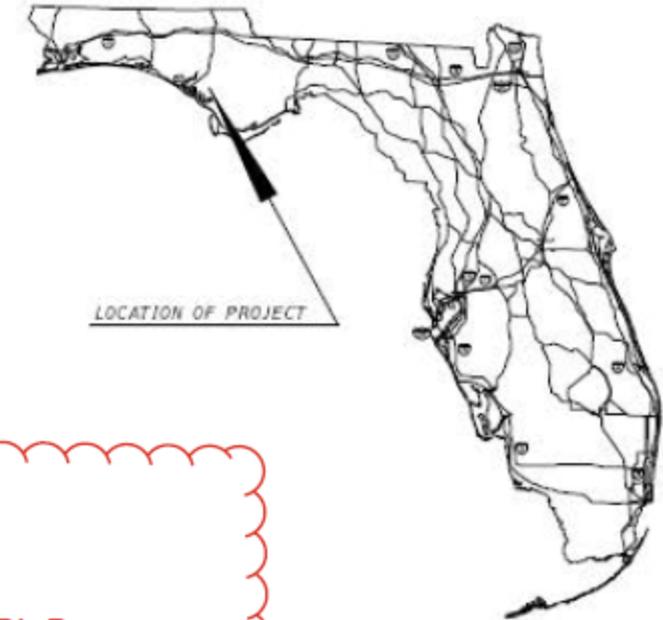

LOCATION OF PROJECT

INDEX OF ROADWAY PLANS

SHEET NO.	SHEET DESCRIPTION
1	KEY SHEET
2 - 2A	SIGNATURE SHEET
3	DRAINAGE MAP
4 - 5	TYPICAL SECTIONS
6	TYPICAL SECTION DETAILS
7 - 9	MODEL MANAGEMENT
10	PROJECT CONTROL
11	GENERAL NOTES
12 - 14	ROADWAY PLAN-PROFILE
15 - 16	TRAFFIC MONITORING SITE
17	SPECIAL DETAILS
18 - 19	DRAINAGE NETWORK PLAN
20 - 21	DRAINAGE NETWORK PROFILE
22	DRAINAGE NETWORK CROSS SECTIONS
23	OPTIONAL MATERIALS TABULATION
24	DRAINAGE SPECIAL DETAILS
25 - 34	ROADWAY CROSS SECTIONS
35 - 38	VERIFIED UTILITY LOCATE
39 - 46	TEMPORARY TRAFFIC CONTROL PLAN
47 - 52	UTILITY ADJUSTMENTS
53 - 56	SELECTIVE CLEARING AND GRUBBING
57	MISCELLANEOUS STRUCTURES
GR-1*	SOIL SURVEY
GR-2*	REPORT OF CORE BORINGS

ADD LANES AND RECONSTRUCT FROM CRIM BLVD. TO KURT ST.

~~PROJECT LOCATION URL: <https://tinyurl.com/367v2589>~~

~~PROJECT LIMITS: BEGIN MP 1.560 - END MP 7.560~~

~~EXCEPTIONS: NONE~~

~~BRIDGE LIMITS: BR#469008 MP 3.422 - MP 3.471~~

~~RAILROAD CROSSING: NONE~~

Replace this URL Box with a Project Location Map (use the Project Location Map from 2022 FDM Exhibit 302-1)

Exhibit 910-2
Revised Lead Key Sheet
Date: 1/1/~~2025~~
2026

* These sheets are included in the Index of Roadway Plans only to indicate that they are part of the Roadway Plans. These sheets are contained in a separate digitally signed and sealed document.

DEVELOPMENTAL STANDARD PLANS (DSPs):
D591-001 LANDSCAPE IRRIGATION SLEEVES

GOVERNING STANDARD PLANS:
Florida Department of Transportation, FY2023-24 Standard Plans for Road and Bridge Construction and applicable Interim Revisions (IRs).

Standard Plans for Road Construction and associated IRs are available at the following website: <http://www.fdot.gov/design/standardplans>

APPLICABLE IRs: IR536-001-01, IR521-001-01

Standard Plans for Bridge Construction are included in the Structures Plans Component

GOVERNING STANDARD SPECIFICATIONS:
Florida Department of Transportation, FY 2023-24 Standard Specifications for Road and Bridge Construction at the following website: <http://www.fdot.gov/programmanagement/Implemented/SpecBooks>

REVISIONS:
FINANCIAL PROJECT ID 123456-1-52-01
Roadway Sheets 1, 2A, 5, & 19 (Revised 04-20-22)

KEY SHEET REVISIONS	
DATE	DESCRIPTION
04-20-22	Added Sheet Number 2A to the Index and Revised Sheet Numbers 5 & 19.

**ROADWAY PLANS
ENGINEER OF RECORD:**

LUKE S. WALKER, P.E.
P.E. LICENSE NUMBER 99991
ROADWAY ENGINEERS, INC.
123 MAIN STREET
TALLAHASSEE, FL 32301
(850) 671-1313
CONTRACT NO.: C0000
VENDOR NO.: 99-999999

FDOT PROJECT MANAGER:

BEN K. UWAIBI, P.E.

CONSTRUCTION CONTRACT NO.	FISCAL YEAR	SHEET NO.
T0000	22	1

CONTRACT PLANS COMPONENTS


- ROADWAY
- SIGNING AND PAVEMENT MARKING
- SIGNALIZATION
- INTELLIGENT TRANSPORTATION SYSTEMS
- LIGHTING
- LANDSCAPE
- ARCHITECTURAL
- STRUCTURES
- TOLL FACILITIES
- UTILITY WORK BY HIGHWAY CONTRACTOR PLANS

INDEX OF SIGNING AND PAVEMENT MARKING PLANS

SHEET NO.	SHEET DESCRIPTION
1	KEY SHEET
2	SIGNATURE SHEET
3	GENERAL NOTES
4 - 7	S&PM PLAN
8	GUIDE SIGN WORKSHEET
9	OVERHEAD SIGN CROSS SECTION
10	SIGN STRUCTURES DATA TABLE
11	FOUNDATION DETAILS
12	BRIDGE MOUNTED SIGN DETAILS
13	REPORT OF CORE BORINGS

STATE OF FLORIDA
 DEPARTMENT OF TRANSPORTATION
SIGNING AND PAVEMENT MARKING PLANS

FINANCIAL PROJECT ID 123456-1-52-01
 (FEDERAL FUNDS)
 BAY COUNTY (46080)
 STATE ROAD NO. 22 (WEWA HWY)

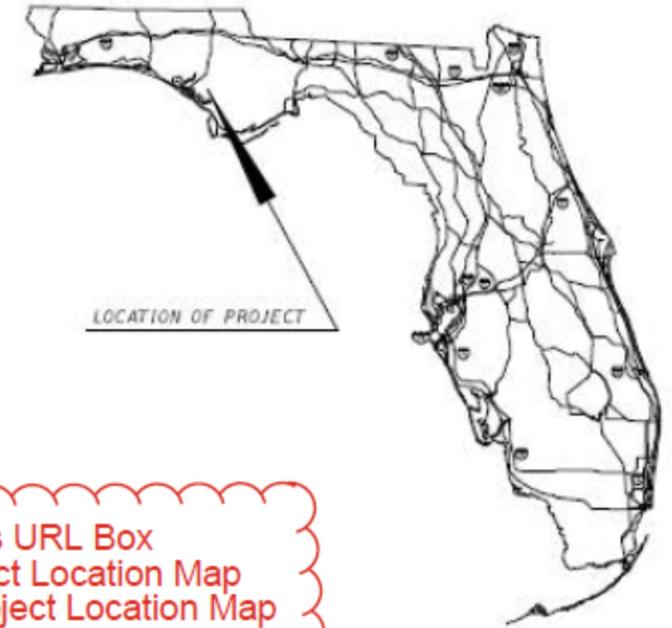

ADD LANES AND RECONSTRUCT FROM CRIM BLVD. TO KURT ST.

~~PROJECT LOCATION URL: <https://tinyurl.com/367v2589>~~


~~PROJECT LIMITS: BEGIN MP 1.560 - END MP 7.560~~

~~EXCEPTIONS: NONE~~

~~BRIDGE LIMITS: BR#30,098 MP 3.422 - MP 3.471~~

~~RAILROAD CROSSING: NONE~~

Replace this URL Box with a Project Location Map (use the Project Location Map from 2022 FDM Exhibit 302-1)

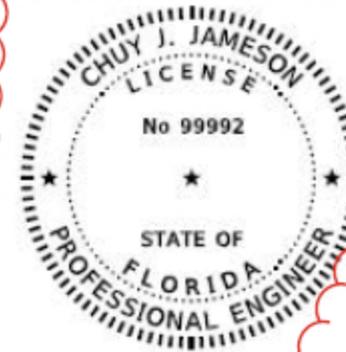

THIS ITEM HAS BEEN DIGITALLY SIGNED AND SEALED BY

Chuy J. Jameson
2022.07.13 11:02:26 - 04'00'

ON THE DATE ADJACENT TO THE SEAL
 PRINTED COPIES OF THIS DOCUMENT ARE NOT CONSIDERED SIGNED AND SEALED AND THE SIGNATURE MUST BE VERIFIED ON ANY ELECTRONIC COPIES.

SIGNING AND PAVEMENT MARKING PLANS ENGINEER OF RECORD:

CHUY J. JAMESON, P.E.
 P.E. LICENSE NUMBER 99992
 ROADWAY ENGINEERS, INC.
 123 MAIN STREET
 TALLAHASSEE, FL 32301
 (850) 671-1313
 CONTRACT NO.: C0001
 VENDOR NO.: 99-999999

FDOT PROJECT MANAGER:

BEN K. UWAIBI, P.E.



This note has already been revised by Errata in June 2025

GOVERNING STANDARD PLANS:

Florida Department of Transportation, FY2023-24 Standard Plans for Road and Bridge Construction and applicable Interim Revisions (IRs).

Standard Plans for Road Construction and associated IRs are available at the following website: <http://www.fdot.gov/design/standardplans>

APPLICABLE IRs: IR536-001-01, IR521-001-01

Standard Plans for Bridge Construction are included in the Structures Plans Component

GOVERNING STANDARD SPECIFICATIONS:

Florida Department of Transportation, FY 2023-24 Standard Specifications for Road and Bridge Construction at the following website: <http://www.fdot.gov/programmanagement/Implemented/SpecBooks>

CONSTRUCTION CONTRACT NO.	FISCAL YEAR	SHEET NO.
T0000	22	1