


Please note that:

On this sheet - we say 18" PIPE,
But on the sections - we say 18 IN PIPE
Do we want to be consistent?

Also, do we need to call-out the structure bottoms as Type P?

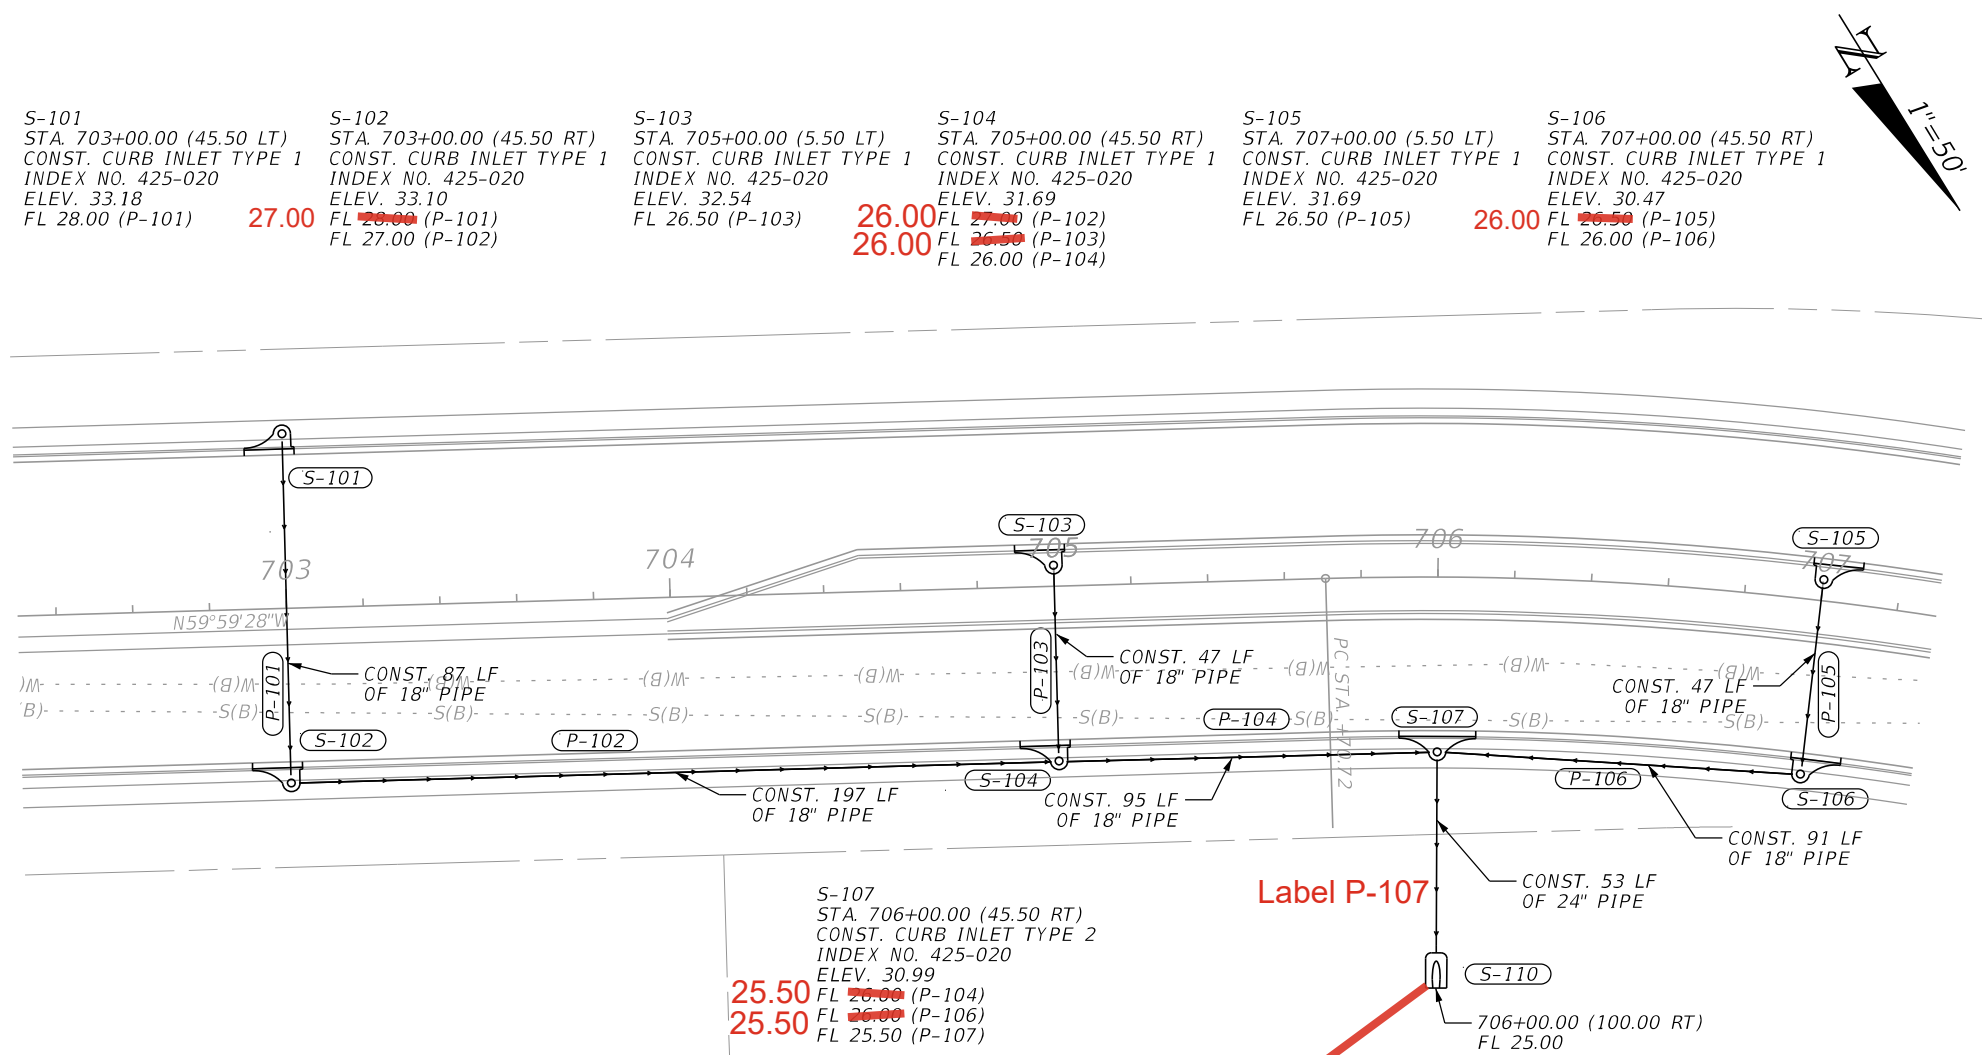

Where do we call-out
the type of MES for S-110?

Exhibit 916-1
Drainage Network Plan
Date: 1/1/2025

2026

REVISIONS				ENGINEER OF RECORD		STATE OF FLORIDA DEPARTMENT OF TRANSPORTATION			DRAINAGE NETWORK 1 PLAN	SHEET NO. 1
DATE	DESCRIPTION	DATE	DESCRIPTION	LUKE S. WALKER, P.E. LICENSE NUMBER: 12345 ROADWAY ENGINEERS, INC. 123 MAIN STREET TALLAHASSEE, FL 32301		ROAD NO.	COUNTY	FINANCIAL PROJECT ID		
						SR 22	BAY	123456-1-52-01		





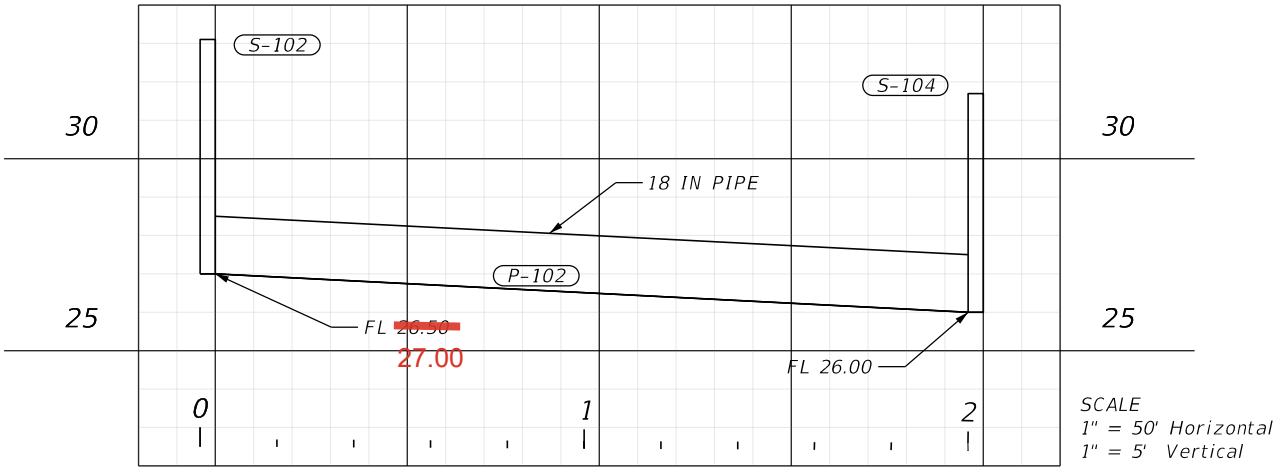


Exhibit 916-2
Drainage Network Profile
Date: 1/1/~~2025~~
2026

REVISIONS				ENGINEER OF RECORD			STATE OF FLORIDA DEPARTMENT OF TRANSPORTATION			DRAINAGE NETWORK 1 PROFILE		SHEET NO.	
DATE	DESCRIPTION	DATE	DESCRIPTION	LUKE S. WALKER, P.E. LICENSE NUMBER: 99991 12345 ROADWAY ENGINEERS, INC. 123 MAIN STREET TALLAHASSEE, FL 32301			ROAD NO.	COUNTY	FINANCIAL PROJECT ID			2	
							SR 22	BAY	123456-1-52-01				

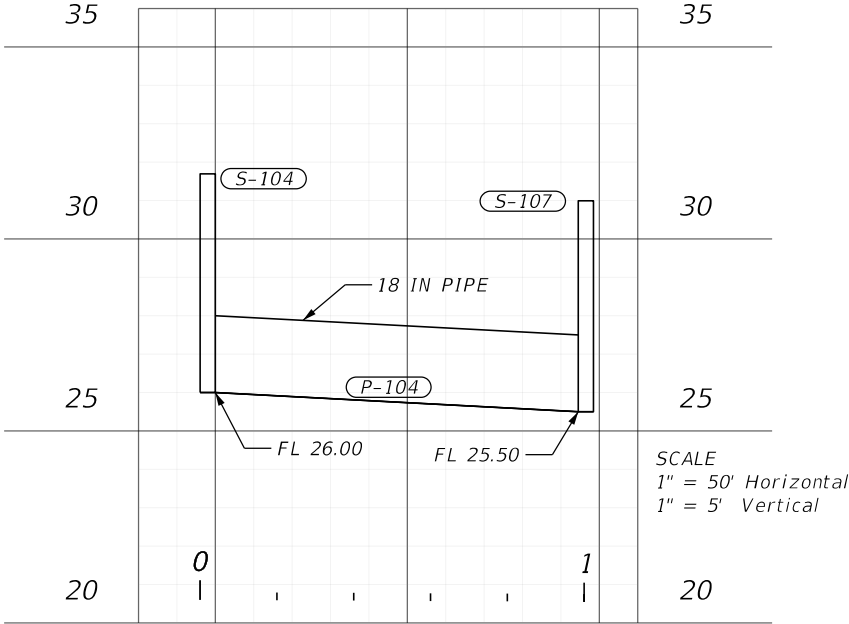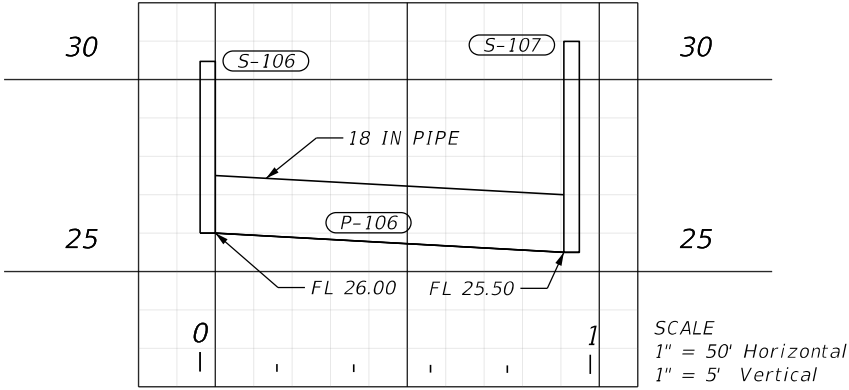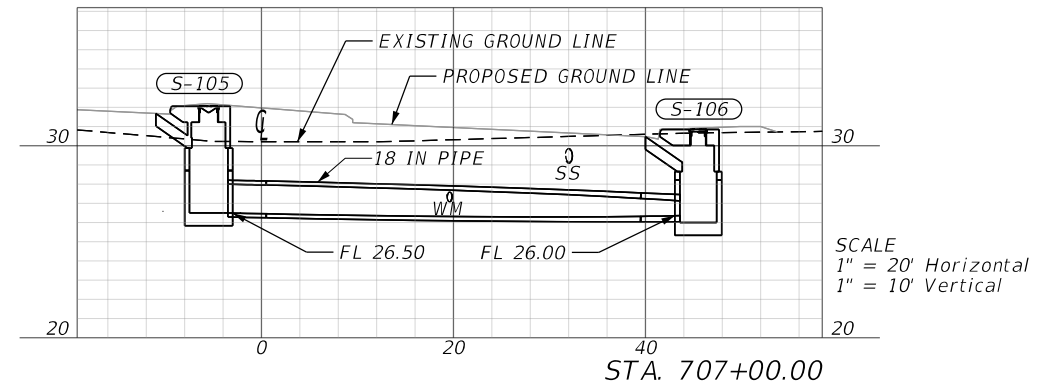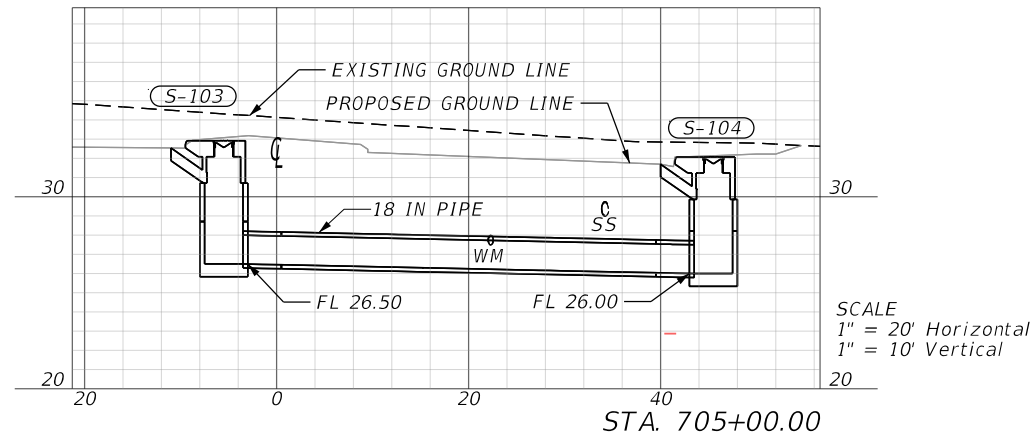

Should we label the pipe numbers on this sheet?

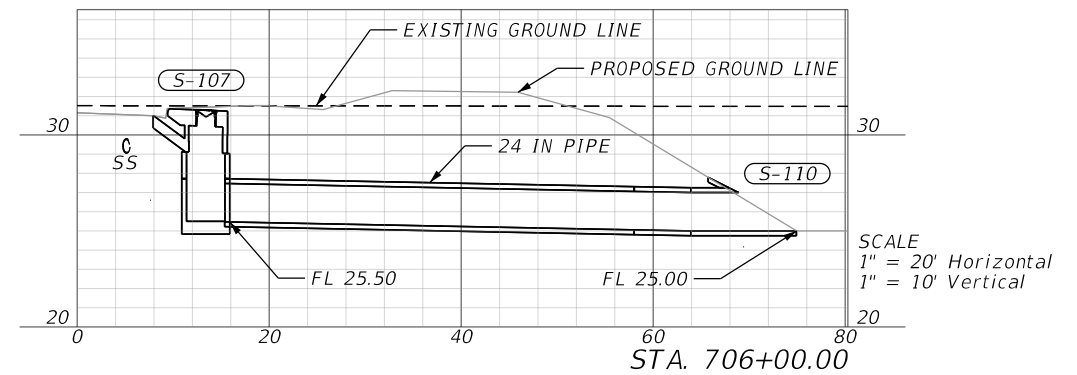
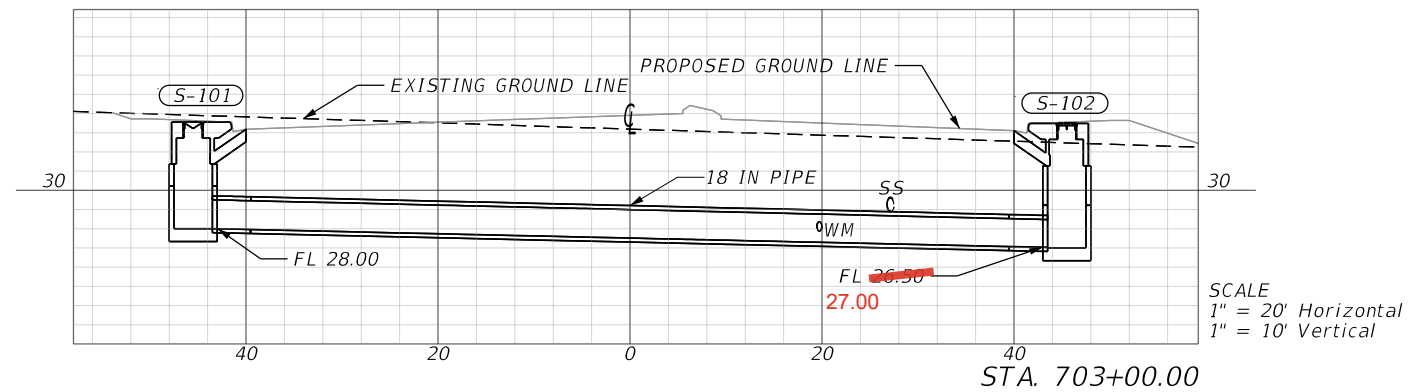


Exhibit 916-3
Drainage Network Cross Sections
Date: 1/1/2025 ~~2025~~ 2026

REVISIONS				ENGINEER OF RECORD	STATE OF FLORIDA DEPARTMENT OF TRANSPORTATION			DRAINAGE NETWORK 1		SHEET NO.		
DATE	DESCRIPTION		DATE	DESCRIPTION	LUKE S. WALKER, P.E. LICENSE NUMBER: 00001 12345 ROADWAY ENGINEERS, INC. 123 MAIN STREET TALLAHASSEE, FL 32301			ROAD NO.	COUNTY	FINANCIAL PROJECT ID	CROSS SECTIONS	3
								SR 22	BAY	123456-1-52-01		

Optional Materials Tabulation					
Group Number	Size(s)	Material	Plotted	As-Built	Remarks
Group 1	18-24	RCP Class II	X		
		SRAP, 16 GA.			
		SRSP, 14 GA.			
Group 2	30	RCP Class IV	X		
		SRAP, 14 GA.			
Group 3	18	RCP Class I	X		
		HDPE Class II			
		PVC ASTM F-949			
		PP			
Group 4	14x23	ERCP, Class II	X		

Pipe Data			
Label	Barrels	Size	Optional Pipe
P-101	1	18	Group 1
P-102	1	18	Group 1
P-103	1	18	Group 3
P-104	1	18	Group 1
P-105	1	18	Group 3
P-106	1	18	Group 3
P-107	1	24	Group 1
P-201	1	14x23	Group 4
P-207	1	30	Group 2

Exhibit 916-4
Optional Materials Tabulation
Date: 1/1/~~2025~~ 2026

REVISIONS				ENGINEER OF RECORD	STATE OF FLORIDA DEPARTMENT OF TRANSPORTATION			OPTIONAL MATERIALS TABULATION	SHEET NO.
DATE	DESCRIPTION	DATE	DESCRIPTION	LUKE S. WALKER, P.E. LICENSE NUMBER: 99997 12345 ROADWAY ENGINEERS, INC. 123 MAIN STREET TALLAHASSEE, FL 32301	ROAD NO.	COUNTY	FINANCIAL PROJECT ID		4
					SR 22	BAY	123456-1-52-01		