


Figure 212.12.5 Mountable Truck Apron

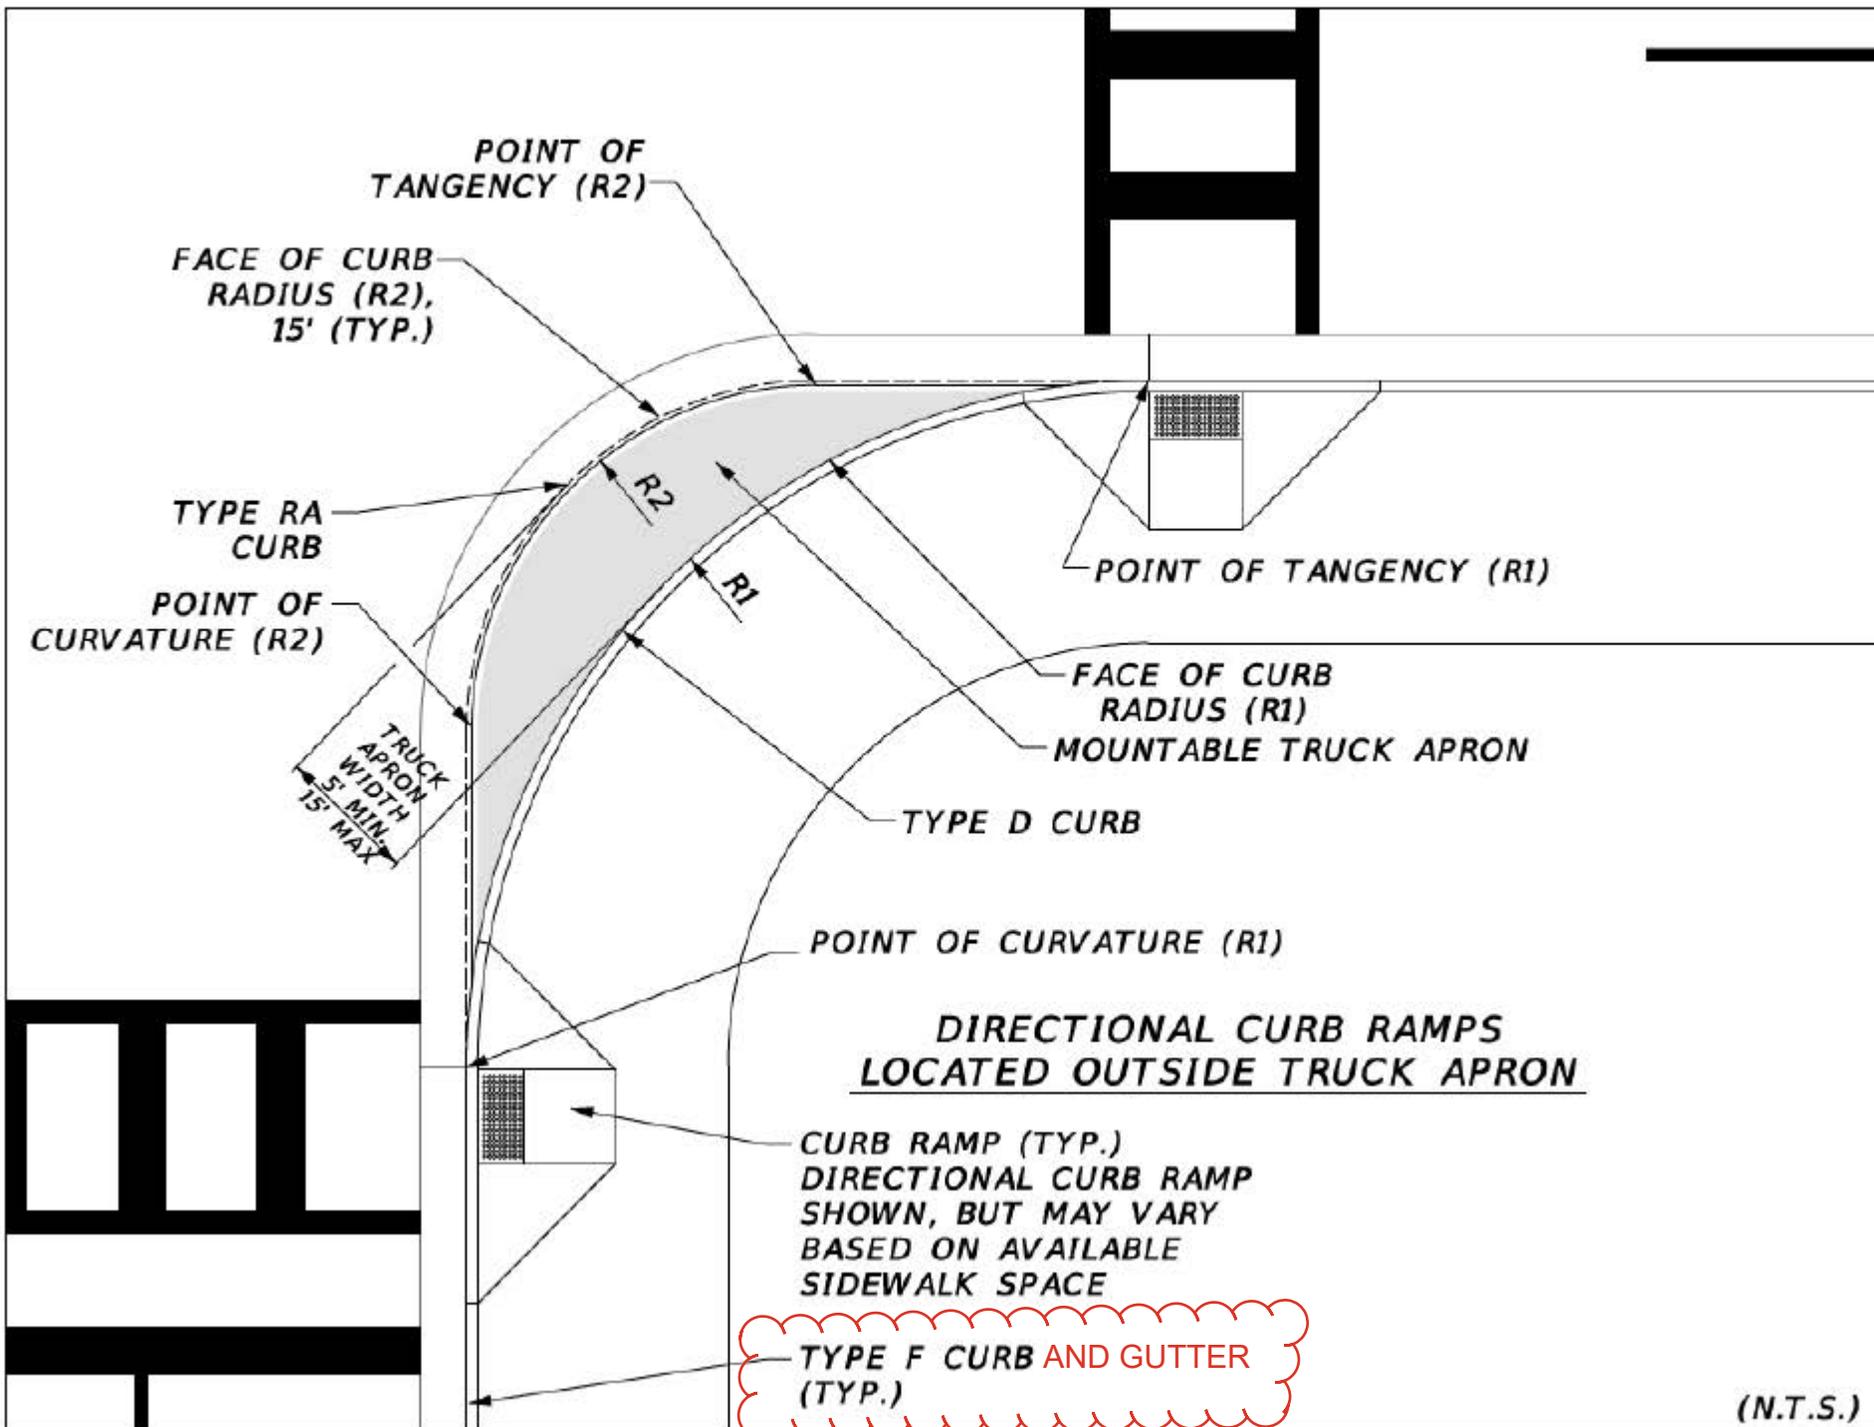

(N.T.S.)