


Bicycle Lane and Sidewalk Example

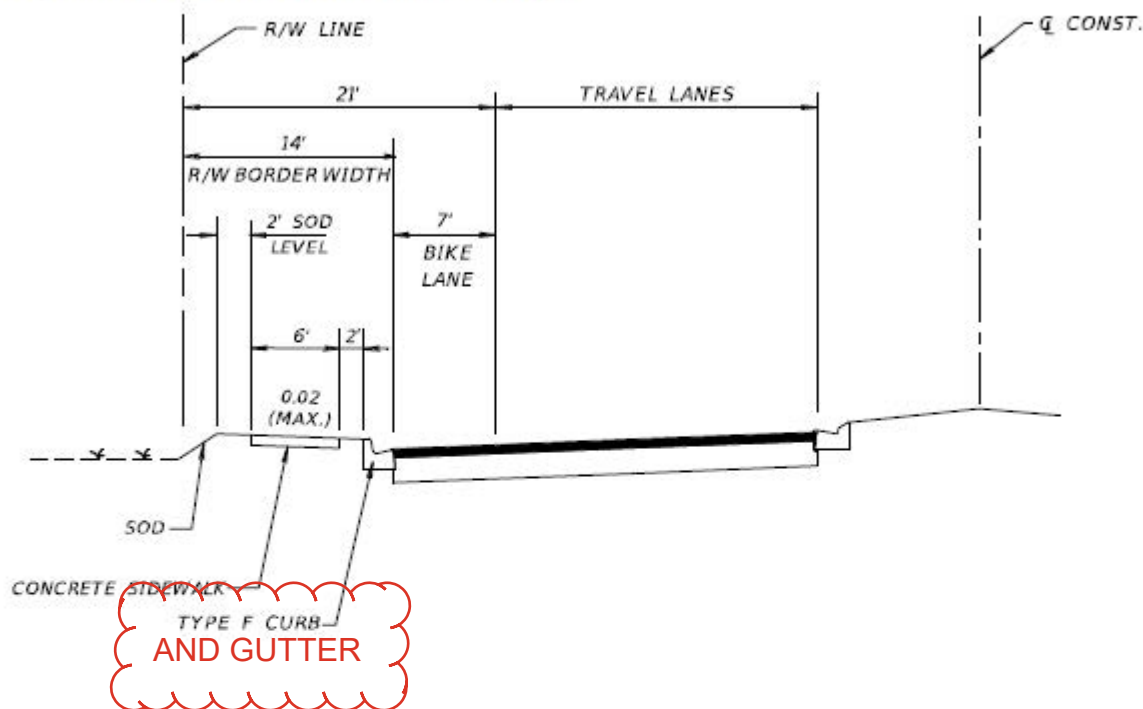

Shared Use Path Example

