



Figure 223.2.5

Angled Bicycle Ramp

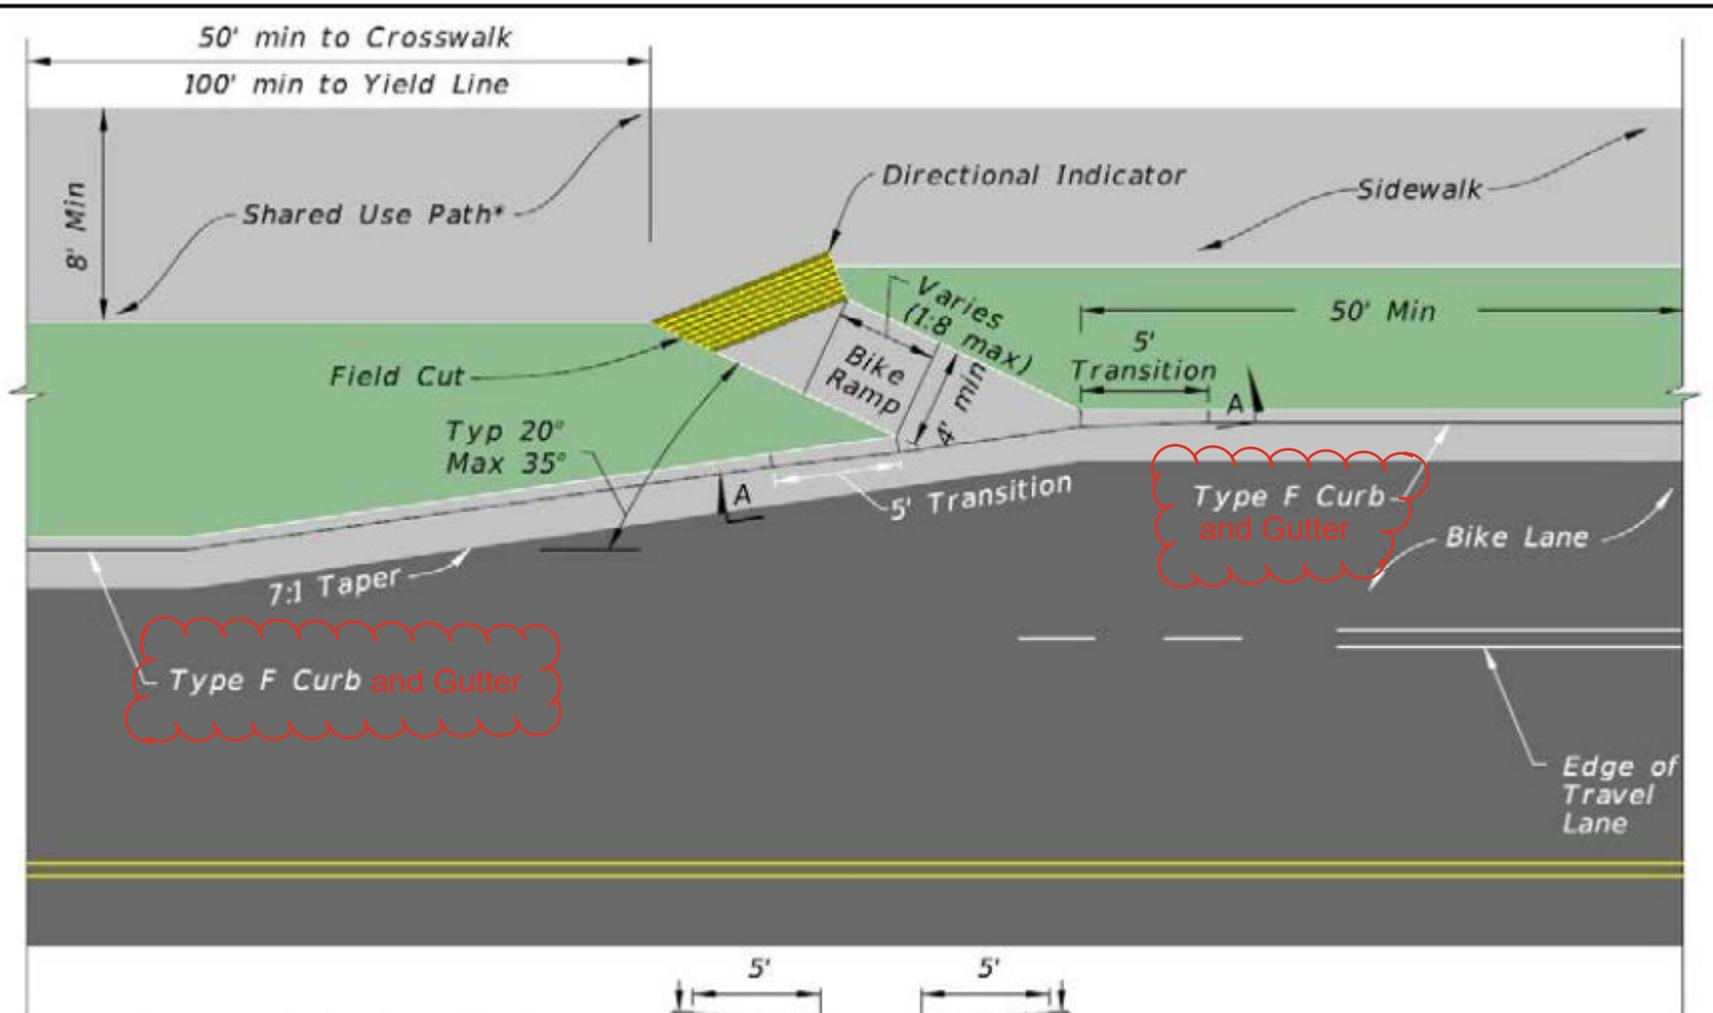

* May use Urban Side Path when criteria applies.

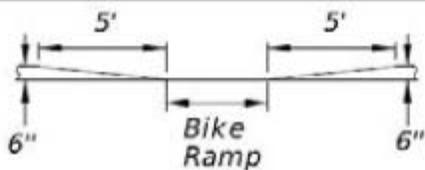

Section A-A

NTS