



Figure 223.2.6

Straight Bicycle Ramp

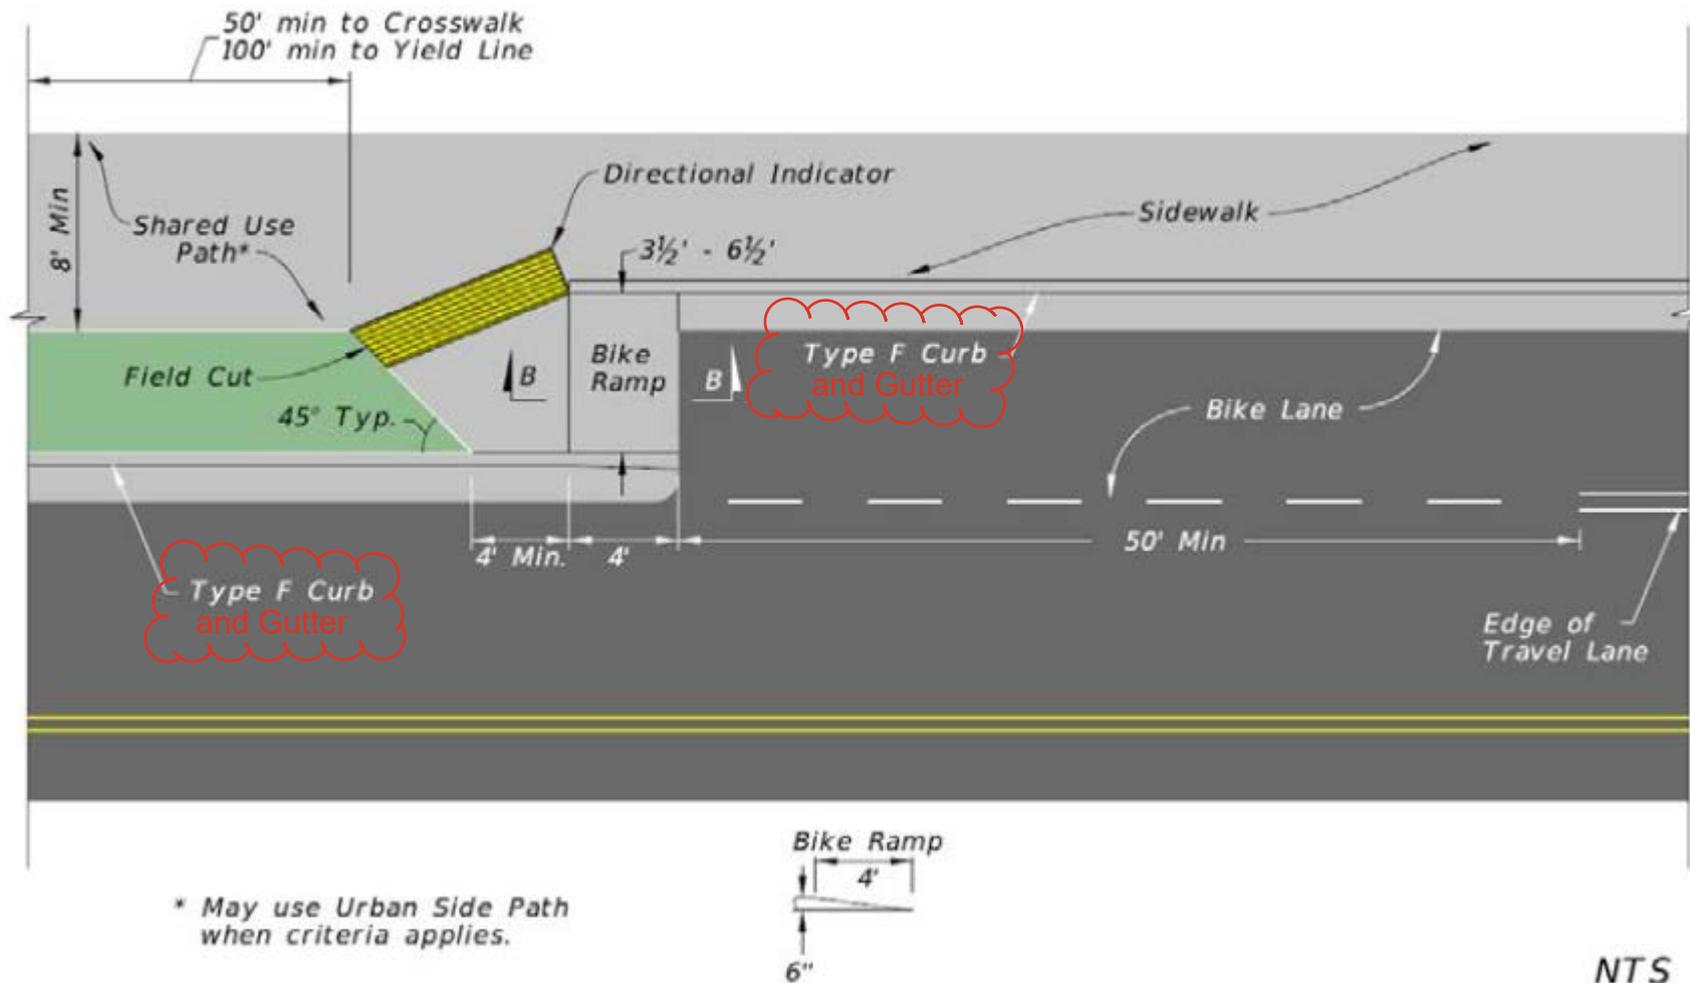

* May use Urban Side Path when criteria applies.

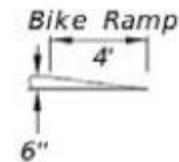

Section B-B

NTS