



**Figure 225.2.1**

**Accessible Boarding and Alighting Area for Flush Shoulder Roadways with Connection to Sidewalk**

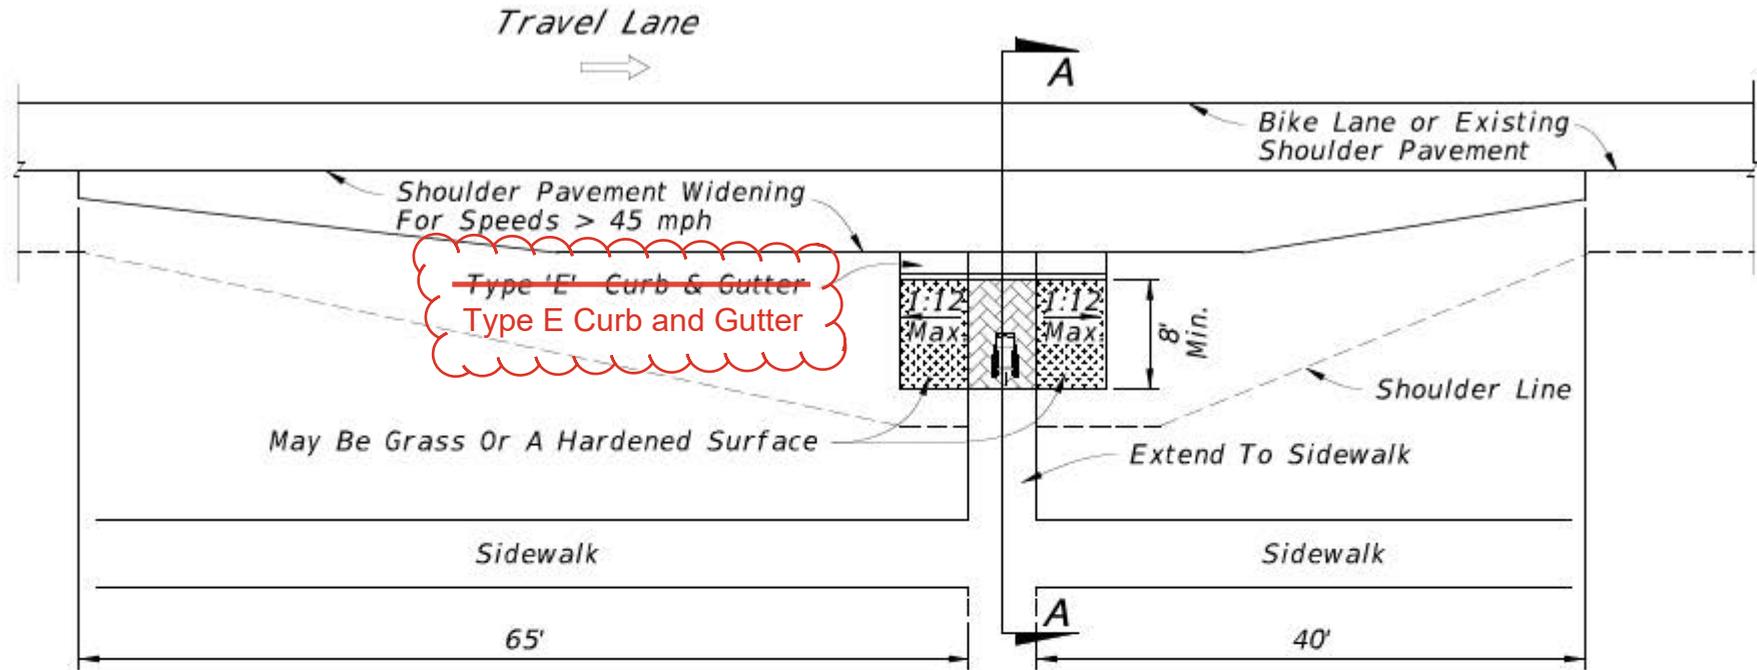

**PLAN VIEW**  
With Sidewalk

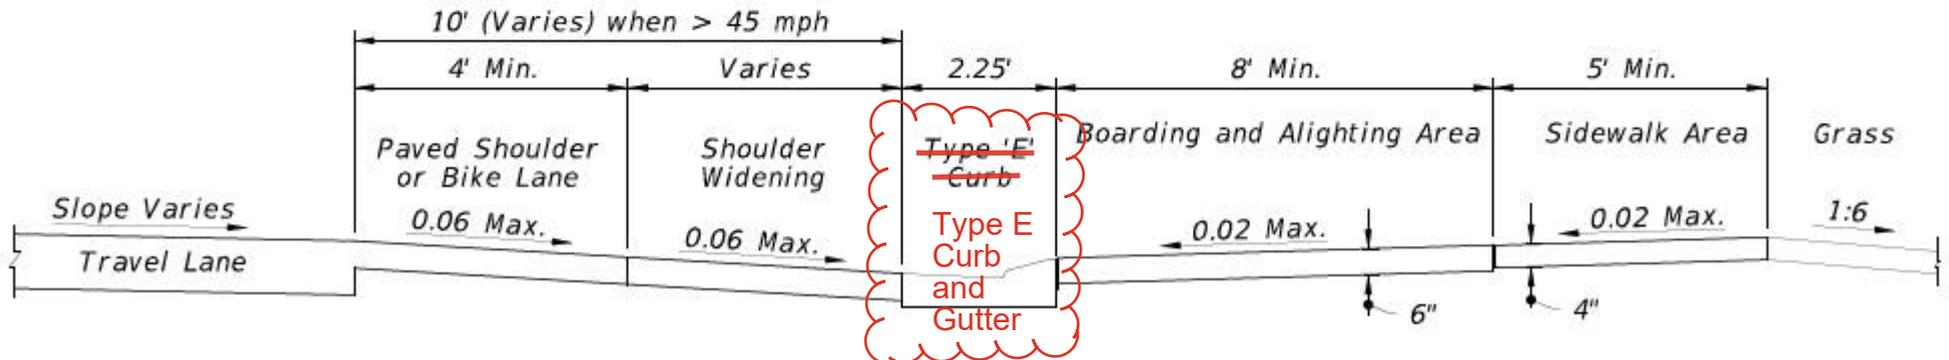

**SECTION A-A**

**LEGEND:**

-  Grass or Hardened Surface
-  Boarding and Alighting Area