



# MODERN ROUNDABOUT DETAILS

\*Min Offset From Lane Edge  
Line to Face of Curb:  
18" With Type E Curb and Gutter  
15" With Traffic Separator

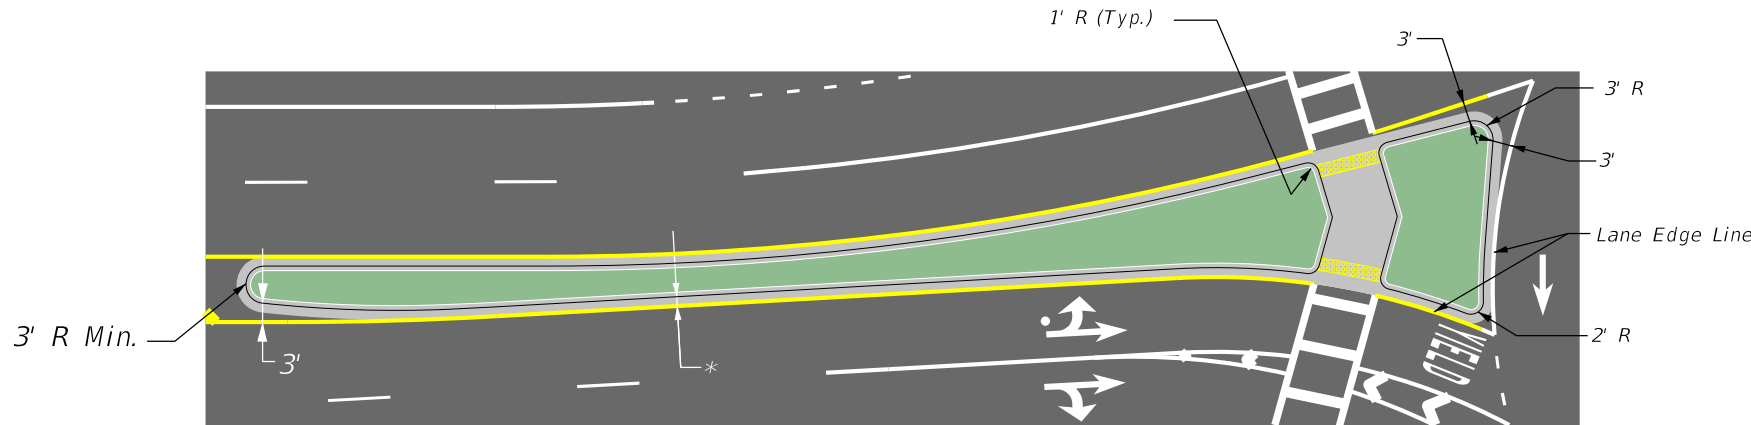


SPLITTER ISLAND DETAIL

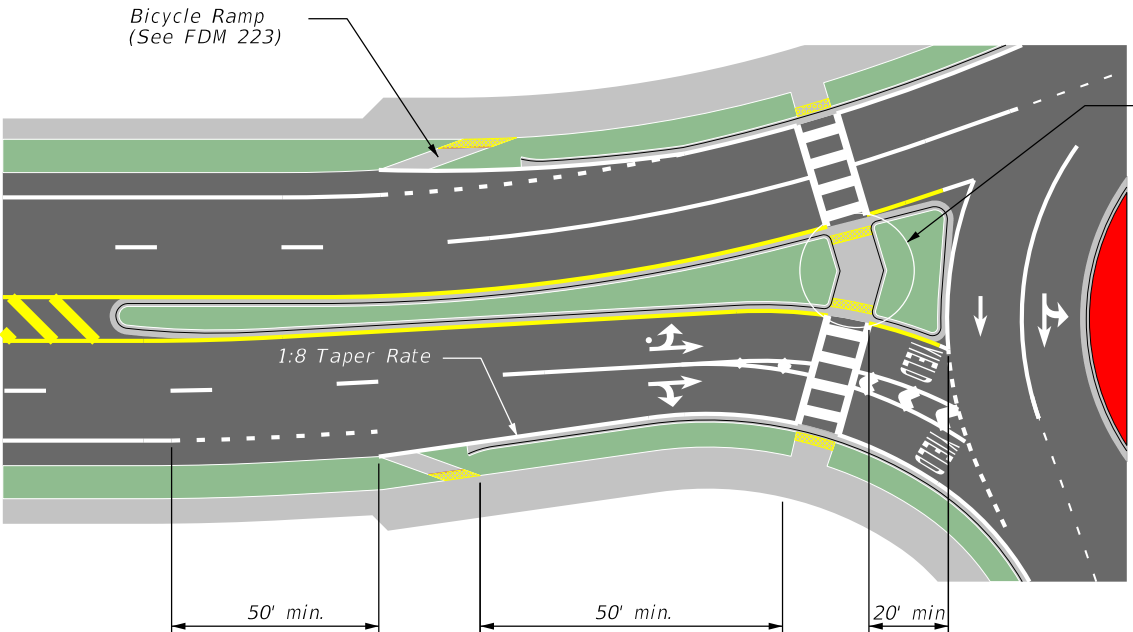


BICYCLE AND PEDESTRIAN DETAIL

Pedestrian Refuge  
See Detail "A"

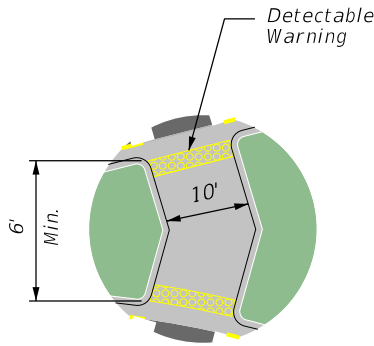

Detail "A"

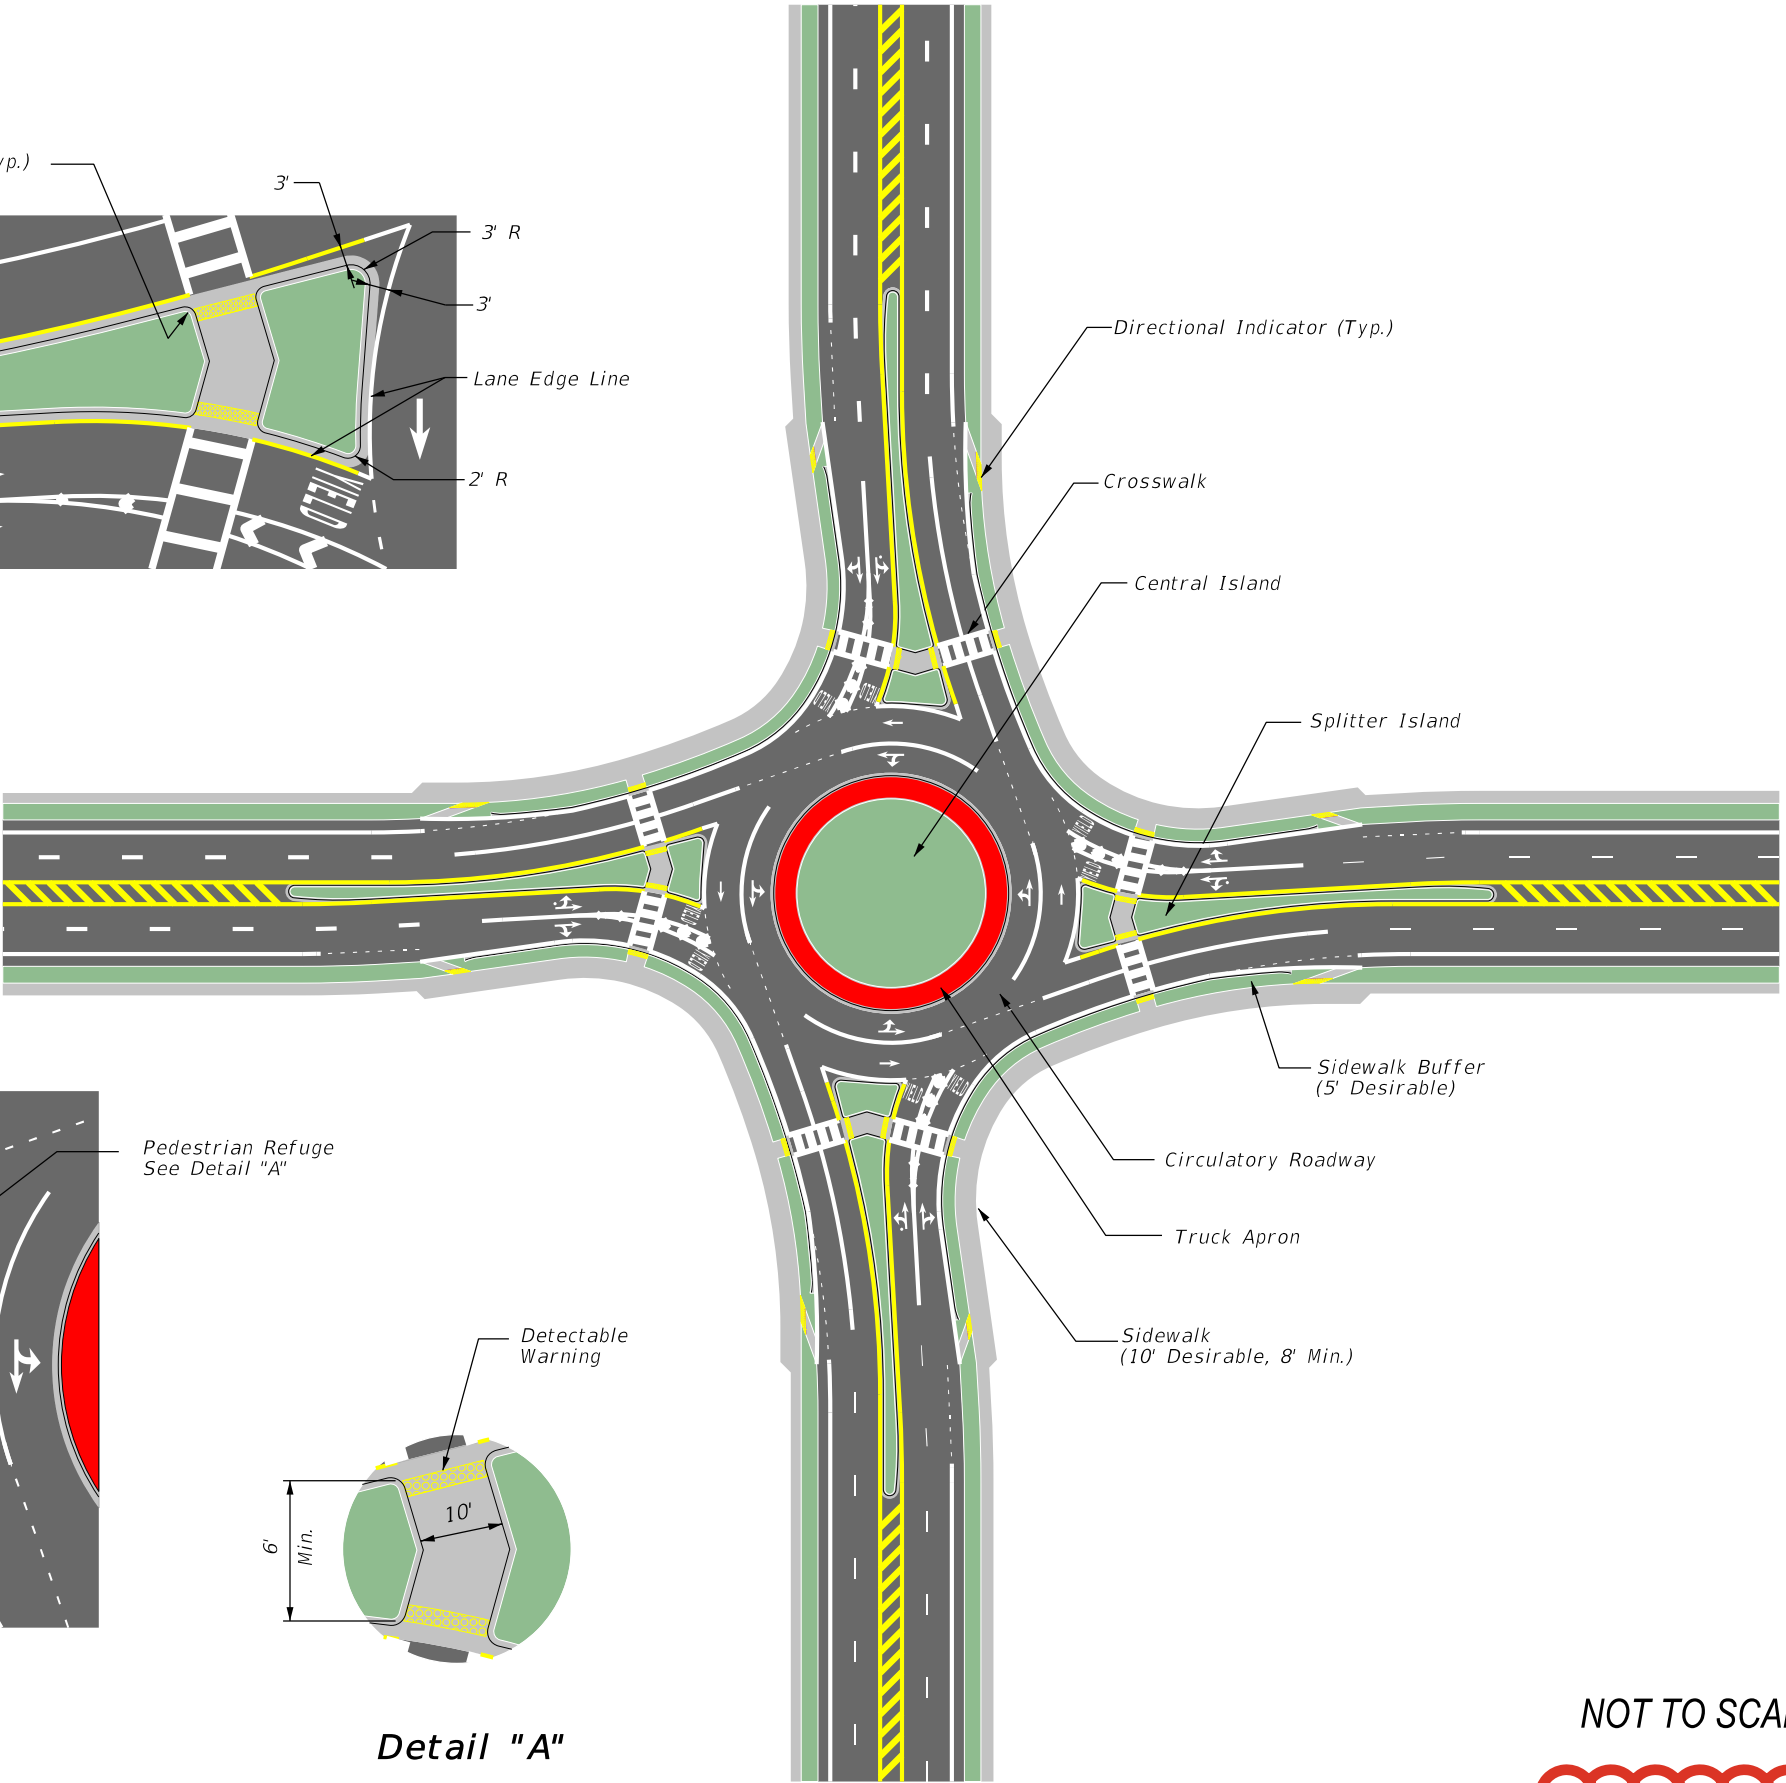

NOT TO SCALE

EXHIBIT 213-1  
01/01/2027