

INDEX OF RFP CONCEPT PLANS

| SHEET NO. | SHEET DESCRIPTION                                                         |
|-----------|---------------------------------------------------------------------------|
| 1         | KEY SHEET                                                                 |
| 2         | DRAINAGE MAP                                                              |
| 3         | TYPICAL SECTION DETAILS                                                   |
| 4         | MODEL MANAGEMENT                                                          |
| 5 - 6     | PROJECT CONTROL                                                           |
| 7         | ROADWAY PLAN-PROFILE                                                      |
| 8 - 10    | STORMWATER MANAGEMENT FACILITIES                                          |
| 11        | SOIL SURVEY                                                               |
| 12 - 14   | REPORT OF CORE BORINGS                                                    |
| 15 - 16   | SELECTIVE CLEARING AND GRUBBING                                           |
| 17        | MITIGATION PLAN                                                           |
| 18        | TRAFFIC PLAN (SIGNING AND PAVEMENT MARKING, SIGNALIZATION, ITS, LIGHTING) |
| 19 - 26   | LANDSCAPE PLAN                                                            |
| 27 - 32   | ARCHITECTURAL PLAN                                                        |
| 33 - 36   | STRUCTURES PLAN                                                           |
| 37 - 40   | UTILITY WORK BY HIGHWAY CONTRACTOR                                        |

STATE OF FLORIDA  
DEPARTMENT OF TRANSPORTATION

RFP CONCEPT PLANS



FINANCIAL PROJECT ID 123456-1-52-01

WAKULLA COUNTY (59010000)

STATE ROAD NO. 61 (US 319)

~~FROM SR 30 (US 98) TO NORTH OF ALASKA WAY~~

MISCELLANEOUS CONSTRUCTION FROM SR 30 (US 98) TO NORTH OF ALASKA WAY

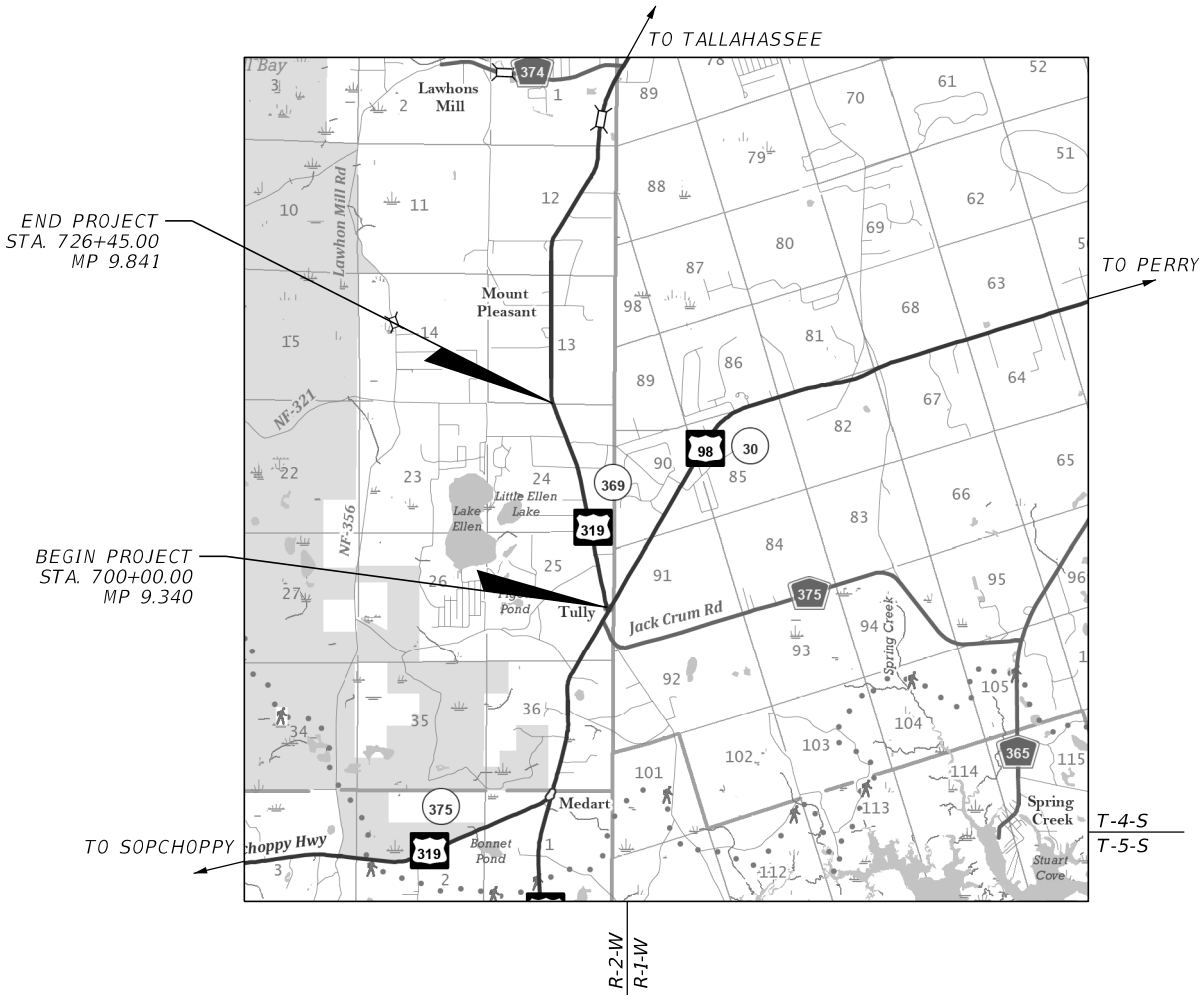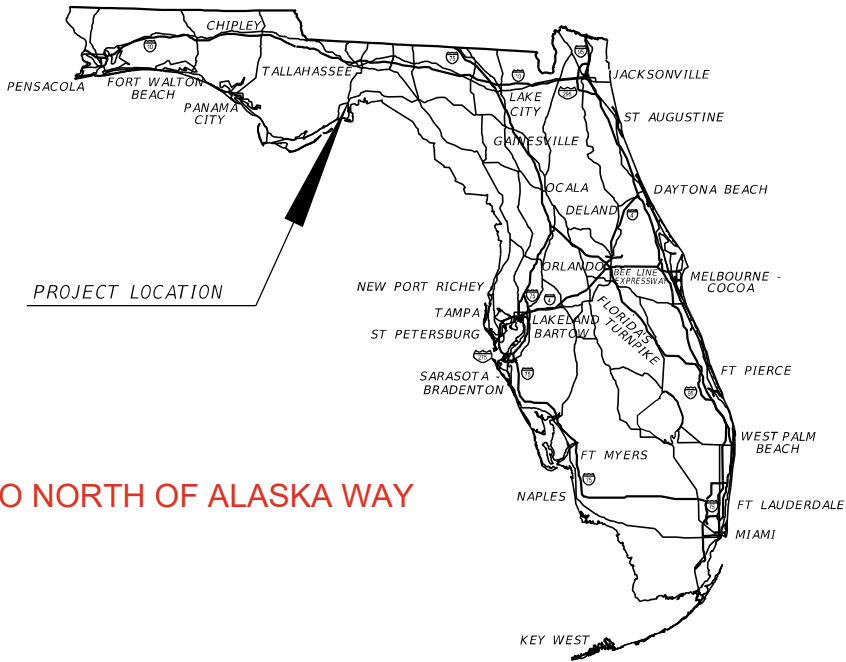

RFP CONCEPT PLANS  
DEVELOPED BY:

JOE ENGINEER, P.E.  
P.E. LICENSE NUMBER 12345  
FLORIDA ENGINEERING, LLC.  
PO BOX 125  
ANYTOWN, FL 12345  
850-123-4567  
CONTRACT NO.: C0000  
VENDOR NO.: 99-999999

FDOT PROJECT MANAGER:

JOHN SMITH, P.E.

Exhibit 907-1  
RFP Concept Plans  
Date: 1/1/2027

| FISCAL<br>YEAR | SHEET<br>NO. |
|----------------|--------------|
| 27             | 1            |