

CONTRACT PLANS COMPONENTS

- ROADWAY
- SIGNING AND PAVEMENT MARKING
- SIGNALIZATION
- INTELLIGENT TRANSPORTATION SYSTEMS
- LIGHTING
- LANDSCAPE
- ARCHITECTURAL
- STRUCTURES
- TOLL FACILITIES
- UTILITY WORK BY HIGHWAY CONTRACTOR

INDEX OF ROADWAY PLANS

SHEET NO.	SHEET DESCRIPTION
1	KEY SHEET
2	SIGNATURE SHEET
3	DRAINAGE MAP
4 - 5	TYPICAL SECTIONS
6	TYPICAL SECTION DETAILS
7 - 9	MODEL MANAGEMENT
10	PROJECT CONTROL
11	GENERAL NOTES
12 - 14	ROADWAY PLAN-PROFILE
15 - 16	TRAFFIC MONITORING SITE
17	SPECIAL DETAILS
18 - 19	DRAINAGE NETWORK 1 PLAN
20 - 21	DRAINAGE NETWORK 1 PROFILE
22	DRAINAGE NETWORK 1 CROSS SECTIONS
23	DRAINAGE NETWORK 2 PLAN
24	DRAINAGE NETWORK 2 PROFILE
25	DRAINAGE NETWORK 2 CROSS SECTIONS
26	OPTIONAL MATERIALS TABULATION
27	DRAINAGE SPECIAL DETAILS
30 - 39	ROADWAY CROSS SECTIONS
40 - 43	VERIFIED UTILITY LOCATE
44 - 51	TEMPORARY TRAFFIC CONTROL PLAN
52 - 57	UTILITY ADJUSTMENTS
58 - 61	SELECTIVE CLEARING AND GRUBBING
62	MISCELLANEOUS STRUCTURES
GR-1*	ROADWAY SOIL SURVEY
GR-2*	REPORT OF CORE BORINGS

* These sheets are included in the Index of Roadway Plans only to indicate that they are part of the Roadway Plans. These sheets are contained in a separate digitally signed and sealed document.

DEVELOPMENTAL STANDARD PLANS (DSPs):
D591-001 LANDSCAPE IRRIGATION SLEEVES

GOVERNING STANDARD PLANS:
Florida Department of Transportation, FY2026-27 Standard Plans for Road and Bridge Construction and applicable Interim Revisions (IRs).

Standard Plans for Road Construction and associated IRs are available at the following website: <https://www.fdot.gov/design/standardplans/default.shtm>

APPLICABLE IRs: IR536-001-01, IR521-001-01

If applicable, Standard Plans for Bridge Construction are included in the Structures Plans Component

GOVERNING STANDARD SPECIFICATIONS:
Florida Department of Transportation, FY2026-27 Standard Specifications for Road and Bridge Construction at the following website: <https://www.fdot.gov/specifications/default.shtm>

STATE OF FLORIDA
DEPARTMENT OF TRANSPORTATION

ROADWAY PLANS



FINANCIAL PROJECT ID 123456-1-52-01

WAKULLA COUNTY (59010000)

STATE ROAD NO. 61 (US 319)

FROM SR 30 (US 98) TO NORTH OF ALASKA WAY

MISCELLANEOUS CONSTRUCTION FROM SR 30 (US 98) TO NORTH OF ALASKA WAY

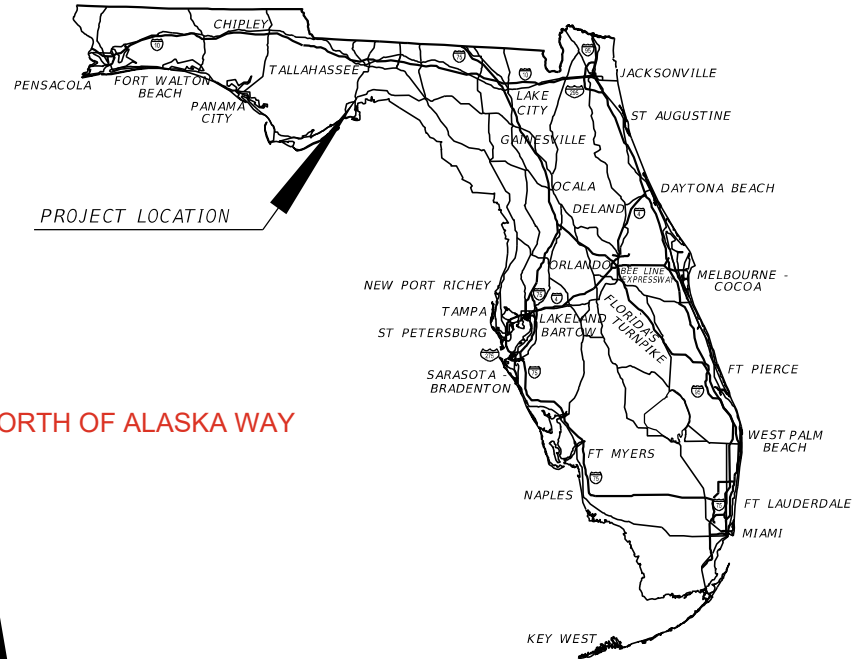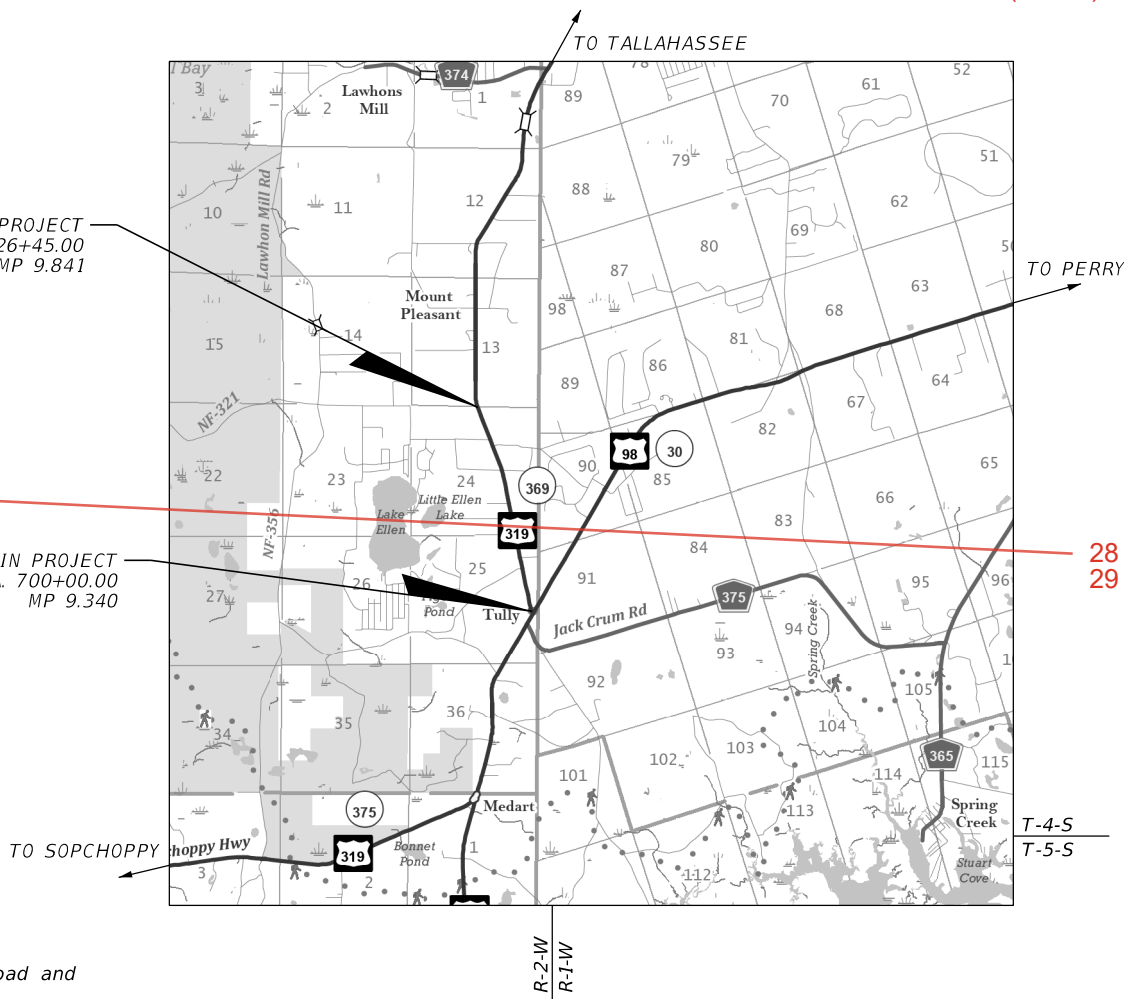

ROADWAY PLANS
ENGINEER OF RECORD:

JOE ENGINEER, P.E.
P.E. LICENSE NUMBER 12345
FLORIDA ENGINEERING, LLC.
PO BOX 125
ANYTOWN, FL 12345
850-123-4567
CONTRACT NO.: C0000
VENDOR NO.: 99-999999

FDOT PROJECT MANAGER:
JOHN SMITH, P.E.

CONSTRUCTION CONTRACT NO.	FISCAL YEAR	SHEET NO.
T0000	27	1

Please make these exact same changes to Exhibit 910-2

Exhibit 910-1
Lead Key Sheet
Date: 1/1/2027