

CONTRACT PLANS COMPONENTS

- ROADWAY
- SIGNING AND PAVEMENT MARKING
- SIGNALIZATION
- INTELLIGENT TRANSPORTATION SYSTEMS
- LIGHTING
- LANDSCAPE
- ARCHITECTURAL
- STRUCTURES
- TOLL FACILITIES
- UTILITY WORK BY HIGHWAY CONTRACTOR

INDEX OF SIGNING AND PAVEMENT MARKING PLANS

| SHEET NO. | SHEET DESCRIPTION                 |
|-----------|-----------------------------------|
| 1         | KEY SHEET                         |
| 2         | SIGNATURE SHEET                   |
| 3         | GENERAL NOTES                     |
| 4 - 7     | SIGNING AND PAVEMENT MARKING PLAN |
| 8         | GUIDE SIGN WORKSHEET              |
| 9         | OVERHEAD SIGN CROSS SECTION       |
| 10        | SIGN STRUCTURES DATA TABLE        |
| 11        | FOUNDATION DETAILS                |
| 12        | BRIDGE MOUNTED SIGN DETAILS       |
| 13        | REPORT OF CORE BORINGS            |

GOVERNING STANDARD PLANS:

Florida Department of Transportation, FY2026-27 Standard Plans for Road and Bridge Construction and applicable Interim Revisions (IRs).

Standard Plans for Road Construction and associated IRs are available at the following website: <https://www.fdot.gov/design/standardplans/default.shtm>

APPLICABLE IRs: IR536-001-01, IR521-001-01

If applicable, Standard Plans for Bridge Construction are included in the Structures Plans Component

GOVERNING STANDARD SPECIFICATIONS:

Florida Department of Transportation, FY2026-27 Standard Specifications for Road and Bridge Construction at the following website: <https://www.fdot.gov/specifications/default.shtm>

STATE OF FLORIDA  
DEPARTMENT OF TRANSPORTATION  
SIGNING AND PAVEMENT MARKING PLANS

FINANCIAL PROJECT ID 123456-1-52-01

WAKULLA COUNTY (59010000)

STATE ROAD NO. 61 (US 319)

~~FROM SR 30 (US 98) TO NORTH OF ALASKA WAY~~

MISCELLANEOUS CONSTRUCTION FROM SR 30 (US 98) TO NORTH OF ALASKA WAY



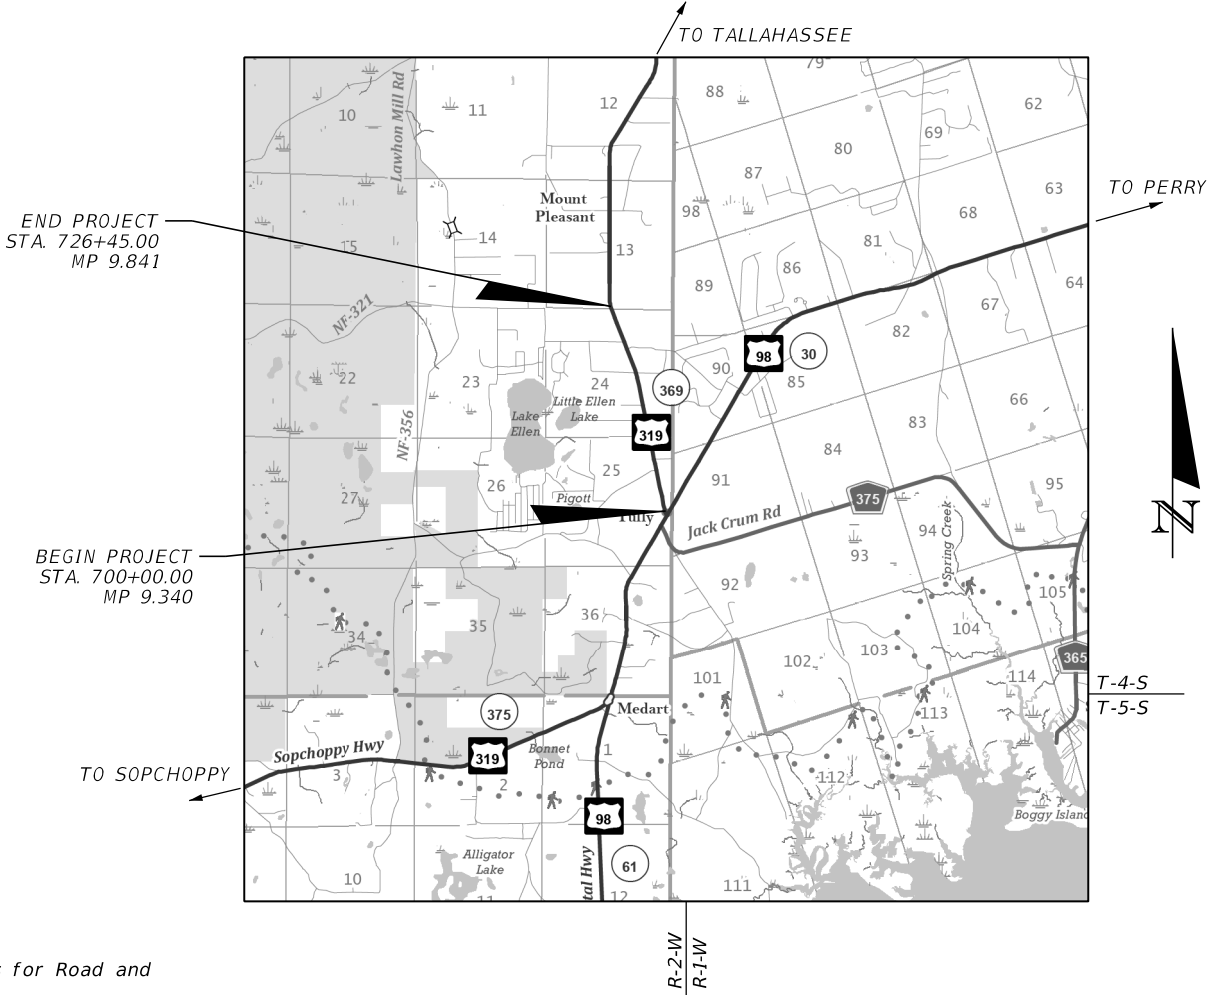


Exhibit 910-3  
Component Key Sheet  
Date: 1/1/2027

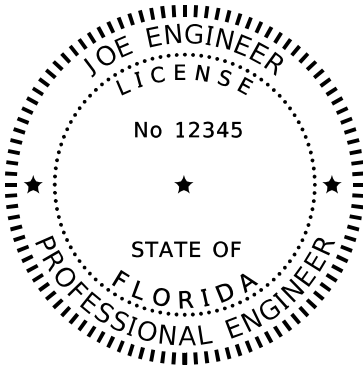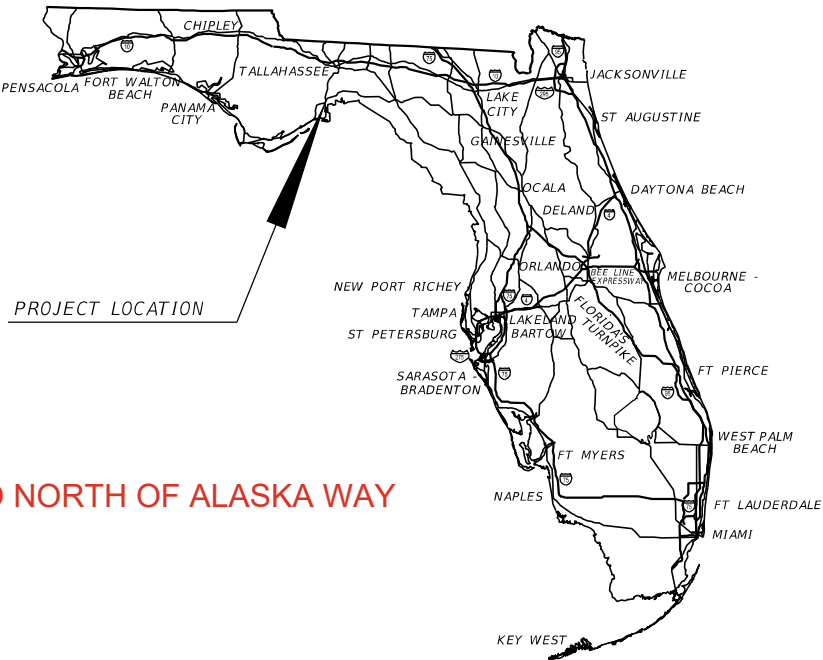

THIS ITEM HAS BEEN DIGITALLY  
SIGNED AND SEALED BY

Joe Engineer  
2026.06.28 12:19:55 - 04'00'

ON THE DATE ADJACENT TO THE SEAL

SIGNATURE MUST BE VERIFIED  
ON ANY ELECTRONIC COPIES.

SIGNING AND  
PAVEMENT MARKING PLANS  
ENGINEER OF RECORD:

JOE ENGINEER, P.E.  
P.E. LICENSE NUMBER 12345  
FLORIDA ENGINEERING, LLC.  
PO BOX 125  
ANYTOWN, FL 12345  
850-123-4567  
CONTRACT NO.: C0000  
VENDOR NO.: 99-999999

FDOT PROJECT MANAGER:

JOHN SMITH, P.E.

| CONSTRUCTION<br>CONTRACT NO. | FISCAL<br>YEAR | SHEET<br>NO. |
|------------------------------|----------------|--------------|
| T0000                        | 27             | 1            |