

# FY 2024-25 Standard Plans Update Training

Rick Jenkins, P.E.  
State Standard Plans Engineer  
Central Office, Roadway Design Office  
[Rick.Jenkins@dot.state.fl.us](mailto:Rick.Jenkins@dot.state.fl.us)



## Standard Plans – Update Training Agenda:

### ➤ General Overview

- **Rick Jenkins**
  - Website Updates  
(<http://www.fdot.gov/design/standardplans/>)

### ➤ Standard Plans Updates

- **Rick Jenkins**
  - Miscellaneous Roadway Updates
- **Shae Gibbs**
  - Miscellaneous Roadway Updates
- **Richard Stepp**
  - Lighting and Barrier Updates
- **Victor Johnson**
  - Index 695-001
- **Joshua Turley**
  - Structures and Bridge Related Updates



## New RDO Website



INDEX A-Z

Search FDOT...

Q Search



OFFICES

MAPS & DATA

CONTACT

ABOUT

PROJECTS

RESOURCES

NEWSROOM

CAREERS

# FDOT Releases Construction Timelines for Moving Florida Forward Projects

The Florida Department of Transportation (FDOT) announces timelines for Moving Florida Forward Infrastructure Initiative projects. Proposed in Governor Ron DeSantis' Freedom First Budget and funded by the Legislature, the Moving Florida Forward Infrastructure Initiative will accelerate priority infrastructure projects across the state through an allocation of \$4 billion starting in the 2023-24 fiscal year.

[Learn More](#)



## Revision Log


[OFFICES](#)
[MAPS & DATA](#)
[CONTACT](#)
[ABOUT](#)
[PROJECTS](#)
[RESOURCES](#)
[NEWSROOM](#)
[CAREERS](#)

### Standard Plans for Road Construction

Standard Plans Index	Interim Revision, Errata, or Developmental (Dev)	Index Title	Design Standards Index	Standard Plans Instructions	Design Tools/ 3D Exhibits
<b>Support Detail</b>					
<a href="#">eBook</a>		Standard Plans for Road Construction - Complete eBook			
<a href="#">Cover/Certification Statement</a>		Cover Sheet / Certification Statement			
<a href="#">Abbrev.</a>		Abbreviations Sheet			
<a href="#">TOC Road</a>		Table of Contents - Road Construction			
<a href="#">Revisions</a>		Revision History Log		<a href="#">SPI</a>	
<b>Miscellaneous</b>					
<a href="#">000-510</a>		Superelevation Transitions - High Speed Roadways	510	<a href="#">SPI</a>	
<a href="#">000-511</a>		Superelevation Transitions - Low Speed Roadways	511		
<a href="#">000-525</a>		Ramp Terminals	525	<a href="#">SPI</a>	
<b>General Construction Operations-Roadway</b>					
<b>Maintenance of Traffic</b>					
<a href="#">000-500</a>		Temporary Detour	500		





## Standard Plans Staff

[OFFICES](#)[MAPS & DATA](#)[CONTACT](#)[ABOUT](#)[PROJECTS](#)[RESOURCES](#)[NEWSROOM](#)[CAREERS](#)

Continuously provide Standard Plans and Specifications that are of excellent quality and value to roadway designers, contractors, and the traveling public.



### Standard Plans

[Current Standard Plans](#)[Standard Plans \(FY 2018-19 Thru Current\)](#)[Developmental Standard Plans](#)

### Supporting Documents

[Roadway Design Bulletins](#)[Standard Plans CADD-DGN and Cell Libraries](#)[Standard Plans Training](#)

### Review and Responses

[Submit a Revision](#)[Industry Review](#)[Track the Status of Revisions](#)[Review Archives](#)

### Temporary Traffic Control (TTC) Maintenance of Traffic (MOT)

[TTC Website](#)[Current TTC Handbook](#)


### Roadway Lighting

[Coming Soon](#)

### Roadside Barriers

[Coming Soon](#)

## Redline Sheet 5: Driven Post Hole

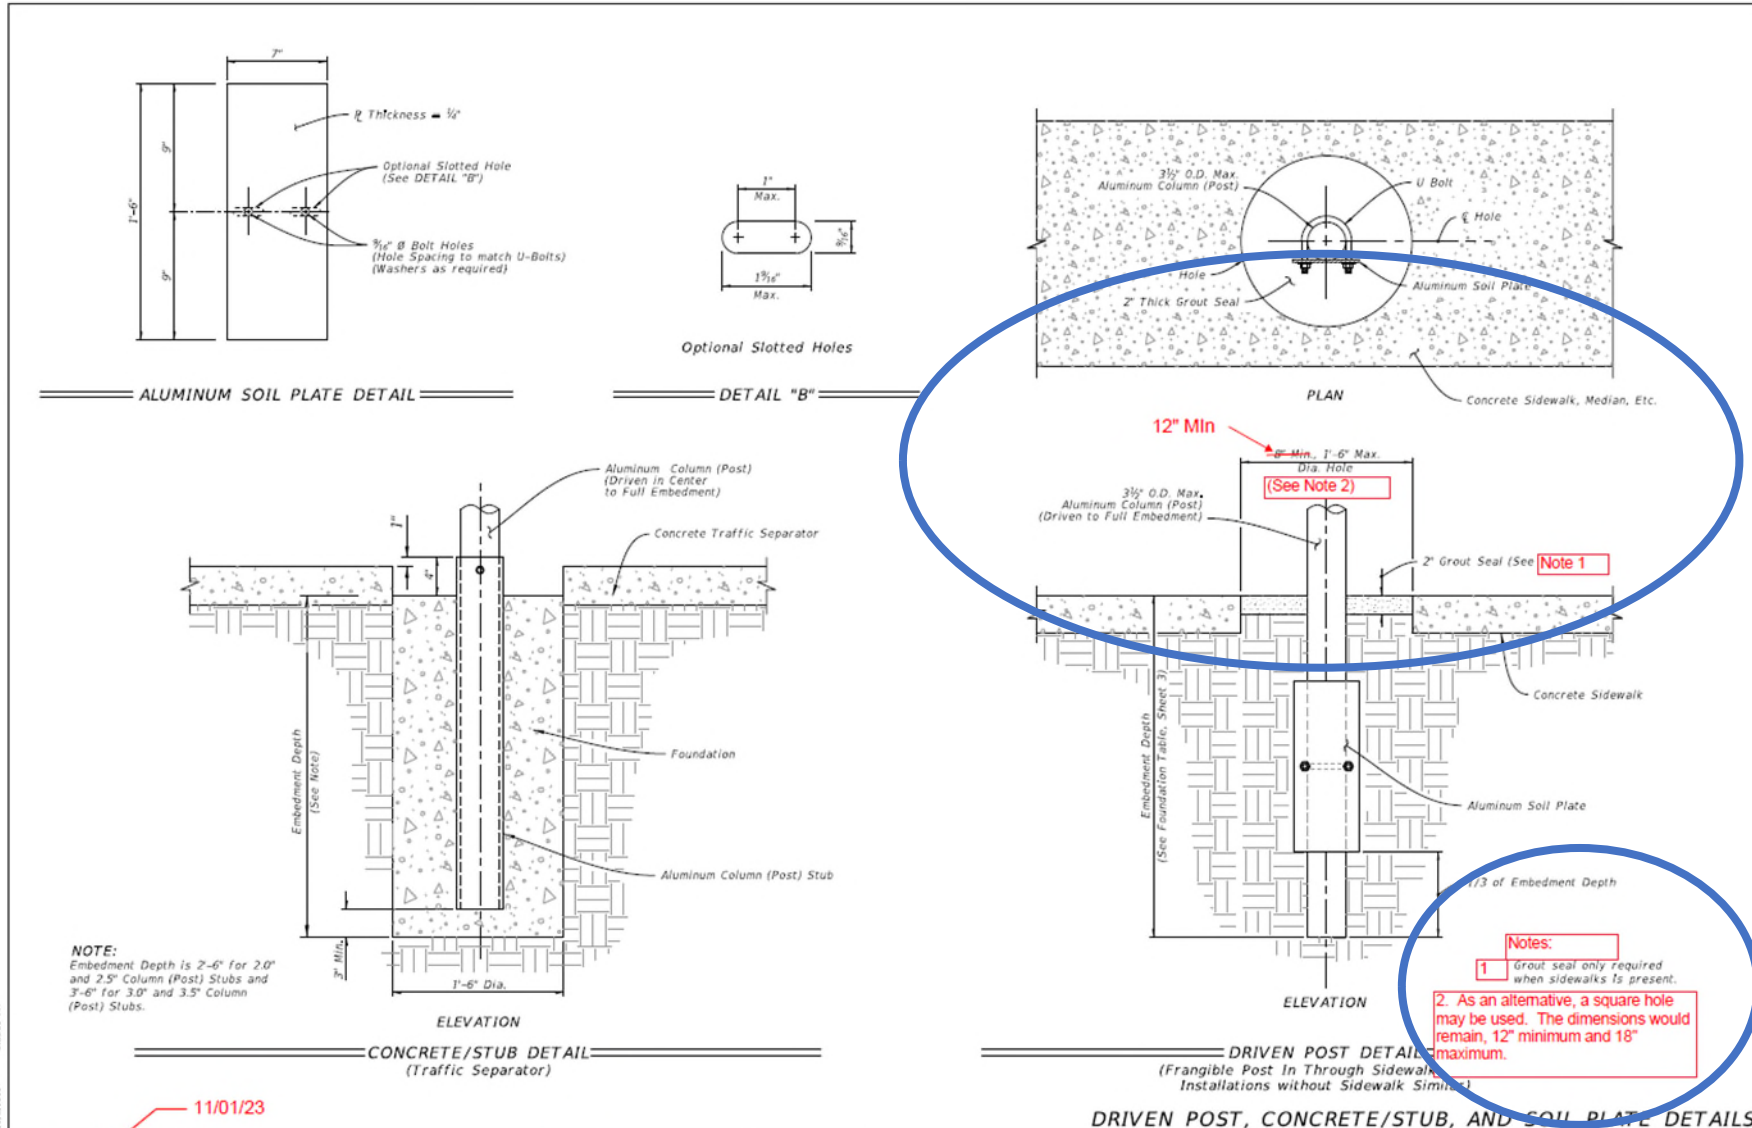


- **Minimum Driven Post Hole Diameter now 12"**
- **Alternate Square Hole Option Added**




## Updated Sheet 5: Driven Post Hole

- Updated Driven Post
- New Note 2

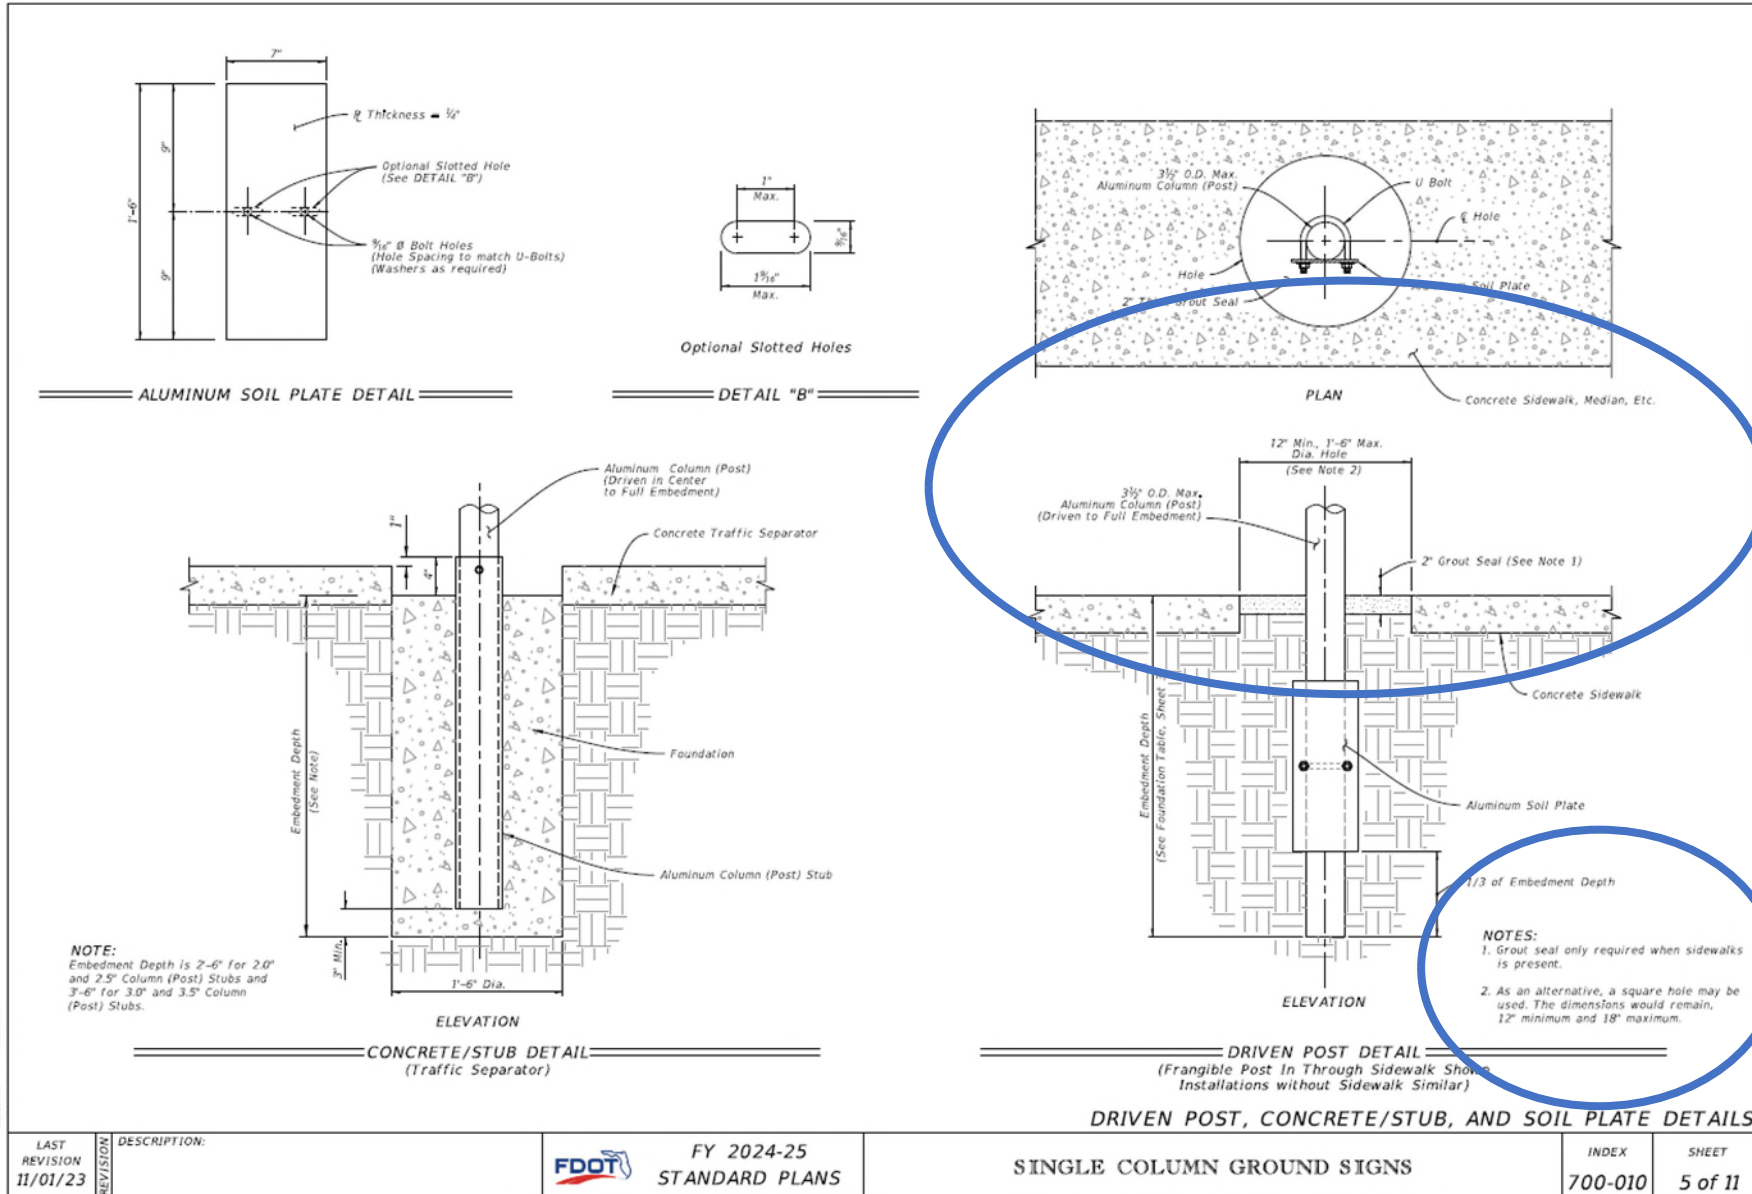



LAST REVISION 11/01/23	DESCRIPTION:	FY 2024-25 STANDARD PLANS	SINGLE COLUMN GROUND SIGNS	INDEX 700-010	SHEET 5 of 11
---------------------------	--------------	------------------------------	----------------------------	------------------	------------------

## Sheet 3: NEW SHEET – Spread Footing Foundation

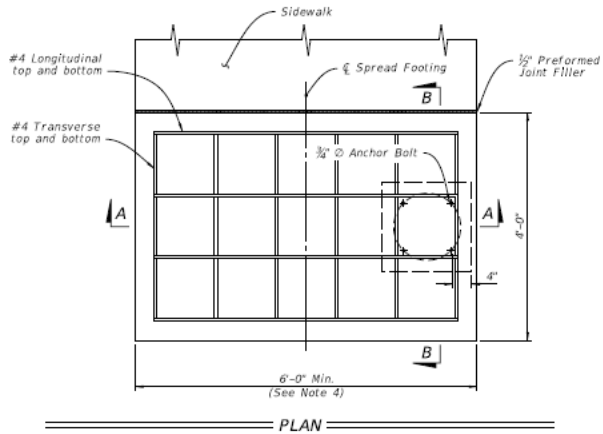

**NOTES:**

1. Install the Spread Footing Foundation only where called for in the Plans.
2. SIDEWALK:
  - a. When abutting sidewalk, match the cross slope of the adjacent sidewalk or curb ramp where applicable. Maintain the minimum depth of footing.
  - b. 1/2" expansion preformed joint filler required between sidewalk and spread footing.
  - c. Apply concrete surface finish to the top of the spread footing in accordance with Specification S22-7.
  - d. Sidewalk placed on the other side or both sides of the spread footing is permitted where shown in the Plans.
3. Only use concrete riser when installed in-line with sidewalk curb that results in a drop off to the adjacent sidewalk.
4. For sidewalks greater than 6', match sidewalk width. Add one #4 transverse bar, top and bottom, per additional foot of spread footing to maintain at minimum the same reinforcement area per foot.
5. Base location can vary on spread footing. Location shown in Plans.

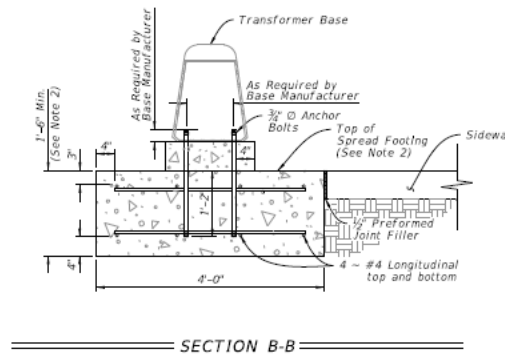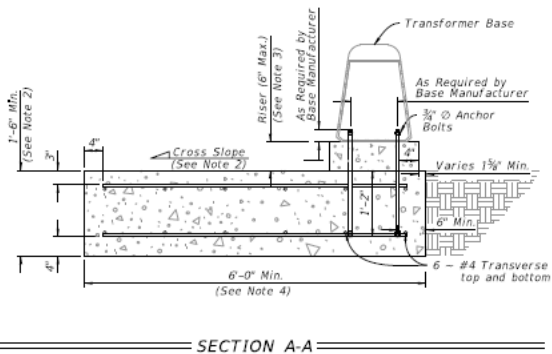

- Spread Footing Option
- Worked with District Staff, Structures Office and TERL
- Allows for Placement in Tight Areas




SPREAD FOOTING FOUNDATION

<p>LAST REVISION 11/01/23</p>	<p>DESCRIPTION:</p>	<p>FY 2024-25 STANDARD PLANS</p>	<p>ENHANCED HIGHWAY SIGNING ASSEMBLIES</p>	<p>INDEX 700-120</p>	<p>SHEET 3 of 15</p>
-----------------------------------	---------------------	--------------------------------------	--	--------------------------	--------------------------

## Sheet 12: NEW SHEET – Roadside Signing Assembly 9

- **New Enhanced version of Railroad Warning Sign**

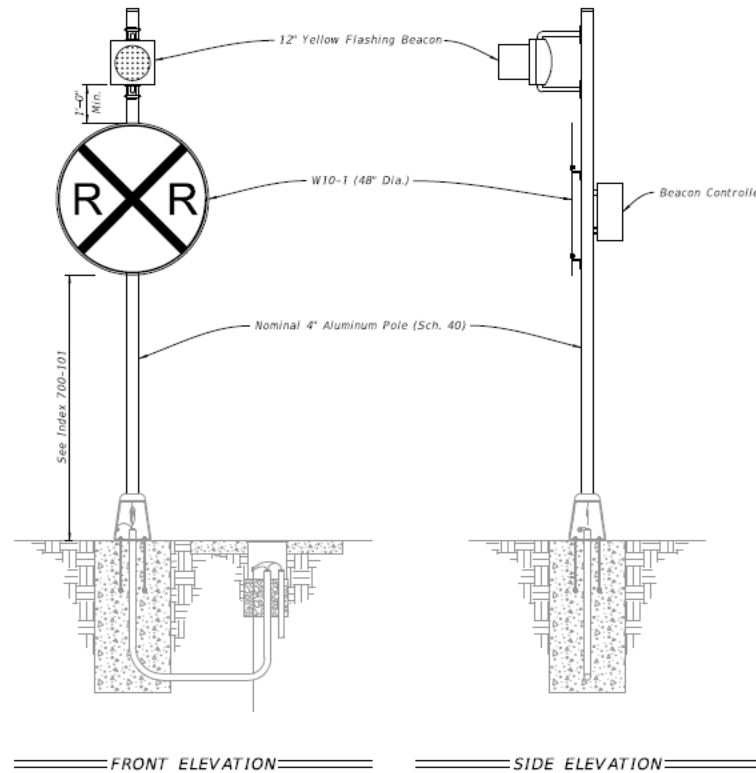

**NOTES:**  
 1. Type A9 Assembly (conventionally powered) is shown. Type B9 Assemblies (solar powered) similar.  
 2. Foundation reinforcement not shown.




ROADSIDE SIGN ASSEMBLY-9

LAST REVISION 11/01/23	DESCRIPTION:	FY 2024-25 STANDARD PLANS	ENHANCED HIGHWAY SIGNING ASSEMBLIES	INDEX 700-120	SHEET 12 of 15
---------------------------	--------------	------------------------------	-------------------------------------	------------------	-------------------

## Sheet 13: NEW SHEET – Roadside Signing Assembly 10

- **New Highlighted version of “Do Not Stop on Tracks” Sign**

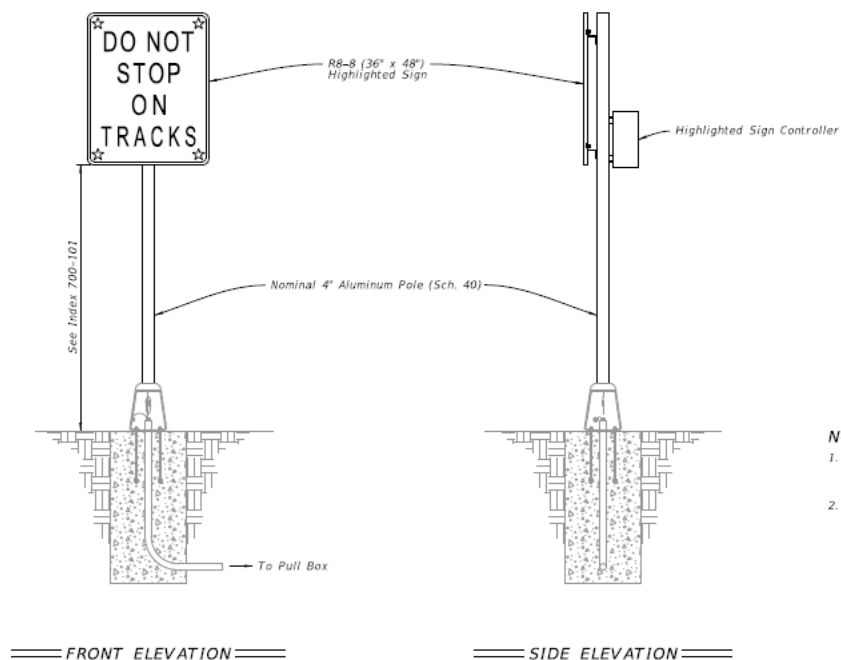

**NOTES:**  
 1. Type A10 Assembly (conventionally powered) is shown.  
 Type B10 Assemblies (solar powered) similar.  
 2. Foundation reinforcement not shown.



10/01/2023 3:18:58 PM


LAST REVISION 11/01/23		DESCRIPTION: FY 2024-25 STANDARD PLANS	ENHANCED HIGHWAY SIGNING ASSEMBLIES	INDEX 700-120	SHEET 13 of 15
---------------------------	--	--	-------------------------------------	------------------	-------------------

ROADSIDE SIGN ASSEMBLY-10



## Sheet 14: NEW SHEET – Roadside Signing Assembly 11

- **New Highlighted version of Yield and Stop Signs at Railroad Crossings**

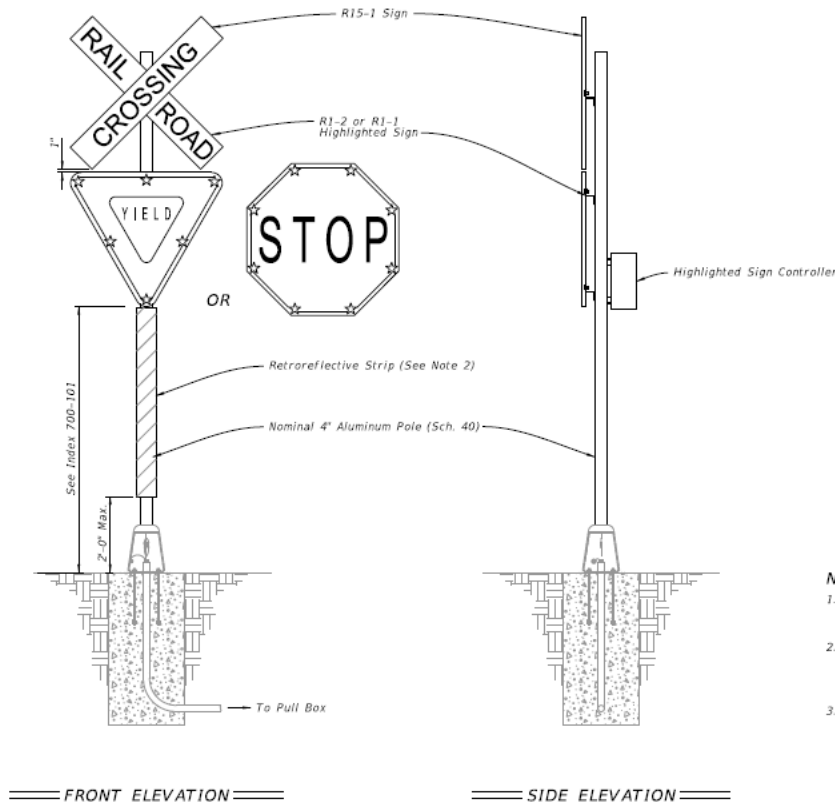

- NOTES:**
1. Type A11 Assembly (conventionally powered) is shown. Type B11 Assemblies (solar powered) similar.
  2. Install red retroreflective strip on front and white retroreflective strip on back in accordance with Specification 700.
  3. Foundation reinforcement not shown.




ROADSIDE SIGN ASSEMBLY-11

10/13/2023 3:19:05 PM

LAST REVISION 11/01/23	DESCRIPTION:	FY 2024-25 STANDARD PLANS	ENHANCED HIGHWAY SIGNING ASSEMBLIES	INDEX 700-120	SHEET 14 of 15
---------------------------	--------------	------------------------------	-------------------------------------	------------------	-------------------

## Redlined Sheet 1: Diagonal Pavement Markings

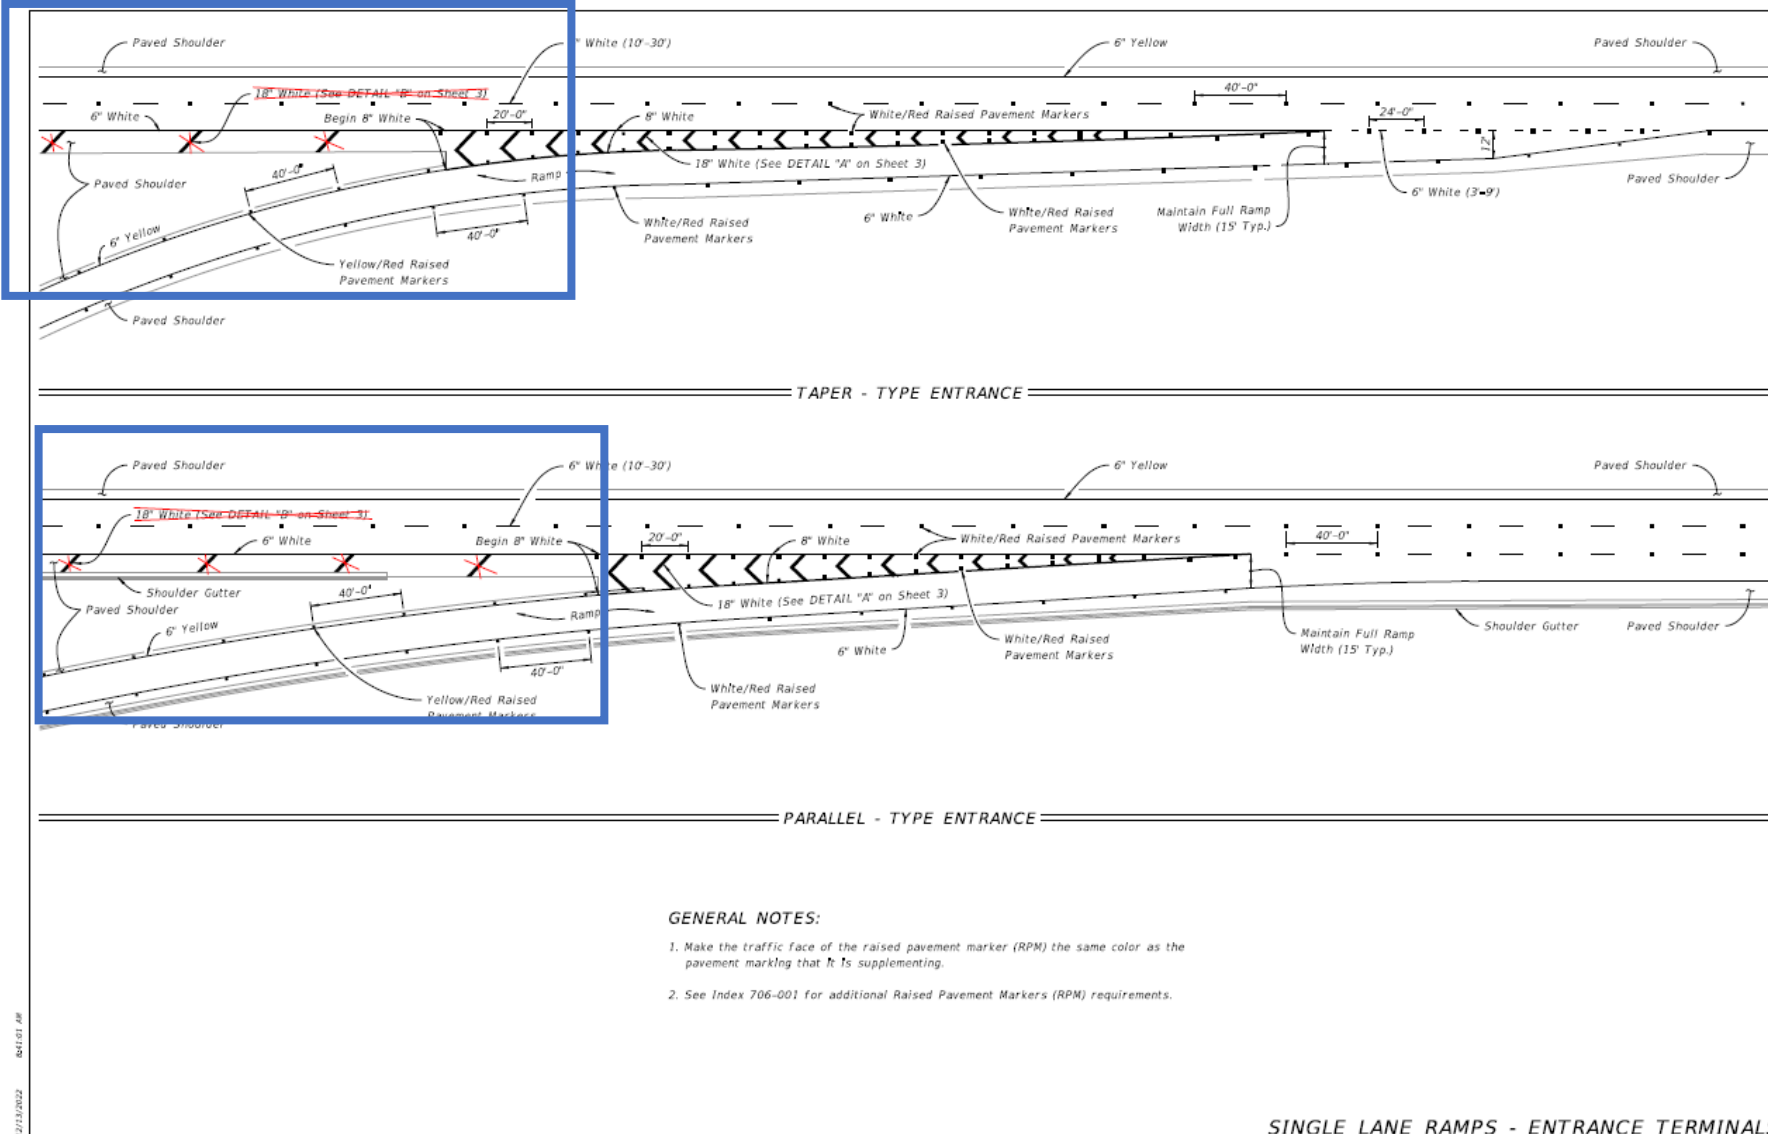

- Deleted Diagonal Pavement Marking
- Interchange Entrances ONLY
- Not Required per AASHTO Greenbook
- Same Update to Sheet 2




SINGLE LANE RAMPS - ENTRANCE TERMINALS

LAST REVISION 23 11/01/21	DESCRIPTION: FY 2023-24 STANDARD PLANS	INTERCHANGE MARKINGS	INDEX 711-003	SHEET 1 of 8
---------------------------------	--	----------------------	------------------	-----------------

## Updated Sheet 1: Diagonal Pavement Markings

• Updated Sheet 1

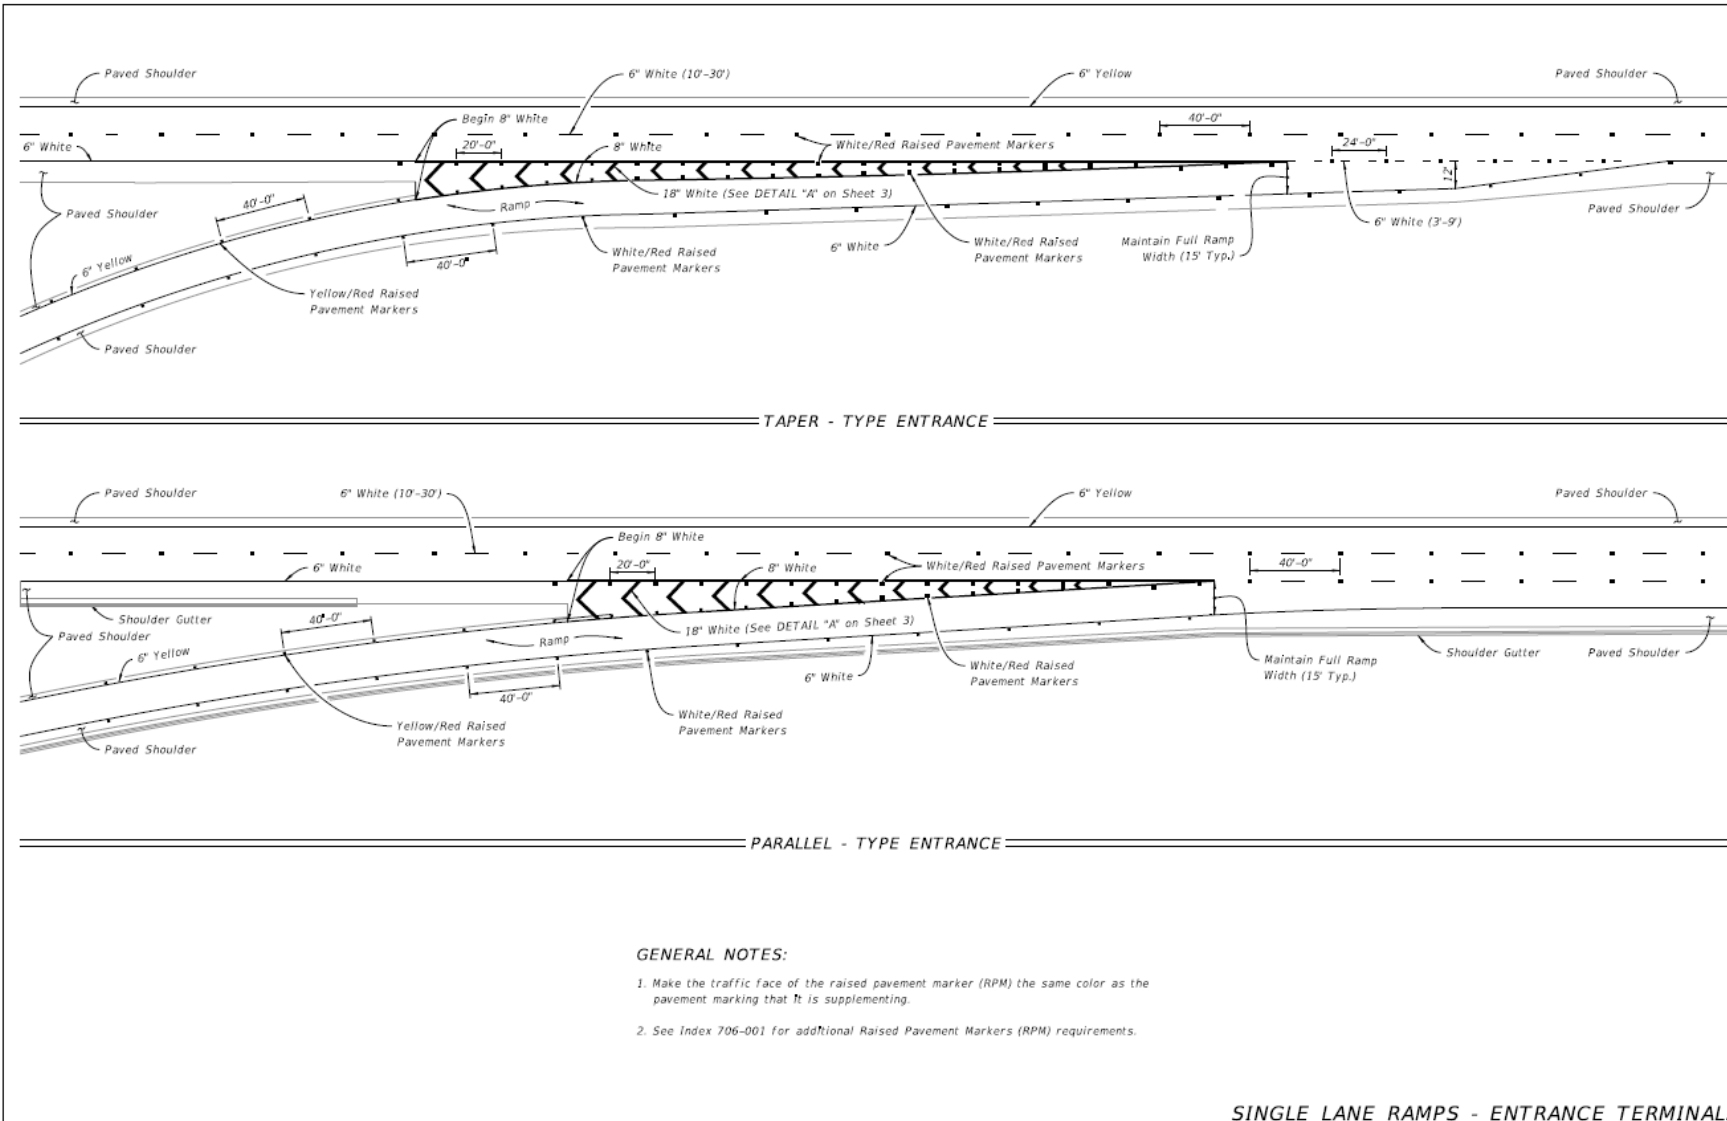

10/14/2023 6:53:06 AM

LAST REVISION 11/01/23	DESCRIPTION:	FY 2024-25 STANDARD PLANS	INTERCHANGE MARKINGS	INDEX 711-003	SHEET 1 of 8
---------------------------	--------------	------------------------------	----------------------	------------------	-----------------

# Contact Us:



Rick Jenkins, P.E.  
State Standard Plans Engineer  
Central Office, Roadway Design Office  
[Rick.Jenkins@dot.state.fl.us](mailto:Rick.Jenkins@dot.state.fl.us)



# FY 2024-25 Standard Plans Update Training

Shae Gibbs  
Standard Plans Specialist  
Roadway Design Office  
[Shae.Gibbs@dot.state.fl.us](mailto:Shae.Gibbs@dot.state.fl.us)



## **Standard Plans – Primary Updates:**

- 1) *Index 102-110 – Type K Temporary Concrete Barrier System***
- 2) *Index 102-200 – Temporary Acrow 300 Series Detour Bridge  
General Notes and Details***
- 3) *Index 400-010 – Cantilever Retaining Wall (C-I-P)***
- 4) *Index 400-011 – Gravity Wall***
- 5) *Index 400-289 – Concrete Box Culvert Details***
- 6) *Index 400-291 – Precast Concrete Box Culverts-Supplemental  
Details***
- 7) *Index 400-292 – Standard Precast Concrete Box Culverts***
- 8) *Index 425-001 – Supplementary Details for Drainage Structures***
- 9) *Index 430-001 – Miscellaneous Drainage Details***



**Standard Plans – Primary Updates:**

- 10) Index 430-012 – U-Type Concrete Endwall Energy Dissipator 30” to 72” Pipe***
- 11) Index 440-001 – Underdrain***
- 12) Index 443-001 – French Drain***
- 13) Index 446-001 – Concrete Pavement Subdrainage***
- 14) Index 455-400 – Precast Concrete Sheet Pile Wall (C-I-P)***
- 15) Index 455-440 – Precast Concrete Sheet Pile Wall (CFRP/GFRP & HSSS/GFRP)***
- 16) Index 524-001 – Ditch Pavement and Sodding***

## GEOSYNTHETIC FOR DRAINAGE APPLICATIONS, FILTER FABRIC (GEOTEXTILE)

(REV 6-1-23)

SECTION 514 is deleted and the following substituted:

### 514-1 Description.

This Section specifies the construction requirements for geosynthetics used in drainage, slope protection, and material separation applications. Install a filter fabric.

### 514-2 Material.

Meet the filter fabric requirements as specified in Use geosynthetic materials meeting the requirements of Section 985 and listed on the Approved Product List (APL). Ensure the geosynthetic materials received at the job site are in unopened shipping packages and the packages are clearly labeled with the manufacturer's name, product name, style number, roll dimension and LOT number, otherwise, the Engineer will reject the material. Store geosynthetic materials in accordance with the manufacturer's instructions ensuring to protect the geosynthetic material from physical damage, debris, and temperatures greater than 140° F. Prevent mud, fluid concrete, asphalt, or other deleterious materials from coming in contact with the geosynthetic materials that could impact the performance of the geosynthetic material. Replace geosynthetic materials with defects, tears, punctures, flaws, deterioration, or other damage at no additional cost to the Department.

### 514-3 Construction Methods.

514-3.1 Geosynthetic Materials for Drainage Applications General: Select a geosynthetic material meeting the appropriate application as specified in 985-3. Place and install the geosynthetic material at the proper elevation, location and orientation, filter fabric (fabric) in the manner and locations as shown in the Contract Documents Plans, and in accordance with the manufacturer's instructions directions, and as specified in these Specifications. Place the geosynthetic material fabric on areas with a uniform slope that are reasonably smooth, free from mounds, windrows, and any debris or projections which might damage the geosynthetic material fabric.

Loosely lay the material. Do not stretch the material. Replace or repair any fabric damaged or displaced before or during placement of overlying layers to the satisfaction of the Engineer and at no expense to the Department.

When overlapping is necessary, the Contractor may sew the seams to reduce overlaps as specified in 985-2.63.

After placement of the geosynthetic material, schedule work so that covering the fabric with the specified material does not exceed the manufacturer's recommendations for exposure to ultraviolet light or five days, whichever is less. If the exposure time is the Engineer determines the exposure time was exceeded, the Contractor shall remove and replace the geosynthetic material fabric at no expense to the Department.

514-3.2 Subsurface Drainage Applications: When indicated in the Plans, place the geosynthetic material fabric with the long dimension parallel to the trench. Place and install the geosynthetic material fabric to provide a minimum 12-inch overlap for each joint or in

accordance with the manufacturer's recommendation, whichever is greater. Do not drop the coarse aggregate filter materials from heights greater than 3 feet.

~~514-3.3 Stabilization and Reinforcement: Overlap adjacent strips of fabric a minimum of 36 inches.~~

514-3.3 Riprap Revetment System Applications Filter: Overlap adjacent strips of geosynthetic material fabric at a minimum of 24 inches and in accordance with the manufacturer's recommendations, whichever is greater. Anchor the geosynthetic materials with securing pins (as recommended by the manufacturer) inserted through both strips of geosynthetic material fabric along a line through the midpoint of the overlap and to the extent necessary to prevent movement displacement of the geosynthetic material fabric.

Place the geosynthetic material fabric so that the upstream (upper) strip of geosynthetic material fabric overlaps the downstream (lower) strip.

Stagger vertical laps a minimum of 5 feet. Use full rolls of geosynthetic material fabric whenever possible in order to reduce the number of vertical laps.

Do not drop bedding stone or riprap from heights greater than 3 feet onto the geosynthetic material fabric.

514-3.4 Repairs: Replace geosynthetic material damaged during or after installation at no cost to the Department. Repair geosynthetics damaged during or after installation only after the manufacturer establishes that the intended use and stability is not affected and after obtaining the Engineer's approval. Make such repairs as follows:

Remove materials placed within the damaged geosynthetic area plus an additional 4 feet in all directions beyond the limits of the damage. Place a patch consisting of the same material as the geosynthetic material over the damaged area in accordance with the manufacturer's recommendation. Overlap the undamaged geosynthetic material with the patch at a minimum of 3 feet in all directions. Place backfill material on the geosynthetic material in accordance with the Contract Documents after repairs have been completed.

For repairs of Geosynthetic material placed on slopes adjacent to water, place geosynthetic material so that the upstream (upper) strip of geosynthetic material overlaps the downstream (lower) strip.

### 514-4 Basis of Payment, Acceptance Criteria.

~~No separate payment will be made for the work specified in this Section. The cost of furnishing, placing, and sewing or overlapping the fabric will be included in the Contract price for the items to which it is incidental.~~


Submit to the Engineer the product label with the manufacturer's name, product name, style number, roll dimension and LOT number at least fourteen days prior to placement. In addition, provide two 8-inch by 10-inch samples of geosynthetic materials for product identification to the Engineer. The acceptance of the geosynthetic material is subject to the approval of the State Materials Office (SMO).

### 514-5 Basis of Payment.

No separate payment will be made for the work specified in this Section. The cost of furnishing, placing, and sewing or overlapping the fabric will be included in the Contract price for the items to which it is incidental.




## Sheet 4: Update Filter Fabric to Geotextile

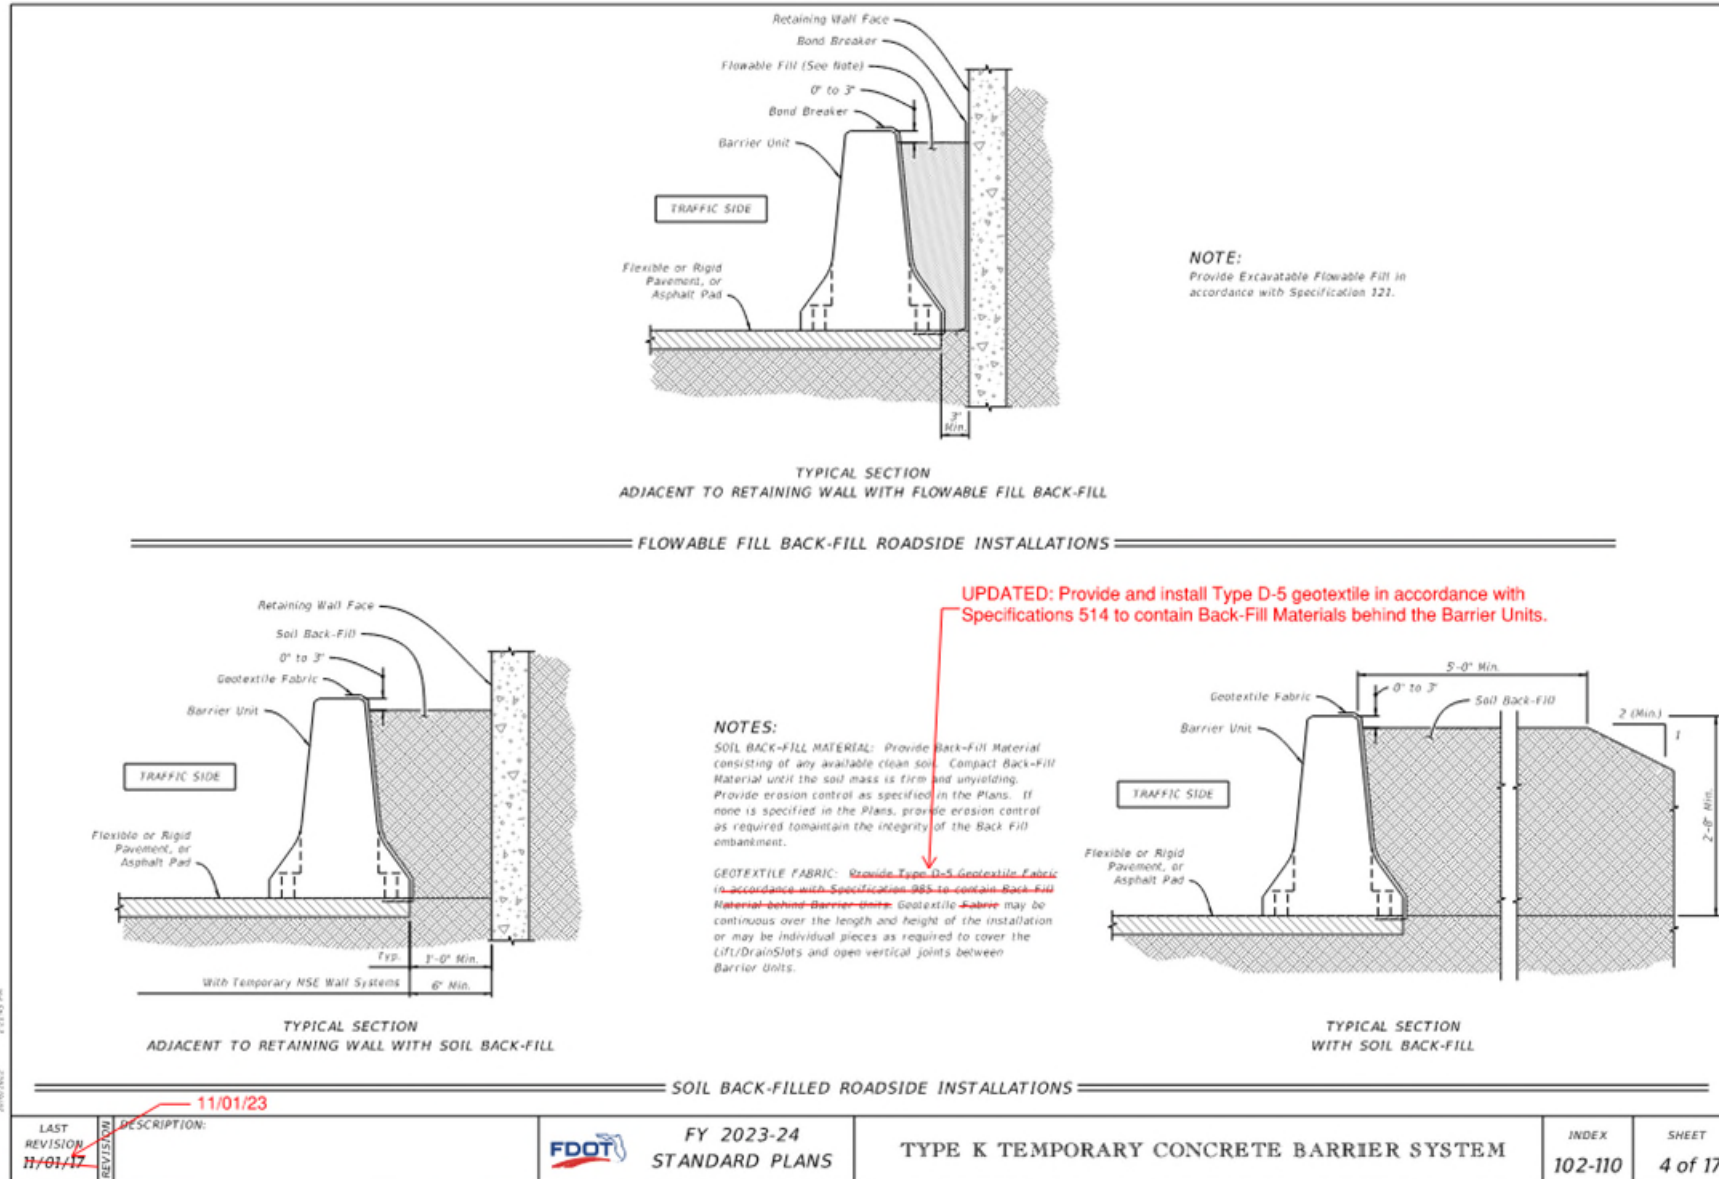

- Updated all references of Filter Fabric to Geotextile.
- Updates references pointing to Specification 985 to instead point to Specification 514.
- Add clarification in notes for types of Geotextile.


## Sheet 3: Update Filter Fabric to Geotextile

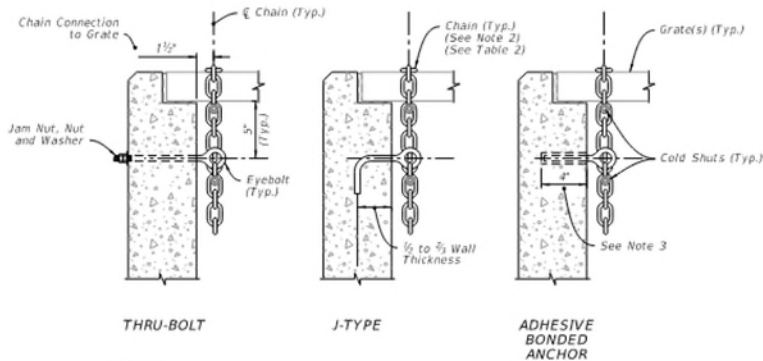

**NOTES:**

1. Install either a 1/2" Ø x 1" Diameter Threaded Straight (Thru-Bolt), a J-Type, or an adhesive Bonded Anchor Eyebolt.
2. Install a 3/8" Chain and 3/8" Cold Shuts. When chaining two grates together provide adequate loop for easy handling.
3. Install adhesive bonded anchor option with a minimum of 4" embedment, and in accordance with Specification 416.


Index Number	Inlet Type	Eye-Bolts	Length of Chain	Handling & Remarks
425-030	1	1	4'-0"	Slide & Spin
	2	2	2 @ 4'-0"	Slide & Spin
425-031	N/A	1	3'-8"	Slide or Slide & Spin
425-032	N/A	1	4'-0"	Slide & Spin
425-040	S	1	4'-0"	Slide & Spin
425-041	V	1	4'-0"	Slide & Spin
425-050	A	1	3'-0"	Slide
	B	1	5'-0"	Slide & Spin
425-051	C	1	2'-6"	Slide & Spin
	D	1	2'-6"	Slide & Spin
	E	2	2 @ 2'-6"	Slide & Spin
	H	2	2 @ 2'-6"	Flip Ctr. Grate and Slide & Spin Single Free Grate
425-052			1 or 2 @ 1'-6"	Center Grate(s) Chained to One End Grate
	F	1	3'-6"	Flip or Slide & Spin
425-053	G	1	6'-0"	Slide
			2'-0"	Lifting Loop
425-054	J	1	4'-0"	Slide & Spin

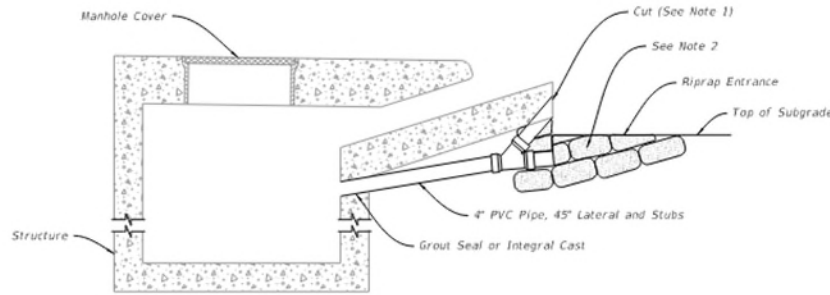

**NOTES:**

1. Bevel cut upper stub to match forming for apron face. Capping or plugging of upper stub is not required. Remove friable base material at stub opening to permit covering of opening with structural course material.
2. Remove riprap, cement PVC cap on lower stub, and place compacted fill in entrance prior to placing base material.

=====**SUBGRADE AND BASE TEMPORARY DRAINS**=====

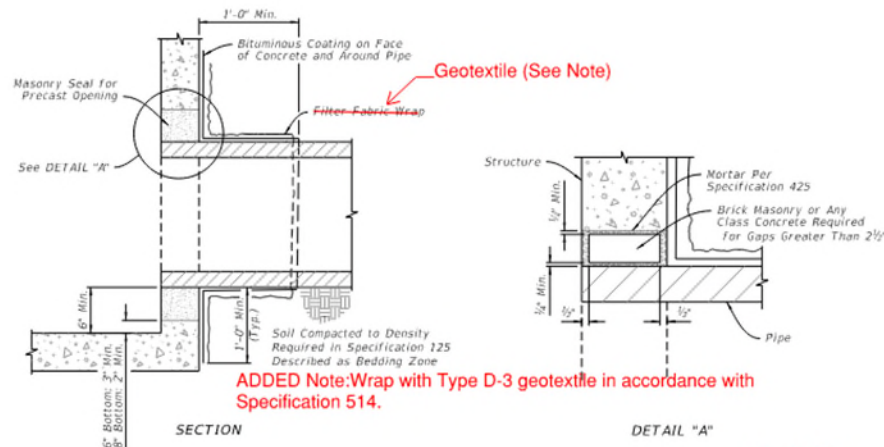

=====**LOCKING GRATES TO INLETS**=====

=====**PIPE TO STRUCTURE FILTER FABRIC WRAP**=====

=====**LOCKING GRATES, SUBGRADE AND BASE TEMPORARY DRAINS, AND PIPE TO STRUCTURE FILTER FABRIC WRAP**=====

- Updated all references of Filter Fabric to Geotextile.
- Updates references pointing to Specification 985 to instead point to Specification 514.
- Add clarification in notes for types of Geotextile.

LAST REVISION	DESCRIPTION:
11/01/20	11/01/23

## Sheet 1: Update Filter Fabric to Geotextile

**GENERAL NOTES:**

1. Use Class II concrete.
2. Chamfer all exposed edges  $\frac{1}{4}$ ".
3. See Index 550-002 for details of Type B fencing.
4. Quantities shown are for estimating purposes only.

Note 5 - Install Type D-2 geotextile in accordance with Specification 514.

TABLE OF CONTENTS:	
Sheet	Description
1	General Notes and Contents
2	Dimensional Details
3	Reinforcing Details and Bedding Diagram

U-TYPE CONCRETE ENDWALLS

- Updated all references of Filter Fabric to Geotextile.
- Updates references pointing to Specification 985 to instead point to Specification 514.
- Add clarification in notes for types of Geotextile.

LAST REVISION	DESCRIPTION:
11/01/21	
11/01/23	


## Sheet 1: Update Filter Fabric to Geotextile

### GENERAL NOTES:


1. Install underdrain pipe that is either 4" smooth or 5" corrugated tubing unless otherwise shown in the Plans. The size to be furnished will be based on the nominal internal diameter of a pipe with a smooth interior wall. Except when prohibited by the Plans, the special provisions or this standard, pipe with a corrugated interior wall may be provided based on the following size equivalency.  
 4" smooth interior equivalent to 5" corrugated interior  
 5" smooth interior equivalent to 6" corrugated interior  
 6" smooth interior equivalent to 8" corrugated interior  
 8" smooth interior equivalent to 10" corrugated interior
2. Fine aggregate is quartz sand meeting the requirements of Specifications 902-4.
3. Coarse aggregate is gravel or stone meeting the requirements of Specification 901-2 or 901-3. The gradation is in accordance with Specifications 901, Grades 4, 467, 5, 56 or 57 stone unless otherwise shown restricted in the Plans.
4. Install Underdrain Type I, II, III and V in accordance with Specification 440.
5. Install filter fabric Type D-3 in accordance with Specifications 985. The internal filter fabric of Type V underdrain has a permittivity of 0.7 /sec. and an AOS of #40 sieve.
6. When Type I is used, use a filter fabric sock in accordance with Specification 948.
7. See Index 120-002 for the standard location of Type I, II, and III underdrain. The location of Type V underdrain and nonstandard locations of Type I, II, and III underdrain will be as detailed in the plans.
8. Install filter fabric joints with a overlap a minimum of 1'. Install the internal filter fabric of Type V underdrain with an overlap into the coarse aggregate or the fine aggregate a minimum of 1'.
9. Use nonperforated pipes for underdrain outlet and make all bends using 1/4 (15 deg.) elbows. Construct 90 deg. bends with two 1/4 elbows separated by at least 1' of straight pipe. Outlet pipes stubbed into inlets or other drainage structures must be a minimum 6" above the structure flow line. Install concrete aprons, hardware cloth, and sod for outlet pipes discharging to grassed areas as shown in Index 446-001 for Edgedrain Outlets.

UPDATED Note 5  
: Install Type D-3 geotextile in accordance with Specification 514.

CHANGED: Geotextile

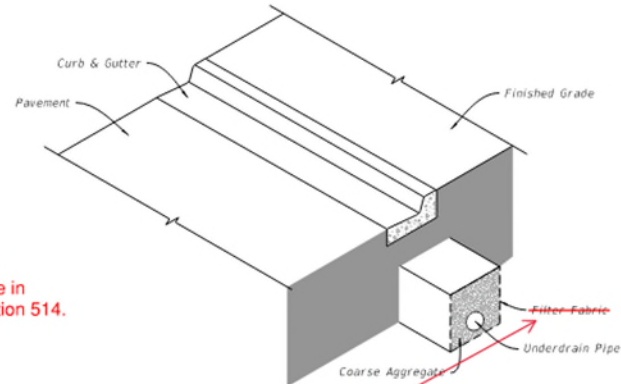

UNDERDRAIN TYPE I, II, AND III ASSEMBLY  
(Type II Shown, Others Similar)

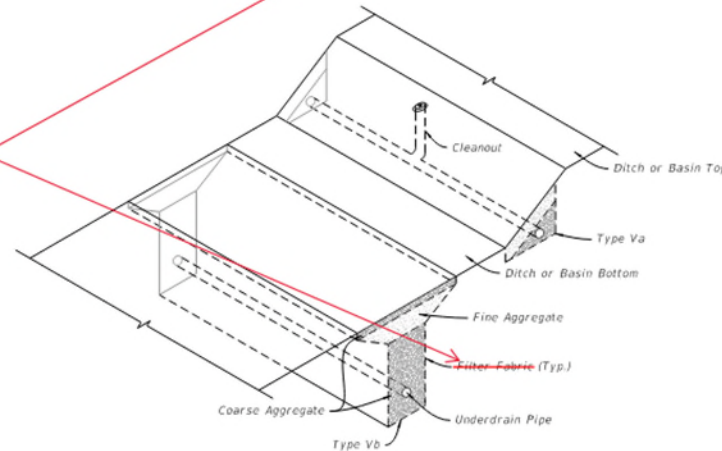

UNDERDRAIN TYPE Va AND Vb ASSEMBLY

TABLE OF CONTENTS:	
Sheet	Description
1	General Notes and Contents
2	Type I, II, and III Underdrains
3	Type Va, Vb, and Cleanout


- Updated all references of Filter Fabric to Geotextile.
- Updates references pointing to Specification 985 to instead point to Specification 514.
- Add clarification in notes for types of Geotextile.



## Standard Plans – Primary Updates:

- 1) ***Index 676-010 – Cabinet Installation Details***
  - Deleted Existing Controller Cabinet details
  - Updated ITS Cabinet
  - **New** - Sheet 4 Ground Mounted Controller Cabinet Riser
  
- 2) ***Index 700-101 – Typical Sections for Placement of Single and Multi-Column Signs***
  - Added retroreflective strip to Wrong Way Driving Sign

## Redlined Sheet 1: Deleted Existing Controller Cabinet

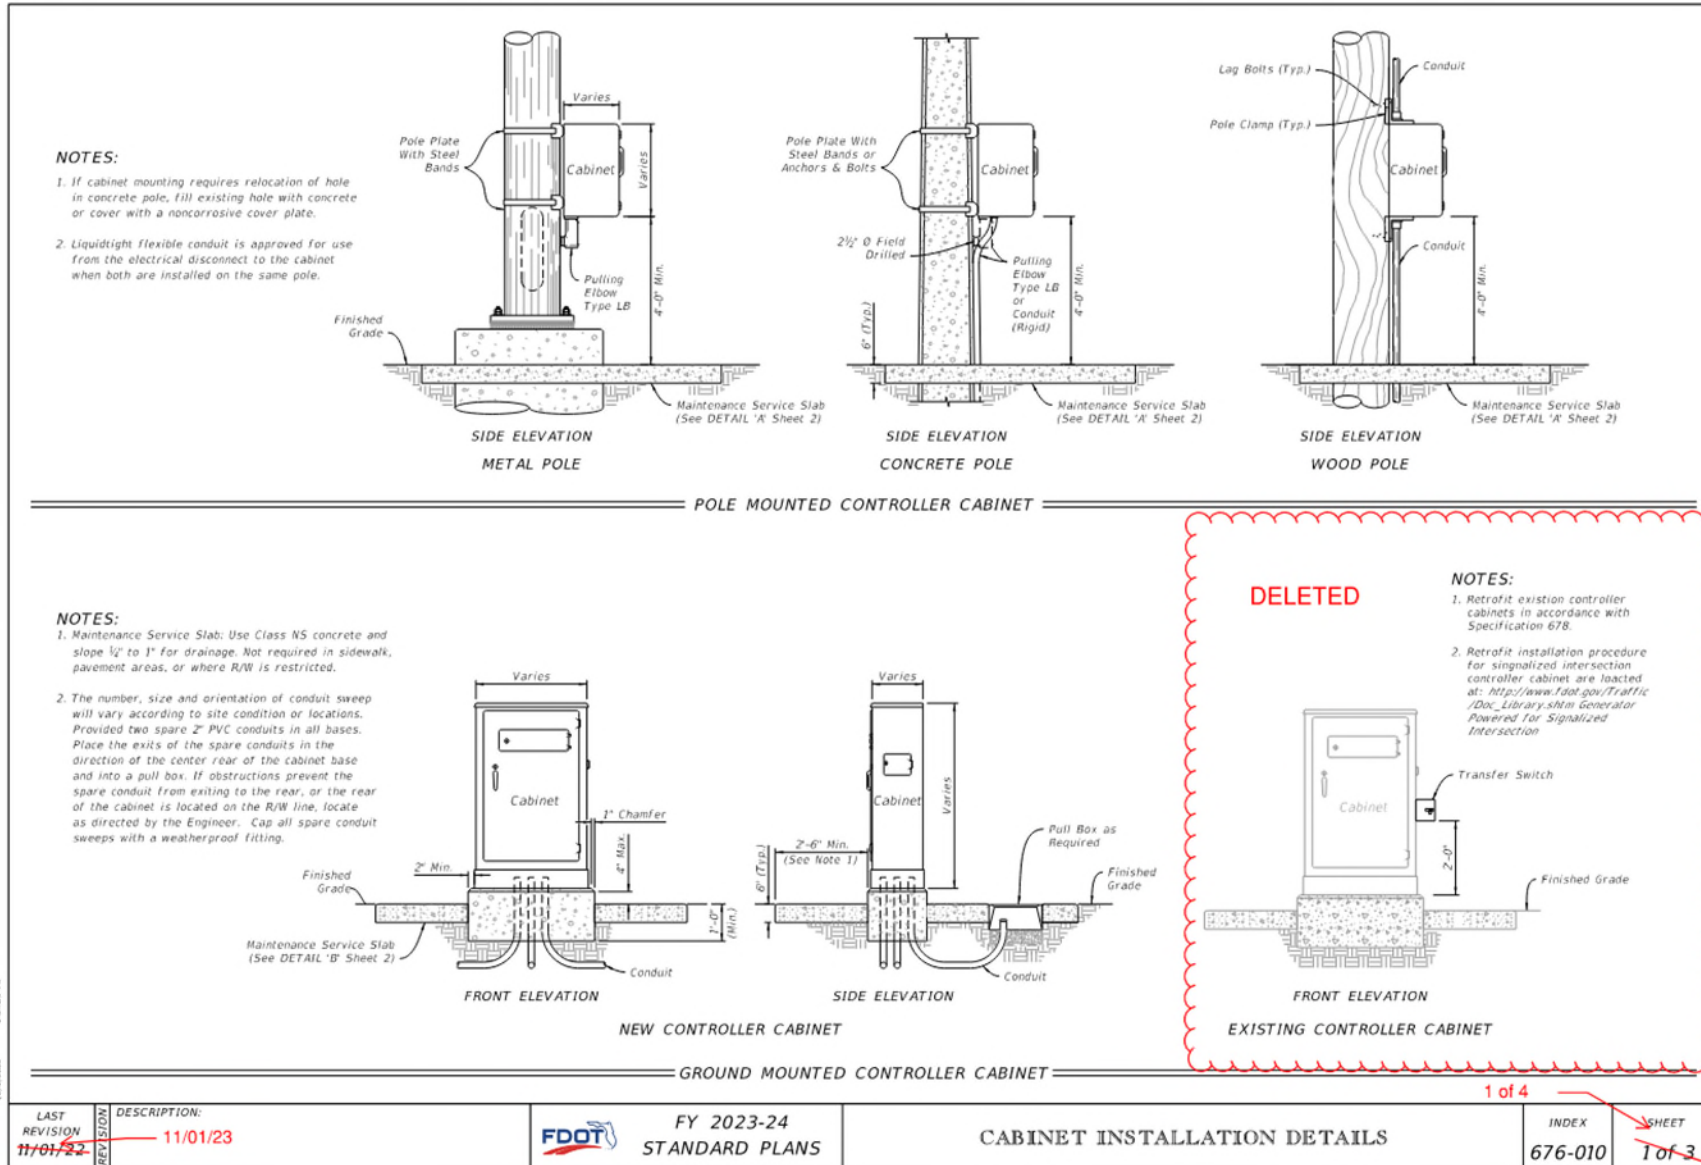

- Deleted Existing Controller Cabinet Detail
- TERL Requested Deletion


LAST REVISION	DESCRIPTION:
11/01/22	11/01/23

## Updated Sheet 1: Deleted Existing Controller Cabinet Details

- Deleted Existing Controller Cabinet Detail
- TERL Requested Deletion

**NOTES:**


- If cabinet mounting requires relocation of hole in concrete pole, fill existing hole with concrete or cover with a noncorrosive cover plate.
- Liquidtight flexible conduit is approved for use from the electrical disconnect to the cabinet when both are installed on the same pole.

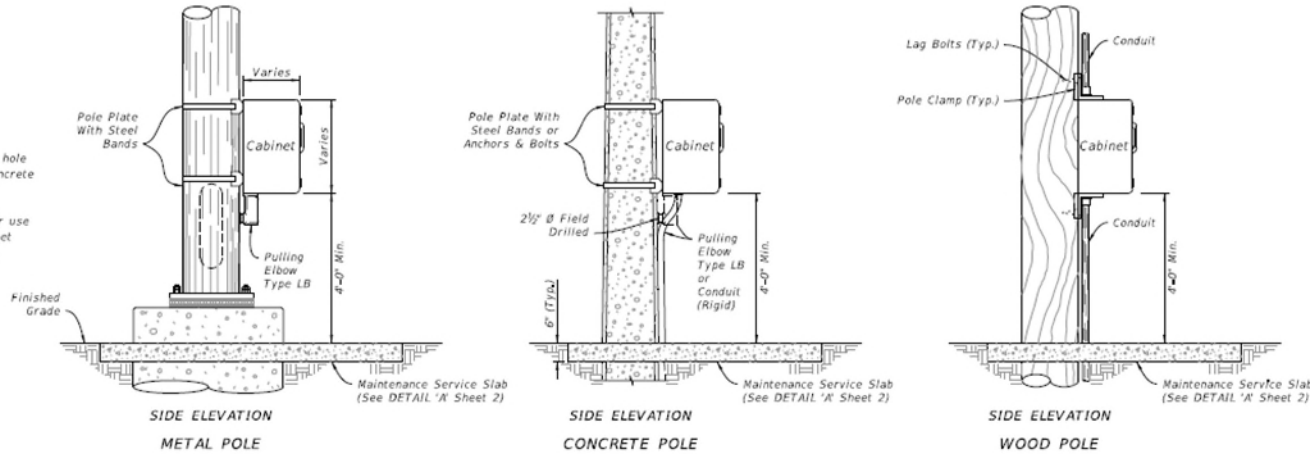

POLE MOUNTED CONTROLLER CABINET

**NOTES:**

- Maintenance Service Slab: Use Class NS concrete and slope 1/2" to 1" for drainage. Not required in sidewalk, pavement areas, or where R/W is restricted.
- The number, size and orientation of conduit sweep will vary according to site condition or locations. Provide two spare 2" PVC conduits in all bases. Place the exits of the spare conduits in the direction of the center rear of the cabinet base and into a pull box. If obstructions prevent the spare conduit from exiting to the rear, or the rear of the cabinet is located on the R/W line, locate as directed by the Engineer. Cap all spare conduit sweeps with a weatherproof fitting.

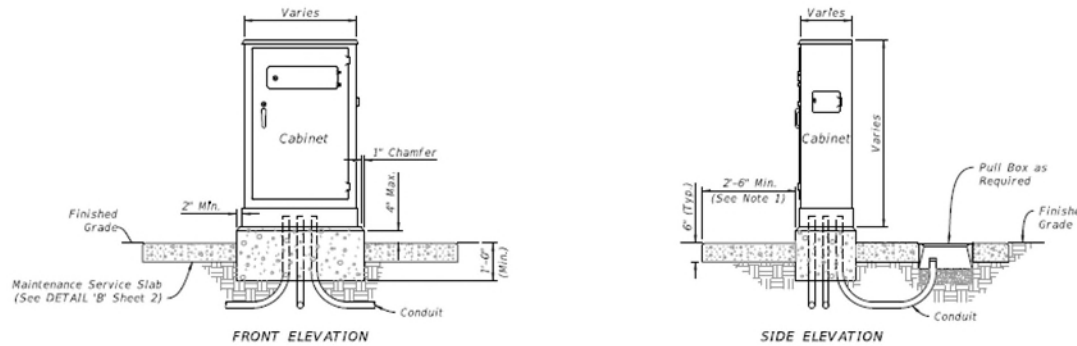

NEW CONTROLLER CABINET

GROUND MOUNTED CONTROLLER CABINET


10/10/2023 2:30:00 PM

## Redlined Sheet 2: Updated ITS Cabinet Detail

- Update Metal Pole Cabinet Brackets

**NOTES:**


- Maintenance Service Slab: Use Class NS concrete and slope 1/4" to 1" for drainage. Not required in sidewalk, pavement areas, or where R/W is restricted.
- If cabinet mounting requires relocation of hole in concrete pole, fill existing hole with concrete or cover with a noncorrosive cover plate.
- Liquidtight Flexible conduit is approved for use from the electrical disconnect to the cabinet when both are installed on the same pole.
- When a pull box is to be placed within the maintenance service slab, the slab width must be extended to provide for the required pull box concrete apron as detailed in Index 635-001.
- Coordinate placement of maintenance service slab with proposed final grade. Grade and compact side slopes around the maintenance service slab to provide a stable and level working area and tie into the proposed embankment.

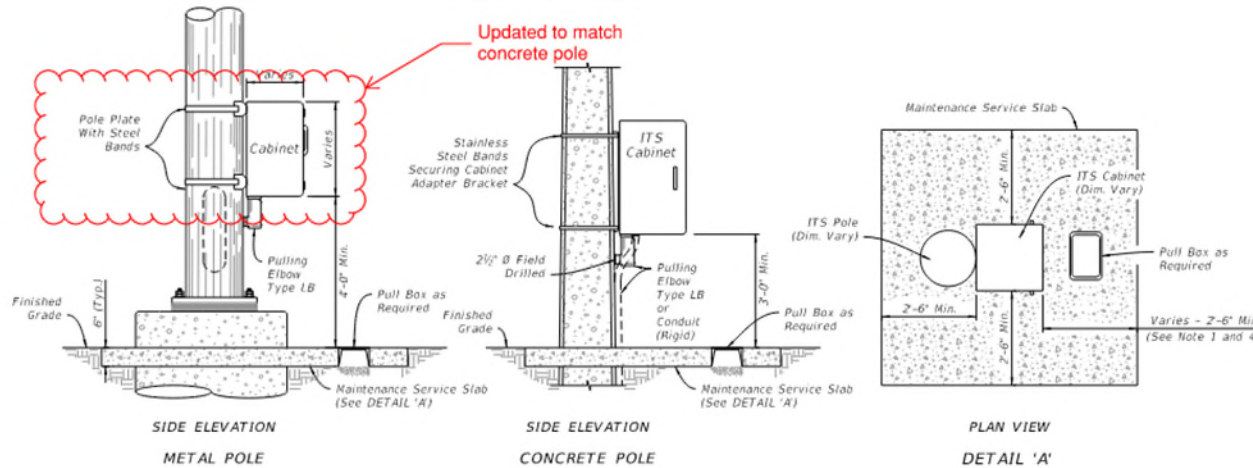

POLE MOUNTED INTELLIGENT TRANSPORTATION SYSTEMS (ITS) CABINET

**NOTES:**

- Maintenance Service Slab: Use Class NS concrete and slope 1/4" to 1" for drainage. Not required in sidewalk, pavement areas, or where R/W is restricted.
- The number, size and orientation of conduit sweep will vary according to site condition or locations. Provided two spare 2" PVC conduits in all bases. Place the exits of the spare conduits in the direction of the center rear of the cabinet base and into a pull box. If obstructions prevent the spare conduit from exiting to the rear, or the rear of the cabinet is located on the R/W line, locate as directed by the Engineer. Cap all spare conduit sweeps with a weatherproof fitting.
- When a pull box is to be placed within the maintenance service slab, the slab width must be extended to provide for the required pull box apron as detailed in Index 635-001.
- Coordinate placement of maintenance service slab with proposed final grade. Grade and compact side slopes around the maintenance service slab to provide a stable and level working area and tie into the proposed embankment.

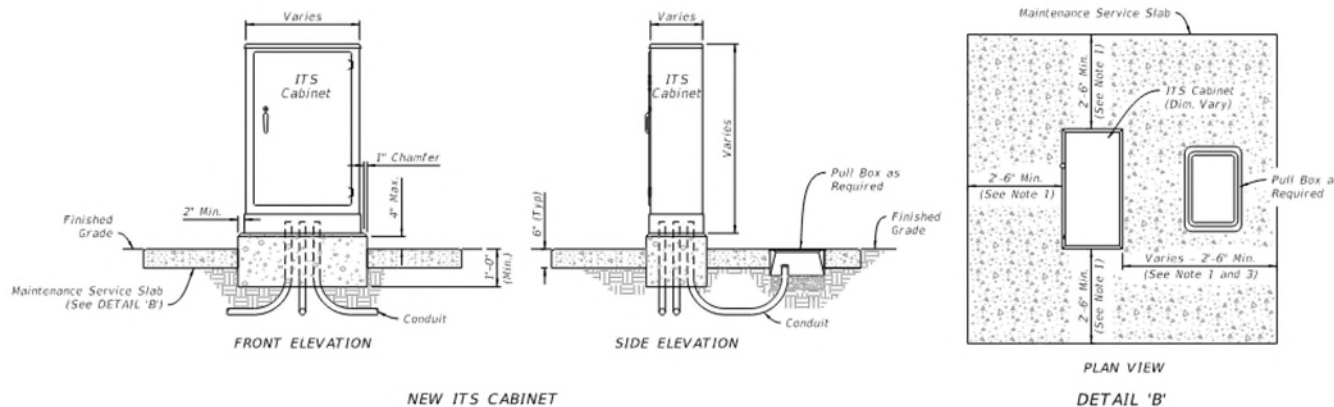


GROUND MOUNTED INTELLIGENT TRANSPORTATION SYSTEMS (ITS) CABINET

LAST REVISION	DESCRIPTION
11/01/22	11/01/23

## Updated Sheet 2: Updated ITS Cabinet Detail

**NOTES:**


1. Maintenance Service Slab: Use Class NS concrete and slope  $\frac{1}{4}$ " to 1" for drainage. Not required in sidewalk, pavement areas, or where R/W Ts restricted.
2. If cabinet mounting requires relocation of hole in concrete pole, fill existing hole with concrete or cover with a noncorrosive cover plate.
3. Liquidtight flexible conduit is approved for use from the electrical disconnect to the cabinet when both are installed on the same pole.
4. Where a pull box is to be placed within the maintenance service slab, the slab width must be extended to provide for the required pull box concrete apron as detailed in Index 635-001.
5. Coordinate placement of maintenance service slab with proposed final grade. Grade and compact side slopes around the maintenance service slab to provide a stable and level working area and tie into the proposed embankment.

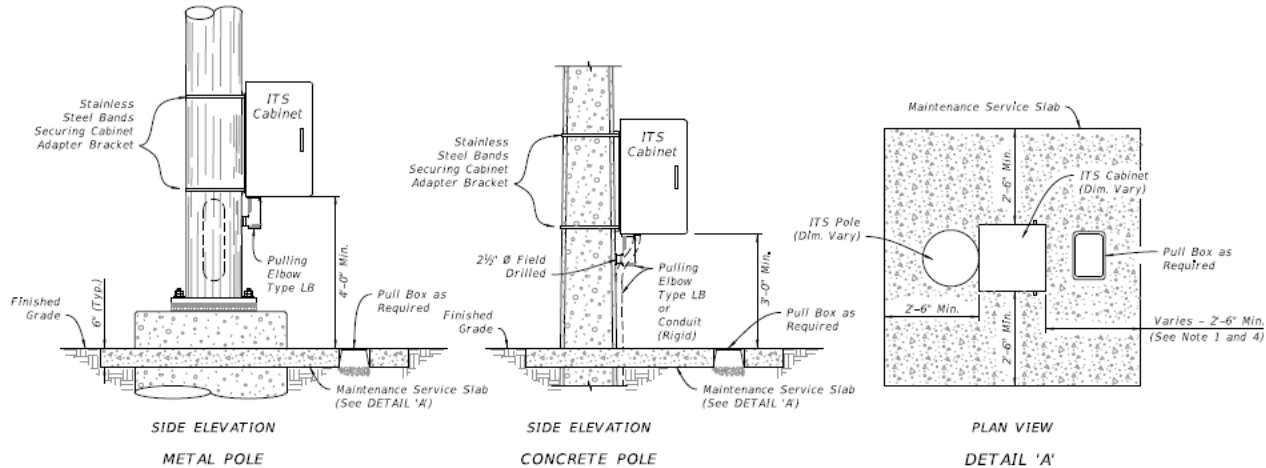

POLE MOUNTED INTELLIGENT TRANSPORTATION SYSTEMS (ITS) CABINET

**NOTES:**

1. Maintenance Service Slab: Use Class NS concrete and slope  $\frac{1}{4}$ " to 1" for drainage. Not required in sidewalk, pavement areas, or where R/W Ts restricted.
2. The number, size and orientation of conduit sweep will vary according to site condition or locations. Provide two spare 2" PVC conduits in all bases. Place the exits of the spare conduits in the direction of the center rear of the cabinet base and into a pull box. If obstructions prevent the spare conduit from exiting to the rear, or the rear of the cabinet is located on the R/W line, locate as directed by the Engineer. Cap all spare conduit sweeps with a weatherproof fitting.
3. When a pull box is to be placed within the maintenance service slab, the slab width must be extended to provide for the required pull box apron as detailed in Index 635-001.
4. Coordinate placement of maintenance service slab with proposed final grade. Grade and compact side slopes around the maintenance service slab to provide a stable and level working area and tie into the proposed embankment.

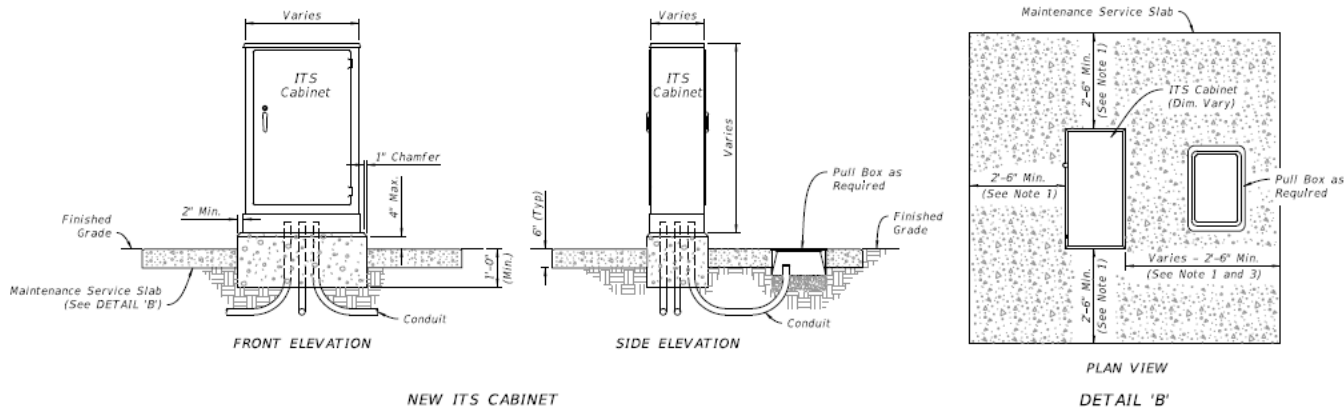

GROUND MOUNTED INTELLIGENT TRANSPORTATION SYSTEMS (ITS) CABINET


- Update Metal Pole Cabinet Brackets

10/12/2023 2:32:38 PM

LAST REVISION 11/01/23	DESCRIPTION:	FDOT FY 2024-25 STANDARD PLANS	CABINET INSTALLATION DETAILS	INDEX 676-010	SHEET 2 of 4
---------------------------	--------------	--------------------------------------	------------------------------	------------------	-----------------



## Sheet 4: NEW SHEET – Ground Mounted Controller Cabinet Riser

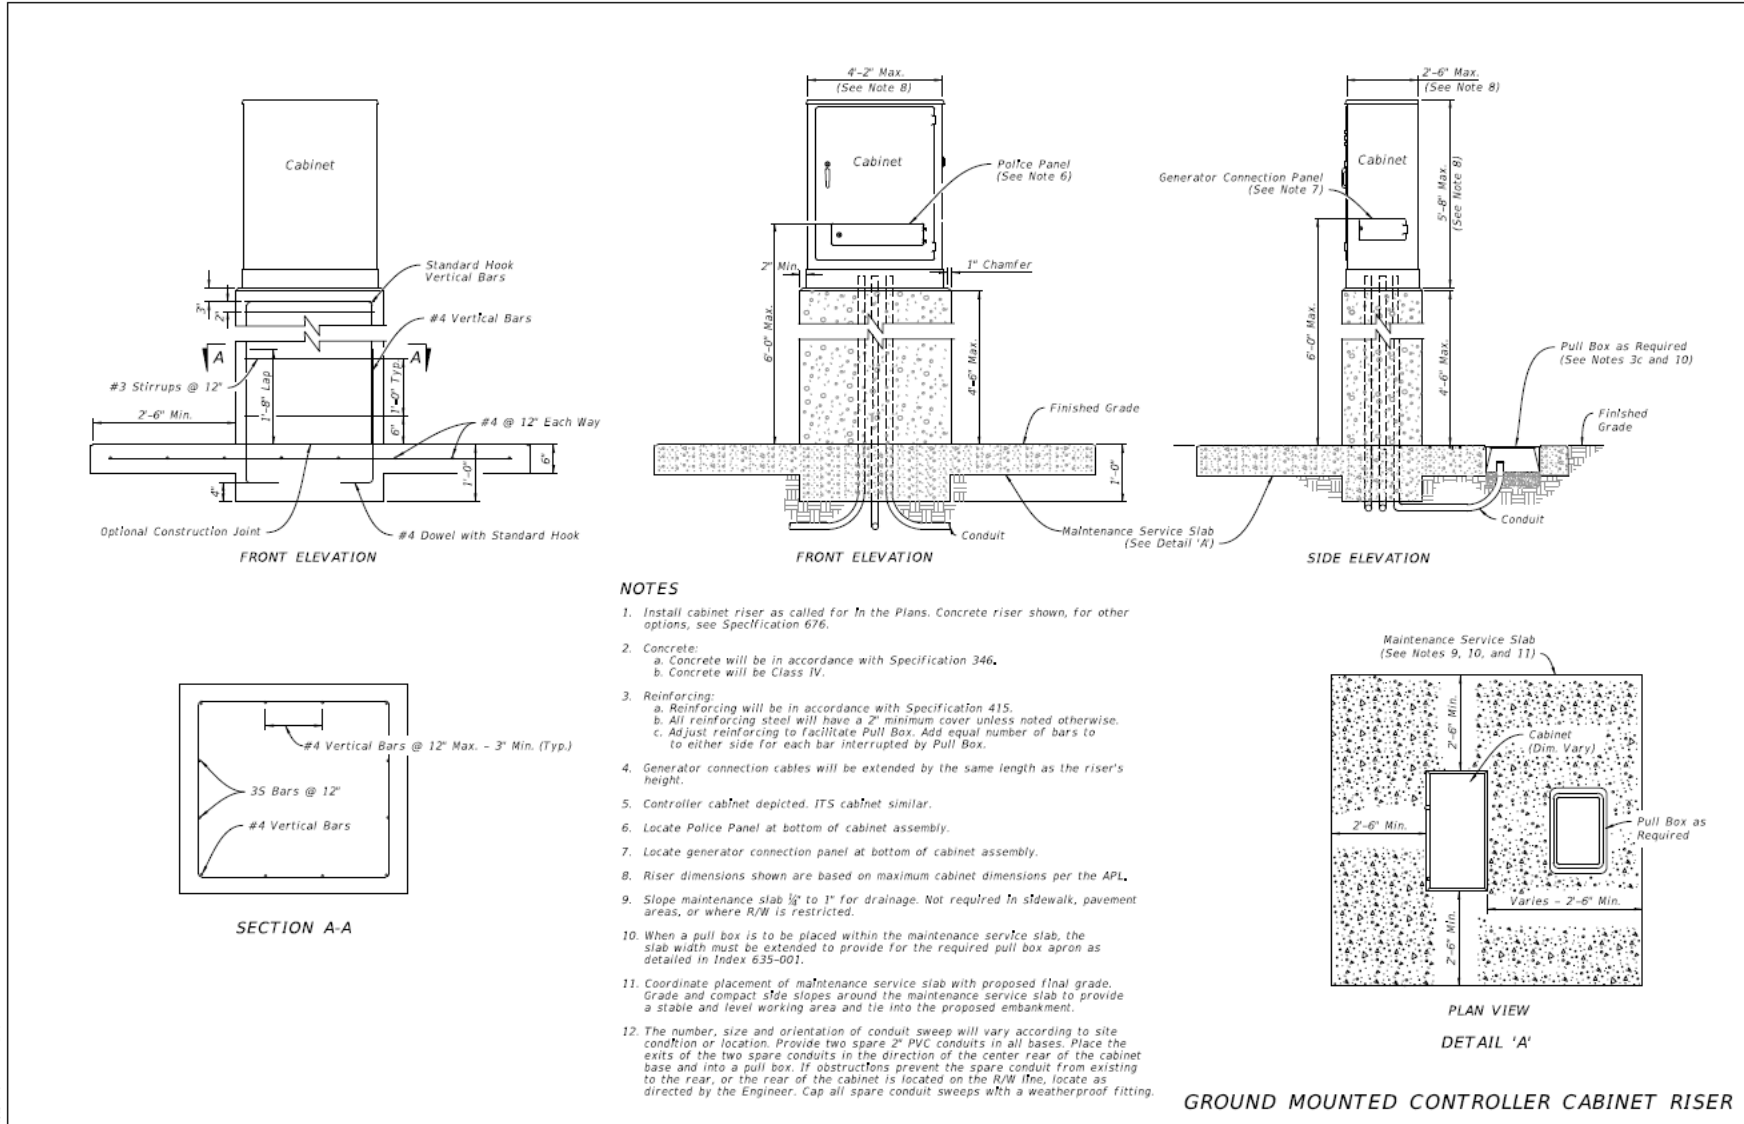


- **New Cabinet Risers**

- **Districts Requested Standard Detail for Riser**

- **Associated Specification 676 Revision**



## Redline Sheet 1: Retroreflective Strip Case X

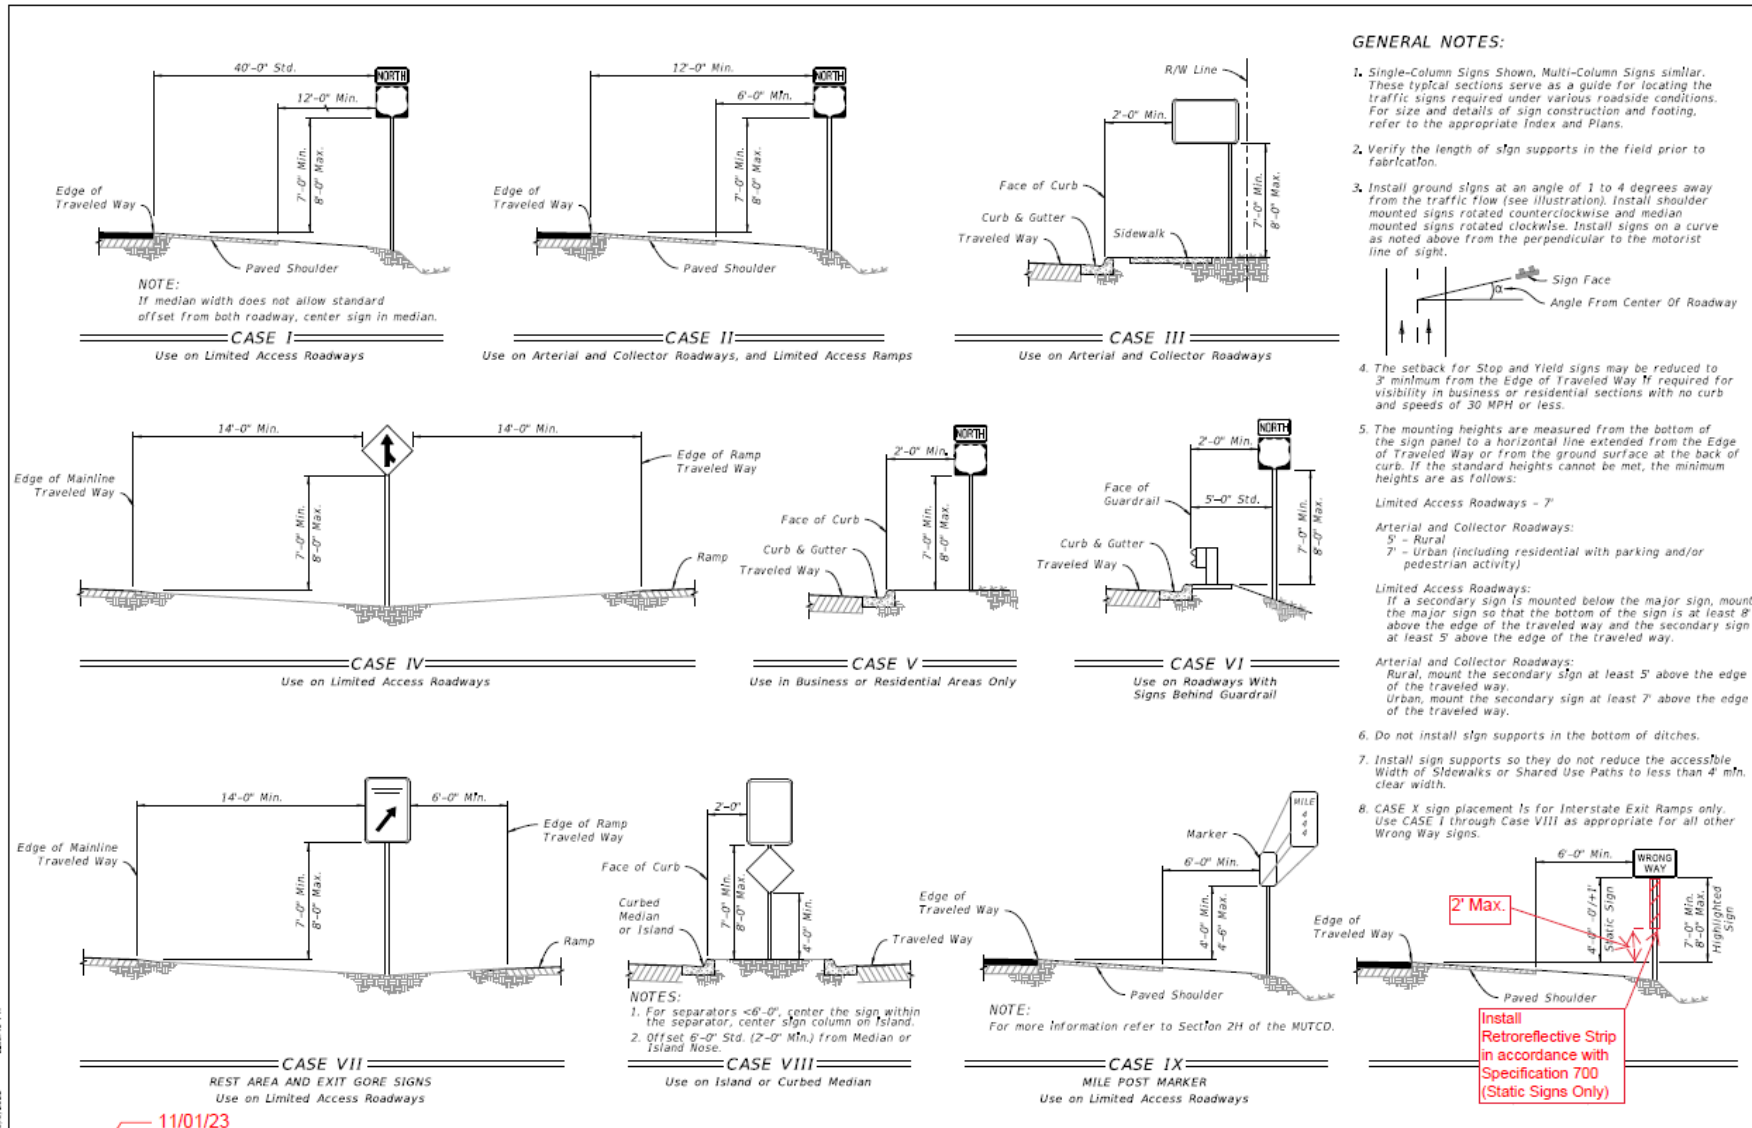


- Updated Case X
- Retroreflective Strip required per FDM 230.4
- Static WWD Sign ONLY
- Standard Specification 700 updated

10/16/2022 2:28:42 PM

LAST REVISION 11/01/23	DESCRIPTION: 11/01/23	FDOT FY 2023-24 STANDARD PLANS	TYPICAL SECTIONS FOR PLACEMENT OF SINGLE AND MULTI-COLUMN SIGNS	INDEX 700-101	SHEET 1 of 1
---------------------------	--------------------------	--------------------------------------	--	------------------	-----------------

## Updated Sheet 1: Retroreflective Strip Case X

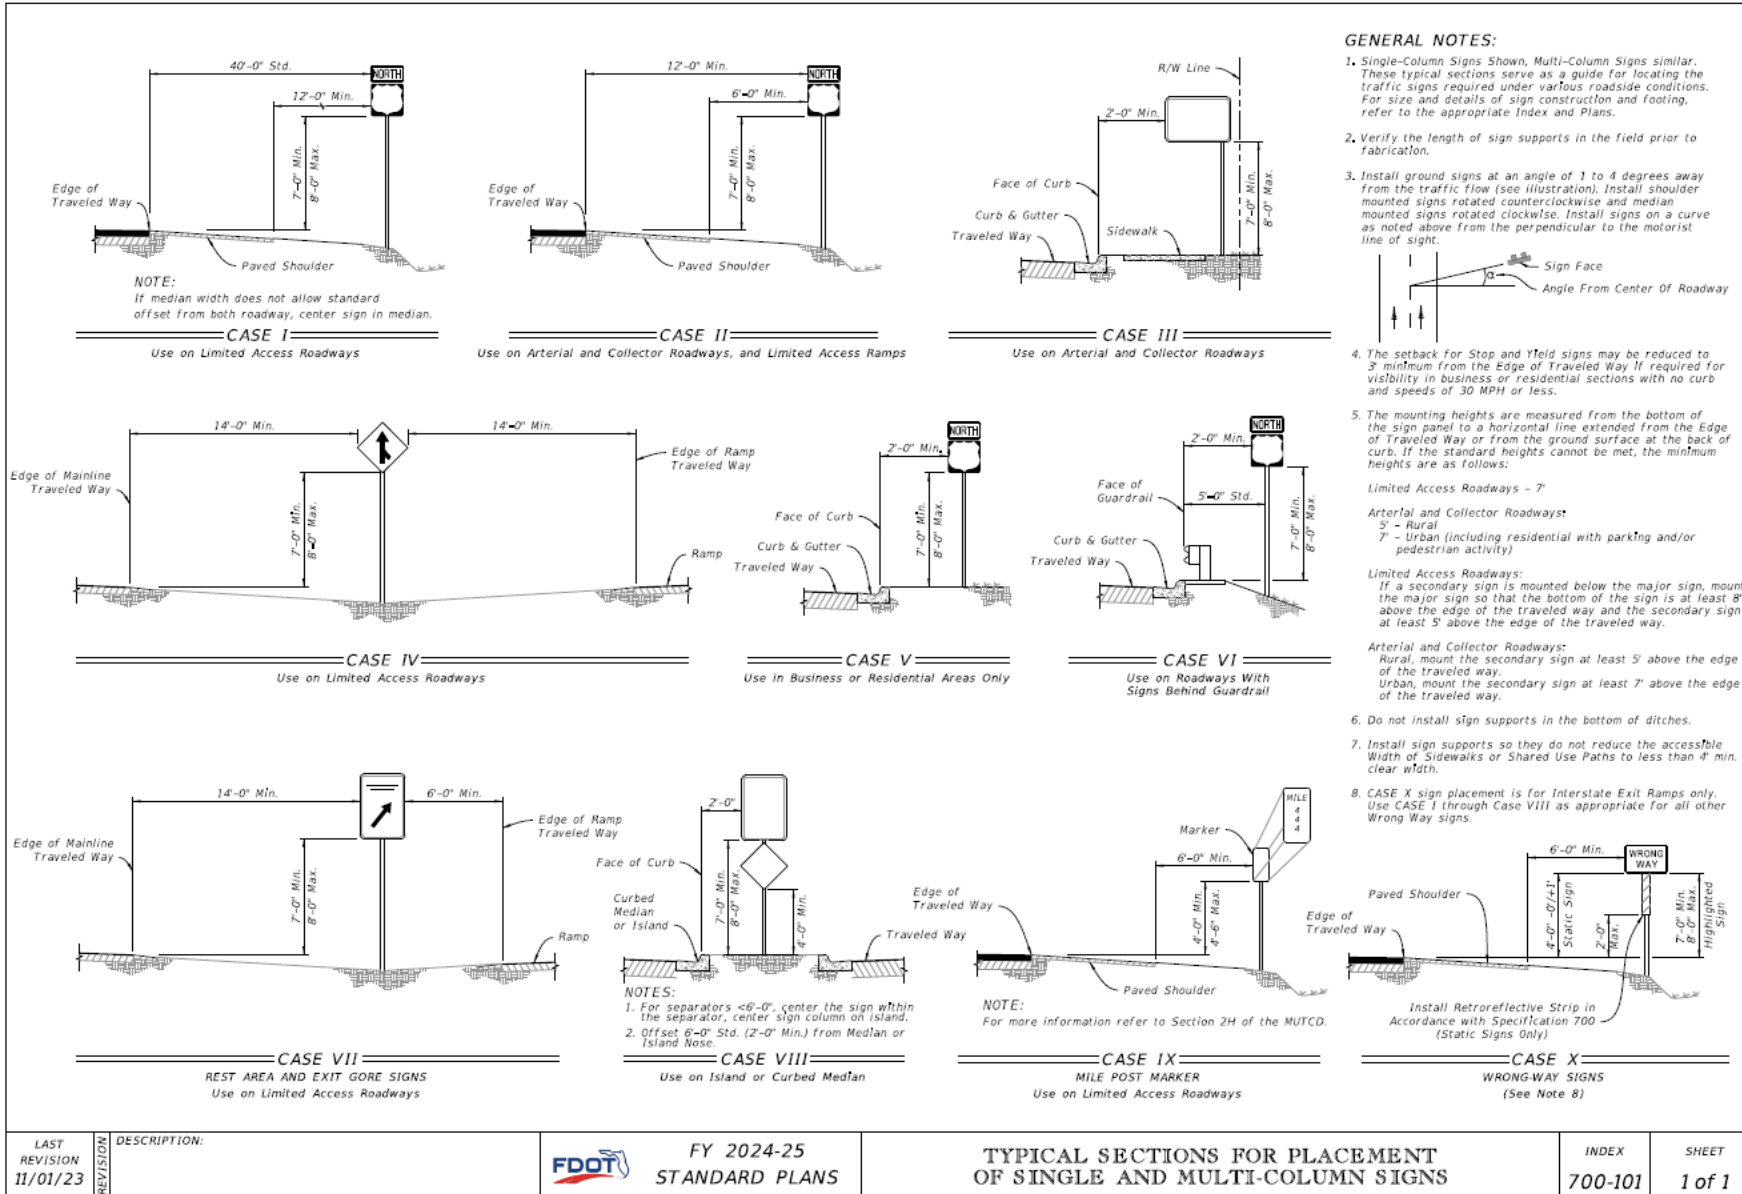

- Updated Case X
- Retroreflective Strip required per FDM 230.4
- Static WWD Sign ONLY
- Standard Specification 700 updated

3/18/24 PM

LAST REVISION 11/01/23	DESCRIPTION:	FDOT FY 2024-25 STANDARD PLANS	TYPICAL SECTIONS FOR PLACEMENT OF SINGLE AND MULTI-COLUMN SIGNS	INDEX 700-101	SHEET 1 of 1
---------------------------	--------------	--------------------------------------	---	------------------	-----------------

# Contact Us:



Shae Gibbs

(850)414-4314

[Shae.gibbs@dot.state.fl.us](mailto:Shae.gibbs@dot.state.fl.us)

# FY 2024-25 Standard Plans Update Training

Richard Stepp, P.E.  
Standard Plans Engineer  
Central Office, Roadway Design Office  
[richard.stepp@dot.state.fl.us](mailto:richard.stepp@dot.state.fl.us)



## Standard Plans – Primary Updates:

- 1) **Index 521-001 – Concrete Barrier**
  - *Added “Shoulder Rocking” compatibility*
- 2) **Index 536-001 – Guardrail**
  - ***New** Sheet 21 - Bridge trailing curb options*
  - *Revised washer usage – new exclusions*
- 3) **Index 639-001 – Service Point Details**
  - ***New** taller concrete service pole option*
- 4) **Index 715 Series - Lighting**
  - *Revised access door location in pole base*
  - ***New** precast shaft foundation option*
  - *Added structural grout pad details for spread footing option*
- 5) **Index D635-005 – Fiber Optic Splice Vault**
  - ***New** – Standardized for Turnpike Usage*






## Standard Plans – Primary Updates:

- ➔ 1) ***Index 521-001 – Concrete Barrier***
- *Added “Shoulder Rocking” compatibility*




## Sheet 2: Median Barrier – Added Shoulder Rocking

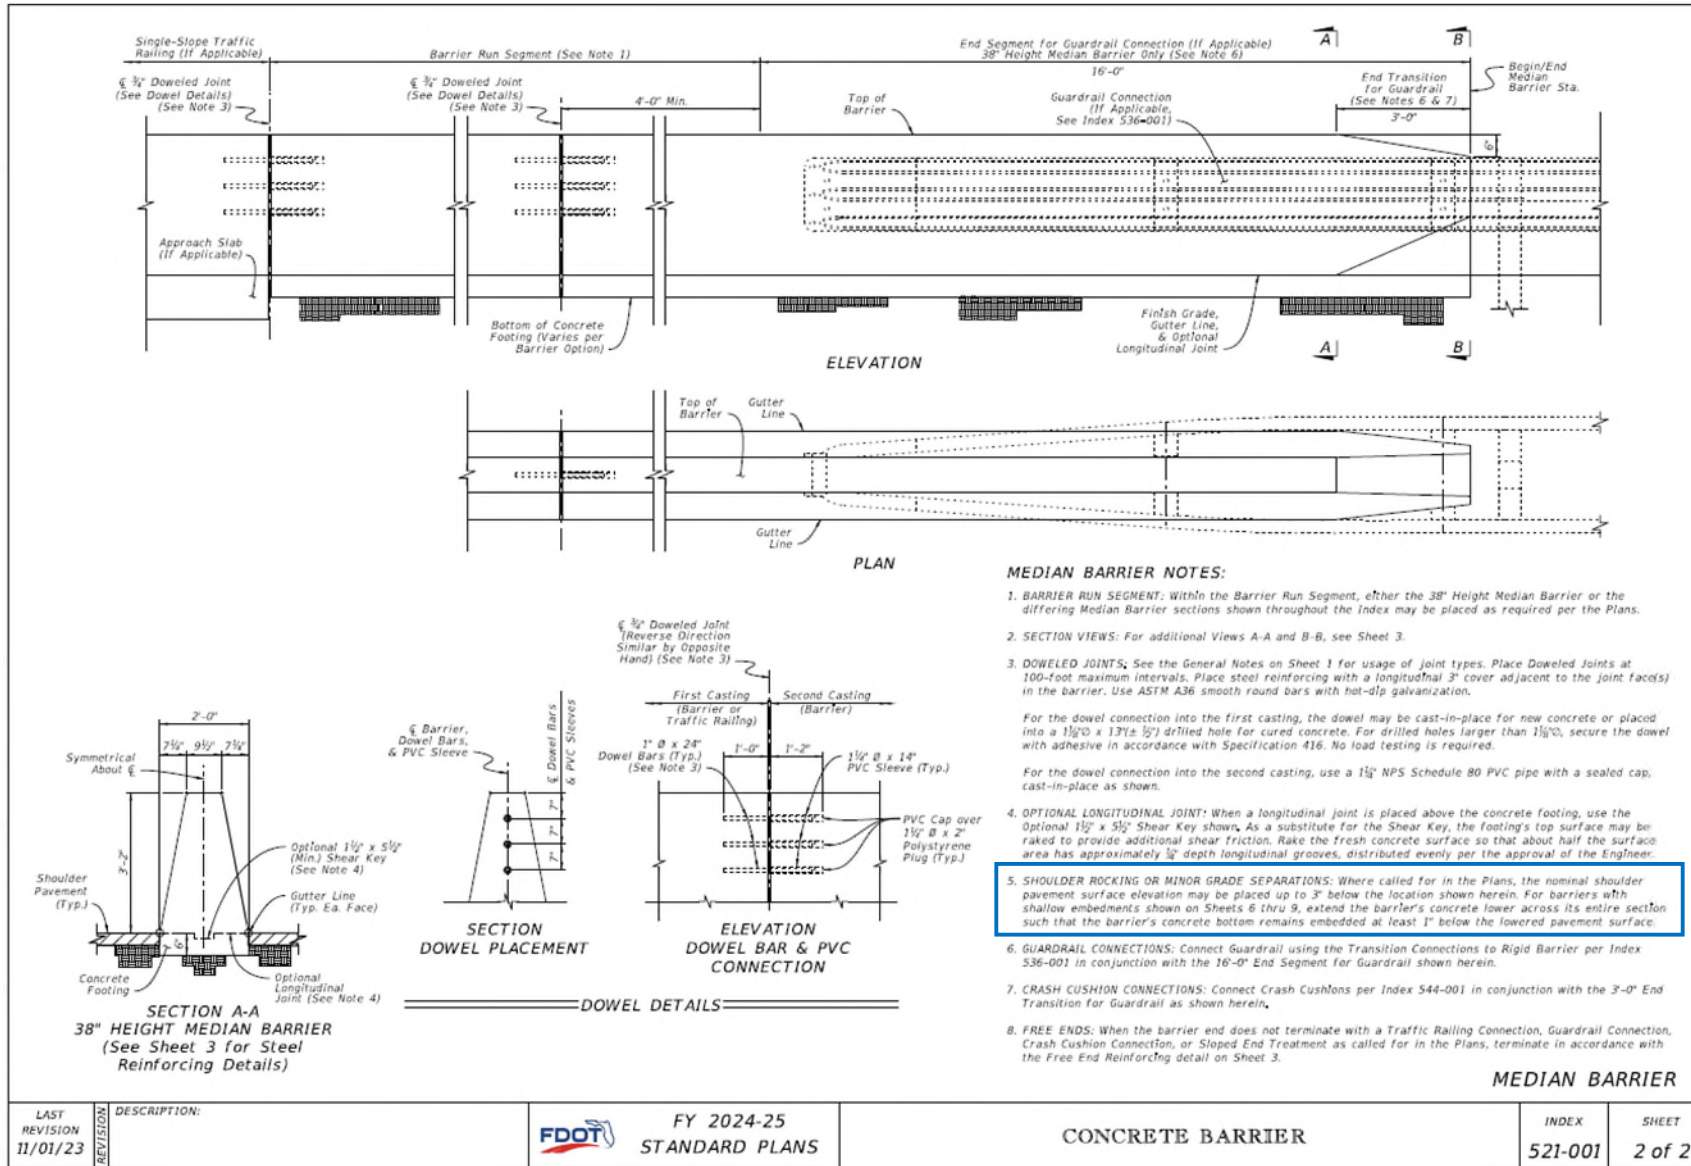

- **Revised Note 5:**  
**Shoulder Rocking or Minor Grade Separations**
- Pavement surface elevation may be placed up to 3" below what is shown in the Standard Plans


## Sheet 2: Median Barrier – Added Shoulder Rocking

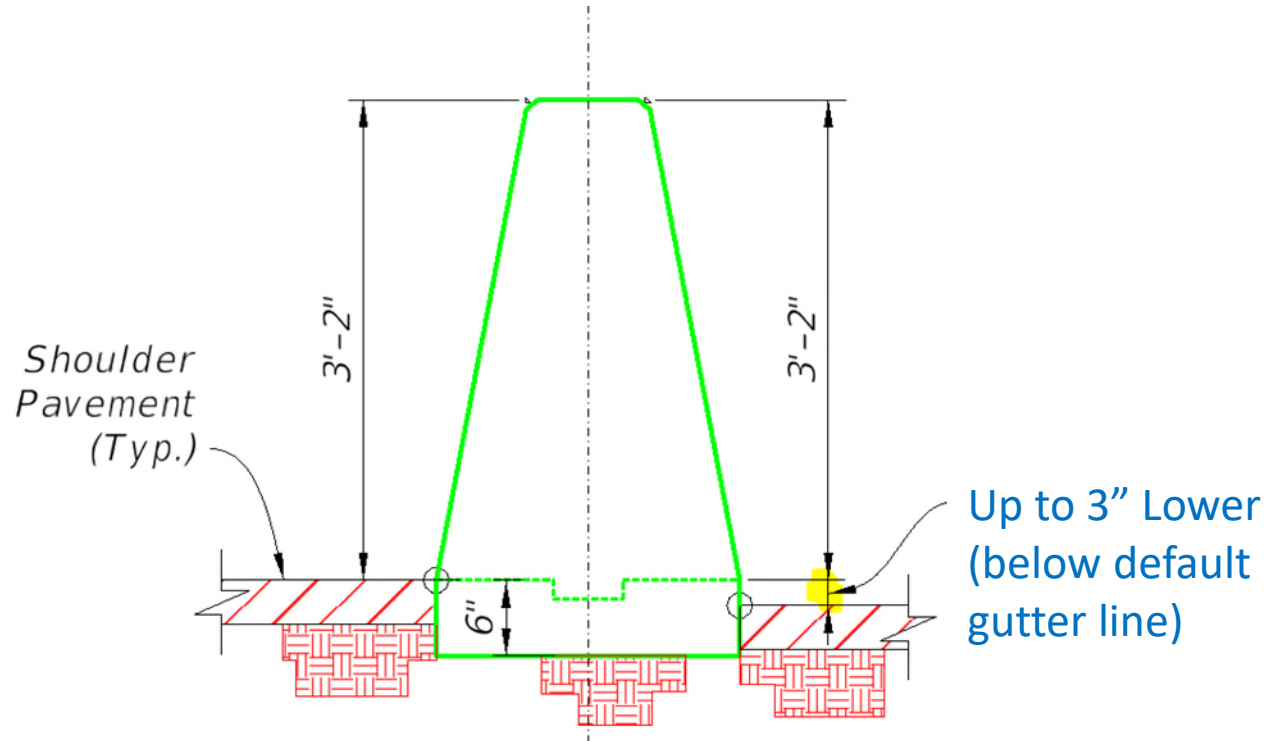

**38" HEIGHT MEDIAN BARRIER**  
(Reinforcing Not Shown)

- **Revised Note 5:**  
**Shoulder Rocking or**  
**Minor Grade Separations**
- Pavement surface elevation may be placed up to 3" below what is shown in the Standard Plans

## Sheet 2: Median Barrier – Added Shoulder Rocking

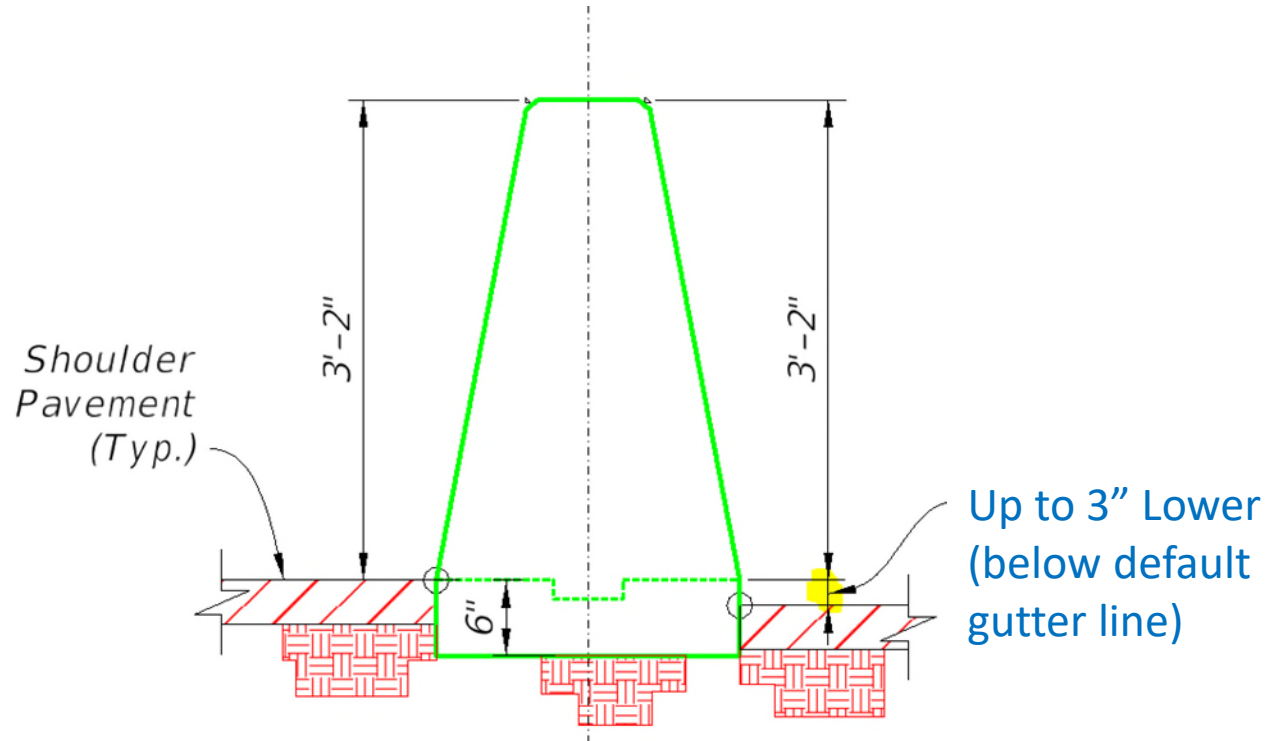

38" HEIGHT MEDIAN BARRIER  
(Reinforcing Not Shown)

- **Revised Note 5:**  
**Shoulder Rocking or Minor Grade Separations**
- **New** Shoulder Rocking Policy and Plans Content Requirements Shown in:
  - **FDM 211.4.2.1**
  - **FDM 915.3.5.1**
  - **SPI 521-001, Part J**

## Standard Plans – Primary Updates:

1) ***Index 521-001 – Concrete Barrier***

- *Added “Shoulder Rocking” compatibility*



2) ***Index 536-001 – Guardrail***

- ***New*** - *Sheet 21 - Bridge trailing curb options*
- *Revised washer usage – new exclusions*





## Sheet 1: Contents and General Notes



SHEET	CONTENTS
1	General Notes; Index Contents
2	General, TL-3 Guardrail - Installed Plan and Elevation
3	Low-Speed, TL-2 Guardrail - Installed Plan and Elevation
4	W-Beam and Thrie-Beam Panel Details
5	Post and Offset Block Details
6	Guardrail Sections - Heights and Adjacent Slopes
7	End Treatment - Approach Terminal Geometry, Parallel
8	End Treatment - Approach Terminal Geometry, Curbed and Double Faced
9	End Treatment - Trailing Anchorage
10	End Treatment - Component Details
11	End Treatment - Controlled Release Terminal (CRT) System
12	Layout for CRT System - Side Roads and Driveways
13	Approach Transition Connection to Rigid Barrier - General, TL-3
14	Approach Transition Connection to Rigid Barrier - General, TL-3 - Curb Connections
15	Approach Transition Connection to Rigid Barrier - Low-Speed, TL-2
16	Approach Transition Connection to Rigid Barrier - Low-Speed, TL-2 - Curb Connections
17	Approach Transition Connection to Rigid Barrier - Details
18	Approach Transition Connection to Rigid Barrier - Double Faced Guardrail
19	Layout to Rigid Barrier - Approach Ends Layout to Rigid Barrier - Approach Ends with Double Faced Guardrail
20	Layout to Rigid Barrier - Trailing Ends Trailing End Transition Connection to Rigid Barrier
21	Trailing End Transition Connection to Rigid Barrier - Curb Connections
22	Rub Rail Details
23	Pedestrian Safety Treatment - Pipe Rail Modified Mount - Special Steel Post for Concrete Structure Mount; Modified Mount - Encased Post for Shallow Mount; Modified Mount - Frangible Leave-Out for Concrete Surface Mount
24	Barrier Delineators - Post Mounted; Clear Space - Reduced Post Spacing for Hazards; 3/8" Button-Head Bolt System
25	

### GENERAL NOTES:

- INSTALLATION:** Construct guardrail in accordance with Specification 536.  
  
*This Index, along with the plans and the manufacturers' drawings on the Approved Products List (APL), is sufficiently detailed for installation of General Guardrail, Low-Speed Guardrail, End Treatment assemblies, and their connecting options shown herein. This precludes requirements for shop drawing submittals unless otherwise specified in the plans.*
- COMPATIBILITY:** The General Guardrail in this Index is based on the Midwest Guardrail System (MGS) design, with an approximate height of 31" at the top of the Panel (2"-1" mounting height at vertical  $\xi$  of Panel) and a midspan panel splice as shown on Sheet 2. Guardrail components included on the APL, which are compatible with this Index, may also be identified as 31" or MGS Guardrail.
- STANDARD COMPONENTS:** Standard guardrail components, including posts, panels, and bolt systems, are based on the Task Force 13 Publication: Guide to Roadside Hardware Components (<http://tf13.org/Guides/componentGuide/>).
- BUTTON-HEAD BOLTS:** Install Button-Head Bolts where indicated using bolts, nuts, and washers as defined on Sheet 25. Place washers under nuts against timber posts. Washers are not required at steel post flanges and panel lap splices. Do not place washers between bolt heads and panels, except where otherwise shown in this Index.
- HEX-HEAD BOLTS:** Install Hex-Head Bolts where indicated using bolts, nuts, and washers in accordance with material properties of Specification 967. Place washers under nuts.
- MISCELLANEOUS ASPHALT PAVEMENT:** Install Miscellaneous Asphalt Pavement where indicated with a tolerance of  $\pm 1/2$ " depth and in accordance with Specification 339.
- ADJACENT SIDEWALKS & SHARED USE PATHS:** When guardrail posts are placed within 4'-0" of a sidewalk or shared use path, use timber posts, or use steel posts only if treated with Pipe Rail as shown on Sheet 23.  
  
*When timber posts are used, one of the following safety treatments is required for the bolt(s) protruding from the back face of the posts:*
  - After tightening the nut, trim the protruding post bolt flush with the nut and galvanize per Specification 562.
  - Use post bolts 15" in length and countersink the washer and nut between 1" and 1 1/2" deep into the back face of the post.
  - Use 15" post bolts with sleeve nuts and washers.  
*When End Treatment posts are within 4'-0" of a sidewalk or shared use path, steel posts are not permitted within the End Treatment segment. Terminate the Pipe Rail outside of End Treatment segments, as noted per Sheet 23.*
- NESTED W-BEAM:** Where called for in the plans, install two W-Beam Panels mounted flush per location, securing all panels with Button-Head Bolts threaded through aligned slots and holes. 2" Button-Head Bolts are permitted for panel splice locations.
- CONNECTION TO RIGID BARRIER:** The connections to Rigid Barrier in this Index only apply to newly constructed bridge Traffic Railing and Concrete Barrier or where the complete Approach Transition Connection to Rigid Barrier shown herein can be installed without conflicting with existing Traffic Railings, structures, or approach slabs.  
  
*For connecting guardrail to existing bridge Traffic Railings, see Indexes 536-002, 521-404, and 521-405.*
- CONNECTION TO EXISTING GUARDRAIL:** Where a transition to existing guardrail at 27" height is required, linearly transition the new guardrail height over a distance ranging from 25'-0" to 31'-3". Height transitions must occur outside of End Treatment and Approach Transition segments.  
  
*Provide an immediate transition to the required midspan panel splice using the available panel options on Sheet 4 (9'-4 1/2' or 15'-7 1/2' panel). Alternatively, this transition to midspan panel splice may be achieved by installing a single reduced post spacing of 3'- 1 1/2' within the new guardrail, immediately adjacent to the connection location.*
- PLANS CALLOUTS:** Begin/End Station labels are shown throughout this Index as they correspond to the station and offset callouts specified in the plans.  
  
*In the plans, Begin/End Guardrail Station refers to the General TL-3 Guardrail Pay Item, and it may be abbreviated as Begin/End GR Station. Where the Low-Speed TL-2 Guardrail Pay Item is specifically required, the callout in the plans will then specify Begin/End TL-2 GR Station.*
- QUANTITY MEASUREMENT:** Measure guardrail and corresponding components as defined in Specification 536. The Guardrail length is measured along the centerline of installed Panels, between the points labeled Begin/End Guardrail Station shown on the following Index Sheets and defined in the plans (typically measured from the  $\xi$  of the panel's post bolt slots at the approach/trailing ends).

- Revised Note 4:  
Washer Requirements  
 Washers now optional against steel flanges. Also, not used a panel splices (Big Contractor Ask!)
- New Sheet 21:  
Trailing End Transition Connection to Rigid Barrier: Curb Connection Options

## Sheet 20: Layout to Rigid Barriers, Trailing Ends

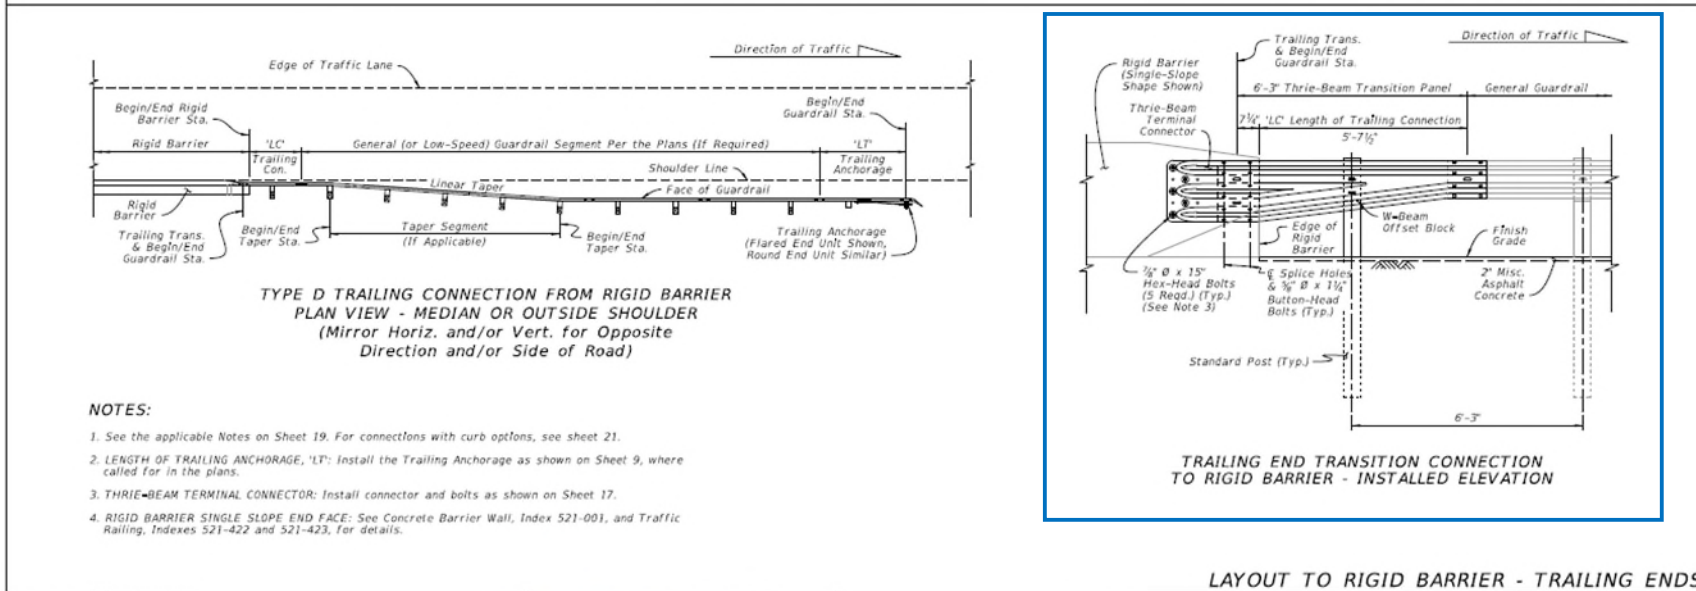
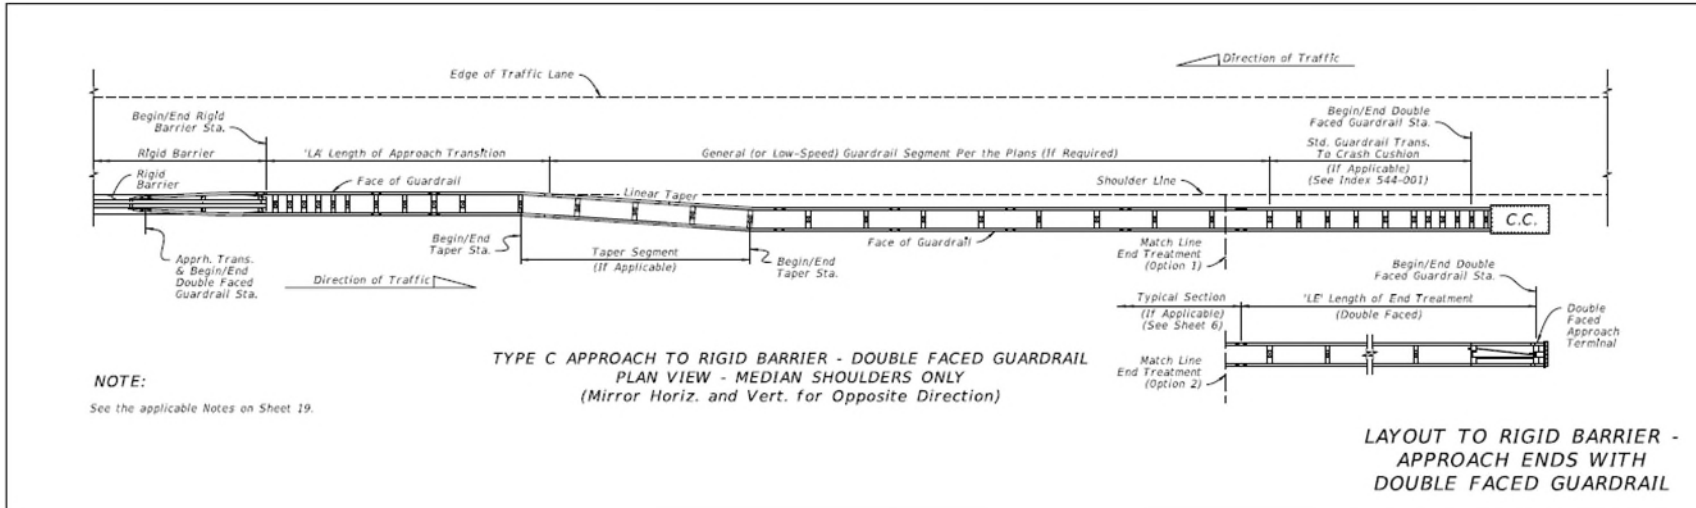


- **Previously, Only Sheet 20** shows basic guardrail connection on trailing end of bridge, with no curb connection
- Note that curb is not required for crashworthiness (unlike on approach end)...
- BUT, designers have requested curb drawings for water conveyance or compatibility with curbed roads


## Sheet 20: Layout to Rigid Barriers, Trailing Ends

- **Revised Note 1** Refers to Sheet 21 for:

**New** trailing curb connection options

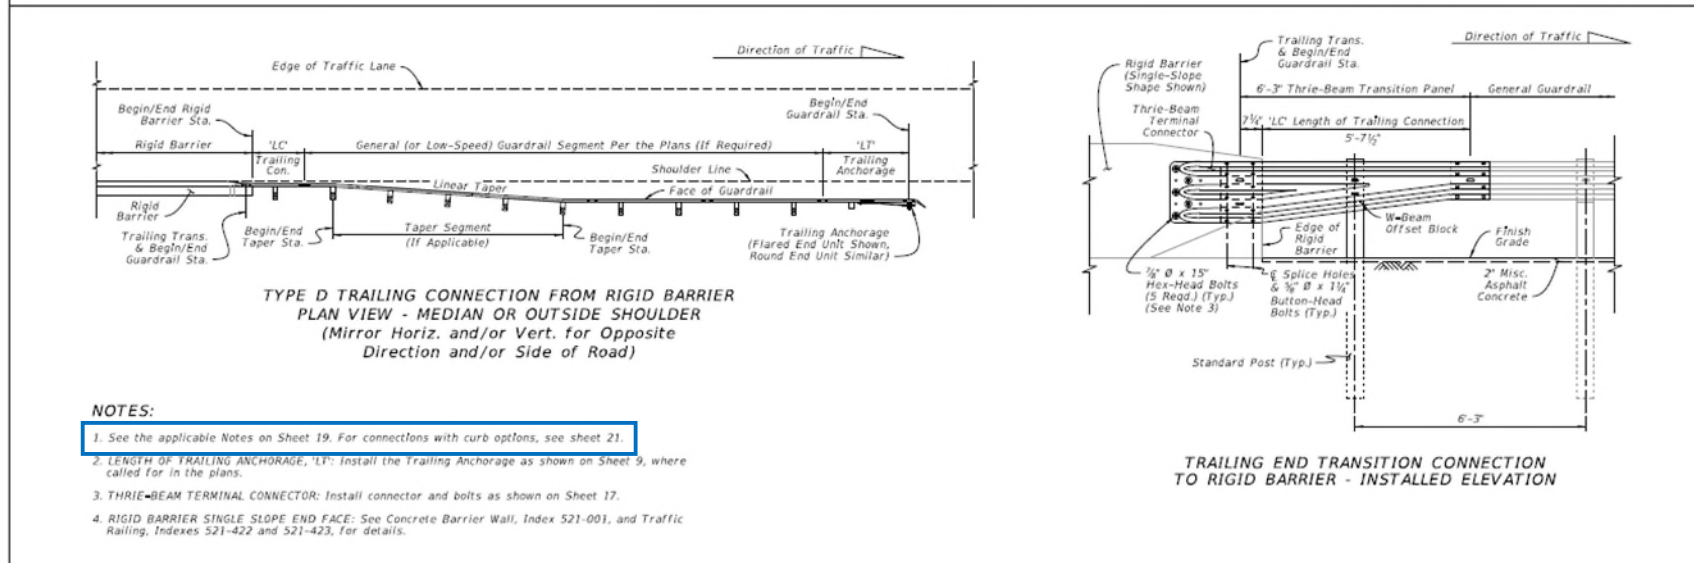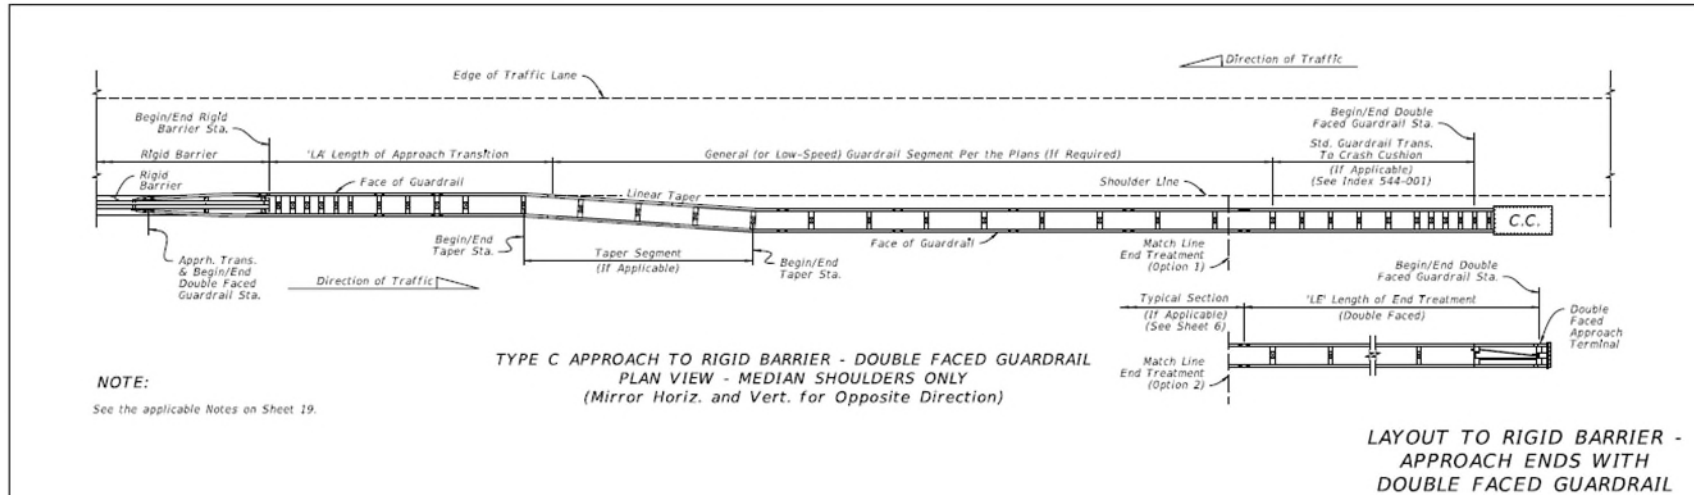



## New Sheet 21: Trailing End Bridge Connections – Curb Connection Options

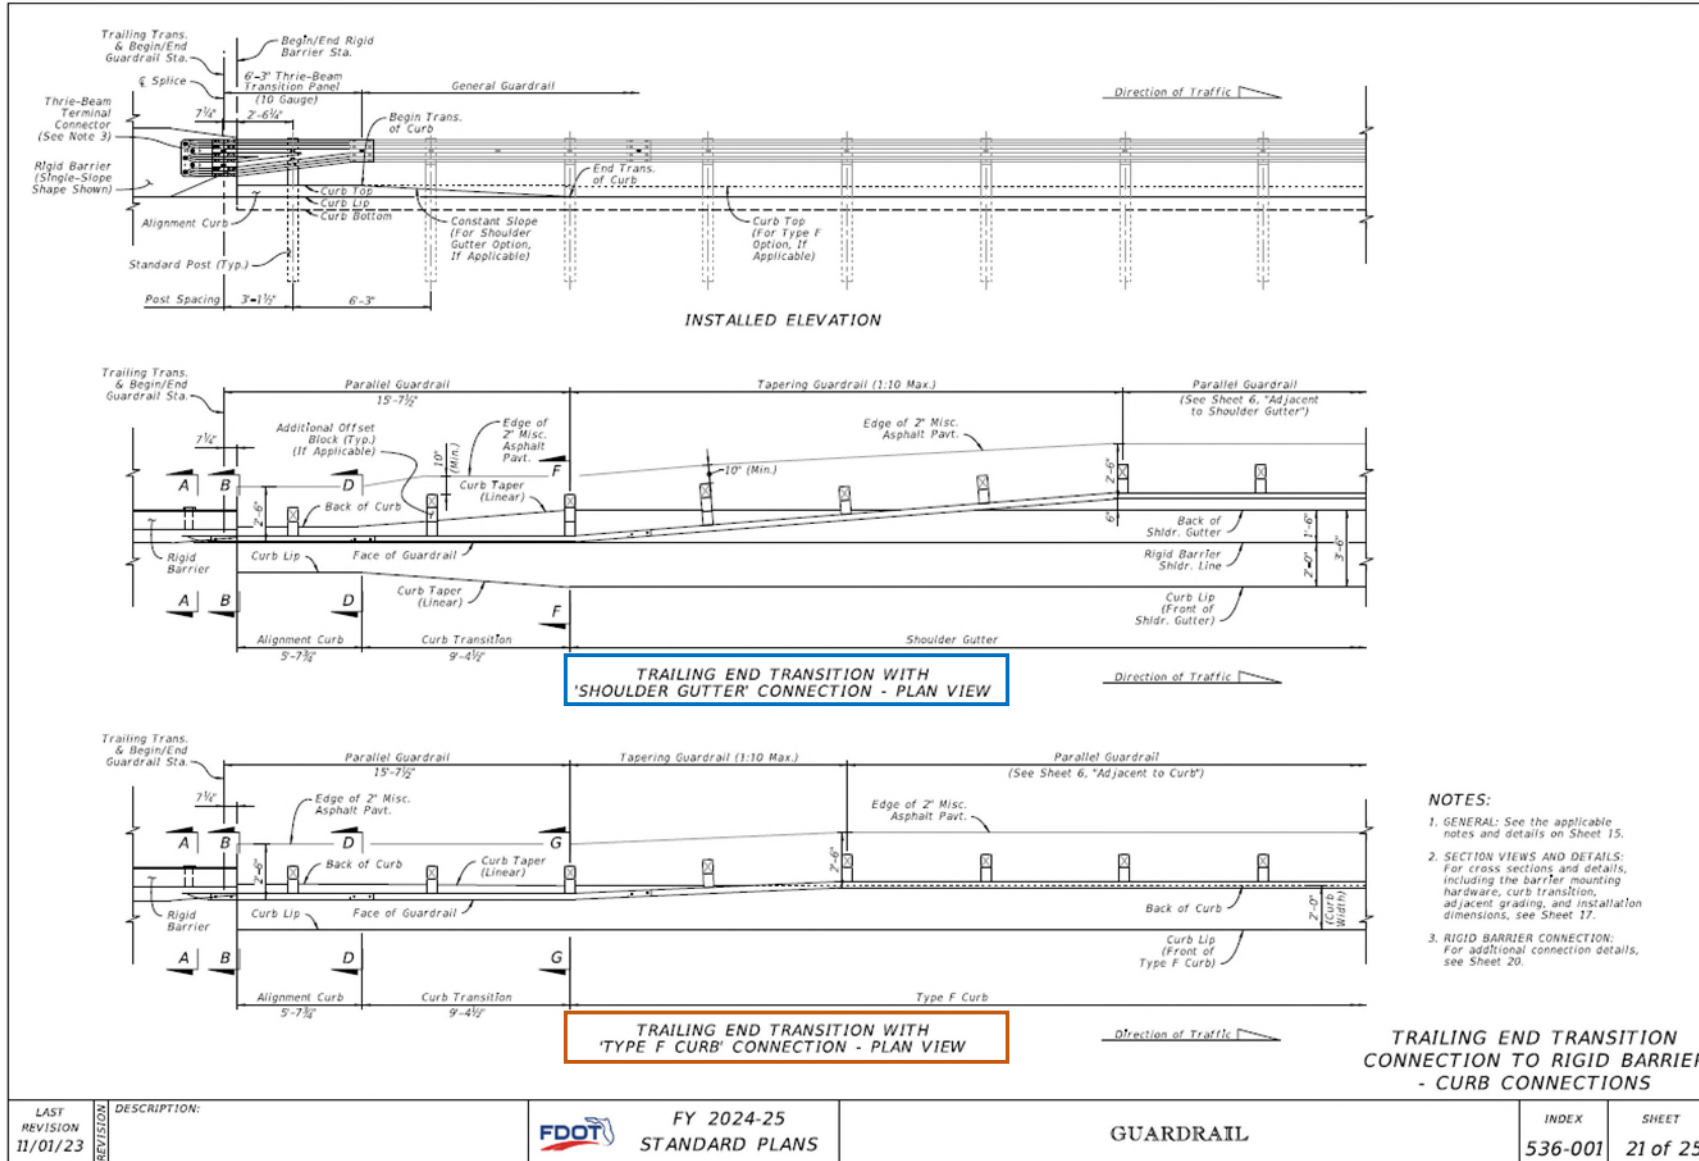

- **New** trailing end options for:
  - **Shoulder Gutter Connection**
  - **Type F Curb Option**
- **NOTE:** Similar to the Approach End, but shorter with less posts and panels (cost savings)



## New Sheet 21: Trailing End Bridge Connections – Shoulder Gutter Example

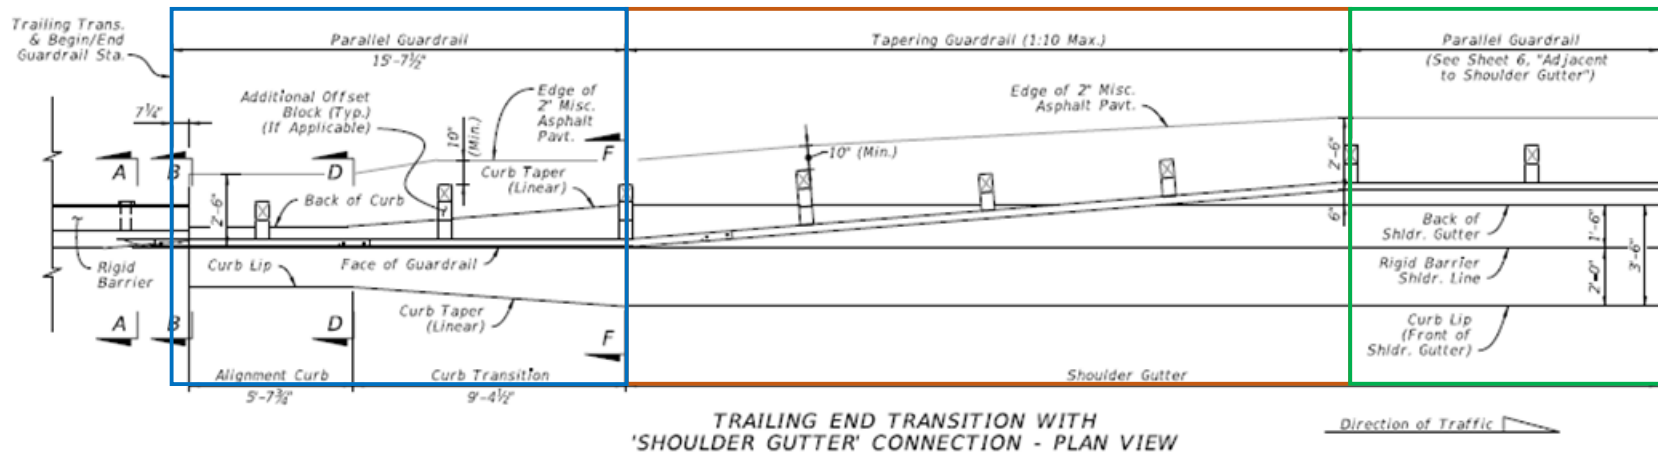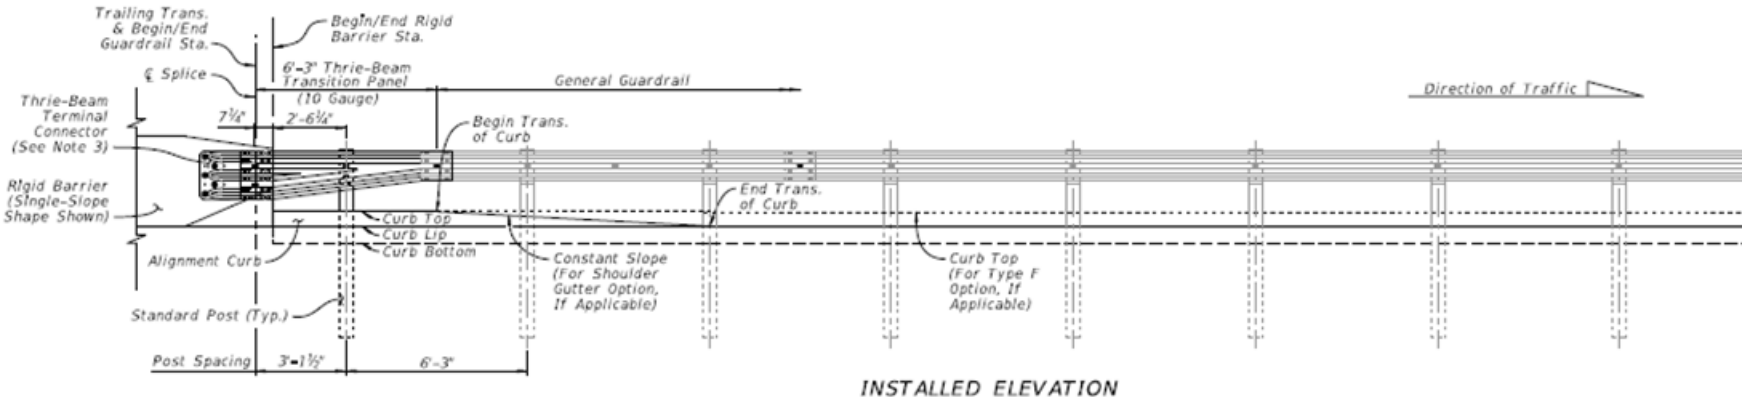


- **Parallel Guardrail – Connection, includes:**
  - Alignment Curb
  - Curb Transition
  
- **Tapering Guardrail – (Shoulder Gutter is Established)**
  
- **Parallel Guardrail – Typical Section, See:**
  - Sheet 6 Shoulder Gutter
  - FDM 210.4 and... Figure 215.4.6


Section views on Sheet 17!  
(same as Approach Transition)



## New Sheet 21: Trailing End Bridge Connections – Curb Connection Options

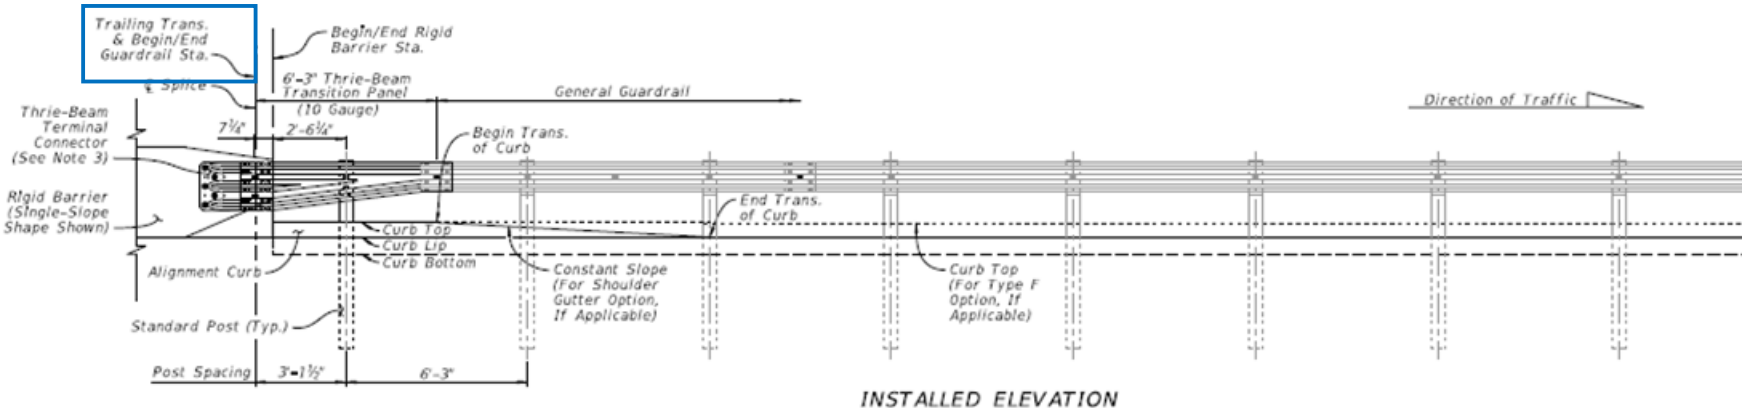

INSTALLED ELEVATION

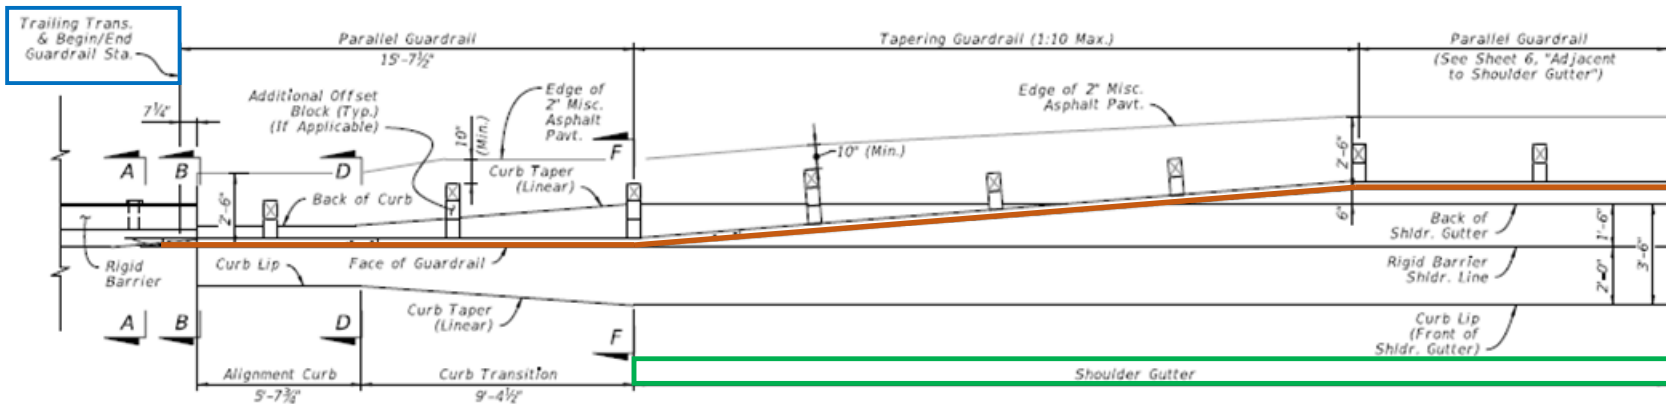

TRAILING END TRANSITION WITH 'SHOULDER GUTTER' CONNECTION - PLAN VIEW

### Roadway Plan View Needs:


- Call out “Trailing Transition...” Station
- Trailing Transition Pay Item: 536-8-113
- Draw guardrail closely matching the Standard Plans
- Call out shoulder gutter limits and tabulate

## Standard Plans – Primary Updates:

- 1) **Index 521-001 – Concrete Barrier**
  - Added “Shoulder Rocking” compatibility
- 2) **Index 536-001 – Guardrail**
  - **New** - Sheet 21 - Bridge trailing curb options
  - Revised washer usage – new exclusions
- ➔ 3) **Index 639-001 – Service Point Details**
  - **New** taller concrete service pole option




## Sheet 1: Detail B – Underground Feed – Service Poles

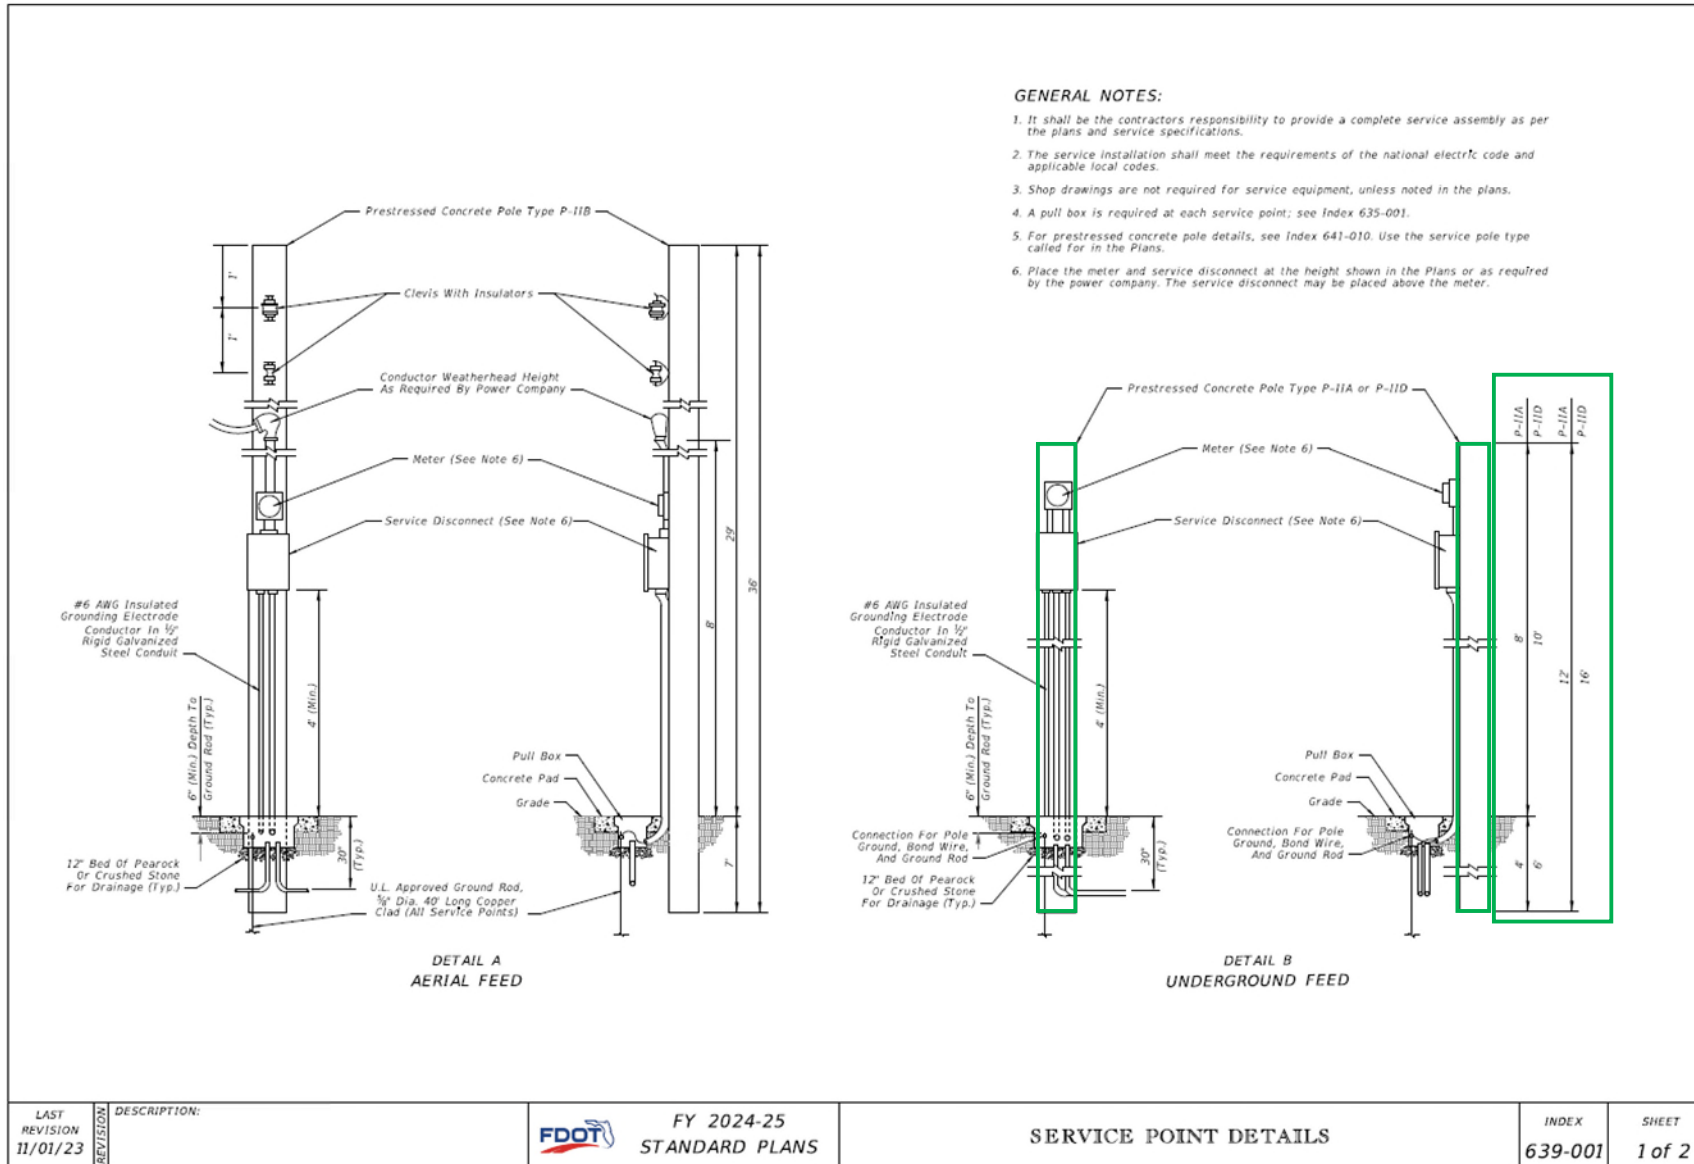


- **New 16-foot service pole option**
- **Service Pole Type PIID (16-foot) was recently added to Index 641-010, Sheet 5**
- **Options to Differentiate Poles:**
  - **Type P-IIA – 12-foot**
  - **Type P-IID – 16-foot**

## Sheet 1: Detail B – Underground Feed – Service Poles

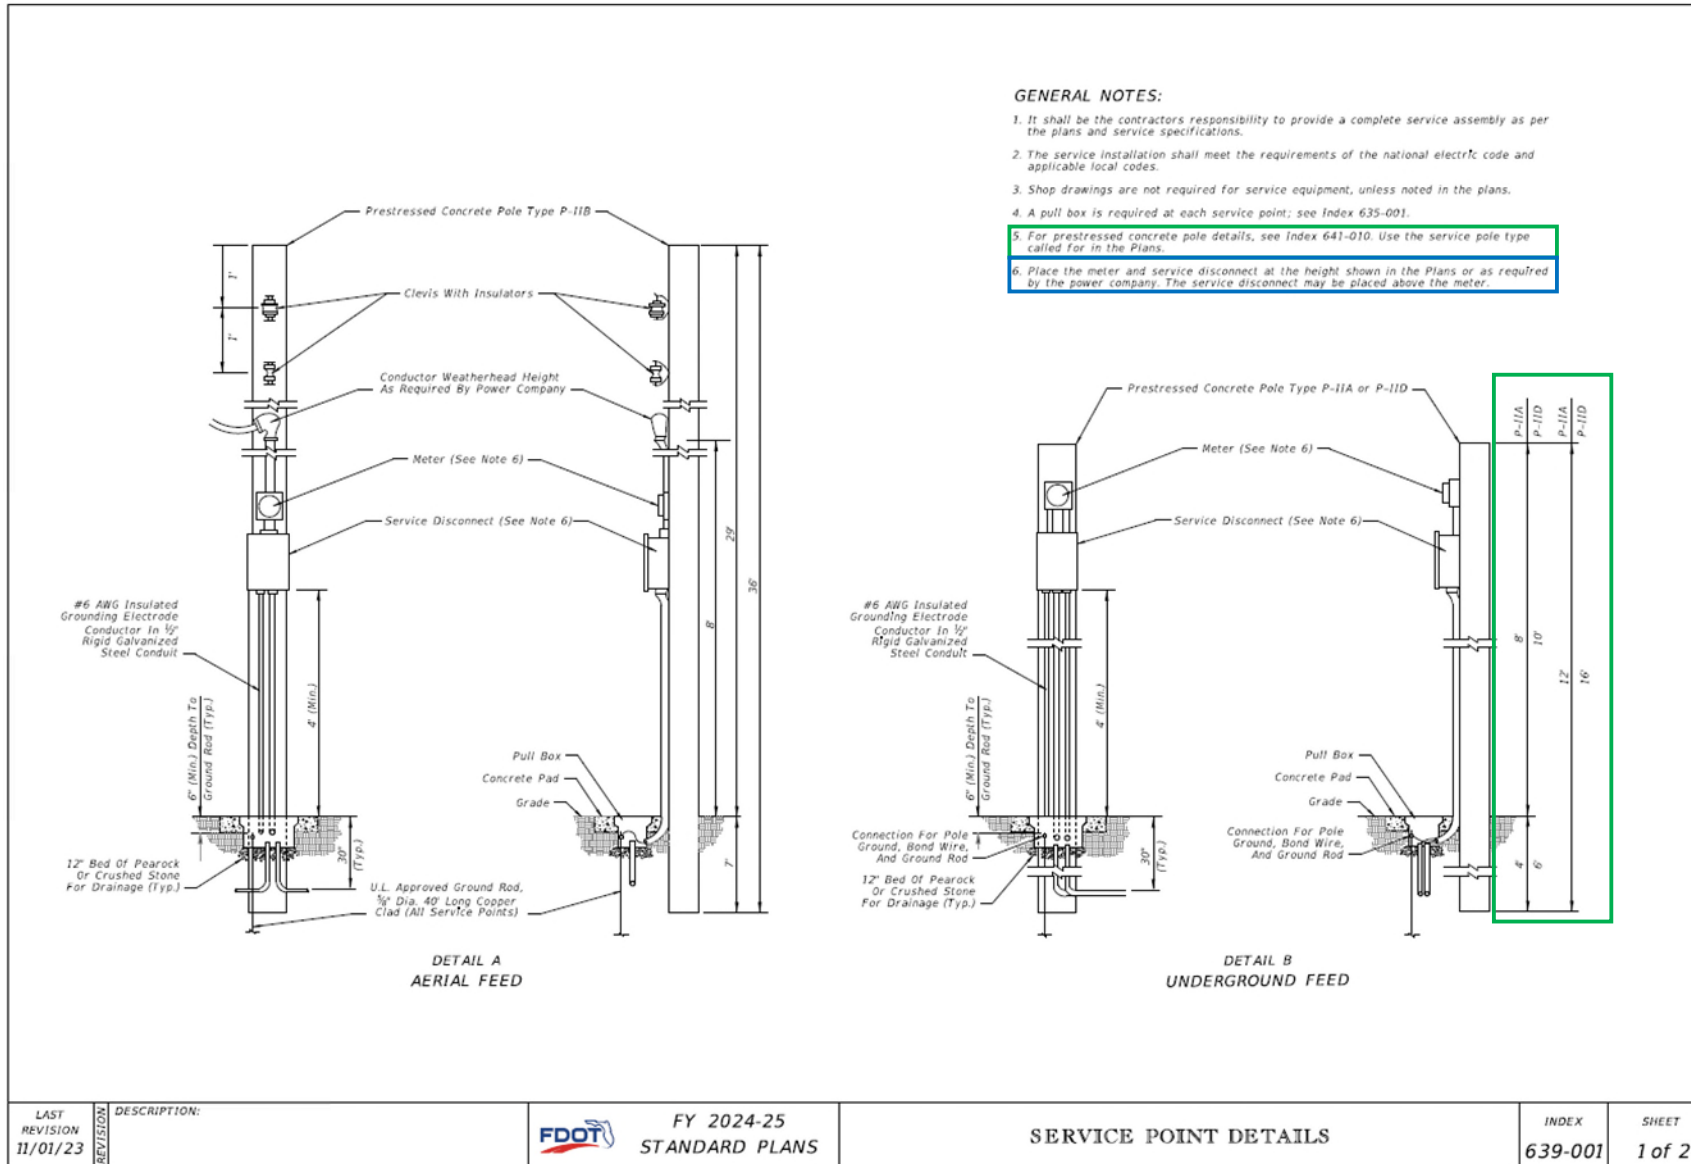

- Note 5, Pole Types:  
Added to reference Index 641-010
- Note 6, Device Heights:  
Added to explain that Meter and Service Pole disconnect height are defined by the EOR in the Plans or by the Power Company.
  - Meter can be placed below Service Disconnect if needed.


## Standard Plans – Primary Updates:

- 1) **Index 521-001 – Concrete Barrier**
  - *Added “Shoulder Rocking” compatibility*
- 2) **Index 536-001 – Guardrail**
  - **New** - *Sheet 21 - Bridge trailing curb options*
  - *Revised washer usage – new exclusions*
- 3) **Index 639-001 – Service Point Details**
  - **New** *taller concrete service pole option*
- 
**4) Index 715 Series - Lighting**
  - *Revised access door location in pole base*
  - **New** *precast shaft foundation option*
  - *Added structural grout pad details for spread footing option*





## Sheet 1: Details updated for Access Door Orientation

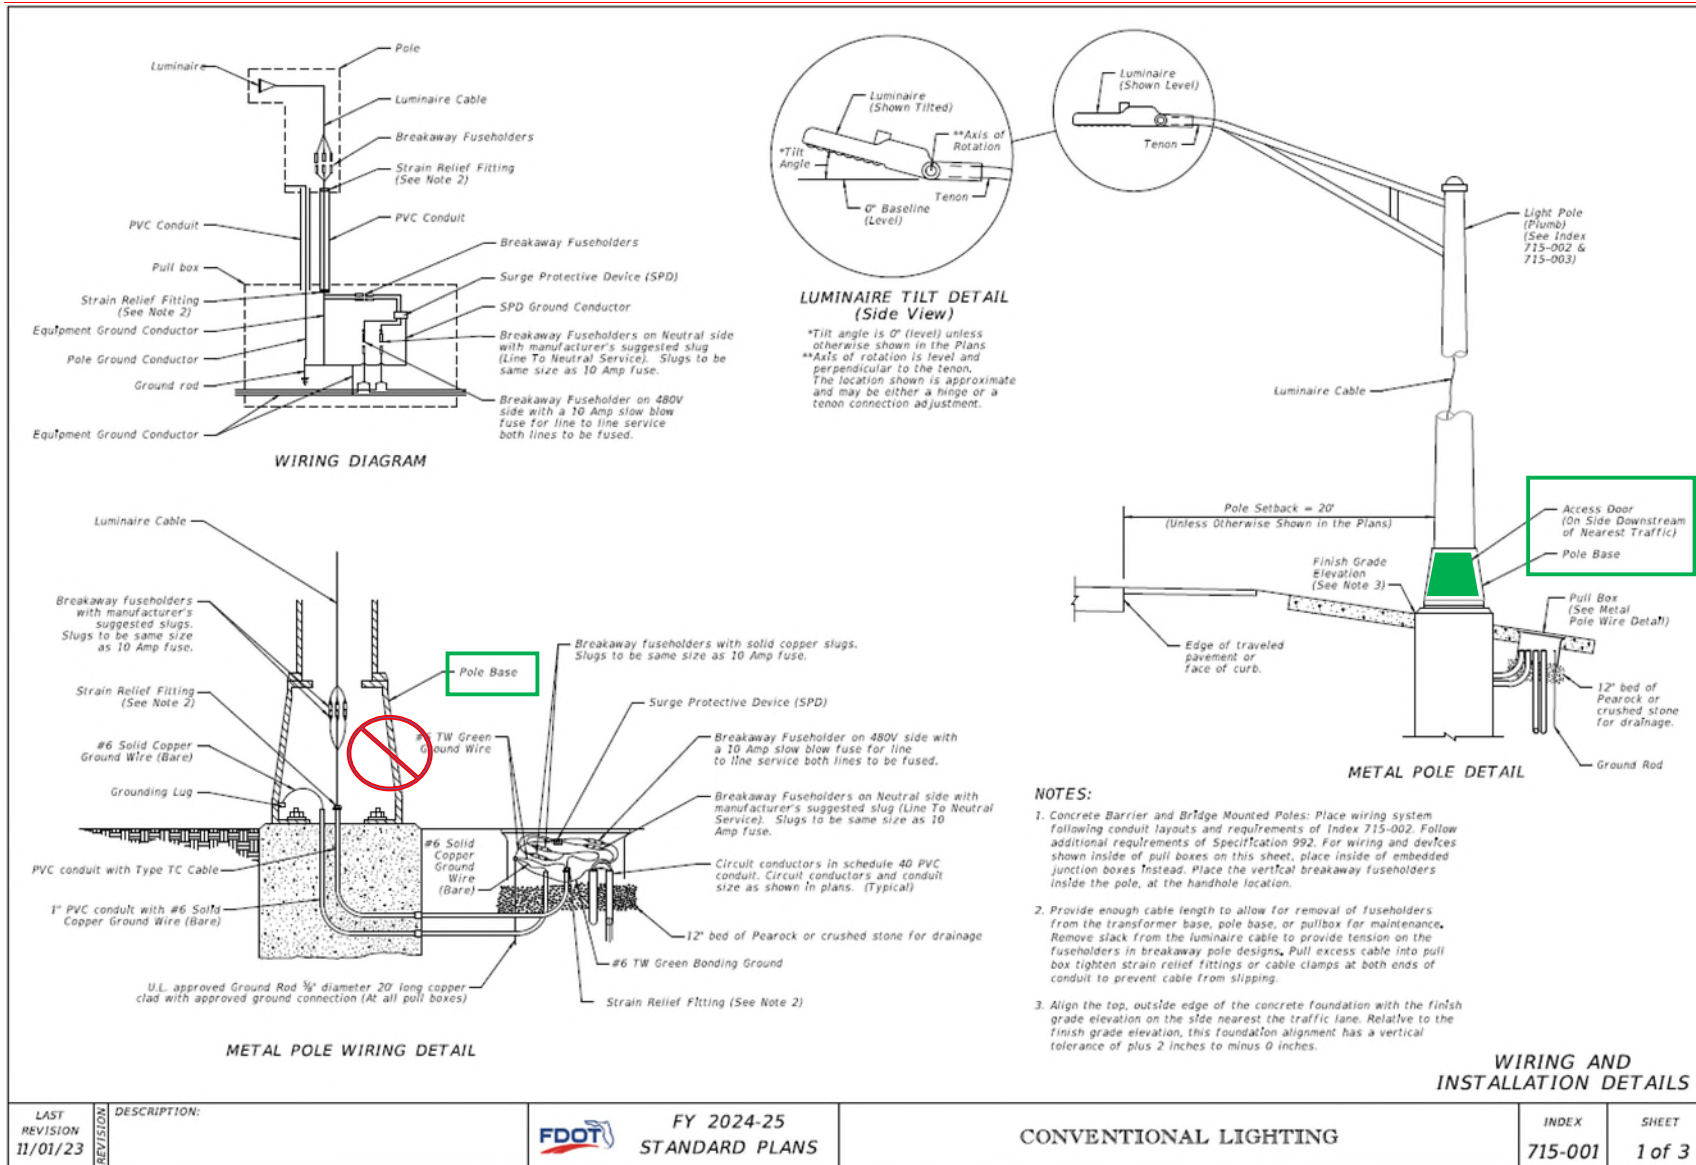

- Removed 'Access Door' from metal pole wiring detail (may misinterpret orientation)
- Added 'Access Door' detail to the Metal Pole Detail (orientation clearly established)
  - Place on downstream side of nearest traffic
  - Matches Standard Specifications 715-3

## Sheet 4: Foundation Details – New Option Added

**SECTION C-C**  
Tie Bars (See Foundation Note 2)  
8 - #7 Bars Equally Spaced  
3" Cover (Typ.)  
1'-0" LABPole & Arm

**TOP MOUNT TENON**  
2 3/8" Ø  
3 1/4"

**TOP VIEW TRANSFORMER BASE**  
Slots for Cast Aluminum Base Shoe 13 1/2" Bolt Circle

**VIEW B-B**  
45° Typ.  
2'-6" Ø  
Typical Each Way 5/16"  
1'-3" Ø Bolt Circle  
4 - Equally Spaced Anchor Bolts Oriented as Shown when the Shaft is Installed.

**BOTTOM VIEW TRANSFORMER BASE**  
Slots for 15" Bolt Circle

**SHAFT FOUNDATION ELEVATION**  
Foundation Depth (See Foundation Table)  
1" Chamfer  
Conduit with Elbow 1" Min. (Typ.)  
Double Nuts (Typ.)  
#6 AWG Bare Ground Wire Cast in Concrete or Placed in Conduit  
8-#7 Bars Equally Spaced  
Class II Concrete Shaft may be Cast-in-Place or Precast With "Flowable Fill" Backfill (See Foundation Note 3)  
Bolt Minimum Embedment (See Foundation Table)

**POLE BASE ELEVATION**  
Fillet Weld Outside of Pole to Top of Base Shoe (See Pole Table)  
8" or 10" Pole Base O.D.  
Pole, Base, & Foundation (Plumb)  
Pole Wall Thickness (See Pole Table)  
Cast Aluminum Pressure Mounted Nut Cover - Bolted Attachment Optional  
Cast Aluminum Base Shoe (See General Notes on Sheet 1)  
Shoe Base Bolt with Nut and Washer  
Fillet Weld Butt of Pole to Inside of Base Shoe (See Pole Table)  
DANGER HIGH VOLTAGE DO NOT TOUCH  
Anchor Bolt and Washer as Required by Approved Breakaway Transformer Base Manufacture (Typ.)  
Cast Aluminum Frangible/Breakaway Transformer Base. See General Notes on Sheet 1.

**ARM-POLE TABLE**  
FOR STANDARD ALUMINUM LIGHT POLES WITH ARM

Mounting Height (FT.)	Wind Speed and Arm Lengths (FT.)					
	120 mph		140 mph		160 mph	
30	8, 10, 12, 15	8, 10, 12	15	8, 10	12, 15	
35	A1-P1	A1-P1	A2-P1	A1-P1	A2-P1	
40				A1-P2	A2-P2	
45	A1-P2	A1-P2	A2-P2	A1-P3	A2-P3	
50						

**ARM POLE NOTES:**  
1. See ARM SECTION detail on Sheet 3 for all A1 and A2 Values.  
2. See Pole Table for all P1, P2, and P3 values.  
3. For Median Barrier Mounted Pole, Use Arm A1.  
4. For 20' and 25' assembly heights use only 8' or 10' arm A1 with P0.

**POLE TABLE**

Pole	Pole Wall Thickness	Top of Base Shoe Weld	Inside of Base Shoe Weld
P0	0.156	3/8"	1/2"
P1	0.156	3/8"	1/2"
P2	0.250	1/2"	1/2"
P3	0.313	3/8"	3/8"

**POLE NOTES:**  
1. Pole wall thicknesses shown are nominal and must be within the Aluminum Association tolerances.  
2. Thicker walls are permitted and tapered walls may be used in accordance with the minimum Aluminum Association thicknesses.

**TOP MOUNT POLE TABLE**  
FOR STANDARD ALUMINUM LIGHT POLES WITH TOP MOUNT

Mounting Height (FT.)	Wind Speed and Arm Lengths (FT.)		
	120 mph	140 mph	160 mph
20	Pole P0	Pole P0	Pole P0
25			
30			
35	Pole P1	Pole P1	Pole P1
40			
45			
50	Pole P2	Pole P2	Pole P2

**SHAFT FOUNDATION TABLE**

Pole	P0	P1	P2	P3
Depth	6'-0"	7'-0"	8'-0"	8'-0"
Bolt Min. Embedment	2'-6"	3'-6"	3'-6"	3'-6"

**SHAFT FOUNDATION OPTION WITH LIGHT POLE & BASE DETAILS**

**SHAFT FOUNDATION NOTES:**  
1. Depths shown are for slopes equal to or flatter than 1:4. For slope steeper than 1:4 and equal to or flatter than 1:2 add 2'-6" to foundation depths shown.  
2. Foundation Tie Bars: #4 Tie Bars @ 12" centers (max.) or D10 (or W10) spiral @ 6" pitch, 3 flat turns top and 1 flat turn bottom.  
3. For precast foundations, the circular cross section shown herein may be substituted with an octagon shape. The out-to-out distance between parallel edges of the octagon must be  $\geq 2'-6"$ . Use the same reinforcing diameter and centered placement with a minimum 3" cover.


- New Note 3: New option for precast foundations:

“For precast foundations, the circular cross section shown here may be substituted with an octagon shape. The out-to-out distance between parallel edges of the octagon must be  $\geq 2'-6"$ ...”

**NOTE:** This option was also added to:

- 715-003 Utility Conflict Pole
- 700-020 Multi-Column Ground Sign

## Sheet 5: Spread Footing Foundation Option

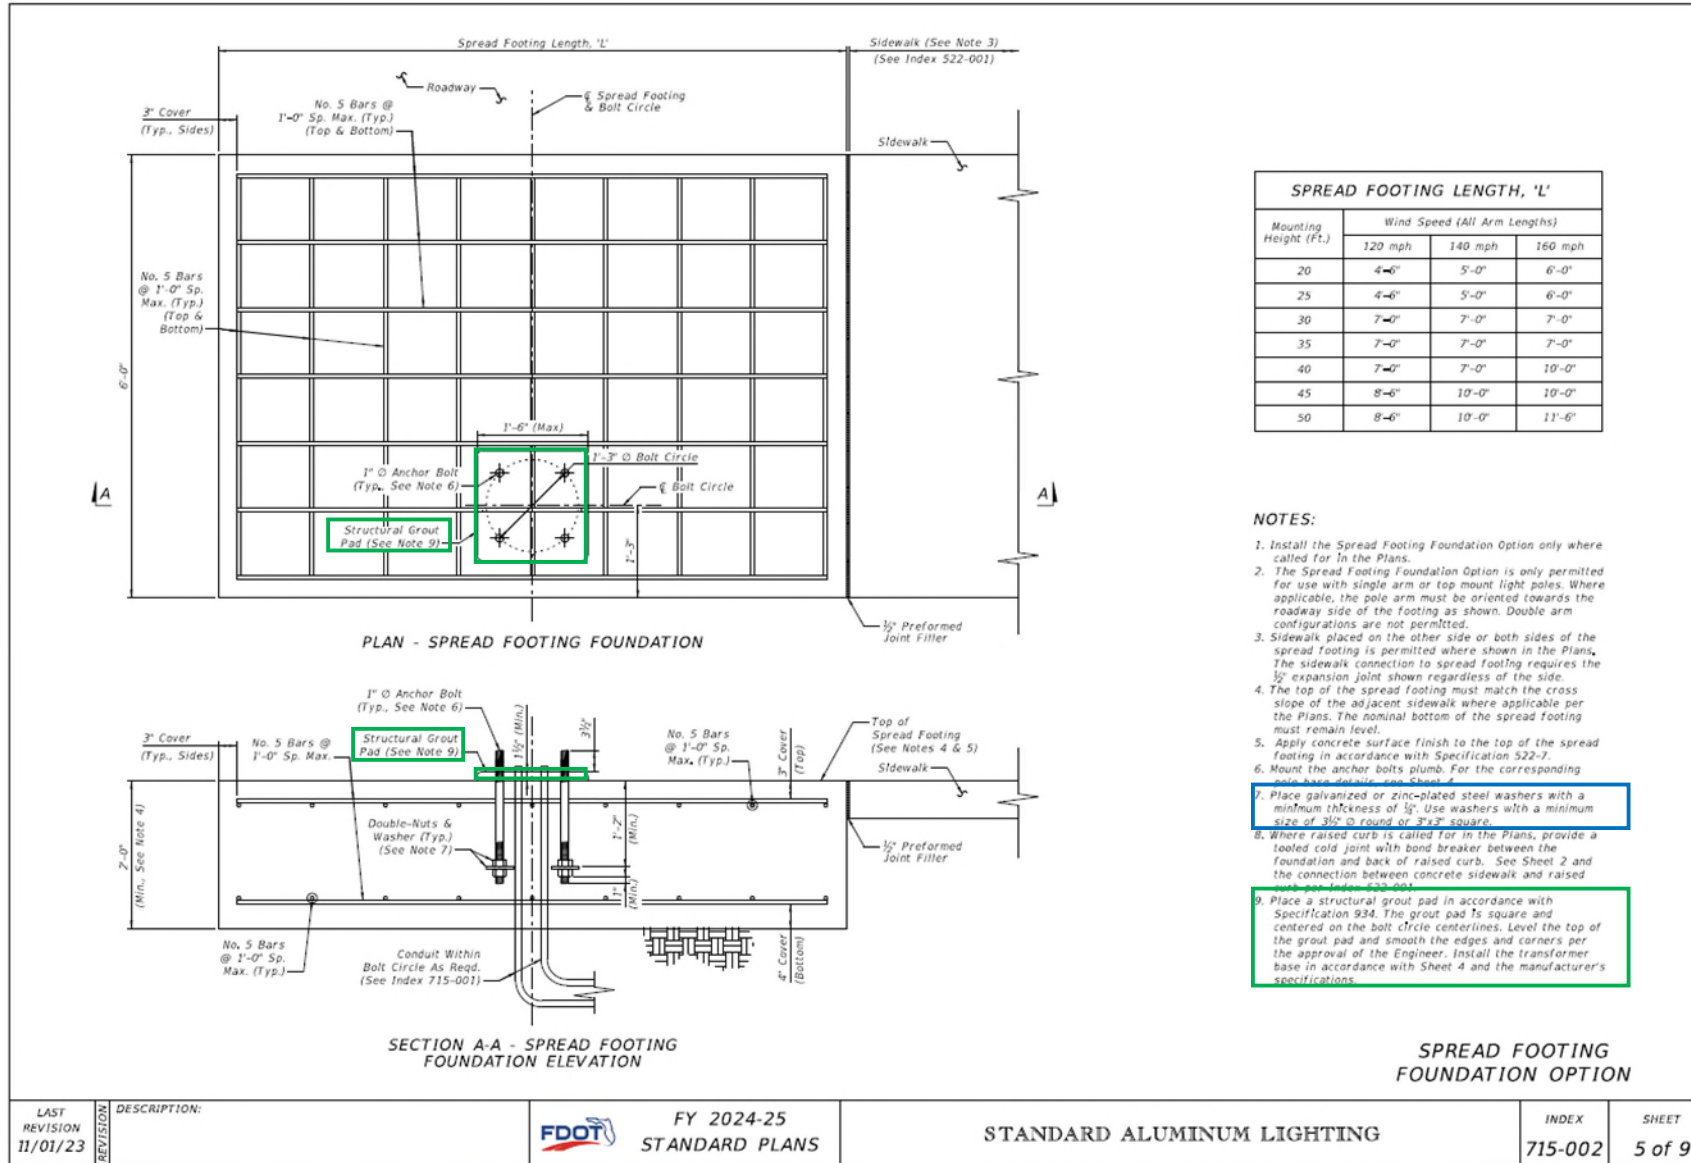

- **New Structural Grout Pad**
  - Assists with constructability
  - Supplements Spec 715-3.1 process
  - Grout in Spec 934
- Updated Note 7 – Revised washer requirements for anchorage
- **NOTE: Spread Footing Compatibility with Utility Conflict Poles is planned. Leeway given in meantime. Contact CO if needed.**

## Training Announcement:

**FLORIDA LTAP CENTER**



### **1) FDOT Roadside Barrier Design (Est. 12 hours)**

- *FDM 215 - Roadside Safety (Usage Needs, Length of Need, General Requirements, etc.)*
- *Standard Plans 536-001 Guardrail, 521-001 Concrete Barrier, 521-002 Pier Protection Barrier*

### **2) FDOT Basic Lighting Design (Est. 9 hours)**

- *FDM 231 - Lighting (Usage Needs, Warranting, Photometric, Voltage Drop, LDAR, etc.)*
- *Standard Plans 715 Series, Conventional Lighting and High Mast Lighting*




**Expected for 2024**

<https://floridaltap.org/>




## Standard Plans – Primary Updates:

- 1) **Index 521-001 – Concrete Barrier**
  - Added “Shoulder Rocking” compatibility
- 2) **Index 536-001 – Guardrail**
  - **New** - Sheet 21 - Bridge trailing curb options
  - Revised washer usage – new exclusions
- 3) **Index 639-001 – Service Point Details**
  - **New** taller concrete service pole option
- 4) **Index 715 Series - Lighting**
  - Revised access door location in pole base
  - **New** precast shaft foundation option
  - Added structural grout pad details for spread footing option
-  5) **Index D635-005 – Fiber Optic Splice Vault**
  - **New** – Standardized for Turnpike Usage






## Sheet 1: All-New Developmental Standard Plans

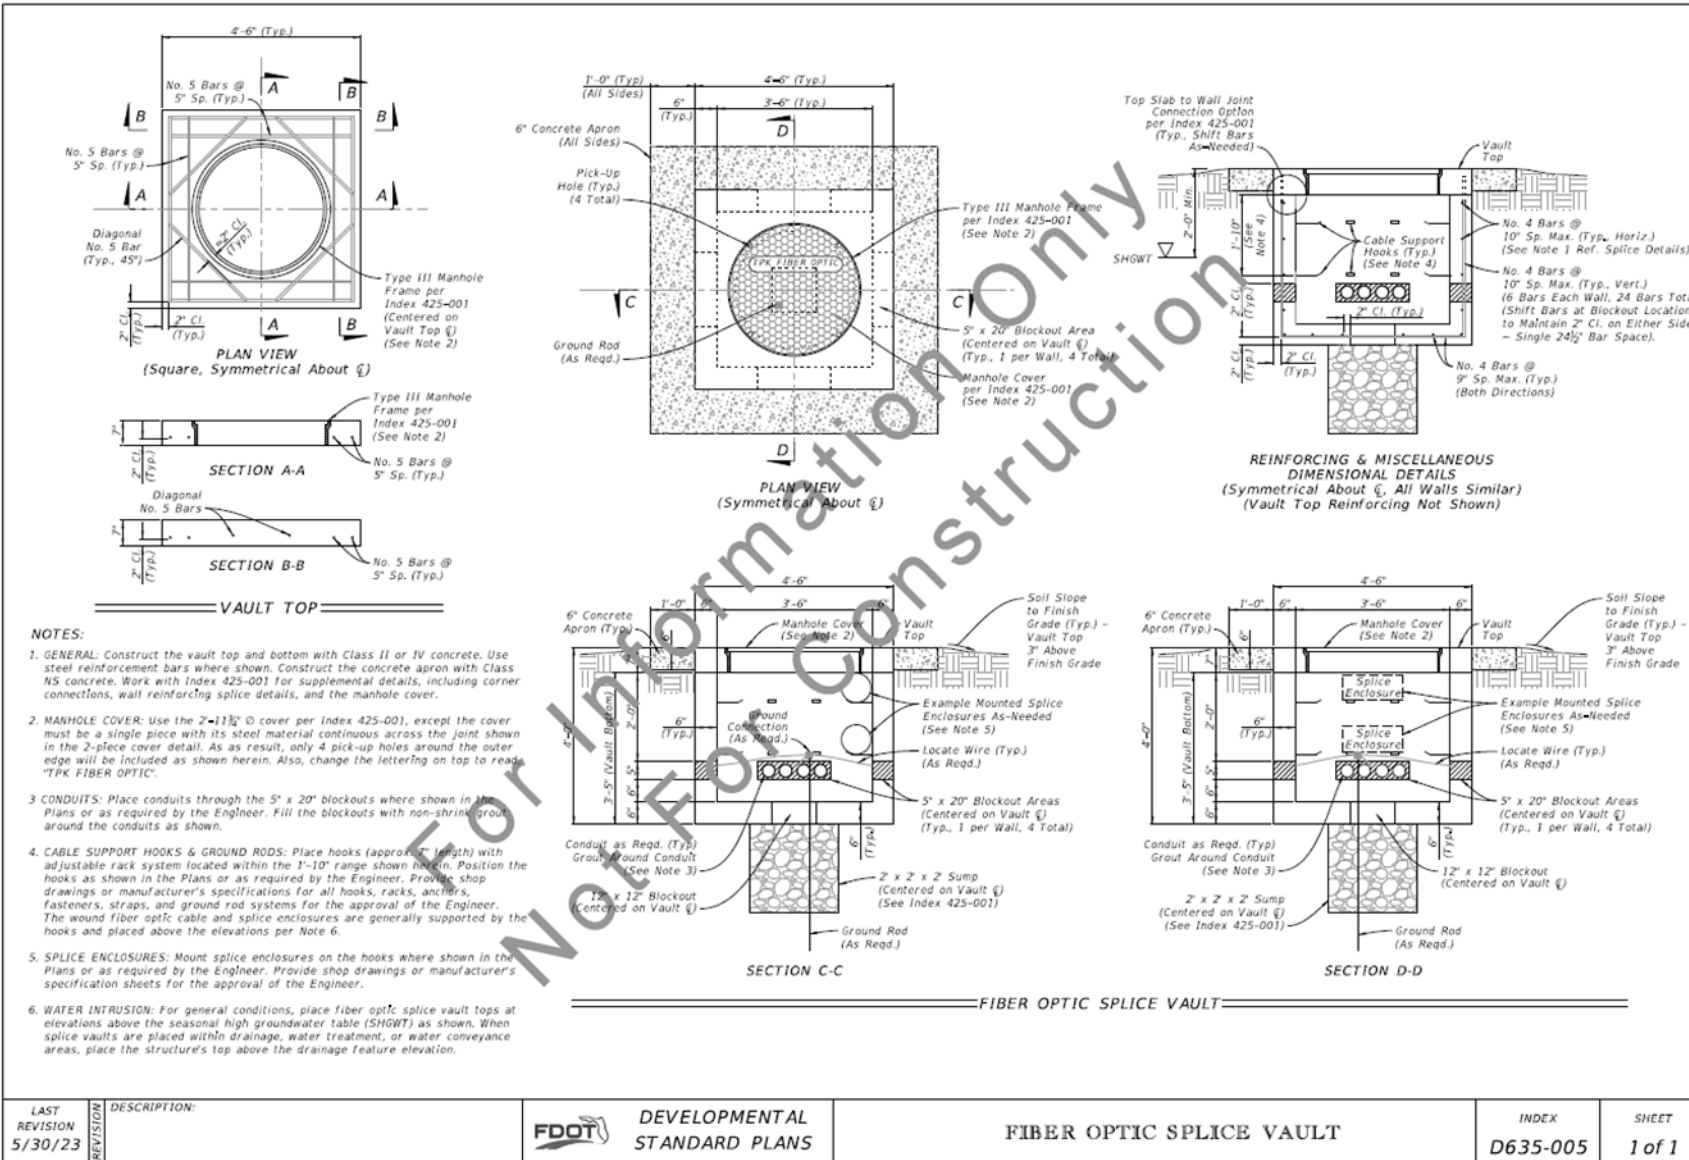

- Added at the request of the Florida Turnpike Enterprise
- “Vaults” are typically placed in medians to facilitate fiber optic access points and connections
- Standardization removes the need for project-specific structural design and shop drawings
- SDO designed for H-20 load
- Uses Type III Manhole frame per Index 425-001

LAST REVISION	DESCRIPTION	DEVELOPMENTAL STANDARD PLANS	FIBER OPTIC SPLICE VAULT	INDEX	SHEET
5/30/23				D635-005	1 of 1

## Sheet 1: All-New Developmental Standard Plans

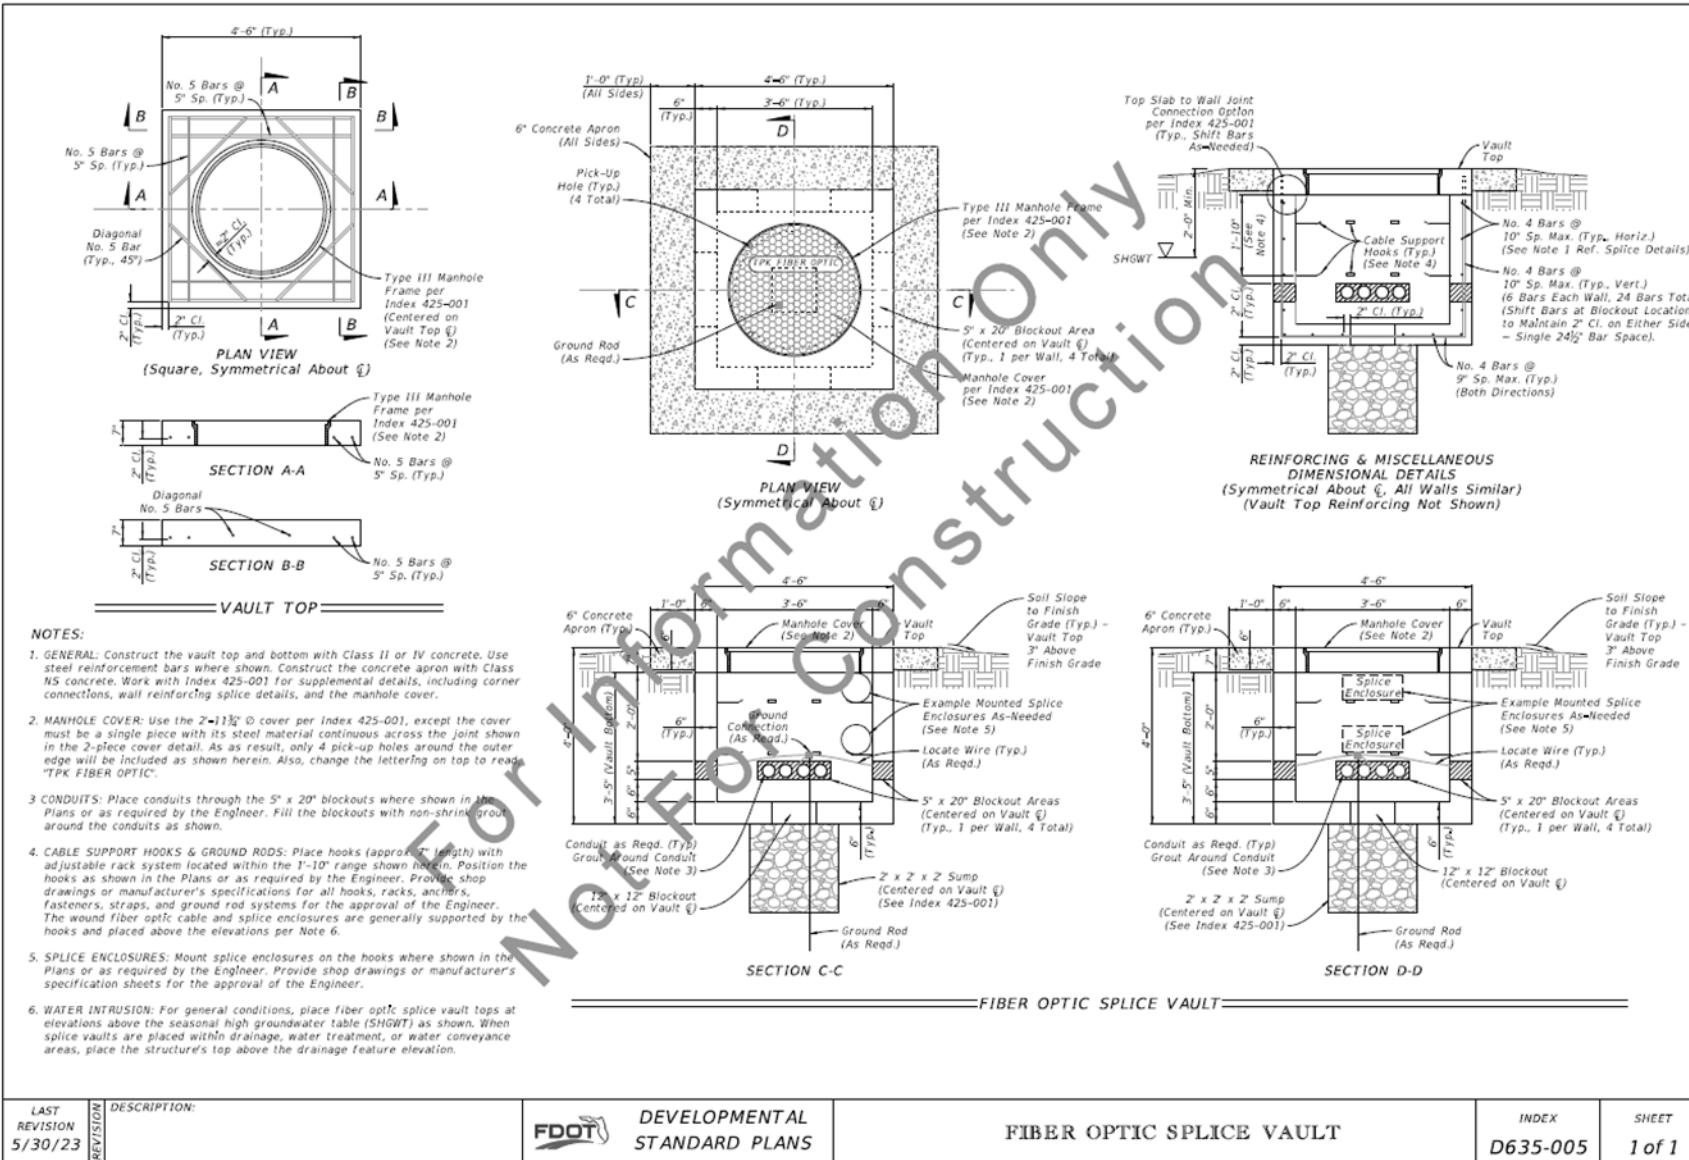

- Plan is to publish with "regular" Standard Plans next year
- For this year...
  - Request approval for usage from CO Monitor per FDM 115.2.4
  - For supporting Specs, use with Blanket MSP for 635 & 996 (See Specs on the Web)
  - Pay Item is 635-4
  - I'll guide you!

LAST REVISION	DESCRIPTION	DEVELOPMENTAL STANDARD PLANS	FIBER OPTIC SPLICE VAULT	INDEX	SHEET
5/30/23				D635-005	1 of 1

# Contact Us:



Richard Stepp, P.E.

FDOT Roadway Design Office  
605 Suwannee Street MS 32  
Tallahassee, Florida 32399-0450

✉: [richard.stepp@dot.state.fl.us](mailto:richard.stepp@dot.state.fl.us)

*Live questions answered in chat box!*

# FY 2024-25 Standard Plans Update Training

**Victor Johnson**

Traffic Data Collections Supervisor  
Transportation Data and Analytics Office  
850-921-7300  
[Victor.Johnson@dot.state.fl.us](mailto:Victor.Johnson@dot.state.fl.us)



## Standard Plans – Primary Updates:


### *Index 695-001 – Traffic Monitoring Site Overview*

- *Updated from 15 to 20 sheets to include Weigh-In-Motion (WIM) and Non-Motorized data collection layouts, infrastructure, and equipment requirements.*
- *Additional sheets were also provided to differentiate the Continuous Count Station (CCS/TTMS) from the Short-Term Monitoring Stations (STMS/PTMS).*
- *All sheet titles were updated, and a Table of Contents was provided for the Index.*
- *There will be additional updates and changes in the next iteration taking input from the Industry Review.*







## Sheet 1: Continuous Count Stations (TTMS/CCS)

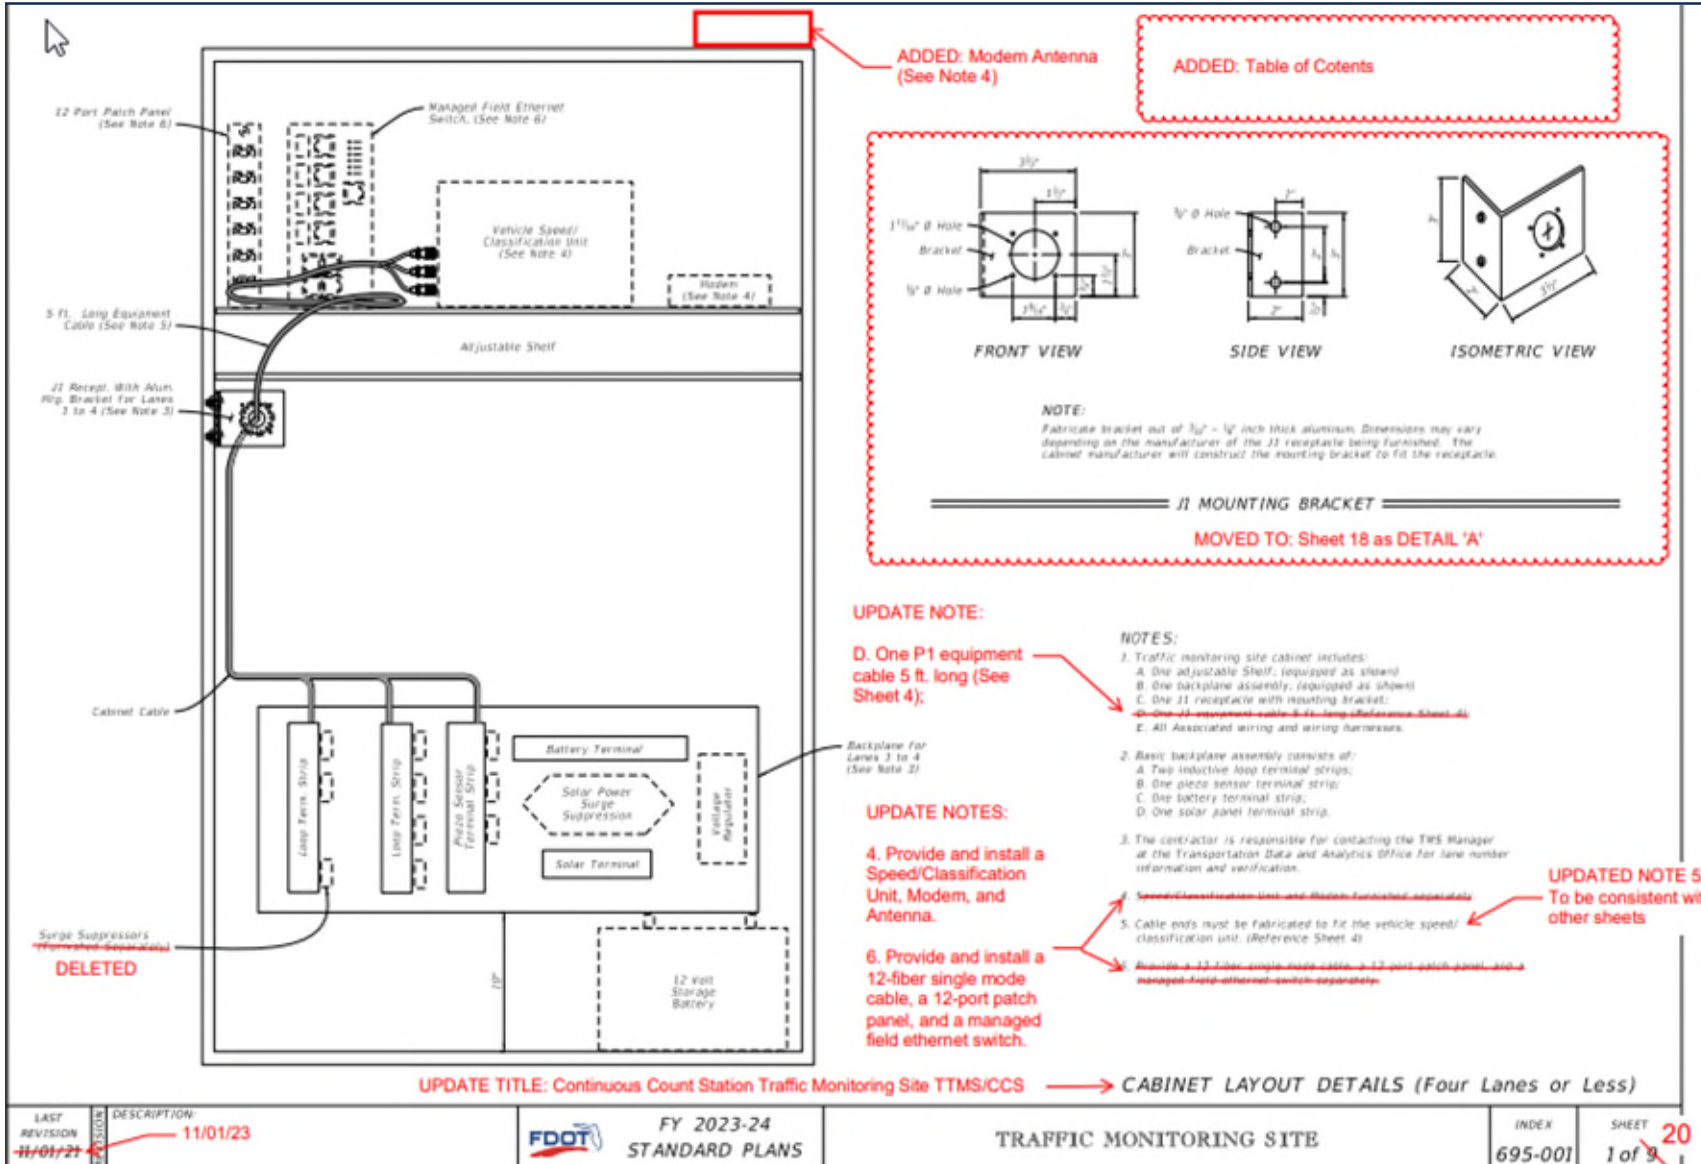


## Sheet 1: Continuous Count Stations (TTMS/CCS)

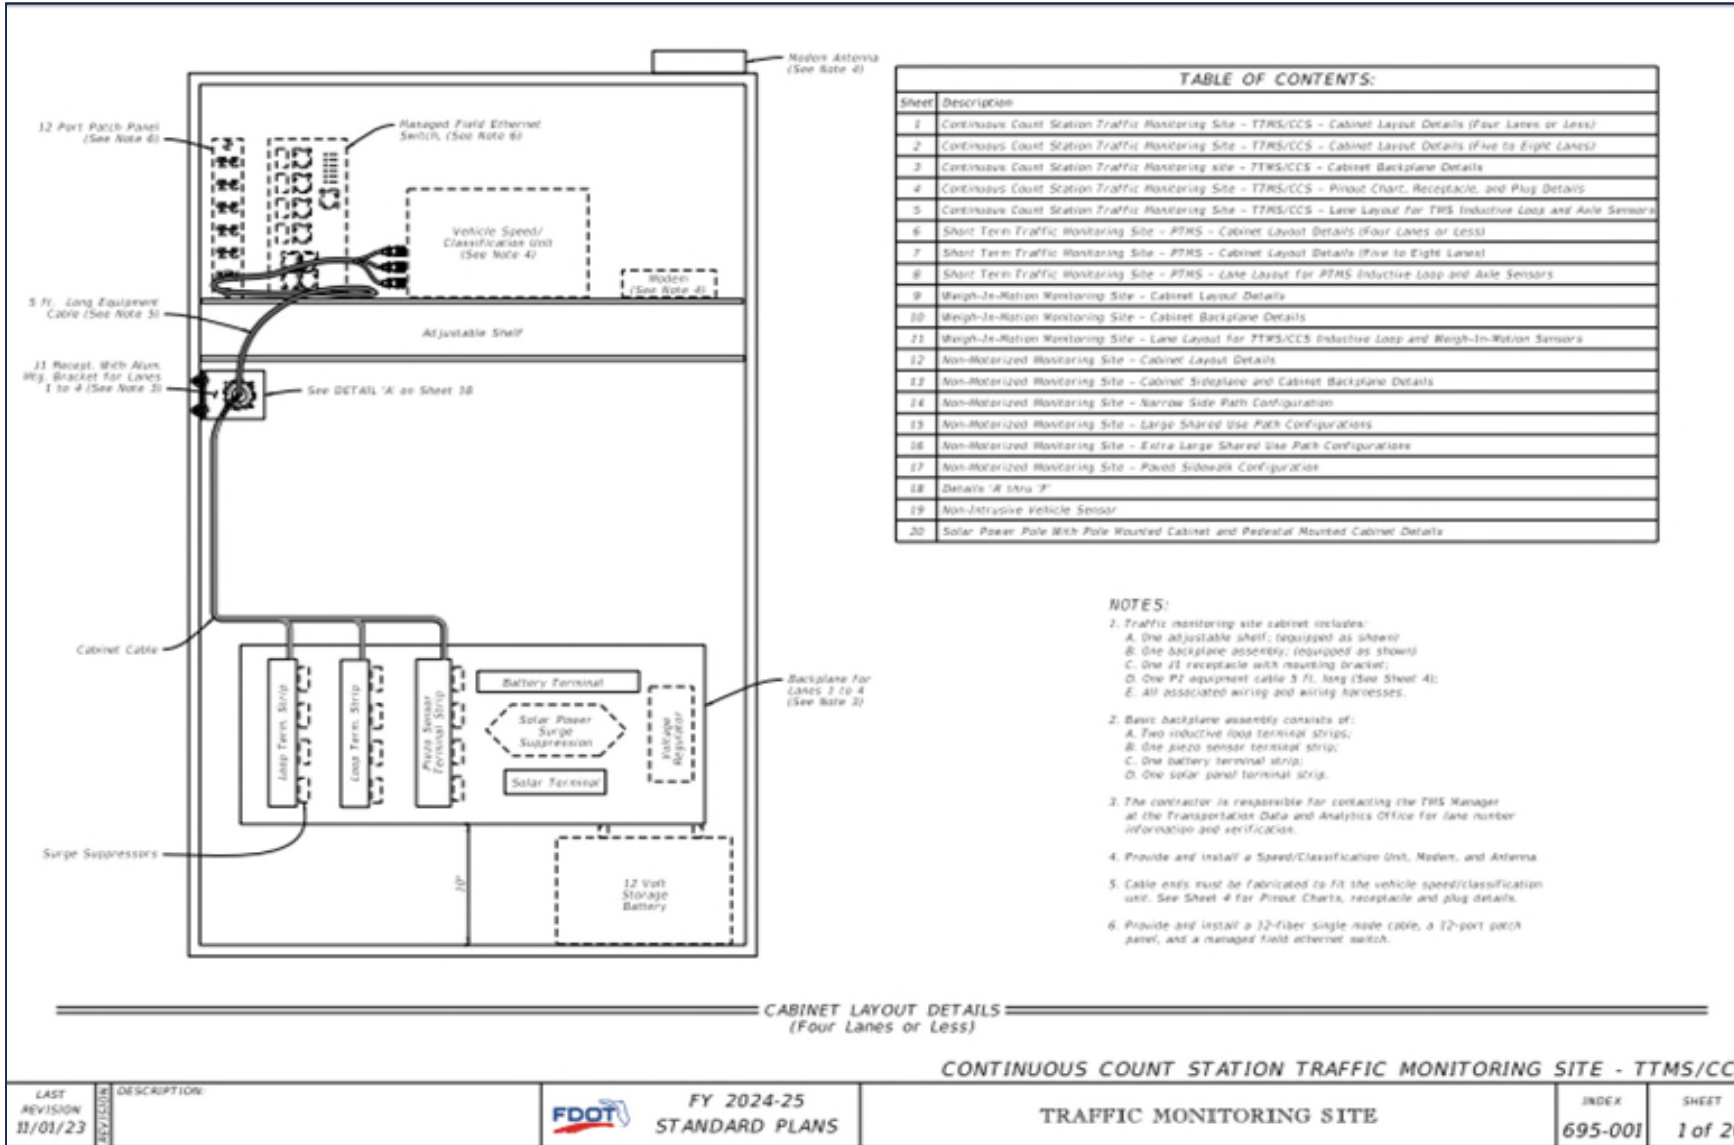

## Sheet 2: Continuous Count Stations Cabinet Layout

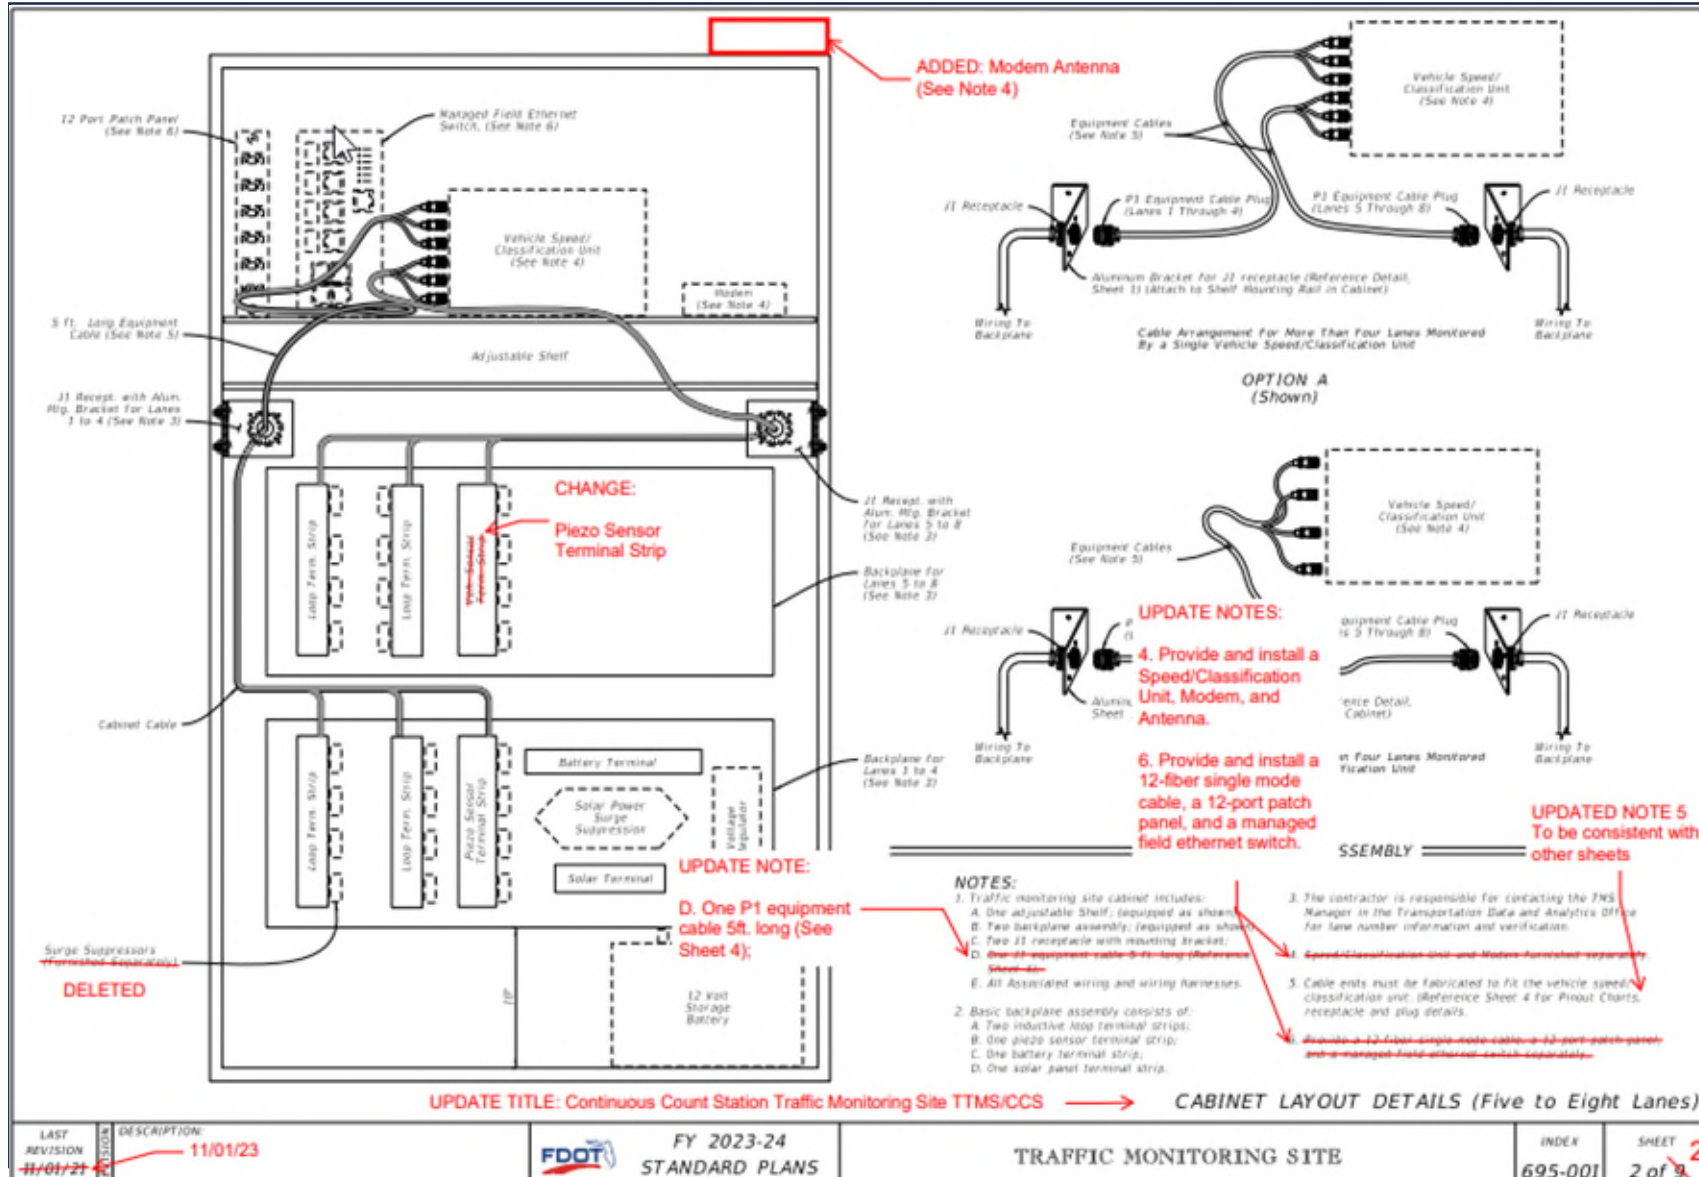


## Sheet 2: Continuous Count Stations Cabinet Layout

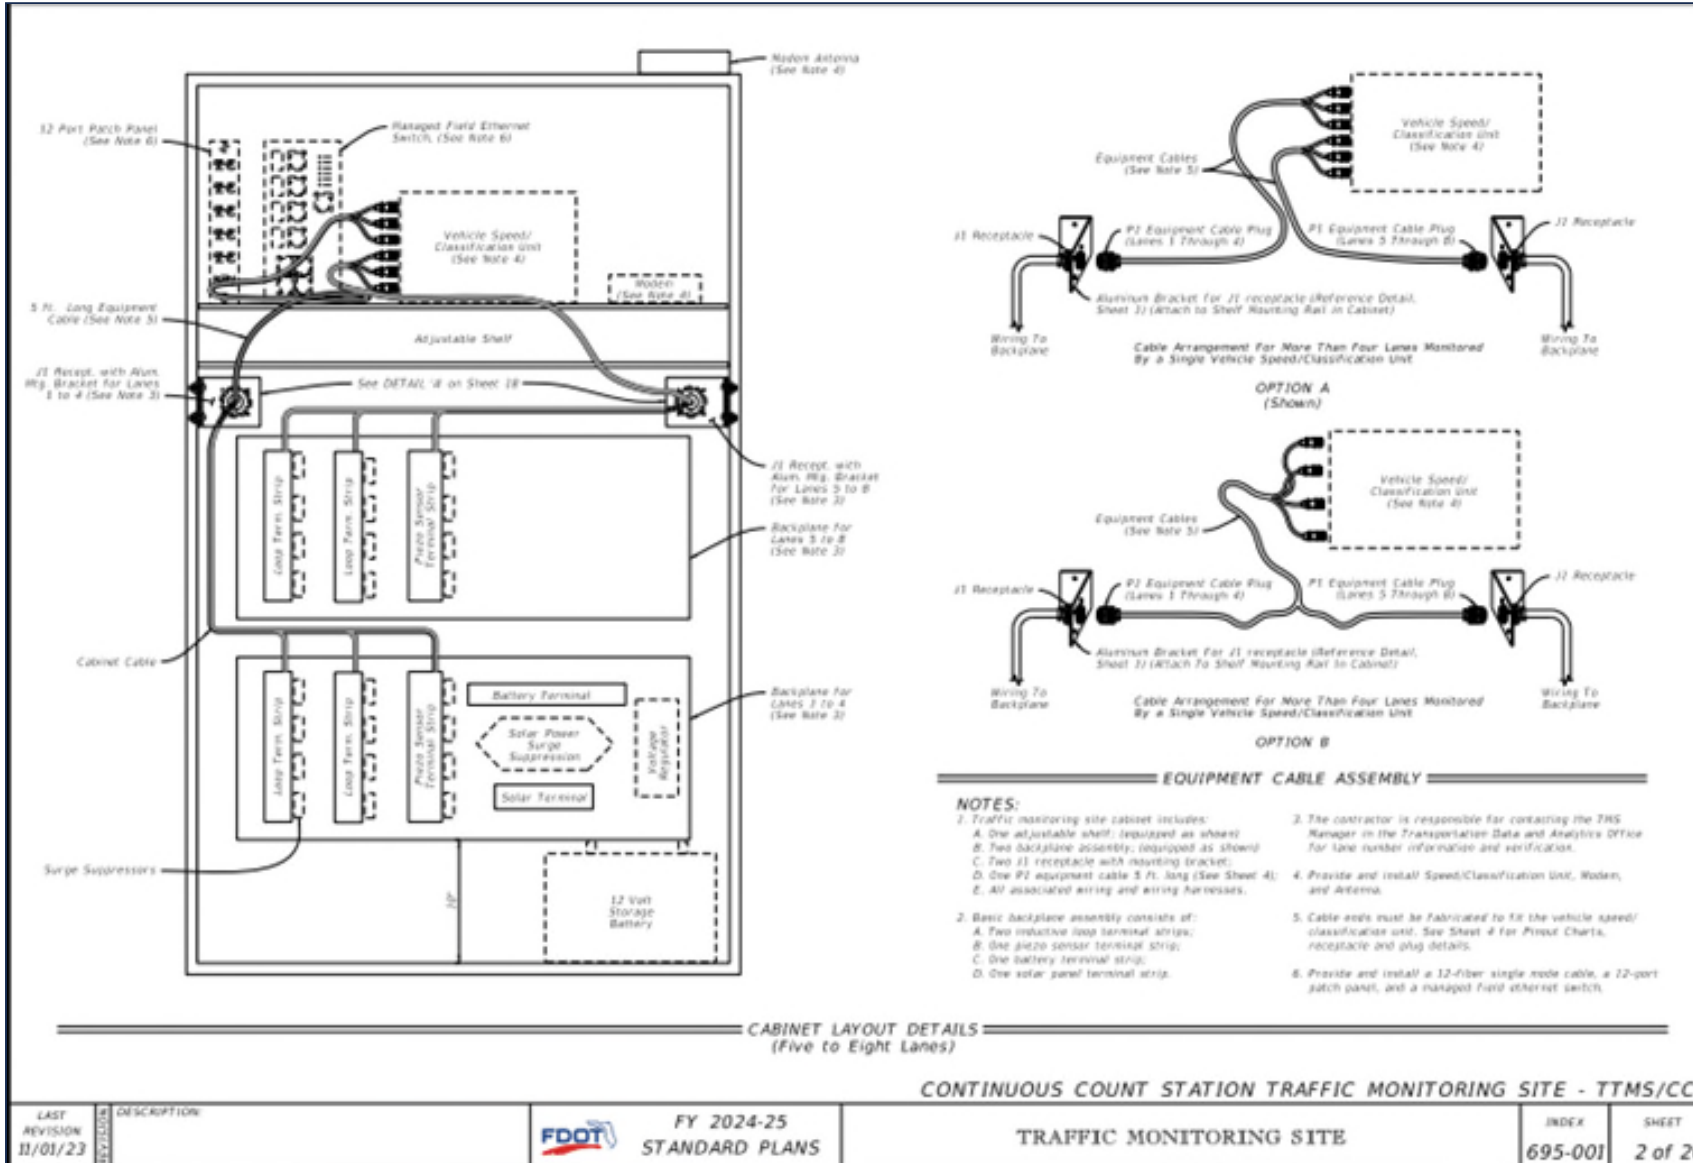




## Sheet 3: Continuous Count Stations Cabinet Backplane

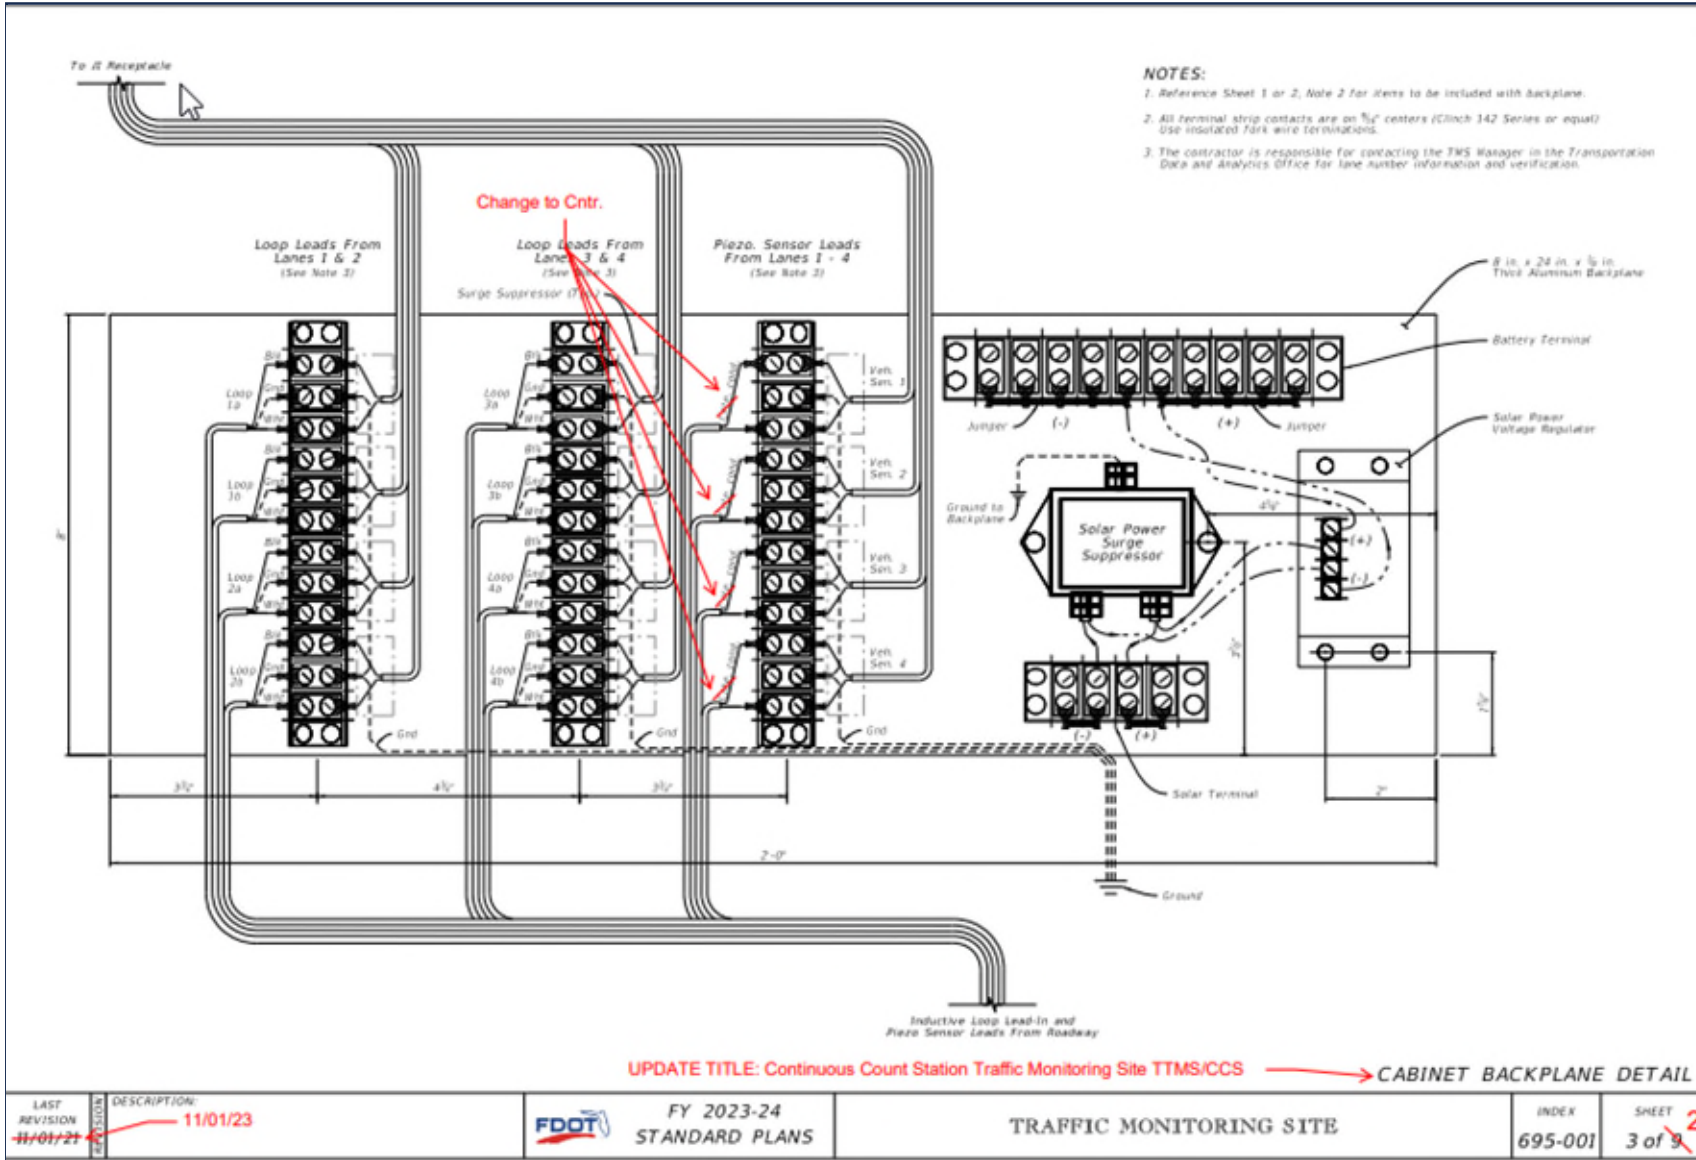



## Sheet 3: Continuous Count Stations Cabinet Backplane

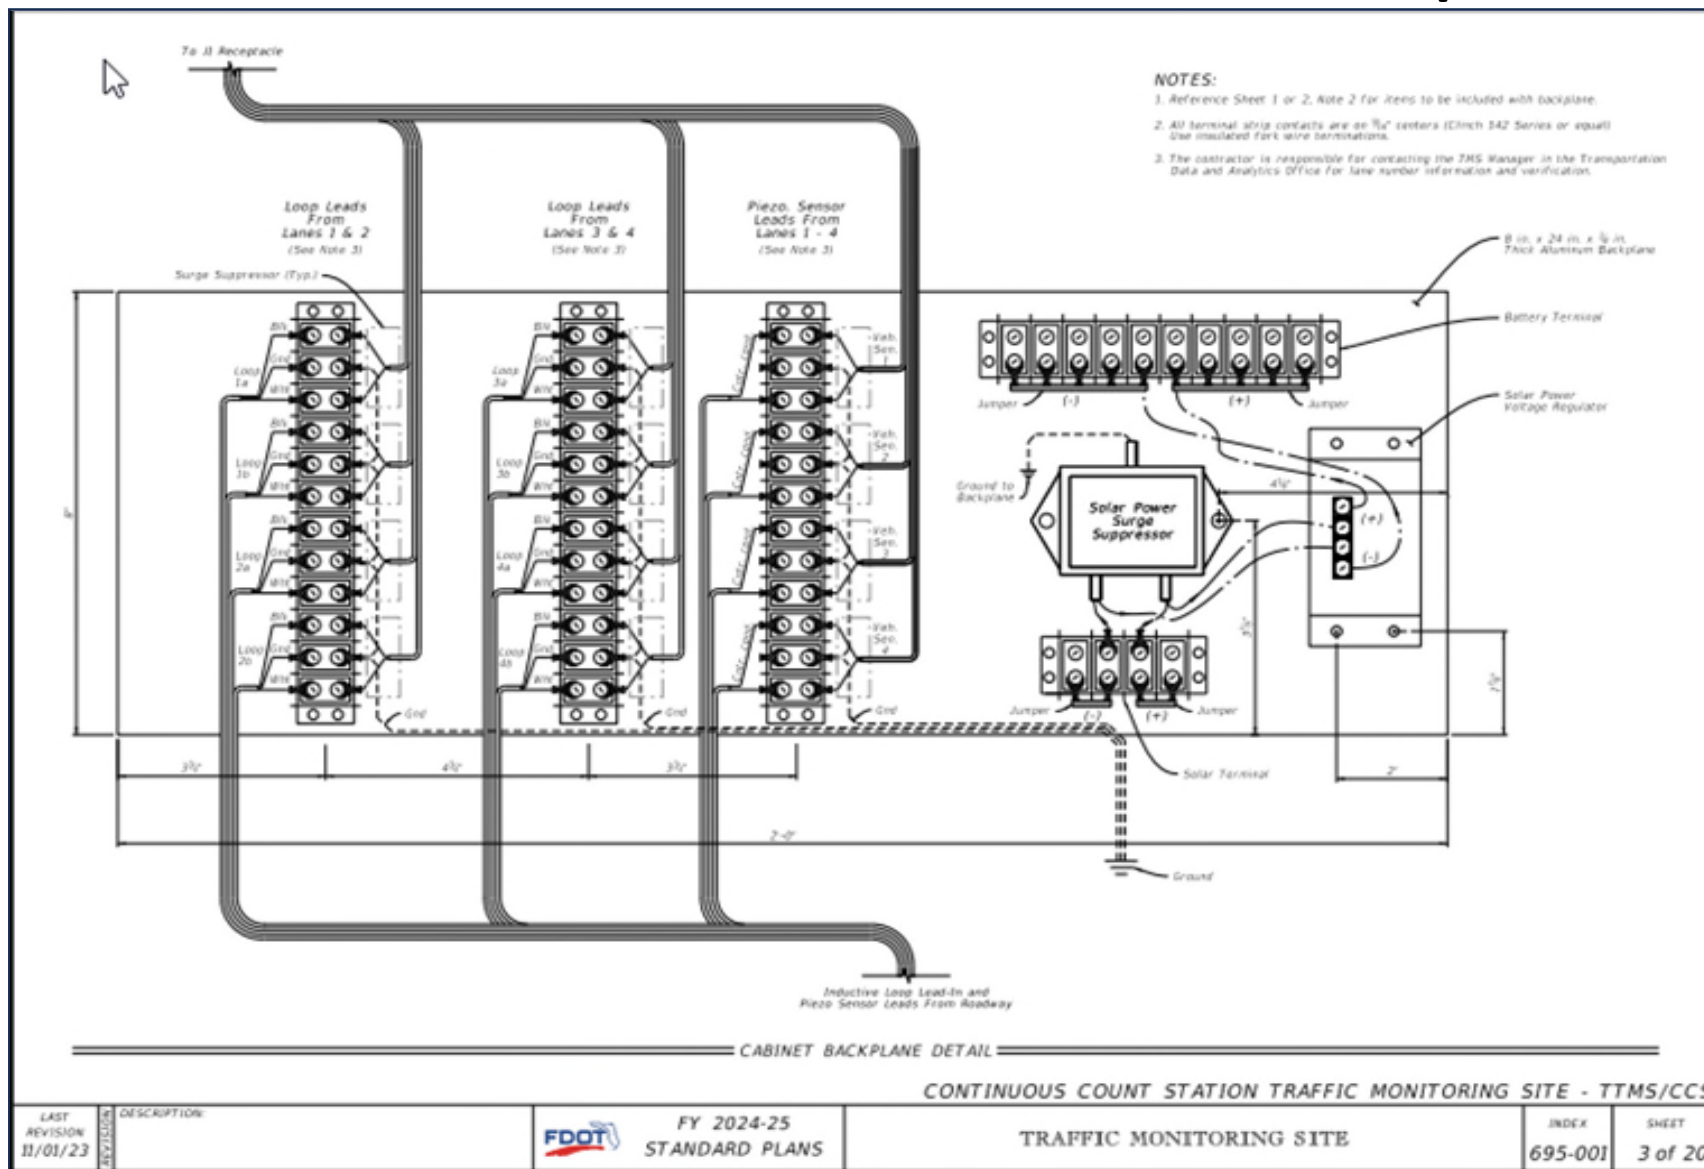

CONTINUOUS COUNT STATION TRAFFIC MONITORING SITE - TTMS/CCS

LAST REVISION 11/01/23	DESCRIPTION: FY 2024-25 STANDARD PLANS	TRAFFIC MONITORING SITE	INDEX 695-001	SHEET 3 of 20
---------------------------	--	-------------------------	------------------	------------------

## Sheet 4: Continuous Count Stations J1 and P1 pinouts

OPTION A

OPTION B

J1 RECEPTACLE PINOUT	
26 Recessed Male Pins	
A	Loop 1a (5a) white
B	Loop 1a (5a) black
C	Loop 1b (5b) red
D	Loop 1b (5b) black
E	Loop 2a (6a) green
F	Loop 2a (6a) blue
G	Loop 2b (6b) orange
H	Loop 2b (6b) tan
J	Loop 3a (7a) white
K	Loop 3a (7a) green
L	Loop 3b (7b) red
W	Loop 3b (7b) black
R	Grd
P	Loop 4a (8a) w/white
R	Loop 4a (8a) w/black
S	Loop 4b (8b) w/red
T	Loop 4b (8b) w/green
U	Piezo 1 (5) (+) w/blue
V	Piezo 1 (5) sh w/orange
W	Piezo 2 (6) (+) w/green
X	Piezo 2 (6) sh w/red
Y	Piezo 3 (7) (+) w/black
Z	Piezo 3 (7) sh w/red/blk
a	Piezo 4 (8) (+) red/ green
a	Piezo 4 sh

EQUIPMENT CABLE PLUG	
26 Female Pin Sockets	
A	Loop 1a (5a)
B	Loop 1a (5a)
C	Loop 1b (5b)
D	Loop 1b (5b)
E	Loop 2a (6a)
F	Loop 2a (6a)
G	Loop 2b (6b)
H	Loop 2b (6b)
R	Grd
J	Loop 3a (7a)
K	Loop 3b (7b)
L	Loop 3b (7b)
W	Loop 3b (7b)
P	Loop 4a (8a)
R	Loop 4a (8a)
S	Loop 4b (8b)
T	Loop 4b (8b)
U	Grd
U	Piezo 1 (5) (+)
V	Piezo 1 sh
W	Piezo 2 (6) (+)
X	Piezo 2 sh
Y	Piezo 3 (7) (+)
Z	Piezo 3 sh
a	Piezo 4 (8) (+)
a	Piezo 4 sh

**NOTES:**

- The contractor is responsible for contacting the TMS Manager in the Transportation Data and Analytics Office for lane number information and verification.
- The equipment cable can accommodate up to four lanes of inductive loop and piezo sensor inputs. (Reference Sheet 1 for cabinet layout)
- For more than four lanes and up to eight lanes of inputs, the following options are available:
  - Second Vehicle Speed/Class. Unit and separate equipment cable connecting to a second J1 receptacle; or
  - Single Vehicle Speed/Class. Unit capable of up to eight lanes of inputs and a single equipment cable with split ends to fit two J1 receptacles. (Reference Sheet 2 detail)
- Numbers in parenthesis in the pinout chart identify lane numbers when a second backplane for lanes 3 through 8 is required.
- Cable Ends must be fabricated to fit the vehicle Speed/Classification Unit.

**ADDED: Title: Pinout Chart, Receptacle, and Plug Details**

UPDATE TITLE: Continuous Count Station Traffic Monitoring Site TTMS/CCS →

LAST REVISION	DESCRIPTION
11/01/23	11/01/23

FY 2023-24
STANDARD PLANS

TRAFFIC MONITORING SITE
-------------------------

INDEX	SHEET
695-001	20
	4 of 9



## Sheet 4: Continuous Count Stations J1 and P1 pinouts

J1 RECEPTACLE PINOUT	
26 Recessed Male Pins	
A	Loop 2a (5a) white
B	Loop 2a (5a) black
C	Loop 2b (5b) red
D	Loop 2b (5b) black
E	Loop 2a (6a) green
F	Loop 2a (6a) blue
G	Loop 2b (6b) orange
H	Loop 2b (6b) tan
J	Loop 2a (7a) white
K	Loop 2a (7a) green
L	Loop 2b (7b) red
M	Loop 2b (7b) black
N	GNd
P	Loop 4a (8a) w/white
R	Loop 4a (8a) w/black
S	Loop 4b (8b) w/red
T	Loop 4b (8b) w/green
U	Piezo 2 (3) (4) w/blue
V	Piezo 2 (3) sh w/orange
W	Piezo 2 (6) (4) w/green
X	Piezo 2 (6) sh w/red
Y	Piezo 3 (7) (4) w/black
Z	Piezo 3 (7) sh w/red/blk
a	Piezo 4 (8) (4) red/green
b	Piezo 4 (8) sh red/white
d	GNd green

P1 EQUIPMENT CABLE PLUG		
26 Female Pin Slots		
A	Loop 2a (5a)	CONNECT TO EQUIPMENT UNIT
B	Loop 2a (5a)	
C	Loop 2b (5b)	
D	Loop 2b (5b)	
E	Loop 2a (6a)	CONNECT TO EQUIPMENT UNIT
F	Loop 2a (6a)	
G	Loop 2b (6b)	
H	Loop 2b (6b)	
W	GNd	CONNECT TO EQUIPMENT UNIT
J	Loop 2a (7a)	
K	Loop 2a (7a)	
L	Loop 2b (7b)	
M	Loop 2b (7b)	CONNECT TO EQUIPMENT UNIT
P	Loop 4a (8a)	
R	Loop 4a (8a)	
S	Loop 4b (8b)	
T	Loop 4b (8b)	CONNECT TO EQUIPMENT UNIT
d	GNd	
U	Piezo 1 (3) (4)	
V	Piezo 1 sh	
W	Piezo 2 (6) (4)	CONNECT TO EQUIPMENT UNIT
X	Piezo 2 sh	
Y	Piezo 3 (7) (4)	
Z	Piezo 3 sh	
a	Piezo 4 (8) (4)	CONNECT TO EQUIPMENT UNIT
d	Piezo 4 sh	

**NOTES:**

- The contractor is responsible for contacting the TMS Manager in the Transportation Data and Analytics Office for lane number information and verification.
- The equipment cable can accommodate up to four lanes of inductive loop and piezo sensor inputs. (See Sheet 2 for cabinet layout).
- For more than four lanes and up to eight lanes of inputs, the following options are available:
  - Second Vehicle Speed/Classification Unit and separate equipment cable connecting to a second J1 receptacle; or
  - Single Vehicle Speed/Classification Unit capable of up to eight lanes of inputs and a single equipment cable with split ends to fit two J1 receptacles. (See Sheet 2 detail)
- Numbers in parentheses in the pinout chart identify lane numbers when a second backplate for lanes 5 through 8 is required.
- Cable Ends must be fabricated to fit the vehicle Speed/Classification Unit.

**PINOUT, RECEPTACLE, AND PLUG DETAILS**

**CONTINUOUS COUNT STATION TRAFFIC MONITORING SITE - TTMS/CCS**

LAST REVISION: 11/01/23

DESCRIPTION:

FY 2024-25  
STANDARD PLANS

TRAFFIC MONITORING SITE

INDEX  
695-001

SHEET  
4 of 20



## Sheet 5: Continuous Count Stations Lane Layout

**ADDED: Non Weight...**

**ADDED: Traffic Flow symbols**

**ADDED: Non Weight...**

**UPDATED NOTES**

**Note 3:** Twist loop leads at the rate of 8 to 16 twists per foot. Extend the twisted pair loop wire directly to the cabinet. No splicing of the loop leads will be permitted.

**Note 5:** See Index 635-001 for pull box and concrete apron details

**Renumbered**

**NOTES:**

1. Install axle sensors and loops associated with axle sensors after placement of the friction course
2. Cut a 3/4" deep slot for the inductive loops. Loop slots will be cut wide enough to allow unforced placement of the wire into the bottom of the slot. Four turns of #14 AWG, place the TW5A 51-7 copper wire in the slot. Place short pieces of locker rod 1/2" to 3/4" in length every 18" to 24" to hold the loop wire in the bottom of the slot.
3. Twist loop leads at the rate of 8 to 16 twists per foot. ~~Twist loop leads at the rate of 8 to 16 twists per foot. Extend the twisted pair loop wire directly to the cabinet. No splicing of the loop leads will be permitted.~~
4. Marking will consist of two rounds of contrasting colored tape, one color for the lane number and the second color for the lead loop location in the lane. The first band closest to the cabinet will represent the lane outside one round of tape will be for lane 1 and two rounds will be lane 2, etc. The lead loop in lane one would have one round of tape and a second round of a contrasting colored tape for the lead loop in the lane. The trailing loop would not have a second contrasting colored band of tape.
5. See Index 635-001 for pull box and apron details.
6. ~~Splicing will be performed using splice kits designed for direct burial. Splice kits will include splice or wire connectors and a housing with sufficient strength to support the splice connections. Taped splices are not permitted.~~
7. Use a chalk line or string and paint to layout the position of the sensor and lead-in cable slots. Ensure saw cuts do not deviate more than 0.5 inches from the chalk line. Use a single blade or ganged blade saw wide enough to cut the axle sensor slot at full width in a single pass. Cutting two slots and chipping out roadway material between them is not allowed.
8. All sensor slots and any cuts in the roadway will be thoroughly blown out to ensure there is no dust or debris prior to installation of sensors or leads.

**DELETED: Note 6**

**EXIT WINDOW DETAIL B**

**EXIT WINDOW DETAIL C**

**MOVED TO: Sheet 18**

**CHANGED TO: TTMS/CCS**

**END VIEW (Axle Sensor Slot) DETAIL E**

**TYPICAL FOR UP TO 4 LANES OF SENSOR LEADS PULLED TO ONE SIDE OF THE ROADWAY**


**UPDATE TITLE: Continuous Count Station Traffic Monitoring Site TTMS/CCS**

**LANE LAYOUT FOR TTMS INDUCTIVE LOOP AND AXLE SENSOR**





## Sheet 5: Continuous Count Stations Lane Layout: 1 to 4 lanes

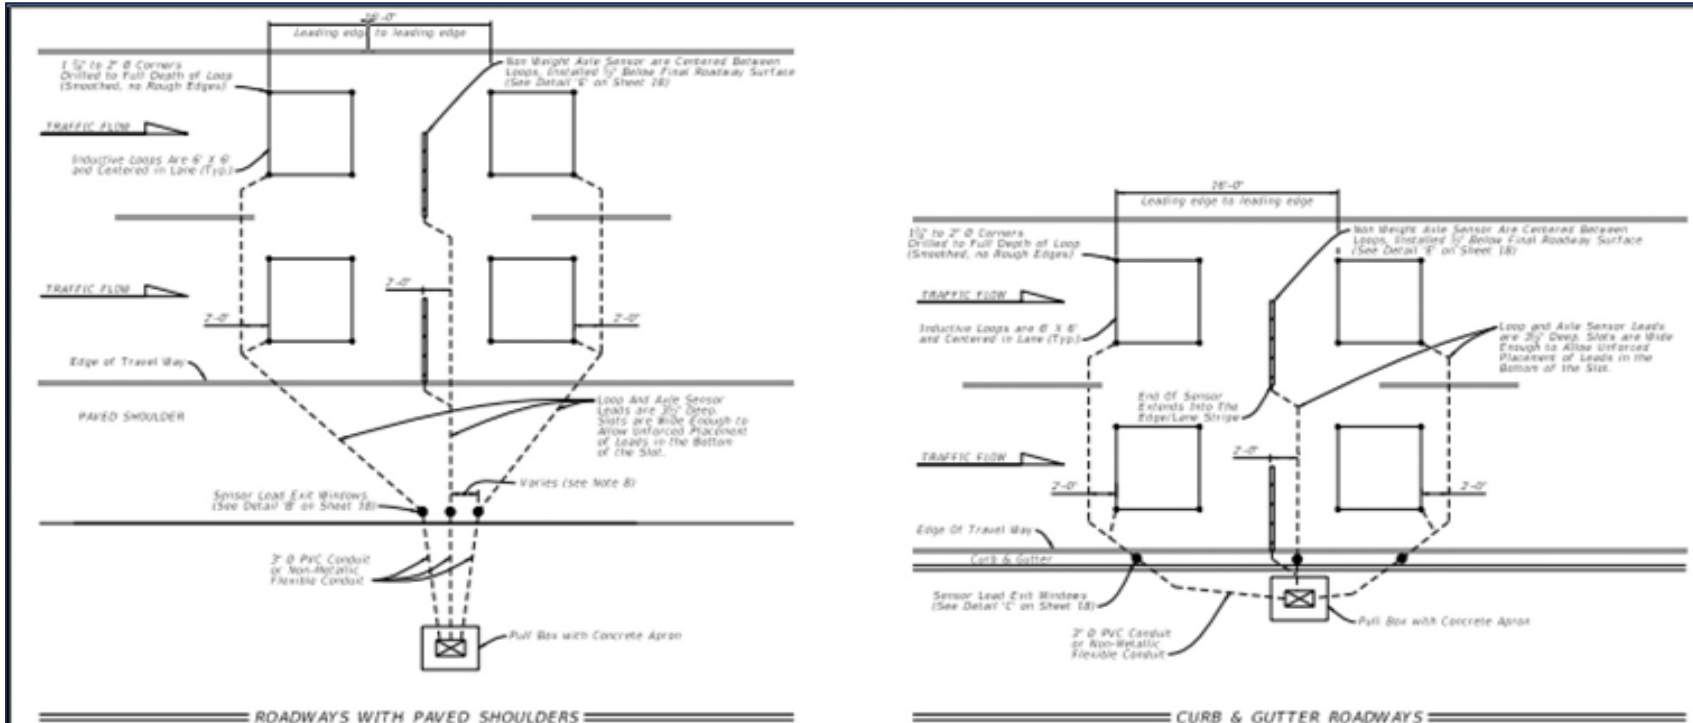

**NOTES:**

1. Install axle sensors and loops associated with axle sensors after placement of the friction course.
2. Cut a 3/4" deep slot for the inductive loops. Loop slots will be cut wide enough to allow unforced placement of the wire into the bottom of the slot. Four turns of #14 AWG, place the JMSA 51-7 copper wire in the slot. Place short pieces of bucker rod (2" to 3" in length) every 20" to 24" to hold the loop wire in the bottom of the slot.
3. Twist loop leads at the rate of 8 to 16 twist per foot. Extend the twisted pair loop wire directly to the cabinet. No splicing of the loop leads will be permitted.
4. Marking will consist of two rounds of contrasting colored tape, one color for the lane number and the second color for the lead loop location in the lane. The first band closest to the cabinet will represent the lane number, one round of tape will be for lane 1 and two rounds will be lane 2, etc. The lead loop in lane one would have one round of tape and a second round of a contrasting colored tape for the lead loop in the lane. The trailing loop would not have a second contrasting colored band of tape.
5. See Index 635-001 for pull box and concrete apron details.
6. Use a chalk line or string and pair to layout the position of the sensor and lead-in cable slots. Ensure saw cuts do not deviate more than 1/8" from the chalk line. Use a single blade or ganged blade saw wide enough to cut the axle sensor slot at full width in a single pass. Cutting two slots and chipping out roadway material between them is not allowed.
7. All sensor slots and any cuts in the roadway will be thoroughly blown out to ensure there is no dust or debris prior to installation of sensors or leads.
8. Install Exit Windows at least 2' apart.

LANE LAYOUT FOR TTMS/CCS INDUCTIVE LOOP AND AXLE SENSORS  
(Typical for up to 4 Lanes of Sensor Leads Pulled to one Side of the Roadway)


CONTINUOUS COUNT STATION TRAFFIC MONITORING SITE - TTMS/CCS

LAST REVISION 11/01/23	DESCRIPTION: FY 2024-25 STANDARD PLANS	TRAFFIC MONITORING SITE	INDEX 695-001	SHEET 5 of 20
---------------------------	--	-------------------------	------------------	------------------







## Sheet 6: *New* Sheet - Short Term Count Stations (STMS/PTMS)

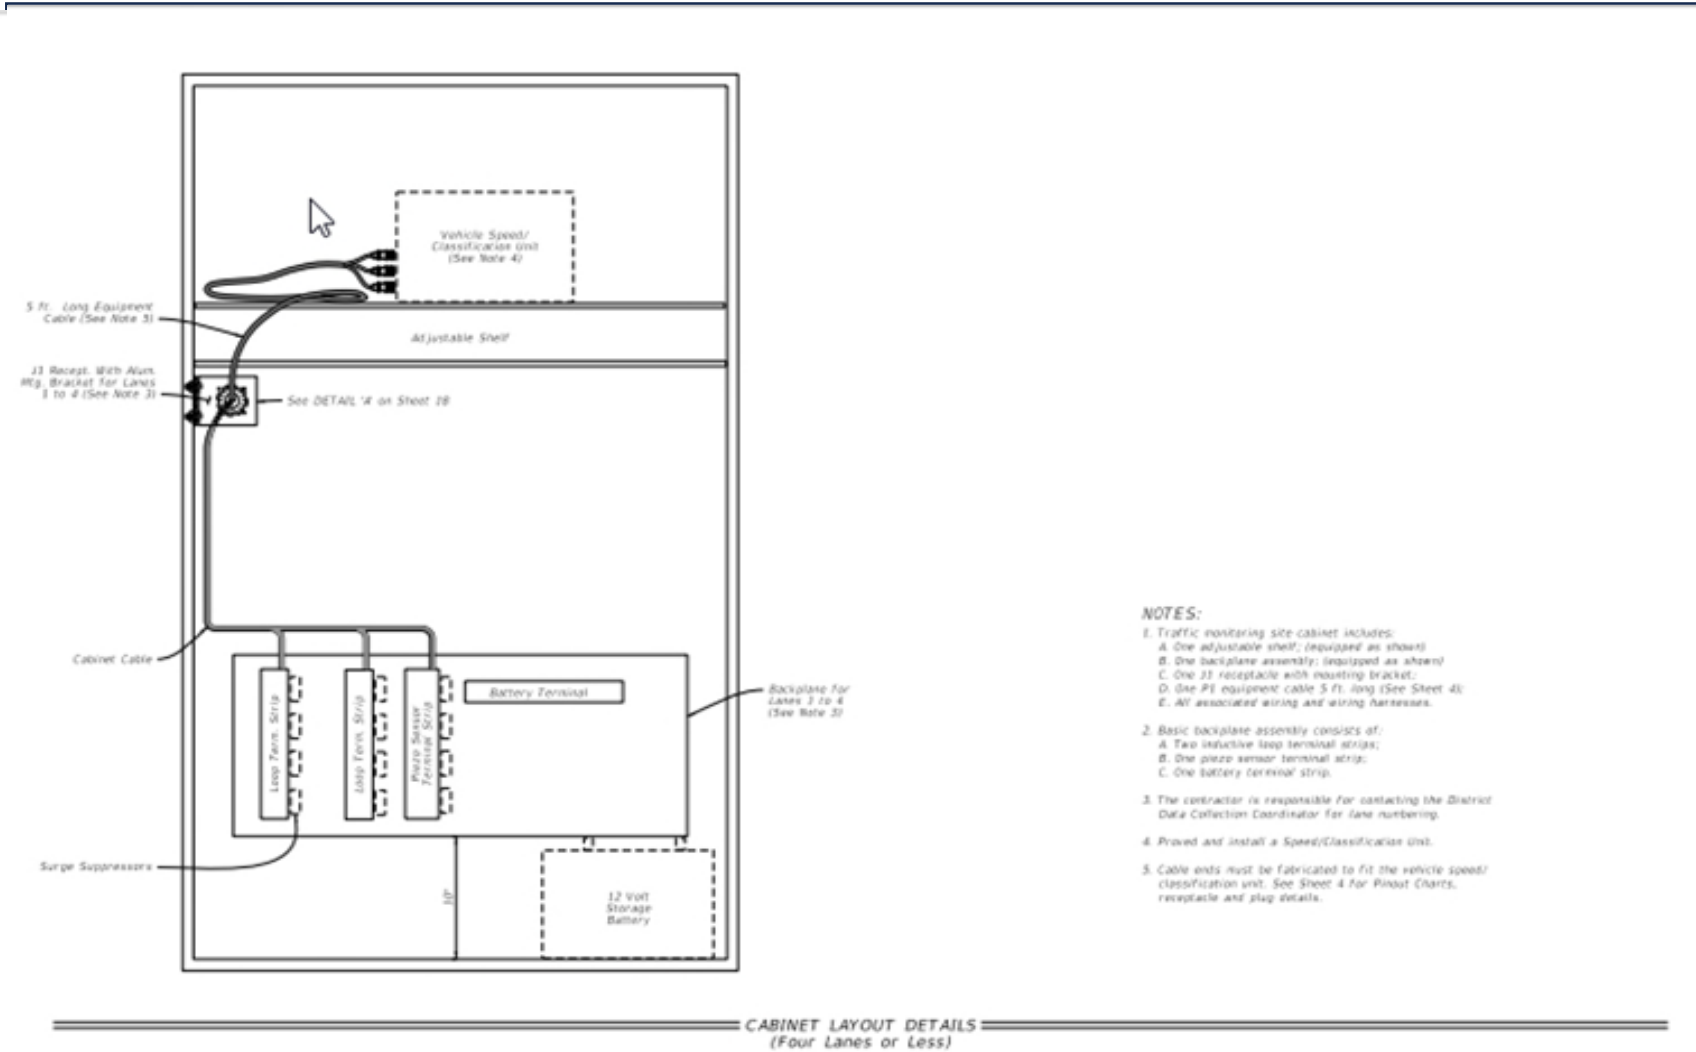


## Sheet 7: Sheet Deletion

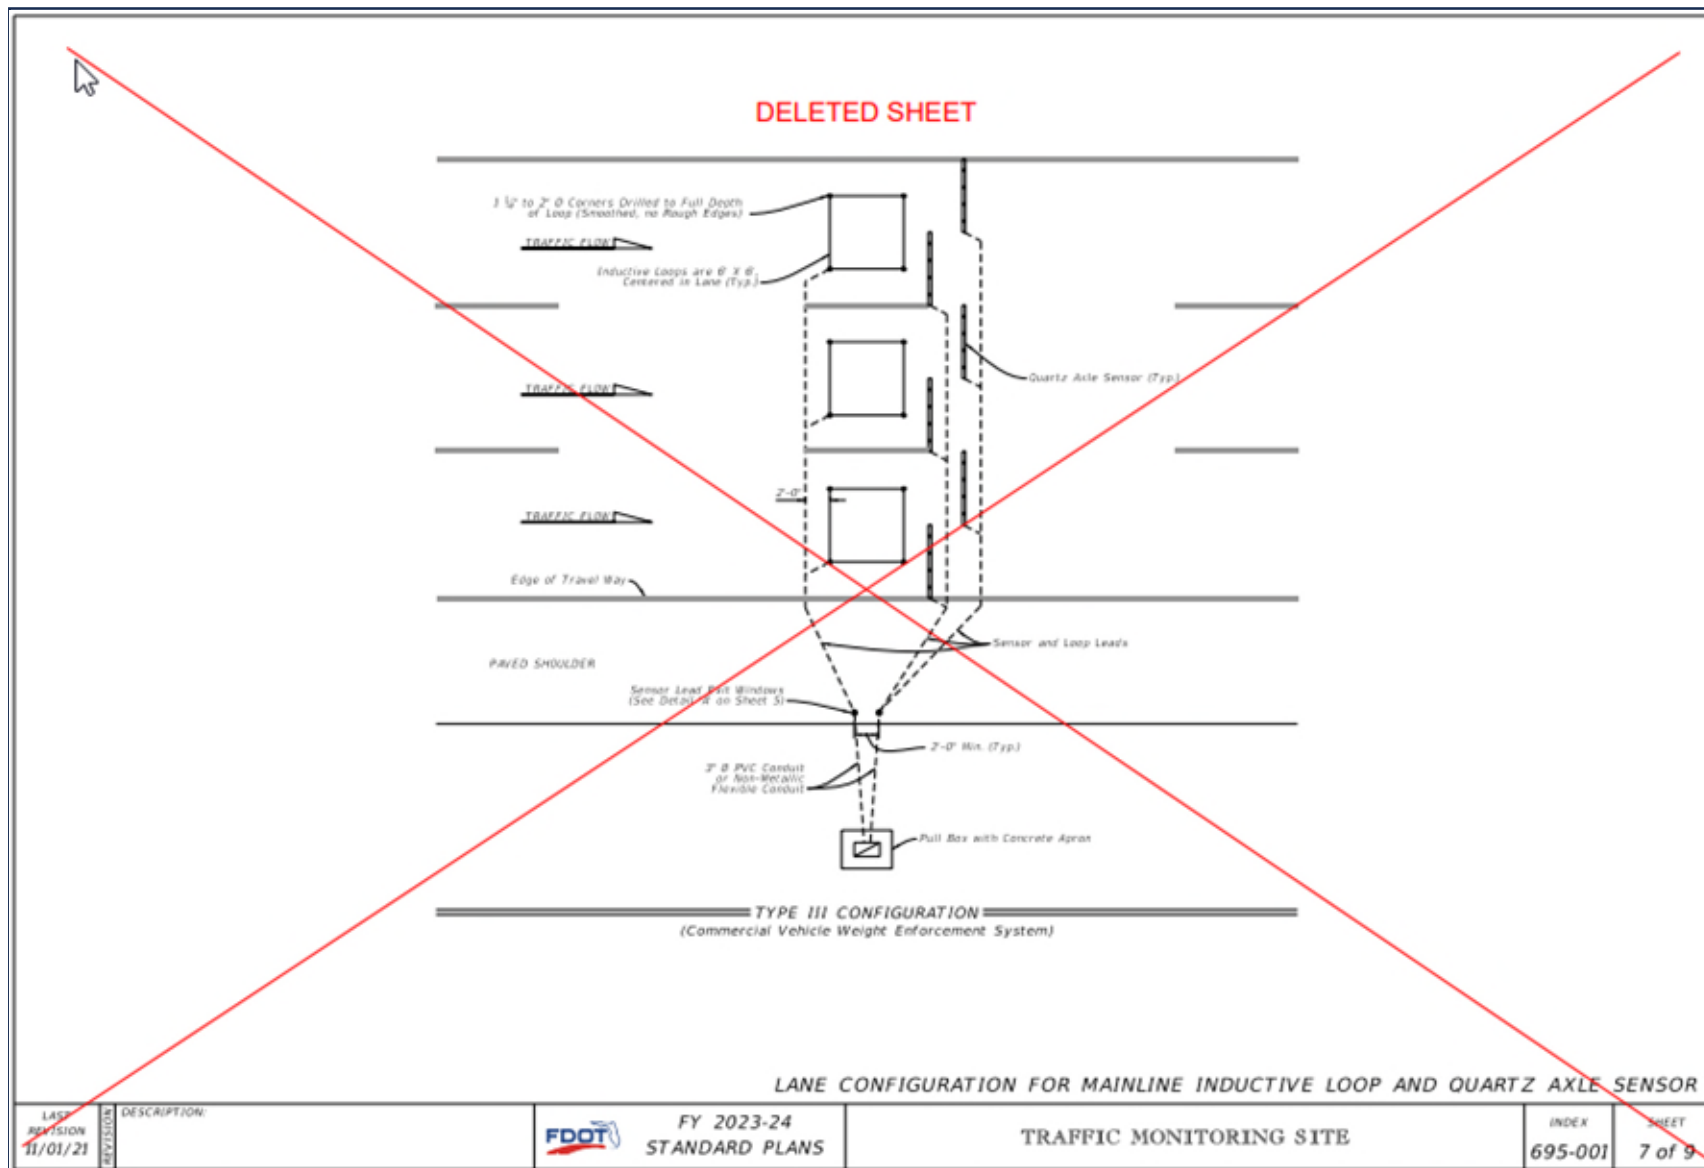


## Sheet 7: *New* Sheet: Short Term Cabinet Layout – 5 to 8

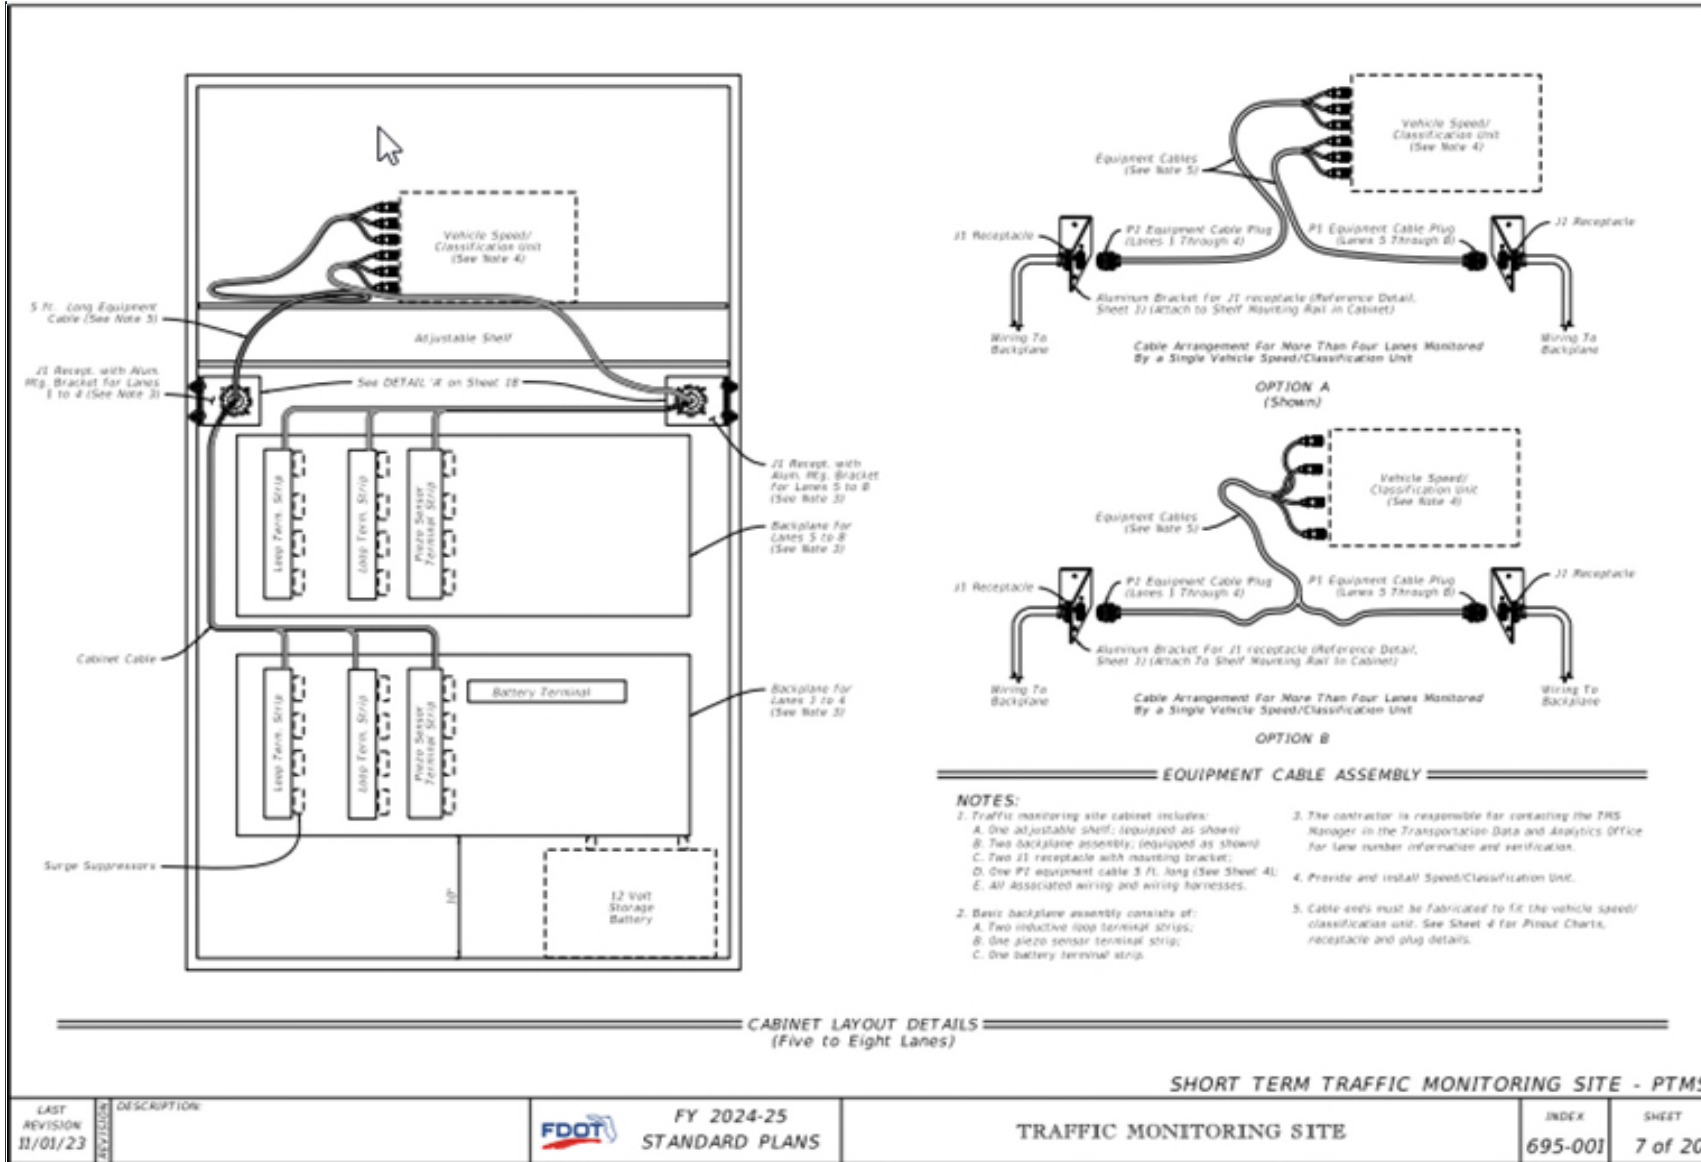

## Sheet 8: *New Sheet* – Short Term Lane Layout ( 1- 4 lanes)

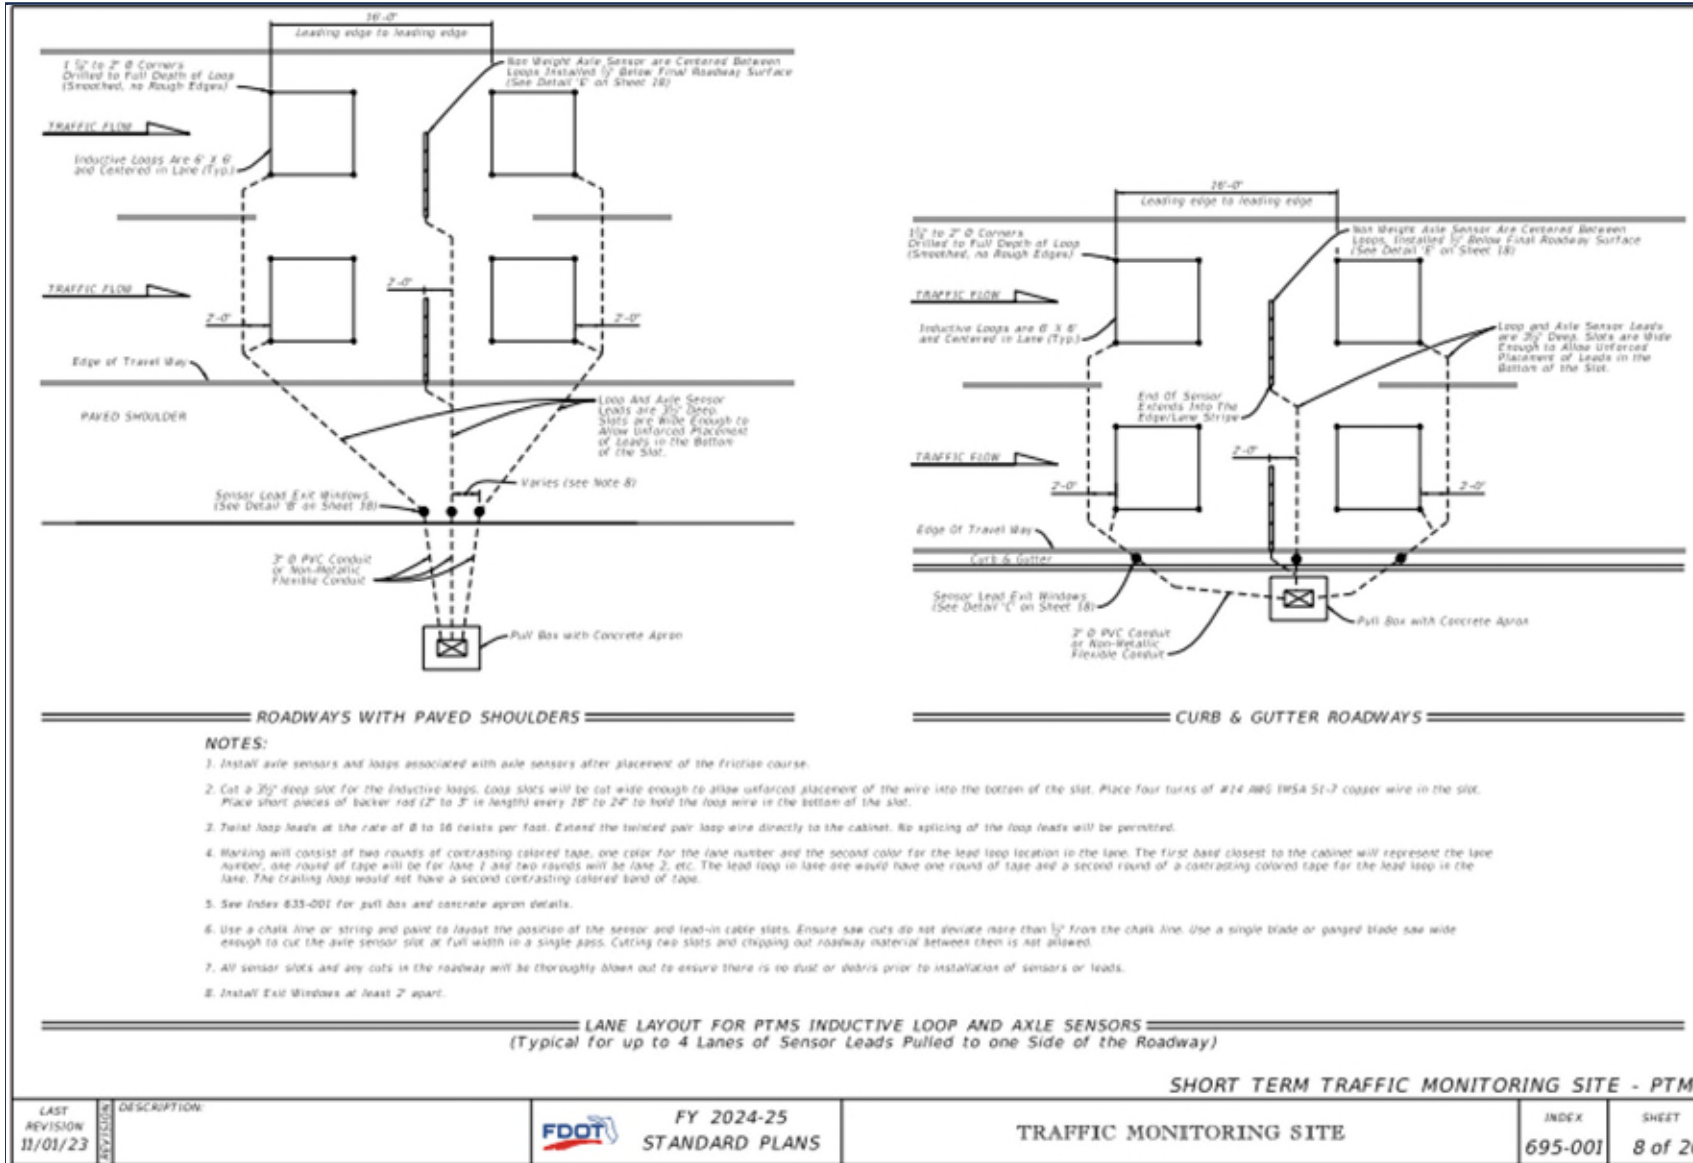

## Sheet 9: *New Sheet* – Weigh-in-Motion Site Cabinet Layout

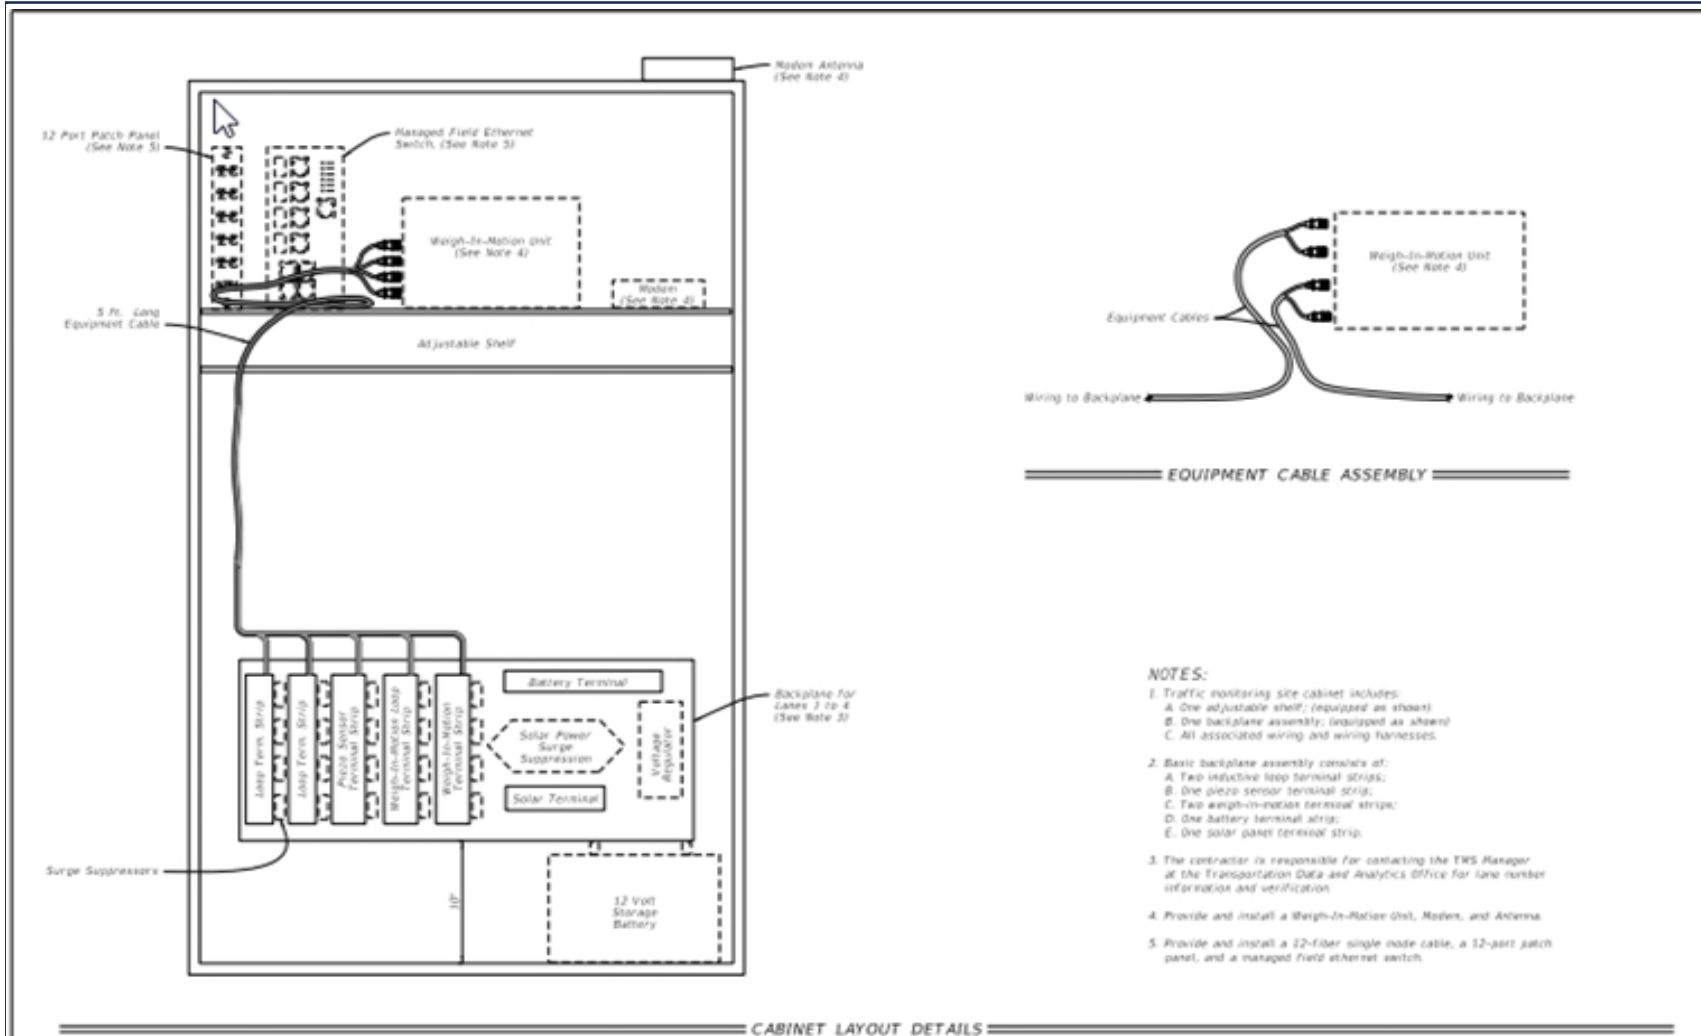


- NOTES:**
- Traffic monitoring site cabinet includes:
    - One adjustable shelf; (equipment as shown)
    - One backplane assembly; (equipped as shown)
    - All associated wiring and wiring harnesses.
  - Basic backplane assembly consists of:
    - Two inductive loop terminal strips;
    - One piezo sensor terminal strip;
    - Two weigh-in-motion terminal strips;
    - One battery terminal strip;
    - One solar panel terminal strip.
  - The contractor is responsible for contacting the TRS Manager at the Transportation Data and Analytics Office for lane number information and verification.
  - Provide and install a Weigh-in-Motion Unit, Modem, and Antenna.
  - Provide and install a 12-fiber single mode cable, a 12-port patch panel, and a managed fiber ethernet switch.






## Sheet 10: *New* Sheet – WIM Station Cabinet Backplane

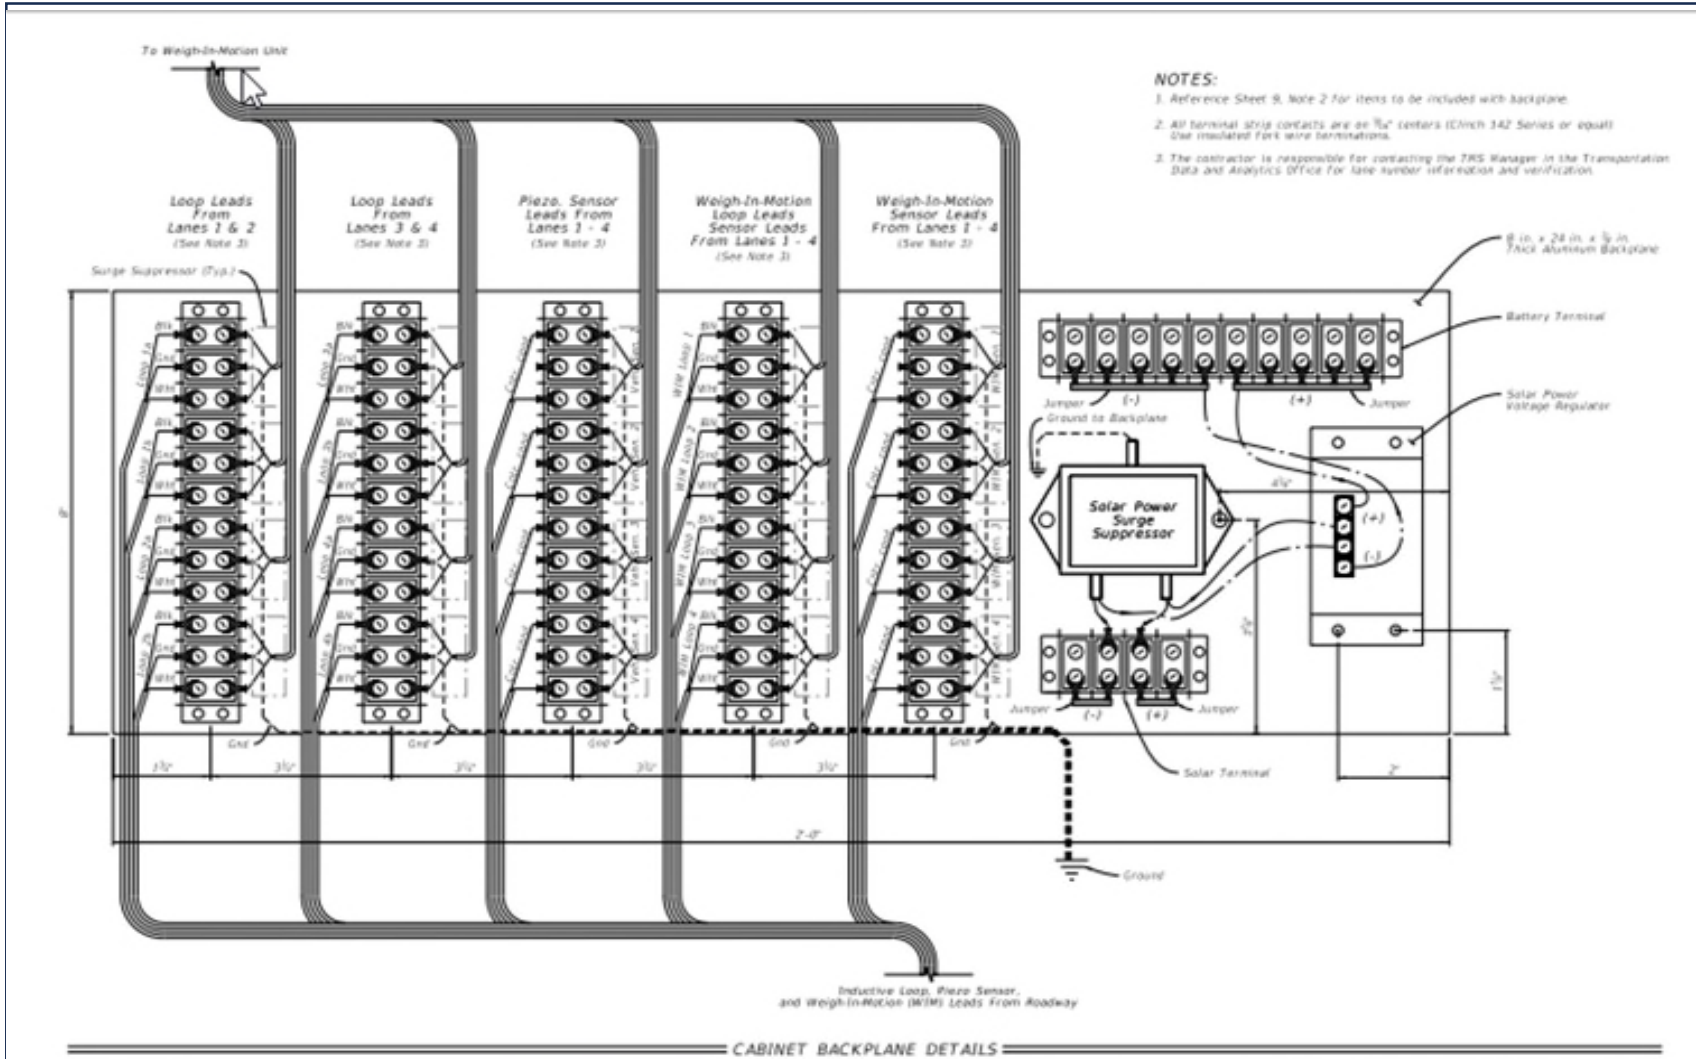


## Sheet 11: WIM Continuous Count Stations Lane Layout

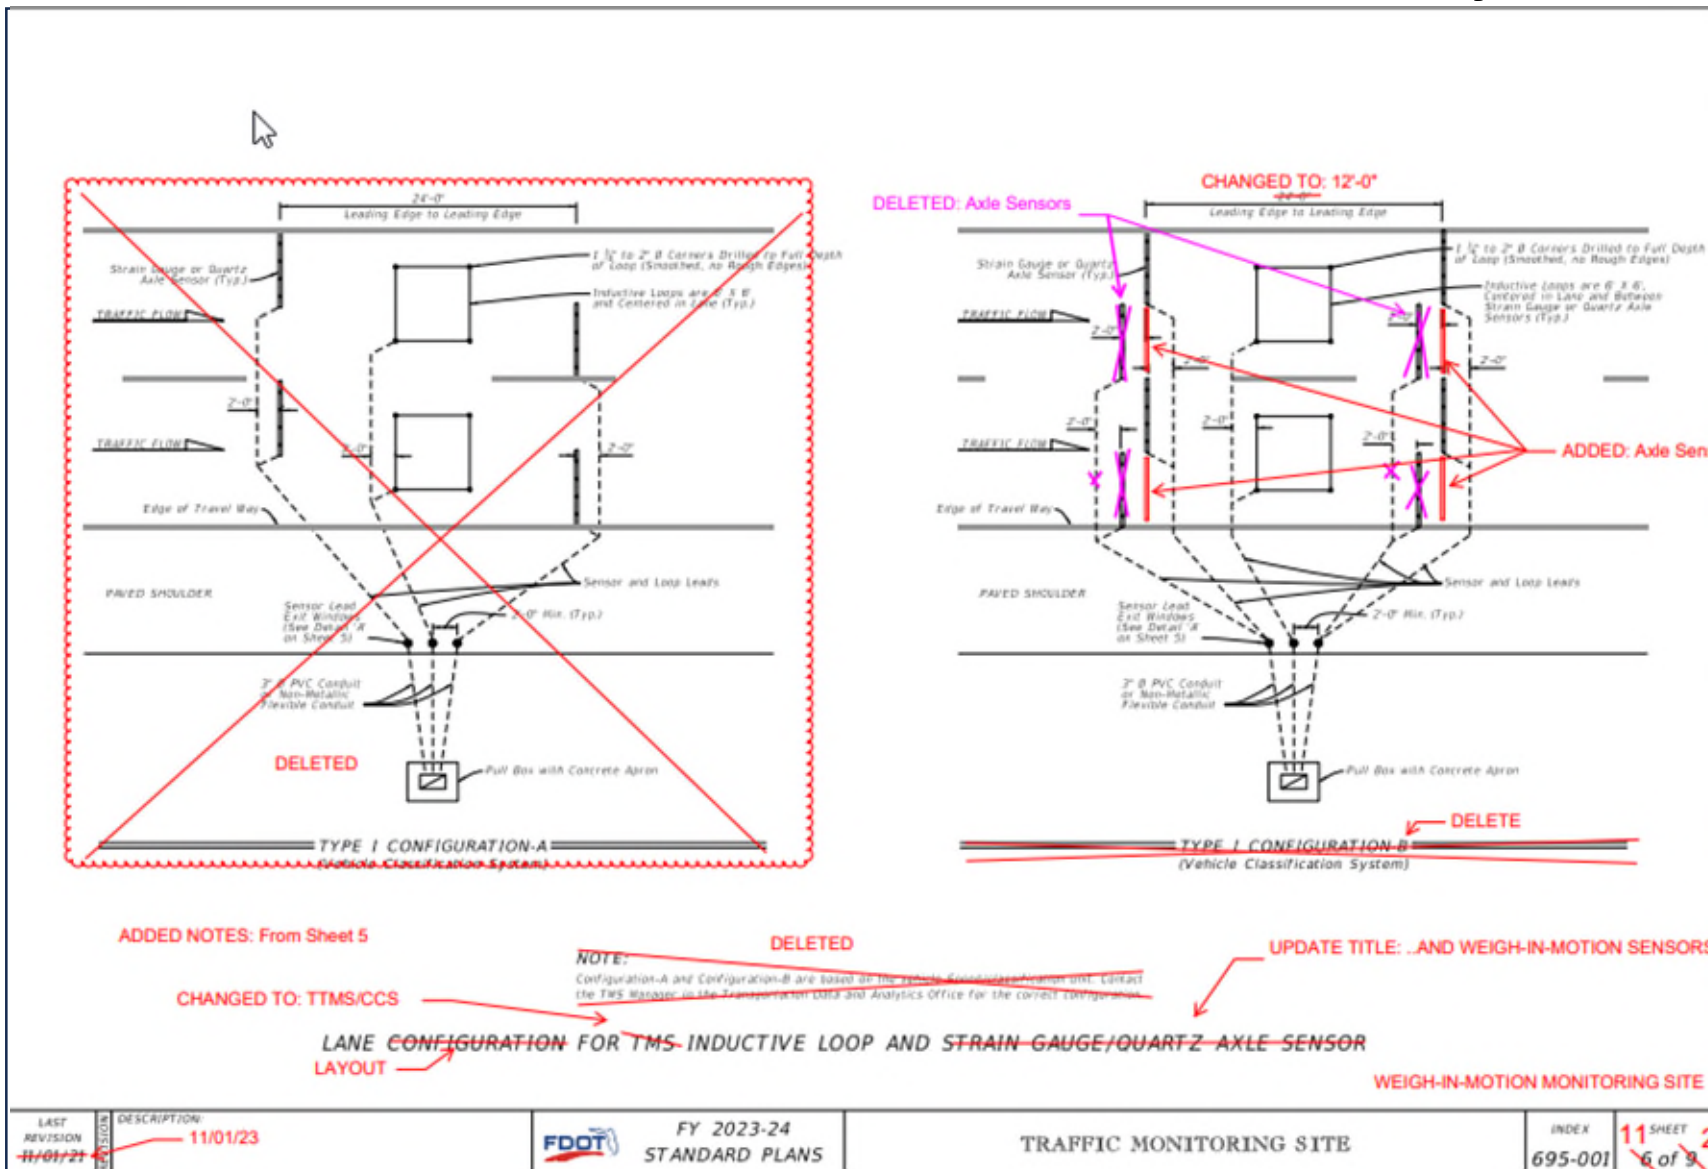

## Sheet 11: WIM Continuous Count Stations Lane Layout

### NOTES:

1. Install axle sensors and loops associated with axle sensors after placement of the friction course.
2. Cut a 3/2" deep slot for the inductive loops. Loop slots will be cut wide enough to allow unforced placement of the wire into the bottom of the slot. Place four turns of #14 AWG JMSA 51-7 copper wire in the slot. Place short pieces of bucker rod (2" to 3" in length) every 18" to 24" to hold the loop wire in the bottom of the slot.
3. Twist loop leads at the rate of 8 to 16 twists per foot. Extend the twisted pair loop wire directly to the cabinet. No splicing of the loop leads will be permitted.
4. Marking will consist of two rounds of contrasting colored tape, one color for the lane number and the second color for the lead loop location in the lane. The first band closest to the cabinet will represent the lane number, one round of tape will be for lane 1 and two rounds will be lane 2, etc. The lead loop in lane one would have one round of tape and a second round of a contrasting colored tape for the lead loop in the lane. The trailing loop would not have a second contrasting colored band of tape.
5. See Index 625-001 for pull box and concrete apron details.
6. Use a chalk line or string and paint to layout the position of the sensor and lead-in cable slots. Ensure saw cuts do not deviate more than 1/2" from the chalk line. Install the sensor according to manufacturer's recommendations.
7. All sensor slots and any cuts in the roadway will be thoroughly blown out to ensure there is no dust or debris prior to installation of sensors or leads.
8. Install Exit Windows at least 2' apart.

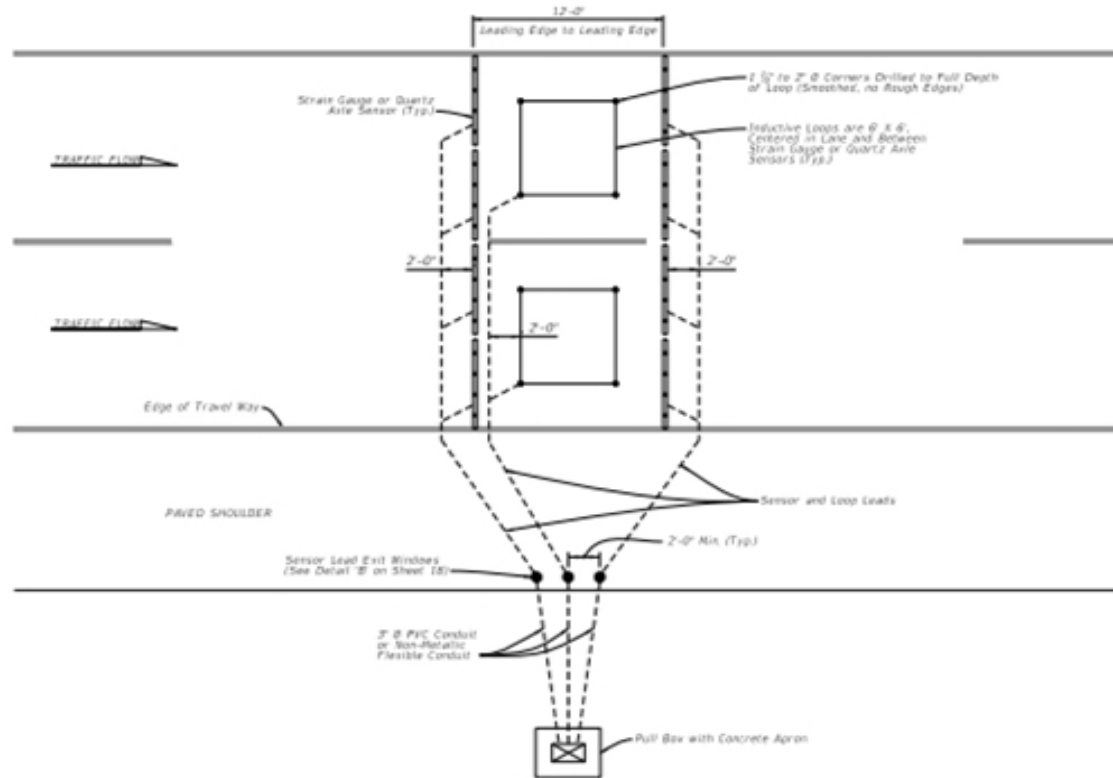


LANE LAYOUT FOR TTMS/CCS INDUCTIVE LOOP AND WEIGH-IN-MOTION SENSORS

### WEIGH-IN-MOTION MONITORING SITE

LAST REVISION 11/01/23	DESCRIPTION	FDOT FY 2024-25 STANDARD PLANS	TRAFFIC MONITORING SITE	INDEX 695-001	SHEET 11 of 20
---------------------------	-------------	--------------------------------------	-------------------------	------------------	-------------------



## Sheet 12: *New* Sheet – Non-Motorized Continuous Count Cabinet

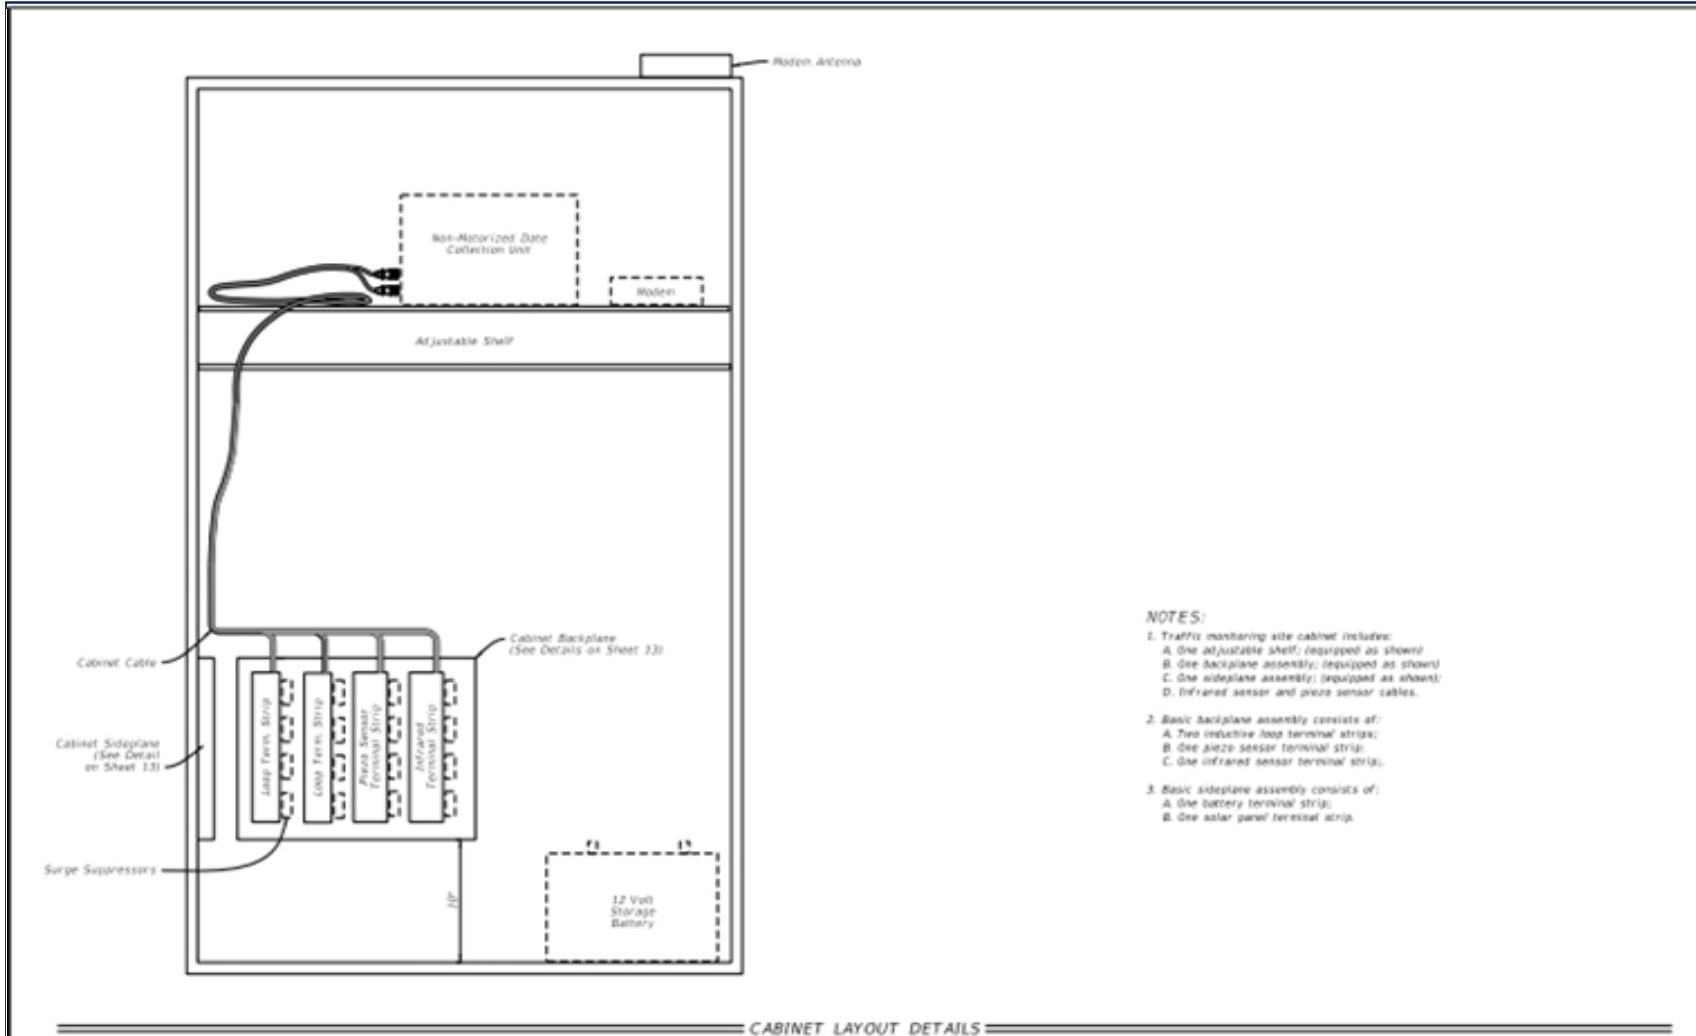

- NOTES:**
- Traffic monitoring site cabinet includes:
    - One adjustable shelf; (equipped as shown)
    - One backplane assembly; (equipped as shown)
    - One sideplane assembly; (equipped as shown)
    - Infrared sensor and piezo sensor cables.
  - Basic backplane assembly consists of:
    - Two inductive loop terminal strips;
    - One piezo sensor terminal strip;
    - One infrared sensor terminal strip.
  - Basic sideplane assembly consists of:
    - One battery terminal strip;
    - One solar panel terminal strip.




CABINET LAYOUT DETAILS

NON-MOTORIZED MONITORING SITE


LAST REVISION: 11/01/23	DESCRIPTION:	FY 2024-25 STANDARD PLANS	TRAFFIC MONITORING SITE	INDEX 695-001	SHEET 12 of 20
-------------------------	--------------	------------------------------	-------------------------	------------------	-------------------

## Sheet 13: *New* Sheet – Nonmotorized Continuous Side and Backplane

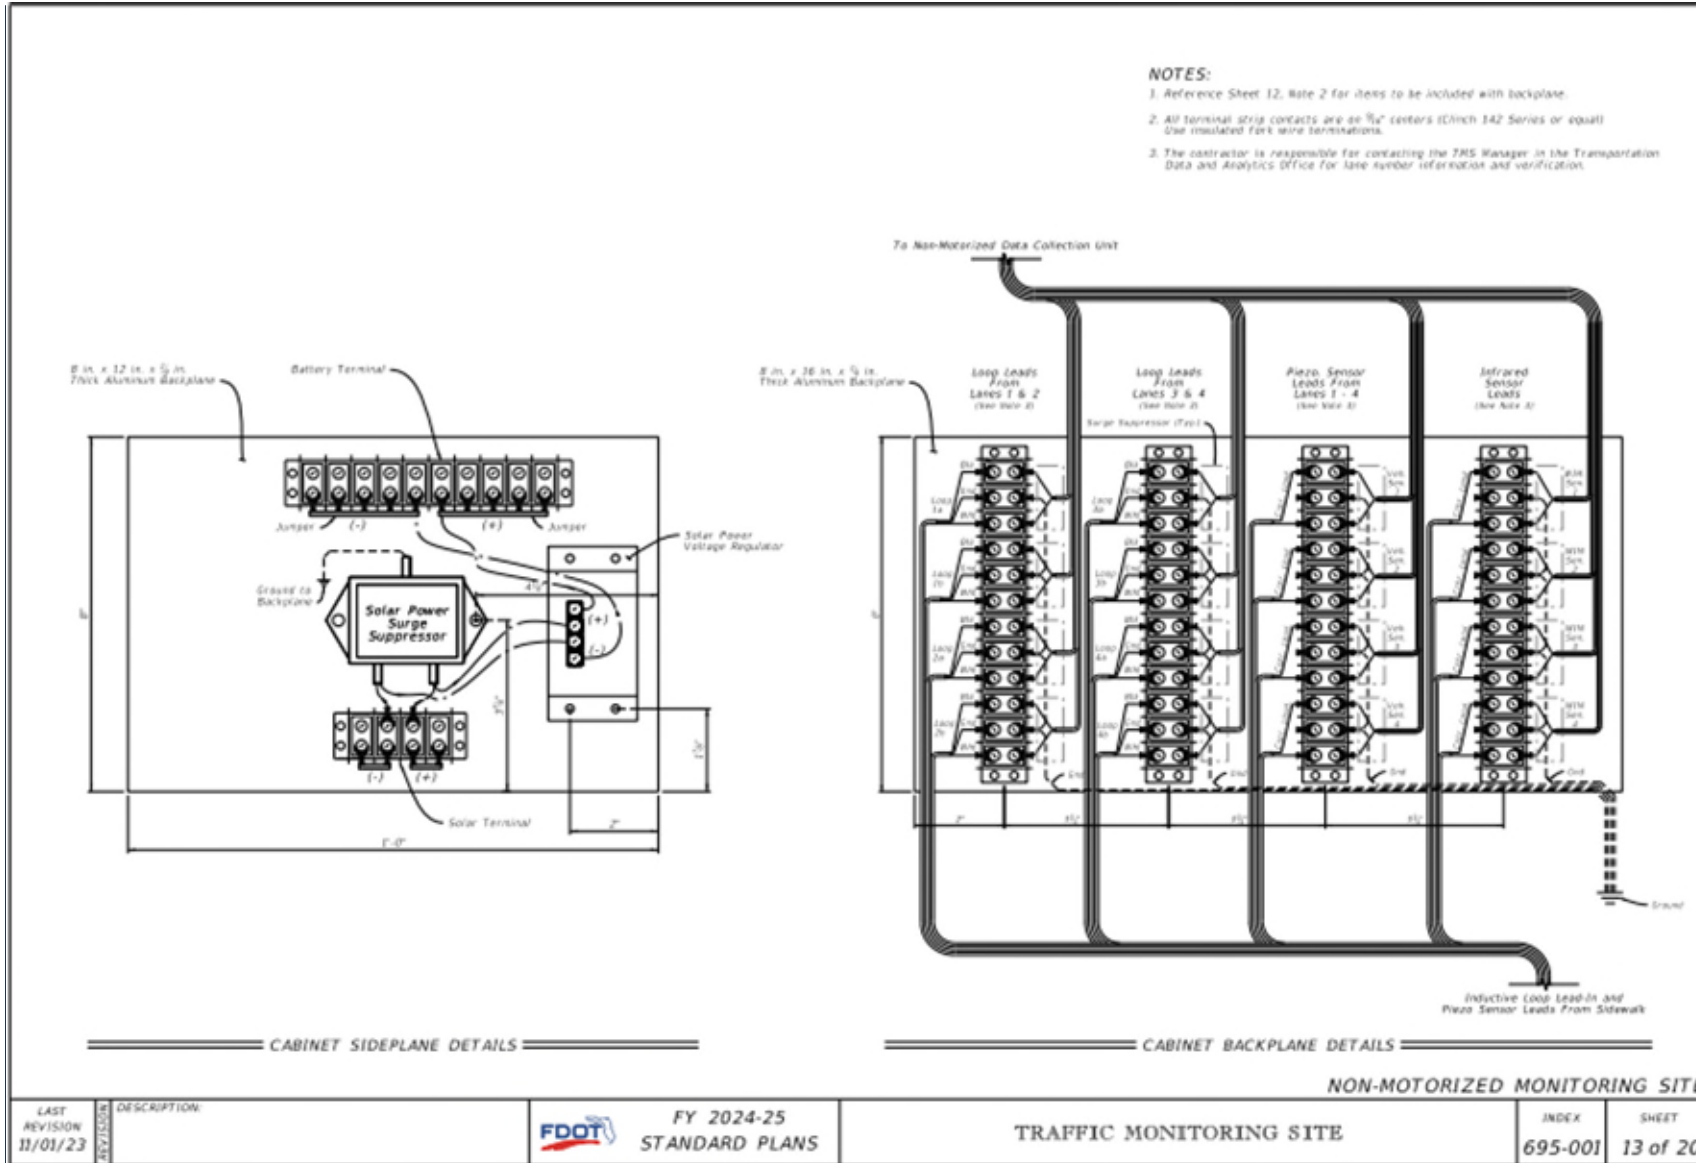




## Sheet 14: *New* Sheet – Nonmotorized Sensor Layout (Narrow Side Path)

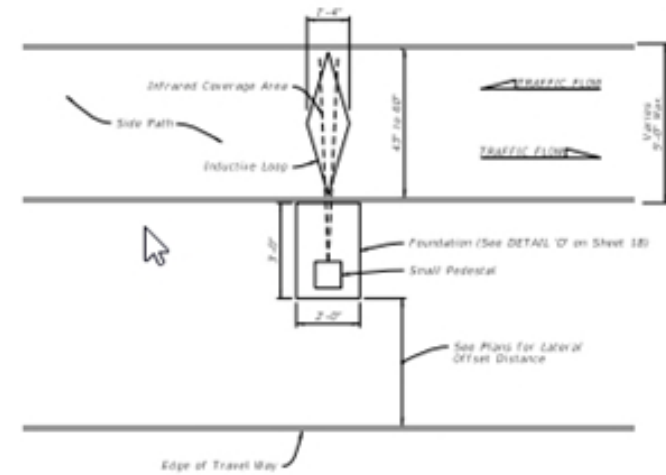

**SINGLE LOOP ASSEMBLY**  
(Directional Recognition With Infrared)

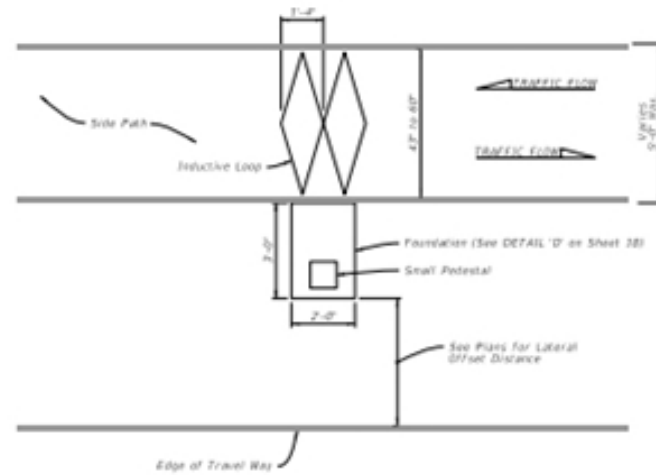

**DUAL LOOP ASSEMBLY**  
(Directional Recognition Without Infrared)


**NON-MOTORIZED MONITORING SITE NOTES:**

1. Use a chalk line or string and pair to layout the position of the sensor and lead-in cable slots. Ensure saw cuts do not deviate more than 0.5 inches from the chalk line. Use a single blade or ganged blade saw wide enough to cut the axle sensor at full width in a single pass. Cutting two slots and chipping out roadway material between them is not allowed.
2. Cut a 5/8" to 1/2" wide slot.
3. All sensor slots and any cuts in the pathway will be thoroughly blown out to ensure there is no dust or debris prior to installation of the loops and leads.
4. Place eight turns of loop wire in each slot.
5. Twist loop leads at the rate of 10 twists per foot.
6. Extend the twisted pair loop wire directly to the termination point with no splices.
7. For the side-by-side configuration, install the farthest loop lead through the rear side loop slot.
8. At the termination point, for north-south pathways, mark the north piezometer and inductive loop sensor lead(s) with one tape. For east-west pathways, mark the east piezometer and inductive loop sensor lead(s) with one tape. Mark the south and west sensor leads(s) with two tapes.
9. Do not point infrared sensors towards a path where motor vehicles pass, a metallic or reflective surface, surfaces exposed to sunlight or vegetation that are likely to move.
10. Avoid placing infrared sensors near heat sources, steep surfaces, high voltage power cables, and telecommunications equipment.
11. If crossing pavement joints see DETAIL 'F' on Sheet 28.


**NARROW SIDE PATH CONFIGURATIONS**




## Sheet 15: *New* Sheet – Nonmotorized Sensor Layout (Large Shared Use Path)

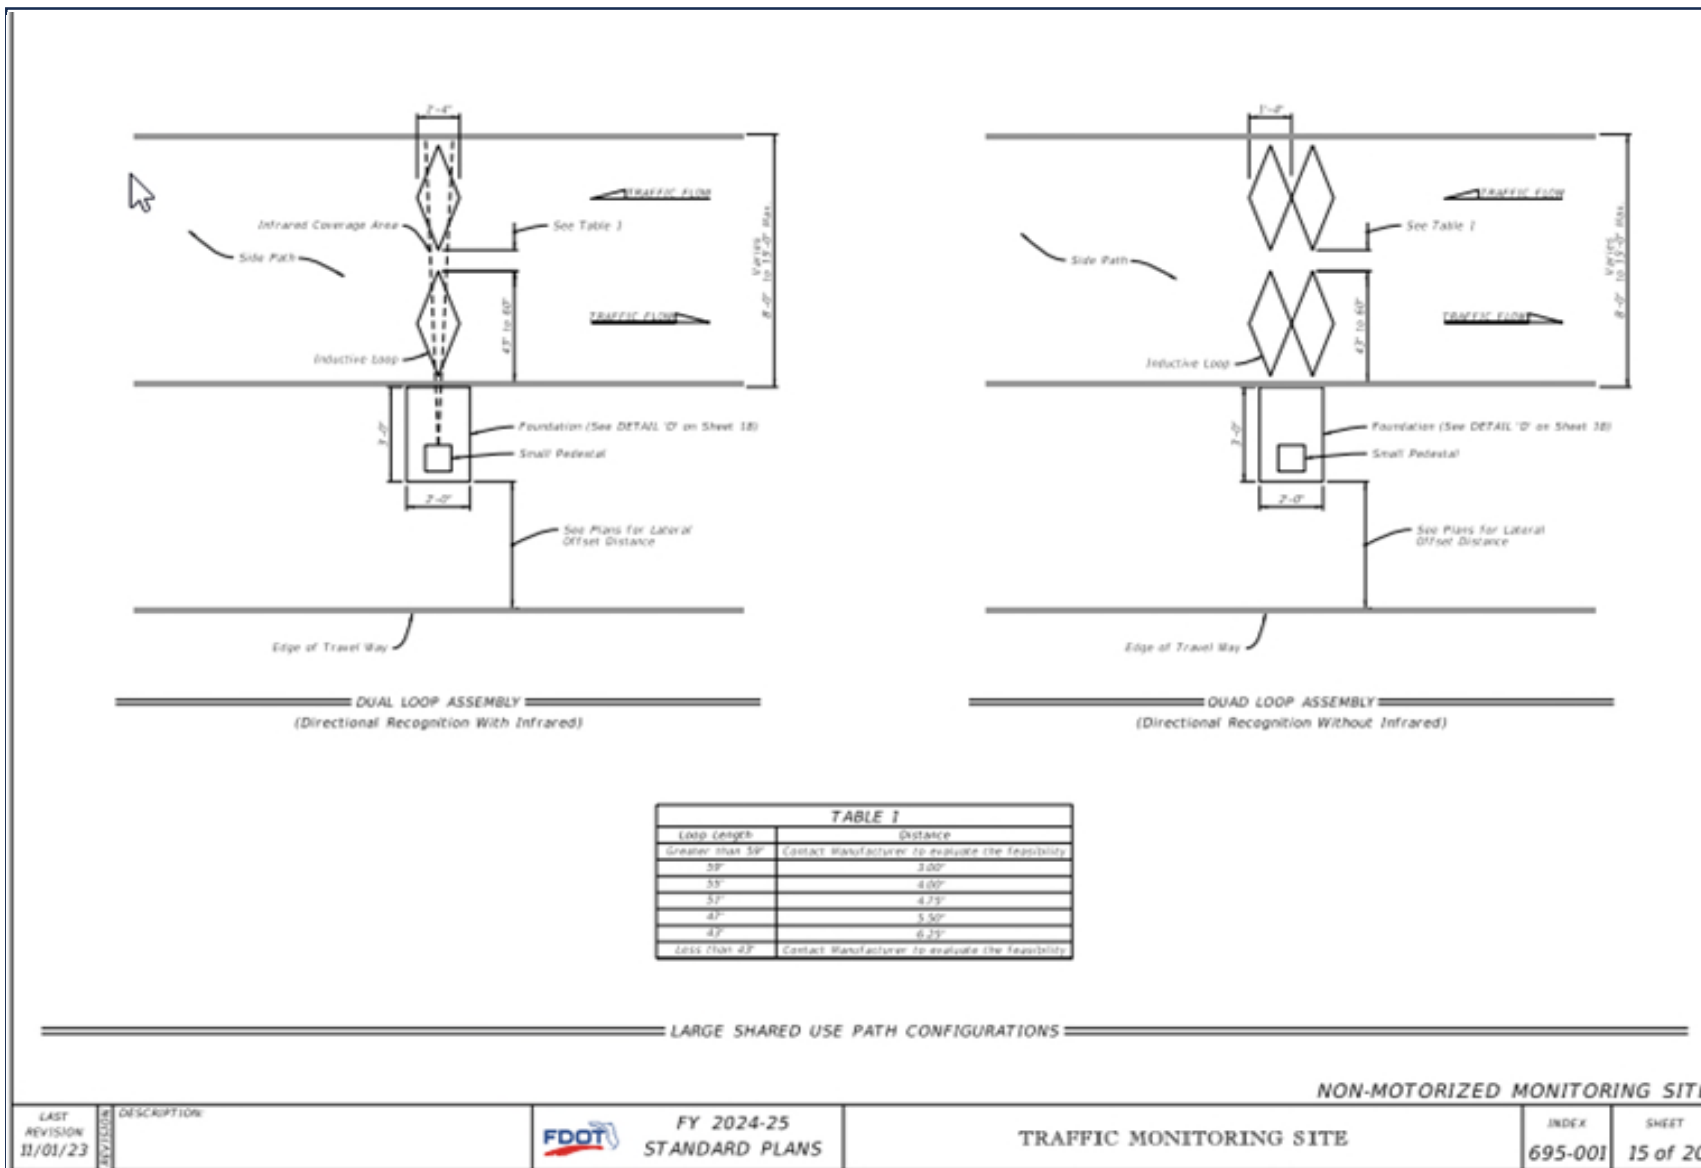


## Sheet 16: *New* Sheet – Non-Motorized Extra Large Shared Use Path Layout

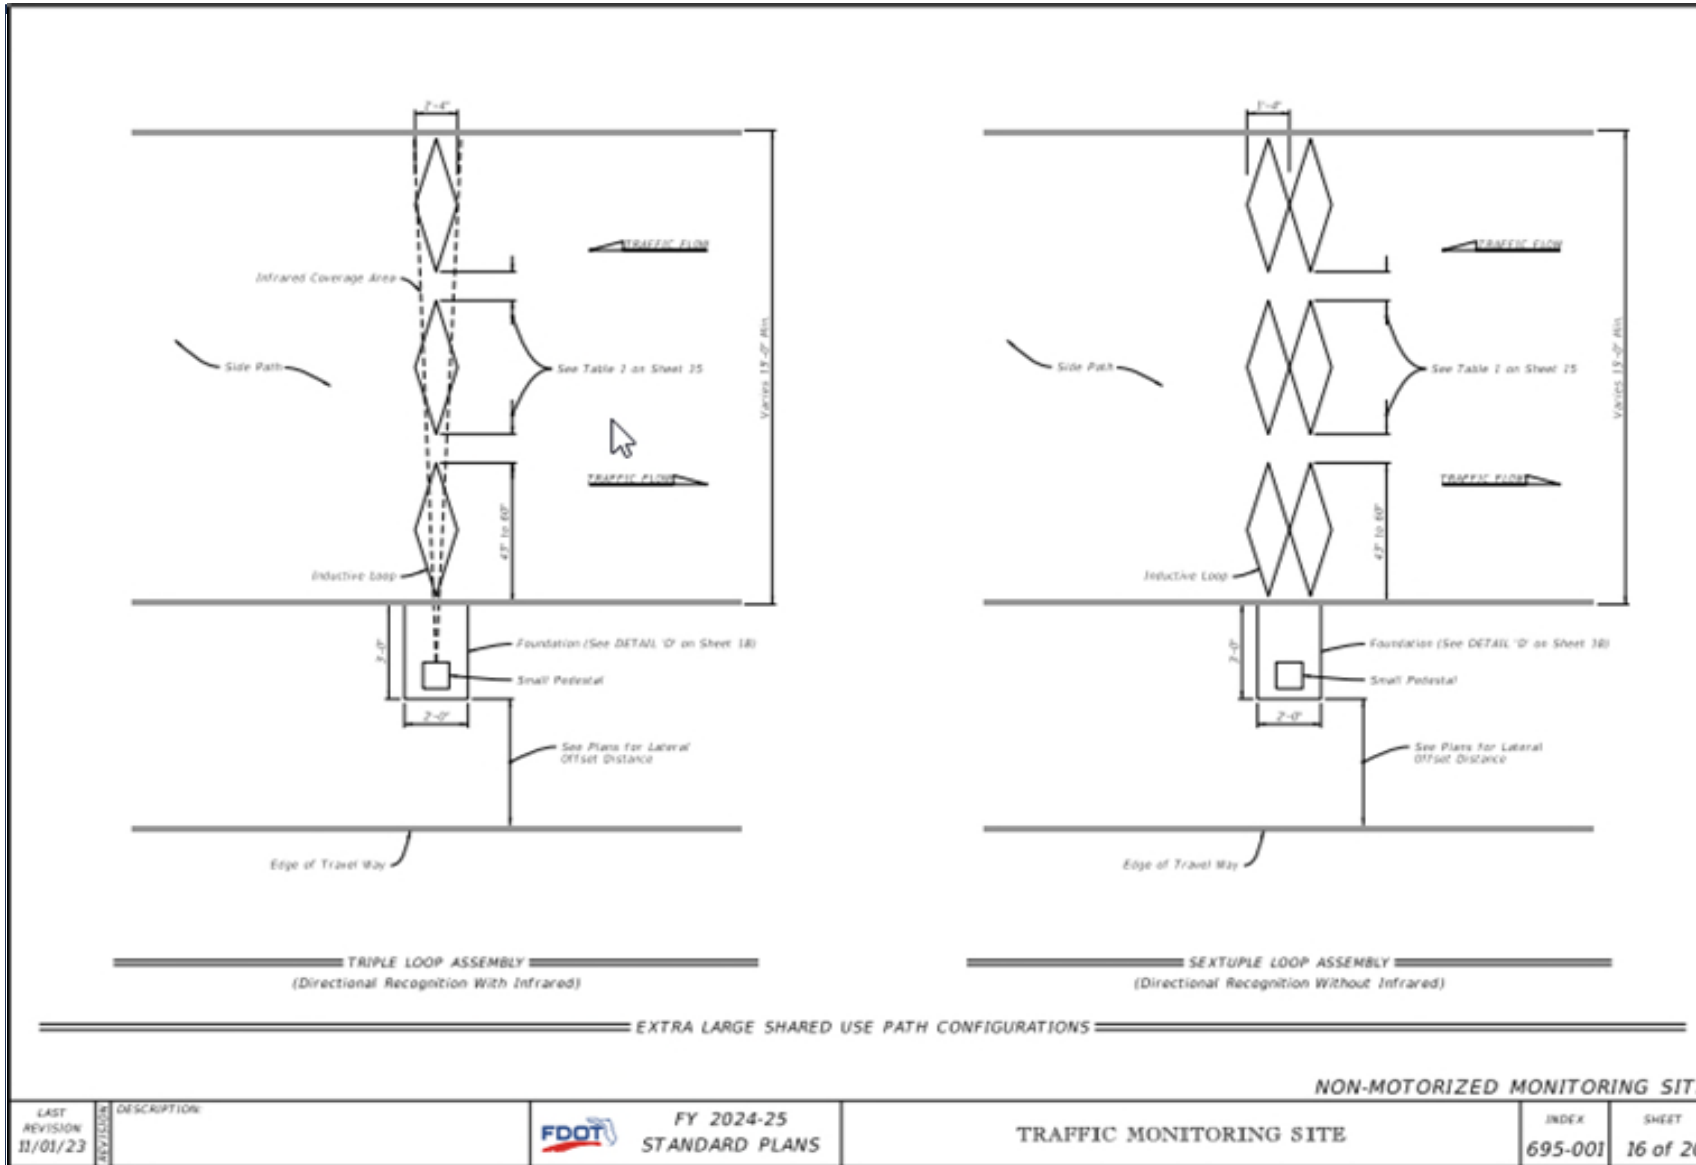

## Sheet 17: *New* Sheet - Non-Motorized Paved Sidewalk Layout

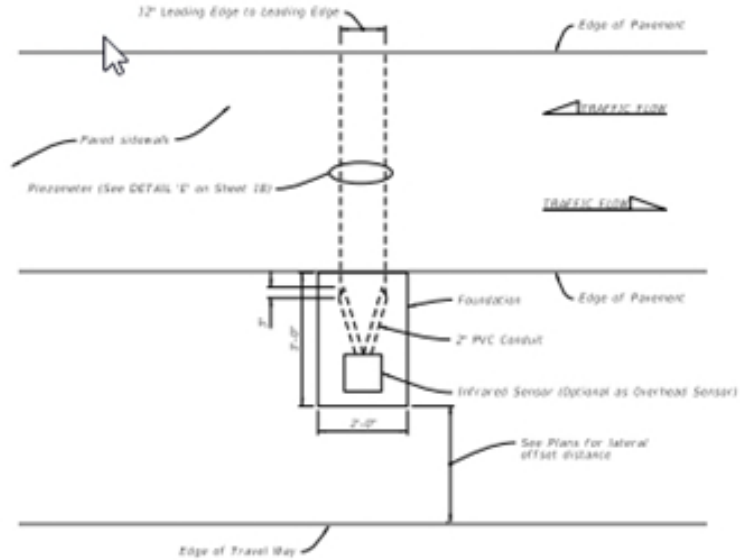

PLAN VIEW

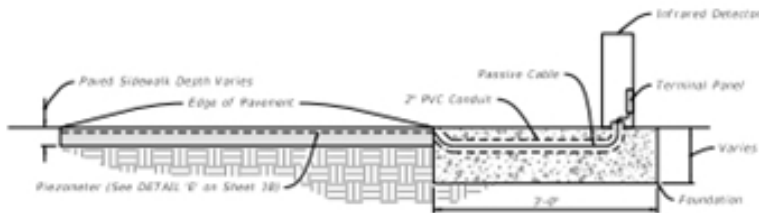

ELEVATION


PAVED SIDEWALK CONFIGURATION

NON-MOTORIZED MONITORING SITE

LAST REVISION 11/01/23	DESCRIPTION:	FY 2024-25 STANDARD PLANS	TRAFFIC MONITORING SITE	INDEX 695-001	SHEET 17 of 20
---------------------------	--------------	------------------------------	-------------------------	------------------	-------------------




## Sheet 18: *New* Sheet – Document Details A-F

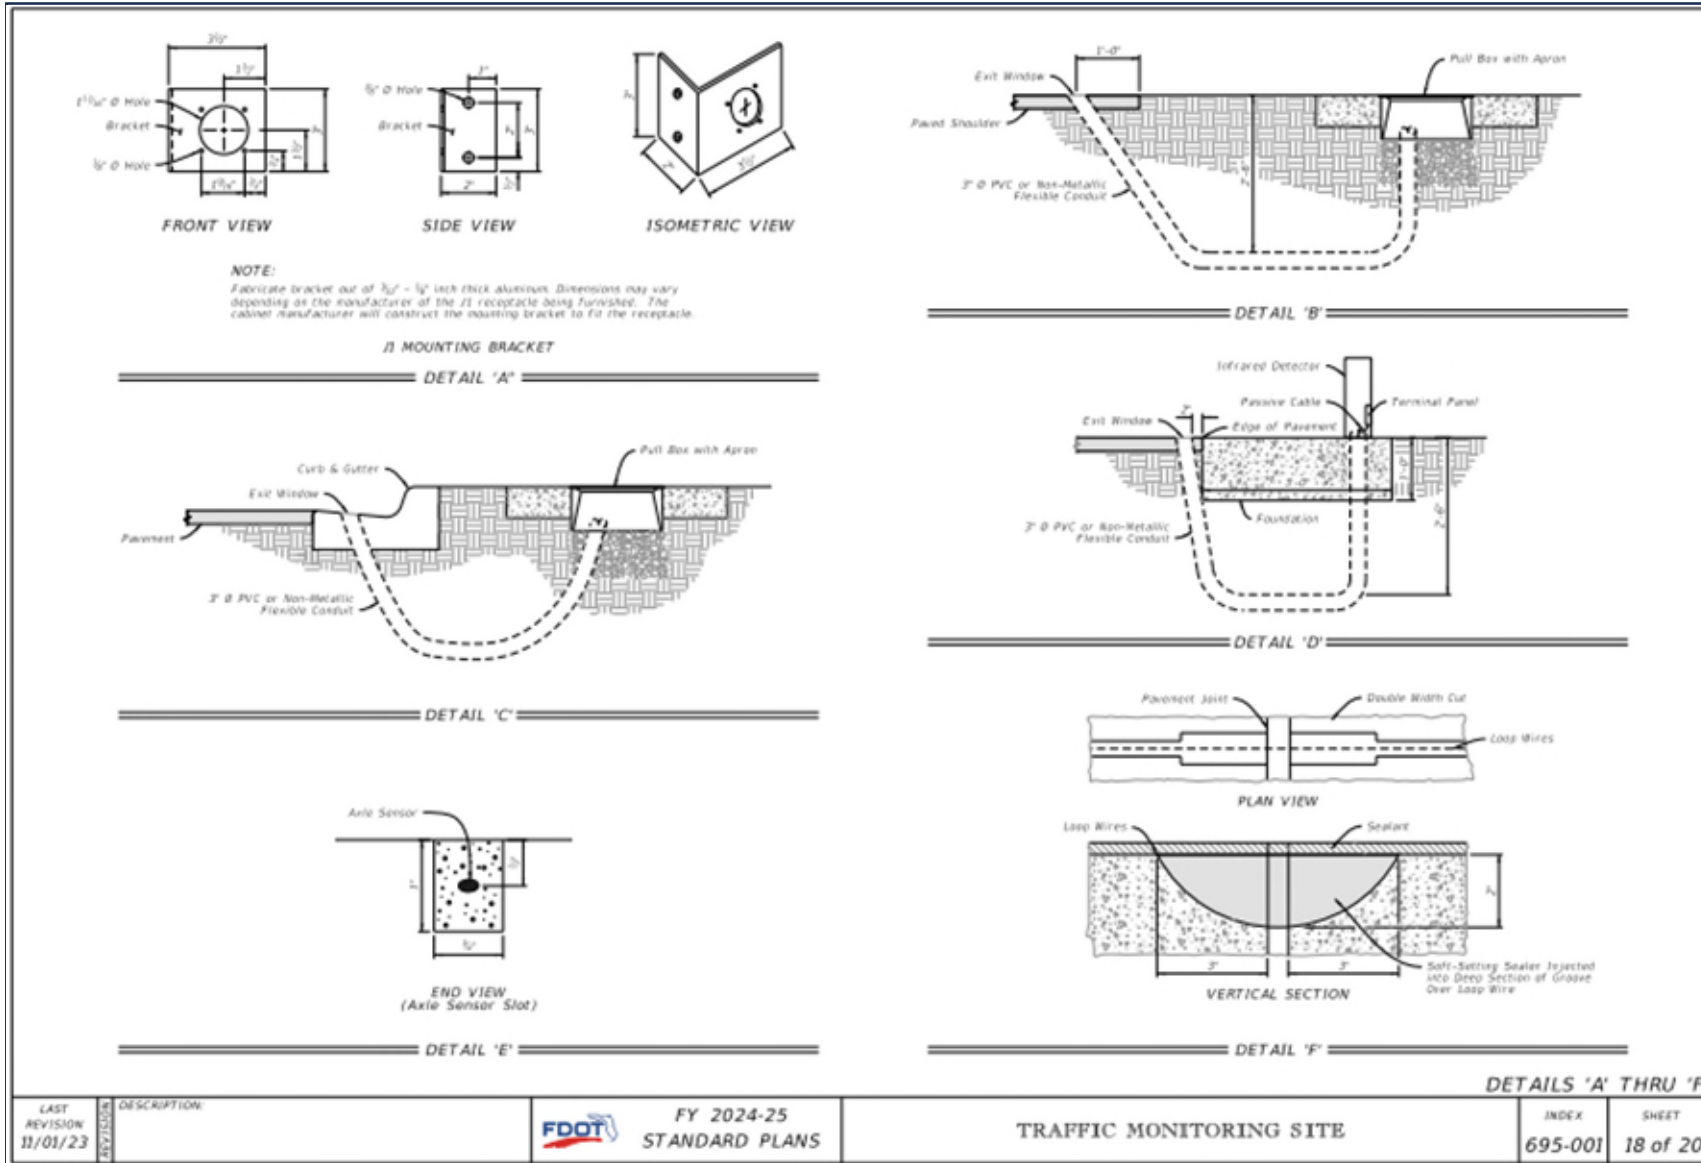

LAST REVISION 11/01/23	DESCRIPTION:	FY 2024-25 STANDARD PLANS	TRAFFIC MONITORING SITE	INDEX 695-001	SHEET 18 of 20
---------------------------	--------------	------------------------------	-------------------------	------------------	-------------------



## Sheet 19: Non-Intrusive Vehicle Sensor Layout

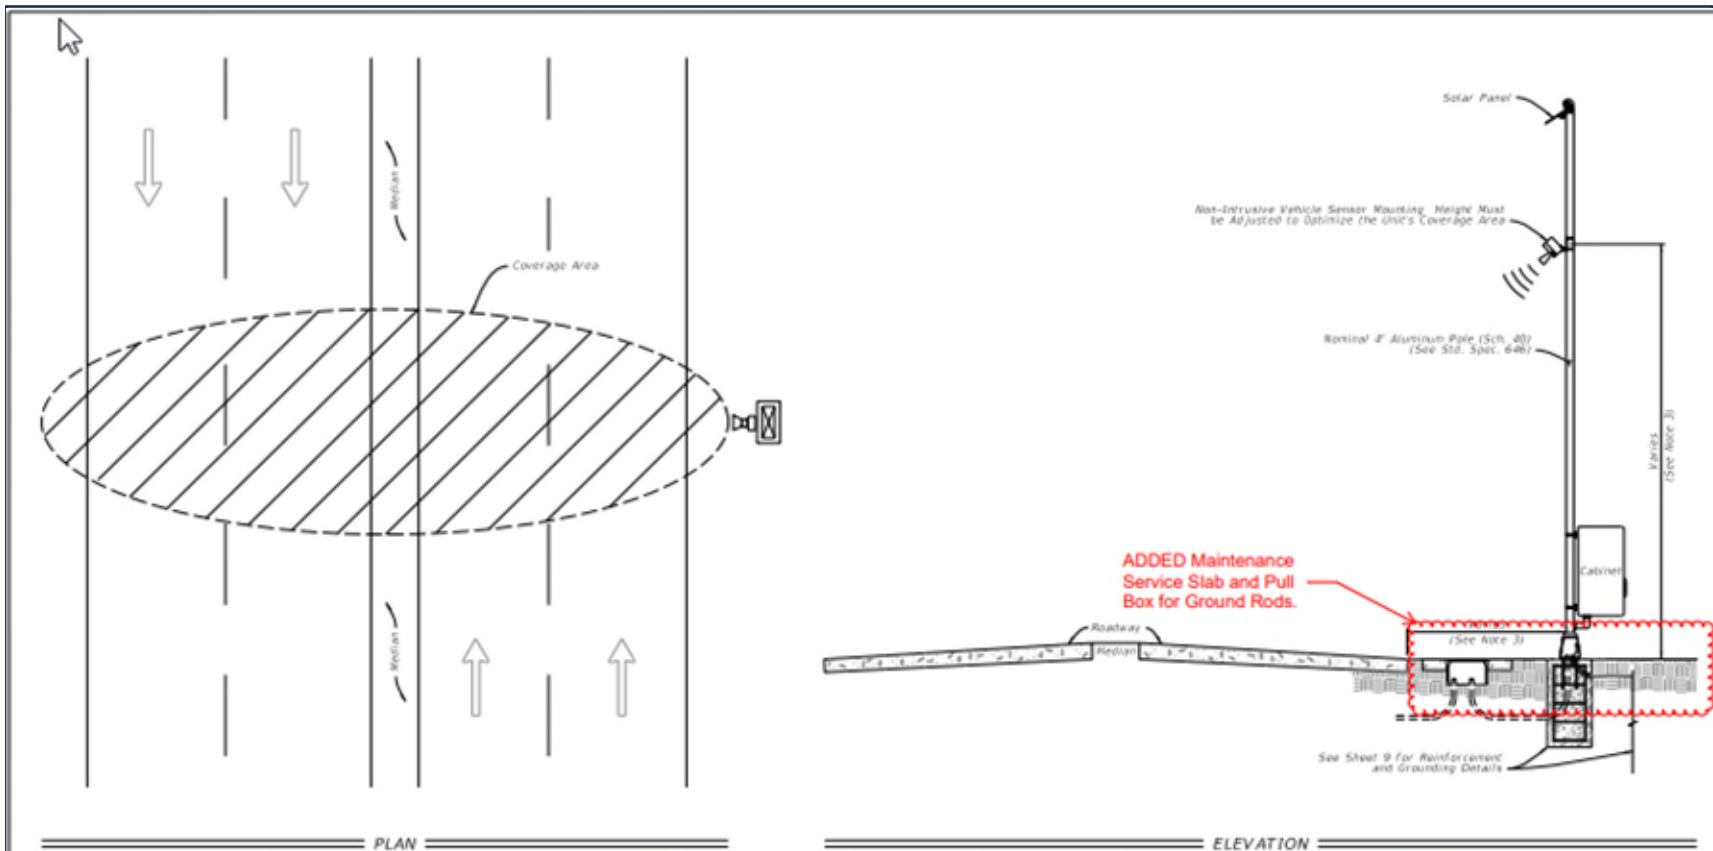


- NOTES:**
1. The unit must be capable of detecting up to eight lanes of traffic (in either or both directions) when mounted perpendicular to the roadway.
  2. Coverage area of the unit is affected by the roadway geometry: distance from the travel lanes, median type and width, barrier walls, etc.
  3. Mounting height of the unit and offset from the roadway must be determined on a site-by-site basis, in accordance with the manufacturer's recommended guidelines. Offset of pole must be greater than or equal to minimum clear zone requirements.

**ADDED Note 4:**  
Cabinet, ground rod pull box, and maintenance service slab installed per Index 676-010, expect cabinet center will be 4 feet above grade.



<b>NON-INTRUSIVE VEHICLE SENSOR</b>		<b>INDEX 695-001</b>	
LAST REVISION 11/01/23	DESCRIPTION 11/01/23	FY 2023-24 STANDARD PLANS	19 SHEET 8 of 9

## Sheet 19: Non-Intrusive Vehicle Sensor Layout

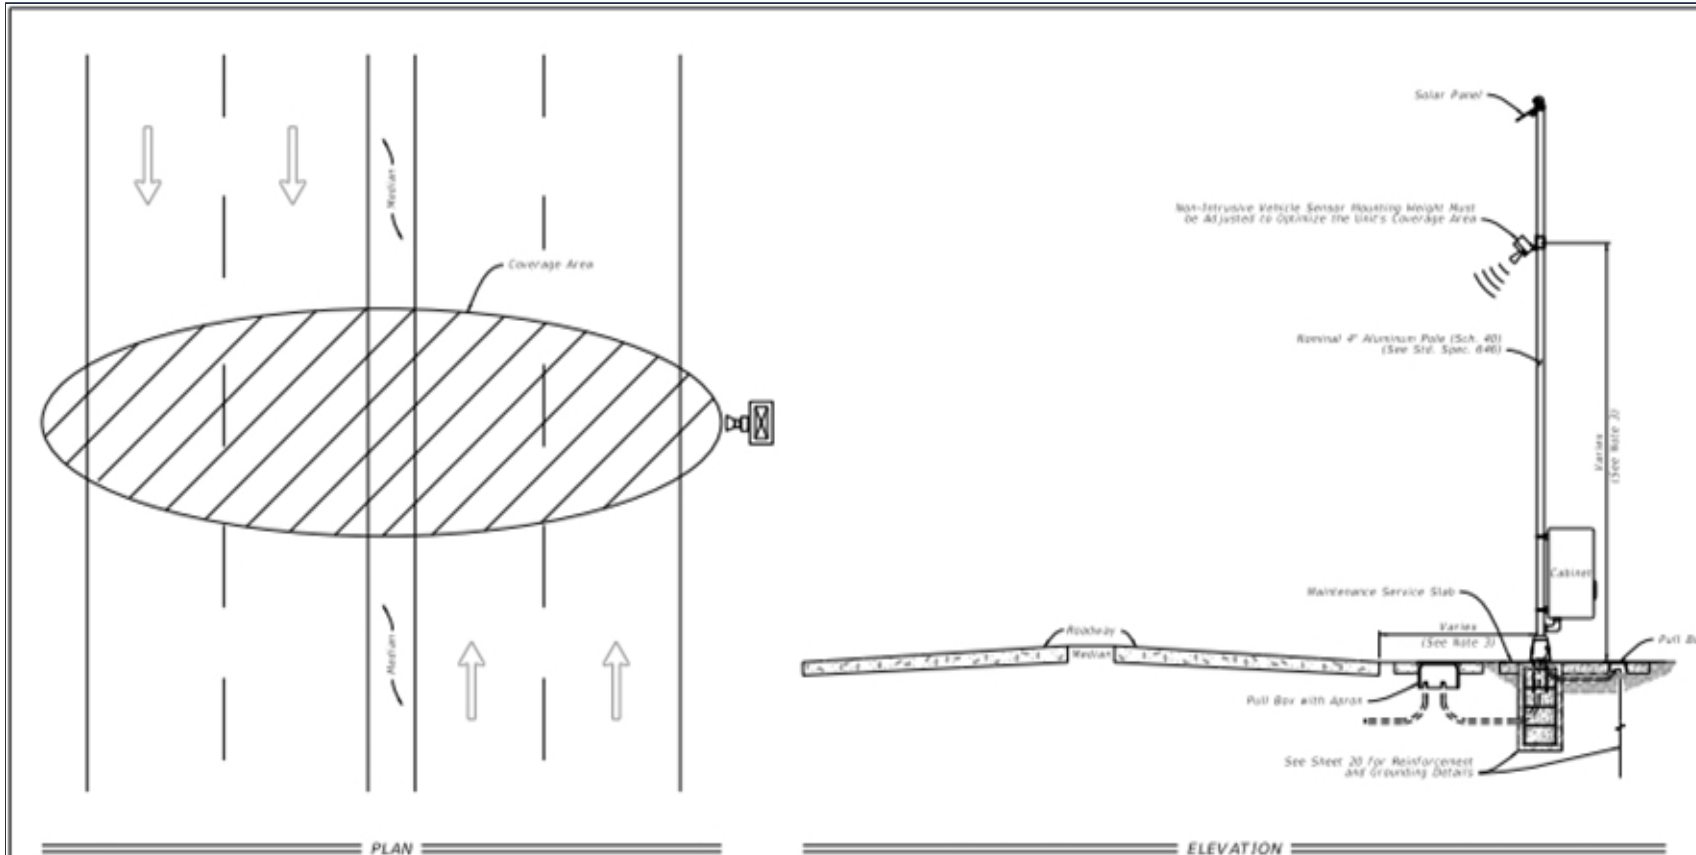

**NOTES:**


1. The unit must be capable of detecting up to eight lanes of traffic in either or both directions when mounted perpendicular to the roadway.
2. Coverage area of the unit is affected by the roadway geometry: distance from the travel lanes, median type and width, barrier walls, etc.
3. Mounting height of the unit and offset from the roadway must be determined on a site-by-site basis, in accordance with the manufacturer's recommended guidelines. Offset of pole must be greater than or equal to minimum clear zone requirements.
4. Cabinet, ground rod pull box, and maintenance service slab installed per Index 676-010, except cabinet center will be 4 feet above grade.




LAST REVISION: 11/01/23 DESCRIPTION:		FDOT FY 2024-25 STANDARD PLANS	TRAFFIC MONITORING SITE	INDEX 695-001	SHEET 19 of 20
---	--	--------------------------------------	-------------------------	------------------	-------------------

NON-INTRUSIVE VEHICLE SENSOR

## Sheet 20: Continuous and Short-Term Cabinet Setup

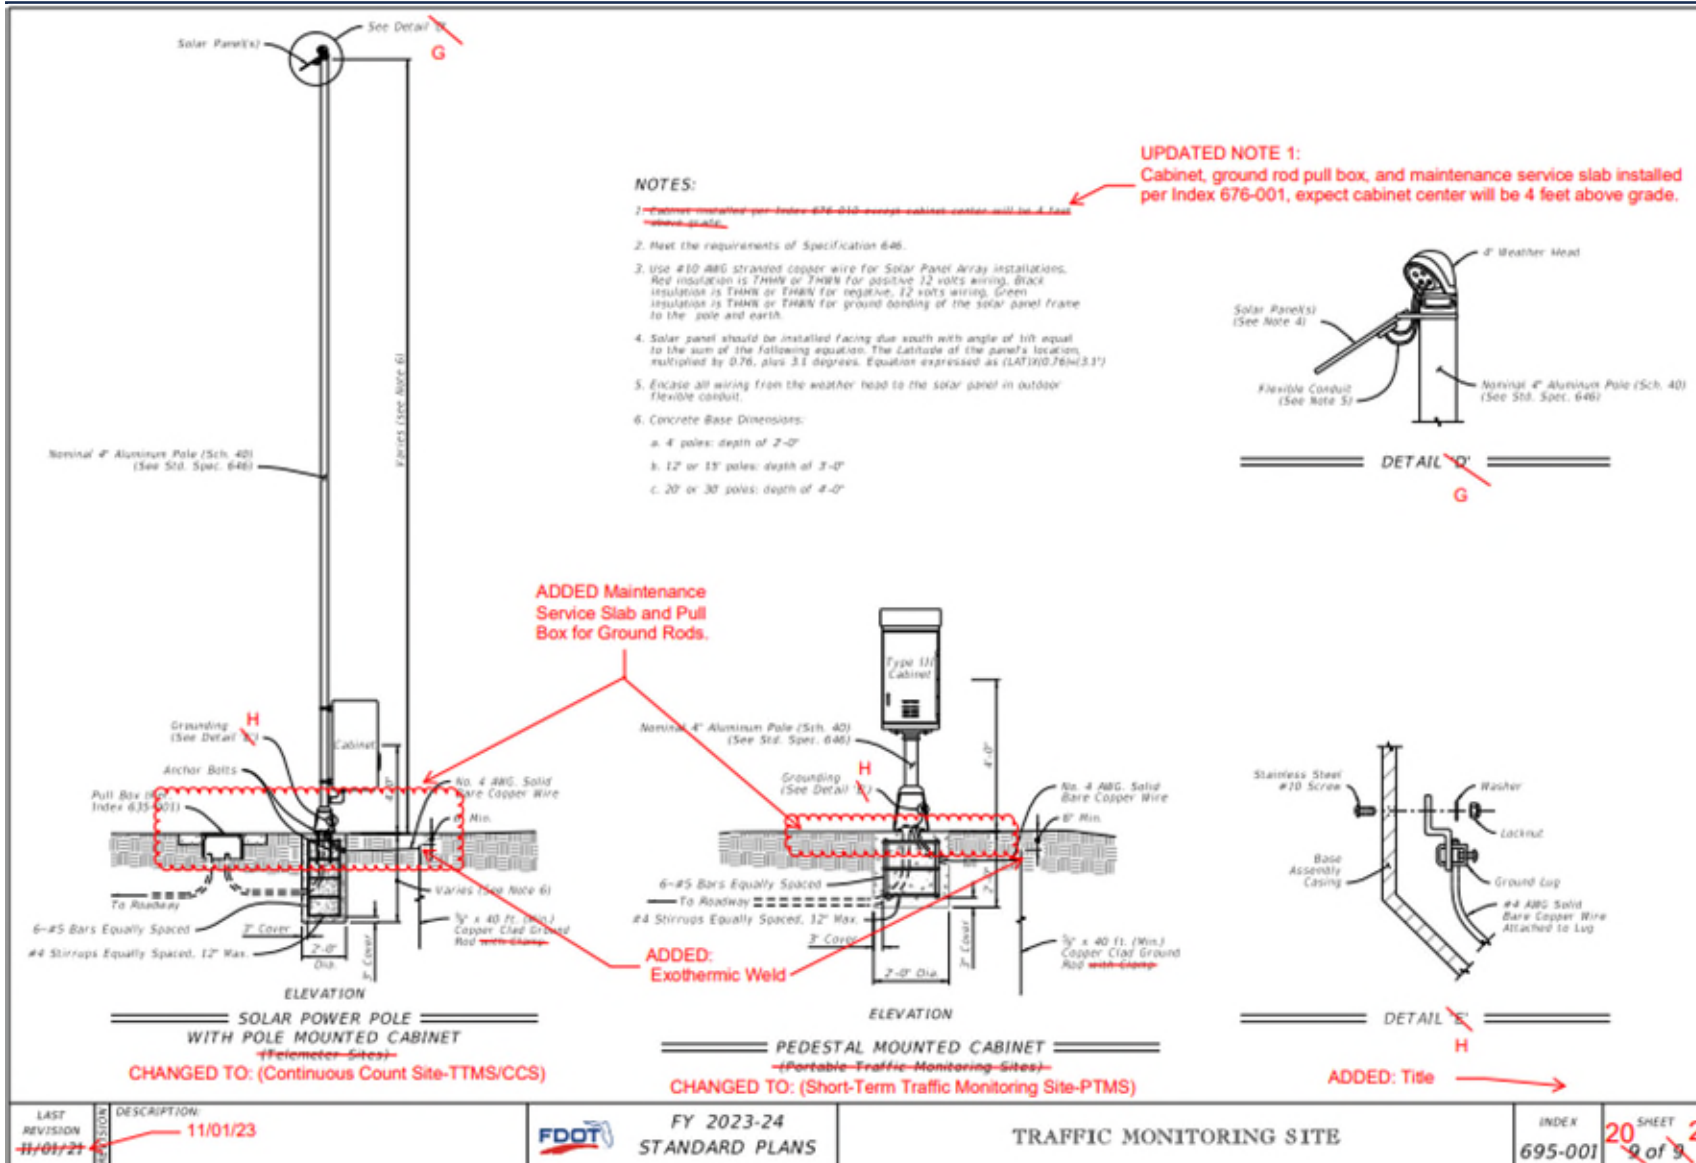

## Sheet 20: Solar Power Setup and Cabinet Details

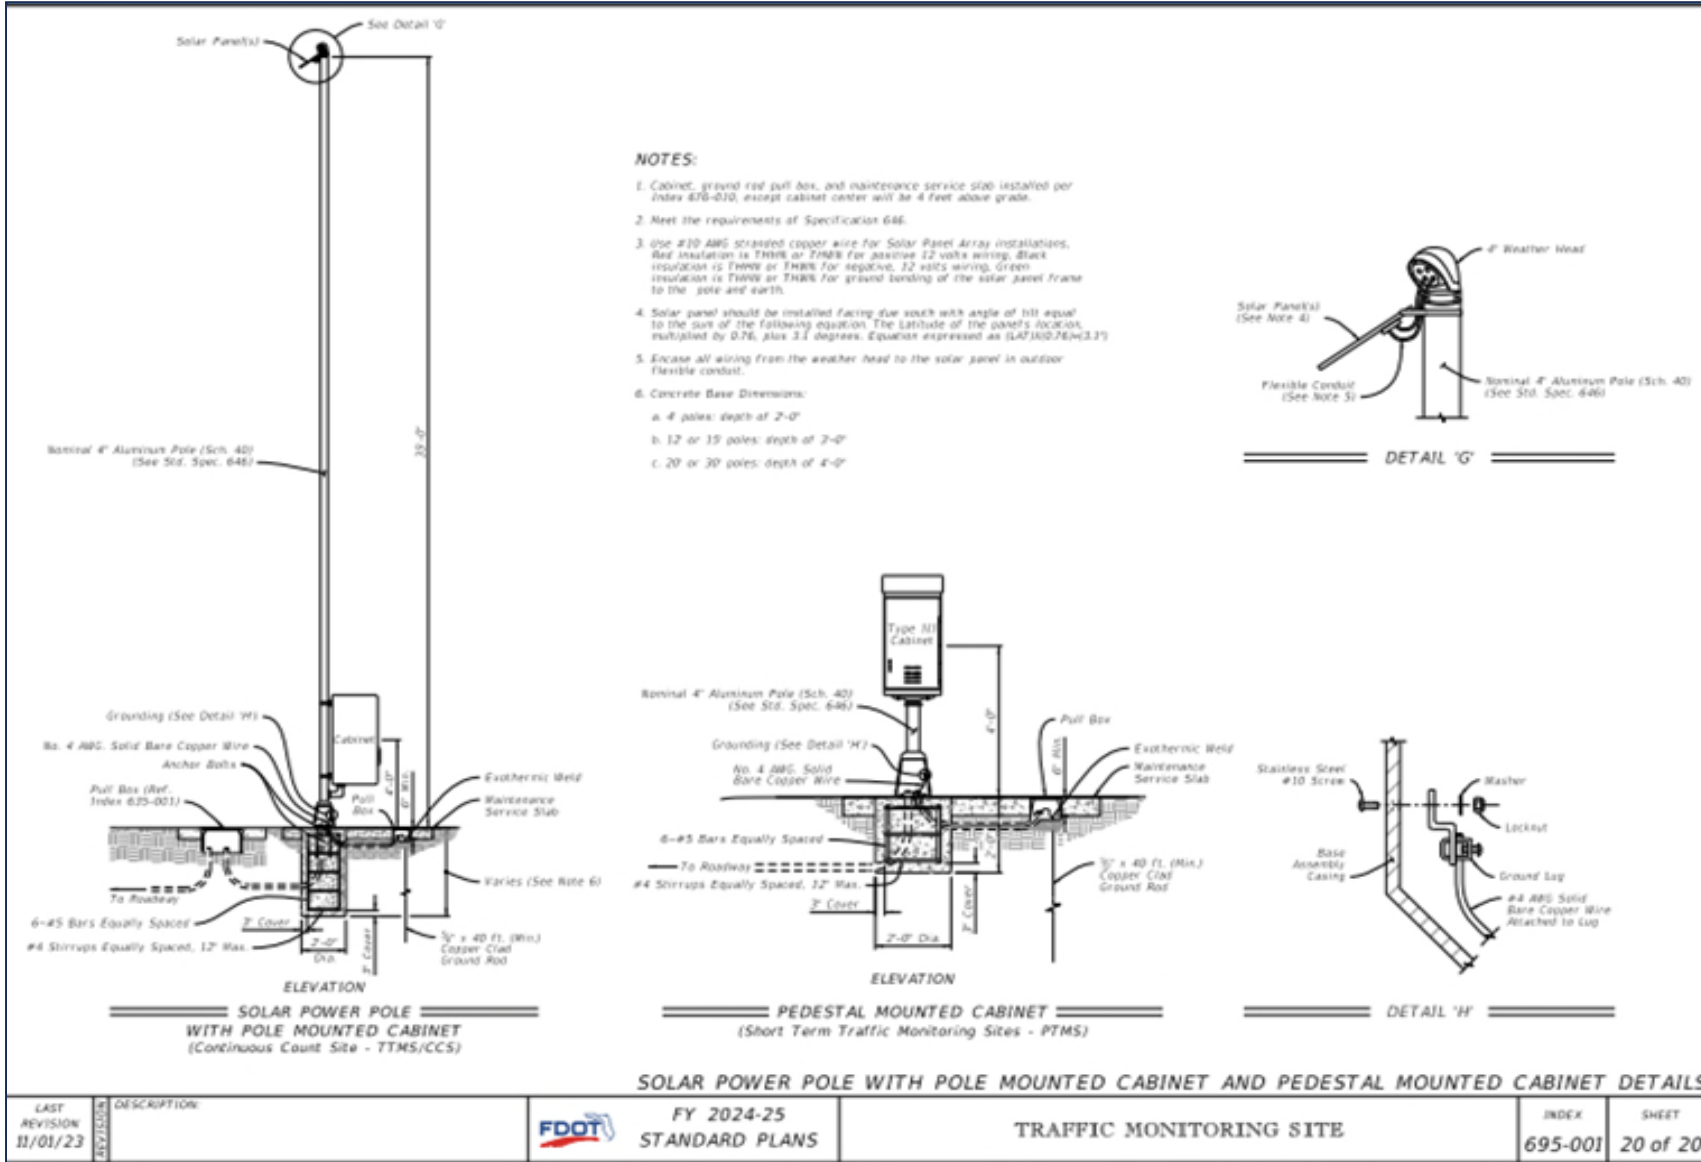

# Contact Us:



## **Victor Johnson**

Traffic Data Collections Supervisor  
Transportation Data and Analytics Office  
850-921-7300  
Victor.Johnson@dot.state.fl.us





# Structures Design Office Standard Plans Training

Presenter: Joshua Turley P.E.



## Standard Plans – Primary Updates:

- 1) **Index 450-511 – BEARING PLATES (TYPE 1) - PRESTRESSED FLORIDA-I AND AASHTO TYPE II BEAM**
  - *Revised Sheet 1*
- 2) **Index 455-031 – 30” SQUARE PRESTRESSED CONCRETE PILE – HIGH MOMENT CAPACITY**
  - *Revised Sheet 1*
- 3) **Index 458-110 – EXPANSION JOINT SYSTEM - POURED JOINT WITH BACKER ROD**
  - *Revised Sheet 1*
- 4) **Index 550-011 – BRIDGE FENCING (CURVED TOP)**
  - *Revised all sheets*
- 5) **Index 550-012 – BRIDGE FENCING (ENCLOSED)**
  - *Revised Sheet 1 and 2*




## Standard Plans – Primary Updates:

- 6) **Index 550-013 – BRIDGE FENCING (OVER RAILROAD)**
  - *Revised all sheets*
- 7) **Index 630-010 – CONDUIT DETAILS - EMBEDDED**
  - *Revised Sheet 1*
- 8) **Index 641-020 – CONCRETE CCTV POLE**
  - *Revised Sheet 2 and 3*





## Sheet 1:

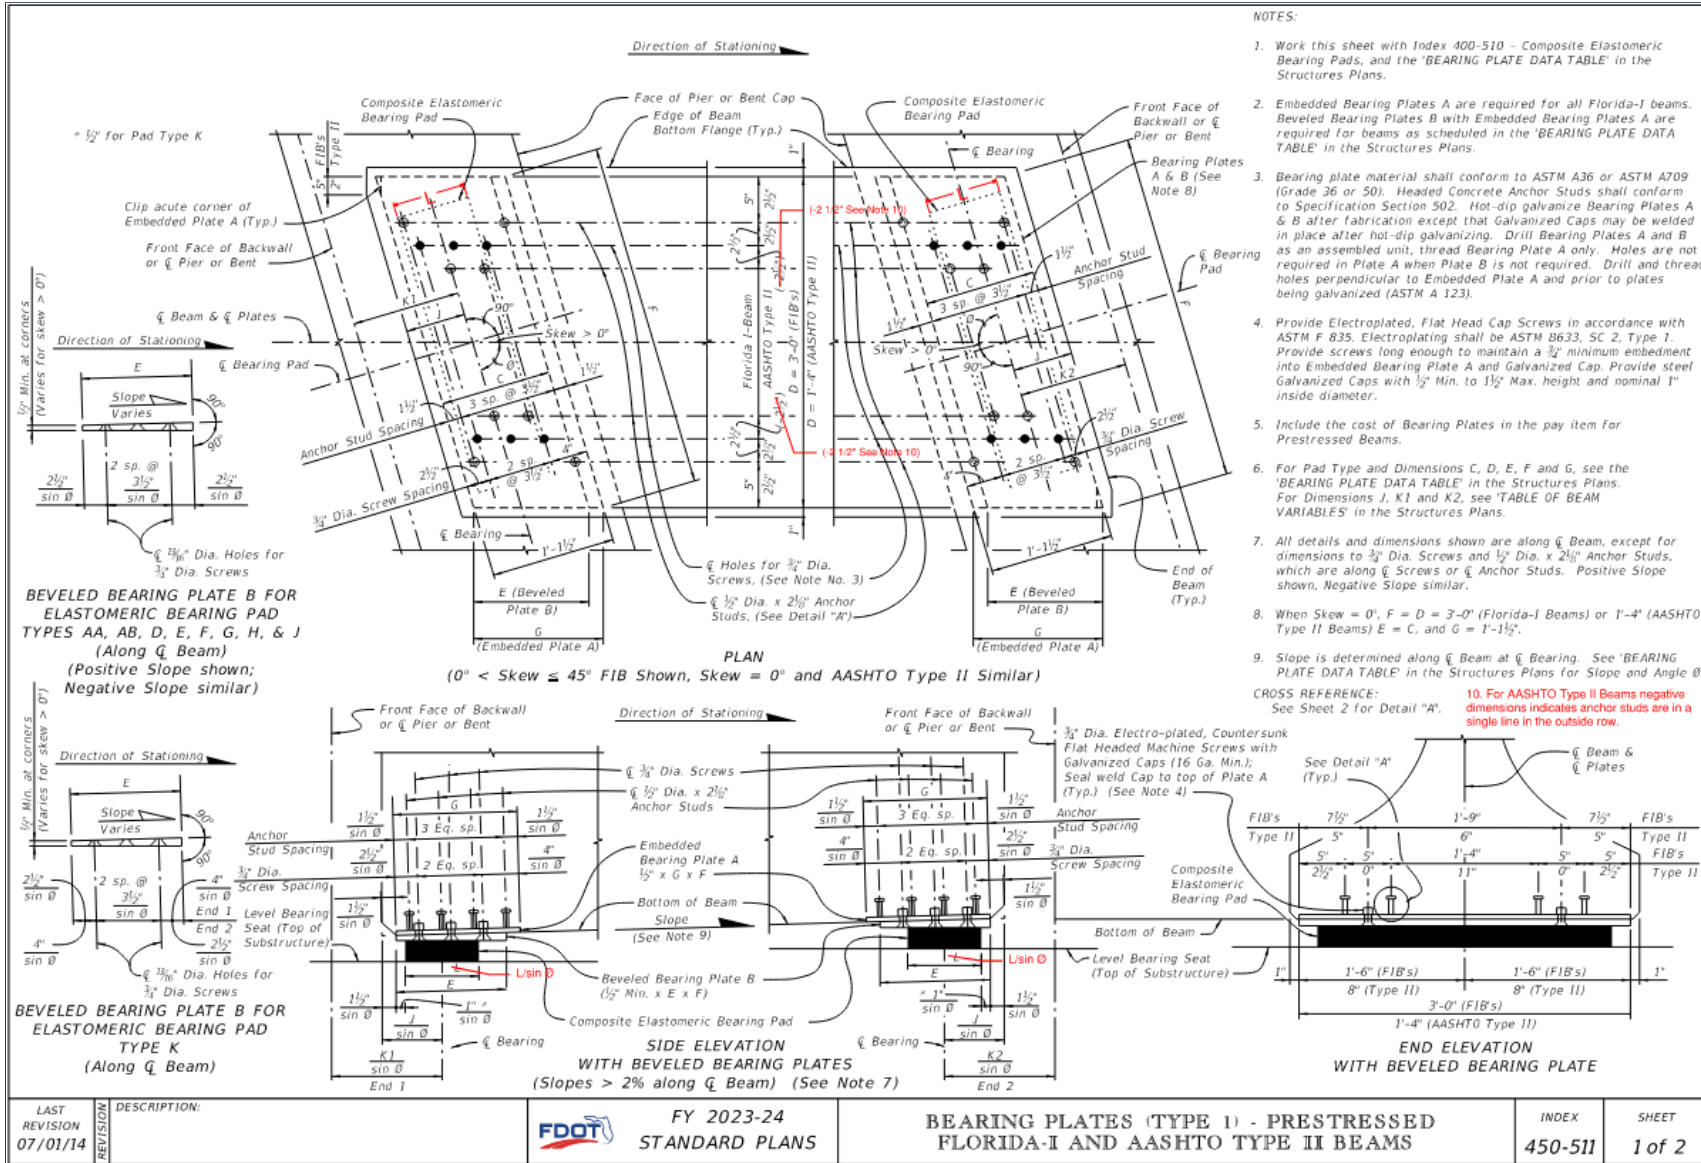

- **Modified dim L for skew angle**
- **Added note to clarify negative dimension**





## Sheet 1: Modified dim L for skew angle

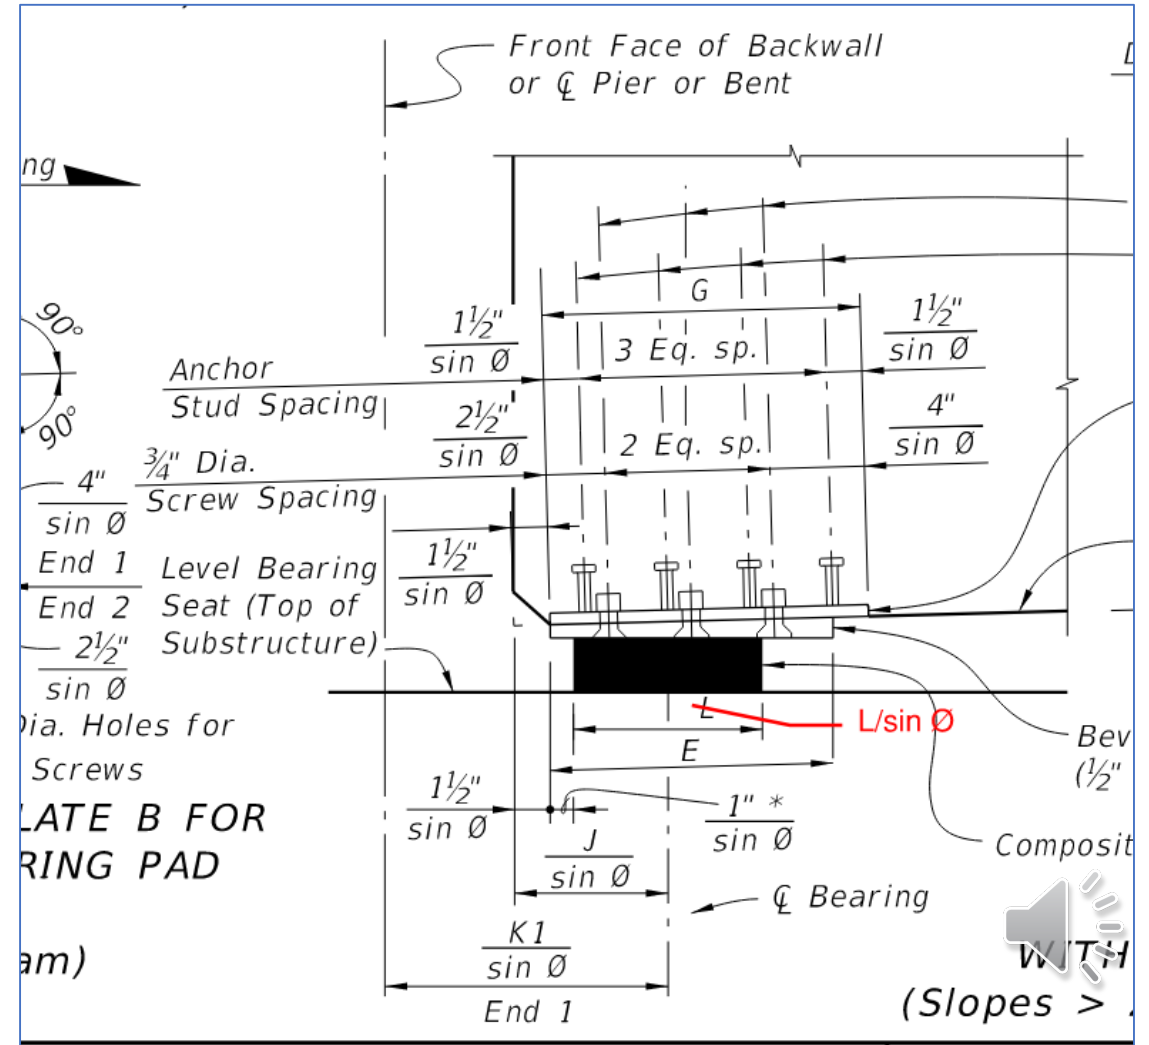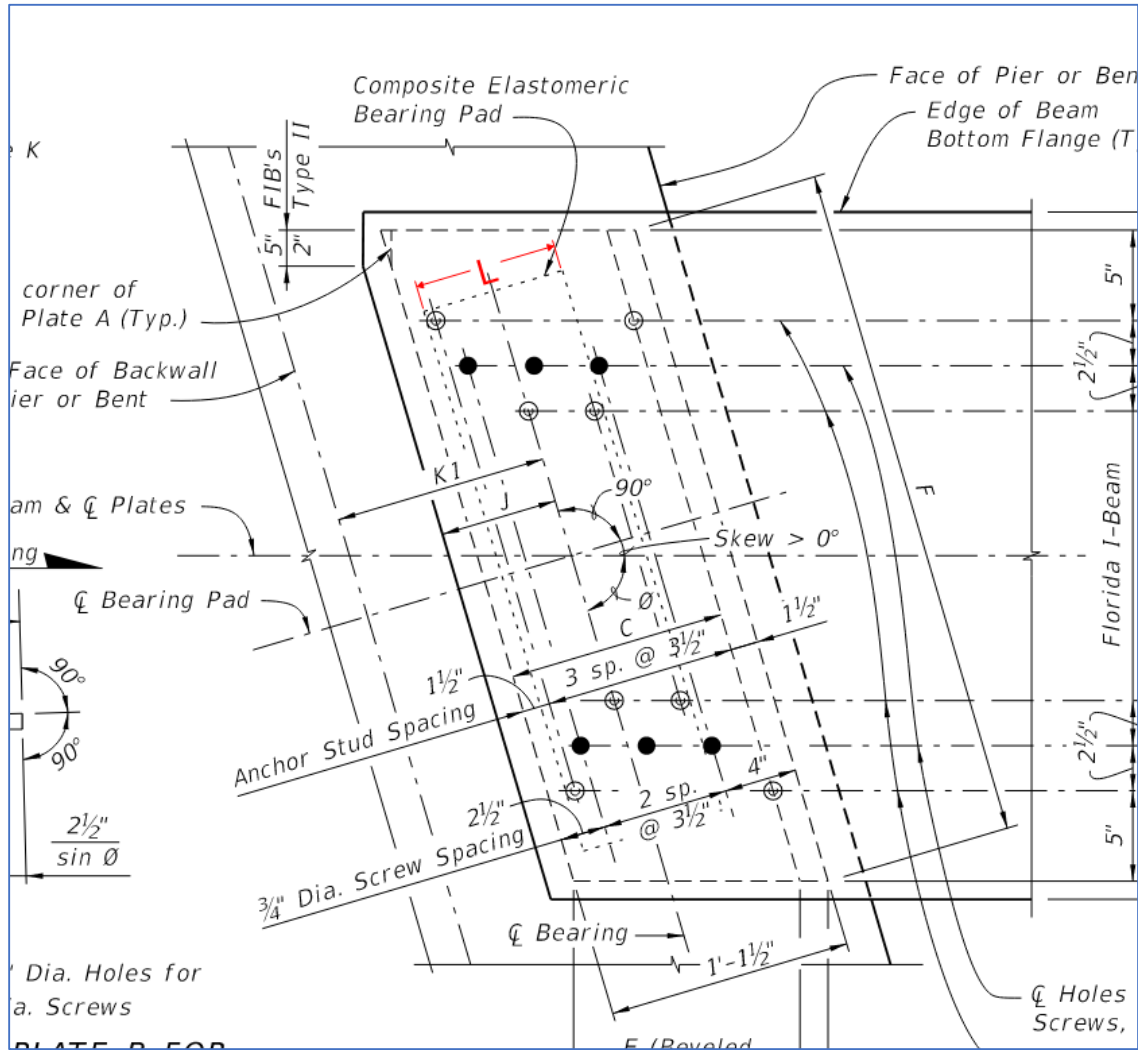



## Sheet 1: Note 10

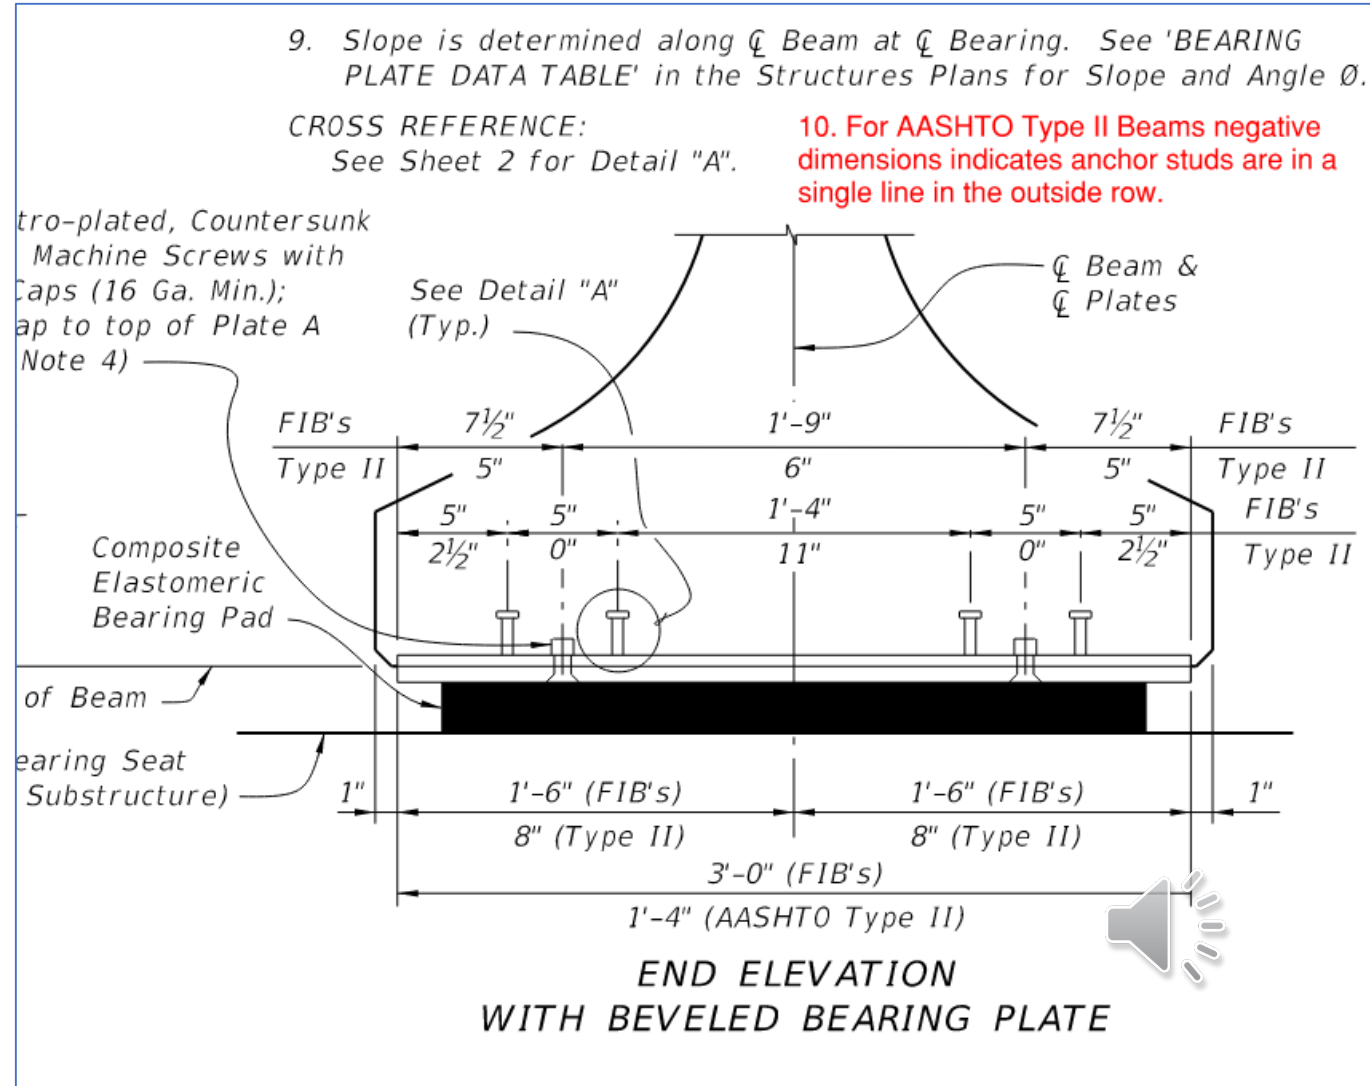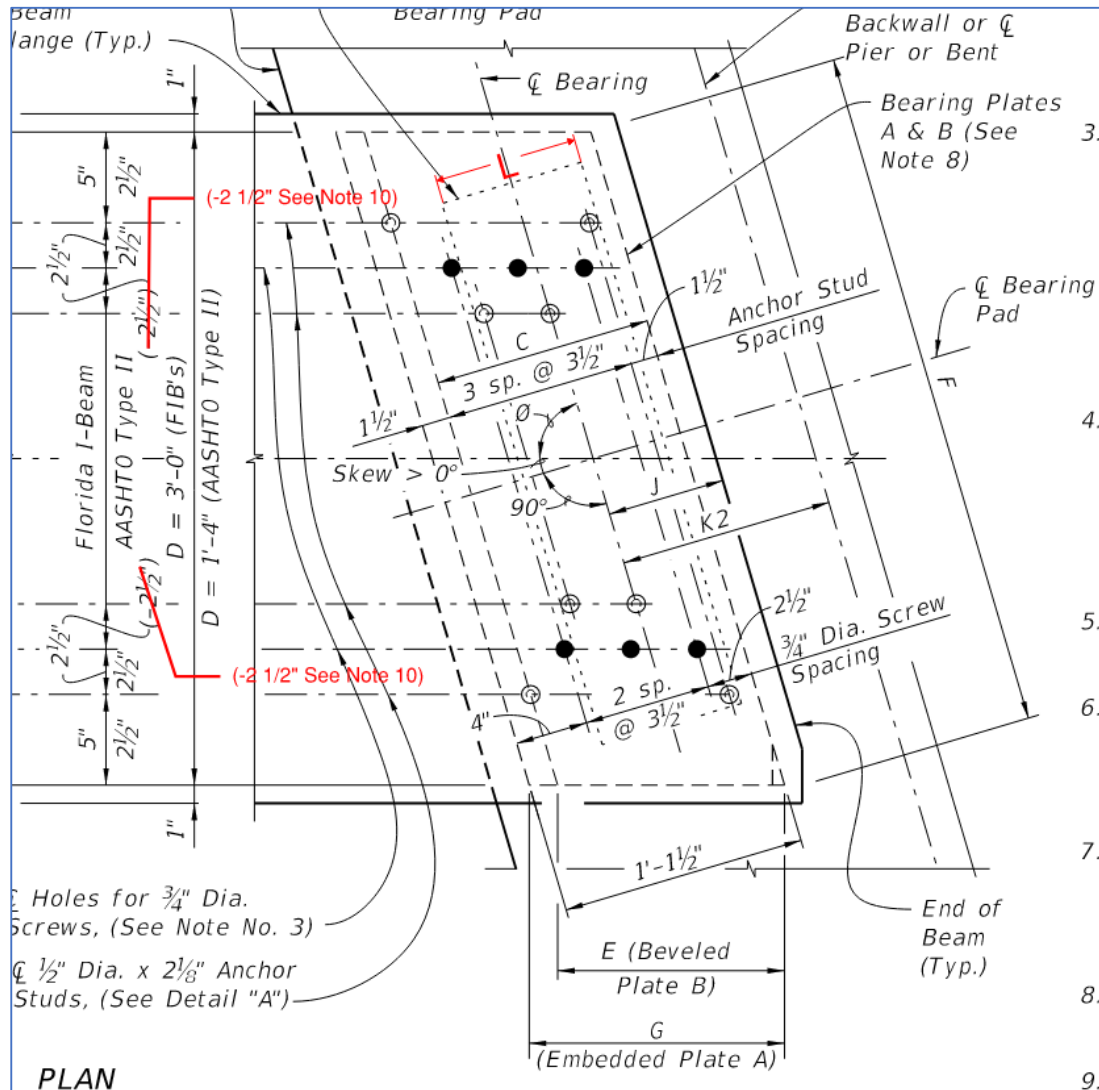

9. Slope is determined along  $\text{C}$  Beam at  $\text{C}$  Bearing. See 'BEARING PLATE DATA TABLE' in the Structures Plans for Slope and Angle  $\theta$ .


CROSS REFERENCE:  
See Sheet 2 for Detail "A".

10. For AASHTO Type II Beams negative dimensions indicates anchor studs are in a single line in the outside row.


tro-plated, Countersunk Machine Screws with Caps (16 Ga. Min.); up to top of Plate A (See Note 4)

See Detail "A" (Typ.)

$\text{C}$  Beam &  $\text{C}$  Plates

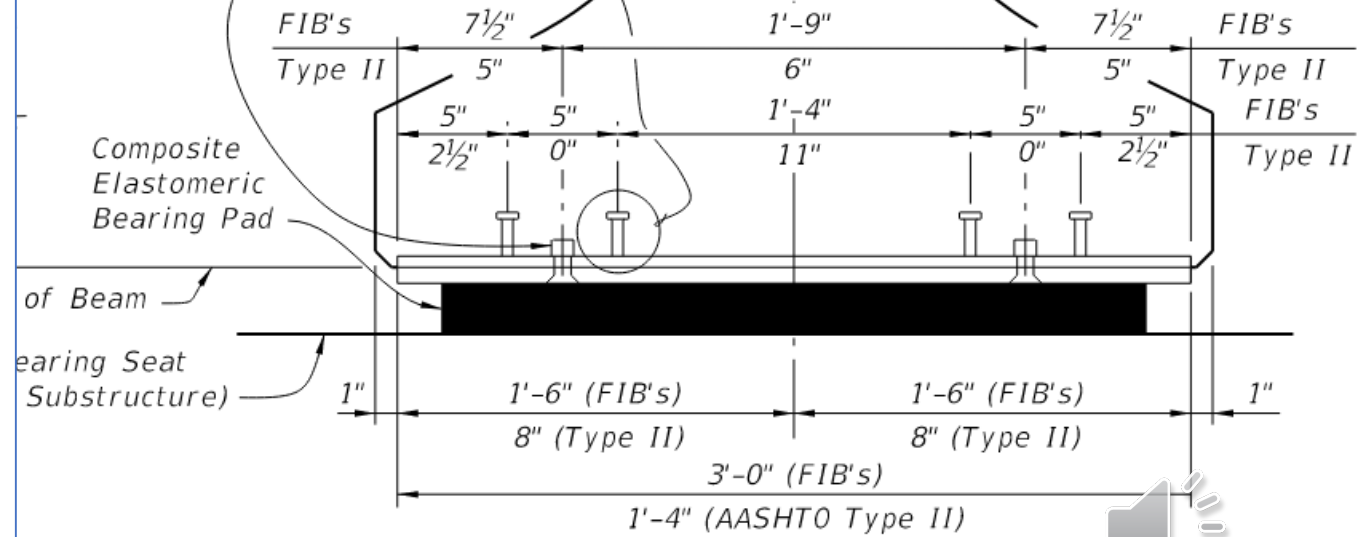

## Sheet 1:

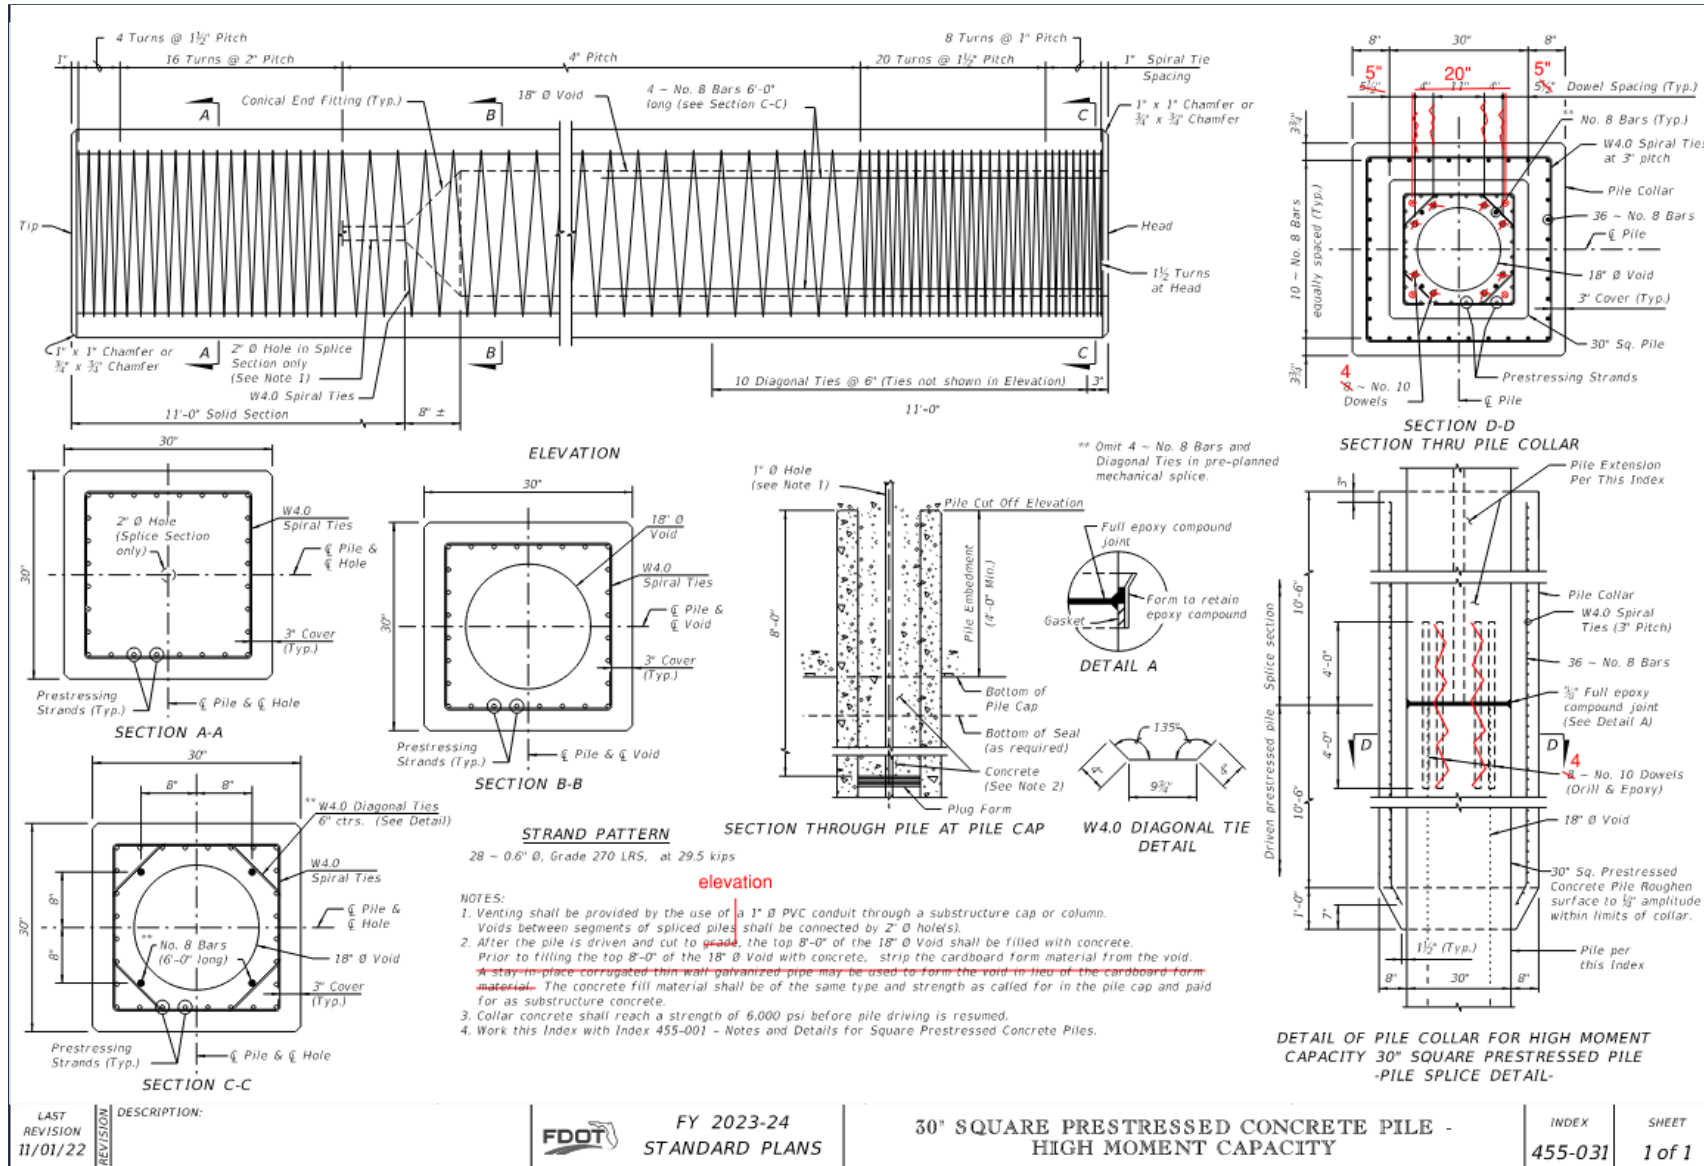


- Revised splice
- Removed corrugated galvanized pipe



LAST REVISION 11/01/22	DESCRIPTION:	FDOT FY 2023-24 STANDARD PLANS	30" SQUARE PRESTRESSED CONCRETE PILE - HIGH MOMENT CAPACITY	INDEX 455-031	SHEET 1 of 1
---------------------------	--------------	--------------------------------------	--	------------------	-----------------

## Sheet 1: Splice

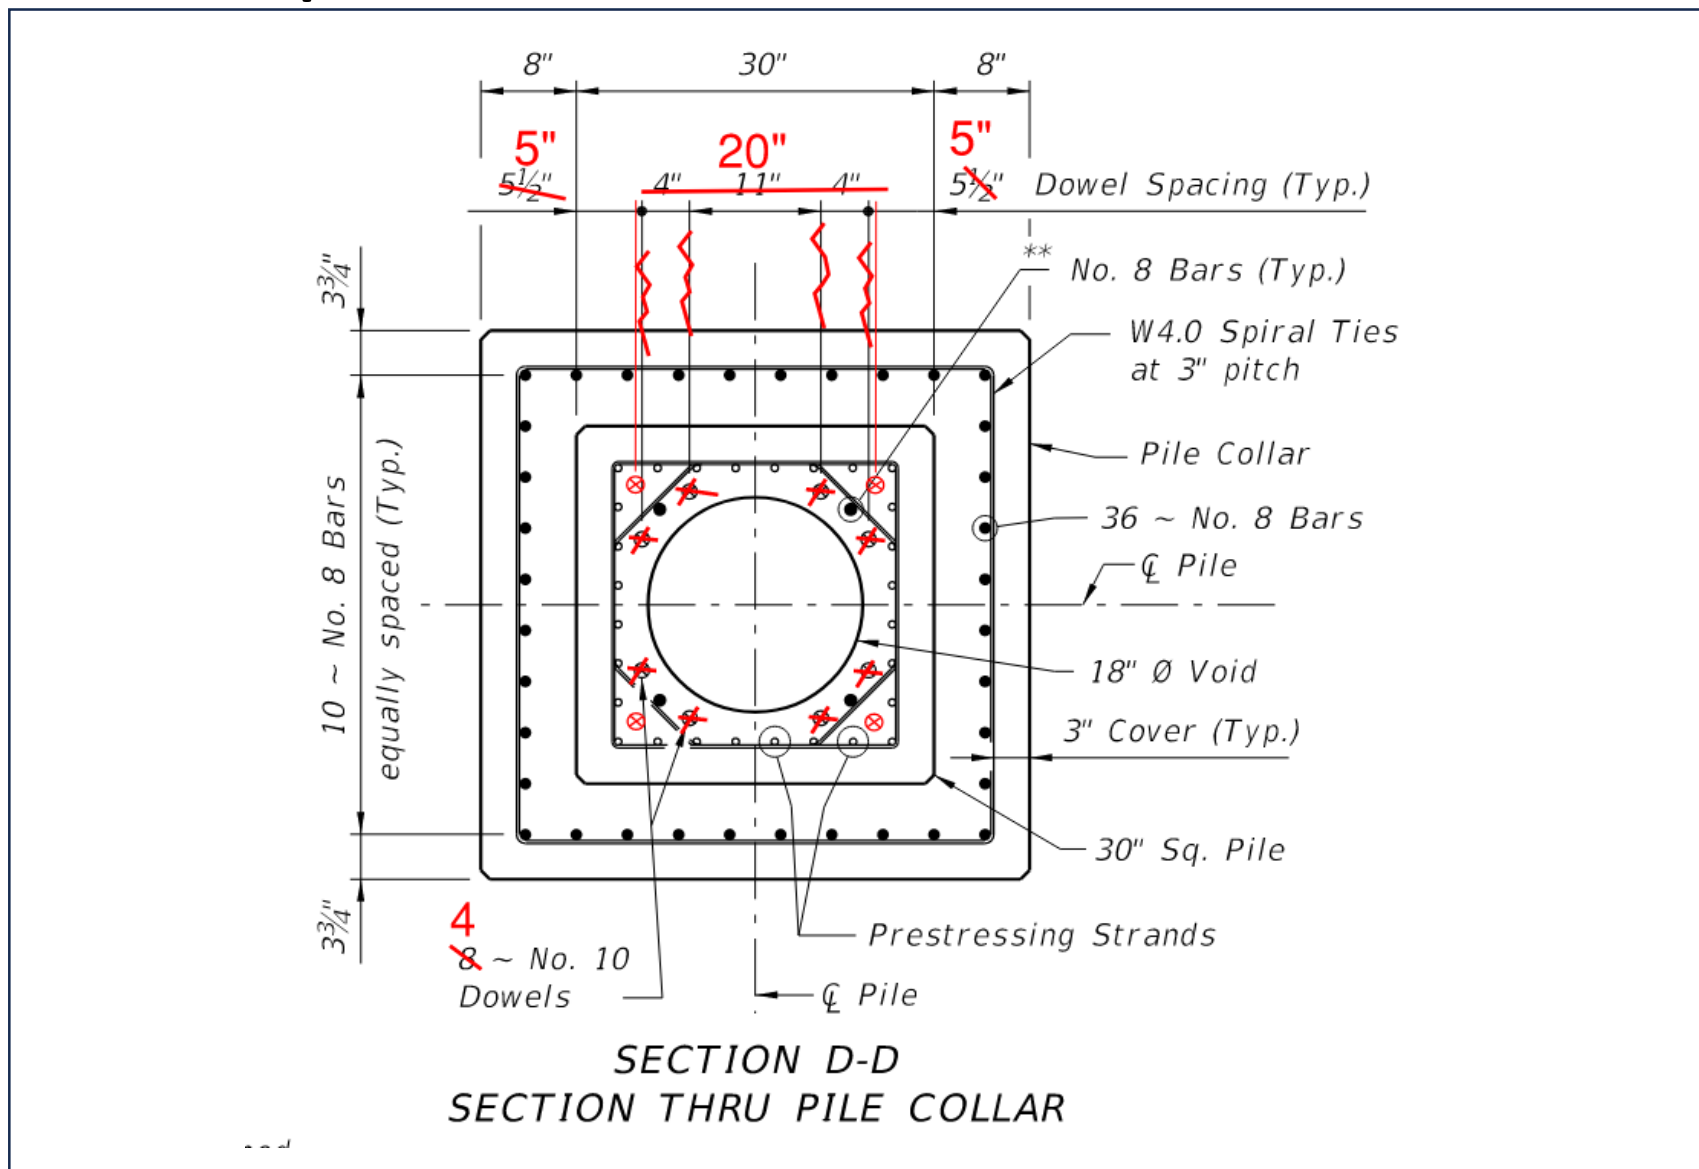


- **Revised splice**
- **Removed corrugated galvanized pipe**




## Sheet 1:


- Modified note for Form Material Removal**

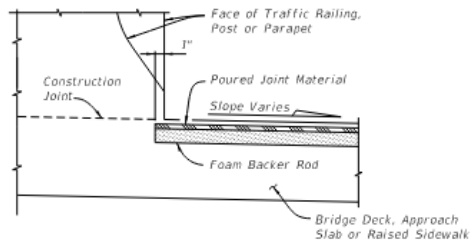


PARTIAL SECTION ALONG Q JOINT  
JOINT TREATMENT AT HIGH SIDE OF  
DECK WITH SLOPES 1% OR GREATER

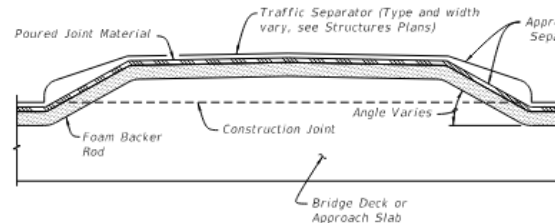

PARTIAL SECTION ALONG Q JOINT.  
JOINT TREATMENT AT TRAFFIC SEPARATOR

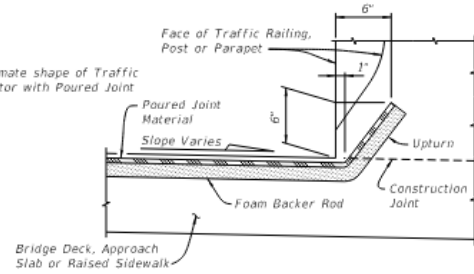

PARTIAL SECTION ALONG Q JOINT  
JOINT TREATMENT AT LOW SIDE OF DECK OR  
HIGH SIDE OF DECK WITH SLOPES < 1%

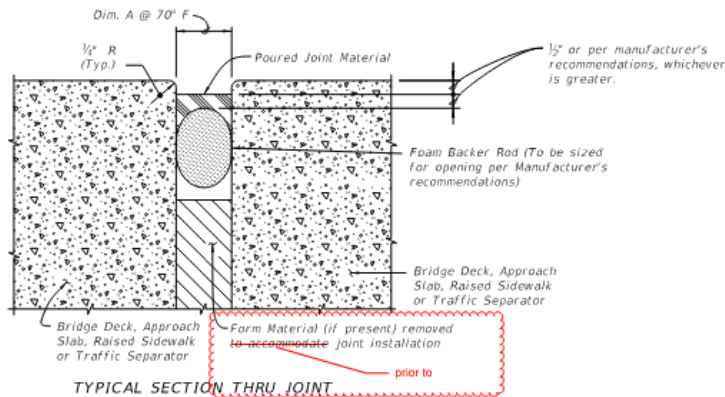


**GENERAL NOTES:**

- Furnish and install Poured Joint With Backer Rod Expansion Joint Systems in accordance with Specification Sections 458 and 932 using Type D silicone sealant material.
- Refer to the Structures Plans, Poured Expansion Joint Data Table for Dim. A @ 70° F.



## Sheet 1:

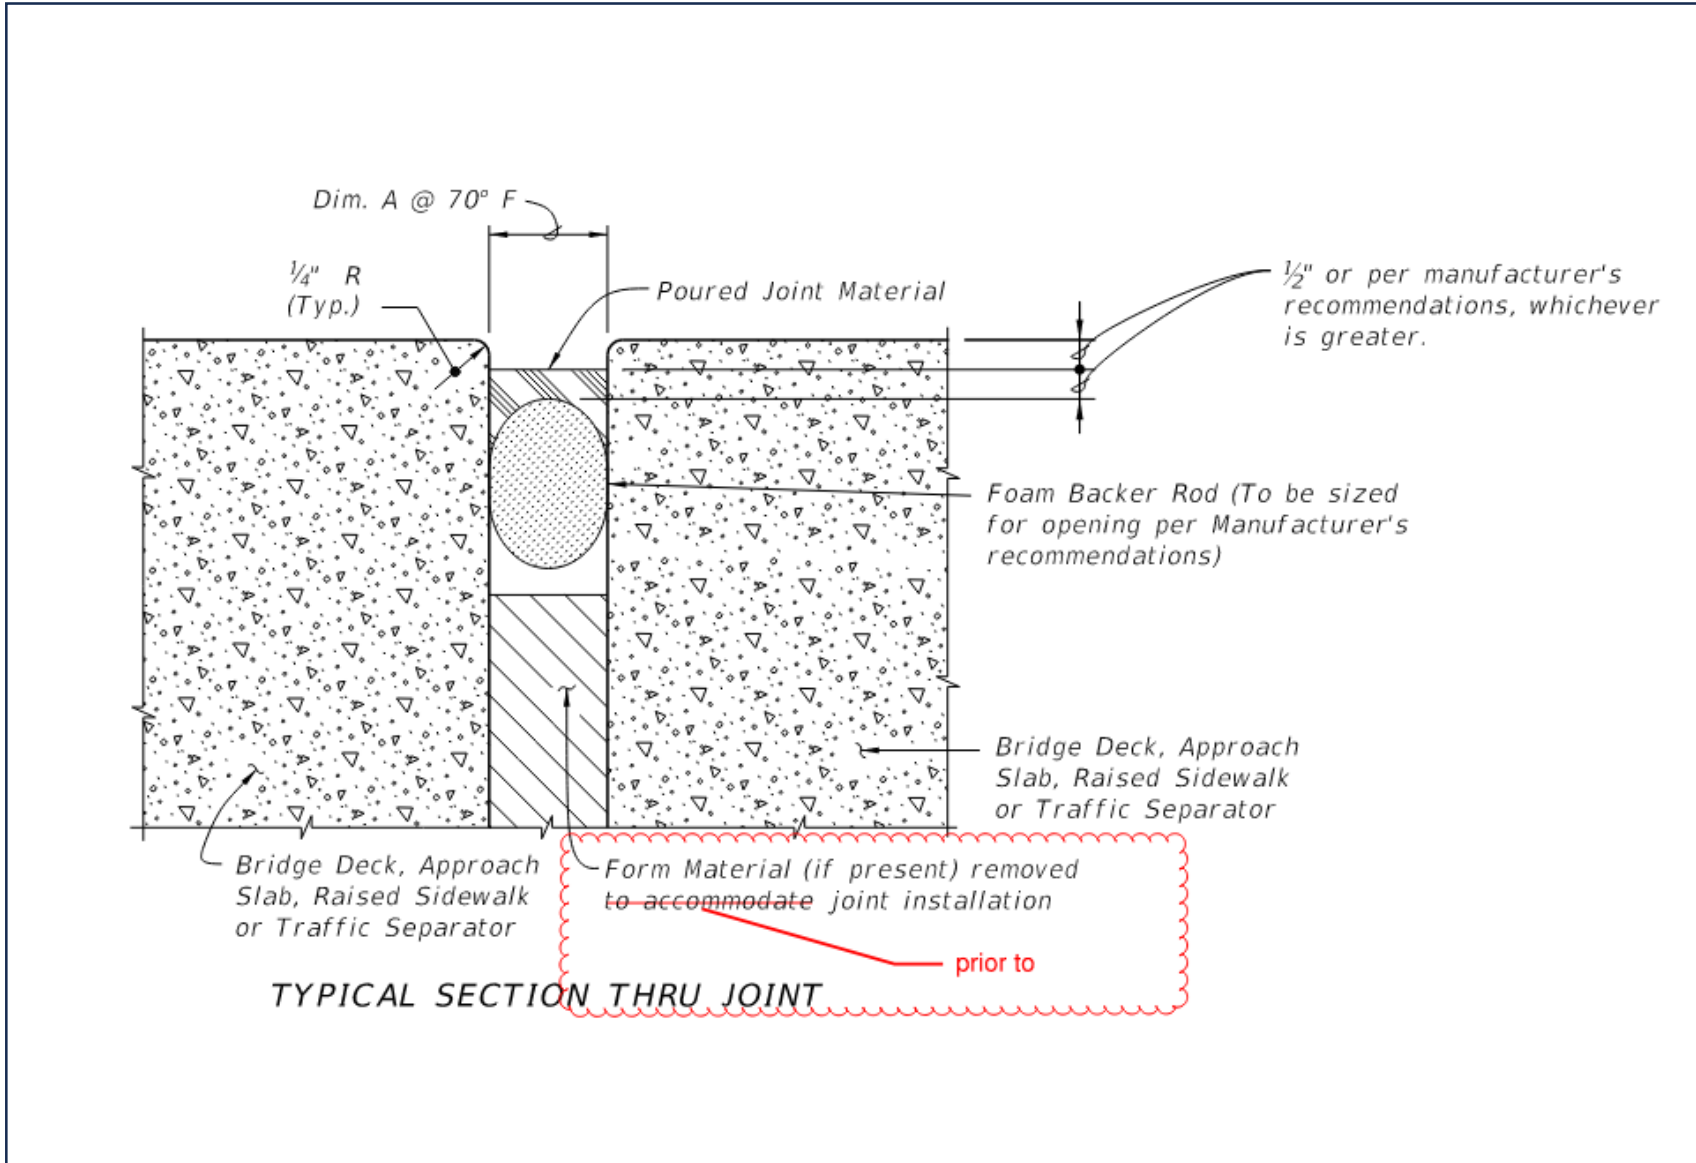


- **Modified note for Form Material Removal**





## Sheet 1:

- **Revised Title**

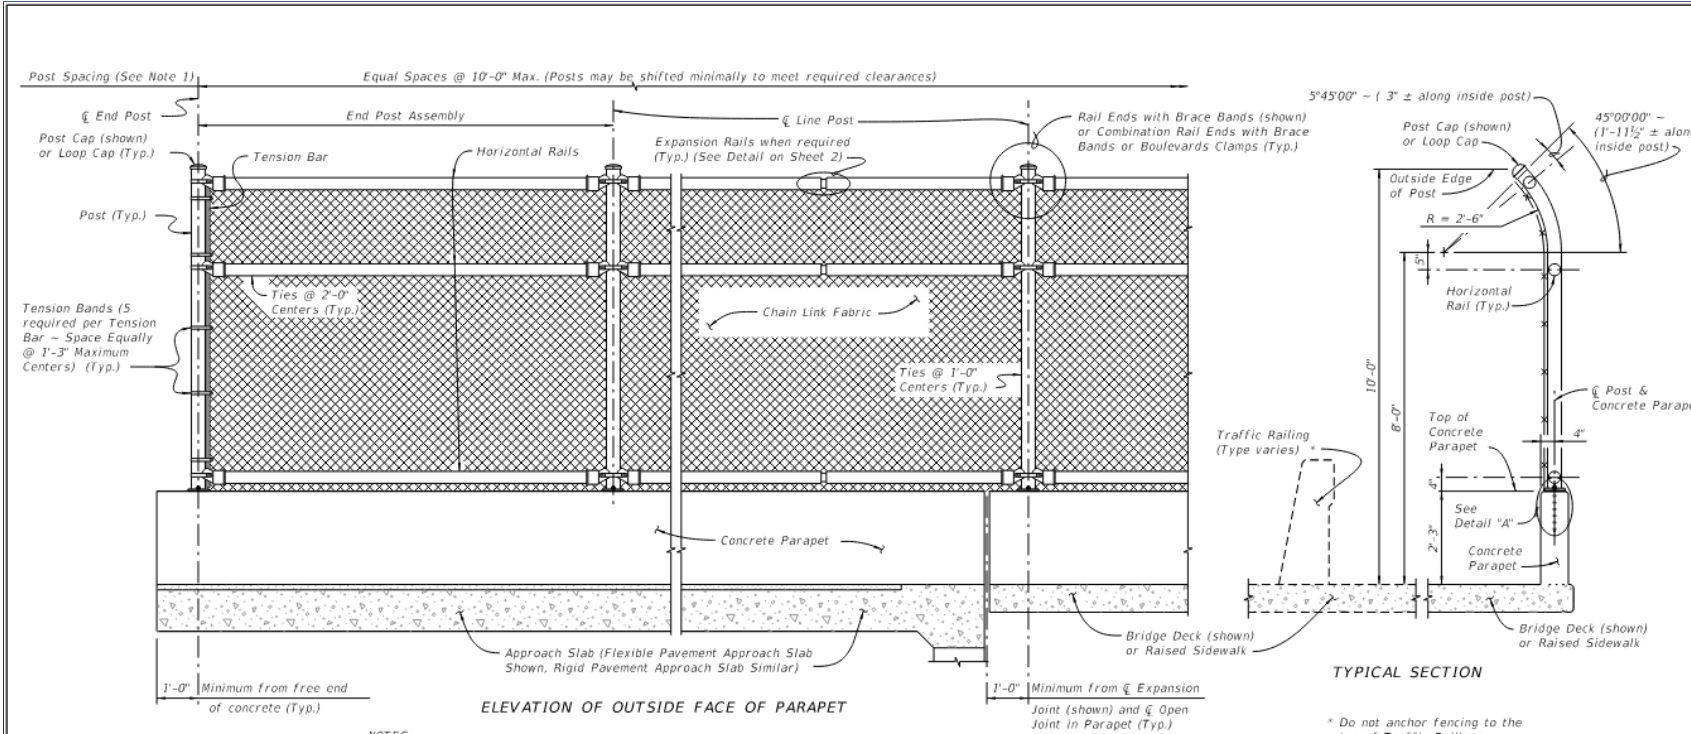

NOTES:  
1. A Pull Post Assembly is required at maximum intervals of 500'-0". See Sheet 2.

### FENCING NOTES

**FENCE APPLICATION:**  
This bridge fence can only be used on sidewalk installations separated from traffic by a traffic railing.

**FENCE INSTALLATION:**  
Install posts plumb (within a tolerance of  $\pm 1\frac{1}{2}$ "). Use shim plates as required to achieve plumb. The required quantity and thickness of shim plates will be determined in the field. Install chain link fence in accordance with ASTM F567 as applicable.

**CONCRETE PARAPET DETAILS:**  
See Index 521-820 – Pedestrian/Bicycle Bullet Railing for Concrete Parapet details. Provide fencing in lieu of aluminum bullet railing as shown on Index 521-820.

**LIMITS OF FENCING:**  
Limits of fencing are from begin of approach slab at Begin Bridge to end of approach slab at End Bridge, unless otherwise shown in the plans.

**PAYMENT:**  
Payment will be made under Fencing, Type R. Payment includes posts, horizontal and expansion rails, brace bands, rail ends, combination rail ends, boulevard clamps, chain link fabric, ties, tension bars and bands, post and loop caps, base plates, anchor rods, bolts, nuts, washers, shim plates, neoprene pads, miscellaneous fence fittings and hardware and all incidental materials and labor required to complete installation of the fence.

**CROSS REFERENCE:**  
For Table of Fence Components and Pull Post Assembly Detail see Sheet 2.  
For Table of Post Attachment Components and Detail "A" see Sheet 3.


BRIDGE FENCING ON PARAPET (CURVED TOP)



LAST REVISION 04/01/23	DESCRIPTION:	FDOT FY 2024-25 STANDARD PLANS	BRIDGE FENCING ON PARAPET	INDEX 550-011	SHEET 1 of 3
---------------------------	--------------	--------------------------------------	---------------------------	------------------	-----------------

## Sheet 1:

- Revised Dimensions

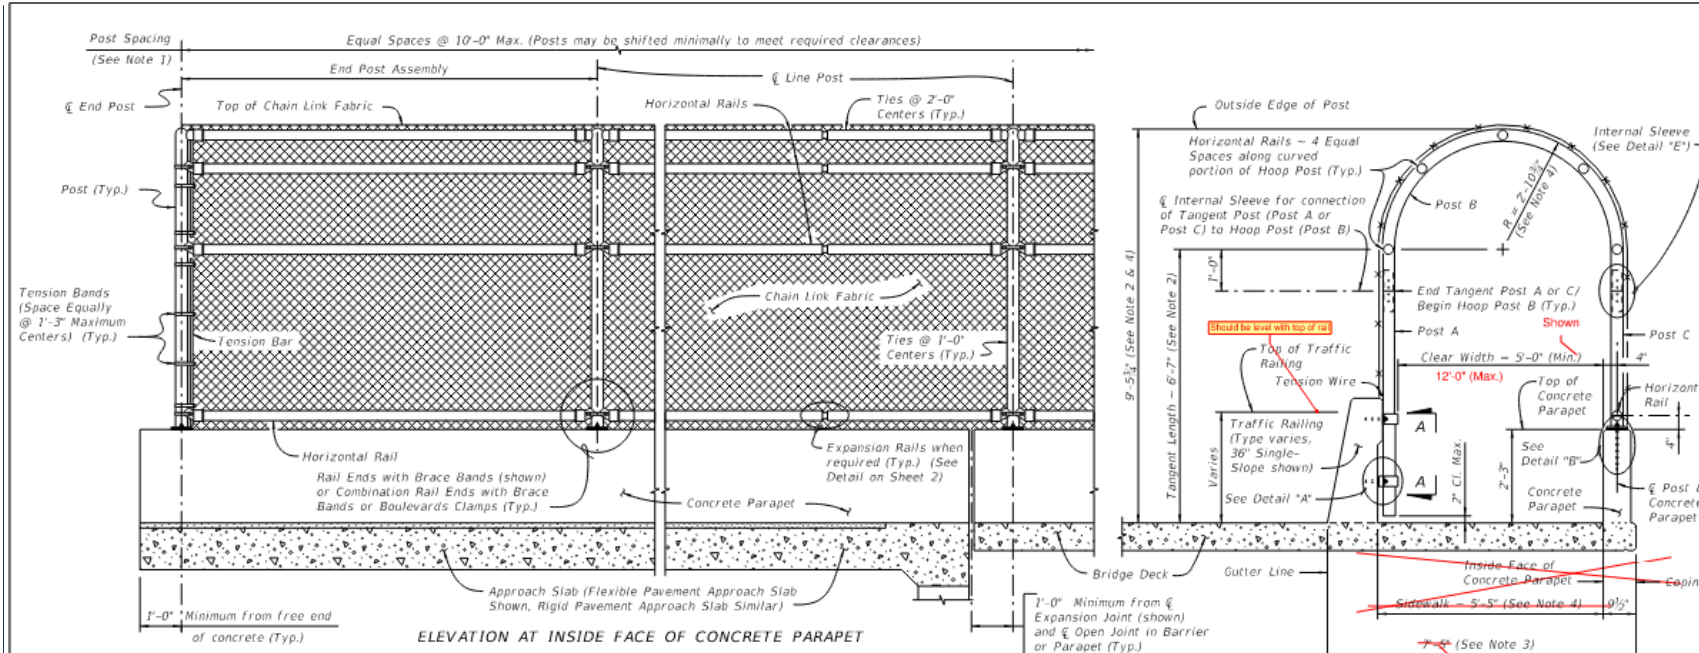

- NOTES:**
1. A Pull Post Assembly is required at maximum intervals of 500'-0". See Sheet 3.
  2. Dimension is measured along Inside Face of Concrete Parapet.
  3. Dimension shown is for 36" Single-Slope Traffic Railings as shown in Index 521-427. Adjust as required for other Traffic Railing Barriers and sidewalk widths.
  4. For sidewalk clear widths greater than 5'-0", increase the radius and height of the curved portion of the Hoop Post at the rate of 6" for every one foot increase in sidewalk width.

**FENCING NOTES**

**FENCE INSTALLATION:**  
Install posts plumb (within a tolerance of  $\pm 1\frac{1}{2}$ " ). Use shim plates as required to achieve plumb. The required quantity and thickness of shim plates will be determined in the field. Install chain link fence in accordance with ASTM F567 as applicable.

**TRAFFIC RAILING DETAILS:**  
See Superstructure Sheets for Traffic Railing details.

**CONCRETE PARAPET DETAILS:**  
See Index 521-820 – Pedestrian/Bicycle Railing for Concrete Parapet details. Provide fencing in lieu of aluminum bullet railing as shown on Index 521-820.

**LIMITS OF FENCING:**  
Limits of fencing are from begin of approach slab at Begin Bridge to end of approach slab at End Bridge, unless otherwise shown in the plans.


**PAYMENT:**  
Payment will be made under Fencing, Type R. Payment includes posts, horizontal and expansion rails, brace bands, rail ends, combination rail ends, boulevard clamps, chain link fabric, tension wire, ties, hoop rings, tension bars and bands, pipe clamps, base plates, anchor rods, bolts, nuts, washers, shim plates, spacers, neoprene pads, miscellaneous fence fittings and hardware and all incidental materials and labor required to complete installation of the fence.

**CROSS REFERENCE:**  
For Table of Fence Components and Table of Post Attachment Components see Sheet 2.  
For Pull Post Assembly Detail, View A-A and Detail "A" see Sheet 3.  
For Detail "B" and "E" see Sheet 4.

LAST REVISION 11/01/17	DESCRIPTION:	FY 2023-24 STANDARD PLANS	BRIDGE FENCING (ENCLOSED)	INDEX 550-012	SHEET 1 of 4
---------------------------	--------------	------------------------------	---------------------------	------------------	-----------------



## Sheet 1:

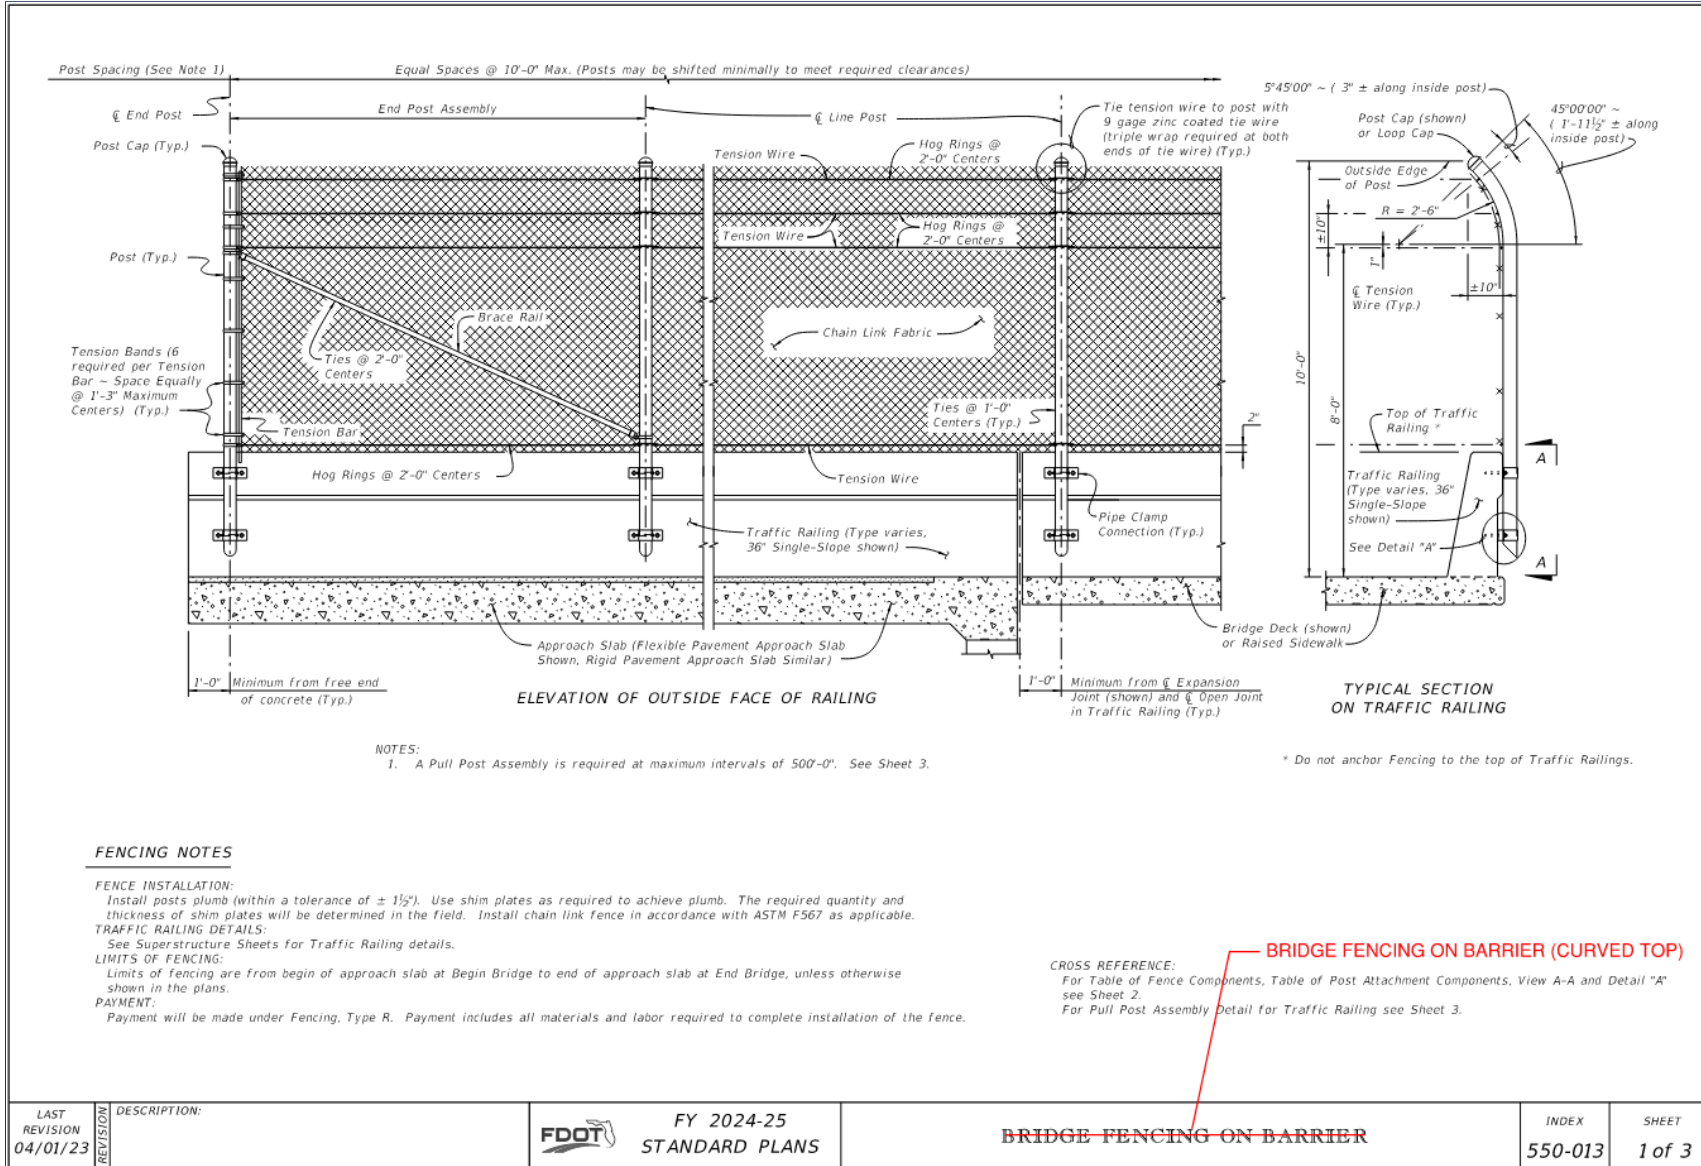

• **Revised Title**



LAST REVISION 04/01/23	DESCRIPTION:	FY 2024-25 <b>STANDARD PLANS</b>	<del>BRIDGE FENCING ON BARRIER</del>	INDEX 550-013	SHEET 1 of 3
---------------------------	--------------	-------------------------------------	--------------------------------------	------------------	-----------------




## Sheet 1:


### CONDUIT GENERAL NOTES:

1. Furnish and install approved Conduits, Fittings and Embedded Junction Boxes (EJB's) in accordance with Specification Sections 630 and 635, this Standard, the National Electric Code (NEC) and as directed by the Engineer.
2. Furnish and install Embedded Junction Boxes (EJB) with weatherproof covers sized in accordance with NEC requirements and the maximum size limits shown. Install EJB adjacent to the Begin and End of Bridges, Begin and End of Retaining Walls, (except omit EJB adjacent to the Bridge unless a precast Traffic Railing with junction slab is used), and at other locations as necessary to maintain 300 foot maximum spacing. See Plans for additional locations and details.
3. For Conduit not designated for future use, see Plans for details. For Conduit designated for future use, stub out and cap the Conduit. Drive a 3'-0"± long 3/4" (min.) diameter Steel Pipe flush with the ground line adjacent to the end of the Conduit as shown on Sheets 2, 3 or 4. Provide the location of the stub out with Steel Pipe to the Engineer for inclusion on the As-Built Plans.
4. Shift vertical Railing reinforcement symmetrically to provide 2" clearance to EJB. Space shifted vertical reinforcement at minimum 3" centers. Cut horizontal Railing reinforcement to provide 2" clearance to EJB and provide supplemental reinforcement as shown. To facilitate placement of Conduit, Expansion Fittings, and Expansion/Deflection Fittings, shift reinforcing a maximum of 1" but do not cut railing reinforcing to facilitate Conduit or Fittings. Do not bundle Conduits, or Conduit and horizontal reinforcement.
5. Place conduits as indicated in this Standard unless Structures Plans indicate fewer.


\* Reduce to 6" maximum when installed in Pedestrian/ Bicycle Railings.

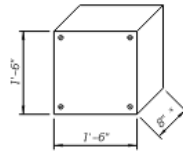


**EJB "A"**  
Double or Triple Conduit  
(Maximum Dimensions)

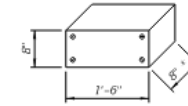


**EJB "B"**  
Single Conduit  
(Maximum Dimensions)

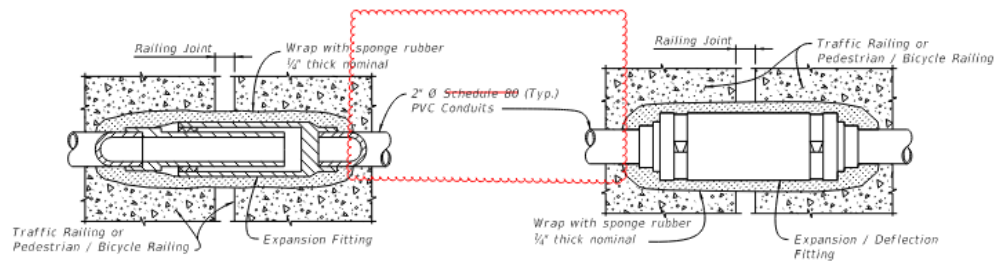

**DETAIL "A"**  
EXPANSION FITTING DETAIL

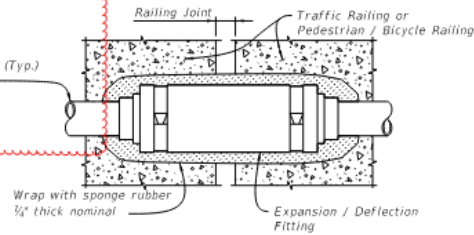

**DETAIL "B" EXPANSION / DEFLECTION FITTING DETAIL (CONCRETE / CONCRETE)**

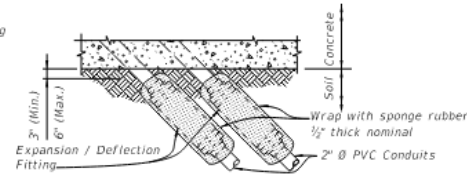

**DETAIL "C" EXPANSION / DEFLECTION FITTING DETAIL (CONCRETE / SOIL)**


### GENERAL

LAST REVISION 11/01/20	DESCRIPTION:	FY 2023-24 STANDARD PLANS	CONDUIT DETAILS - EMBEDDED	INDEX 630-010	SHEET 1 of 4
---------------------------	--------------	------------------------------	----------------------------	------------------	-----------------

- Revised for Sch 40 pipe



## Sheet 1:

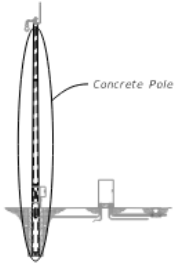

### NOTES:

- Diameter of 12-sided poles are measured flat to flat.
- Total Taper applies to pole, strands and reinforcing.
- For 12-Sided Pole and Round Poles Option 2, Stress prestressed strand to 70% of Ultimate before transfer. For Round Pole Option 1, stress prestressed strand to 60% of Ultimate before transfer.
- Pole Design Tables, Burial Depth is based on level ground (flatter than 1:5). Increase the burial depth in accordance with the Additional Burial Depth Due To Ground Slope table for foundations with slopes 1:5 and steeper. Use the higher value for slope or diameter values that fall between those shown on the table.

Ground Slope	Additional Burial Depth (feet)
1:5	3
1:4	4
1:3	5
1:2	7


5. Strand Pattern 1 may be used in lieu of Strand Pattern 2 where required by fabrication to facilitate Handhole construction.

### 12-SIDED POLE DESIGN TABLE (See Note 1)


Pole Length (ft)	Pole Height (ft)	Burial Depth (ft)	Total Taper (in/ft) (See Note 2)	Void Taper (in/ft)	Min. Wall Thickness Tip (in)	Min. Wall Thickness Butt (in)	Tip Diameter (in)	Butt Diameter (in)	Strand Pattern	Strand Diameter
63	50	13	0.18	0.18	3	3	12	23.34	1	0.6"
69	55	14	0.18	0.18	3	3	12	24.42	1	0.6"
75	60	15	0.18	0.18	3	3	12	25.50	1	0.6"
80	65	15	0.18	0.18	3	3	12	26.40	1	0.6"
86	70	16	0.18	0.18	3	3	12	27.48	1	0.6"

### ROUND POLE DESIGN TABLE

Pole Length (ft)	Pole Height (ft)	Burial Depth (ft)	Design Option	Total Taper (in/ft) (See Note 2)	Void Taper (in/ft)	Min. Wall Thickness Tip (in)	Min. Wall Thickness Butt (in)	Tip Diameter (in)	Butt Diameter (in)	Strand Pattern	Strand Diameter
63	50	13	Option 1	0.216	0.192	3	3.76	12.15	25.76	3	0.5"
			Option 2	0.180	0.172	3	3.50	12.00	23.34	4	0.5"
69	55	14	Option 1	0.216	0.192	3	3.83	12.15	27.05	3	0.5"
			Option 2	0.180	0.173	3	3.50	12.00	24.42	4	0.5"
75	60	15	Option 1	0.216	0.192	3	3.90	12.15	28.35	3	0.5"
			Option 2	0.180	0.173	3	3.50	12.00	25.50	4	0.5"
80	65	15	Option 1	0.216	0.192	3	3.96	12.15	29.43	3	0.5"
			Option 2	0.180	0.174	3	3.50	12.00	26.40	4	0.5"
86	70	16	Option 1	0.216	0.192	3	4.03	12.15	30.73	3	0.5"
			Option 2	0.180	0.174	3	3.50	13.00	28.48	4	0.5"

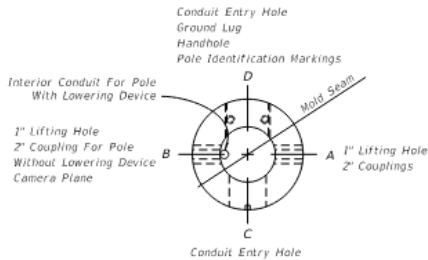

PLAN VIEW

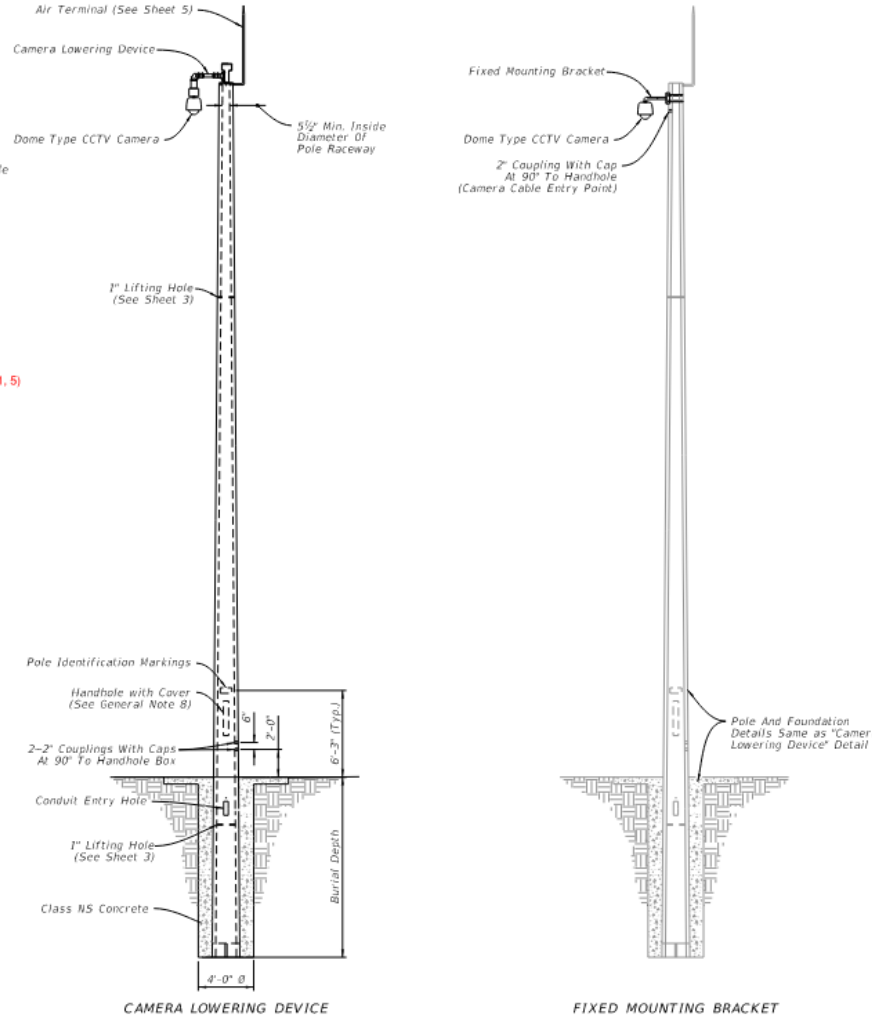

CAMERA LOWERING DEVICE

FIXED MOUNTING BRACKET

ELEVATION


• Added new strand pattern





## Sheet 2:

- Added new strand pattern

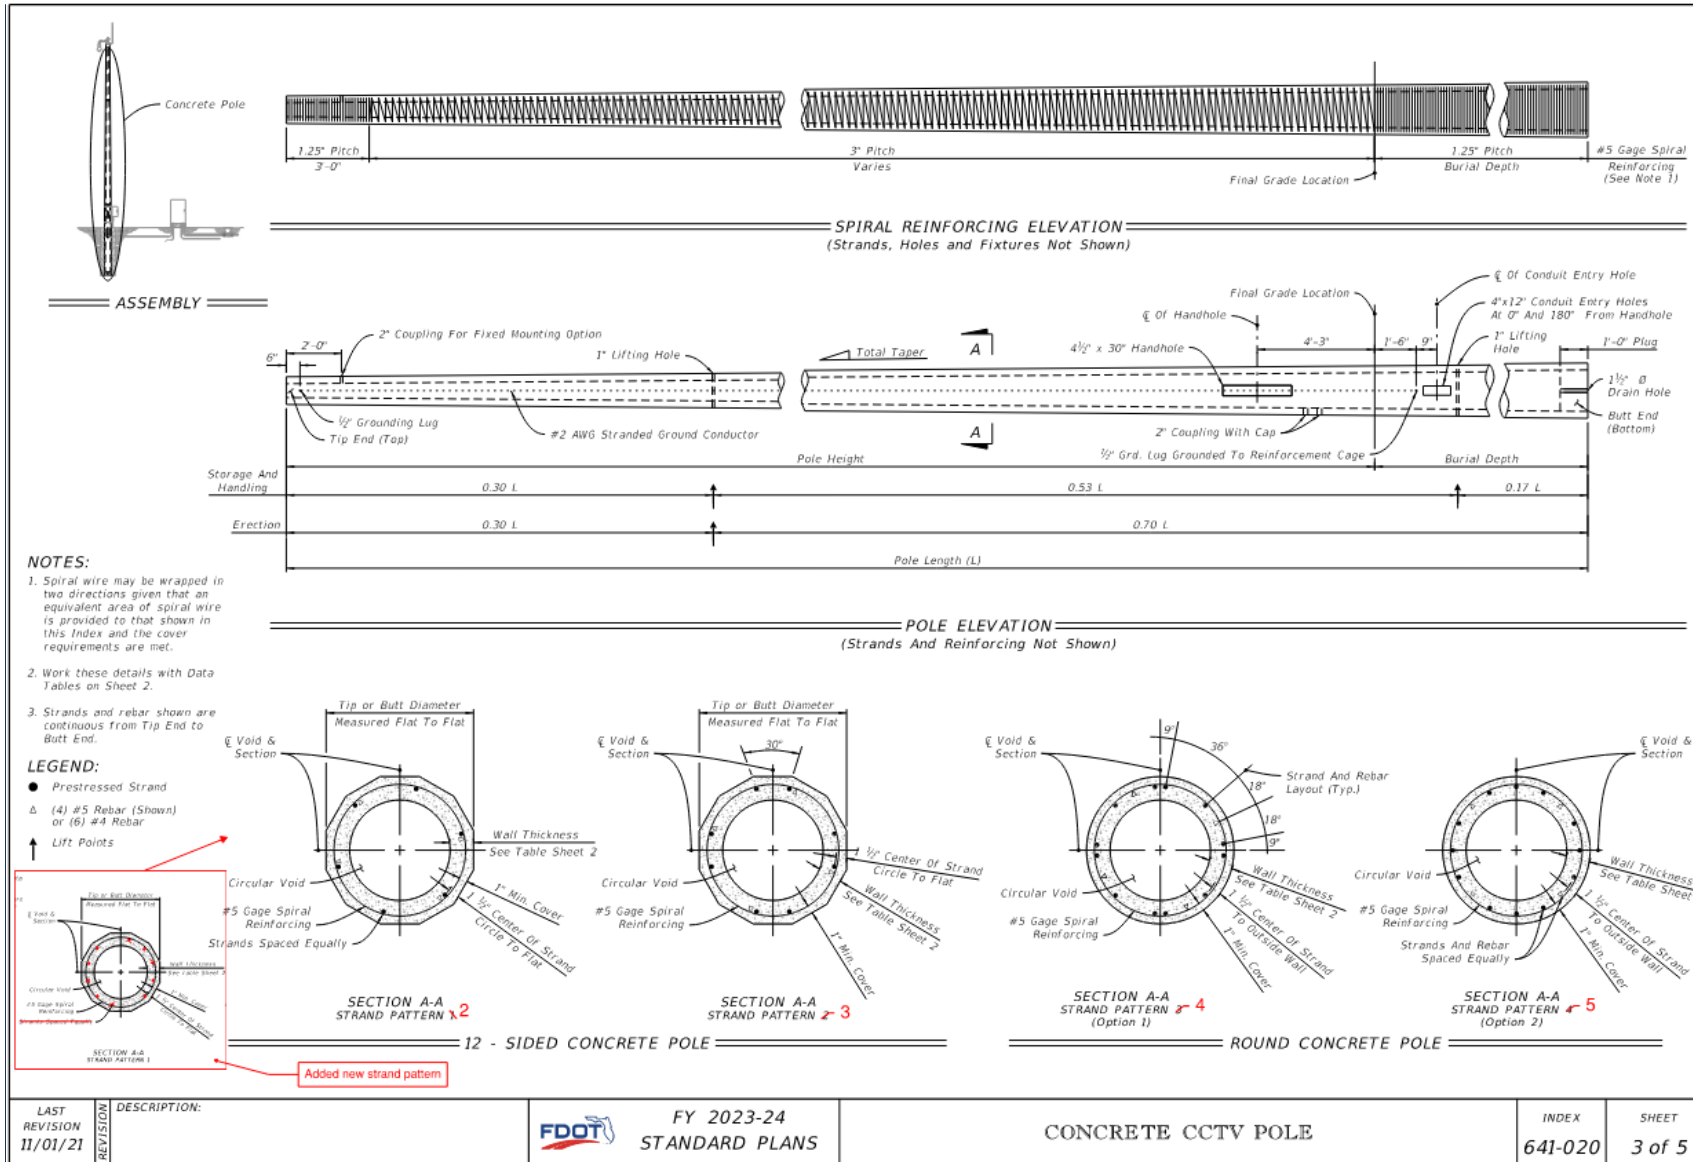

LAST REVISION 11/01/21	DESCRIPTION:	FDOT FY 2023-24 STANDARD PLANS	CONCRETE CCTV POLE	INDEX 641-020	SHEET 3 of 5
---------------------------	--------------	--------------------------------------	--------------------	------------------	-----------------

# Contact Us:



## For Questions or Suggestions:

Contact: Structures Standard Plans Engineer  
Joshua Turley P.E.

[Joshua.Turley@dot.state.fl.us](mailto:Joshua.Turley@dot.state.fl.us)

850-414-4475

