


# *Design Standards Update*

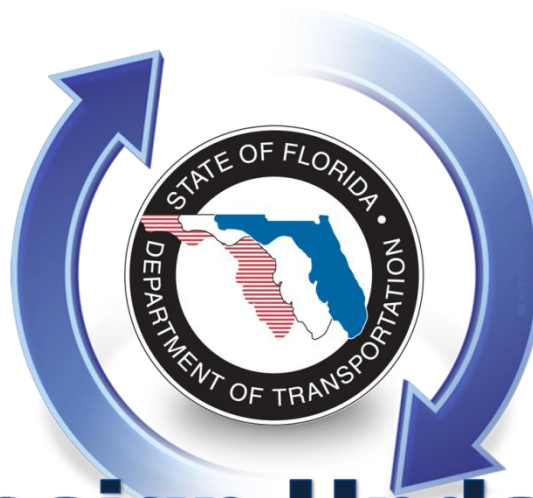

## **Design Update Training**

Patrick Overton, P.E.

Design Standards Engineer

[Patrick.Overton@dot.state.fl.us](mailto:Patrick.Overton@dot.state.fl.us)

# *Index 199 – Geotextile Criteria*

- ◆ Mechanically Stabilized Retaining Wall and Supporting Spread Footing Foundations applications were added to the Drainage class(D-2).



# Index 199 – Cont.

CLASS	TYPE (1)	APPLICATION DESCRIPTION	INDEX NO.	PERMITTIVITY (sec <sup>-1</sup> )	AOS SIEVE#	MIN. GRAB TENSILE STRENGTH (lb)	MIN. SEWN STRENGTH (lb/in)	
DRAINAGE (D)	D-1	Revetment (Special)		(See D-2)	(See D-2)	315	7.2	
	D-2	Revetment (Standard)		281	% SOIL PASSING No. 200 SIEVE <15% 0.7 15% to 50% 0.2 >50% 0.1	% SOIL PASSING No. 200 SIEVE <15% 40 15% to 50% 60 >50% 70*	Woven Monofilament 248 Other Geotextiles: Elongation <50% 315 ≥50% 203	Woven Monofilament 5.7 Other Geotextiles: Elongation <50% 6.9 ≥50% 4.7
		Articulating Block****						
		Gabions						
		Rock, Rubble, Broken Concrete						
	D-3	Underdrain ***	286	% SOIL PASSING No. 200 SIEVE <15% 0.5 15% to 50% 0.2 >50% 0.1	% SOIL PASSING No. 200 SIEVE <15% 40 15% to 50% 60 >50% 70*	Elongation <50% 248 ≥50% 158	Elongation <50% 5.7 ≥50% 3.6	
		French Drain	285					
		Sheet Piling Filter						
		Filter Fabric Jacket (Culvert)	280					
		Concrete Pavement Subdrainage	287					
	D-4	Slope Pavement (Sand-Cement)		0.5	40	180	4.2	
		Ditch Pavement (Sand-Cement)	281					
	D-5	Mechanically Stabilized Retaining Wall		0.5	40	180	4.2	
		Cast-In-Place Retaining Wall						

Filtration Efficiency % ASTM-D-5141  
Flow Rate gpm/min ASTM-D-5141

LAST REVISION 07/01/13

DESCRIPTION:



FDOT 2014 DESIGN STANDARDS

GEOTEXTILE CRITERIA


INDEX NO. 199

SHEET NO. 1 of 1



# Index 199 – Cont.

Index No	Total Sheets	Index Title	Revision	Instructions for Design Stds (IDS)	Data Table Cell Library	Borderless DGNs
(PDF)				(PDF)	(ZIP)	(ZIP) Terms of Use
Complete eBooklet (277mb)	966			Combined Available IDS (11mb)	Combined Available CELs (1mb)	Combined Available DGNs (57mb)
		<b>COVER, TABLE OF CONTENTS AND REVISIONS</b>				
Cover	3	Booklet Cover		Cover		
Content	2	Table of Contents		Content		
Revisions	4	Booklet Revisions		Introduction Revisions		
		<b>ABBREVIATIONS AND SYMBOLS</b>	<b>Roadway Contact</b>			
001	4	Standard Abbreviations				
002	4	Standard Symbols				
		<b>EROSION CONTROL AND WATER QUALITY</b>	<b>Hydraulics Contact</b>			
104	2	Permanent Erosion Control				
105	1	Shoulder Sodding and Turf on Existing Facilities				
		<b>DRAINAGE</b>	(199-288, 293-295) Hydraulics Contact (289-292) Structures Contact			
199	1	Geotextile Criteria		IDS-199		

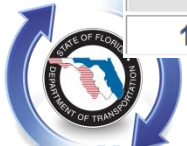

# Index 199 – Cont.

Instructions for Design Standards  
Index 199 Geotextile Criteria (Rev. 07/13)

Topic No. 625-010-003-j  
2014

## Index 199 Geotextile Criteria (Rev. 07/13)

### Design Criteria

The Designer is to review the criteria provided in the index and determine the geotextile type that satisfies project requirements. The geotextile type shall be called for in the plans or contained in the project special provisions.

### Plan Content Requirements

Provide the geotextile type required in the summary tables of the plans for the application except when this information is already detailed in another referenced Standard Index. In the case of project special provision, provide the geotextile type required in the summary tables of the plans.

### Payment

The Drainage class (D) is a component of a Standard Index - No pay item exists.

Under Erosion class (E), Wind Screen or Silt Fence does not have a pay item. This will be an inclusive cost associated with a construction activity.

Item number	Item description	Unit Measure
0571-1-11	Plastic Erosion Mat, Turf Reinforced Mat, Type 1	SY
0571-1-12	Plastic Erosion Mat, Turf Reinforced Mat, Type 2	SY
0571-1-13	Plastic Erosion Mat, Turf Reinforced Mat, Type 3	SY



# *Index 200 Series*

- ◆ Removed all Proprietary Product references throughout the Indexes.
- ◆ Precast and foundry suppliers to provide correlations between DOT Index requirements and their catalog of products.




# *Index 205 – Pipe BackFill*


- ◆ All tables were removed and placed in the Drainage Manual.




# Index 205 - Previous Sheet 1

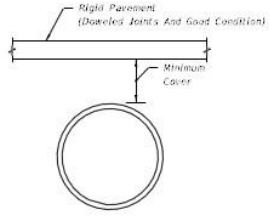


**RIGID PAVEMENT**

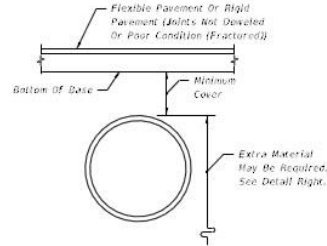

**FLEXIBLE PAVEMENT**

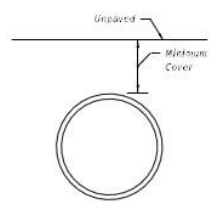


**UNPAVED**

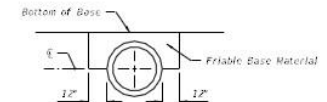

**FRIABLE BASE**

The cost of furnishing and installing the extra base material shall be included in the cost of the culvert.

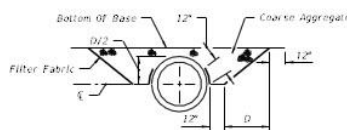


**ASPHALTIC CONCRETE BASE**

The coarse aggregate shall be placed in 6 inch lifts and compacted sufficiently as to be firm and unyielding. The coarse aggregate shall be gravel or stone meeting the requirements of Standard Specification Sections 901-2, 4, 467, 5, 56, or 57 unless restricted in the plans. The filter fabric shall be Type D-3 (See Index No. 199). The cost of furnishing and installing the coarse aggregate and filter fabric shall be included in the cost of the culvert.


PIPE TYPE/SIZE & SHAPE	MINIMUM COVER	PIPE TYPE/SIZE & SHAPE	MINIMUM COVER	
			COMMERCIAL	NON-COMMERCIAL
<b>CONCRETE (See Note 6)</b> Round & Elliptical	5"	<b>CONCRETE (See Note 6)</b> Round & Elliptical		5"
<b>CORRUGATED STEEL</b> 15"-72" Round & Arch Equiv.	9"	<b>CORRUGATED STEEL</b> 12"-30" Round	12"	5"
78" & Larger Round & Arch Eq.	15"	12"-30" Round	18" (15")	12" (12")
<b>CORRUGATED ALUMINUM</b> 15"-72" Round & Arch Equiv.	9"	36"-48" Round	18" (12") (15")	12" (12") (12")
78"-102" Round & Arch Equiv.	15"	54"-72" Round	18" (12") (15")	15" (12") (12")
<b>CORRUGATED POLYETHYLENE</b> 15"-60" Round	9"	78"-96" Round	18" (12")	12" (12")
<b>POLYVINYL CHLORIDE</b> 15"-36" Round	9"	102" & Larger Round	18" (12")	12" (12")
		15"-30" Arch Equiv.	18" (12")	12" (12")
		36"-48" Arch Equiv.	24" (12") (15")	18" (12")
		54"-72" Arch Equiv.	24" (15") (24")	18" (12") (15")
		78"-96" Arch Equiv.	30" (18") (24")	24" (12") (18")
		102" & Larger Arch Equiv.	30" (12")	24" (12")
		<b>CORRUGATED ALUMINUM</b> 12"-24" Round	21" (21")	15" (15")
		30"-48" Round	24" (18") (24")	18" (12") (15")
		54"-72" Round	30" (24") (27")	24" (18") (21")
		78"-102" Round	30" (15") (27")	24" (12") (21")
		102" & Larger	36"	30"
		15"-24" Arch Equiv.	27" (21")	24" (21")
		30"-48" Arch Equiv.	33" (21") (27")	27" (15") (21")
		54"-72" Arch Equiv.	36" (24") (30")	30" (18") (27")
		78"-96" Arch Equiv.	30" (15") (36")	24" (12") (30")
		102" & Larger Arch Equiv.	36"	30"
		<b>CORRUGATED POLYETHYLENE</b> 15"-60" Round	21"	15"
		<b>POLYVINYL CHLORIDE</b> 15"-36" Round	21"	15"

**MINIMUM COVER FOR CONCRETE, STEEL, ALUMINUM, POLYETHYLENE AND POLYVINYL CHLORIDE PIPE**

LAST REVISION	DESCRIPTION		<b>FDOT DESIGN STANDARDS</b> 2013	<b>COVER HEIGHT</b>	<b>INDEX NO.</b> 205	<b>SHEET NO.</b> 1
07/01/07						




# Index 205 Cont.

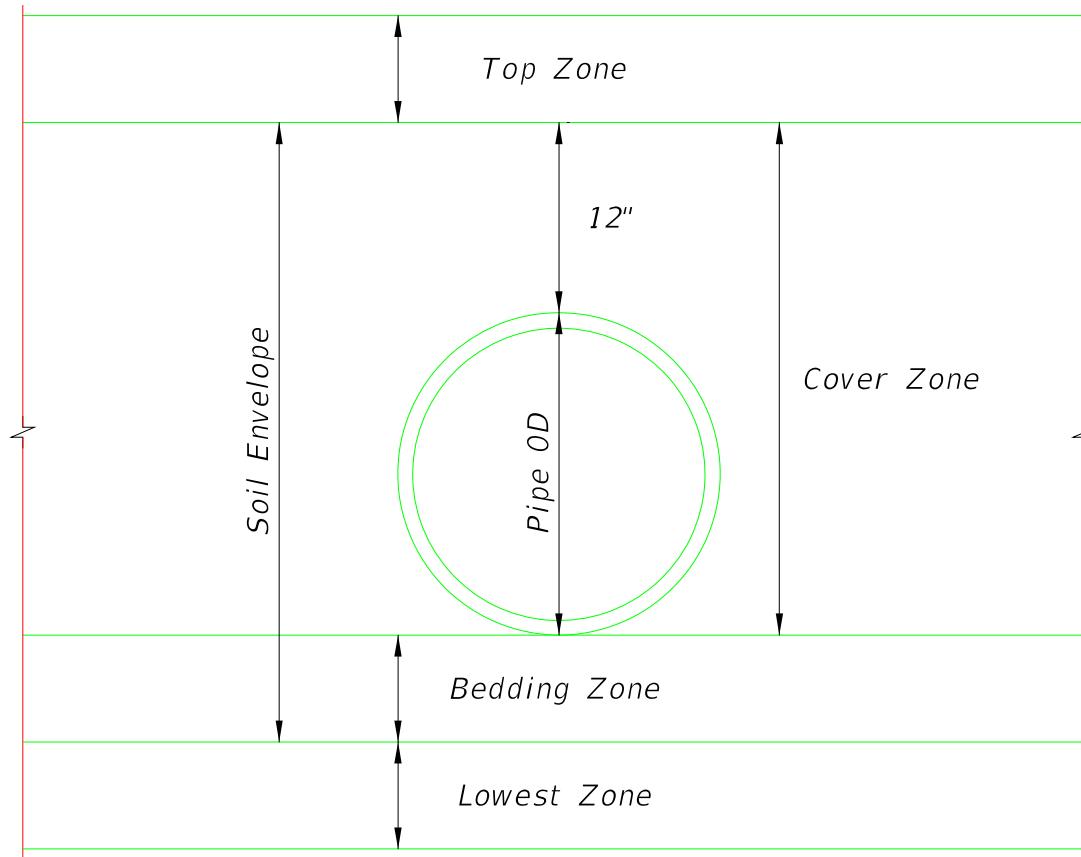


## Pipe Backfill

For Additional Information On Pipe Backfill Requirements See Specification Section 125.

SHEET  
NO.  
1 of 1

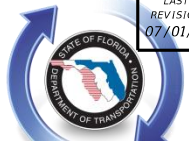


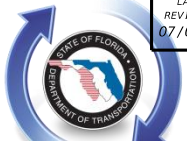
# Index 216 – Closed Flume Inlet

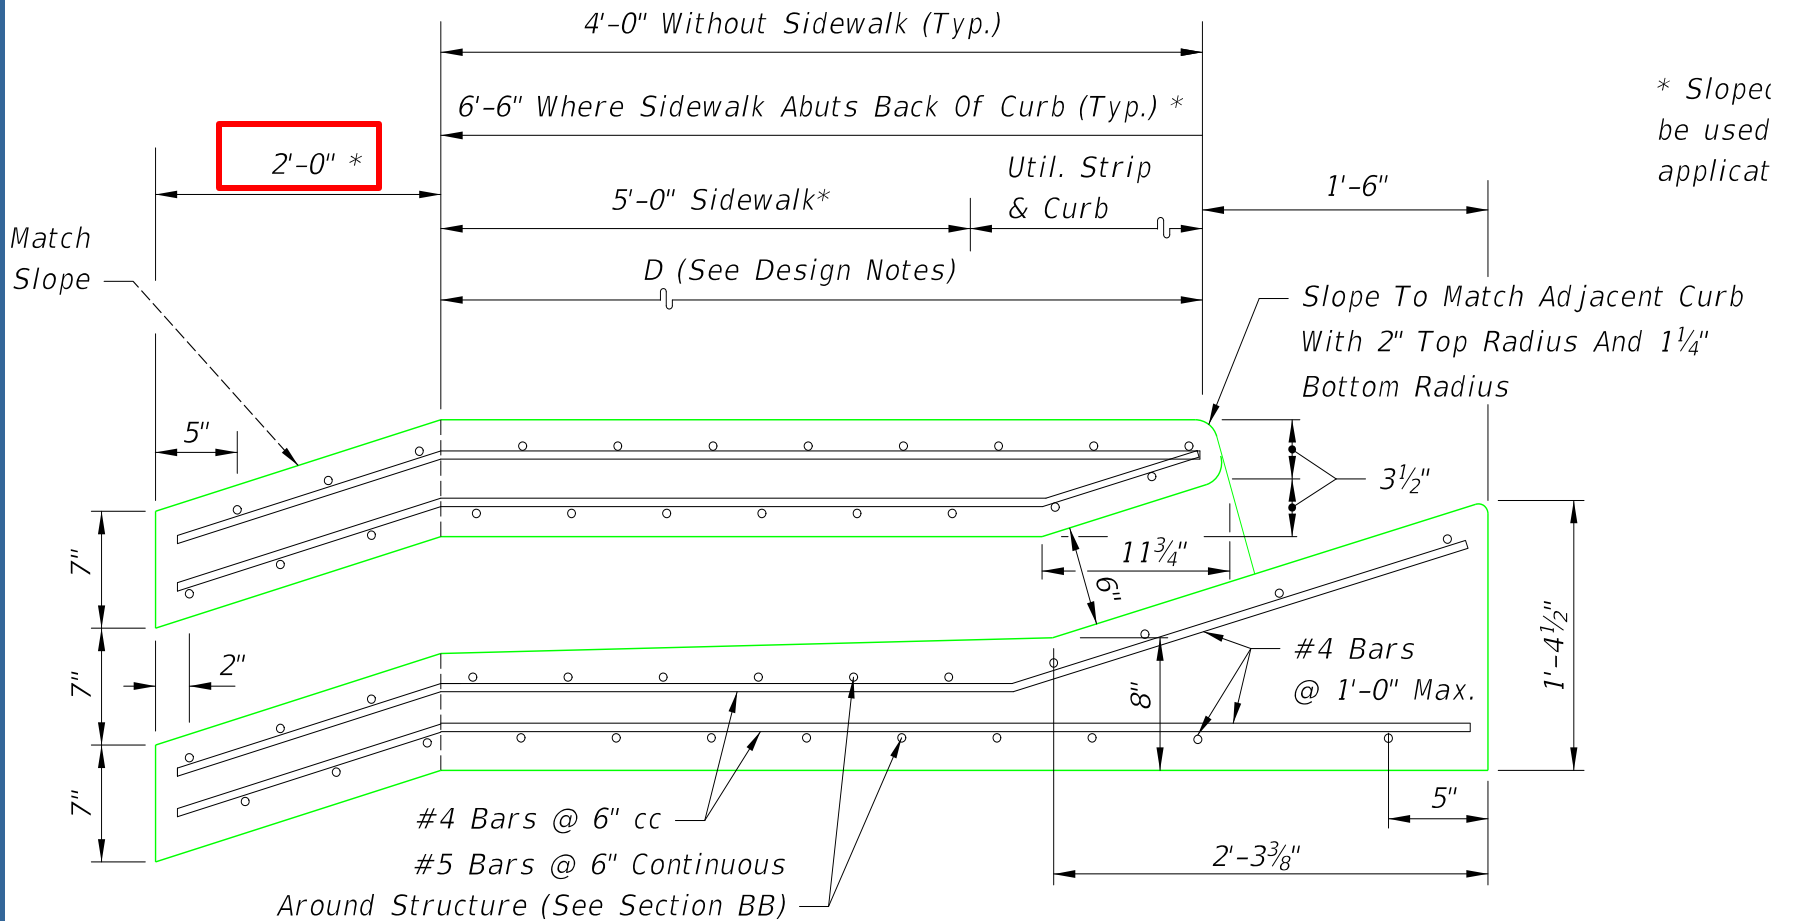

\* Slopes be used applicat

## SECTION AA

LAST REVISION 07/01/13	DESCRIPTION:	 FDOT 2014 DESIGN STANDARDS	CLOSED FLUME INLET	INDEX NO. 216	SHEET NO. 1 of 3
---------------------------	--------------	---	--------------------	------------------	---------------------




# *Index 410 – Concrete Barrier Wall*


- ◆ Structures Bulletin 13-02 and Roadway Bulletin 13-01 (Median Barrier Mounted Overhead Sign Structures) was released in last March
- ◆ The index was revised to include the drawings from the bulletin.




# Index 410 Cont.

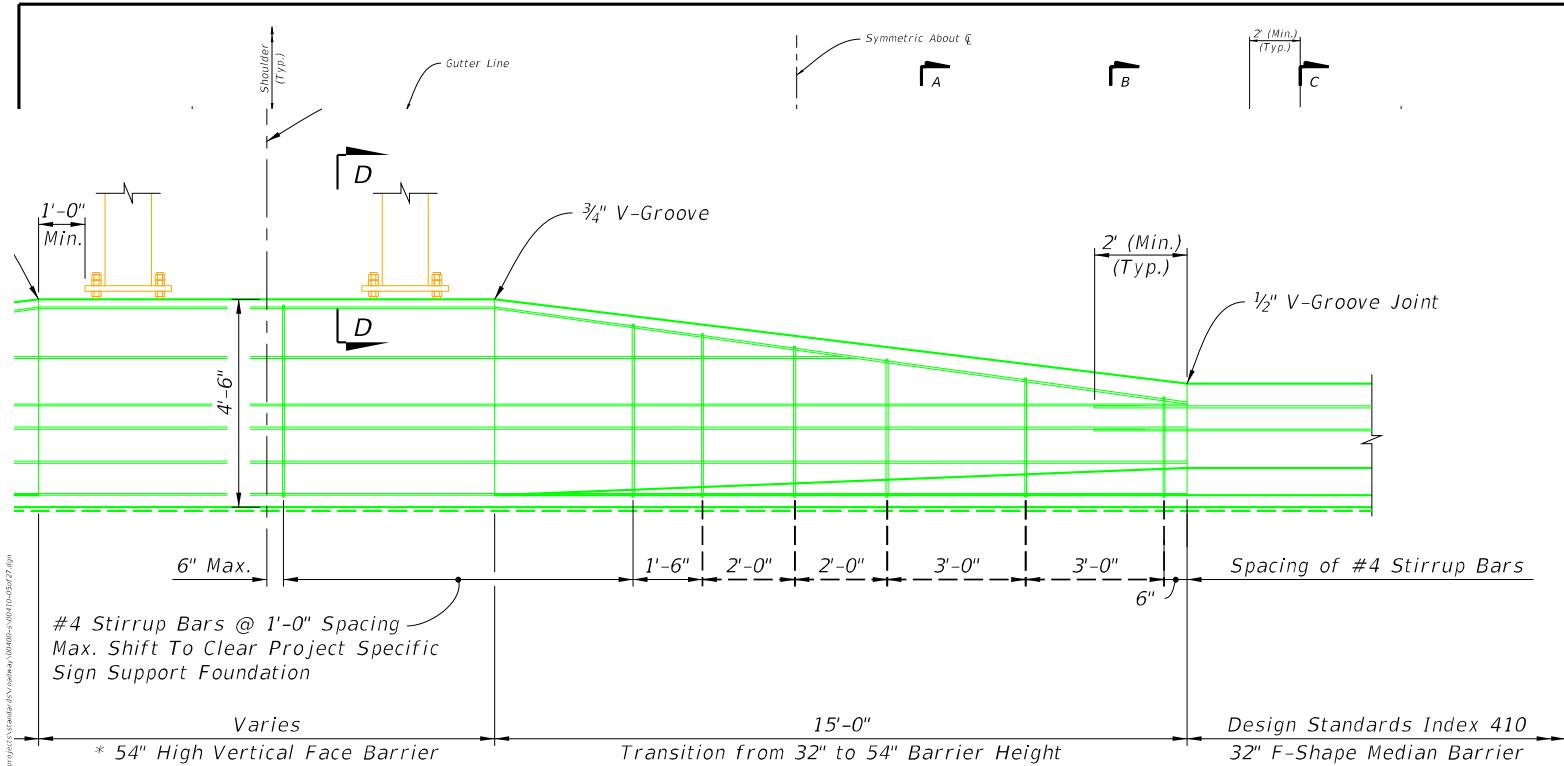

## ELEVATION

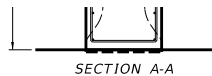

LARGE SIGN MEDIAN BARRIER MOUNTED SIGN SUPPORT TRANSITION (OPTION 1)

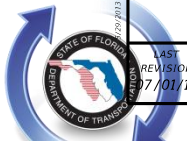

LAST REVISION 07/01/13

REVISION	DESCRIPTION
07/01/13	


FDOT 2014 DESIGN STANDARDS

CONCRETE BARRIER WALL




INDEX NO. 410

SHEET NO. 5 of 27

# Index 410 Con't – Single Sign Support

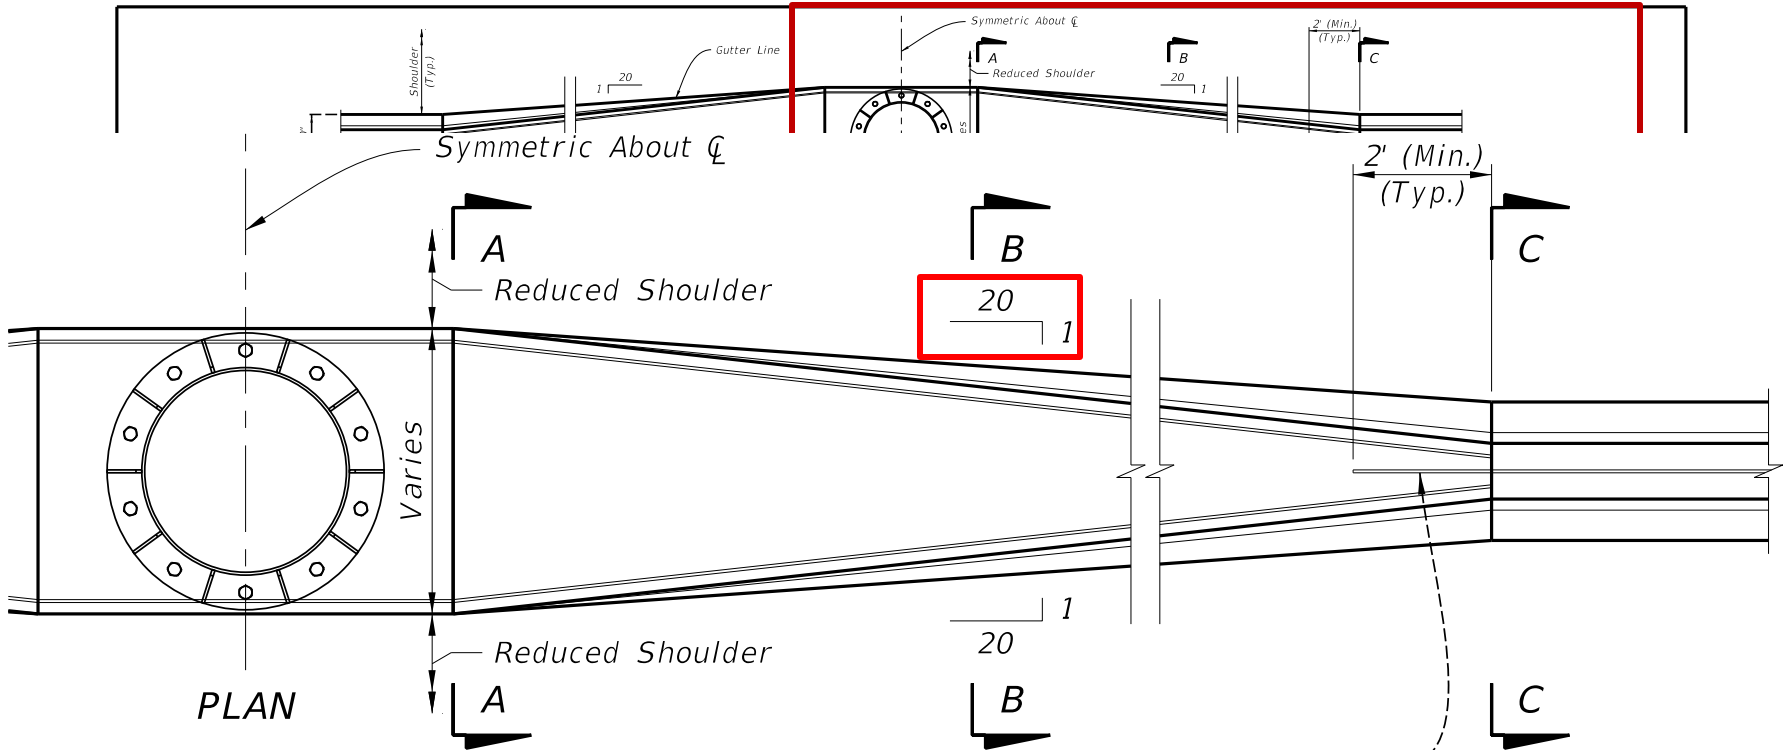

Extend Index 410  
Reinforcing (Typ.)

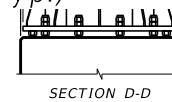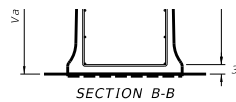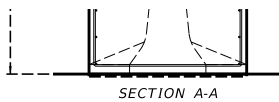


LARGE SIGN MEDIAN BARRIER MOUNTED SIGN SUPPORT TRANSITION (OPTION 2)

5/20/2013 8/17/2013 AM 10/16/2013	LAST REVISION 07/01/13	DESCRIPTION: FDOT 2014 DESIGN STANDARDS	CONCRETE BARRIER WALL	INDEX NO. 410	SHEET NO. 6 of 27
---	---------------------------	---	-----------------------	------------------	----------------------




# Index 410 Cont. – Single Sign Support

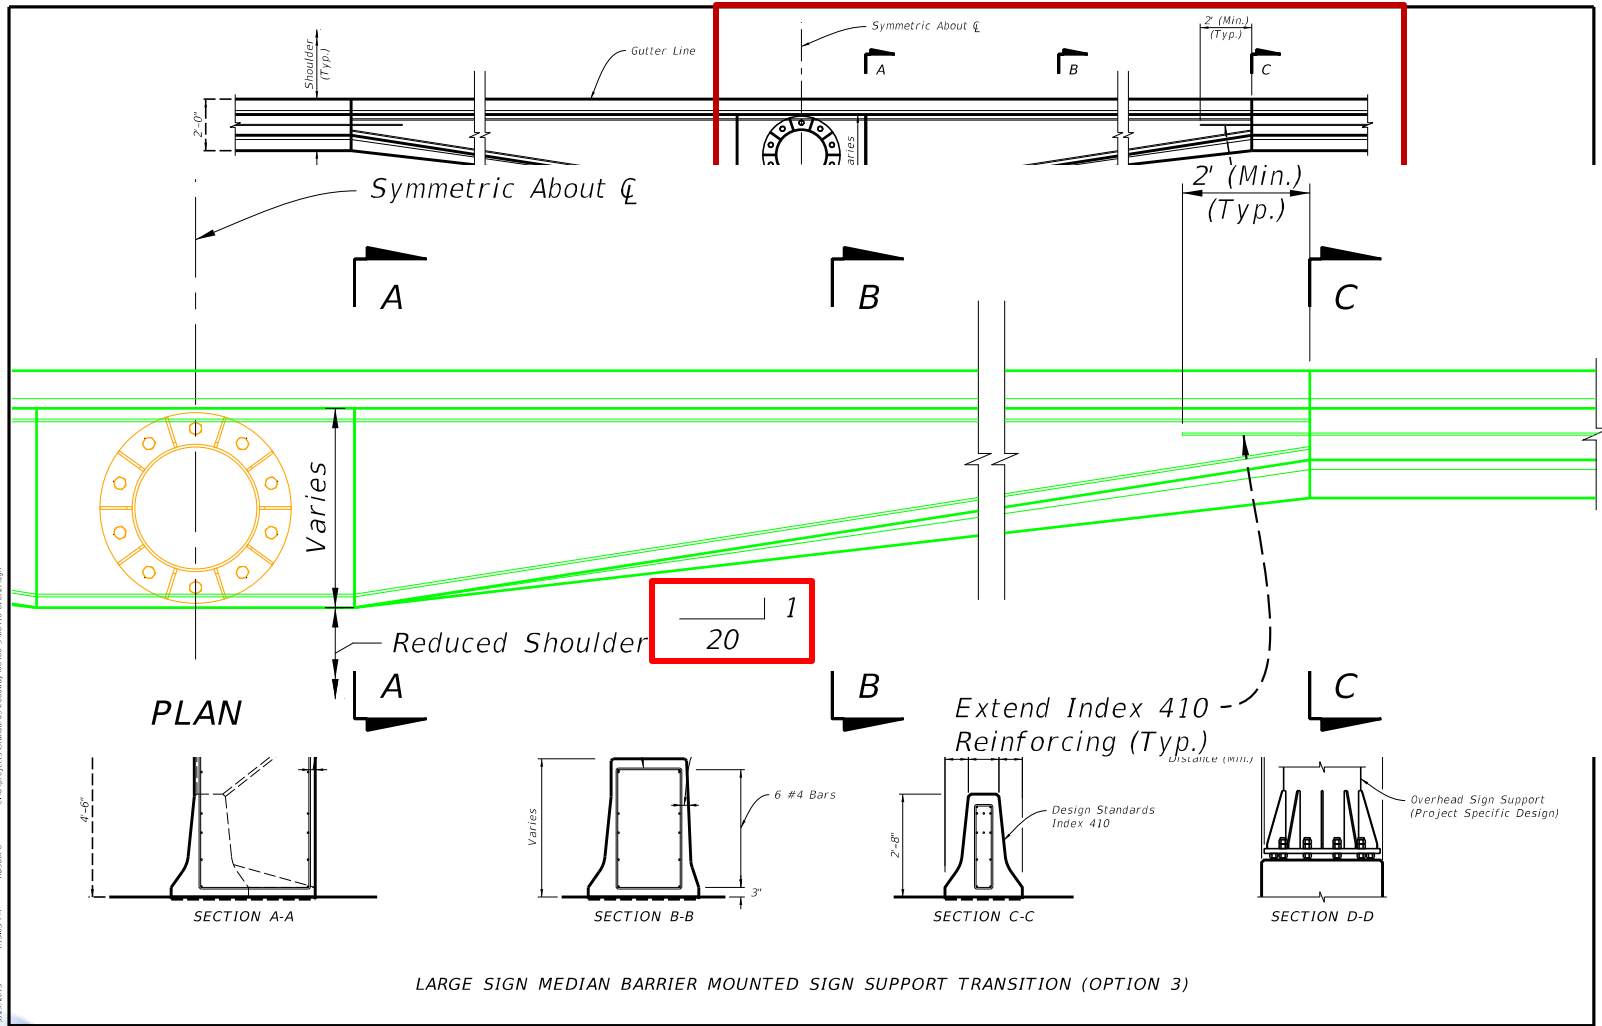


8/29/2013 4:53:53 PM C:\Users\jcs\Documents\AutoCAD\Drawings\Index 410\Index 410.dwg

LAST REVISION 07/01/13	DESCRIPTION: FDOT 2014 DESIGN STANDARDS	CONCRETE BARRIER WALL	INDEX NO. 410	SHEET NO. 7 of 27
---------------------------	--	-----------------------	------------------	----------------------

# Index 700

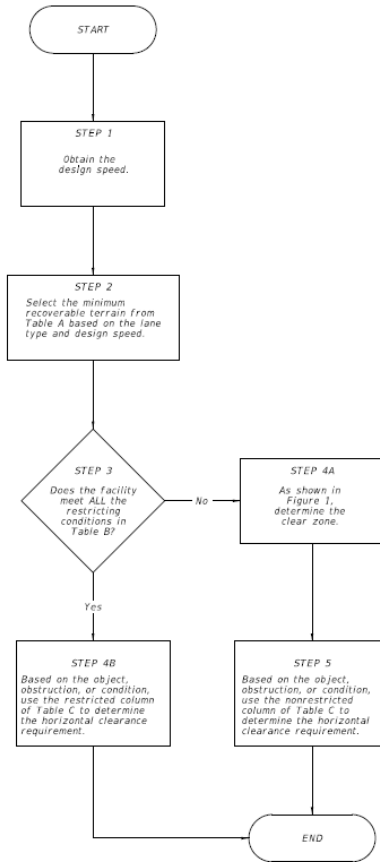

PROCESS FOR DETERMINING HORIZONTAL CLEARANCE

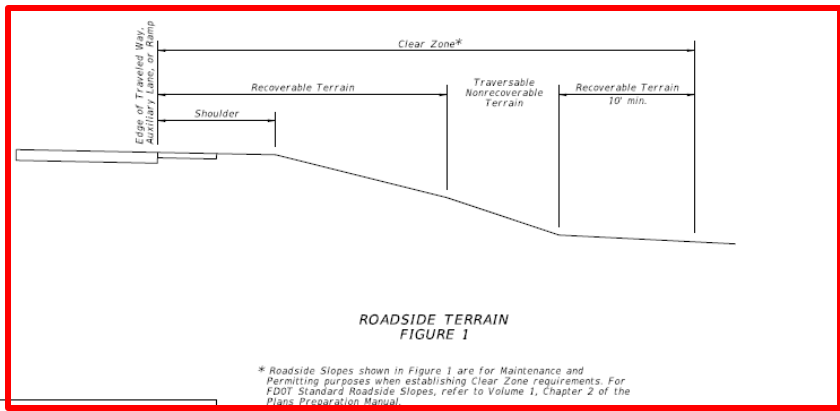

ROADSIDE TERRAIN  
FIGURE 1

\* Roadside Slopes shown in Figure 1 are for Maintenance and Permitting purposes when establishing Clear Zone requirements. For FDOT Standard Roadside Slopes, refer to Volume 1, Chapter 2 of the Plans Preparation Manual.

TABLE A  
MINIMUM RECOVERABLE TERRAIN (ft)

Design Speed (mph)	Travel Lanes & Multilane Ramps	Auxiliary Lanes & Single Lane Ramps
<45	18	10
45	24	14
50	24	14
55	30	18
>55	36	24

TABLE B  
RESTRICTING CONDITIONS

1. The facility is an urban facility.
2. The facility's design speed is 45 mph or less.
3. The facility is predominantly a curbed facility.
4. The distance from the traveled way to the R/W line is less than the value obtained in STEP 2.

### DEFINITIONS

**Roadside Terrain** includes all surfaces along the roadway adjacent to the traveled way. For the purpose of establishing clear zones and horizontal clearance requirements, roadside terrain is defined as recoverable, traversable, traversable nonrecoverable, nontraversable, and hazardous as follows:

**Clear Zone** is the relatively flat unobstructed area that is to be provided for safe use by errant vehicles, and must be wide enough so that the sum of all the recoverable terrain within is equal to or greater than the value obtained in STEP 2. Recoverable terrain provided beyond nonrecoverable terrain must be a minimum of 10 feet. Areas beyond nontraversable and hazardous terrain cannot be used as recoverable or traversable nonrecoverable terrain.

**Horizontal Clearance Requirements** are shown in Table C and are the required offsets to an object from a specified point on the roadway.

**Recoverable** when it is safely traversable and on a slope that is 1v:4h or flatter.

**Traversable** when the slope is 1v:3h or flatter.

**Traversable Nonrecoverable** when it is safely traversable and on a slope that is steeper than 1v:4h but not steeper than 1v:3h.

**Nontraversable** when it is not safely traversable or on a slope that is steeper than 1v:3h.

**Hazardous** when a slope is steeper than 1v:3h and deeper than 6 feet as shown in Figure 2.

LAST REVISION 07/01/13

DESCRIPTION:



FDOT 2014  
DESIGN STANDARDS

ROADSIDE OFFSETS

INDEX NO.  
700

SHEET NO.  
1 of 2



# Index 700 Cont.

*Traversable Nonrecoverable* when it is safely traversable and on a slope that is steeper than 1v:4h but not steeper than 1v:3h.

\* Roadside Slopes shown in Figure 1 are for Maintenance and Permitting purposes when establishing Clear Zone requirements. For FDOT Standard Roadside Slopes, refer to Volume 1, Chapter 2 of the Plans Preparation Manual.






# Index 700 Cont.

CATEGORY	Item No.	OBJECTS, OBSTRUCTIONS OR CONDITIONS	TABLE C			
			HORIZONTAL CLEARANCE REQUIREMENTS			
			Restricted (See Table B)	Nonrestricted		
GENERAL	1	Above ground fixed hazards: All roadside objects, obstructions or conditions other than those listed below that exceed 4 inches in height and pose a hazard to errant vehicles and vehicle occupants.	Locate as close to the Right of Way as practical and not less than 4 feet from face of curb.	Locate outside the clear zone as close to the Right of Way as practical.		
	2	Drop-off hazards: Any point along a roadside slope steeper than 1v:3h that is deeper than 6 feet below the hinge point. See Figure 2.	Locate the point that is 6 feet below the hinge point no less than 22 feet from the edge of traveled way.	Treat as roadside slopes in accordance with Design Standard, Index 400.		
ROADWAY	3	All FDOT approved guardrails, guardrail end terminals, crash cushions, and concrete barriers (temporary or permanent).	Locate as shown in the Design Standards.			
	4		Design Standard, Index 532			
	5	Mailboxes	Not Shown in Design Standards, Index 532	Not to be used.		
	6	Trees	Expected to become greater than 4 inches in diameter (measured 6 inches above the ground).	Outside roadways: Locate no less than 4 feet from face of curb in accordance with Design Standard, Index 546. Inside medians: Locate no less than 6 feet from the edge of traffic lane and in accordance with Design Standard, Index 546.	Locate outside the clear zone as close to the Right of Way as practical and in accordance with Design Standard, Index 546.	
	7		Not expected to become greater than 4 inches in diameter (measured 6 inches above the ground).	Locate in accordance with Design Standard, Index 546.		
	8		Behind guardrail.	Locate no less than 5 feet from the back of the guardrail post.		
	9	Canals	Unshielded	Locate as close to the Right of Way as practical and not less than 40 feet from the edge of traveled way.	Design speeds of 50 mph and greater: Locate as close to the Right of Way as practical and not less than 60 feet from the edge of traveled way. Design speeds less than 50 mph: Locate as close to the Right of Way as practical and not less than 50 feet from the edge of traveled way.	
	DRAINAGE	10	Culvert wing walls, endwalls, retaining walls and flared end sections	less than or equal 6 feet deep.	Locate no less than 4 feet from face of curb.	Locate outside the clear zone.
		11		greater than 6 feet deep.	Treat as drop-off hazard; See Item No. 2.	
12			Mitered end sections.	Locate as shown in Design Standard, Index 273 and Index 273.		
TRAFFIC CONTROL DEVICES	13	Fragible or breakaway sign supports.	Locate in accordance with Design Standard, Index 17302.			
	14	Overhead sign supports and other nonfragible signs.	Locate no less than 4 feet from face of curb.	Locate outside the clear zone.		
LIGHTING	15	Traffic inductive detectors, signal controller cabinets, signal poles, strain poles and mast arms.	Locate no less than 4 feet from face of curb and not in medians.	Locate outside the clear zone and not in medians.		
	16	Conventional lighting (fragible and nonfragible).	Locate no less than 4 feet from face of curb and only on barrier walls in medians.	Locate 20 feet from travel lanes or 14 feet from auxiliary lanes. Not in medians. May be clear zone width when the clear zone is less than 20 feet.		
	17	Highmast lighting	Not applicable	Locate outside the clear zone.		
STRUCTURES	18	Bridge piers and abutments: Above ground vertical structures.	Locate not less than 16 feet from edge of traveled way.	Locate outside the clear zone.		
UTILITIES	19	Fire hydrants with bases no higher than 4 inches above ground.	Locate not less than 2 feet from face of curb.	Locate as close to the Right of Way as practical.		
	20	Aboveground fixed UTILITIES (AFUs).	New AFUs placed no closer than 4 feet from the face of curb and as close to the RAW as practical.	New AFUs are to be outside the Clear Zones established using Table A Recoverable Terrain and as close to the R/W line as practical.		
RAILROADS	21	Railroad crossing traffic control devices.	Locate in accordance with Design Standard, Index 17862.			


## GENERAL NOTES


- When shielding an object and sidewalks are present, an unobstructed sidewalk width of at least 4 feet must be provided.
- When site specific conditions prohibit meeting the horizontal clearance requirements in TABLE C, the object, obstruction or condition must be crashworthy or mitigated, possible by shielding. Otherwise, the Plans Preparation Manual, Volume 1, Chapters 2, 4, 21, 23 and 25.

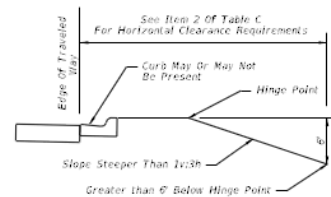

DROP-OFF HAZARDS

FIGURE 2

LAST REVISION 07/01/13	DESCRIPTION:		FDOT 2014 DESIGN STANDARDS	ROADSIDE OFFSETS	INDEX NO. 700	SHEET NO. 2 of 2
---------------------------	--------------	---	-------------------------------	------------------	------------------	---------------------

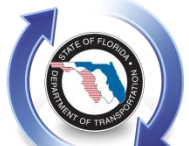

# Index 700 Cont. – Table C

		TABLE C			
CATEGORY	Item No.	OBJECTS, OBSTRUCTIONS OR CONDITIONS	HORIZONTAL CLEARANCE REQUIREMENTS		
			Restricted (See Table B)	Nonrestricted	
ROADWAY	3	All FDOT approved guardrails, guardrail end terminals, crash cushions, and concrete barriers (temporary or permanent).	Locate as shown in the Design Standards.		
	4	Mailboxes	Design Standard, Index 532	Locate in accordance with Design Standard, Index 532.	
	5		Not Shown in Design Standard, Index 532	Not to be used.	
	6	Trees	Expected to become greater than 4 inches in diameter (measured 6 inches above the ground).	Outside roadways: Locate no less than 4 feet from face of curb in accordance with Design Standard, Index 546. Inside medians: Locate no less than 6 feet from the edge of traffic lane and in accordance with Design Standard, Index 546.	Locate outside the clear zone as close to the Right Of Way as practical and in accordance with Design Standard, Index 546.
	7		Not expected to become greater than 4 inches in diameter (measured 6 inches above the ground).	Locate in accordance with Design Standard, Index 546.	
	8	Canals	Behind guardrail.	Locate no less than 5 feet from the back of the guardrail post.	
	9		Unshielded	Locate as close to the Right Of Way as practical and not less than 40 feet from the edge of traveled way.	Design Speeds of 50 mph and greater: Locate as close to the Right Of Way as practical and not less than 60 feet from the edge of traveled way. Design speeds less than 50mph: Locate as close to the Right Of Way as practical and not less than 50 feet from the edge of traveled way.

TRAFFIC CONTROL DEVICES	12	Mitered end sections.	Locate as shown in Design Standard, Index 1733 and Index 1735.	
	13	Frangible or breakaway sign supports.	Locate in accordance with Design Standard, Index 17302.	
	14	Overhead sign supports and other nonfrangible signs.	Locate no less than 4 feet from face of curb.	Locate outside the clear zone
LIGHTING	15	Traffic infraction detectors, signal controller cabinets, signal poles, strain poles and mast arms	Locate no less than 4 feet from face of curb and not in medians.	Locate outside the clear zone and not in medians.
	16	Conventional lighting (frangible and nonfrangible).	Locate no less than 4 feet from face of curb and only on barrier walls in medians.	Locate 20 feet from travel lanes or 14 feet from auxiliary lanes. Not in medians. May be clear zone width when the clear zone is less than 20 feet.
	17	Highmast lighting	Not applicable	Locate outside the clear zone.
STRUCTURES	18	Bridge piers and abutments: Above ground vertical structures.	Locate not less than 16 feet from edge of traveled way.	Locate outside the clear zone.
UTILITIES	19	Fire hydrants with bases no higher than 4 inches above ground.	Locate not less than 2 feet from face of curb.	Locate as close to the Right Of Way as practical.
	20	Aboveground fixed Utilities (AFUs).	New AFUs placed no closer than 4 feet from the face of curb and as close to the R/W as practical.	New AFUs are to be outside the Clear Zones established using Table A Recoverable Terrain and as close to the R/W line as practical.
RAILROADS	21	Railroad crossing traffic control devices.	Locate in accordance with Design Standard, Index 17882.	



# *Questions or Comments*



# *The End*

Patrick Overton, P.E

Design Standards Engineer

(850) 414-4348

[Patrick.overton@dot.state.fl.us](mailto:Patrick.overton@dot.state.fl.us)



# *Design Standards Update 2014 eBooklet*

# *THE END*

Please visit us at:

<http://www.dot.state.fl.us/rddesign/cs/cs.shtm>

or

contact me

Darren Martin

Design Standards Specialist

(850) 414 - 4824

[Darren.Martin@dot.state.fl.us](mailto:Darren.Martin@dot.state.fl.us)

