


MOT Standards

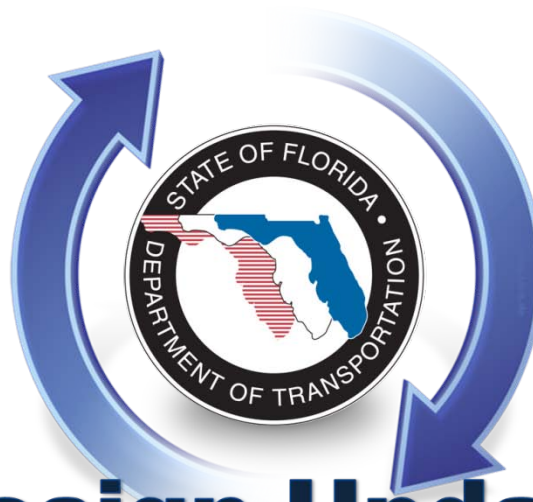


Design Update Training

Ezzeldin Benghuzzi

ezzeldin.benghuzzi@dot.state.fl.us

(850) 414-4352

Design Index 414

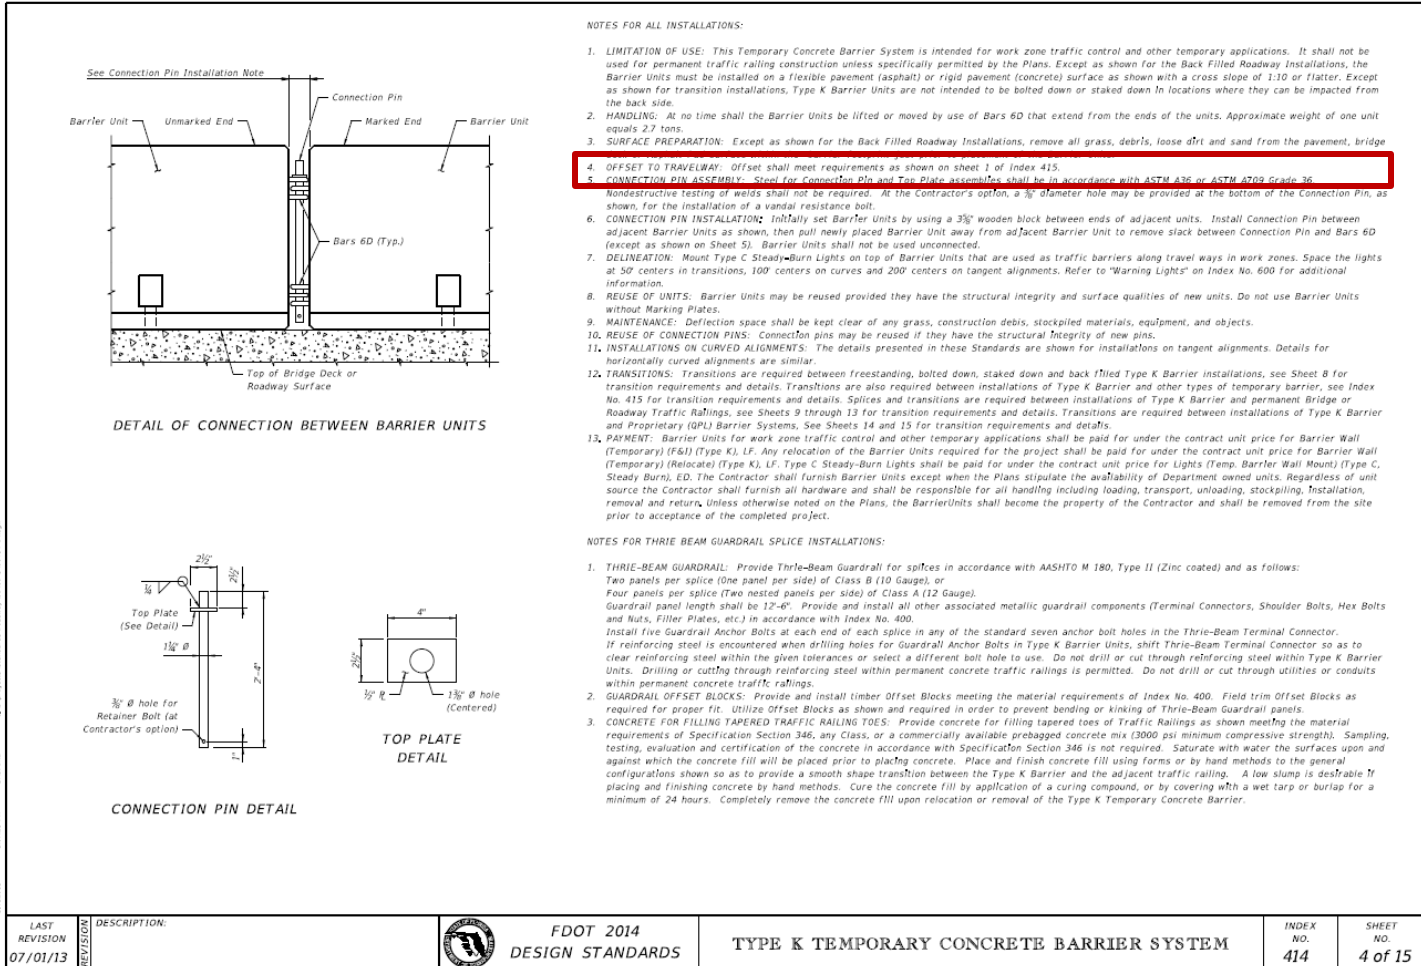


Design Index 414

4. *OFFSET TO TRAVELWAY: Offset shall meet requirements as shown on sheet 1 of Index 415.*



Design Index 415

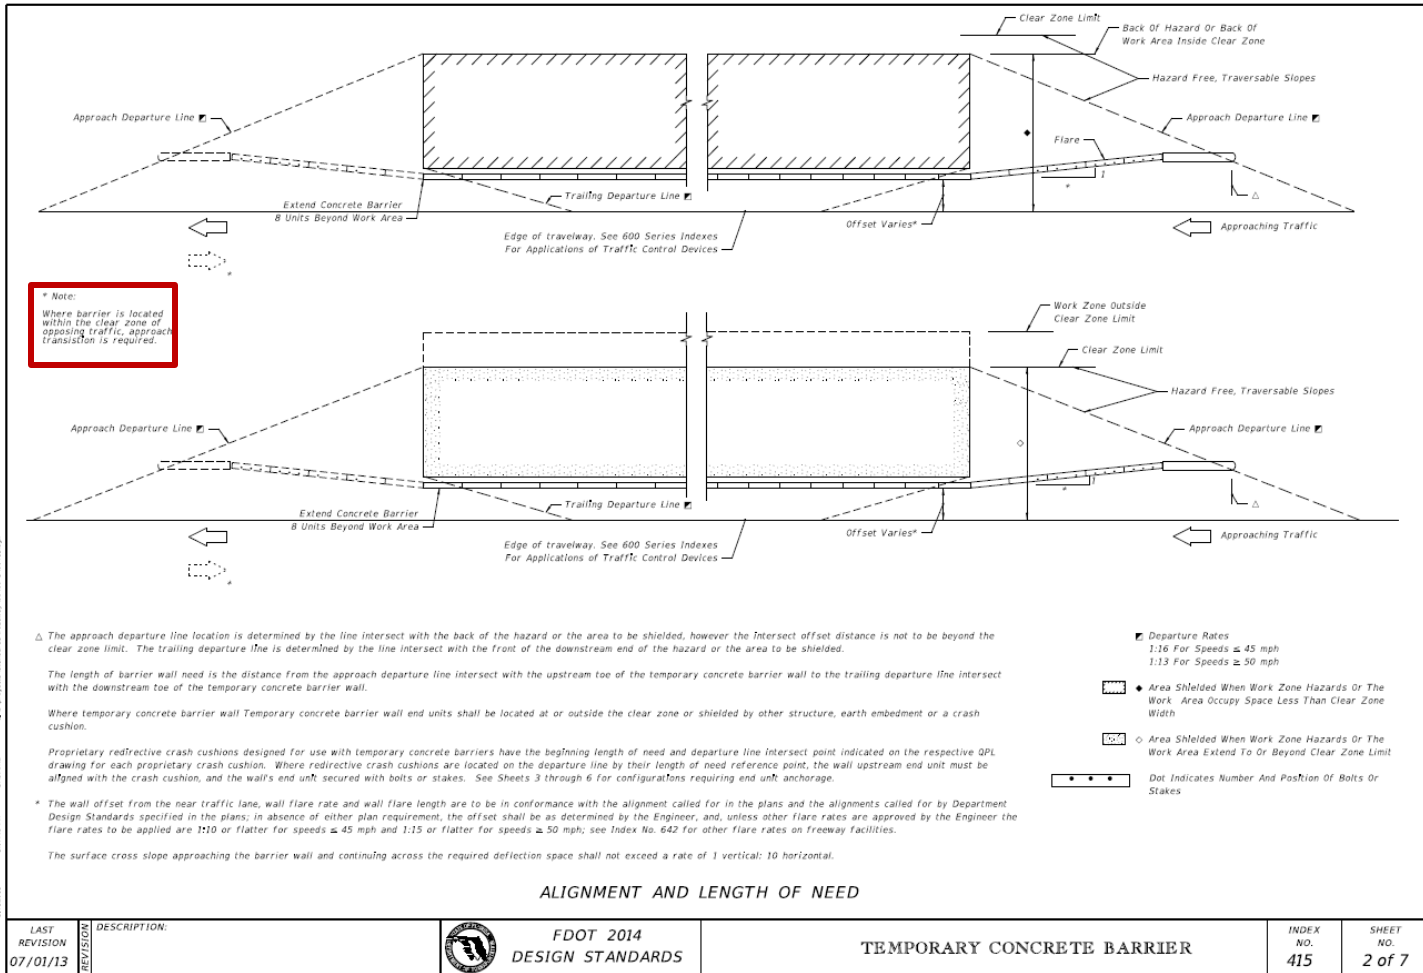


Design Index 415

Note:
Where barrier is located within the clear zone of opposing traffic, approach transition is required.

CLEAR ZONE WIDTHS FOR WORK ZONES

The term 'clear zone' describes the unobstructed relatively flat area, impacted by construction, extending outward from the edge of the traffic lane. The table below gives clear zone widths in work zones for medians and roadside conditions other than for roadside canals; where roadside canals are present, clear zone widths are to conform with the distances to canals as described in Volume 1, Chapter 4, Section 4.2 and Exhibit 4-A and 4-B of the Plans Preparation Manual.

WORK ZONE SPEED (MPH)	TRAVEL LANES & MULTILANE RAMPS (feet)	AUXILIARY LANES & SINGLE LANE RAMPS (feet)
60-70	30	18
55	24	14
45-50	18	10
30-40	14	10
ALL SPEEDS CURB & GUTTER	4' BEHIND FACE OF CURB	4' BEHIND FACE OF CURB

Work Zone Speed (mph)	X (Length Of Advancement) Ft.
≤45	16 (D-d)
≥50	13 (D-d)

Equation Variables:
L = Length of Need = The distance a longitudinal barrier must be extended in advance of an area of concern in order to adequately shield the hazard.
X = Length of advancement = The distance a longitudinal barrier must be extended in advance of an area of concern in order to adequately shield the hazard
D(RA), D(LA) = Distance in feet from the near edge of the travel way to the back of the hazard or the clear zone limit, whichever is less
d(RA), d(LA) = Distance in feet from the near edge of the travel way to the face of the Barrier
Departure line = A line extending from the Point of Departure to the back of a hazard or clear zone. The point at which a barrier intersects the departure line establishes the beginning of both the Length of Need and the Length of Advancement.

LEGEND

- LA : Left Approach
- RA : Right Approach
- Departure Rates: 1:16 For Speeds ≤ 45 mph, 1:13 For Speeds ≥ 50 mph
- Area Shielded When Work Zone Hazards Or The Work Area Occupy Space Less Than Clear Zone Width
- Area Shielded When Work Zone Hazards Or The Work Area Extend To Or Beyond Clear Zone Limit
- Dot Indicates Number And Position Of Bolts Or Stakes

STRAIGHT ALIGNMENT AND LENGTH OF NEED

LAST REVISION 07/01/13	DESCRIPTION:	FDOT 2014 DESIGN STANDARDS	TEMPORARY CONCRETE BARRIER	INDEX NO. 415	SHEET NO. 3 of 7
---------------------------	--------------	-------------------------------	----------------------------	------------------	---------------------




Design Index 415

** Note:*


Where barrier is located within the clear zone of opposing traffic, approach transistion is required.




Design Index 600

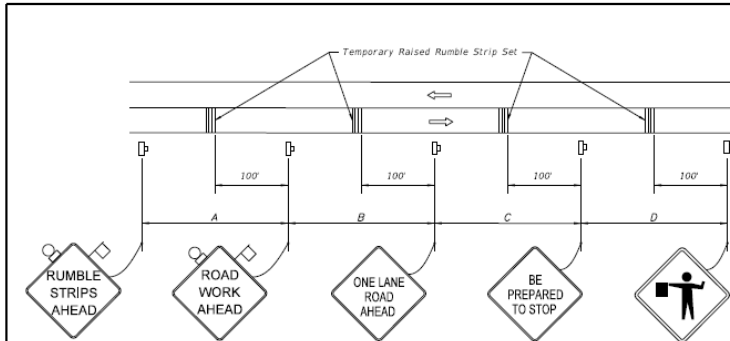


TYPICAL PLACEMENT OF TEMPORARY RAISED RUMBLE STRIPS

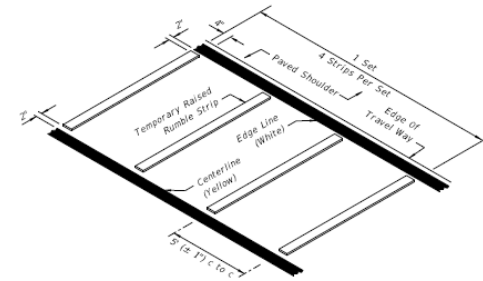

REMOVABLE POLYMER RUMBLE STRIP SET
(PAVED SHOULDER SHOWN)

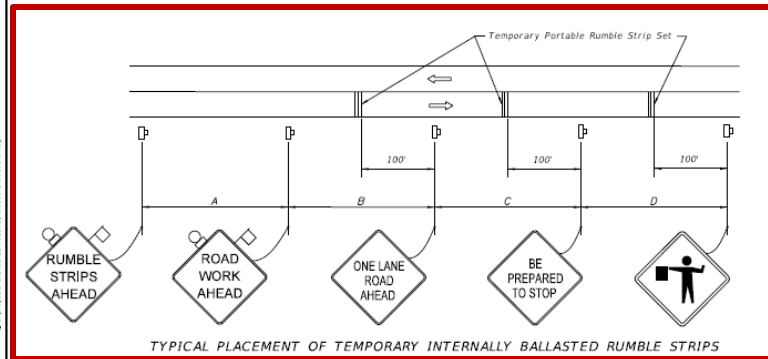

TYPICAL PLACEMENT OF TEMPORARY INTERNALLY BALLASTED RUMBLE STRIPS

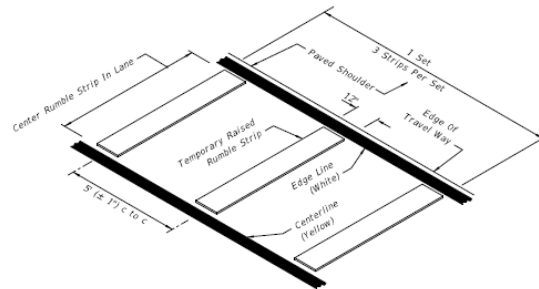

MOLDED ENGINEERED POLYMER RUMBLE STRIP SET
(PAVED SHOULDER SHOWN)

GENERAL NOTES

1. Temporary rumble strips sets shall be placed in advance of each flagging station when called for in the plans.
2. Temporary rumble strip sets are used to supplement a series of advanced warning signs and shall be installed and removed when the signs are installed and removed.
3. Remove the temporary rumble strips prior to removing the advance warning signs.

DISTANCE BETWEEN SIGNS

Speed (mph)	Spacing (ft.)			
	A	B	C	D
40 or less	200	200	200	100
45	350	350	350	175
50	500	500	500	250
55 or greater	500	1640	1000	500

LAST REVISION 07/01/13

DESCRIPTION:




FDOT 2014
DESIGN STANDARDS

GENERAL INFORMATION FOR TRAFFIC
CONTROL THROUGH WORK ZONES

INDEX NO.
600

SHEET NO.
4 of 13


Design Index 600

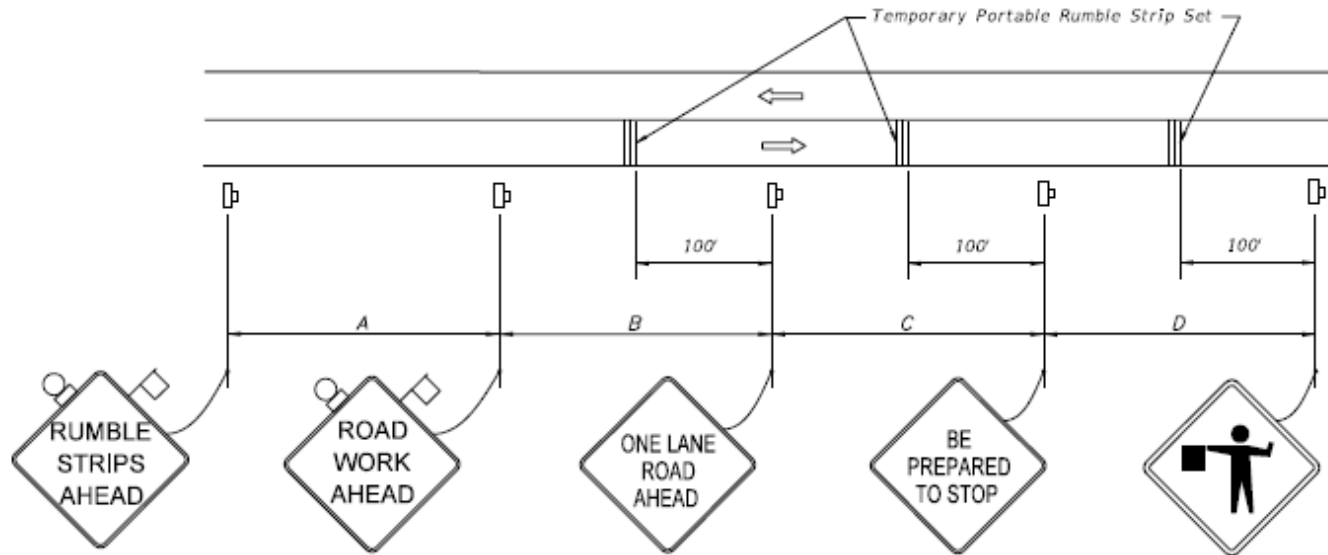

TYPICAL PLACEMENT OF TEMPORARY INTERNALLY BALLASTED RUMBLE STRIPS



Design Index 600

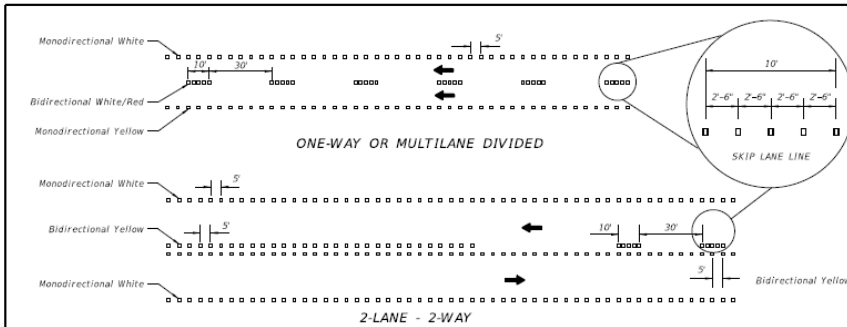

RPM CLASS	APPLICATION FOR REFLECTIVE PAVEMENT MARKERS
A	Work Zone Applications Only, For Traffic And Nontraffic Areas.
B	Permanent Application In Traffic And Nontraffic Areas Or Can Be Used In Work Zone Applications For Traffic And Nontraffic Areas.

TEMPORARY SUBSTITUTION OF RPM'S FOR PAINT OR REMOVABLE TAPE

1. Paint or removable tape are the required work zone markings and shall be placed in accordance with the plans and specifications. If these work zone markings can not be placed due to weather restrictions identified in the appropriate specification, temporary substitution of RPM's for work zone markings will be allowed until the weather condition permits the placement of appropriate work zone marking. Temporary substitution of RPM's for work zone markings will be allowed for equipment malfunction, placement of the appropriate work zone marking shall be made within 3 days, or sooner if possible. When RPM's are used as a temporary substitution for work zone markings the following shall apply:


a. Lane widths identified in the plans must be maintained. Placement of RPM's should consider where work zone markings will be placed as soon as conditions allow. If the RPM's can not be placed so that the lane width is maintained after the placement of the work zone markings, the conflicting RPM's must be removed.

b. The color of the RPM body and the reflective face shall conform to the color of the marking for which they substitute.

In work zones, CLASS A or B RPM's may be used to form lane lines, edge lines and temporary gore areas as a temporary substitute for paint or removable tape at the spacing shown above.


NOTES FOR REFLECTIVE PAVEMENT MARKERS

- The color of the raised pavement marker under both day and night conditions shall conform to the color of the marking for which they serve as a positioning guide, or for which they supplement or substitute.
- To provide contrast on concrete pavement, or light asphalt, the five (5) white RPM's shall be followed by five black RPM's. The spacing between RPM's shall be 2'-6". Black RPM's will not be required for contrast with yellow RPM's.
- RPM's used to supplement lane lines are to be paid for as Reflective Pavement Marker (Temporary), EA. RPM's used as a temporary substitute for paint or removable tape due to weather restrictions are to be paid for as Reflective Pavement Marker (Temporary), EA. RPM's used as a temporary substitute for paint or removable tape due to equipment malfunction are to be placed at the Contractor's expense.

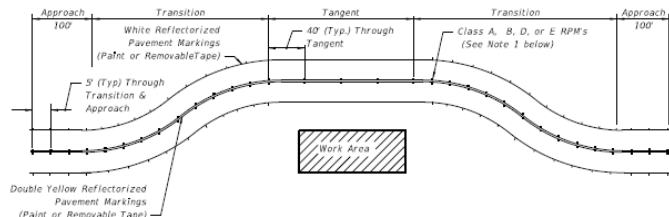


USE OF RPM'S TO SUPPLEMENT PAINT OR REMOVABLE TAPE IN WORK ZONES

- RPM's shall be installed as a supplement to:
 - All lane lines.
 - Edge lines in transition & approach areas.
 - Edge lines of gore areas.
- Placement of RPM's should be as shown in Index No. 17352 with the following exceptions:
 - RPM's shall be placed at 5 feet center to center in approach and transition areas.

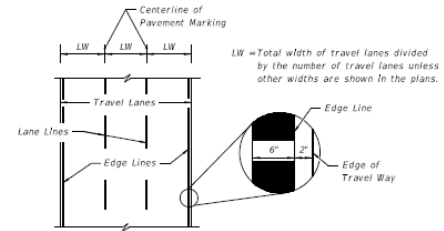

PLACEMENT OF PAVEMENT MARKINGS

PAVEMENT MARKINGS

LAST REVISION 07/01/13	DESCRIPTION:	 FDOT 2014 DESIGN STANDARDS	GENERAL INFORMATION FOR TRAFFIC CONTROL THROUGH WORK ZONES	INDEX NO. 600	SHEET NO. 13 of 13
---------------------------	--------------	---	---	------------------	-----------------------




Design Index 600

RPM
CLASS *APPLICATION FOR REFLECTIVE PAVEMENT MARKERS*


A *Work Zone Applications Only, For Traffic And Nontraffic Areas.*

B *Permanent Application In Traffic And Nontraffic Areas Or Can Be Used In Work Zone Applications For Traffic And Nontraffic Areas.*

- c. In work zones, Class A or B RPM's may be used to form lane lines, edge lines and temporary gore areas as a temporary substitute for paint or removable tape at the spacing shown above.



Design Index 625

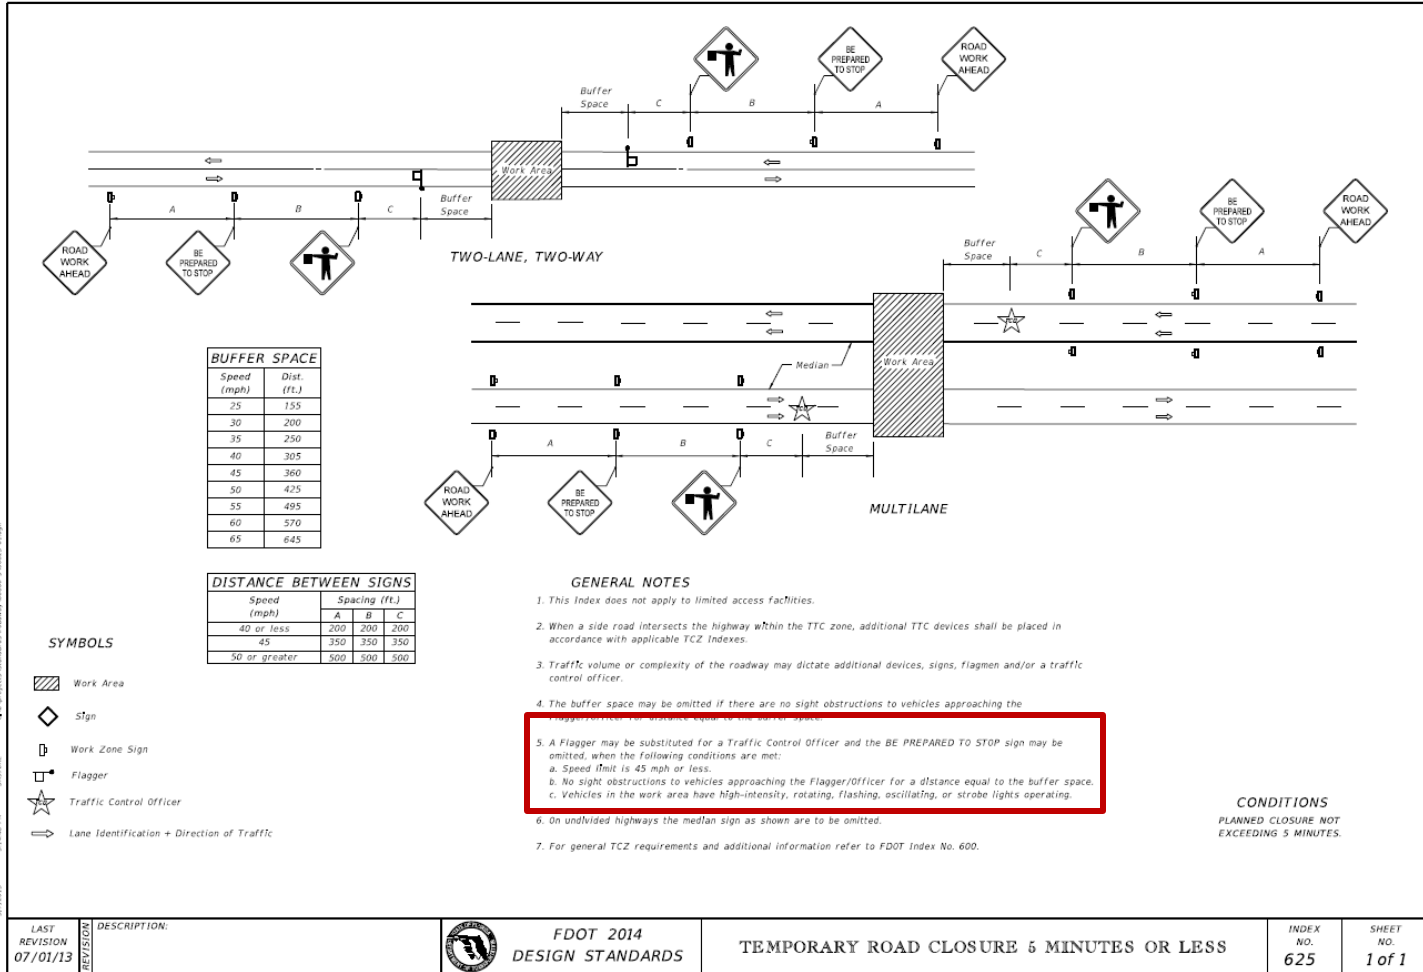

Design Index 625

5. *A Flagger may be substituted for a Traffic Control Officer and the BE PREPARED TO STOP sign may be omitted, when the following conditions are met:*
- a. Speed limit is 45 mph or less.*
 - b. No sight obstructions to vehicles approaching the Flagger/Officer for a distance equal to the buffer space.*
 - c. Vehicles in the work area have high-intensity, rotating, flashing, oscillating, or strobe lights operating.*



Design Index 660

CORNER SIDEWALK CLOSURE WITH TEMPORARY CROSSWALKS

MID-BLOCK SIDEWALK CLOSURE

MID-BLOCK SIDEWALK CLOSURE WITH TEMPORARY WALKWAY

GENERAL NOTES

- Only the signs controlling pedestrian flows are shown. Other work zone signs will be needed to control traffic on the streets.
- For spacing of traffic control devices and general TCZ requirements refer to Index No. 600. Maximum spacing between barricades, vertical panels, drums or tubular markers shall not be greater than 25'.
- Street lighting should be considered.
- For nighttime closures use Type A flashing warning lights on barricades supporting signs and closing sidewalks. Use Type C steady-burn lights on channelizing devices separating the work area from vehicular traffic.
- Pedestrian traffic signal display controlling closed crosswalks shall be covered or deactivated.
- Post Mounted Signs located near or adjacent to a sidewalk shall have a 2" minimum clearance from the bottom of sign to the sidewalk.
- When construction activities involve sidewalks on both sides of the street, efforts should be made to stage the construction so that both sidewalks are not out of service at the same time.
- In the event that sidewalks on both sides of the street are closed, pedestrians shall be gulfed around the construction zone.
- Temporary walkways shall be a minimum of 4' wide with a maximum 0.02 cross slope and a maximum 0.05 running slope between ramps. Temporary walkways less than 5' in width shall provide for a 5' x 5' passing space at intervals not to exceed 200'. Temporary ramps shall meet the requirements for curb ramps specified in Index No. 304. Temporary walkway surfaces and ramps shall be stable, firm, slip resistant, and kept free of any obstructions and hazards such as holes, debris, mud, construction equipment, stored materials, etc.
- Temporary ramps and temporary crosswalk markings shall be removed with reopening of the sidewalk, unless otherwise noted in the plans. All work and materials associated with constructing temporary curb ramps and temporary crosswalk markings, removal and disposal of temporary curb ramps and temporary crosswalk markings, and restoration to original condition shall be paid for as Maintenance of Traffic, Lump Sum.
- A pedestrian longitudinal channelizing device shall be placed across the full width of the closed sidewalk.

CONDITIONS

WHERE ANY VEHICLE, EQUIPMENT WORKERS OR THEIR ACTIVITIES ENCRACH ON THE SIDEWALK FOR A PERIOD OF MORE THAN 60 MINUTES.

SYMBOLS

- Work Area
- Channelizing Device (See Index No. 600)
- Work Zone Sign
- Required Locations For Either Temporary Or Permanent Curb Ramps.
- Lane Identification + Direction of Traffic
- Pedestrian Longitudinal Channelizing Device

LAST REVISION 07/01/13	REVISION	DESCRIPTION:	FDOT 2014 DESIGN STANDARDS	PEDESTRIAN CONTROL FOR CLOSURE OF SIDEWALKS	INDEX NO. 660	SHEET NO. 1 of 1
---------------------------	----------	--------------	-------------------------------	---	------------------	---------------------

Design Index 660

- 11. A pedestrian longitudinal channelizing device shall be placed across the full width of the closed sidewalk.*



Questions

