



GENERAL NOTES

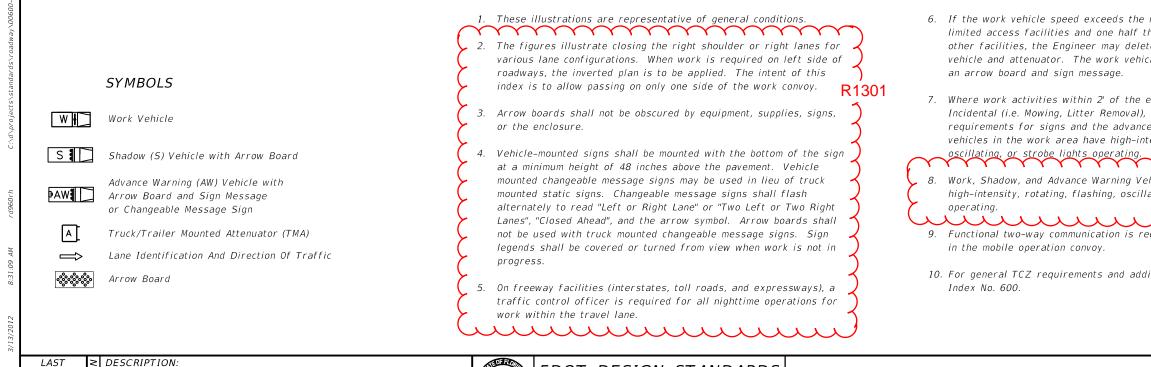

REVISION R1301--Added new Note 2, Notes 3, 4, 5 and 8 revised. Revised detail for Work on Shoulder and detail for Work Within Travel Lane. 07/01/12



FDOT DESIGN STANDARDS FY 2012/2013

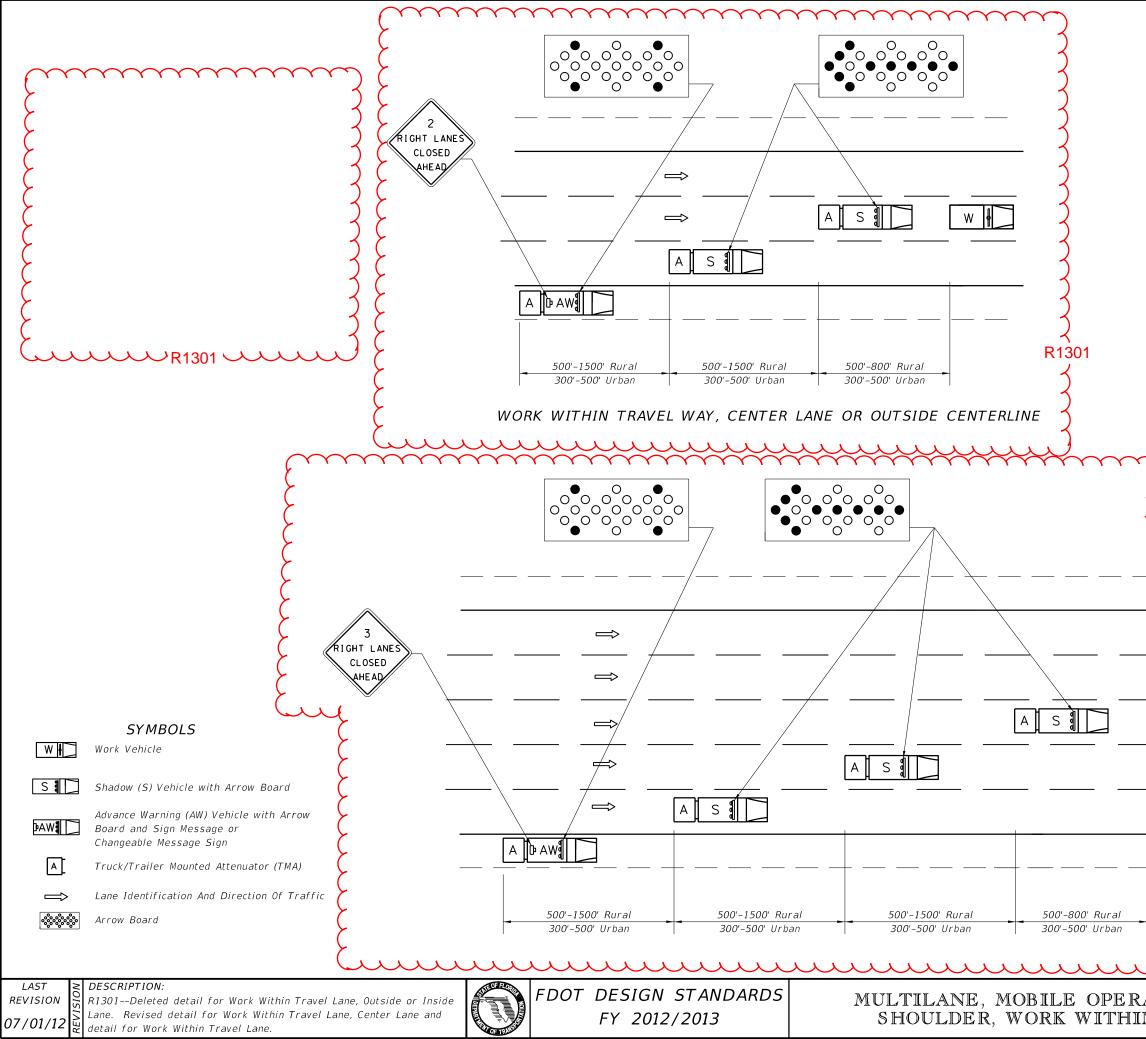

ARROW BOARD MODE MOVE/MERGE Where adequate shoulder width is not availa the advance warning vehicle may drive in th		
R1301 WORK WITHIN TRA	WEL LA	NE
ATIONS WORK ON N TRAVEL WAY	index no. 619	sheet NO. 2