



Florida Department of Transportation

RON DESANTIS
GOVERNOR

1074 Hwy 90
Chipley, Florida 32428

KEVIN J. THIBAUT, P.E.
SECRETARY

April 9, 2019

ADDENDUM NO. 2

To: ALL PROPOSAL HOLDERS
FINANCIAL ITEM NUMBER: 43775215201
CONTRACT NUMBER: E3S03
DESCRIPTION: The improvements under this District Contract consist of milling and resurfacing of SR 79 from CR 177 to the Alabama State line in Holmes County.

BIDS TO BE RECEIVED: April 16, 2019

If you are a PROPOSAL HOLDER, this is your authorization to make the following changes to the plans and specification packages you now have for the subject project:

- **Pay Item No. 0458-2 Sheet 3 has been revised. The previous quantity was 10.8 the revised quantity is 100.8**

Please use this revision when preparing your bid.

Sealed bids will be received until 2:00 p.m. local time on April 16, 2019 in the District Three Procurement Services Conference Room, Room 230, Administration Building, 1074 Highway 90, Chipley, Florida.

AMENDMENT NOTIFICATION

If you are a PROPOSAL HOLDER, please go to the CPP Online Ordering System at <https://fdotwp1.dot.state.fl.us/contractproposalprocessingonlineordering/> to download Amendment No. 2, file E3S03.002.

Also all PROPOSAL HOLDERS please acknowledge receipt of the addendum under the Acknowledgement of Amendments tab on your electronic bid.

If you have any further questions please contact Roland Ybarra by phone at (850) 330-1364 or by email at roland.ybarra@dot.state.fl.us

Sincerely,

Steve Thames
District Procurement Services Manager

ST:ry

c.c. Ed Hudec, Heath Riley, Renae Sanders, Jared Kirkland, Hal Gore, file

CONTRACT PLANS COMPONENTS

ROADWAY PLANS
SIGNING AND PAVEMENT MARKING PLANS

**STATE OF FLORIDA
DEPARTMENT OF TRANSPORTATION**

CONTRACT PLANS

**FINANCIAL PROJECT ID 437752-1-52-01
HOLMES COUNTY (52030)**

STATE ROAD NO. 79



SR 79 FROM NORTH OF CR 177 TO THE ALABAMA STATE LINE

INDEX OF ROADWAY PLANS

SHEET NO.	SHEET DESCRIPTION
1	KEYSHEET
2 - 2A	△ SIGNATURE SHEET
3	SUMMARY OF PAY ITEMS
4	TYPICAL SECTION
5 - 6	TYPICAL SECTION DETAILS
7	SUMMARY OF DRAINAGE STRUCTURES
8	OPTIONAL MATERIALS TABULATION
9 - 14	PROJECT LAYOUT
15 - 25	PROJECT CONTROL
26	GENERAL NOTES
27 - 57	PLAN SHEETS
58 - 59	DRAINAGE STRUCTURES
60	EXPANSION JOINT DETAILS
61 - 62	STORMWATER POLLUTION PREVENTION PLAN
63 - 65	TEMPORARY TRAFFIC CONTROL PLANS
66	SUMMARY OF VERIFIED UTILITIES
SQ-1 - SQ-10	SUMMARY OF QUANTITIES

LOCATION OF PROJECT

<https://goo.gl/maps/R7hSeRsNne92>

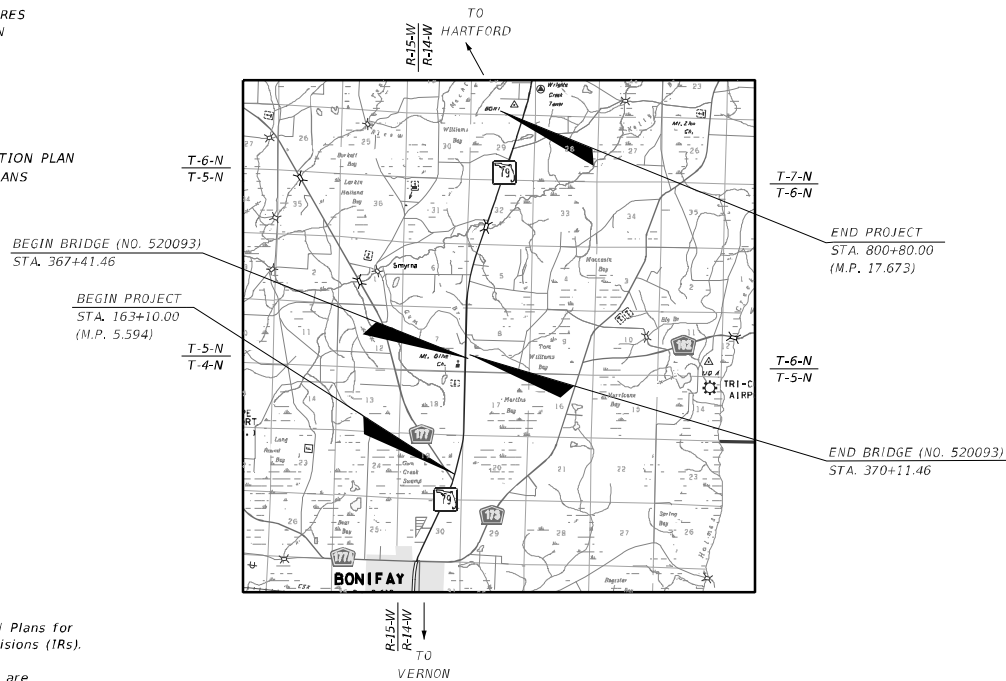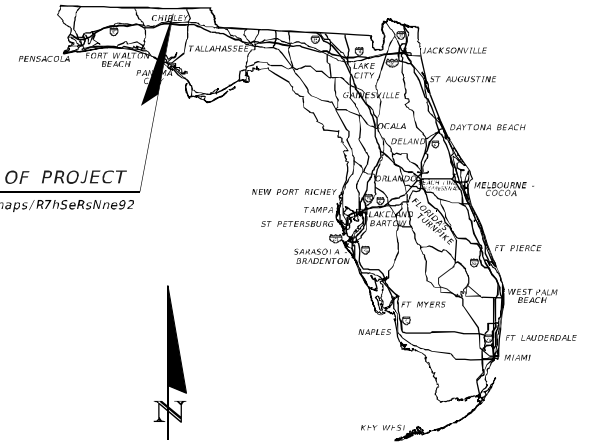

**ROADWAY PLANS
ENGINEER OF RECORD:**
ADAM J. SCURLOCK, P.E. NO.: 75445
FDOT ROADWAY DESIGN
1074 HWY 90
CHIPLEY, FLORIDA 32428
(850) 330-1612

FDOT PROJECT MANAGER:
ALICIA MCDANIEL
(850) 330-1378

PLANS PREPARED BY:
MEAGAN L. ROGERS
(850) 330-1714

GOVERNING STANDARD PLANS:

Florida Department of Transportation, FY2018-19 Standard Plans for Road and Bridge Construction and applicable Interim Revisions (IRs).

Standard Plans for Road Construction and associated IRs are available at the following website: <http://www.fdot.gov/design/standardplans>

REVISIONS:

FINANCIAL PROJECT ID 437752-1-52-01
△ Roadway Sheet 1, 2A, 3, SQ-8 (Revised 4/8/2019)


KEY SHEET REVISIONS	
DATE	DESCRIPTION
4/8/2019	ADDED SHEET 2A

GOVERNING STANDARD SPECIFICATIONS:

Florida Department of Transportation, January 2019 Standard Specifications for Road and Bridge Construction at the following website: <http://www.fdot.gov/programmanagement/Implemented/SpecBooks>

CONSTRUCTION CONTRACT NO.	FISCAL YEAR	SHEET NO.
E3S03	19	1

THE OFFICIAL RECORD OF THIS SHEET IS THE ELECTRONIC FILE DIGITALLY SIGNED AND SEALED UNDER RULE 61G15-23.004, F.A.C.

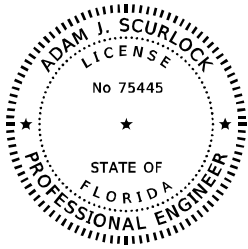

THIS ITEM HAS BEEN DIGITALLY
SIGNED AND SEALED BY:

Adam J Scurlock
2019.04.08 16:24:02 -06'00'

ON THE DATE ADJACENT TO THE SEAL


PRINTED COPIES OF THIS DOCUMENT ARE
NOT CONSIDERED SIGNED AND SEALED
AND THE SIGNATURE MUST BE VERIFIED
ON ANY ELECTRONIC COPIES.

FLORIDA DEPT. OF TRANSPORTATION
1074 HIGHWAY 90
CHIPLEY, FL 32428
ADAM J. SCURLOCK, P.E. NO. 75445

THE ABOVE NAMED PROFESSIONAL ENGINEER SHALL BE RESPONSIBLE FOR
THE FOLLOWING SHEETS IN ACCORDANCE WITH RULE 61G15-23.004, F.A.C.

SHEET NO. SHEET DESCRIPTION

1	KEYSHEET
2A	SIGNATURE SHEET
3	SUMMARY OF PAY ITEMS

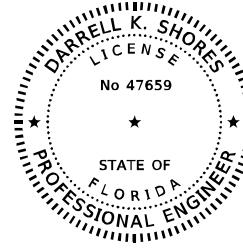

THIS ITEM HAS BEEN DIGITALLY
SIGNED AND SEALED BY:

Darrell K Shores Date:
2019.04.08
16:16:48 -05'00'

ON THE DATE ADJACENT TO THE SEAL

PRINTED COPIES OF THIS DOCUMENT ARE
NOT CONSIDERED SIGNED AND SEALED
AND THE SIGNATURE MUST BE VERIFIED
ON ANY ELECTRONIC COPIES.

FLORIDA DEPT. OF TRANSPORTATION
1074 HIGHWAY 90
CHIPLEY, FL 32428
DARRELL K. SHORES, P.E. NO. 47659

THE ABOVE NAMED PROFESSIONAL ENGINEER SHALL BE RESPONSIBLE FOR
THE FOLLOWING SHEETS IN ACCORDANCE WITH RULE 61G15-23.004, F.A.C.

SHEET NO. SHEET DESCRIPTION

2A	SIGNATURE SHEET
50-8	SUMMARY OF QUANTITIES

REVISIONS				ADAM J. SCURLOCK, P.E. P.E. LICENSE NUMBER 75445 ROADWAY DESIGN FDOT DISTRICT 3 1074 HWY 90 CHIPLEY, FLORIDA 32428	STATE OF FLORIDA DEPARTMENT OF TRANSPORTATION			<i>SIGNATURE SHEET</i>	SHEET NO.
DATE	DESCRIPTION	DATE	DESCRIPTION		ROAD NO.	COUNTY	FINANCIAL PROJECT ID		
04/08/19	JJS ADDED SHEET				SR 79	HOLMES	437752-1-52-01		

FLORIDA DEPARTMENT OF TRANSPORTATION PROPOSAL SUMMARY OF PAY ITEMS FOR PROPOSAL: E3503						
LEAD PROJECT : 437752-1-52-01		DISTRICT : 03		COUNTY/SECTION : 52030000		
PROJECT(S) : 43775215201		COUNTY : HOLMES				
0002 SUMMARY OF ROADWAY						
SPC	ALT	ITEM NUMBER	ITEM DESCRIPTION	UNIT	43775215201	QUANTITY TOTAL
		0101- 1-	MOBILIZATION 43775215201	LS	1.000	1.000
		0102- 1-	MAINTENANCE OF TRAFFIC 43775215201	(LS)	1.000	1.000
		0102- 3-	COMMERCIAL MATERIAL FOR TEMPORARY DRIVEWAY MAINTENANCE	CY	155.100	155.100
		0102- 60-	WORK ZONE SIGN	ED	14720.000	14720.000
		0102- 74- 1	CHANNELIZING DEVICE- TYPES 1, 11, DI, VP, DRUM, OR LCD	ED	103736.000	103736.000
		0102- 74- 7	CHANNELIZING DEVICE- PEDESTRIAN LCD (LONGITUDINAL CHANNELIZING DEVICE)	LF	624.000	624.000
		0102- 78-	TEMPORARY RETROREFLECTIVE PAVEMENT MARKER	EA	2992.000	2992.000
		0102- 99-	PORTABLE CHANGEABLE MESSAGE SIGN, TEMPORARY	ED	814.000	814.000
		0102-150- 1	PORTABLE REGULATORY, SIGN	ED	320.000	320.000
		0102-150- 2	RADAR SPEED DISPLAY UNIT	ED	320.000	320.000
		0104- 10- 3	SEDIMENT BARRIER	LF	3351.000	3351.000
		0104- 18-	INLET PROTECTION SYSTEM	EA	6.000	6.000
		0107- 1-	LITTER REMOVAL	AC	736.830 N	736.830
		0107- 2-	MOWING	AC	621.740 N	621.740
		0110- 1- 1	CLEARING & GRUBBING 43775215201	(LS)	1.000	1.000
		0110- 4- 10	REMOVAL OF EXISTING CONCRETE	SY	93.000	93.000
		0110- 7- 1	MAILBOX, F&I SINGLE	EA	2.000	2.000
		0286- 1-	TURNOUT CONSTRUCTION/DRIVEWAY BASE- OPTIONAL MATERIALS	SY	86.000	86.000
		0327- 70- 6	MILLING EXIST ASPH PAVT, 1 1/2" AVG DEPTH	SY	168489.000	168489.000
		0327- 70- 12	MILLING EXIST ASPH PAVT, 1 1/4" AVG DEPTH	SY	2177.000	2177.000
		0334- 1- 52	SUPERPAVE ASPHALTIC CONCRETE, TRAFFIC B, PG76-22	TN	14040.500	14040.500
		0337- 7- 80	ASPHALT CONCRETE FRICTION COURSE, TRAFFIC B, FC-9.5, PG 76-22	TN	16515.300	16515.300
		0400- 1- 2	CONCRETE CLASS 1, ENDWALLS	CY	6.500	6.500
		0430-175-118	PIPE CULVERT, OPTIONAL MATERIAL ROUND, 18"S/CD	LF	206.000	206.000
		0430-175-236	PIPE CULVERT, OPT MATERIAL, OTHER SHAPE - ELLIP/ARCH, 30"S /CD	LF	48.000	48.000
		0430-982-125	MITERED END SECTION, OPTIONAL ROUND, 18" CD	EA	8.000	8.000
		0430-982-633	MITERED END SECTION, OPTIONAL - ELLIPTICAL / ARCH, 30" CD	EA	2.000	2.000
		0440- 1- 20	UNDERDRAIN, TYPE 11	LF	326.000	326.000
		0440- 73- 2	UNDERDRAIN OUTLET PIPE, 6"	LF	8.000	8.000
		0522- 1-	CONCRETE SIDEWALK AND DRIVEWAYS, 4" THICK	SY	125.000	125.000
		0524- 1- 2	CONCRETE DITCH PAVEMENT, NON REINFORCED, 4"	SY	1728.000	1728.000
		0527- 2-	DETECTABLE WARNINGS	SF	119.000	119.000
		0530- 3- 4	RIPRAP, RUBBLE, F&I, DITCH LINING	TN	160.400	160.400
		0570- 1- 2	PERFORMANCE TURF, 50D	SY	34428.000	34428.000
		0710- 11-101	PAINTED PAVEMENT MARKINGS, STANDARD, WHITE, SOLID, 6"	GM	23.801	23.801
		0710- 11-123	PAINTED PAVEMENT MARKINGS, STANDARD, WHITE, SOLID FOR CROSSWALK AND ROUNDABOUT, 12"	LF	69.000	69.000
		0710- 11-125	PAINTED PAVEMENT MARKINGS, STANDARD, WHITE, SOLID FOR STOP LINE OR CROSSWALK, 24"	LF	397.000	397.000
		0710- 11-201	PAINTED PAVEMENT MARKINGS, STANDARD, YELLOW, SOLID, 6"	GM	36.612	36.612

FLORIDA DEPARTMENT OF TRANSPORTATION PROPOSAL SUMMARY OF PAY ITEMS FOR PROPOSAL: E3503						
LEAD PROJECT : 437752-1-52-01		DISTRICT : 03		COUNTY/SECTION : 52030000		
PROJECT(S) : 43775215201		COUNTY : HOLMES				
0002 SUMMARY OF ROADWAY						
SPC	ALT	ITEM NUMBER	ITEM DESCRIPTION	UNIT	43775215201	QUANTITY TOTAL
		0710- 11-231	PAINTED PAVEMENT MARKINGS, STANDARD, YELLOW, SKIP, 6"	GM	8.178	8.178
		0999- 25-	INITIAL CONTINGENCY AMOUNT, DO NOT BID 43775215201	LS	1.000 N	1.000

FLORIDA DEPARTMENT OF TRANSPORTATION PROPOSAL SUMMARY OF PAY ITEMS FOR PROPOSAL: E3503						
LEAD PROJECT : 437752-1-52-01		DISTRICT : 03		COUNTY/SECTION : 52030000		
PROJECT(S) : 43775215201		COUNTY : HOLMES				
0001 SUMMARY OF STRUCTURES						
SPC	ALT	ITEM NUMBER	ITEM DESCRIPTION	UNIT	43775215201	43775215201 BR# 520093 QUANTITY TOTAL
		0450- 1- 21	BRIDGE DECK EXPANSION JOINT, REHABILITATION, POURED JOINT WITH BACKER ROD	LF		440.000 440.000
		0450- 2-	POLYMER NOSING FOR BRIDGE DECK EXPANSION JOINT	CF		100.800 100.800

FLORIDA DEPARTMENT OF TRANSPORTATION PROPOSAL SUMMARY OF PAY ITEMS FOR PROPOSAL: E3503						
LEAD PROJECT : 437752-1-52-01		DISTRICT : 03		COUNTY/SECTION : 52030000		
PROJECT(S) : 43775215201		COUNTY : HOLMES				
0003 SUMMARY OF SIGNING						
SPC	ALT	ITEM NUMBER	ITEM DESCRIPTION	UNIT	43775215201	QUANTITY TOTAL
		0700- 1- 11	SINGLE POST SIGN, F&I GROUND MOUNT, UP TO 12 SF	AS	12.000	12.000
		0700- 1- 60	SINGLE POST SIGN, REMOVE	AS	10.000	10.000
		0700- 3-501	SIGN PANEL, RELOCATE, UP TO 12 SF	EA	9.000	9.000
		0701- 18-101	PROFILED THERMOPLASTIC, STANDARD- ASPHALT SURFACES, WHITE, SOLID, 6"	GM	21.167	21.167
		0701- 18-201	PROFILED THERMOPLASTIC, STANDARD- ASPHALT SURFACES, YELLOW, SOLID, 6"	GM	12.871	12.871
		0710- 90-	PAINTED PAVEMENT MARKINGS, FINAL SURFACE 43775215201	LS	1.000	1.000
		0711- 11-123	THERMOPLASTIC, STANDARD, WHITE, SOLID, 12" FOR CROSSWALK AND ROUNDABOUT	LF	69.000	69.000
		0711- 11-125	THERMOPLASTIC, STANDARD, WHITE, SOLID, 24" FOR STOP LINE AND CROSSWALK	LF	397.000	397.000
		0711- 11-160	THERMOPLASTIC, STANDARD, WHITE, MESSAGE OR SYMBOL	EA	4.000	4.000
		0711- 16-101	THERMOPLASTIC, STANDARD-OTHER SURFACES, WHITE, SOLID, 6"	GM	2.634	2.634
		0711- 16-201	THERMOPLASTIC, STANDARD-OTHER SURFACES, YELLOW, SOLID, 6"	GM	5.435	5.435
		0711- 16-231	THERMOPLASTIC, STANDARD-OTHER SURFACES, YELLOW, SKIP, 6"	GM	4.089	4.089

REVISIONS			
DATE	DESCRIPTION	DATE	DESCRIPTION
04/08/19	Δ REVISE 458+2 QUANTITY		

ADAM J. SCURLOCK, P.E.
P.E. LICENSE NUMBER 75445
ROADWAY DESIGN
FDOT DISTRICT 3
1074 HWY 90
CHIPLEY, FLORIDA 32428

STATE OF FLORIDA DEPARTMENT OF TRANSPORTATION		
ROAD NO.	COUNTY	FINANCIAL PROJECT ID
SR 79	HOLMES	437752-1-52-01

SUMMARY OF PAY ITEMS

SHEET NO.
3

THE OFFICIAL RECORD OF THIS SHEET IS THE ELECTRONIC FILE DIGITALLY SIGNED AND SEALED UNDER RULE 61G15-23.004, F.A.C.

SUMMARY OF STRUCTURE QUANTITIES - BRIDGE 520093

SECTION	PAY ITEM NO.	PAY ITEM DESCRIPTION	LOCATION	UNIT	QUANTITY		TOTAL		DESIGN NOTES	CONSTRUCTION REMARKS
					P	F	P	F		
	0458-1-21	Bridge Deck Expansion Joint, Rehabilitation, Poured Joint with Backer Rod		LF	440.00		440.00			
	0458-2 Δ	Polymer Nosing for Bridge Deck Expansion Joint		CF	100.80		100.80			

REVISIONS				DARRELL K. SHORES, P.E. P.E. LICENSE NUMBER 47659 ROADWAY DESIGN FDOT DISTRICT 3 1074 HWY 90 CHIPLEY, FLORIDA 32428	STATE OF FLORIDA DEPARTMENT OF TRANSPORTATION			SUMMARY OF QUANTITIES	SHEET NO.
DATE	DESCRIPTION	DATE	DESCRIPTION		ROAD NO.	COUNTY	FINANCIAL PROJECT ID		SQ-8
04/08/19	Δ REVISE 458-2 QUANTITY				SR 79	HOLMES	437752-1-52-01		