



Florida Department of Transportation

RON DESANTIS
GOVERNOR

605 Suwannee Street
Tallahassee, FL 32399-0450

JARED W. PERDUE, P.E.
SECRETARY

August 4, 2026

ADDENDUM NO. 1

To: ALL PROPOSAL HOLDERS
FINANCIAL ITEM NUMBER: 21904235201
CONTRACT NUMBER: E3Y64

DESCRIPTION: The Improvements under this District Contract consist of the removal and replacement of coating systems on all steel superstructure components for spans 5, 6, and 7 for SR 71 over Intracoastal Waterway Bridge No. 510951 in Gulf County.

BIDS TO BE RECEIVED: Thursday, August 13, 2026

If you are a PROPOSAL HOLDER, this is your authorization to make the following changes to the plans and specification packages you now have for the subject project:

REVISION 1

-The following Plan Sheets have been Revised

- Sheet B-1 Added Sheet B-2A to index
- Sheet B-2A added
- Sheet B-3 Added

- E3Y64 CADD REV01 and E3Y64 Plan sheets have been added to the Contractor Proposal Processing (CPP) website for your use.

Please use this revision when preparing your bid.

Electronic Bids will be received until 10:00 a.m. local time on August 13, 2026, in the District Three Procurement Services Office, Administration Building, 1074 Highway 90, Chipley, Florida.

AMENDMENT NOTIFICATION

If you are a PROPOSAL HOLDER, please go to the CPP Online Ordering System at [CPP.Web](#) to download E3Y64 Amendment No. 1, file E3Y64.001.

Also, all PROPOSAL HOLDERS please acknowledge receipt of the addendum under the Acknowledgement of Amendments tab on your electronic bid.

If you have any further questions, please contact Karen Woodham by phone at (850) 330-1340 or by email at Karen.Woodham@dot.state.fl.us.

Sincerely,

Ranae Dodson
Digitally signed by: Ranae Dodson
DN: cn = Ranae Dodson email =
Ranae.Dodson@dot.state.fl.us C = US O = Florida
Department of Transportation OU = Procurement
Date: 2025.08.04 14:06:26 -0500

Ranae Dodson
District Procurement Manager

RD:kw

c.c. Kevin Fussell, District Construction Engineer, file


STATE OF FLORIDA
DEPARTMENT OF TRANSPORTATION

STRUCTURES PLANS

FINANCIAL PROJECT ID 219042-3-52-01

GULF COUNTY (51020000)

STATE ROAD NO. 71
PAINTING PROJECT AT SR 71 OVER
INTRACOASTAL WATERWAY (WHITE CITY) BRIDGE NO. 510951

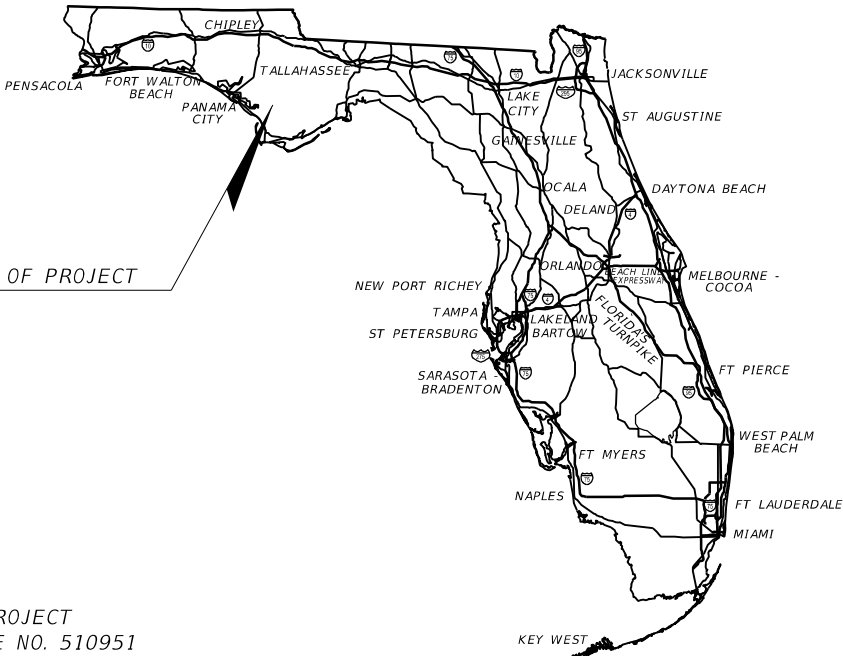

LOCATION OF PROJECT

INDEX OF STRUCTURES PLANS

GENERAL SHEETS:

SHEET NO. SHEET DESCRIPTION

B-1 KEY SHEET
B-2 SIGNATURE SHEET
B-2A SIGNATURE SHEET
B-3 GENERAL NOTES
B-4 TEMPORARY TRAFFIC CONTROL PLAN

SR 71 OVER ICWW (WHITE CITY) BRIDGE (BRIDGE NO. 510951):

SHEET NO. SHEET DESCRIPTION

B1-1 PLAN AND ELEVATION (1 OF 2)
B1-2 PLAN AND ELEVATION (2 OF 2)
B1-3 TYPICAL SECTION

EXISTING BRIDGE PLANS (BRIDGE NO. 510951):

SHEET NO. SHEET DESCRIPTION

BX1-1 THRU EXISTING BRIDGE PLANS
BX1-16


GOVERNING STANDARD PLANS:

Florida Department of Transportation, FY 2026-27 Standard Plans for Road and Bridge Construction and applicable Interim Revisions (IRs).

Standard Plans for Road Construction and associated IRs are available at the following website: <http://www.fdot.gov/design/standardplans>

GOVERNING STANDARD SPECIFICATIONS:

Florida Department of Transportation, FY 2026-27 Standard Specifications for Road and Bridge Construction at the following website: <http://www.fdot.gov/programmanagement/Implemented/SpecBooks>

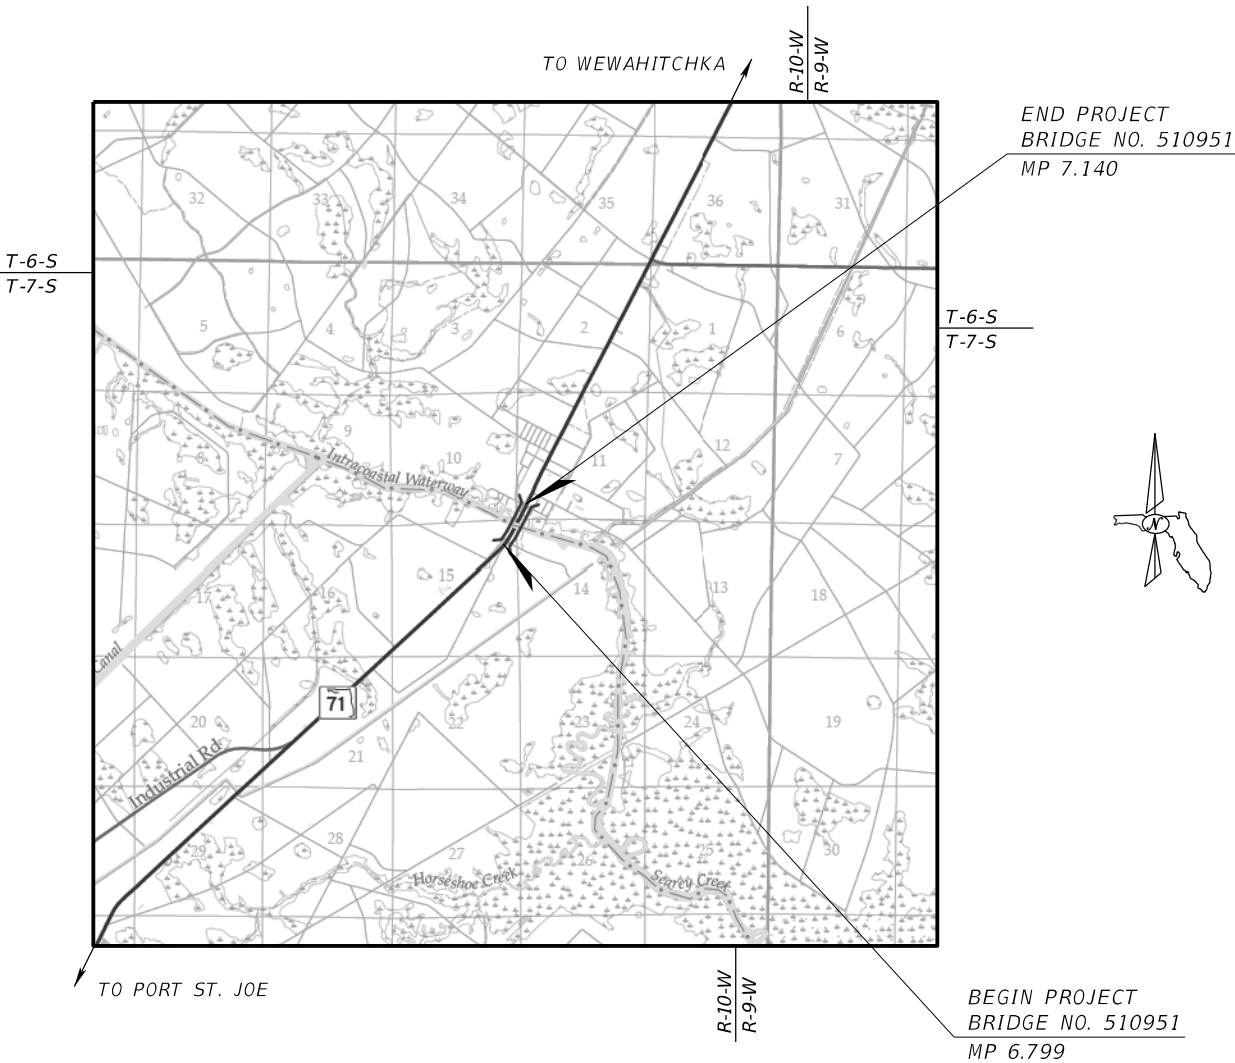

REVISIONS:

FINANCIAL PROJECT ID 219042-3-52-01
Structure sheets B-1, B-2A, & B-3
(Revised 08/04/2026)

KEY SHEET REVISIONS	
DATE	DESCRIPTION
8/04/26	ADDED SHEET B-2A TO INDEX

STRUCTURES PLANS


ENGINEER OF RECORD:

MARK S. LAUCKNER, P.E.
P.E NO.: 58663
PATEL, GREENE & ASSOCIATES, LLC
14499 N. DALE MABRY HIGHWAY SUITE 200
TAMPA, FL 33618
(813) 946-8955
CONTRACT NO.: C-A190
VENDOR NO.: 45-2209743

FDOT PROJECT MANAGER:

DEAN M. MITCHELL P.E.
(850) 415-9016

CONSTRUCTION CONTRACT NO.	FISCAL YEAR	SHEET NO.
E3Y64	27	B-1

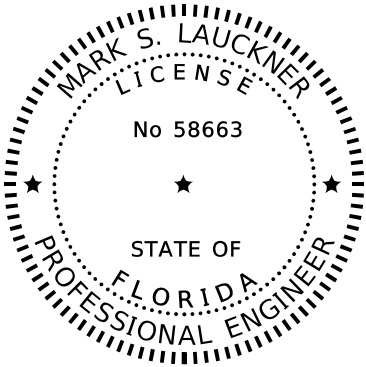

THIS ITEM HAS BEEN DIGITALLY SIGNED AND SEALED BY:

ON THE DATE ADJACENT TO THE SEAL

SIGNATURE MUST BE VERIFIED ON ANY ELECTRONIC COPIES.

PATEL, GREENE & ASSOCIATES, LLC
14499 N. DALE MABRY HIGHWAY, SUITE 200
TAMPA, FL 33618
MARK S. LAUCKNER, P.E. NO. 58663

THE ABOVE NAMED PROFESSIONAL ENGINEER SHALL BE RESPONSIBLE FOR THE FOLLOWING SHEETS IN ACCORDANCE WITH RULE 61G15-23.004, F.A.C.

GENERAL SHEETS:

SHEET NO.	SHEET DESCRIPTION
B-1	KEY SHEET
B-2A	SIGNATURE SHEET
B-3	GENERAL NOTES

BRIDGE NO. 510951

REVISIONS						DRAWN BY: CJK CHECKED BY: CC DESIGNED BY: MSL CHECKED BY: CC	STATE OF FLORIDA DEPARTMENT OF TRANSPORTATION			SHEET TITLE:		REF. DWG. NO.
DATE	BY	DESCRIPTION	DATE	BY	DESCRIPTION					SIGNATURE SHEET		
08/04/26	MSL	 NEW SHEET.					ROAD NO.	COUNTY	FINANCIAL PROJECT ID	PROJECT NAME:		SHEET NO.
							SR 71	GULF	219042-3-52-01	PAINTING PROJECT AT SR 71 OVER ICWW (WHITE CITY) BRIDGE		B-2A

DESIGN SPECIFICATIONS:

1. FDOT STRUCTURES MANUAL (JANUARY 2026).
2. AASHTO LRFD BRIDGE DESIGN SPECIFICATIONS (9TH EDITION).
3. FDOT DESIGN MANUAL (JANUARY 2026).

GOVERNING STANDARDS AND CONSTRUCTION SPECIFICATIONS:

1. FDOT FY 2026-27 STANDARD PLANS FOR ROAD AND BRIDGE CONSTRUCTION.
2. FDOT STANDARD SPECIFICATIONS FOR ROAD AND BRIDGE CONSTRUCTION (FY 2026-27), AS AMENDED BY CONTRACT DOCUMENTS.

SCOPE OF WORK:

1. COMPLETE REMOVAL AND REPLACEMENT OF COATING SYSTEM ON ALL STEEL SUPERSTRUCTURE COMPONENTS FOR SPANS 5, 6 AND 7.

PLAN DIMENSIONS:

1. DIMENSIONS IN THESE PLANS ARE FROM THE EXISTING BRIDGE PLANS AND ARE MEASURED IN FEET EITHER HORIZONTALLY OR VERTICALLY, UNLESS OTHERWISE NOTED.
2. VERIFY ALL EXISTING FIELD CONDITIONS AND DIMENSIONS PRIOR TO COMMENCING REPAIRS OR ORDERING ANY MATERIAL. NOTIFY ENGINEER OF ANY DISCREPANCIES FOUND.

TEMPORARY TRAFFIC CONTROL:

1. FOR TEMPORARY TRAFFIC CONTROL NOTES AND DETAILS, SEE SHEET B-4.

UTILITY/AGENCY OWNERS:

COMPANY	CONTACT	PHONE NUMBER/E-MAIL
CITY OF PORT ST. JOE	JOHN GRANTLAND	850-229-8247/jgrantland@psj.fl.gov
CONSOLIDATED COMMUNICATIONS (FORMALLY FAIRPOINT COMMUNICATIONS)	SAMMIE WILLIAMS	850-229-7275/samual.williams@consolidated.com
GULF COAST ELECTRIC COOP.	KAMERON CAVANAUGH	850-739-9037/kcavanaugh@gcec.com
MEDIACOM	PAUL PITTS	845-913-6499/ppitts@mediacomcc.com
ST. JOE NATURAL GAS	STUART SHOAF	850-229-8216 ext.209/sshoaf@stjoegas.com

ALL UTILITIES ARE TO REMAIN. IF ANY EXISTING UTILITIES CONFLICT WITH PROPOSED CONSTRUCTION METHOD, MATERIALS, OR EQUIPMENT, NOTIFY THE ENGINEER.

WEATHER STATION EQUIPMENT:

1. WEATHER STATION EQUIPMENT IS LOCATED ON THE BRIDGE. PROTECT EXISTING WEATHER STATION EQUIPMENT SUCH THAT THEY REMAIN OPERATIONAL DURING CONSTRUCTION ACTIVITIES. IF A PROBLEM IS DISCOVERED, NOTIFY THE FDOT TRAFFIC MANAGEMENT CENTER AT 850-330-1795.

CLEAN AND REPAINT:

1. COMPLETELY REMOVE AND REPLACE EXISTING COATING SYSTEM ON ALL EXPOSED EXISTING STRUCTURAL STEEL MEMBERS IN ACCORDANCE WITH THE SPECIFICATIONS AND MODIFIED SPECIAL PROVISIONS. EXISTING STRUCTURAL STEEL MEMBERS INCLUDE GIRDERS, SPLICES, STIFFENERS, CROSS FRAMES, AND CONNECTION PLATES.

-
2. THE FINISH COAT MUST MATCH EXISTING COLOR. CONFIRM COLOR BY COLOR MATCHING THE EXISTING FINISH COAT USING A FAN DECK UNDER APPROPRIATE LIGHTING OR USING AN ALTERNATE METHOD TO THE SATISFACTION OF THE ENGINEER.

HAZARDOUS MATERIALS:

1. THE RESULTS OF THE JUNE 2019 ASSESSMENT OF THE EXISTING PAINT SYSTEM ARE AS FOLLOWS (UNITS ARE IN MG/KG):

SAMPLE NO.	COLOR	CONDITION	LEAD (mg/kg)	CADMIUM (mg/kg)	CHROMIUM (mg/kg)	ARSENIC (mg/kg)
AREA 1	LIGHT GREY	INTACT	34	BRL *	19	BRL *
AREA 2	LIGHT GREY	INTACT	73	2.4	15	BRL *
AREA 3	LIGHT GREY	INTACT	41	BRL *	6.9	BRL *
AREA 4	LIGHT GREY	INTACT	52	BRL *	13	BRL *

* BELOW REPORTING LIMITS (BRL) - INDICATES THE ANALYTE WAS NOT DETECTED AT THE REPORTING LIMIT.

NAVIGATIONAL REQUIREMENTS:

1. EXISTING NAVIGATION LIGHTING MUST BE MAINTAINED WITH UNRESTRICTED ACCESS AND VISIBILITY AT ALL TIMES.
2. SUBMIT A COPY OF THE CONSTRUCTION PLAN, SCHEDULE, AND SEQUENCE OF OPERATIONS FOR THE BRIDGE, APPROVED BY THE ENGINEER, TO THE U.S. COAST GUARD FOR APPROVAL 60 DAYS PRIOR TO STARTING WORK OVER OR IN THE WATERWAY.
3. NOTIFY U.S. COAST GUARD SECTOR MOBILE WATERWAYS MANAGEMENT AND U.S. COAST GUARD DISTRICT 8 BRIDGE ADMINISTRATION 10 DAYS PRIOR TO THE START OF CONSTRUCTION AND 45 DAYS PRIOR TO ANY ANTICIPATED CHANNEL RESTRICTIONS.
4. ANY CHANNEL RESTRICTIONS (HORIZONTAL AND/OR VERTICAL) MUST BE APPROVED BY THE U.S. COAST GUARD. PROVIDE 45 DAYS ADVANCED NOTICE. MARK ALL BARGES WITH USCG APPROVED LIGHTS AND PROVIDE BARGES WITH LIGHTS INSTALLED ON THE CORNERS TO ENSURE VISIBILITY BY NEARBY VESSELS. MAKE VISIBLE AND MARK WORK AREAS TO WARN VESSELS OF CONSTRUCTION AREAS.
5. WATERBORNE CRAFT MUST DISPLAY THE FDOT LOGO FLAG AVAILABLE FROM THE FDOT DISTRICT 3 STRUCTURES MAINTENANCE OFFICE (DSMO) AT (850) 330-1652. AN EMERGENCY BOAT MUST BE ON SITE AT ALL TIMES WHEN PERSONNEL ARE PRESENT OVER WATER. THIS BOAT IS IN ADDITION TO THE WATERBORNE CRAFT USED FOR CONSTRUCTION AND AS REQUIRED FOR INSPECTION. MAINTAIN APPROPRIATE SKIMMERS AND ABSORBENT MATERIALS AT WORK AREA FOR DEPLOYMENT IN THE EVENT OF AN ACCIDENTAL SPILL.

6. CONTACT INFORMATION FOR U.S. COAST GUARD:

DISTRICT 8 BRIDGE WATERWAYS SECTOR MOBILE
(504) 671-2327, LocalNoticeFeedback@uscg.mil (833) 662-8724

WORK, STAGING, AND STORAGE AREAS:

1. RESTRICT EQUIPMENT AND OPERATIONS TO THE PROJECT RIGHT OF WAY. DO NOT USE PRIVATE PROPERTY FOR PARKING, STORAGE OF EQUIPMENT, OR PROJECT ELEMENTS UNLESS PERMISSION IS OBTAINED BY THE PRIVATE PROPERTY OWNER.
2. DO NOT ALLOW HAULING UNITS OR EQUIPMENT TO DAMAGE EXISTING LANDSCAPE ELEMENTS. STAGING AREAS WILL BE APPROVED BY THE PROJECT ADMINISTRATOR SO THAT EQUIPMENT, VEHICLES, MATERIALS AND DEBRIS WILL NOT IMPACT THE PLANTED LANDSCAPE AREAS OF THE ROADSIDE, MEDIANS, OR THE AREAS UNDER THE CANOPY OF THE EXISTING TREES ON THE PROJECT SITE.
3. SECURE EQUIPMENT PROPERLY AND AWAY FROM THE BRIDGE DURING SEVERE WEATHER OR WHEN UNATTENDED ON THE LANDSIDE OF THE BRIDGE.
4. EQUIPMENT OR MATERIAL MAY NOT BE TIED TO OR PLACED UPON ANY PART OF THE EXISTING BRIDGE DURING CONSTRUCTION ACTIVITIES WITHOUT PRIOR APPROVAL OF THE ENGINEER.

BRIDGE NO. 510951

REVISIONS						MARK S. LAUCKNER, P.E. License Number: 58663 PATEL, GREENE & ASSOCIATES, LLC 14499 N. DALE MABRY HIGHWAY , STE 200 TAMPA, FL 33618	DRAWN BY: CJK CHECKED BY: CC DESIGNED BY: MSL CHECKED BY: CC	STATE OF FLORIDA DEPARTMENT OF TRANSPORTATION			SHEET TITLE:		REF. DWG. NO.
DATE	BY	DESCRIPTION	DATE	BY	DESCRIPTION			ROAD NO.	COUNTY	FINANCIAL PROJECT ID	GENERAL NOTES		
08/04/26	MSL	 UPDATED NOTE.									PROJECT NAME:		
											PAINTING PROJECT AT SR 71 OVER ICWW (WHITE CITY) BRIDGE		
											B-3		