Centennial FDOT 1915 ★ 2015

Florida Department of Transportation

RICK SCOTT
GOVERNOR

1000 NW 111th Avenue
Miami, Florida 33172-5800

JIM BOXOLD
SECRETARY

Addendum #2
Dated: August 11, 2015

FAILURE TO LOAD ALL AMENDMENT FILES OR TO SUBMIT THE SIGNED ADDENDUM PAGE PRIOR TO THE LETTING DATE WILL CAUSE THE BID TO BE NON-RESPONSIVE.

Project/ Proposal Number:	E-6J90
Financial Project Number:	417740-8-92-01/417740-9-92-01/417740-9-92-02
Contract Number:	E-6J90
County(ies):	Miami-Dade County
Letting Date/ Time:	September 23, 2015 at 10:00 A.M.
Location:	District Six, Adam Leigh Cann Building 1000 NW 111th Avenue Miami, Florida 33172
Project Description:	A low Bid Design-Build contract to solicit competitive Bid Prices and Technical Proposals from Proposers for the replacement of ITS devices in Miami-Dade County.

Please note the changes as follows:

Signing Concept Plan Sheets S-04, S-10, S-12, and S-17 have been revised. Bidders need to replace corresponding sheets with these revised sheets.

Addendum Attachments and Amendment Notification:

If you are a BID DOCUMENT HOLDER for the subject project, please go to the Online Ordering Web Site at https://www3.dot.state.fl.us/ContractProposalProcessingOnlineOrdering/ to download the new bidding documents and amendment files for this addendum. Please acknowledge receipt of this addendum in Expedite Bid by opening the Acceptance of Bidding Acknowledgements folder and confirming your acknowledgement of Amendment and Addenda files or fax the signed copy to District Six District Contracts Office at (305) 470-5309 prior to the letting date, September 23, 2015.

Nadine Chinapoo
Contract Supervisor
District Contracts, Design-Build, and Commodities & Contractual Services

Please acknowledge receipt of this addendum by signing in the area provided below.

Return this acknowledgment by fax (305) 470-5309 to District Six District Contracts Office.

COMPANY NAME	SIGNATURE
TITLE	PRINT

N.T.S.

NW 20th STREET

NW 6th PLACE

I-95 SB

I-95 NB

INSTALL NEW SIGN PANEL (GS-08) (14'-6" X 8'-6")

EXPRESS LANES
REGISTERED CARPOOLS NO TOLL

REGISTERED CARPOOLS PREPAID TOLLS BEGIN ¼ MILE

EXISTING SIGN PANEL TO BE REMOVED

INSTALL ONE NEW COLOR LANE STATUS DMS PANEL

XXXXXXXXX

XXXXXXXXX

EXPRESS LANES ½ MILE

MERGE ONLY

EXISTING SIGN PANEL TO REMAIN
EXISTING DMS PANEL TO BE REMOVED

INSTALL NEW SIGN PANEL (GS-01) (24'-0" X 20'-6")
INSTALL THREE NEW COLOR TOLL AMOUNT DMS PANELS

$25 PLUS TOLL FOR VIOLATION

TO 595 $ XX.XX

TO Ives Dairy $ XX.XX

TO 826 $ XX.XX

EXPRESS LANES ONLY

$25 PLUS TOLL FOR VIOLATION

TO 826 $ XX.XX

REGISTERED CARPOOLS FREE (WHEN ON TOLL)

EXISTING SIGN AND DMS PANELS TO BE REMOVED

NW 20th STREET

NW 5th PLACE

NW 21st STREET

I-95 NB BEFORE NW 20th STREET

I-95 NB AT NW 20th STREET

REVISIONS			
DATE	DESCRIPTION	DATE	DESCRIPTION

HNTB CORPORATION
8700 W. FLAGLER STREET
SUITE 402
MIAMI, FL 33174-2428
TEL.: (305) 551-8100
FAX :(305) 551-2800

STATE OF FLORIDA
DEPARTMENT OF TRANSPORTATION

ROAD NO.	COUNTY	FINANCIAL PROJECT ID
9A	MIAMI-DADE	417740-8-92-01

SIGNING CONCEPT PLAN

SHEET NO. S-04

wlucky 8/3/2015 2:48:19 PM \\miaw00\projects3\56218\9TechProd\TWO 14_ On Call ITS\ITS Device Replacement – 95 Express DMS and Others\12345615201\signing\PLANSP03.DGN

N.T.S.

EXISTING SIGN TO REMAIN

REGISTER CARPOOLS 1 800 234 RIDE

INSTALL NEW SIGN PANEL (GS-08) (14'-6" X 8'-6") POST MOUNTED

EXPRESS LANES REGISTERED CARPOOLS NO TOLL

EXPRESS LANES REGISTERED CARPOOLS AND PREPAID TOLLS BEGIN 1 MILE

REMOVE EXISTING SIGN

I-95 SB

I-95 NB

I-95 SB

NW 6th AVE.

NW 161st ST.

EXPRESS LANES ONLY

SunPass

112

836

TO

95

TO

$25 PLUS TOLL FOR VIOLATION

$ XX.XX

REGISTERED CARPOOLS FREE ONLY

112

836

95

TO

TO

$25 PLUS TOLL FOR VIOLATION

$ XX.XX

INSTALL NEW SIGN PANEL (GS-06) (24'-0" X 19'-6") INSTALL ONE NEW COLOR TOLL AMOUNT DMS PANEL

EXISTING SIGN AND DMS PANELS TO BE REMOVED

NW 165th ST.

I-95 SB AT US 441

REVISIONS			
DATE	DESCRIPTION	DATE	DESCRIPTION

HNTB CORPORATION
8700 W. FLAGLER STREET
SUITE 402
MIAMI, FL 33174-2428
TEL.: (305) 551-8100
FAX :(305) 551-2800

STATE OF FLORIDA
DEPARTMENT OF TRANSPORTATION

ROAD NO.	COUNTY	FINANCIAL PROJECT ID
9A	MIAMI-DADE	417740-8-92-01

SIGNING CONCEPT PLAN

SHEET NO.
S-10

wlucky 8/3/2015 2:43:29 PM \\miaw00\projects3\56218\9TechProd\TWO 14_ On Call ITS\ITS Device Replacement - 95 Express DMS and Others\12345615201\signing\PLANSP09.dgn

N.T.S.

NW 38th STREET

NW 39th STREET

NW 42nd STREET

NW 12th AVENUE

SR 112 EB

SR 112 WB

NW 40TH STREET

NW 41st STREET

INSTALL NEW SIGN PANEL (GS-01) (24'-0" X 20'-6") INSTALL THREE NEW COLOR TOLL AMOUNT DMS PANELS

EXISTING SIGN AND DMS PANELS TO BE REMOVED

INSTALL NEW SIGN PANEL (GS-08) (14'-6" X 8'-6")

EXISTING SIGN PANEL TO BE REMOVED

INSTALL NEW GROUND MOUNTED SIGN (GS-07) (14'-6" X 6'-6")

SR 112 EB AT NW 12th AVENUE

REVISIONS			
DATE	DESCRIPTION	DATE	DESCRIPTION

HNTB CORPORATION
8700 W. FLAGLER STREET
SUITE 402
MIAMI, FL 33174-2428
TEL.: (305) 551-8100
FAX :(305) 551-2800

STATE OF FLORIDA
DEPARTMENT OF TRANSPORTATION

ROAD NO.	COUNTY	FINANCIAL PROJECT ID
9A	MIAMI-DADE	417740-8-92-01

SIGNING CONCEPT PLAN

SHEET NO. S-12

wlucky 8/3/2015 2:45:44 PM \\miaw00\projects3\56218\9TechProd\TWO 14_ On Call ITS\ITS Device Replacement - 95 Express DMS and Others\12345615201\signing\PLANSP11.DGN

SIGN NAME	GS-07			QTY	1	SIGN NUMBER	STATION(S)
PANEL		BORDER					none
WIDTH	14'-6"	WIDTH	2"				
HEIGHT	6'-6"	RADII	10"				
LEGEND	White	COLOR	White				
COLOR	Blue						

SYMBOL(S)	ANGLE	X	Y	WID	HT

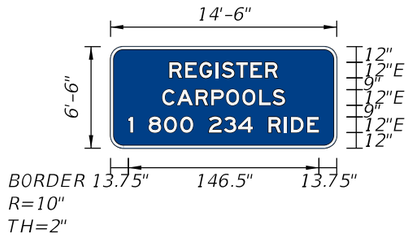

NO. OF LIGHT FIXTURES | FIXTURE SPACING | PHOTOMETRIC CURVE | WATT | VOLTAGE

COPY		R	E	G	I	S	T	E	R		L											
SPACE	45.3	12.1	11	12.5	4.6	11	11	11.4	9.7	45.3	83.4											
COPY		C	A	R	P	O	O	L	S		L											
SPACE	39.7	11.4	14.3	12.1	11.4	12.5	12.8	10.3	9.7	39.7	94.6											
COPY		1		8	0	0		2	3	4		R	I	D	E		L					
SPACE	13.7	3.6	12	11.8	12.5	10.1	12	11.4	11	11.3	12	12.1	5.3	12.5	9	13.7	146.5					
COPY																						
SPACE																						
COPY																						
SPACE																						
COPY																						
SPACE																						

SIGN NAME	GS-08			QTY	3	SIGN NUMBER	STATION(S)
PANEL		BORDER					none
WIDTH	14'-6"	WIDTH	2"				
HEIGHT	8'-6"	RADII	12"				
LEGEND	White	COLOR	Black				
COLOR	White						

SYMBOL(S)	ANGLE	X	Y	WID	HT

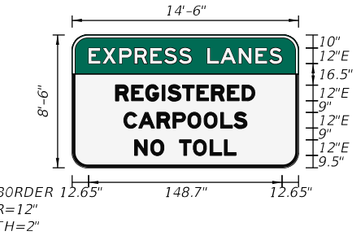

NO. OF LIGHT FIXTURES | FIXTURE SPACING | PHOTOMETRIC CURVE | WATT | VOLTAGE

COPY		E	X	P	R	E	S	S		L	A	N	E	S		L							
SPACE	12.7	10.7	12.8	11.8	12.1	10.7	11.4	9.7	12	10	14.3	12.8	10.7	9.7	12.7	148.7							
COPY		R	E	G	I	S	T	E	R	E	D		L										
SPACE	33.5	12.1	11	12.5	4.6	11	11	11.4	12.1	11.4	9.7	33.5	106.9										
COPY		C	A	R	P	O	O	L	S		L												
SPACE	39.7	11.4	14.3	12.1	11.4	12.5	12.8	10.3	9.7	39.7	94.6												
COPY		N	O		T	O	L	L		L													
SPACE	47.9	12.5	10.1	12	10.7	12.8	11	9	47.9	78.1													
COPY																							
SPACE																							
COPY																							
SPACE																							

SIGN NAME			QTY		SIGN NUMBER	STATION(S)
PANEL		BORDER				
WIDTH		WIDTH				
HEIGHT		RADII				
LEGEND		COLOR				
COLOR						

SYMBOL(S)	ANGLE	X	Y	WID	HT

NO. OF LIGHT FIXTURES | FIXTURE SPACING | PHOTOMETRIC CURVE | WATT | VOLTAGE

COPY																							
SPACE																							
COPY																							
SPACE																							
COPY																							
SPACE																							
COPY																							
SPACE																							
COPY																							
SPACE																							

SIGN NAME			QTY		SIGN NUMBER	STATION(S)
PANEL		BORDER				
WIDTH		WIDTH				
HEIGHT		RADII				
LEGEND		COLOR				
COLOR						

SYMBOL(S)	ANGLE	X	Y	WID	HT

NO. OF LIGHT FIXTURES | FIXTURE SPACING | PHOTOMETRIC CURVE | WATT | VOLTAGE

COPY																							
SPACE																							
COPY																							
SPACE																							
COPY																							
SPACE																							
COPY																							
SPACE																							
COPY																							
SPACE																							

REVISIONS			
DATE	DESCRIPTION	DATE	DESCRIPTION

HNTB CORPORATION
8700 W. FLAGLER STREET
SUITE 402
MIAMI, FL 33174-2428
TEL.: (305) 551-8100
FAX :(305) 551-2800

STATE OF FLORIDA
DEPARTMENT OF TRANSPORTATION

ROAD NO.	COUNTY	FINANCIAL PROJECT ID
9A	MIAMI-DADE	417740-8-92-01

GUIDE SIGN

SHEET NO. S-17

wlucky 8/7/2015 12:00:00 PM \\miaw00\projects3\56218\9TechProd\TW0 14_ On Call ITS\ITS Device Replacement - 95 Express DMS and Others\12345615201\signing\GSWKSG01.DGN