




THREE THRU LANES - APPROACH AUXILIARY LANE  
(Shown Without Shoulder Gutter)

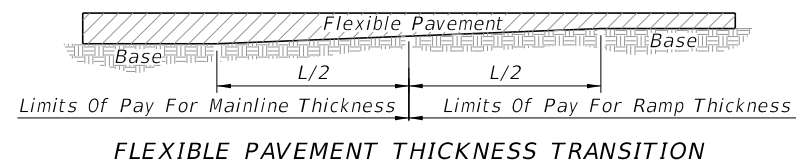


DETAIL "A"

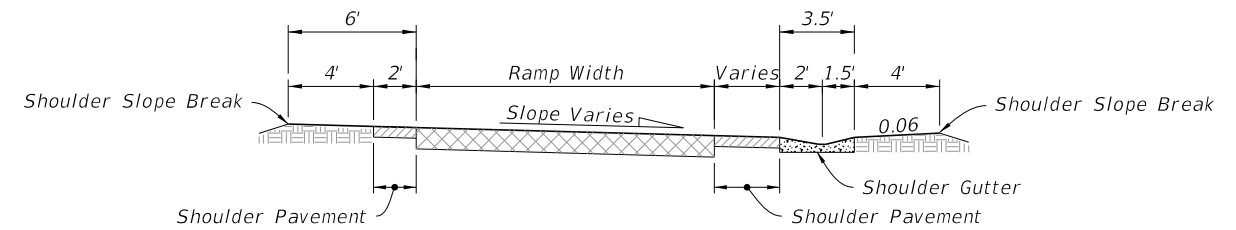

SECTION A-A

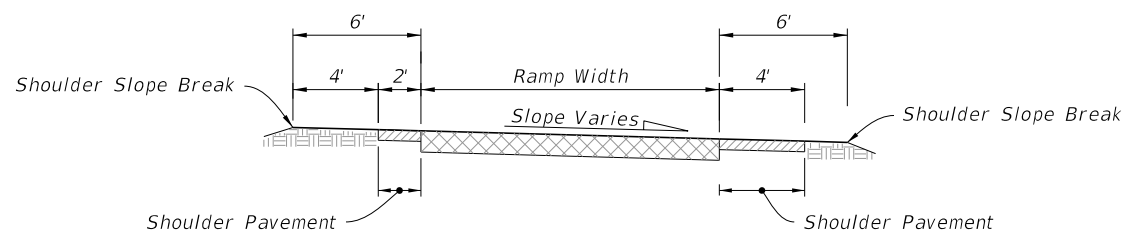

SECTION B-B

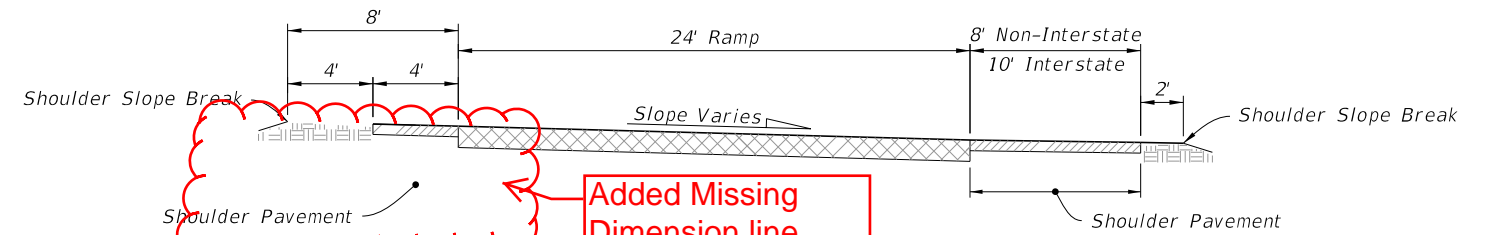

SECTION C-C

TWO LANE RAMPS - EXIT TERMINALS

LAST REVISION 11/01/17	DESCRIPTION:
---------------------------	--------------




FY 2018-19  
STANDARD PLANS

RAMP TERMINALS


INDEX  
000-525

SHEET  
2 of 5

10/16/2017 7:51:20 AM

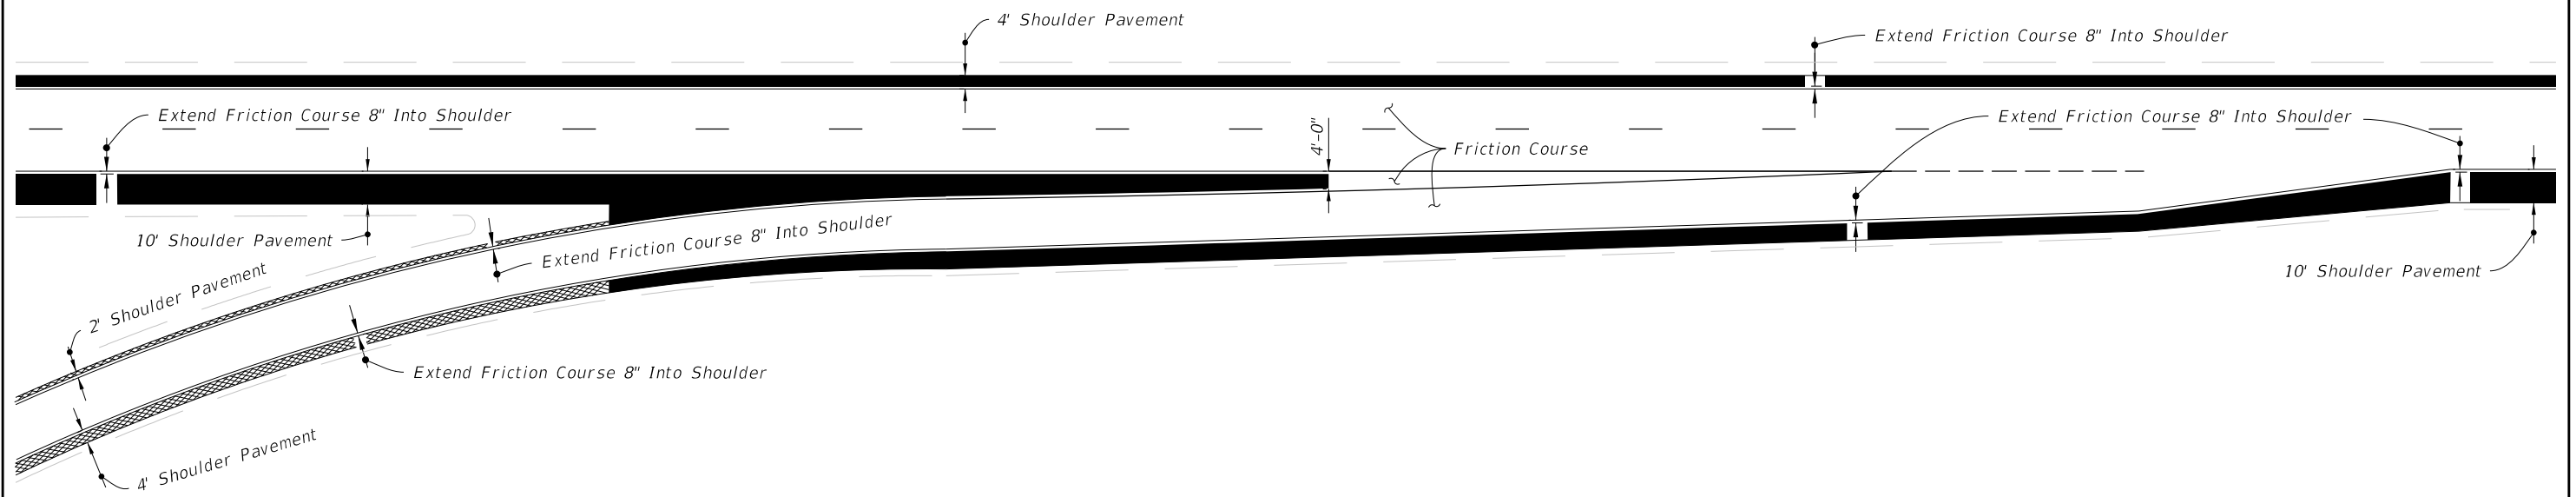

TAPER - TYPE ENTRANCE  
(Shown Without Shoulder Gutter)

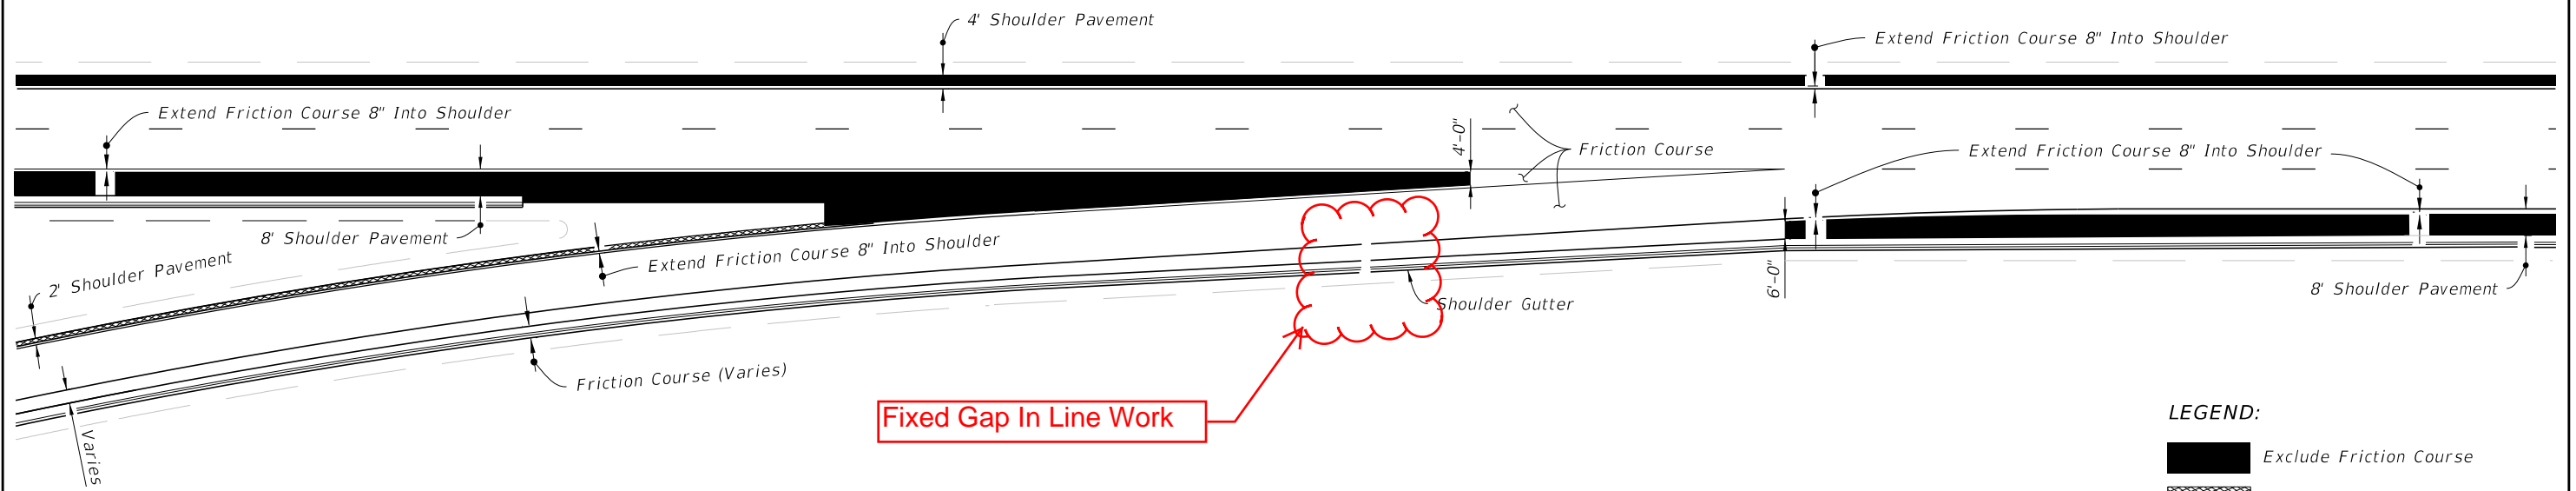

Fixed Gap In Line Work

LEGEND:

- Exclude Friction Course
- Friction Course Optional

PARALLEL - TYPE ENTRANCE  
(Shown With Shoulder Gutter)

ENTRANCE TERMINALS - FRICTION COURSE LOCATION (FOR FLEXIBLE PAVEMENT)

10/16/2017 7:51:21 AM

LAST REVISION 11/01/17	REVISION	DESCRIPTION:	 FY 2018-19 STANDARD PLANS	RAMP TERMINALS	INDEX 000-525	SHEET 5 of 5
---------------------------	----------	--------------	----------------------------------	----------------	------------------	-----------------