



PLAN

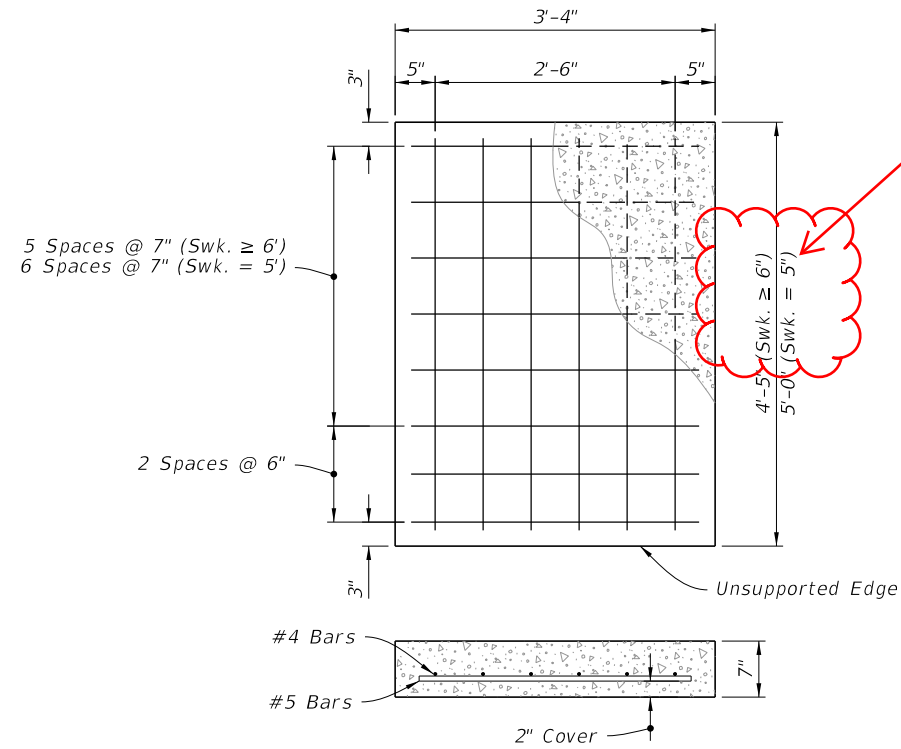


SLAB REINFORCEMENT


CORRECTED: Dimension

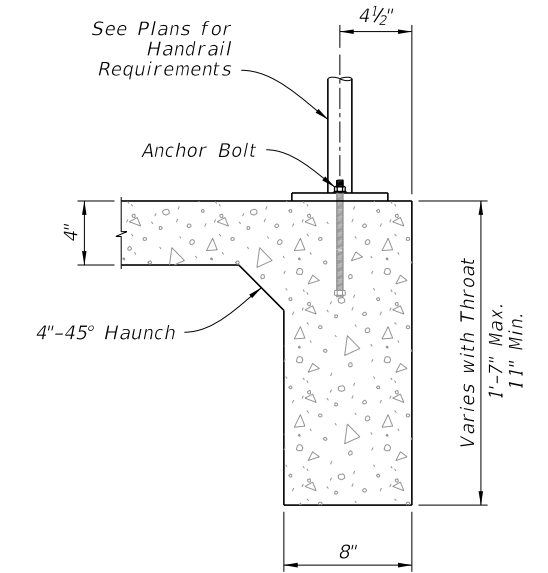


SECTION B-B

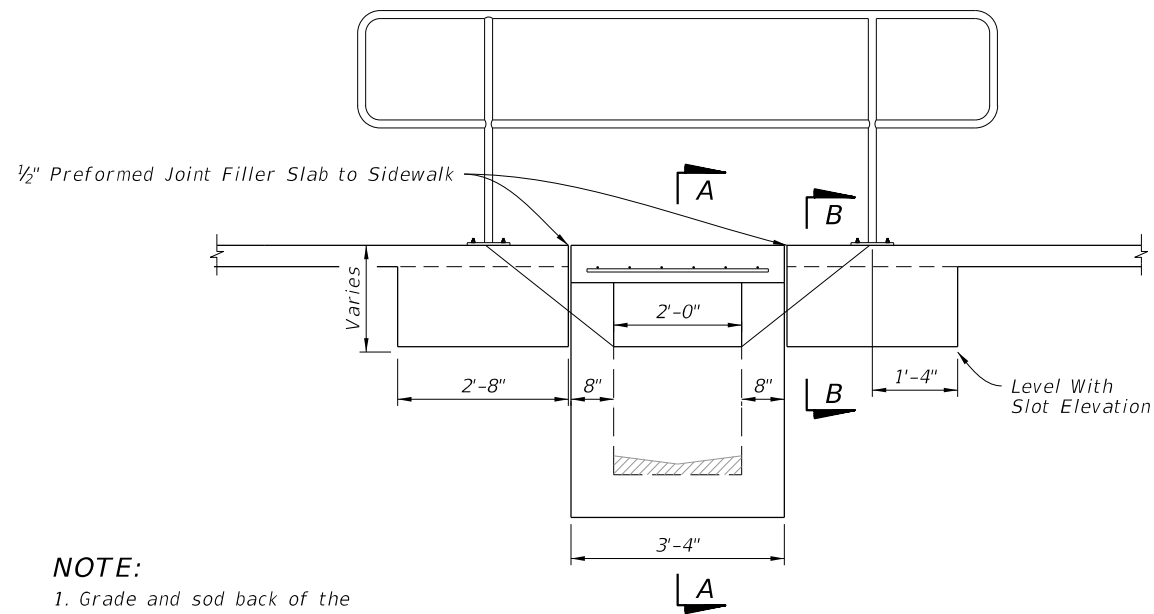

ELEVATION

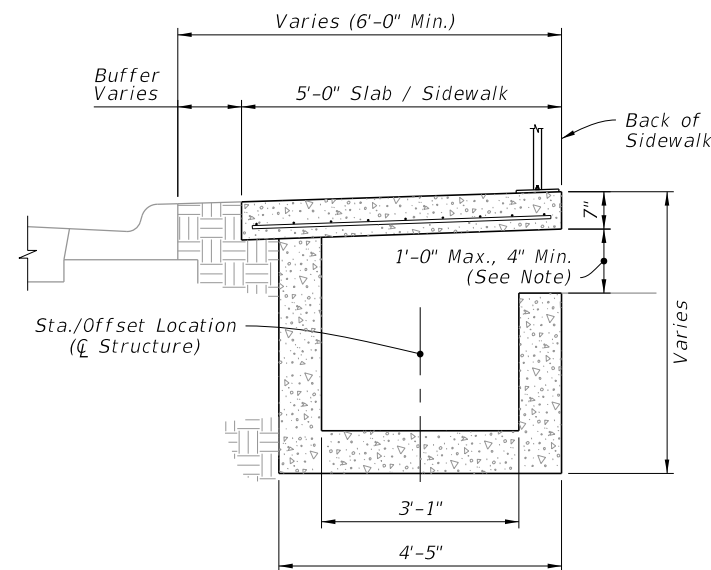

5'-0" SIDEWALK WITH BUFFER
SECTION A-A

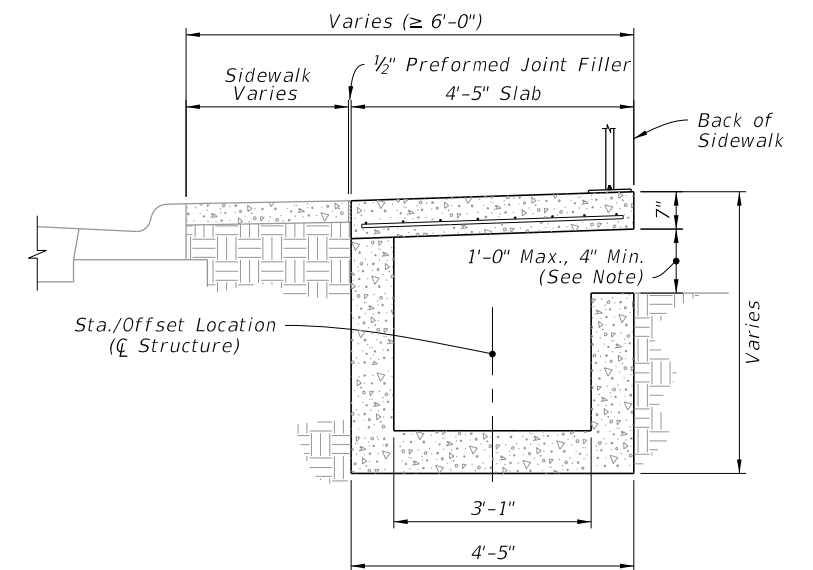

≥6'-0" SIDEWALK WITHOUT BUFFER
SECTION A-A

TYPE C INLET (MODIFIED)

- NOTE:**
1. Grade and sod back of the sidewalk as directed by the Engineer.
 2. Pipe connection not shown.

10/12/2020 7:01:45 AM

LAST REVISION 11/01/20	DESCRIPTION:
---------------------------	--------------



FY 2021-22
STANDARD PLANS

BACK OF SIDEWALK DRAINAGE

INDEX
425-060

SHEET
2 of 4