


**FTP-65-06**  
 3' X 1'-6"  
 2" Radii 3/4" Border  
 4" Series D Legend  
 White Background  
 Black Legend and Border

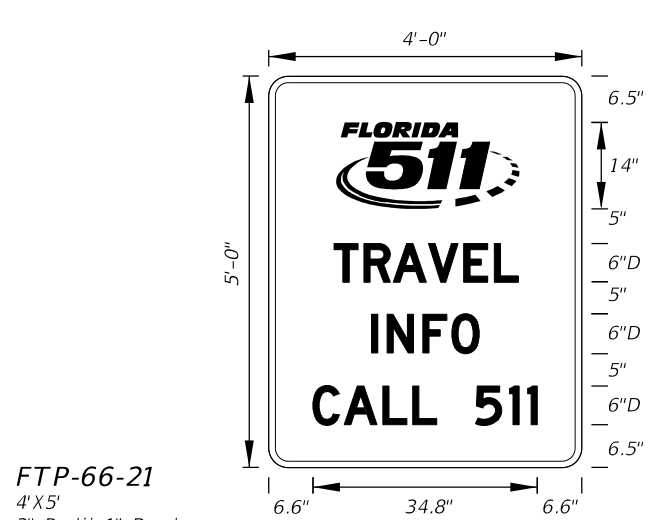

**FTP-66-21**  
 4' X 5'  
 3" Radii 1" Border  
 6" Series D Legend  
 Blue Background  
 White Legend and Border




**FTP-67-21**  
 5.5' X 6'  
 3" Radii 1" Border  
 8" Series D Legend  
 Blue Background  
 White Legend and Border



DETAIL for **FTP-66** AND **FTP-67**


Sign Mounting Holes Can Be Punched Or Field Drilled With No Obstruction To Text Or Symbols From Holes Or Bolts.

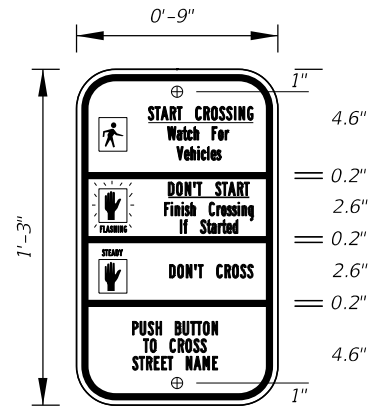

**FTP-68A-06**  
 9" X 1'-3"  
 1.5" Radii 3/4" Border  
 Series B Legend  
 White Background  
 Black Legend and Border


See Standard Highway Signs Manual, Sign R10-3b For Letter Size Spacing And Symbol Sizes.

Sign Mounting Holes Can Be Punched Or Field Drilled With No Obstruction To Text Or Symbols From Holes Or Bolts.

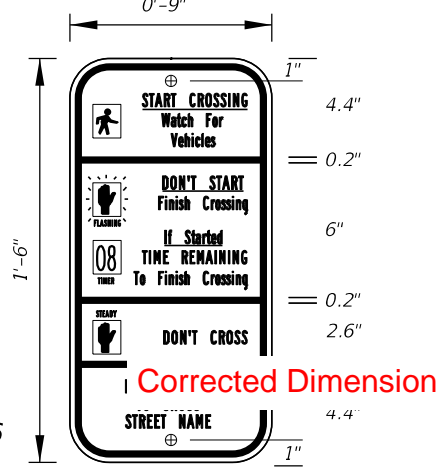


**FTP-68B-06**  
 9" X 1'-6"  
 1.5" Radii 3/4" Border  
 Series B Legend  
 White Background  
 Black Legend and Border

See Standard Highway Signs Manual, Sign R10-3b For Letter Size Spacing And Symbol Sizes.

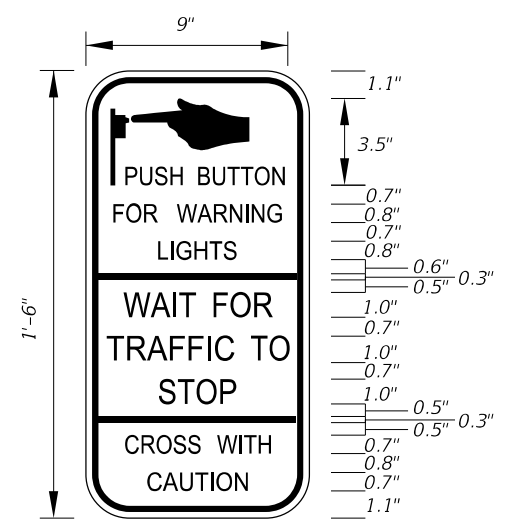


**FTP-68C-21**  
 1'-6" X 9"  
 1.5" Radii 1/2" Border

Series D Legend  
 White Background  
 Black Legend and Border

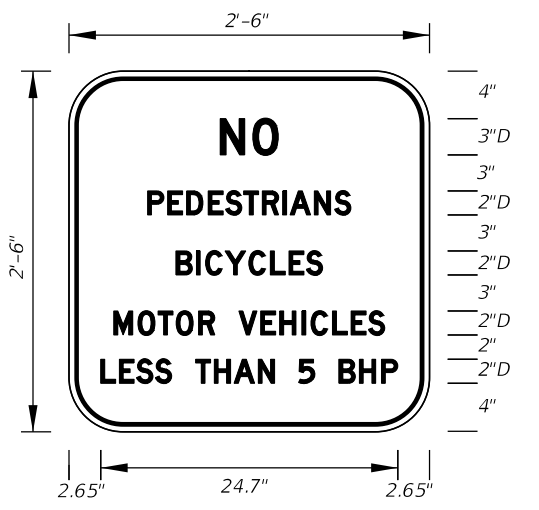


**FTP-69-06**  
 2'-6" X 2'-6"  
 4" Radii 3/4" Border

2" and 3" Series D Legend  
 White Background  
 Black Legend and Border

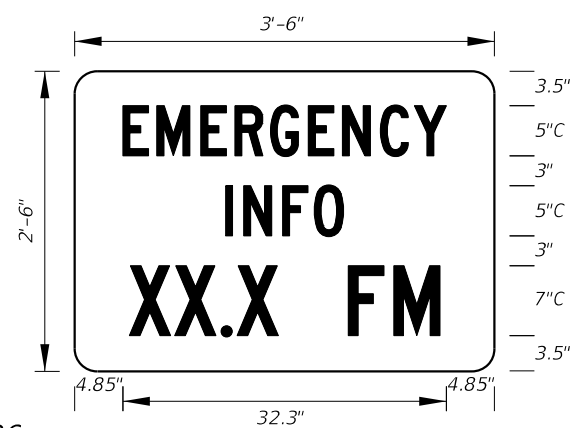

**FTP-70-06**  
 3'-6" X 2'-6"  
 2.25" Radii 3/4" Border  
 5" Series C and 7" Series C Legend  
 Blue Background  
 White Legend and Border

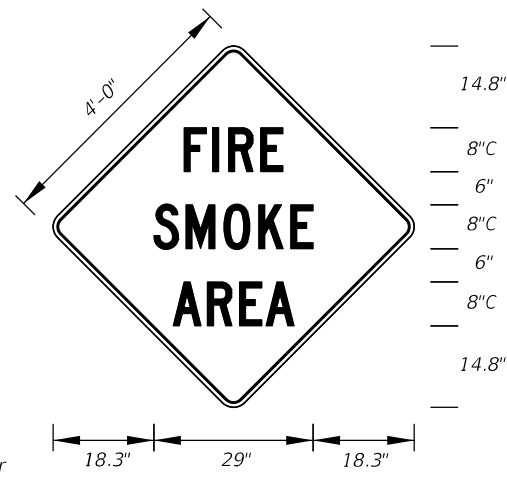


**FTP-71-06**  
 4' X 4'  
 2" Radii 3/4" Border  
 8" Series C Legend  
 Yellow Background  
 Black Legend and Border



**FTP-72-06**  
 3' X 3'  
 2" Radii 3/4" Border













6" Series C Legend  
 Yellow Background  
 Black Legend and Border

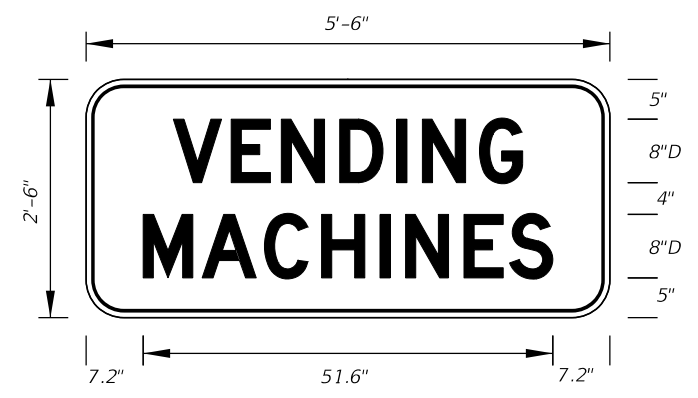

**FTP-73-06**  
 5'-6" X 2'-6"  
 4" Radii 3/4" Border

8" Series D Legend  
 Blue Background  
 White Legend and Border

10/12/2020 9:05:15 AM

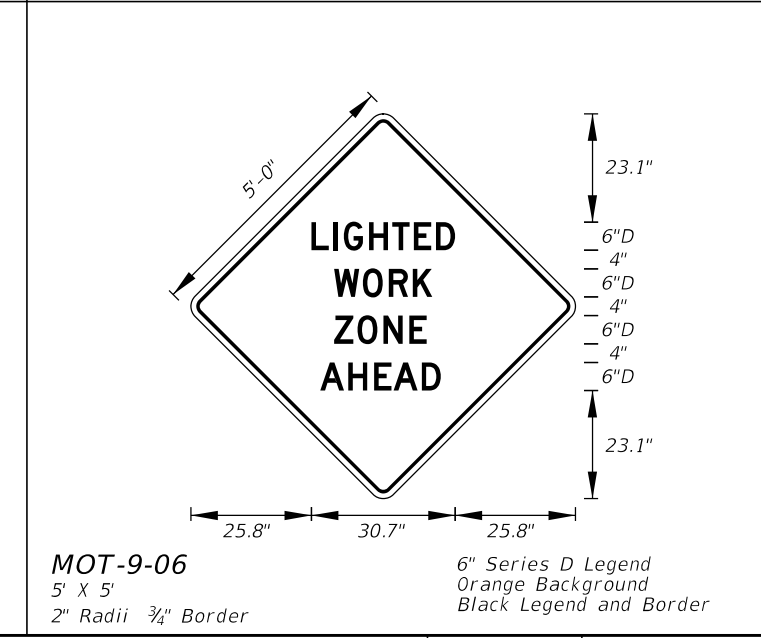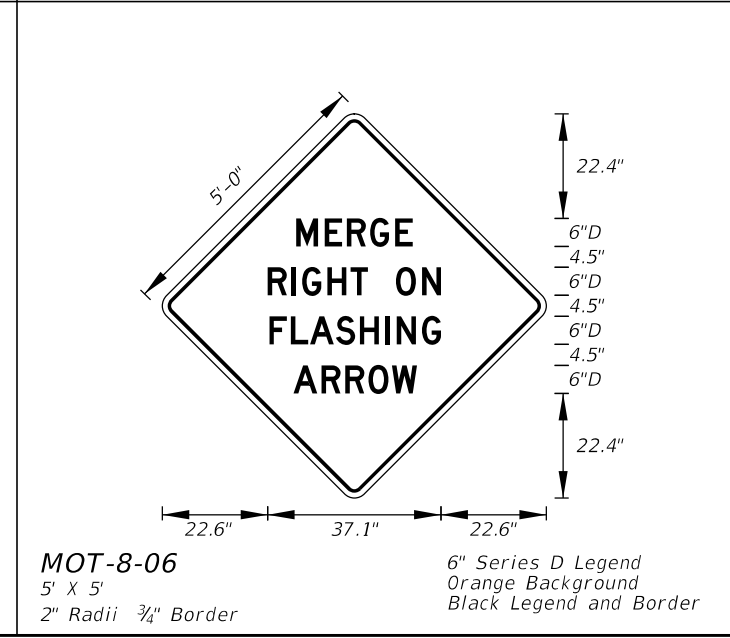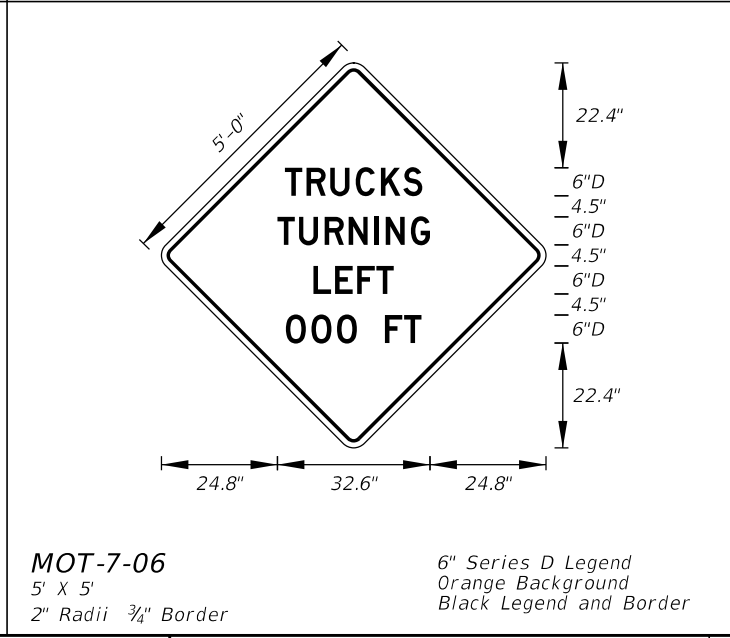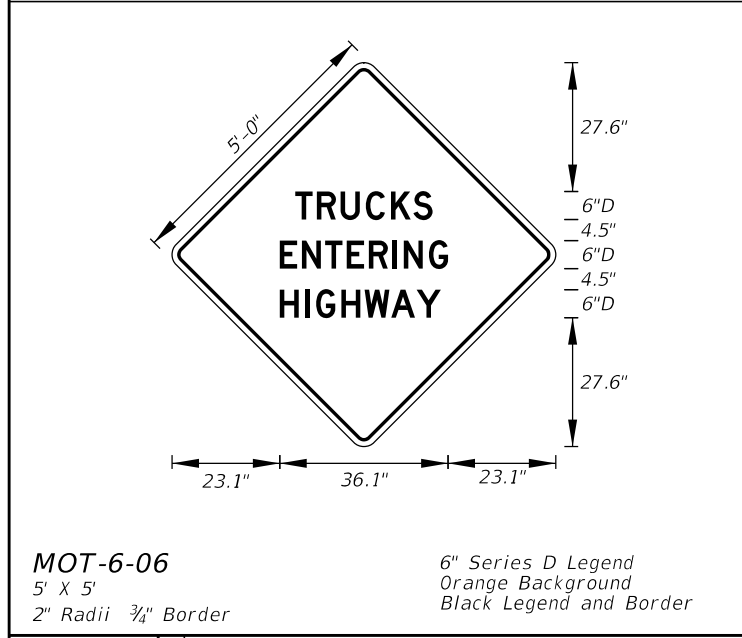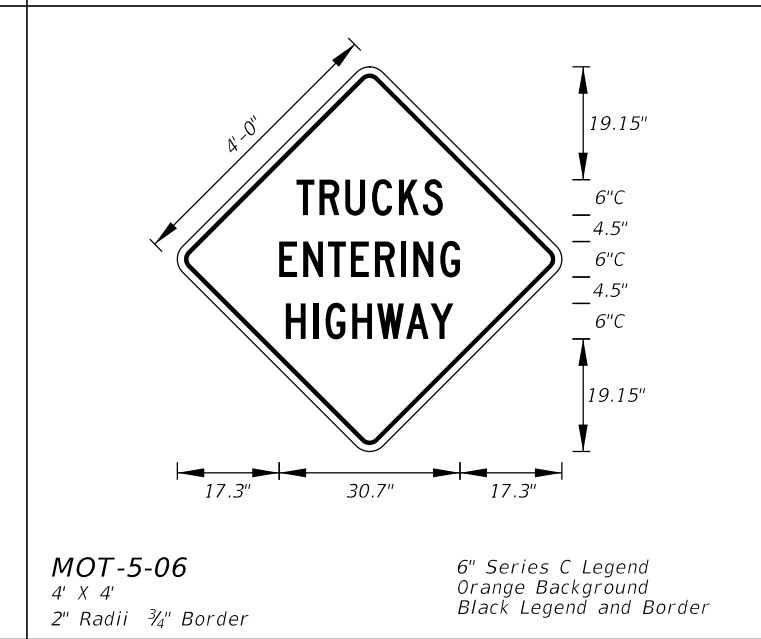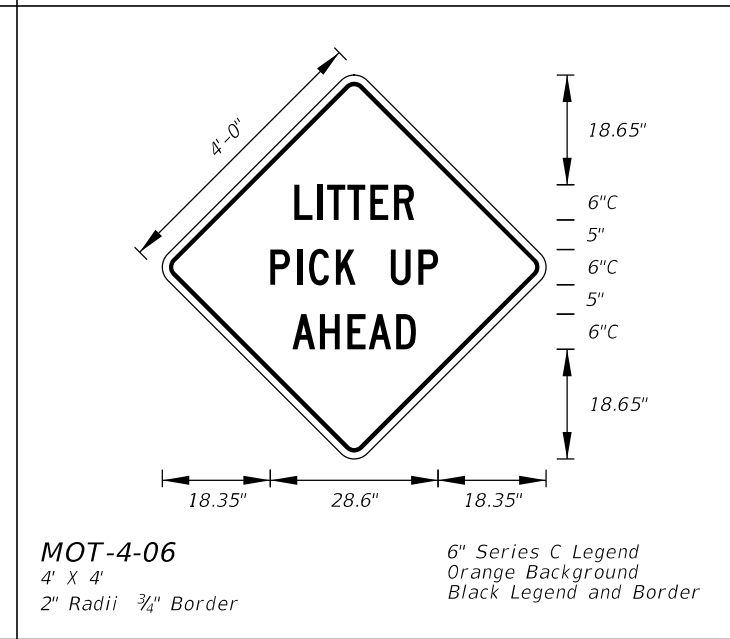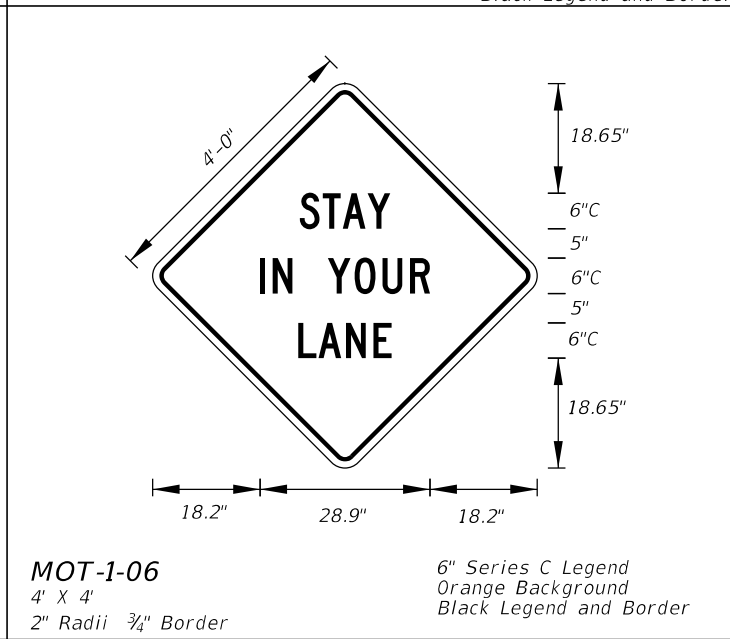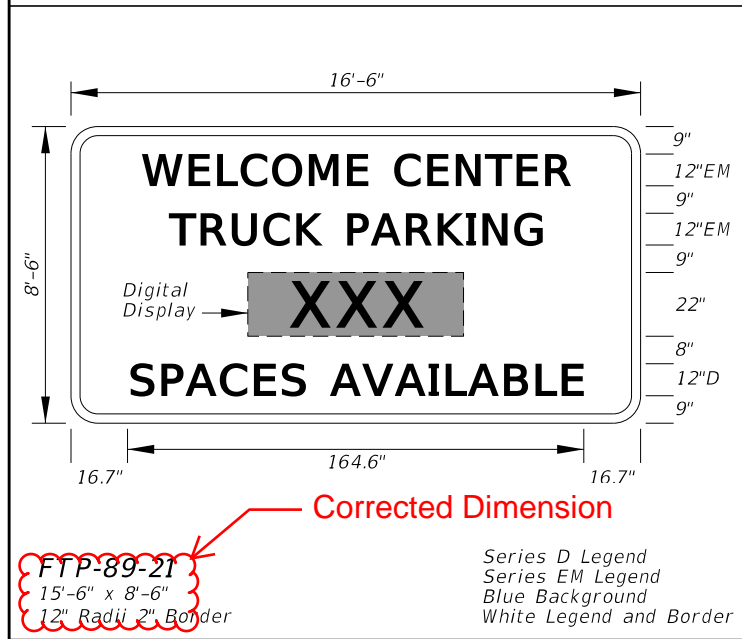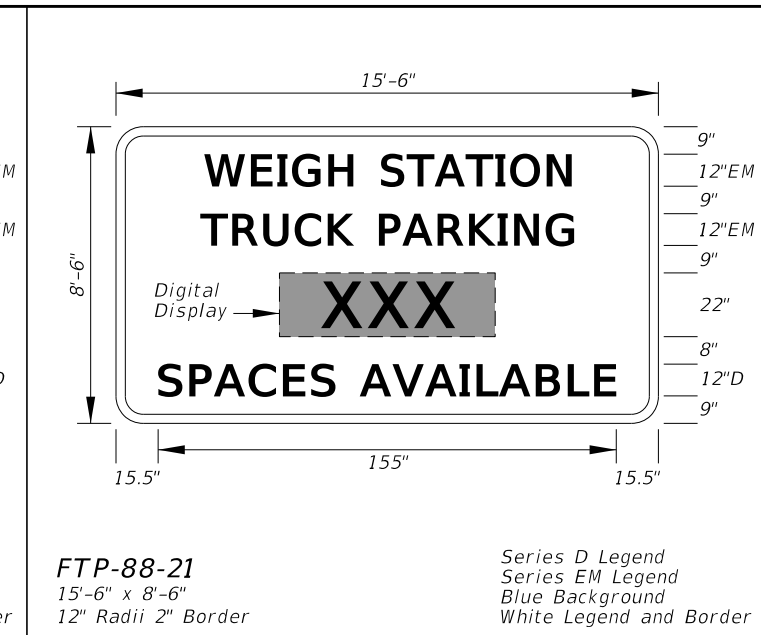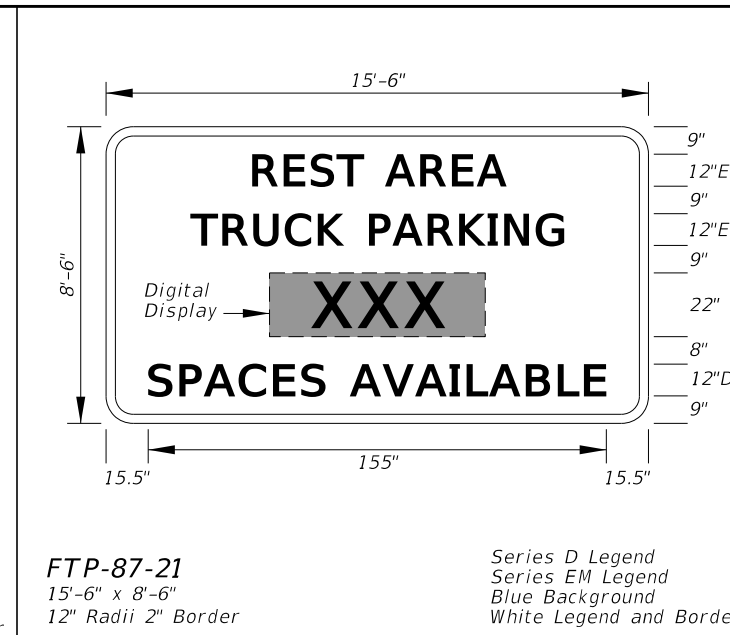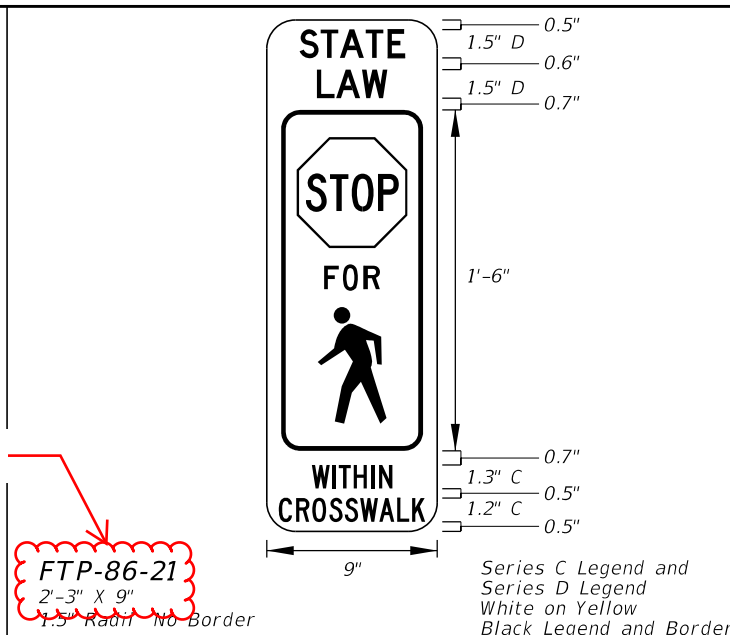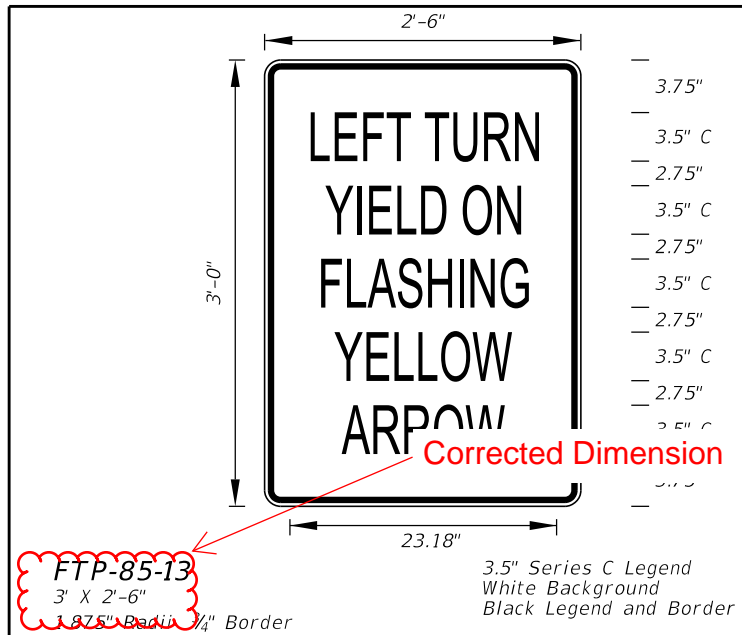

10/12/2020 9:05:40 AM

LAST REVISION	DESCRIPTION:
11/01/20	