




Shared Lane Marking (SLM)

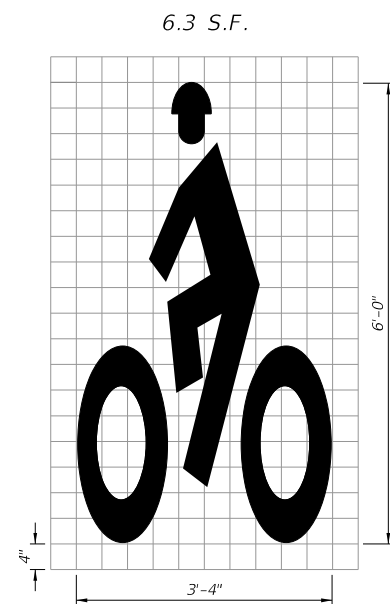

Helmeted Bicyclist Symbol

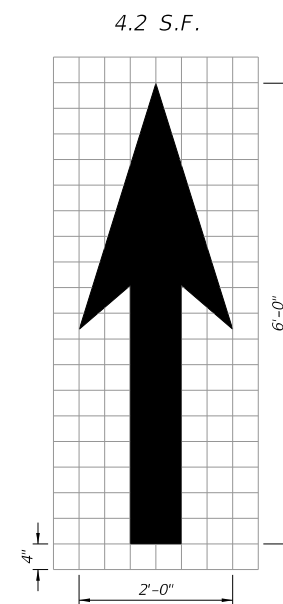

Bike Lane Arrow

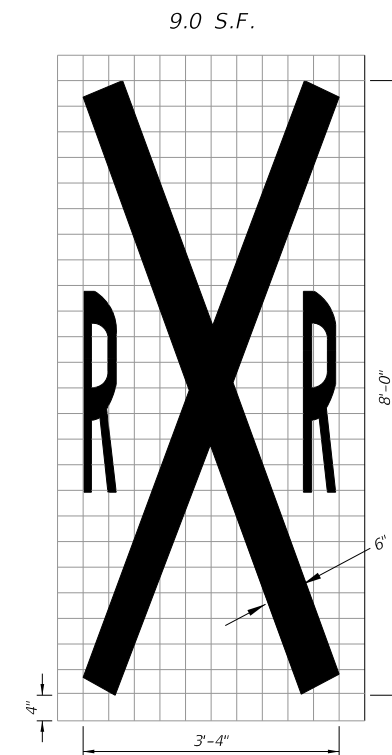

~~Railroad Crossing  
(For Shared Use Path Only)~~

Deleted


NOTES:

1. All bicycle markings and pavement messages shall be White.
2. All bicycle markings shall be preformed thermoplastic.
3. All grids are 4" x 4".


STANDARD PAVEMENT MARKING MESSAGE LAYOUTS

10/12/2020 9:10:48 AM

LAST REVISION 11/01/17	REVISION	DESCRIPTION:		FY 2021-22 STANDARD PLANS	BICYCLE MARKINGS	INDEX 711-002	SHEET 1 of 2
---------------------------	----------	--------------	--	------------------------------	------------------	------------------	-----------------

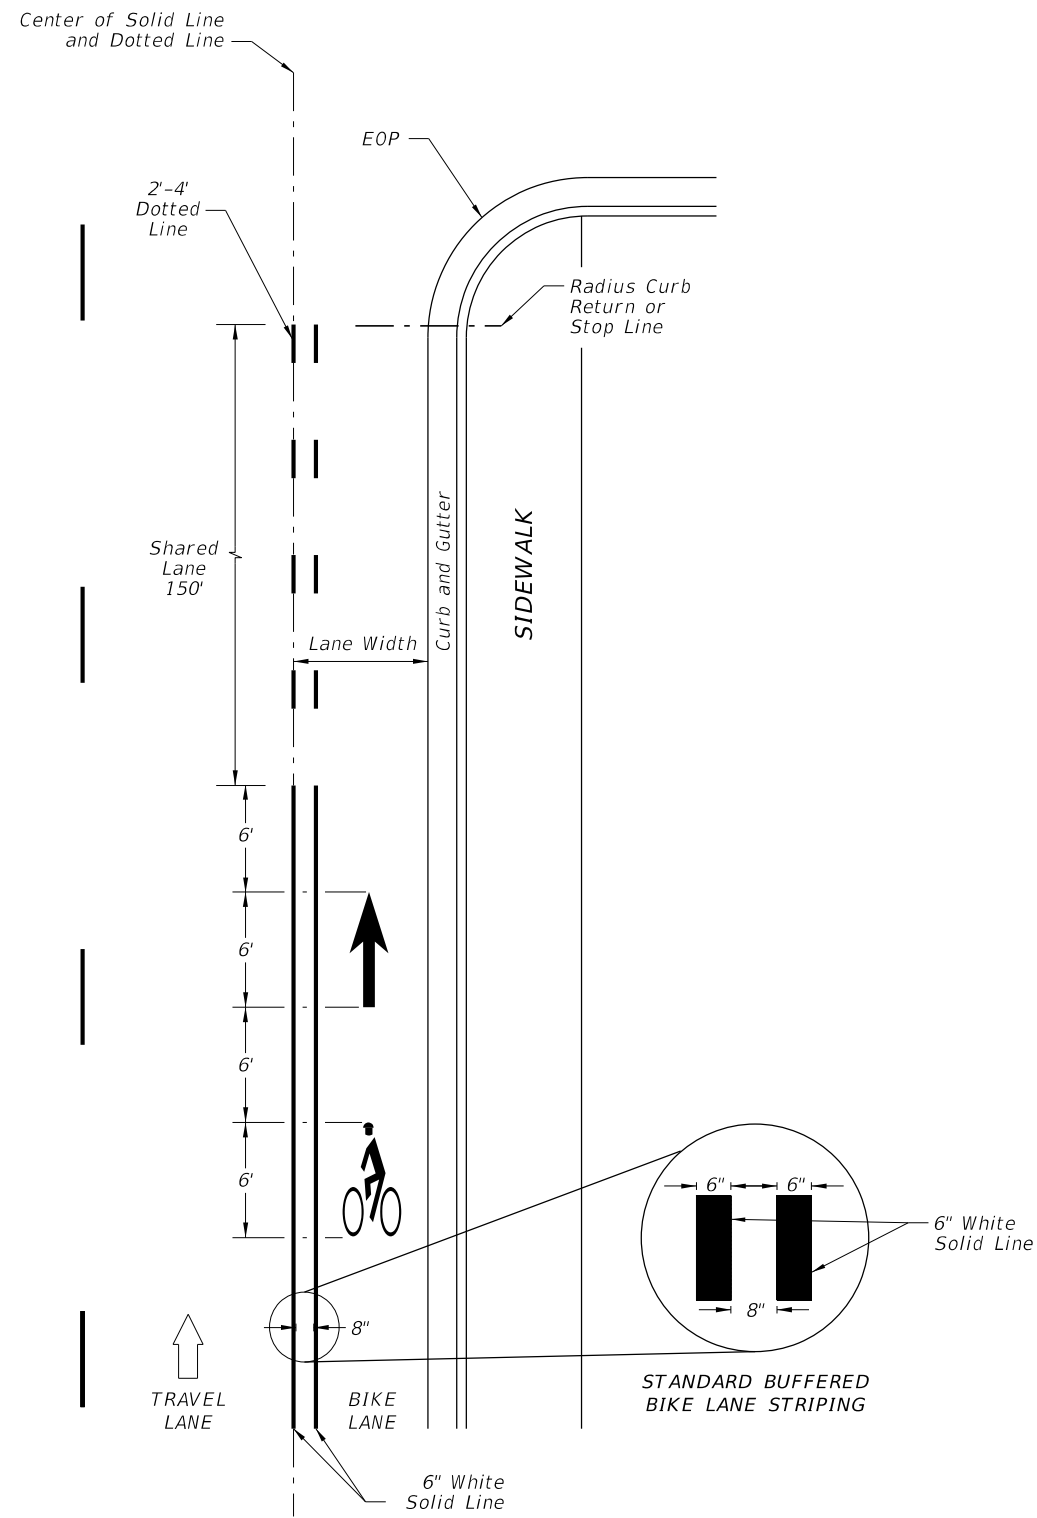

APPROACH TO INTERSECTIONS DETAILS

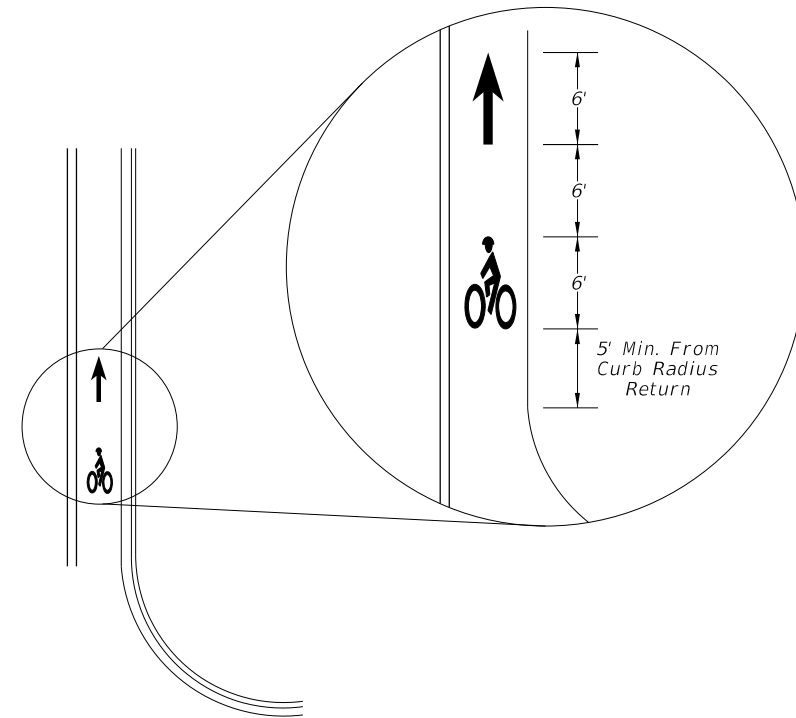

FAR SIDE OF INTERSECTION DETAIL

**BUFFERED BIKE LANES**

10/12/2020 9:10:53 AM

LAST REVISION 11/01/17	REVISION DESCRIPTION:	 FY 2021-22 STANDARD PLANS	BICYCLE MARKINGS	INDEX 711-002	SHEET 2 of 2
---------------------------	-----------------------	---	------------------	------------------	-----------------